

**SOIL/SITE EVALUATION  
 for ON-SITE WASTEWATER SYSTEM**

Owner: \_\_\_\_\_ Applicant: \_\_\_\_\_  
 Address: \_\_\_\_\_ Date Evaluated: \_\_\_\_\_  
 Proposed Facility: \_\_\_\_\_ Design Flow (.1949): \_\_\_\_\_ Property Size: \_\_\_\_\_  
 Location of Site: \_\_\_\_\_ Property Recorded: \_\_\_\_\_  
 Water Supply:  Public  Individual  Well  Spring  Other  
 Evaluation Method:  Auger Boring  Pit  Cut  
 Type of Wastewater:  Sewage  Industrial Process  Mixed

1940 Landscape Position/ Slope%	Horizon Depth (IN.)	SOIL MORPHOLOGY .1941		OTHER PROFILE FACTORS				Profile Class & LTAR
		1941 Structure/ Texture	1941 Consistence Mineralogy	1942 Soil Wetness/ Color	1943 Soil Depth (IN)	1956 Sapro Class	1944 Restr. Horz.	
	0-48	G LS	VFR NS/NP					S.R
	0-28	G LS	VFR NS/NP					S.R
	0-28	G LS	VFR NS/NP					S.R
	0-16	G LS	VFR NS/NP					S.R
	16-42"	G SL	VFR SS/NP					S.R
	0-23"	G LS	VFR NS/NP					S.R
	23-20"	G SL	VFR SS/NP					S.R

Description	Initial System	Repair System
Available Space (.1945)	✓	✓
System Type(s)	CON	CON
Site LTAR	6	6

Other Factors (.1946): \_\_\_\_\_  
 Site Classification (.1948): PS  
 Evaluated By: GT  
 Others Present: \_\_\_\_\_


COMMENTS: \_\_\_\_\_  
 \_\_\_\_\_  
 \_\_\_\_\_

<u>LANDSCAPE POSITIONS</u>	<u>GROUP</u>	<u>TEXTURES</u>	<u>.1955 LTAR</u>	<u>CONSISTENCE MOIST</u>	<u>WET</u>
R-RIDGE	I	S-SAND	1.2 - 0.8	VFR-VERY FRIABLE FR-FRIABLE FI-FIRM VFI-VERY FIRM EFI-EXTREMELY FIRM	NS-NON-STICKY SS-SLIGHTLY STICKY S-STICKY VS-VERY STICKY NP-NON-PLASTIC SP-SLIGHTLY STICKY P-PLASTIC VP-VERY PLASTIC
S-SHOULDER SLOPE		LS-LOAMY SAND			
L-LINEAR SLOPE	II	SL-SANDY LOAM	0.8 - 0.6		
FS-FOOT SLOPE		L-LOAM			
N-NOSE SLOPE	III	SI-SILT-	0.6 - 0.3		
H-HEAD SLOPE		SIL-SILT LOAM			
CC-CONCLAVE SLOPE		CL-CLAY LOAM			
CV-CONVEX SLOPE		SCL-SANDY CLAY LOAM			
T-TERRACE	IV	SIC-SILTY CLAY	0.4 - 0.1		
FP-FLOOD PLAN		C-CLAY			
		SC-SANDY CLAY			

STRUCTURE  
 SG-SINGLE GRAIN  
 M-MASSIVE  
 CR-CRUMB  
 GR-GRANULAR  
 SBK-SUBANGULAR BLOCKY  
 ABK-ANGULAR BLOCKY  
 PL-PLATY  
 PR-PRISMATIC

MINERALOGY  
 SLIGHTLY EXPANSIVE  
 EXPANSIVE

Show profile locations and other site features (dimensions, reference or benchmark, and North).

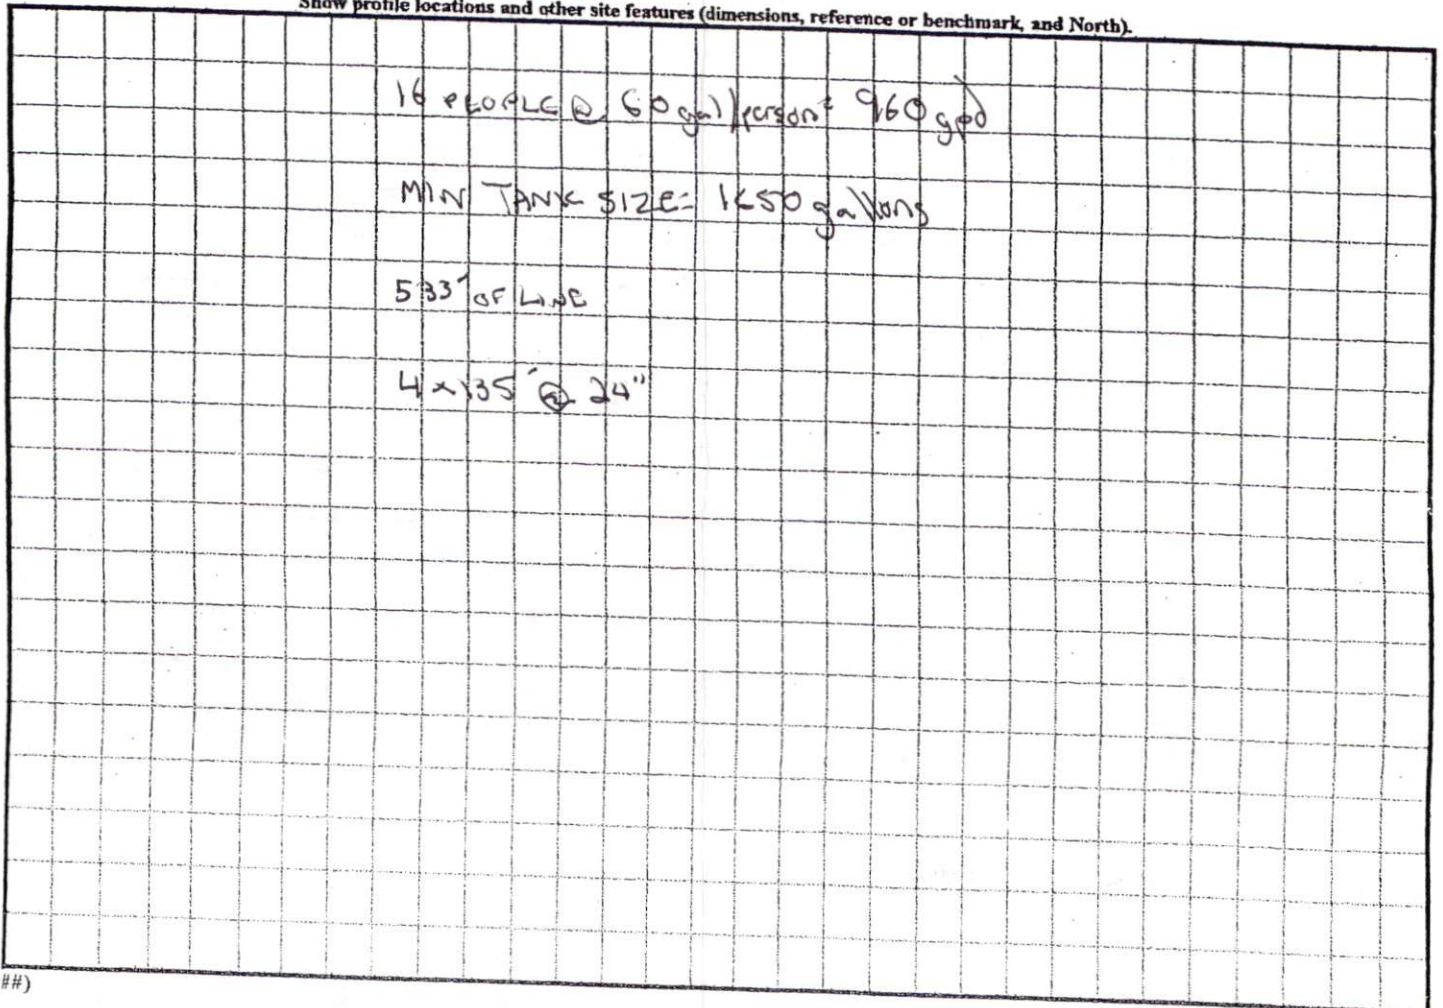

**Thomas J. Boyce**  
**11886 NC 42**  
**Holly Springs, NC 27540**  
**919-557-0826**  
**NC Licensed Soil Scientist # 1241**  
**NC Registered Sanitarian # 1353**

Jimmy Autry  
5845 NC 210 South  
Bunnlevel, NC 28323

Re: Migrant house site behind greenhouses at 5845 NC 210 South, Harnett County

Dear Mr. Autry,

A soils evaluation was completed on the above referenced property on December 30, 2005. The purpose of the evaluation was to determine the ability of the soils to support a subsurface waste disposal system. All ratings and determinations were made in accordance with "Laws and Rules for Sewage Treatment and Disposal Systems, 15A NCAC 18A .1900".

The site was evaluated by auger borings and landscape position. The typical soils were thirty-four or more inches of loamy sand or sandy loam over sandy clay loam to thirty-six or more inches. The long term acceptance rate will probably be .6-.8 gpd/sqft. A system was laid out based on 20 people or 1200 gallons per day at a .6 long term acceptance rate. This means approximately 670 linear feet of conventional drainline with a 2,000 gallon septic tank. Smaller tanks can be used in series instead of a large tank. Enclosed is a drawing representing the site and the system.

This report does not guarantee or represent approval or issuance of permits as needed by the local health department. This report only represents my opinion as a licensed soil scientist. A lot by lot evaluation should be done prior to recording. I trust this is the information that you require at this time. If you have any questions or need assistance, please call.


Sincerely,

*Thomas J. Boyce*  
Thomas J. Boyce



Larry Hoxby  
 5845 NC 210 South  
 Burnsville, NC 28323

Greenhouse

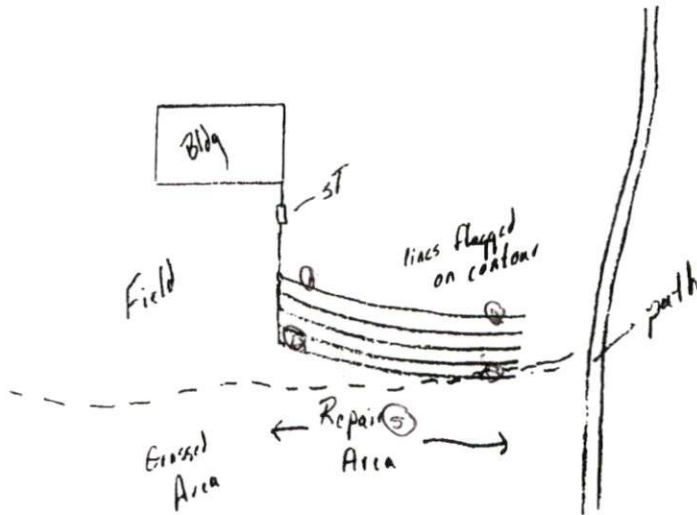

20 migrants = 1200 sq ft

.6 LTAH

670' corr. structure  
or  
5 lines - 135'

Septic Tank

1900 gallons

Single Tank or

two in series



N13