
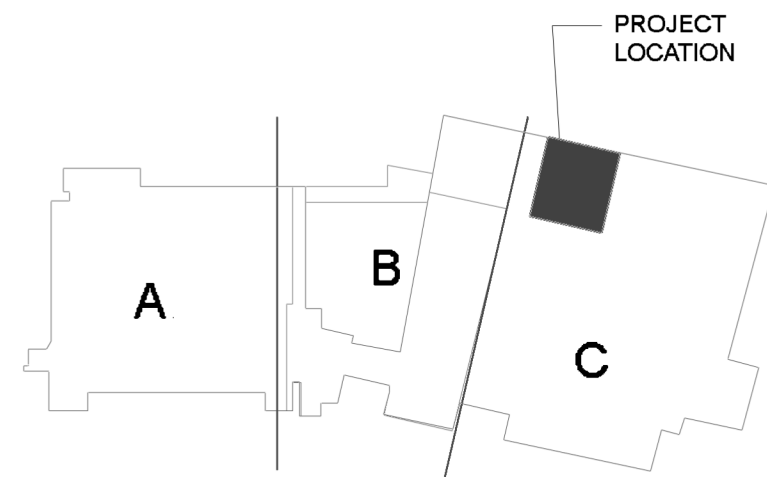


Sprinkler Legend										
Symbol	Manufacturer	SIN	Model	K-Factor	Type	Size	Response	Finish	Temperature	Quantity
●	Reliable	RA1414	F1FR56	5.6	Pendent	1/2	Quick	Chrome	155°F	5
										Total = 5

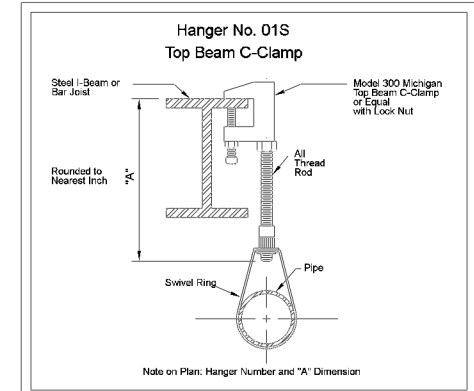


KEY PLAN
NO SCALE

Reviewed For Code Compliance By:
D. Banks Wallace
 Chief Deputy Fire Marshal
 12/17/2018 8:07:07 AM

HANGER RULES

MAX HANGER SPACING	CPVC
3/4" PIPE	5'-6" O.C.
1" PIPE	6'-0" O.C.
1-1/4" PIPE	6'-6" O.C.
1-1/2" PIPE	7'-0" O.C.
2" PIPE	8'-0" O.C.
MAX HANGER SPACING	STEEL
1"	12'
1-1/4"	12'
1-1/2"	15'
2"	15'
2-1/2"	15'
3"	15'
4"	15'
6"	15'
8"	15'
END OF LINE HANGER	STEEL
1"	3'
1-1/4"	4'
1-1/2" & LARGER	5'
ARMOVER HANGER	STEEL
1"	> 2' HORIZONTAL
PRESSURE GREATER THAN 100 PSI	
ARMOVER HANGER	STEEL
1"	> 1' HORIZONTAL
PENDENT SPRINKLERS ON DROPS REQUIRE HANGERS THAT HOLD THE PIPE DOWN. RODS TIGHT TO PIPE.	

CENTRAL HARNETT PHARMACY
3/16" = 1'-0"

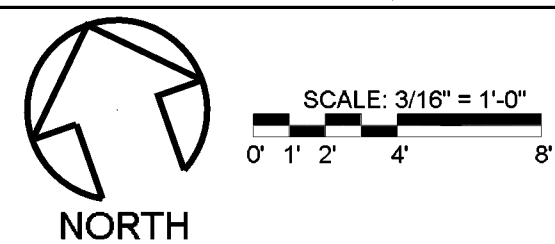

FIRE PROTECTION NOTES

- EXISTING FIRE PROTECTION DESIGN TO REMAIN - NFPA 13, 2013 ED.
- RELOCATED 5 EXISTING HEADS FOR NEW ROOM LAYOUT
- FIELD VERIFY ALL SPRINKLER COVERAGE PER CODE
- INSTALL HANGERS AS NEEDED PER NFPA 13
- MAX HEAD SPACING 225 SQ. FT.
- ALL NEW HEADS TO MATCH EXISTING STYLE

CHH PHARMACY FIRE PROTECTION

CHH PHARMACY
215 BRIGHTWATER DRIVE
LILLINGTON, NC

BLACKSTONE
FIRE CONTROL
Your Business for Life™

PO BOX 4584
GREENSBORO, NC 27404
O: (336) 791-0593
F: (336) 217-8305

OWNER: MICHAEL MERACADANTE
NC FS-C LICENSE 30490
NICET ID # 118530

SCALE:	3/16" = 1'-0"	FILE NAME:	CHH PHARM
A.H.J.:	HARNETT CO	DRAWING:	CHH PHARM
CONT. W/:	DA EVERETT	DRAWING NUMBER:	
DRAWN BY:	M. STEVENSON		
DATE:	11/18/18		
PLOT DATE:	11/20/18		

FP - 01