




Ossa
STUDIO

4539 HEDGEMORE DRIVE, SUITE 101
CHARLOTTE NC 28209
704.890.2553
WWW.OSSASTUDIO.COM

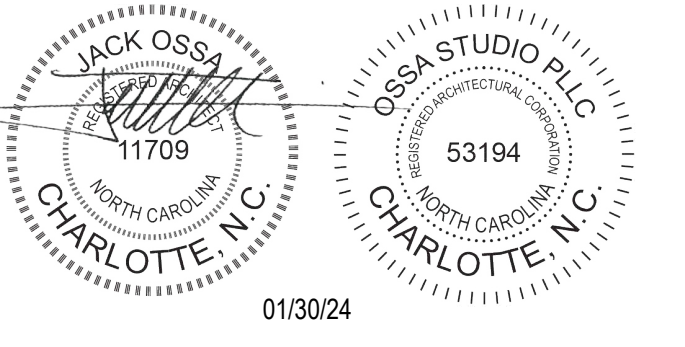

PROJECT TEAM

General Contractor
ECCLESIA CONSTRUCTION
www.ecclesiainc.com
919.327.5670


Civil Engineering
HILLIARD ENGINEERING, PLLC
www.hilliarde.com
919.352.2834

Structural Engineering
PROVIDENCE PARTNERS
www.providencpartnersinc.com
704.266.6621

Mechanical, Electrical, Plumbing & Fire Protection
ENGINEERING
www.engineering.com
704.287.2193

Date	Description
01/30/24	FOR CONSTRUCTION
1 05/8/24	PERMIT REVIEW COMMENTS
2 10/14/24	RTAP NO. 1

Project Name

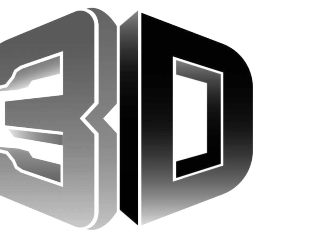

community church
making church come *alive*
658 GRAHAM ROAD
SANFORD NC 27311

Client

3D COMMUNITY CHURCH

Project Number

23024.00

Description

COVER SHEET

Scale

A00.00


3D COMMUNITY CHURCH

658 GRAHAM ROAD SANFORD NC 27311


10/14/24 RTAP NO. 1

01/30/24 FOR CONSTRUCTION


10/14/2024 5:05:36 PM C:\Printran\Drawings\Revit\Loc2\2024_00_3D Community Church\andrew.mcdellan\FCLC.rvt

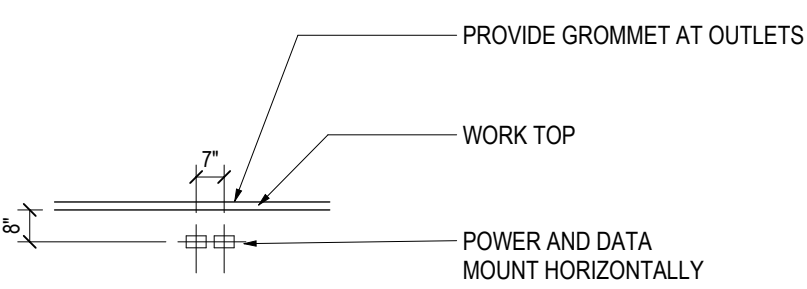


LOCATIONS AT WORK SURFACES OUTLETS

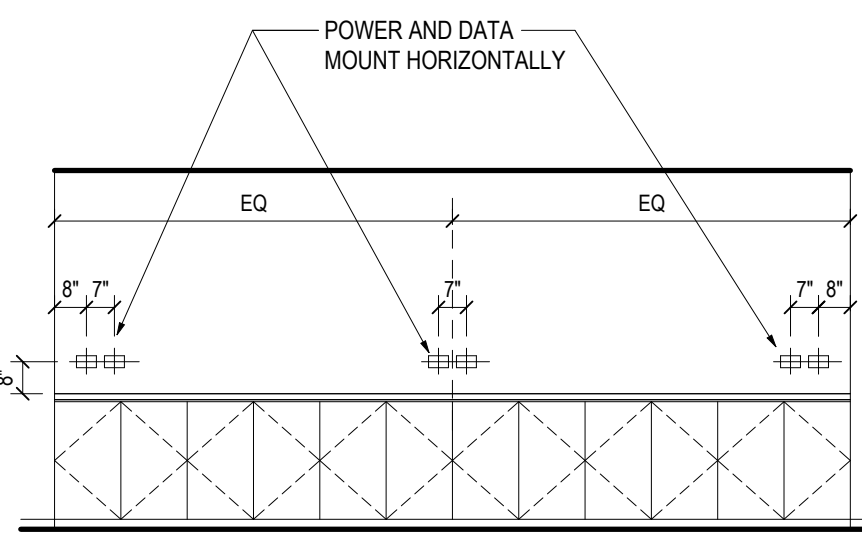


LOCATIONS AT MILLWORK COUNTERS OUTLETS

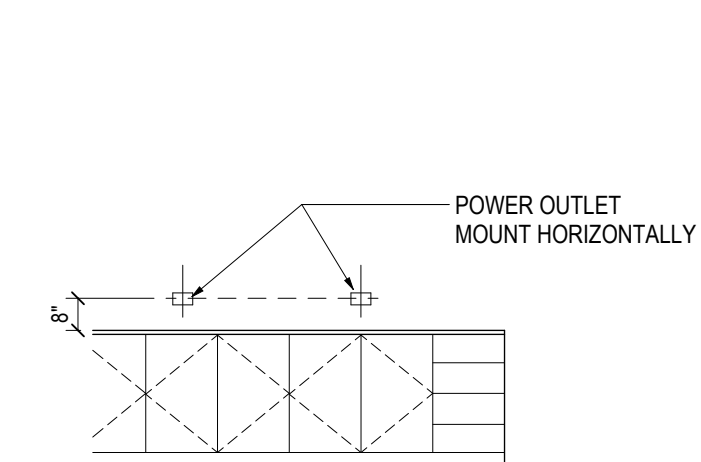


LOCATIONS AT MILLWORK COUNTERS OUTLETS

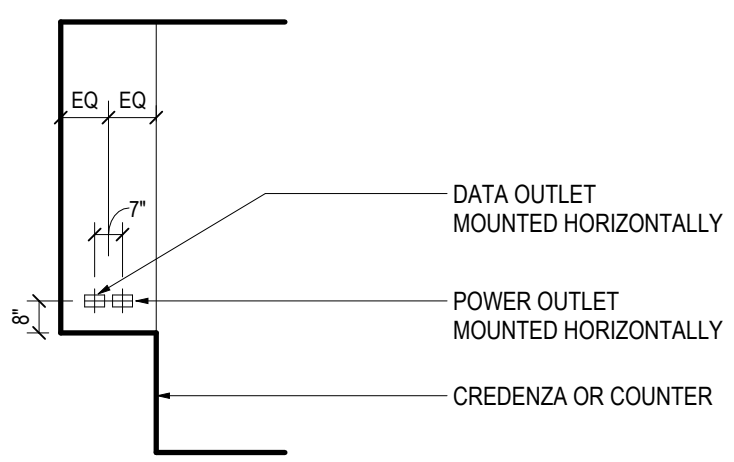


LOCATIONS AT CREDENZAS OR COUNTERS OUTLETS

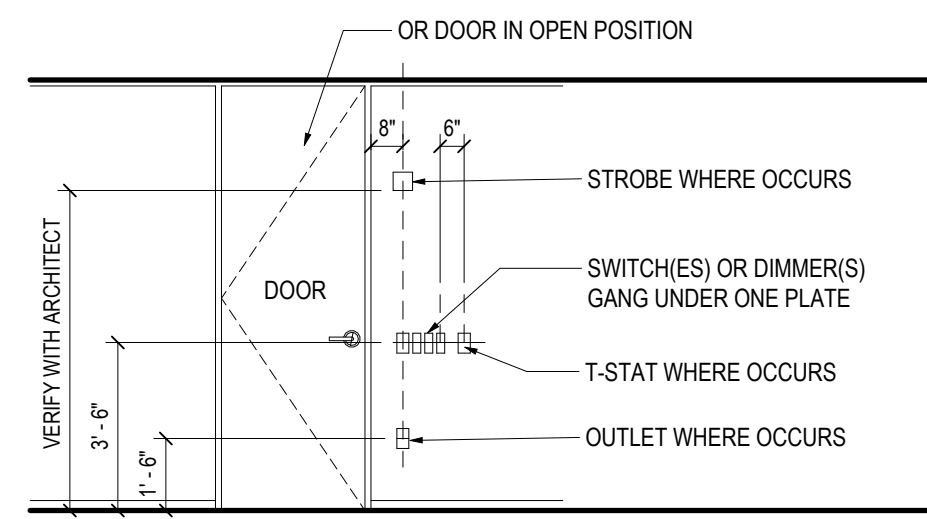

LOCATIONS AT DOOR JAMBS SWITCH AND THERMOSTATS

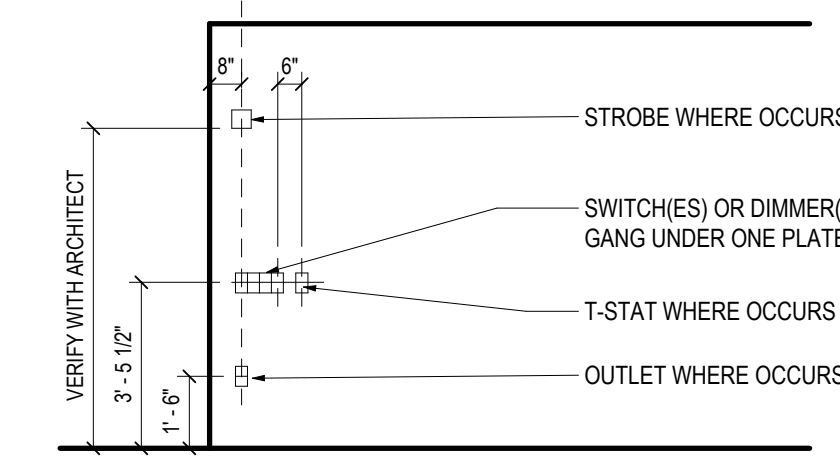

LOCATIONS AT CORNERS

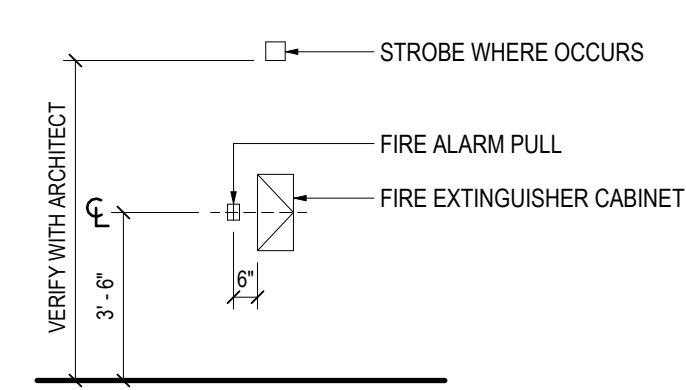

LOCATIONS AT FIRE EXTINGUISHER CABINET STROBES AND FIRE ALARM PULLS

GENERAL NOTES

1. COMPLY WITH CODES, LAWS, ORDINANCES, RULES, AND REGULATIONS OF PUBLIC AUTHORITIES GOVERNING THE WORK.
2. OBTAIN AND PAY FOR PERMITS AND INSPECTIONS REQUIRED BY PUBLIC AUTHORITIES GOVERNING THE WORK.
3. REVIEW DOCUMENTS, VERIFY DIMENSIONS AND FIELD CONDITIONS AND CONFIRM THAT WORK IS BUILDABLE AS SHOWN. REPORT ANY CONFLICTS OR OMISSIONS TO THE ARCHITECT FOR CLARIFICATION PRIOR TO PERFORMING ANY WORK IN QUESTION.
4. SUBMIT REQUESTS FOR SUBSTITUTIONS, REVISIONS, OR CHANGES TO ARCHITECT FOR REVIEW PRIOR TO PURCHASE, FABRICATION OR INSTALLATION.
5. COORDINATE WORK WITH THE OWNER, INCLUDING SCHEDULING TIME AND LOCATIONS FOR DELIVERIES, BUILDING ACCESS, USE OF BUILDING SERVICES AND FACILITIES, AND USE OF ELEVATORS. MINIMIZE DISTURBANCE OF OPERATIONS, FUNCTIONS AND OCCUPANTS.
6. OWNER WILL PROVIDE WORK NOTED "BY OTHERS" OR "NIC" UNDER SEPARATE CONTRACT. INCLUDE SCHEDULE REQUIREMENTS IN CONSTRUCTION PROGRESS SCHEDULE AND COORDINATE TO ASSURE ORDERLY SEQUENCE OF INSTALLATION.
7. COORDINATE TELECOMMUNICATIONS, DATA AND SECURITY SYSTEM INSTALLATIONS.
8. MAINTAIN EXITS, EXIT LIGHTING, FIRE PROTECTIVE DEVICES, AND ALARMS IN CONFORMANCE WITH CODES AND ORDINANCES.
9. PROTECT AREA OF WORK AND ADJACENT AREAS FROM DAMAGE.
10. MAINTAIN WORK AREAS SECURE AND LOCKABLE DURING CONSTRUCTION. COORDINATE WITH TENANT AND LANDLORD TO ENSURE SECURITY.
11. DO NOT SCALE DRAWINGS. WRITTEN DIMENSIONS GOVERN. IN CASE OF CONFLICT, CONSULT THE ARCHITECT.
12. PARTITIONS ARE DIMENSIONED FROM FINISH FACE TO FINISH FACE, UNLESS OTHERWISE NOTED. MAINTAIN DIMENSIONS MARKED "CLEAR" ALLOW FOR THICKNESS OF FINISHES.
13. COORDINATE AND PROVIDE BACKING FOR MILLWORK AND ITEMS ATTACHED OR MOUNTED TO WALLS OR CEILINGS.
14. WHERE EXISTING ACCESS PANELS CONFLICT WITH CONSTRUCTION, RELOCATE PANELS TO ALIGN WITH AND FIT WITHIN NEW CONSTRUCTION.
15. UNDERCUT DOORS TO CLEAR TOP OF FLOOR FINISHES BY 1/4 INCH, UNLESS OTHERWISE NOTED.

FIRE DEPARTMENT NOTES

1. PROVIDE A PORTABLE FIRE EXTINGUISHER WITH A RATING OF NOT LESS THAN 4-A WITHIN 75 FOOT TRAVEL DISTANCE TO ALL PORTIONS OF THE BUILDING ON EACH FLOOR, AND ADDITIONAL EXTINGUISHERS AS REQUIRED BY FIRE DEPARTMENT FIELD INSPECTOR OR BUILDING DEPARTMENT INSPECTOR.
2. PROVIDE EXIT SIGN WITH 6" LETTERS OVER REQUIRED EXITS, WHERE SHOWN ON DRAWINGS, AND ADDITIONAL SIGNS AS REQUIRED BY BUILDING DEPARTMENT INSPECTOR OR FIRE DEPARTMENT FIELD INSPECTOR. CONNECT EXIT SIGNS TO EMERGENCY POWER CIRCUITS. COMPLY WITH BUILDING CODES.
3. PROVIDE EMERGENCY LIGHTING OF ONE FOOT CANDELA AT FLOOR LEVEL. COMPLY WITH BUILDING CODES.
4. MAINTAIN AISLES AT LEAST 44" WIDE AT PUBLIC AREAS.
5. EVERY EXIT DOOR SHALL BE OPERABLE FROM THE INSIDE WITHOUT THE USE OF A KEY OR ANY SPECIAL KNOWLEDGE OR EFFORT. SPECIAL LOCKING DEVICES SHALL BE OF AN APPROVED TYPE. ALL NEW DOORS SHALL HAVE APPROVED LEVER HANDLES.
6. DOORS OPENING INTO REQUIRED 1-HOUR, FIRE-RESISTIVE CORRIDORS SHALL BE PROTECTED WITH A SMOKE OR DRAFT STOP ASSEMBLY HAVING A 20-MINUTE RATING AND SHALL BE SELF-CLOSING.
7. 20-MINUTE DOOR JAMBS TO BE TIGHT-FITTING, SMOKE AND DRAFT CONTROLLED.
8. EXIT DOORS SHALL SWING IN THE DIRECTION OF TRAVEL WHEN SERVING 50 OR MORE PERSONS AND IN ANY HAZARDOUS AREA.
9. INTERIOR WALL AND CEILING FINISHES FOR EXIT CORRIDOR SHALL NOT EXCEED AN END POINT FLAME SPREAD RATING:
 - A. CLASS I, FLAME SPREAD 0-25, SMOKE DENSITY 100, FOR MATERIALS INSTALLED IN VERTICAL EXITS.
 - B. CLASS II, FLAME SPREAD 26-75, SMOKE DENSITY 300, FOR MATERIALS INSTALLED IN HORIZONTAL EXITS.
 - C. CLASS III, FLAME SPREAD 76-200, SMOKE DENSITY 450, FOR MATERIALS INSTALLED IN ANY OTHER LOCATION.
10. DECORATIONS (CURTAINS, DRAPES, SHADES, HANGINGS, ETC.) SHALL BE NON-COMBUSTIBLE OR BE FLAMEPROOFED IN AN APPROVED MANNER.
11. PROVIDE FIRE DAMPERS OR DOORS WHERE AIR DUCTS PENETRATE FIRE-RATED WALLS OR CEILINGS.
12. STORAGE, DISPENSING OR USE OF ANY FLAMMABLE OR COMBUSTIBLE LIQUIDS, FLAMMABLE GAS AND HAZARDOUS SUBSTANCES SHALL COMPLY WITH FIRE CODE REGULATIONS.
13. WOOD BLOCKING SHALL BE FIRE TREATED IN ACCORDANCE WITH APPLICABLE CODE REQUIREMENTS.
14. EXTEND OR MODIFY EXISTING FIRE SAFETY SYSTEMS AS REQUIRED TO PROVIDE AN APPROVED FIRE LIFE SAFETY SYSTEM. SUBMIT PLANS TO FIRE DEPARTMENT WITH COMPLETE DESCRIPTION OF SEQUENCE OF OPERATION, AND OBTAIN APPROVAL PRIOR TO INSTALLATION.
15. LOCATE THE CENTER OF FIRE ALARM INITIATING DEVICES 48" ABOVE THE LEVEL OF THE FLOOR, WORKING PLATFORM, GROUND SURFACE OR SIDEWALK.
16. EMERGENCY WARNING SYSTEMS SHALL ACTIVATE A MEANS OF WARNING THE HEARING IMPAIRED. FLASHING VISUAL WARNING SHALL HAVE A FREQUENCY OF NOT MORE THAN 60 FLASHES PER MINUTE.
17. EXTEND OR MODIFY EXISTING AUTOMATIC FIRE EXTINGUISHING SYSTEM AS REQUIRED TO PROVIDE AN APPROVED AUTOMATIC FIRE EXTINGUISHING SYSTEM. SUBMIT PLANS TO FIRE DEPARTMENT AND OBTAIN APPROVAL PRIOR TO INSTALLATION.
18. AUTOMATIC SPRINKLER SYSTEMS SHALL BE SUPERVISED BY AN APPROVED CENTRAL, PROPRIETARY OR REMOTE STATION SERVICE OR A LOCAL ALARM WHICH WILL GIVE AN AUDIBLE SIGNAL AT A CONSTANTLY ATTENDED LOCATION.

FINISH NOTES

1. ENSURE SURFACES TO RECEIVE FINISHES ARE CLEAN, TRUE, AND FREE OF IRREGULARITIES. DO NOT PROCEED WITH WORK UNTIL UNSATISFACTORY CONDITIONS HAVE BEEN CORRECTED.
2. REPAIR EXISTING SURFACES TO REMAIN AS REQUIRED FOR APPLICATION OF NEW FINISHES.
3. PROVIDE STRAIGHT, FLUSH RESILIENT BASE AT CARPETED AREAS AND COVERED, TOP SET RESILIENT BASE AT RESILIENT FLOORING, UNLESS OTHERWISE NOTED.

POWER & COMMUNICATION NOTES

1. PRIOR TO CORING SLAB, REVIEW LOCATIONS WITH ARCHITECT AND COORDINATE LOCATIONS WITH OWNER.
2. COORDINATE INSTALLATION OF TELECOMMUNICATIONS, DATA AND SECURITY SYSTEMS AND AUDIOVISUAL DRAWINGS.
3. VERIFY EQUIPMENT SPECIFICATIONS, POWER AND INSTALLATION REQUIREMENTS WITH MANUFACTURERS TO ENSURE PROPER FIT AND FUNCTION.
4. VERIFY MOUNTING REQUIREMENTS OF ELECTRICAL, TELEPHONE AND OTHER EQUIPMENT.
5. GANG ADJACENT LIGHT SWITCHES AND COVER WITH A SINGLE PLATE.
6. MOUNT STANDARD WALL SWITCHES AND THERMOSTATS AT HEIGHTS REQUIRED BY TITLE 24 AND ADA GUIDELINES, UNLESS OTHERWISE NOTED. WHEN THERMOSTATS AND LIGHT SWITCH OCCUR TOGETHER, INSTALL BOTH ALIGNED HORIZONTALLY WITH CENTER LINE AT -3'-2" ABOVE FINISHED FLOOR.
7. INDICATED DIMENSIONS ARE TO THE CENTER LINE OF OUTLET OR SWITCH, OR CLUSTER OF OUTLETS OR SWITCHES, UNLESS OTHERWISE NOTED.
8. INSTALL OUTLETS ON OPPOSITE SIDES OF PARTITIONS IN SEPARATE STUD CAVITIES. DO NOT INSTALL BACK-TO-BACK.
9. PROVIDE MATCHING COVER PLATES, RECEPTACLES AND RELATED ITEMS. PROVIDE ONE-PIECE TYPE GANG COVER PLATES, UNLESS OTHERWISE NOTED.
10. IDENTIFY DEDICATED OR ISOLATED GROUND ELECTRICAL OUTLETS WITH A RED DOT.

DISABLED ACCESS NOTES

1. IN BUILDINGS AND FACILITIES, FLOORS OF A GIVEN STORY SHALL BE A COMMON LEVEL THROUGHOUT, OR SHALL BE CONNECTED BY PEDESTRIAN RAMPS, PASSENGER ELEVATORS OR SPECIAL ACCESS LIFTS.
2. FLOOR SURFACES SHALL BE SLIP-RESISTANT.
3. EVERY CORRIDOR AND AISLE SERVING AN OCCUPANT LOAD OF 10 OR MORE SHALL BE NOT LESS THAN 44" IN WIDTH.
4. ABRUPT CHANGES IN LEVEL ALONG ANY ACCESSIBLE ROUTE SHALL NOT EXCEED 1/2" IN HEIGHT. LEVEL CHANGES NOT EXCEEDING 1/4" MAY BE VERTICAL. BEVEL OTHERS WITH A SLOPE NO GREATER THAN 1:2.
5. LATCHING AND LOCKING DEVICES THAT ARE HAND ACTIVATED AND WHICH ARE IN A PATH OF TRAVEL SHALL BE OPERABLE WITH A SINGLE EFFORT BY LEVER TYPE HARDWARE, PANIC BARS, PUSH-PULL ACTIVATING BARS, OR OTHER HARDWARE DESIGNED TO PROVIDE PASSAGE WITHOUT REQUIRING THE ABILITY TO GRASP THE OPENING HARDWARE.
6. CENTER HAND ACTIVATED DOOR OPENING HARDWARE BETWEEN 30" AND 44" ABOVE THE FLOOR.
7. MAXIMUM PULL OR PUSH EFFORT TO OPERATE DOORS SHALL NOT EXCEED 8.5 POUNDS FOR EXTERIOR DOORS AND 5 POUNDS FOR INTERIOR DOORS. MEASURED AT RIGHT ANGLES TO HINGED DOORS AND AT CENTER PLANE OF SLIDING OR FOLDING DOORS. CORRESPONDING DEVICES OR AUTOMATIC DOOR OPERATORS MAY BE UTILIZED TO MEET THE ABOVE STANDARDS. MAXIMUM EFFORT TO OPERATE REQUIRED FIRE DOORS MAY BE INCREASED NOT TO EXCEED 15 POUNDS.
8. THE BOTTOM 10" OF ALL DOORS (EXCEPT SLIDING AND AUTOMATIC) SHALL HAVE A SMOOTH UNINTERRUPTED SURFACE TO ALLOW THE DOOR TO BE OPENED BY A WHEELCHAIR FOOTREST WITHOUT CREATING A TRAP OR HAZARDOUS CONDITION. PROVIDE A 10" HIGH SMOOTH PANEL ON THE PUSH SIDE OF NARROW FRAME DOORS.
9. EVERY REQUIRED ENTRANCE OR PASSAGE DOORWAY SHALL BE NOT LESS THAN 3'-0" IN WIDTH AND NOT LESS THAN 6'-8" IN HEIGHT. DOORS SHALL BE CAPABLE OF OPENING AT LEAST 90 DEGREES AND SHALL BE SECURELY MOUNTED THAT THE CLEAR WIDTH OF THE DOORWAY IS NOT LESS THAN 32".
10. WHERE A PAIR OF DOORS IS UTILIZED, AT LEAST ONE OF THE DOORS SHALL PROVIDE A CLEAR, UNOBSTRUCTED OPENING WIDTH OF 32" WITH THE LEAF POSITIONED AT AN ANGLE OF 90 DEGREES FROM ITS CLOSED POSITION.
11. IDENTIFY ACCESSIBLE ENTRANCES WITH AT LEAST ONE STANDARD SIGN AND WITH ADDITIONAL UNIDIRECTIONAL SIGNS, AS REQUIRED, VISIBLE FROM APPROACHING PEDESTRIAN WAYS.
12. THE FLOOR OR LANDING ON EACH SIDE OF AN ENTRANCE OR PASSAGE DOOR SHALL BE LEVEL AND CLEAR. THE LEVEL AND CLEAR AREA SHALL HAVE A LENGTH IN THE DIRECTION OF DOOR SWING OF AT LEAST 60" AND THE LENGTH OPPOSITE THE DIRECTION OF DOOR SWING OF 44" AS MEASURED.
13. FLOORS OR LANDINGS SHALL BE NOT MORE THAN 1/2" LOWER THAN THE THRESHOLD OF THE BE BEVELED WITH A SLOPE NO GREATER THAN 1:2.
14. TO ALERT THE VISUALLY IMPAIRED, MARK THE UPPER APPROACH AND THE LOWER READ OF EACH INTERIOR STAIR WITH A STRIP OF CLEARLY CONTRASTING COLOR AT LEAST 2" WIDE, PLACED PARALLEL TO AND NOT MORE THAN 1" FROM THE NOSE OF THE STEP OR LANDING. THE STRIP SHALL BE OF A MATERIAL THAT IS AT LEAST AS SLIP RESISTANT AS THE OTHER TREADS OF THE STAIR.
15. CENTER ELECTRICAL RECEPTACLE OUTLETS NOT LESS THAN 15" ABOVE THE FLOOR OR WORKING PLATFORM.
16. SANITARY FACILITIES LOCATED ON AN ACCESSIBLE FLOOR OF A BUILDING SHALL BE ACCESSIBLE TO THE PHYSICALLY HANDICAPPED.
17. ENTRY TO SANITARY FACILITIES:
 - A. 44" CLEAR AISLES OR CORRIDORS WHERE OCCUPANT LOAD IS 10 OR MORE.
 - B. DOORWAYS TO HAVE A 32" CLEAR OPENING.
 - C. ON APPROACH SIDE, PROVIDE A 90" CLEAR LEVEL SPACE WHEN DOOR SWINGS TOWARD APPROACH AND 44" SPACE WHEN DOOR SWINGS AWAY FROM APPROACH.
18. TOILET ROOM ACCESSORIES:
 - A. MOUNT BOTTOM EDGE OF MIRRORS NO HIGHER THAN 40" FROM THE FLOOR.
 - B. MOUNT TOILET TISSUE DISPENSERS WITHIN 12" FROM THE FRONT EDGE OF THE TOILET SEAT.
 - C. MOUNT DISPENSING AND DISPOSAL FIXTURES (TOWEL, SANITARY NAPKINS, WASTE, COIN SLOTS, ETC.) WITH OPERATING PARTS NO HIGHER THAN 40" FROM THE FLOOR.
19. SINGLE ACCOMMODATION TOILET FACILITY:
 - A. WATER CLOSET TO HAVE A 28" CLEARANCE FROM A FIXTURE AND 32" FROM A WALL.
 - B. MINIMUM CLEAR SPACE IN FRONT OF WATER CLOSET TO BE 48".
 - C. A SPACE 36" X 48" IS PERMITTED IN FRONT OF EXISTING WATER CLOSET ACCESSIBLE TO THE HANDICAPPED.
20. THE HEIGHT OF THE WATER CLOSET (TOP OF SEAT) SHALL BE BETWEEN 17" AND 19".
21. MOUNT FLUSH VALVE CONTROL, NO MORE THAN 44" ABOVE THE FLOOR, ON THE SIDE OF THE TOILET WITH THE GREATEST SEPARATION FROM ADJACENT WALL OR OTHER SURFACE.
22. PROVIDE GRAB BARS ON EACH SIDE, OR ONE SIDE AND BACK OF WATER CLOSET.
 - A. GRAB BARS TO BE 37" HIGH AND PARALLEL TO THE FLOOR.
 - B. SIDE BARS TO BE 42" LONG AND PROJECT 24" IN FRONT OF WATER CLOSET STOOL. GRAB BAR AT BACK TO BE 36" LONG.
 - C. DIAMETER OF GRAB BARS TO BE 1-1/4" TO 1-1/2".
 - D. PROVIDE 1-1/2" CLEARANCE BETWEEN GRAB BARS AND WALL.
 - E. GRAB BARS (INCLUDING CONNECTORS, FASTENERS, SUPPORT BACKING, ETC.) SHALL SUPPORT A 250 POUND LOAD.
 - F. GRAB BARS SHALL NOT ROTATE WITHIN THEIR FITTINGS.
 - G. GRAB BARS AND ANY ADJACENT SURFACES SHALL BE FREE OF SHARP OR ABRASIVE ELEMENTS.
 - H. EDGES SHALL HAVE A MINIMUM RADIUS OF 18".
23. PROVIDE A CLEAR FLOOR SPACE 30" X 48" IN FRONT OF LAVATORY TO PERMIT A FORWARD APPROACH.
24. MOUNT LAVATORIES WITH A MINIMUM CLEARANCE OF 29" FROM THE FLOOR TO THE BOTTOM OF THE APRON. PROVIDE KNEE CLEARANCE UNDER THE FRONT LIP EXTENDING A MINIMUM OF 30" IN WIDTH WITH 8" MINIMUM WIDTH AND SHALL BE A MINIMUM OF 9" HIGH FROM THE FLOOR. A MINIMUM OF 17" DEEP FROM THE FRONT OF THE LAVATORY.
25. FAUCET CONTROLS AND OPERATING MECHANISMS SHALL BE OPERABLE WITH ONE HAND AND SHALL NOT REQUIRE TIGHT GRASPING, PINCHING OR TWISTING OF THE WRIST. THE FORCE REQUIRED TO ACTIVATE SHALL BE NO GREATER THAN 5 POUNDS. LEVER-OPERATED, PUSH-TYPE AND ELECTRONICALLY CONTROLLED MECHANISMS ARE EXAMPLES OF ACCEPTABLE DESIGNS. SELF-CLOSING ARE ALLOWED IF THE FAUCET REMAINS OPEN FOR AT LEAST 10 SECONDS.
26. INSULATE OR OTHERWISE COVER HOT WATER AND DRAIN PIPES UNDER LAVATORIES.
27. THERE SHALL BE NO SHARP OR ABRASIVE SURFACES UNDER LAVATORIES.

DRAWING INDEX

#	SHEET NAME	#	DATE	REVISION
ARCHITECTURAL				
A00.00	COVER SHEET	2	10/14/24	RTAP NO. 1
A00.01	DRAWING INDEX, GENERAL NOTES AND MOUNTING DIAGRAMS	1	05/8/24	PERMIT REVIEW COMMENTS
A00.02	ACCESSIBILITY REFERENCE DETAILS			
A00.03	APPENDIX B	1	05/8/24	PERMIT REVIEW COMMENTS
A00.04	LIFE SAFETY PLAN	2	10/14/24	RTAP NO. 1
A00.05	PARTITIONS, DOORS, & WINDOW TYPES	2	10/14/24	RTAP NO. 1
A00.07	UL PARTITION DETAILS			
A01.01	3D PLAN SECTION			
A01.02	EXTERIOR RENDERINGS			
A02.00	ARCHITECTURAL SITE PLAN			
A02.01	CONSTRUCTION PLAN	2	10/14/24	RTAP NO. 1
A02.02	SLAB PLAN			
A02.03	REFLECTED CEILING PLAN	2	10/14/24	RTAP NO. 1
A02.04	ENLARGED REFLECTED CEILING PLAN	2	10/14/24	RTAP NO. 1
A02.05	FINISH PLAN	2	10/14/24	RTAP NO. 1
A02.06	FURNITURE PLAN			
A02.07	ENLARGED PLANS & SECTIONS			
A02.08	ENLARGED PLANS & ELEVATIONS			
A03.01	EXTERIOR ELEVATIONS	2	10/14/24	RTAP NO. 1
A03.02	EXTERIOR ELEVATIONS	2	10/14/24	RTAP NO. 1
A04.10	WALL SECTIONS	1	05/8/24	PERMIT REVIEW COMMENTS
A04.11	WALL SECTIONS	1	05/8/24	PERMIT REVIEW COMMENTS
A04.20	INTERIOR ELEVATIONS			
A04.21	INTERIOR ELEVATIONS			
A04.22	INTERIOR ELEVATIONS			
A04.23	INTERIOR ELEVATIONS			
A05.01	EXTERIOR VIEWS			
A05.02	INTERIOR VIEWS			
A05.03	INTERIOR VIEWS			
A05.04	INTERIOR VIEWS			
A05.10	MILLWORK DETAILS			
A06.01	PLAN DETAILS	1	05/8/24	PERMIT REVIEW COMMENTS
A06.10	SECTION DETAILS			
A06.11	SECTION DETAILS	2	10/14/24	RTAP NO. 1
A06.20	SECTION DETAILS	2	10/14/24	RTAP NO. 1
CIVIL				
1	COVER SHEET			
2	EXISTING CONDITION			
3	OVERALL SITE LAYOUT PLAN			
4	INITIAL EROSION AND SED. CONTROL PLAN			
5	INTERMEDIATE GEO. AND SED. CONTROL PLAN			
6	FINAL EROSION AND SED. CONTROL PLAN			
7	SEDIMENT AND EROSION CONTROL NARRATIVE			
8	NV601 GROUND STABILIZATION AND MATERIALS HANDLING			
9	NC601 SEFL INSPECTION RECORDKEEPING AND REPORTING			
10	GRAVING AND DRAINAGE PLAN			
11	WATER LINE PLAN AND PROFILE			
12	WATER LINE DETAILS			
13	LANDSCAPE PLAN			
D1	SWALE DRAINAGE MAP			
ELECTRICAL				
E00.01	GENERAL NOTES, RISER DIAGRAM & ABBREVIATIONS - ELECTRICAL	1	4/22/24	PERMIT REVISION
E00.02	SPECIFICATIONS - ELECTRICAL			
E00.03	DETAILS - ELECTRICAL			
E00.04	SCHEDULES & DIAGRAMS - ELECTRICAL	2	5/3/24	PERMIT REVISION
E01.01	FLOOR PLAN - LIGHTING	1	4/24/24	PERMIT REVISION
E02.01	FLOOR PLAN - POWER	1	4/24/24	PERMIT REVISION
E03.01	FLOOR PLAN - SYSTEMS	2	5/3/24	PERMIT REVISION
MECHANICAL				
M00.01	NOTES & ABBREVIATIONS - HVAC			
M00.02	SPECIFICATIONS - HVAC			
M01.01	FLOOR PLAN - HVAC	1	5/3/24	PERMIT REVISION
M06.01	SCHEDULES - HVAC			
M07.01	DETAILS - HVAC			
M07.02	DETAILS - HVAC	1	5/3/24	PERMIT REVISION
PLUMBING				
P00.01	NOTES & ABBREVIATIONS - PLUMBING			
P01.01	FLOOR PLAN - PLUMBING			
P04.01	ENLARGED PLANS - PLUMBING			
P07.01	DETAILS - PLUMBING			
STRUCTURAL				
S001	NOTES - STRUCTURAL			
S100	FOUNDATION PLAN			
S101	FRAMING AND STAGE PLAN			
S401	SECTIONS			
S402	SECTION			



Ossa Studio

4539 HEDGEWOOD DRIVE, SUITE 101
CHARLOTTE NC 28209
704.890.2853
WWW.OSSASTUDIO.COM




PROJECT TEAM

- General Contractor**
ECCLESIA CONSTRUCTION
www.ecclesiaincconstruction.com
919.327.5670
- Civil Engineering**
HILLIARD ENGINEERING, PLLC
www.hillardgrp.com
919.352.2834
- Structural Engineering**
PROVIDENCE PARTNERS
www.providencepartnersinc.com
704.266.6621
- Mechanical, Electrical, Plumbing & Fire Protection**
ENGINEERING
www.engineering.com
704.287.2193

Date	Description
10/30/24	FOR CONSTRUCTION
1 05/8/24	PERMIT REVIEW COMMENTS

Project Name

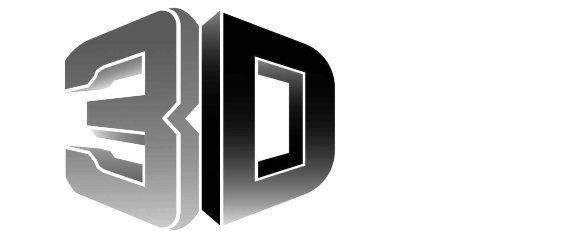

community church
making church come alive
658 GRAHAM ROAD
SANFORD NC 27311

Client

3D COMMUNITY CHURCH

Project Number

23024.00

Description

DRAWING INDEX, GENERAL NOTES AND MOUNTING DIAGRAMS



Scale

As indicated

A00.01


01 MOUNTING LOCATIONS

SCALE: 1/4" = 1'-0"

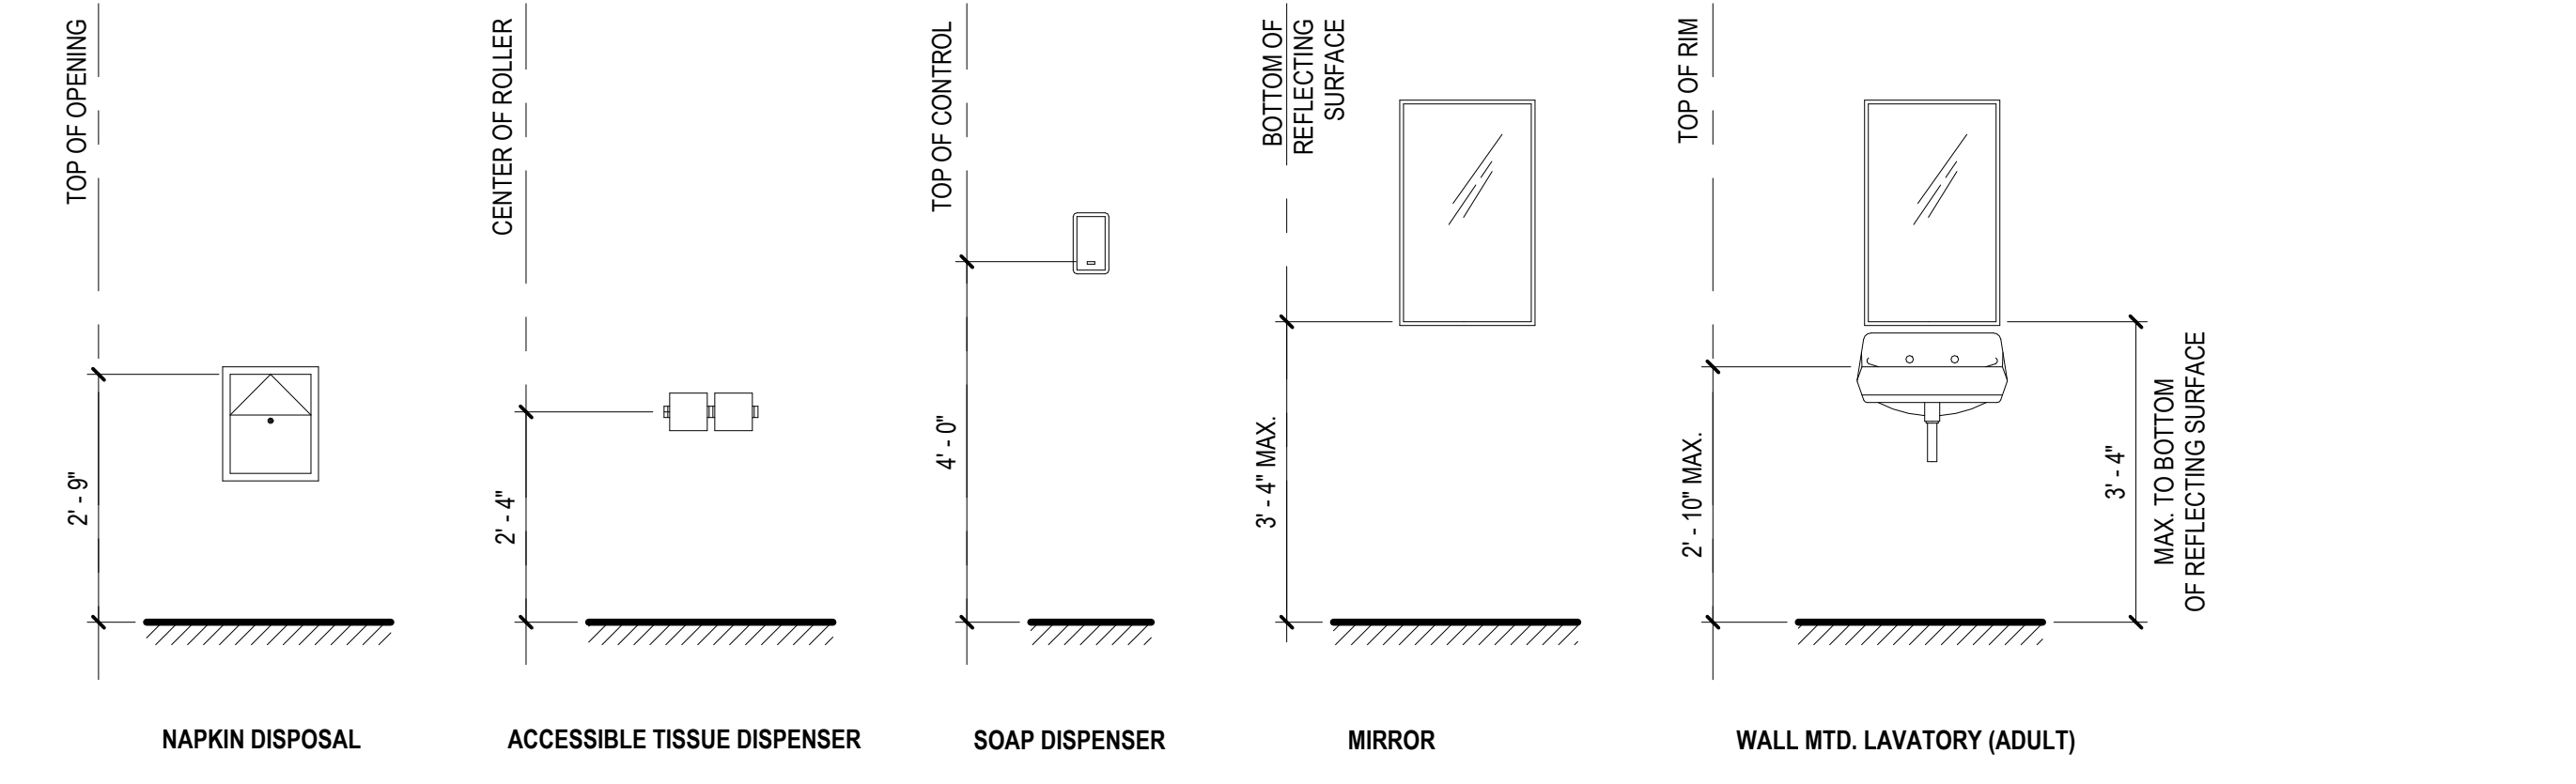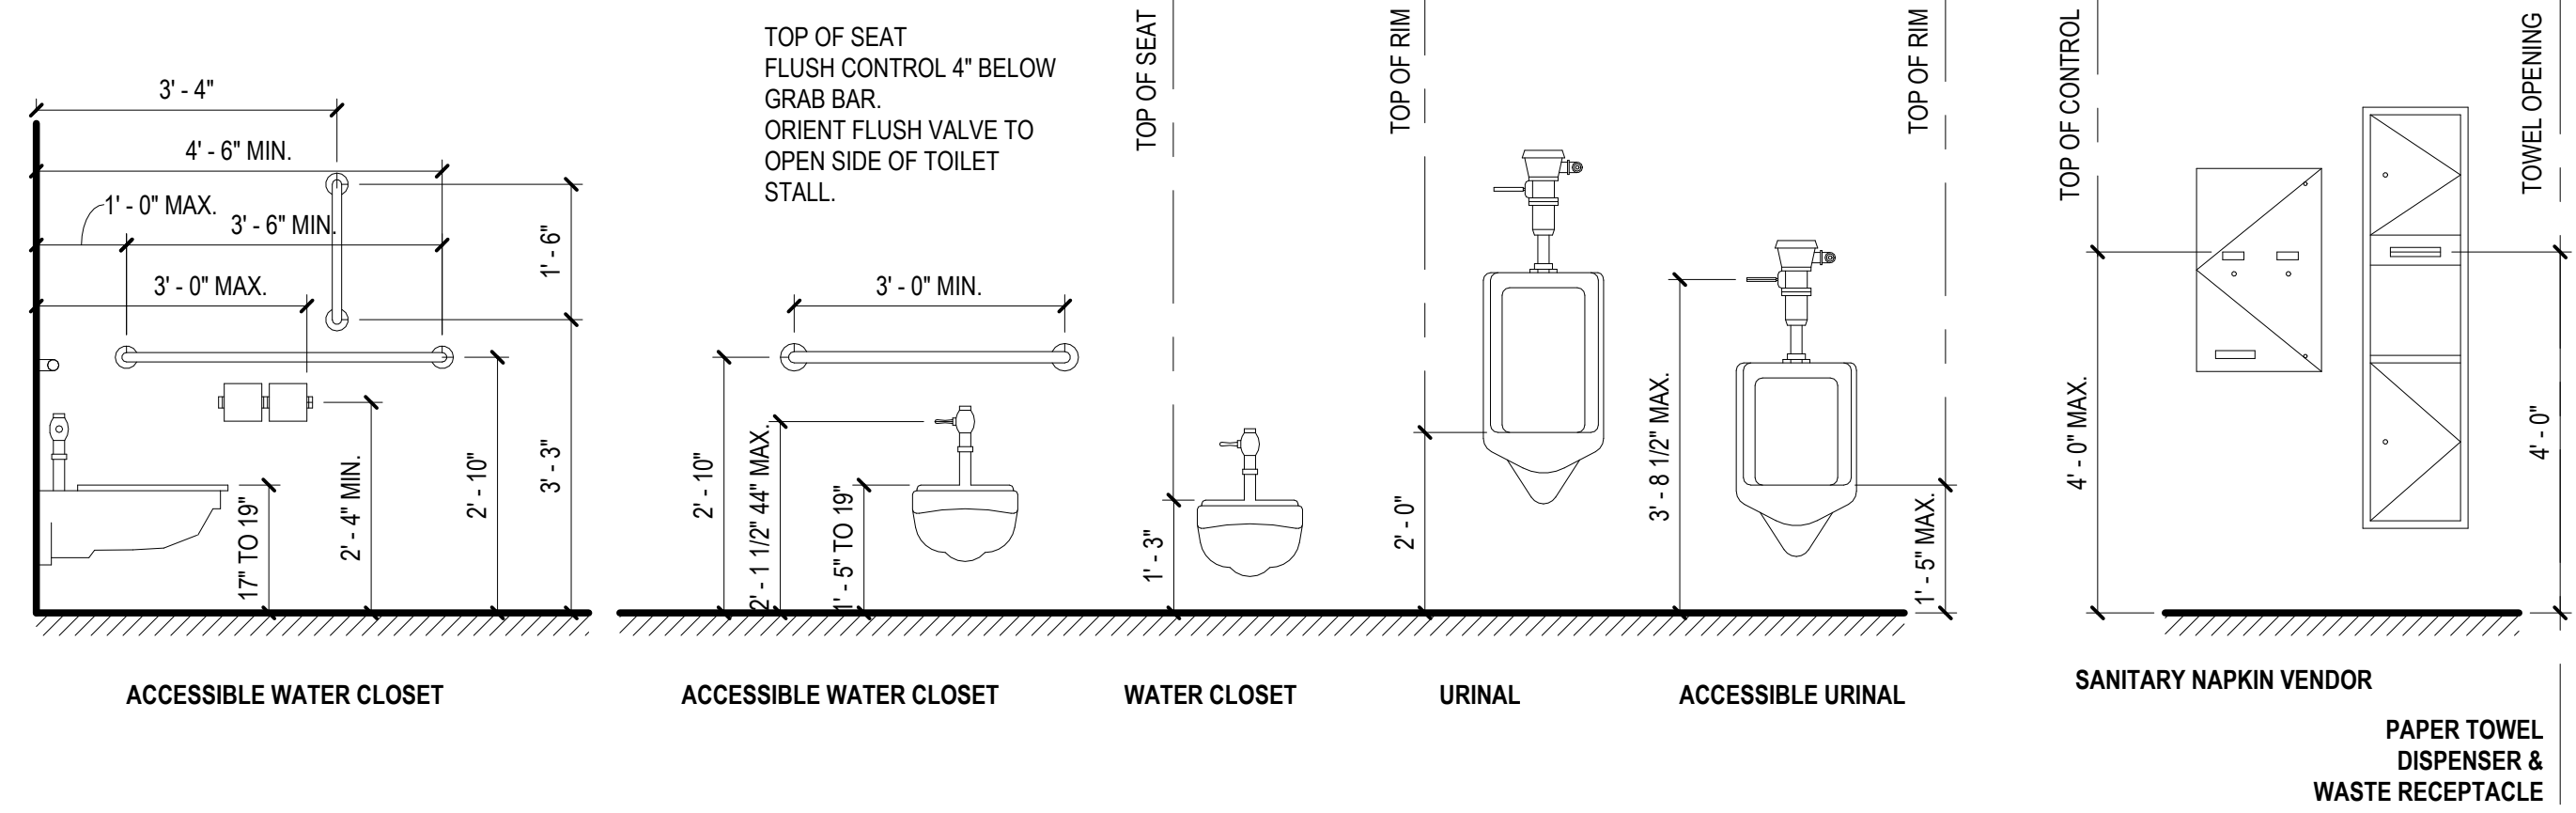


02 MOUNTING LOCATIONS - RESTROOM


SCALE: 1/2" = 1'-0"

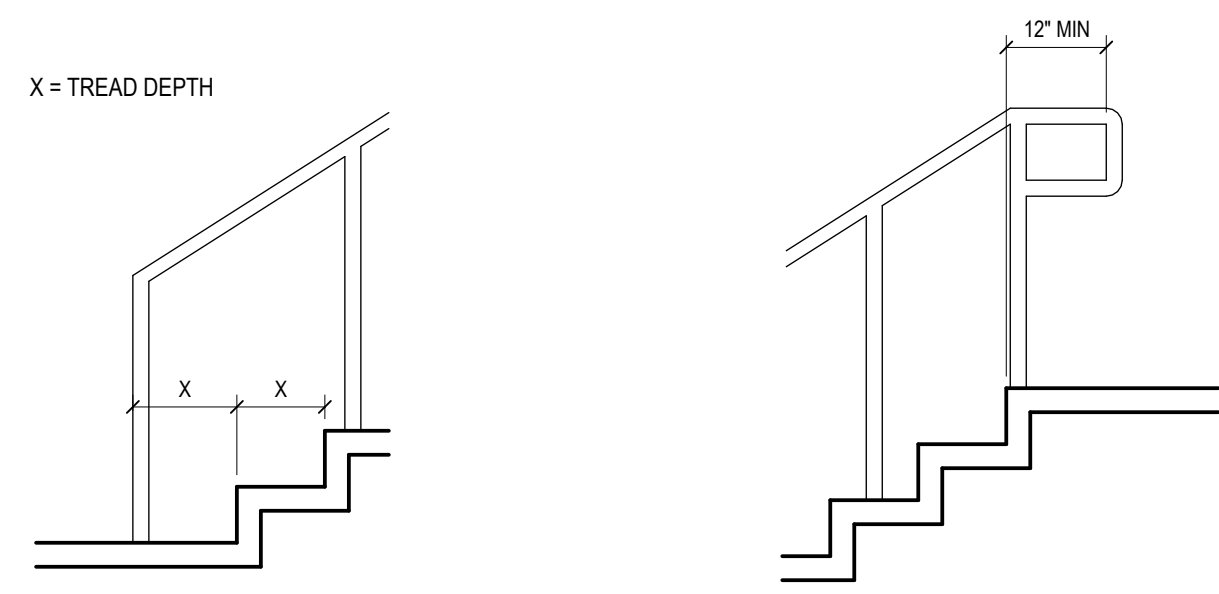


HANDRAIL EXTENSION AT STAIRS

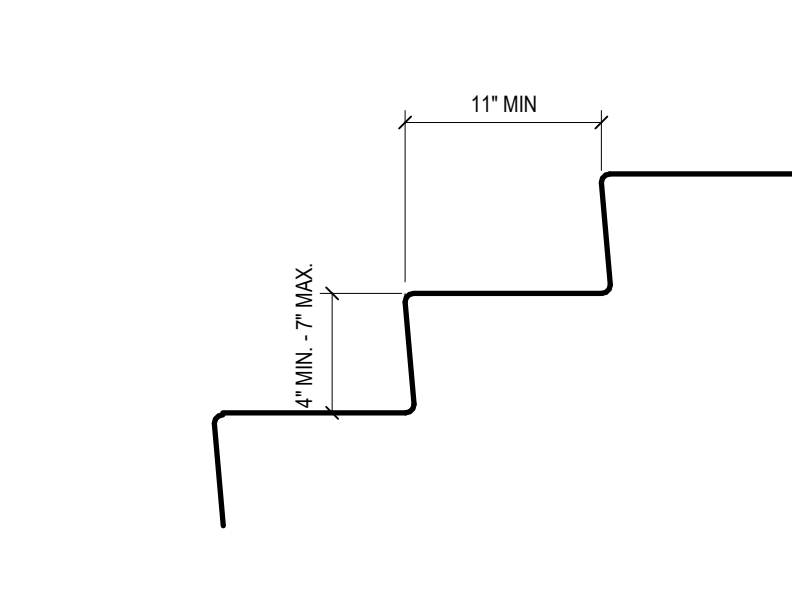


TREADS AND RISERS

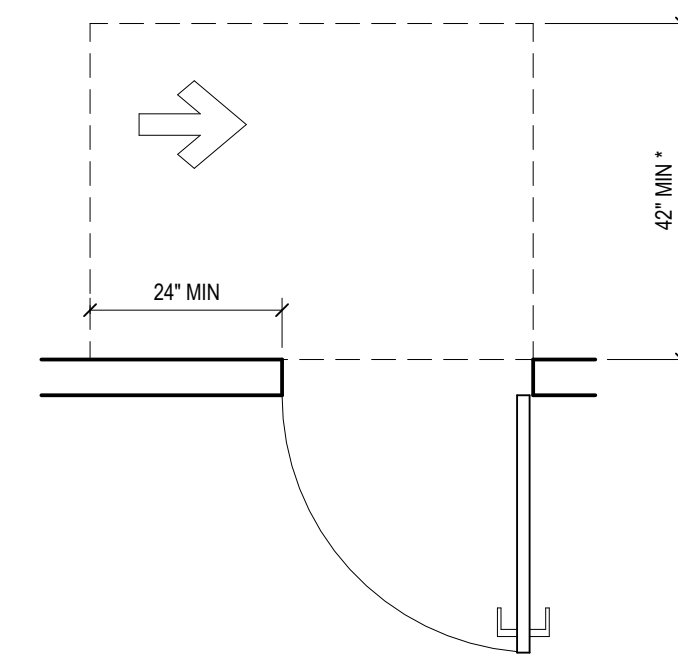

* 48" MIN IF CLOSER IS PROVIDED
(G) LATCH APPROACH, PUSH SIDE

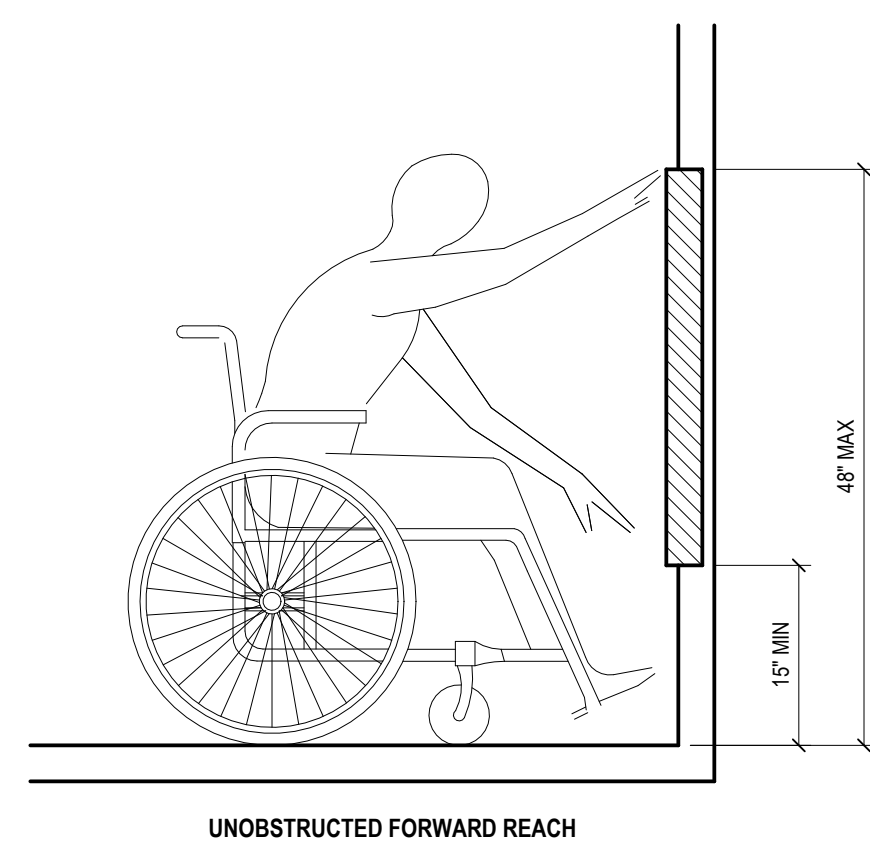


UNOBSTRUCTED FORWARD REACH

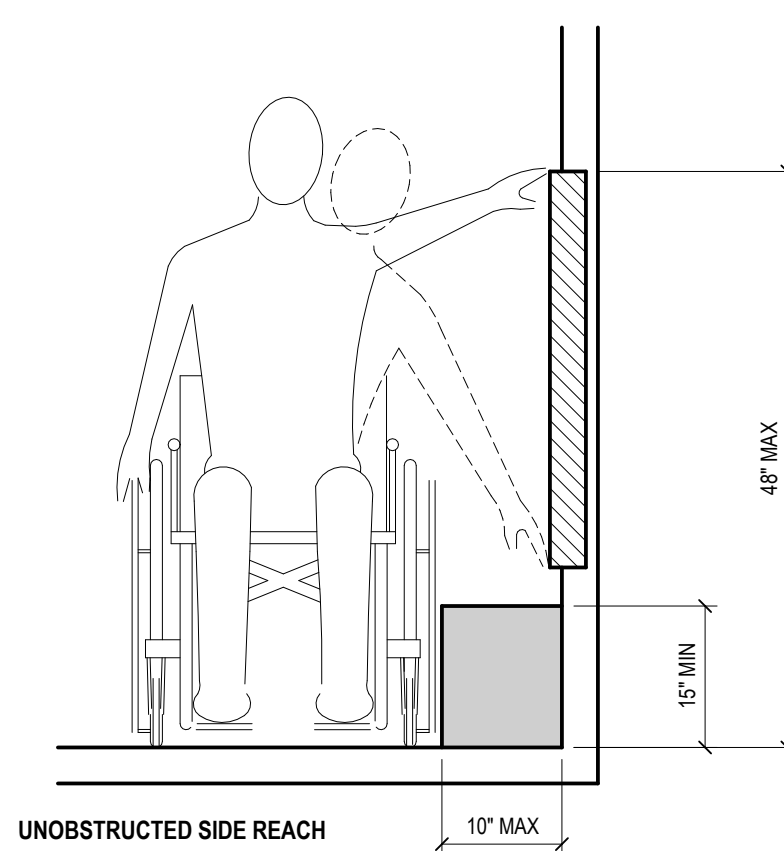


UNOBSTRUCTED SIDE REACH


ALL DIAGRAMS ON THIS SHEET ARE REFERENCED FROM:
ACCESSIBLE AND USABLE BUILDINGS AND FACILITIES
ICC A117.1-2009
ANSI - AMERICAN NATIONAL STANDARD

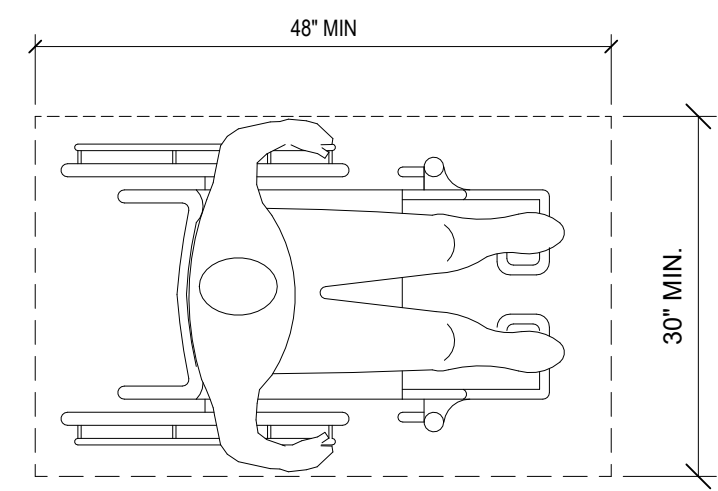

SIZE OF CLEAR FLOOR SPACE


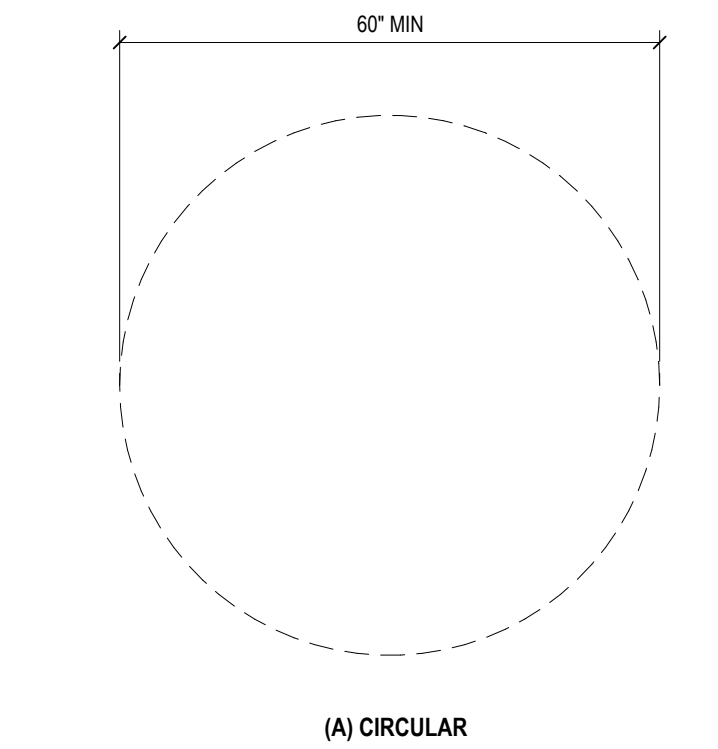


(A) CIRCULAR

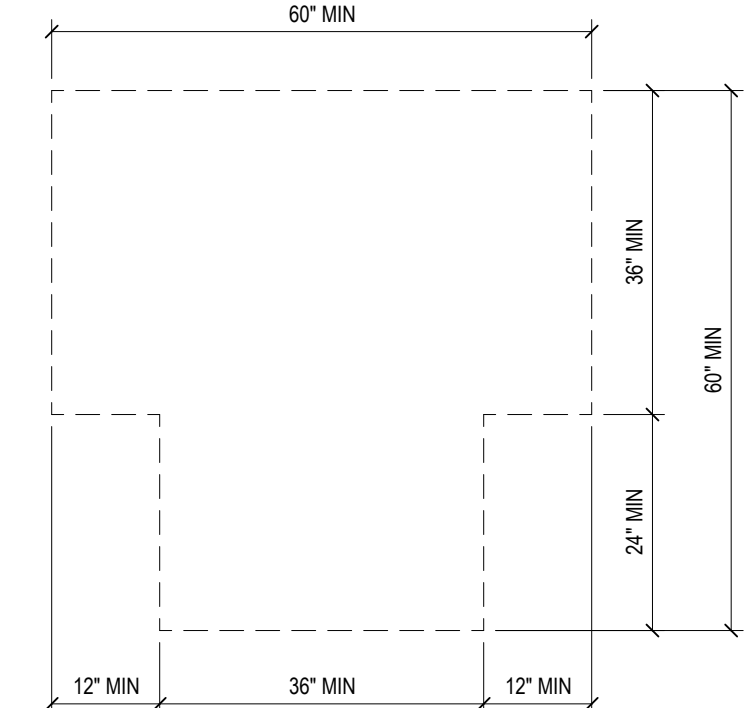


(B) T-SHAPED


TOP AND BOTTOM EXTENSION AT RAMPS

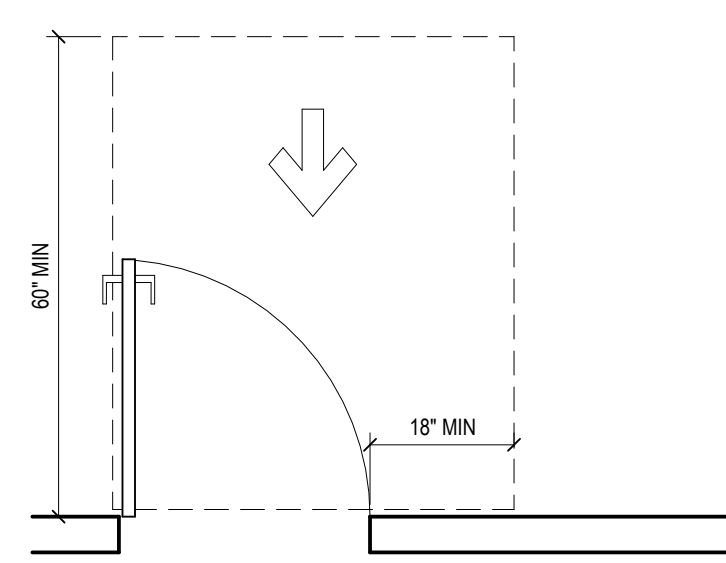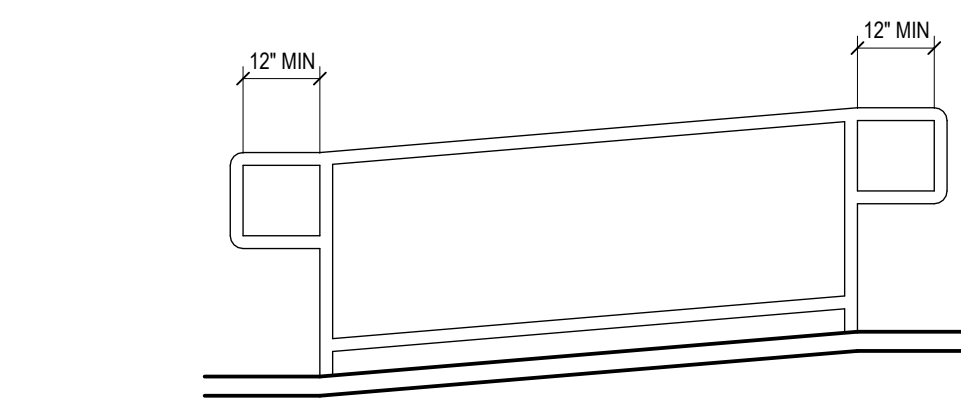


(A) FRONT APPROACH, PULL SIDE

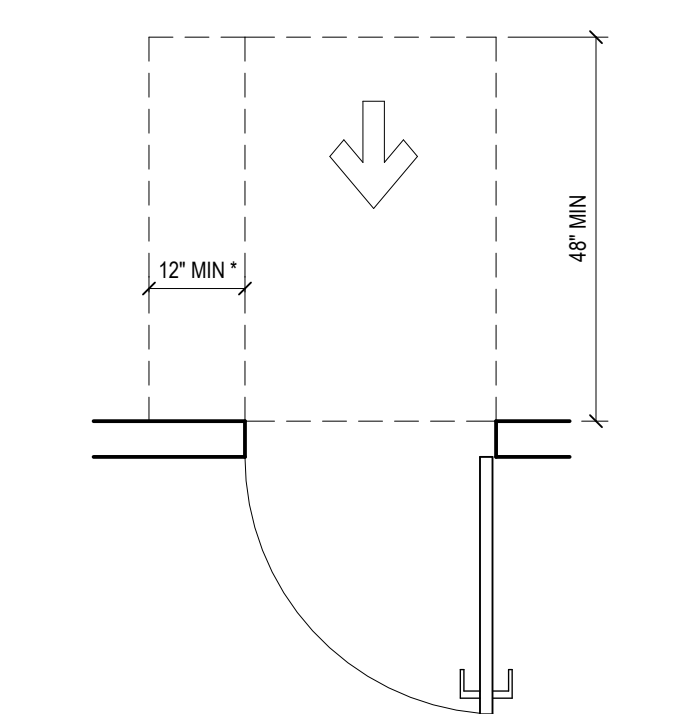


* IF BOTH CLOSER AND LATCH ARE PROVIDED
(B) FRONT APPROACH, PULL SIDE

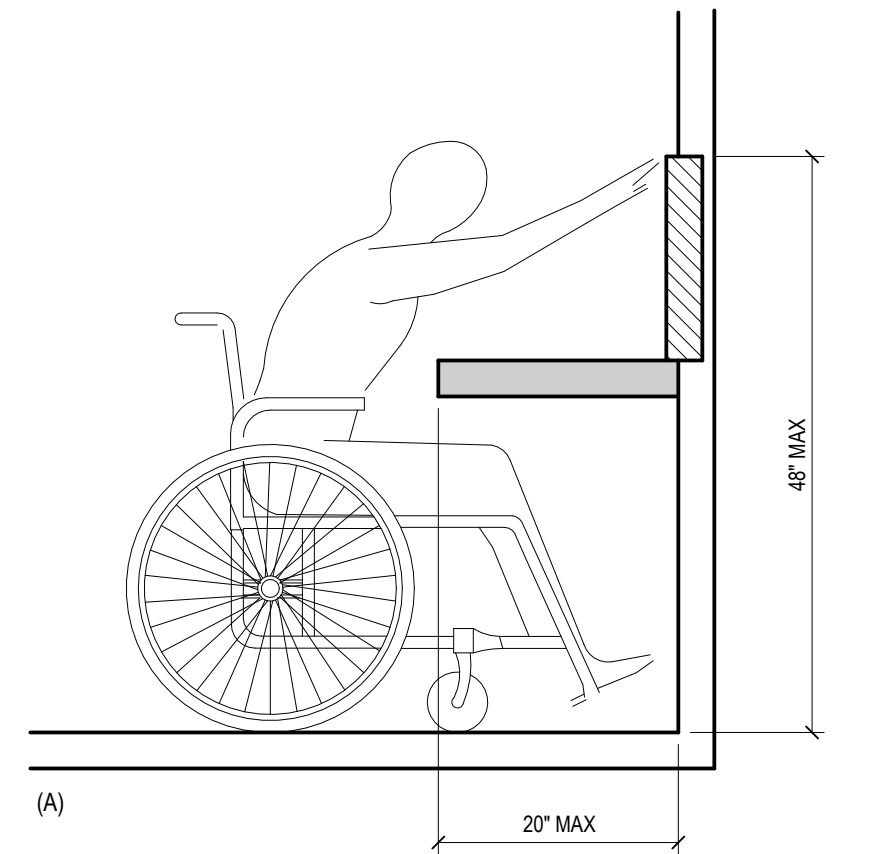


OBSTRUCTED HIGH FORWARD REACH

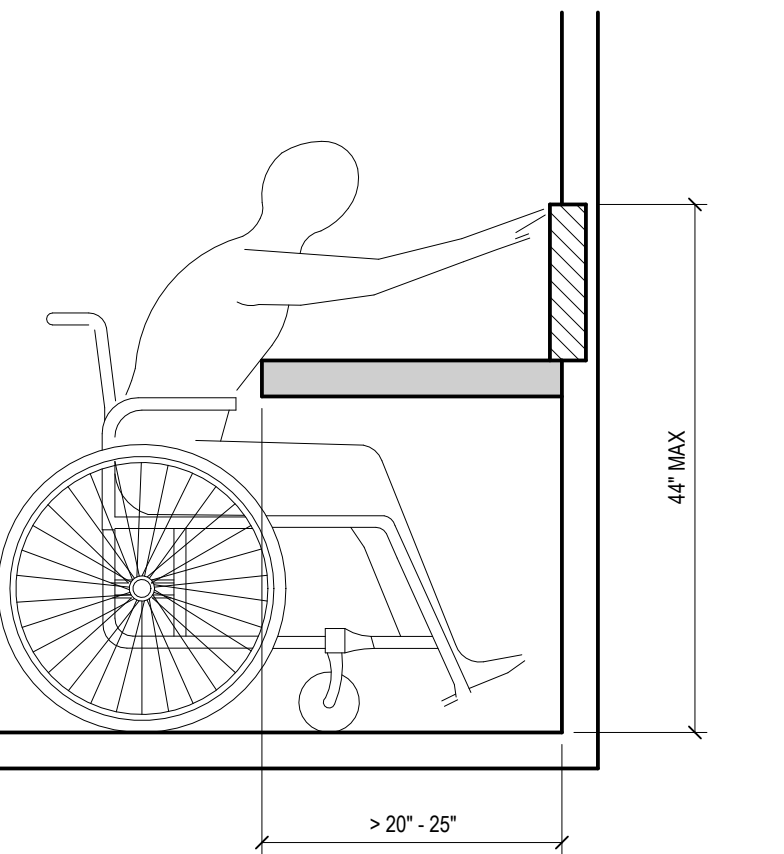

(B)

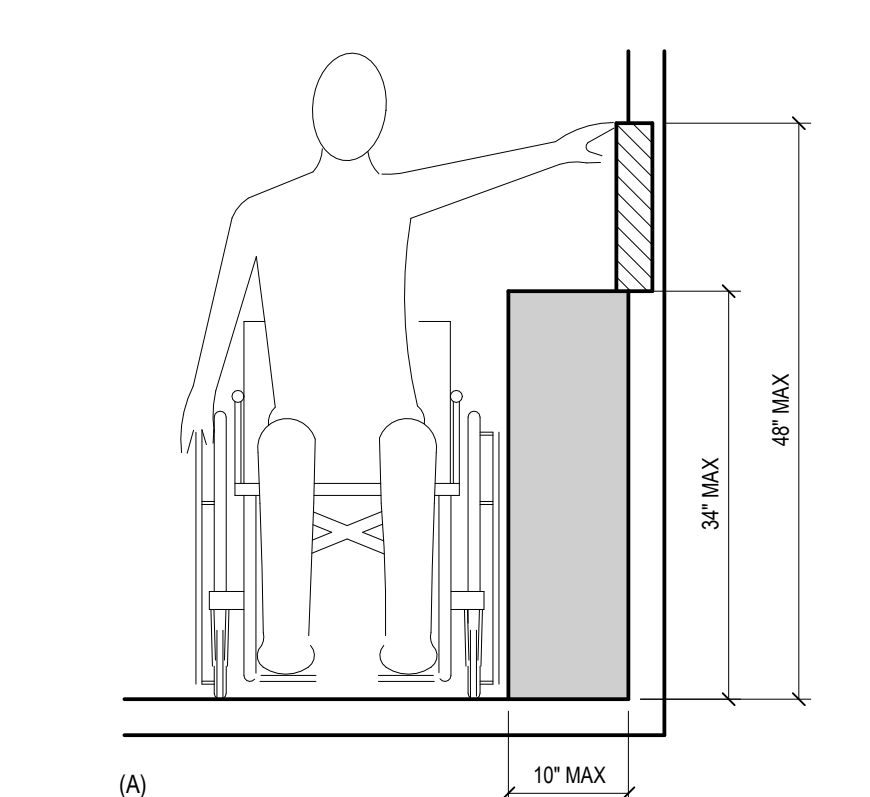


OBSTRUCTED HIGH SIDE REACH

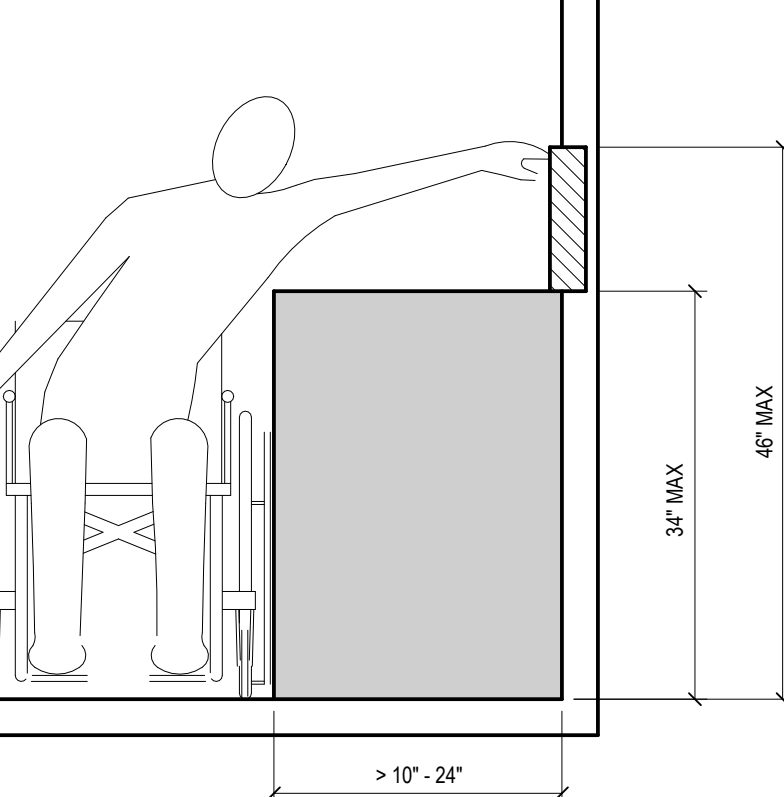


(B)


HANDRAIL HEIGHT

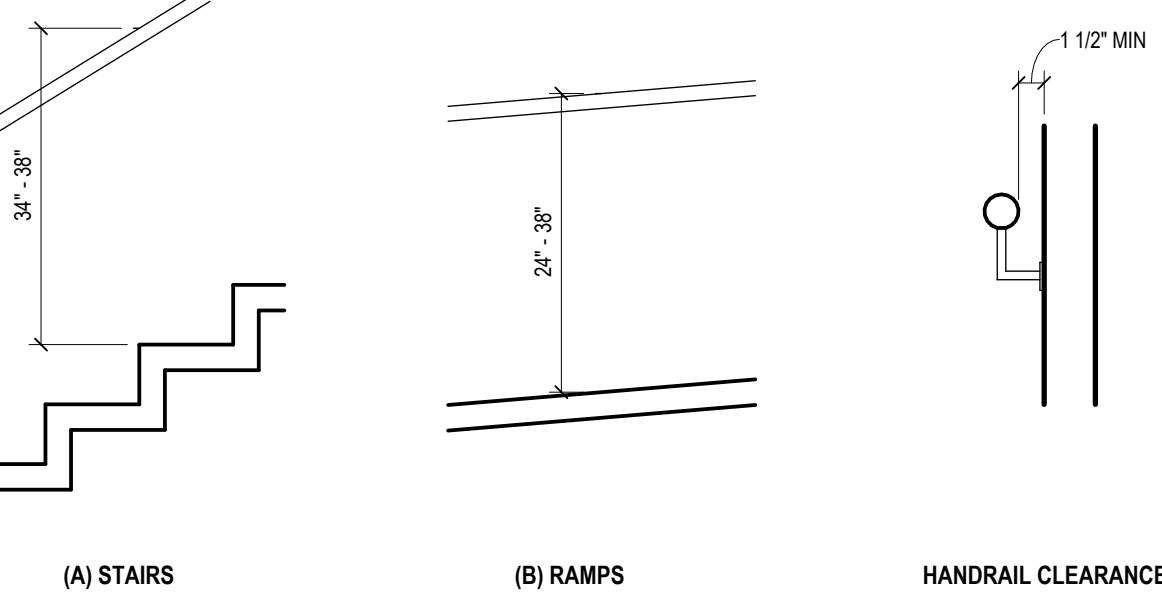


(A) STAIRS (B) RAMPS HANDRAIL CLEARANCE

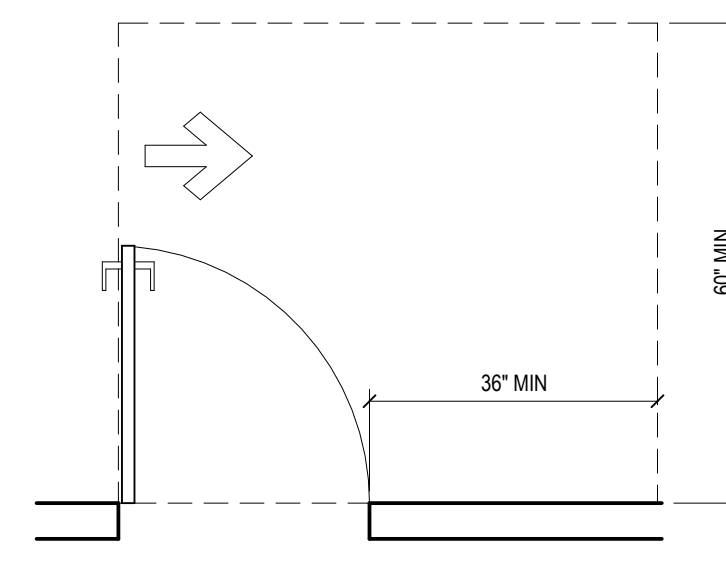


(C) HINGE APPROACH, PULL SIDE

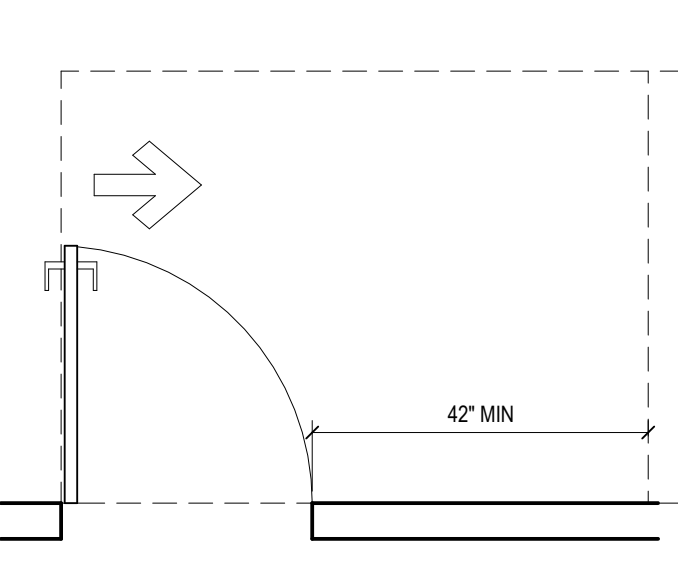

(D) HINGE APPROACH, PULL SIDE

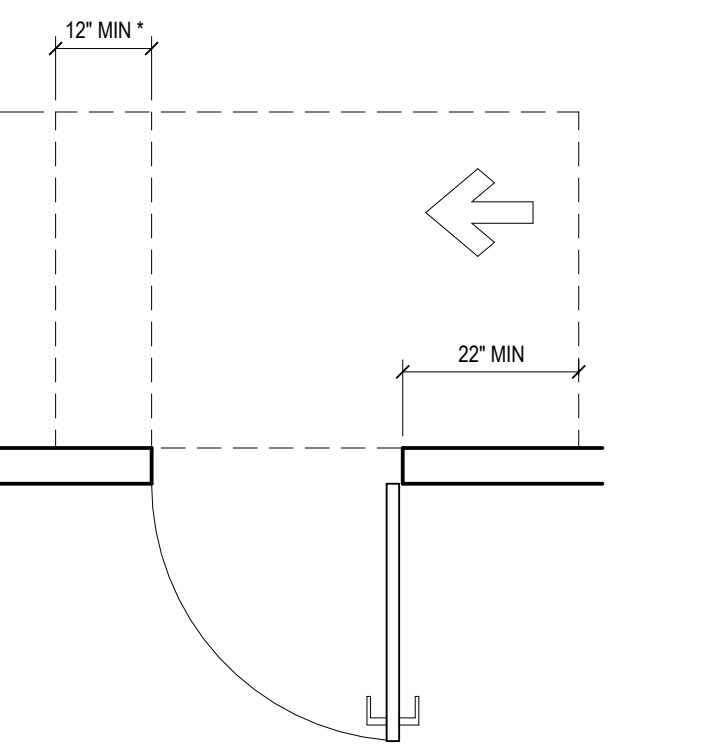


* IF BOTH CLOSER AND LATCH ARE PROVIDED
** 48" MIN IF BOTH CLOSER AND LATCH PROVIDED
(E) HINGE APPROACH, PUSH SIDE

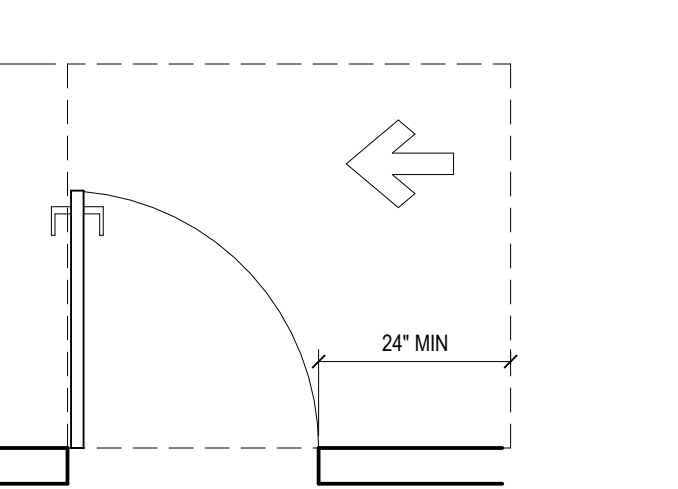


* 54" MIN IF CLOSER IS PROVIDED
(F) LATCH APPROACH, PULL SIDE


REACH RANGES

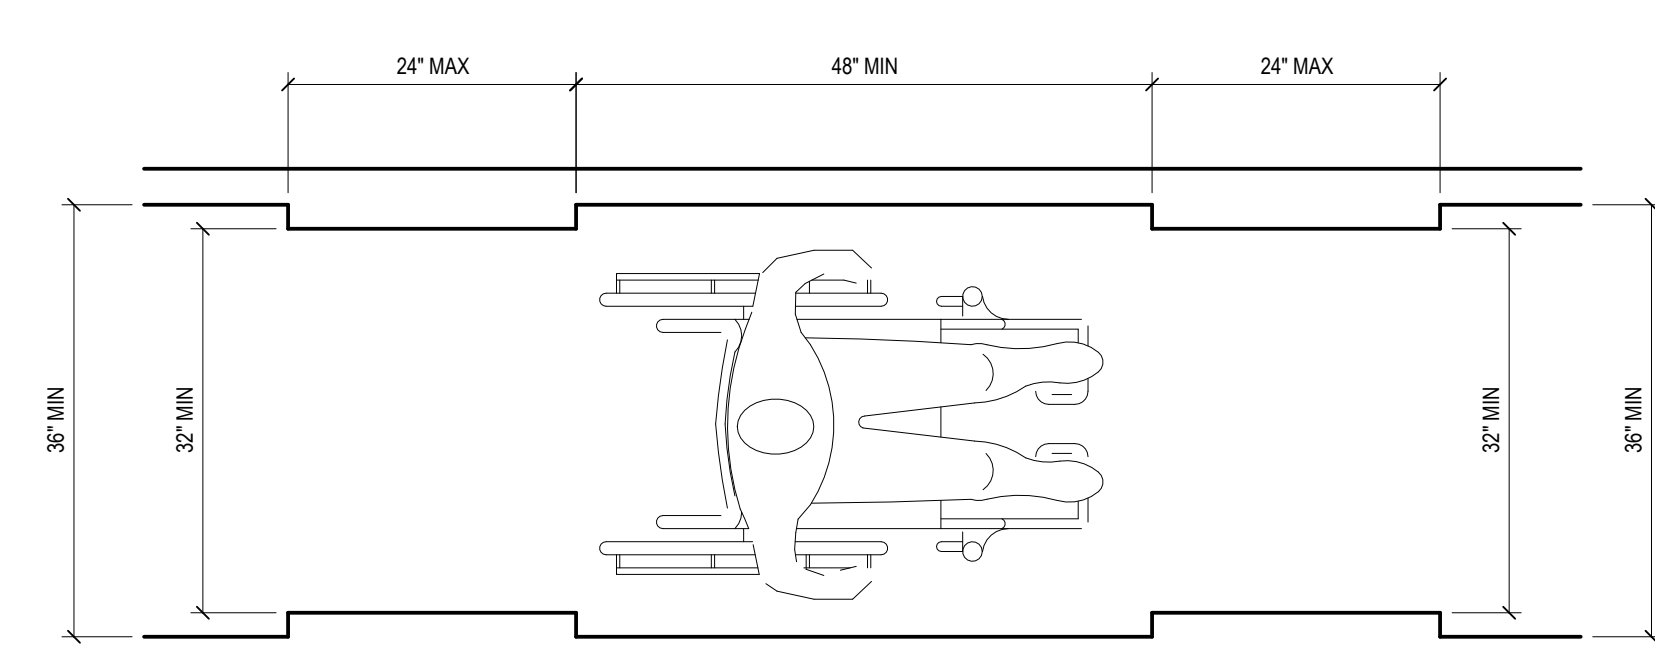


TURNING SPACE

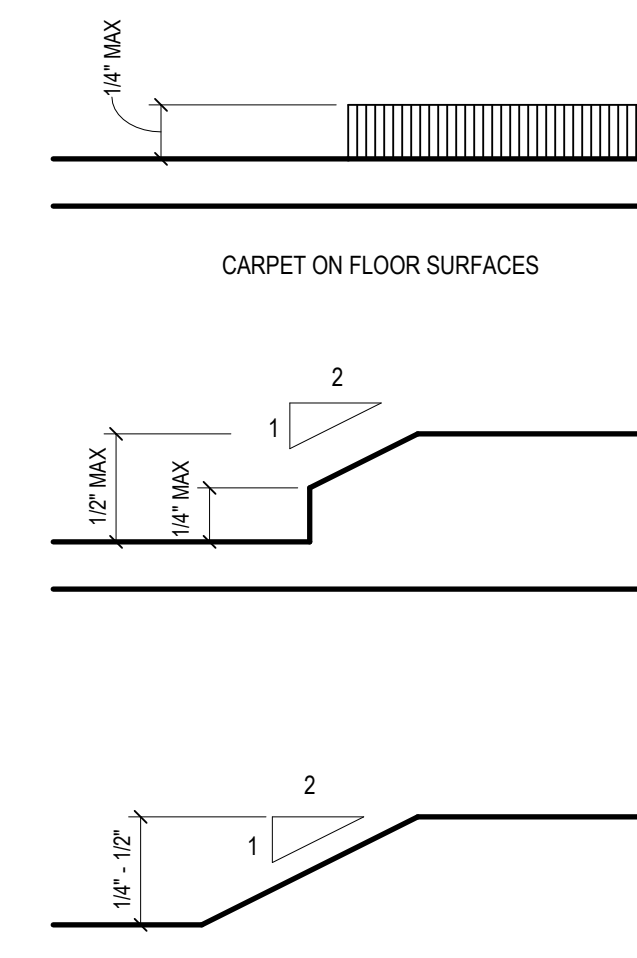


CLEARANCE FOR WATER CLOSET

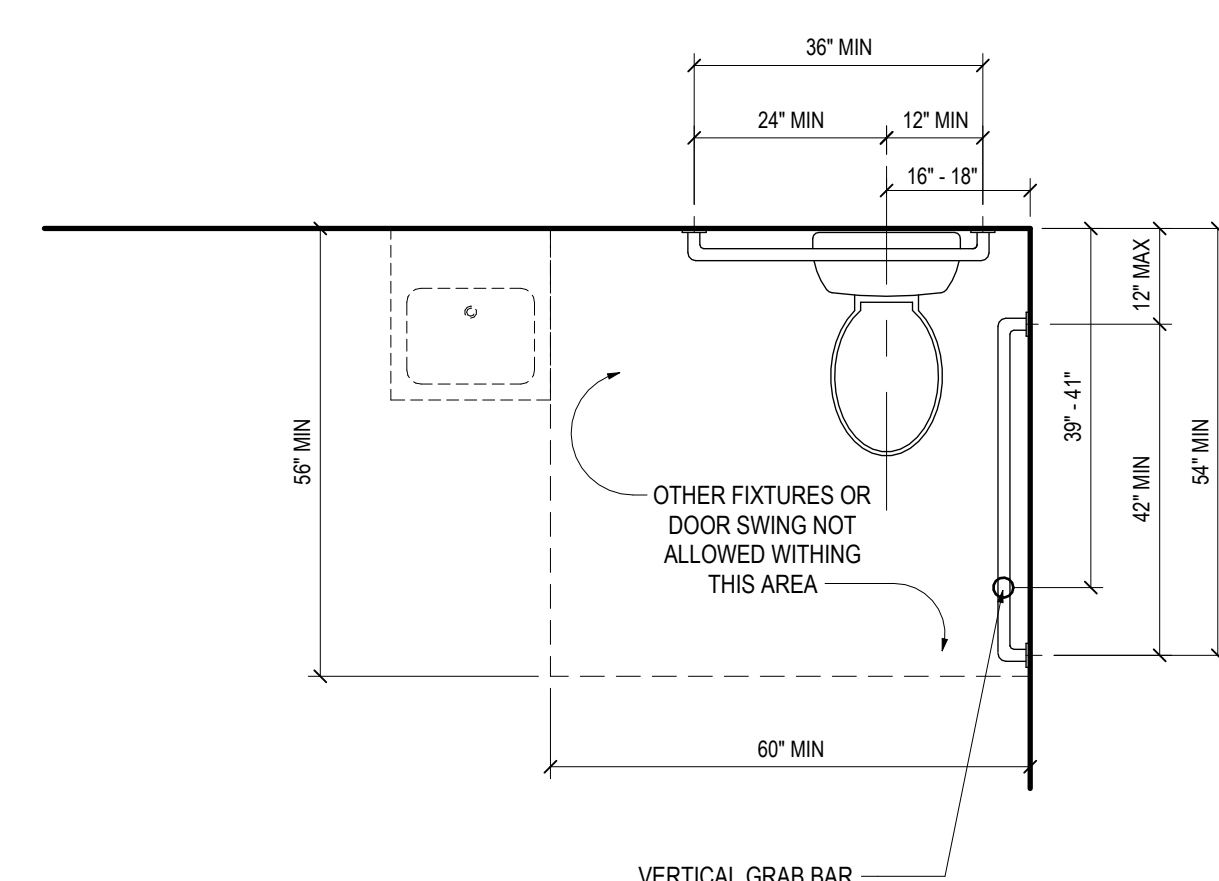


MANEUVERING CLEARANCE MANUAL SWINGING DOORS

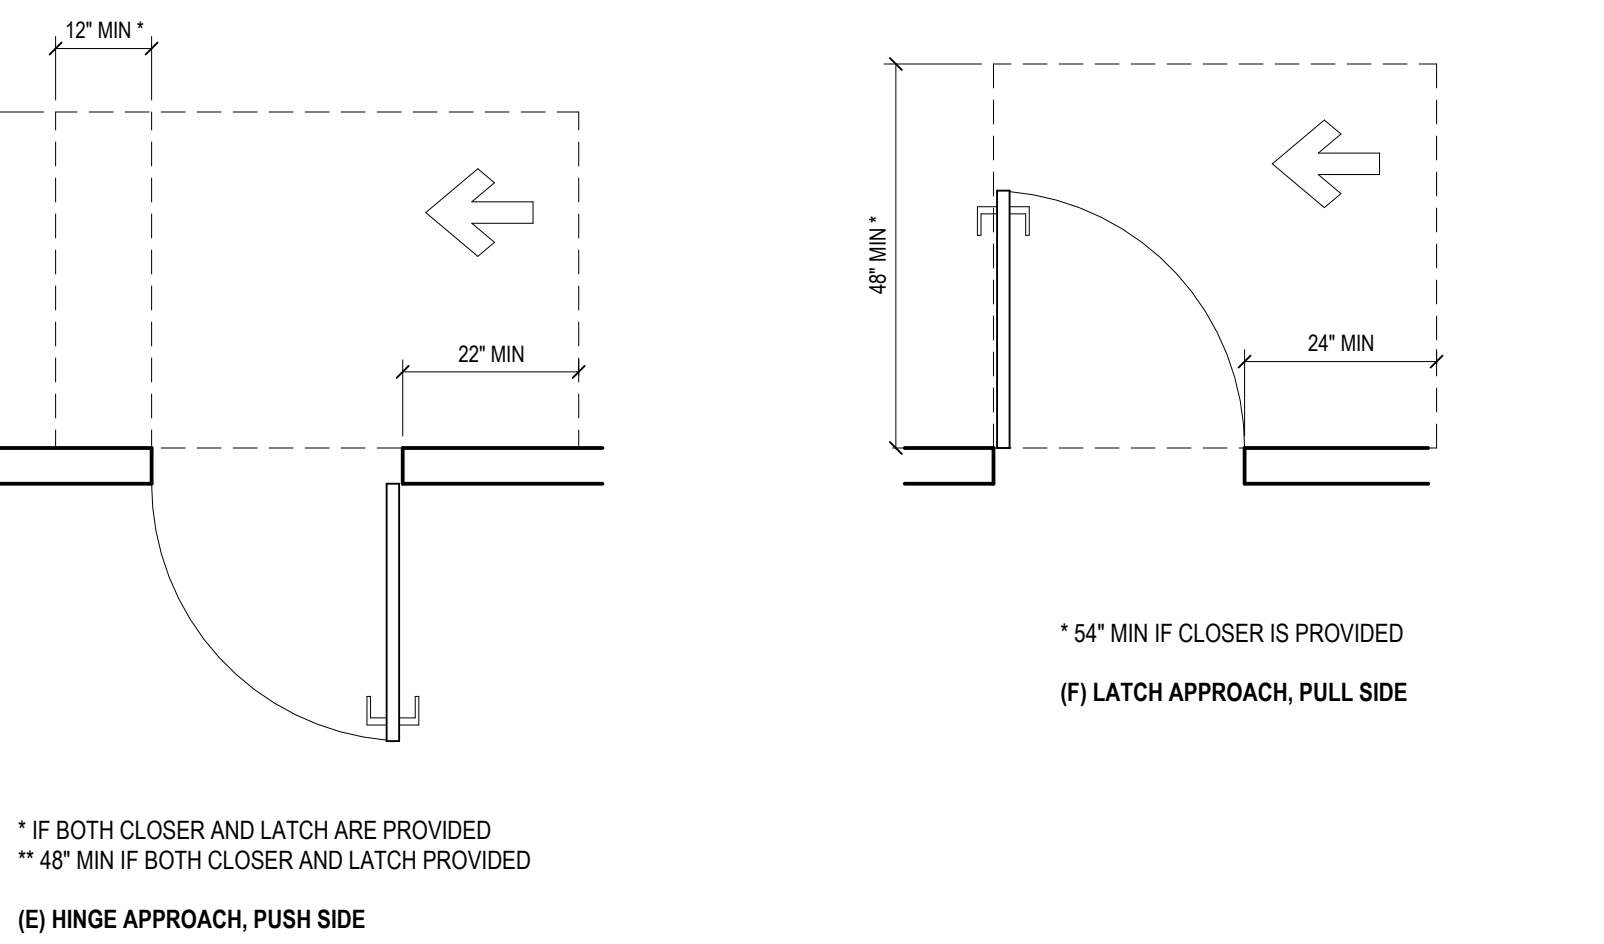

CLEAR WIDTH OF AN ACCESSIBLE ROUTE

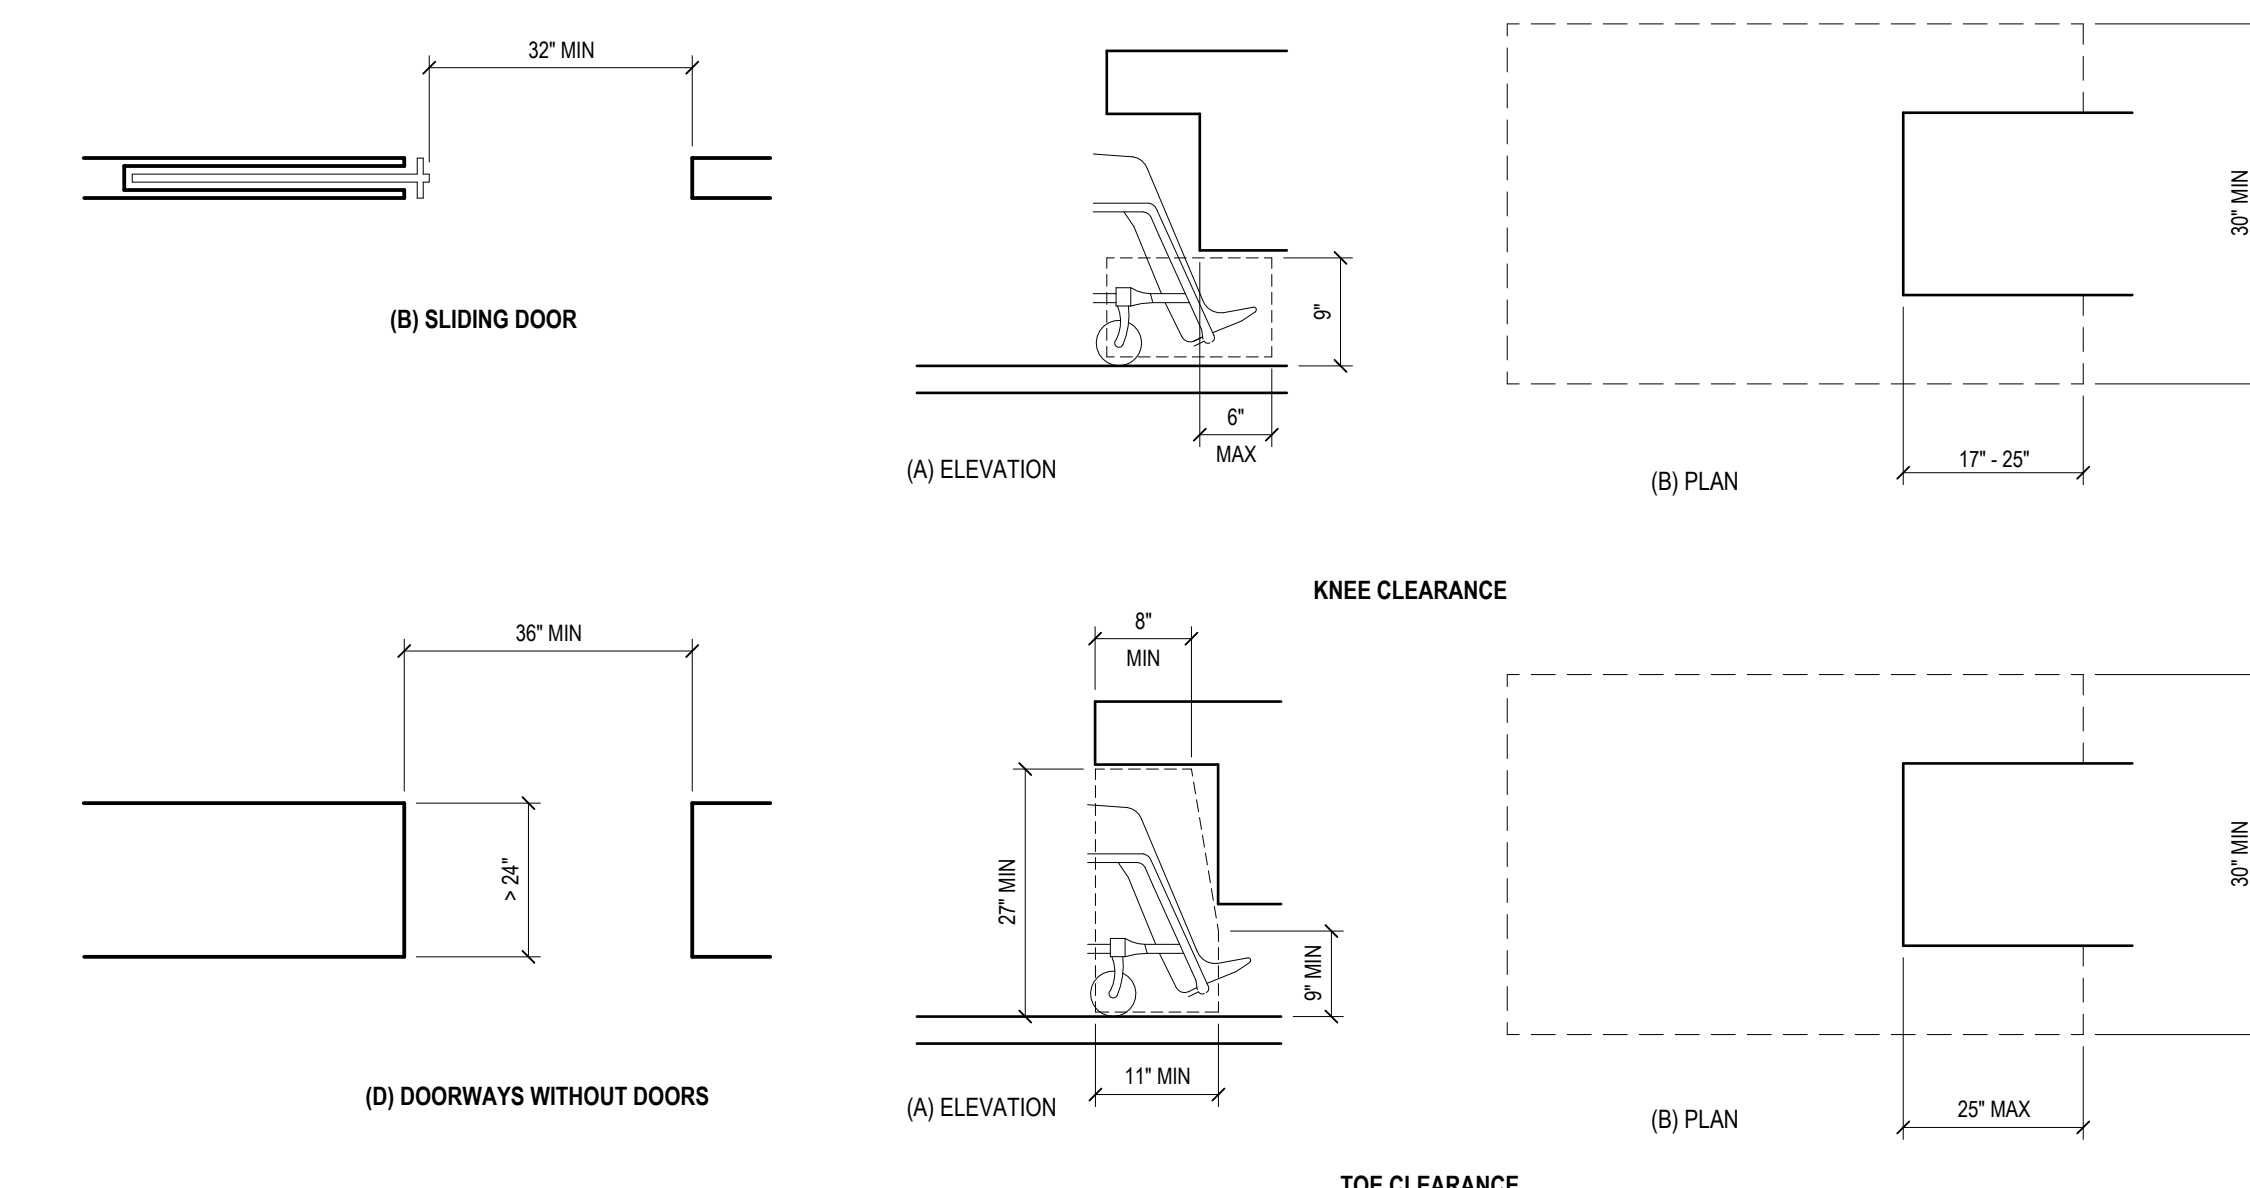


CHANGES IN LEVEL

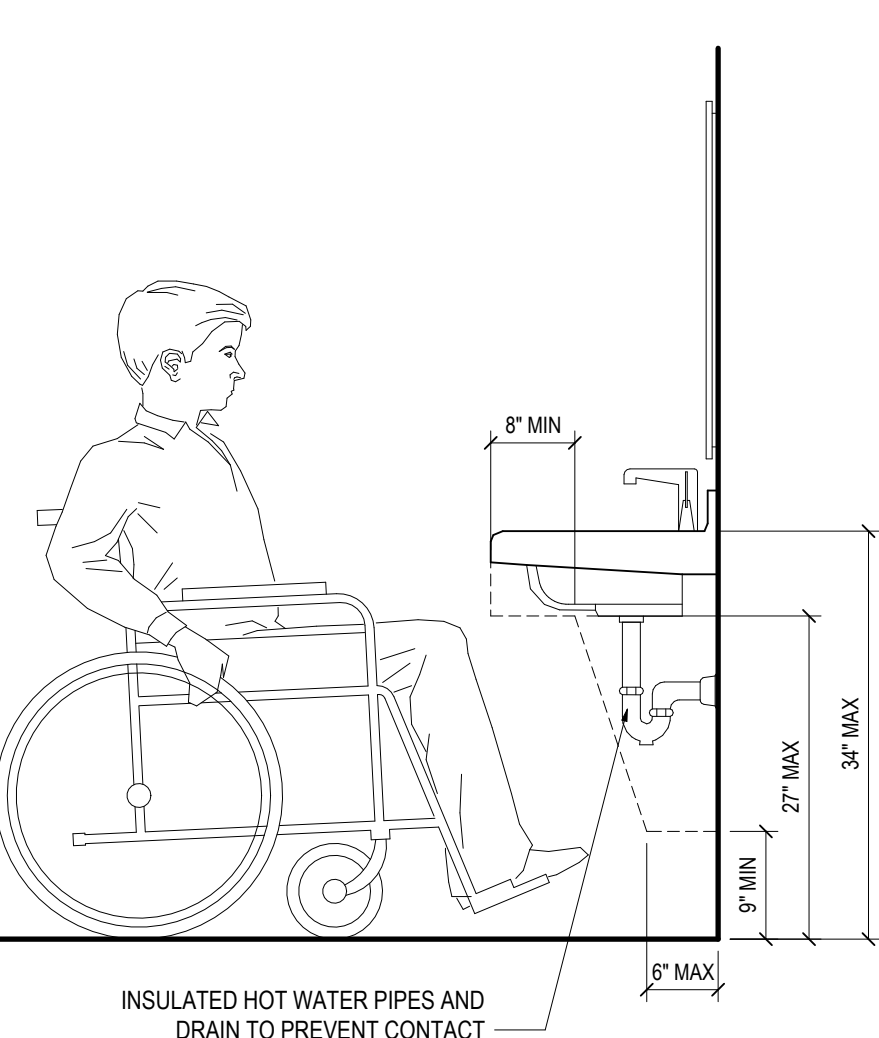


PROVIDE SIGNAGE IN ACCORDANCE WITH 2018
NCBC SECTION 1111, SECTION 2902.4 AND ICC
A117.1 - 2009, SECTION 703.






UNISEX RESTROOM

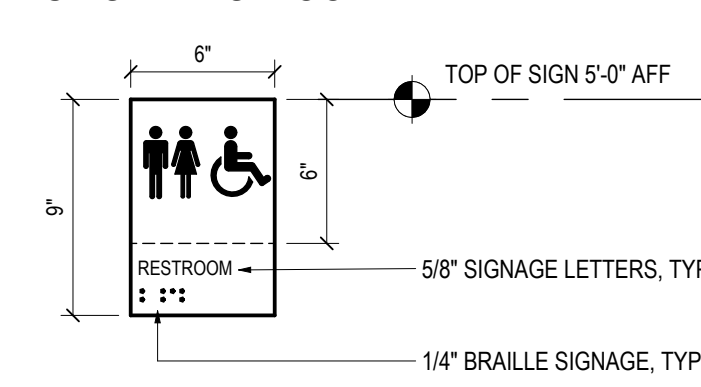

MEN RESTROOM

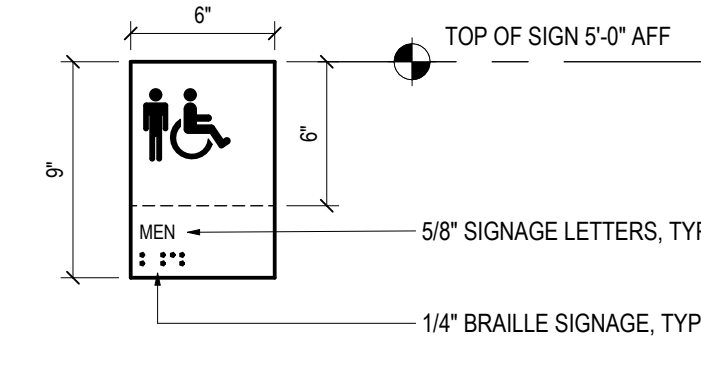

WOMEN RESTROOM

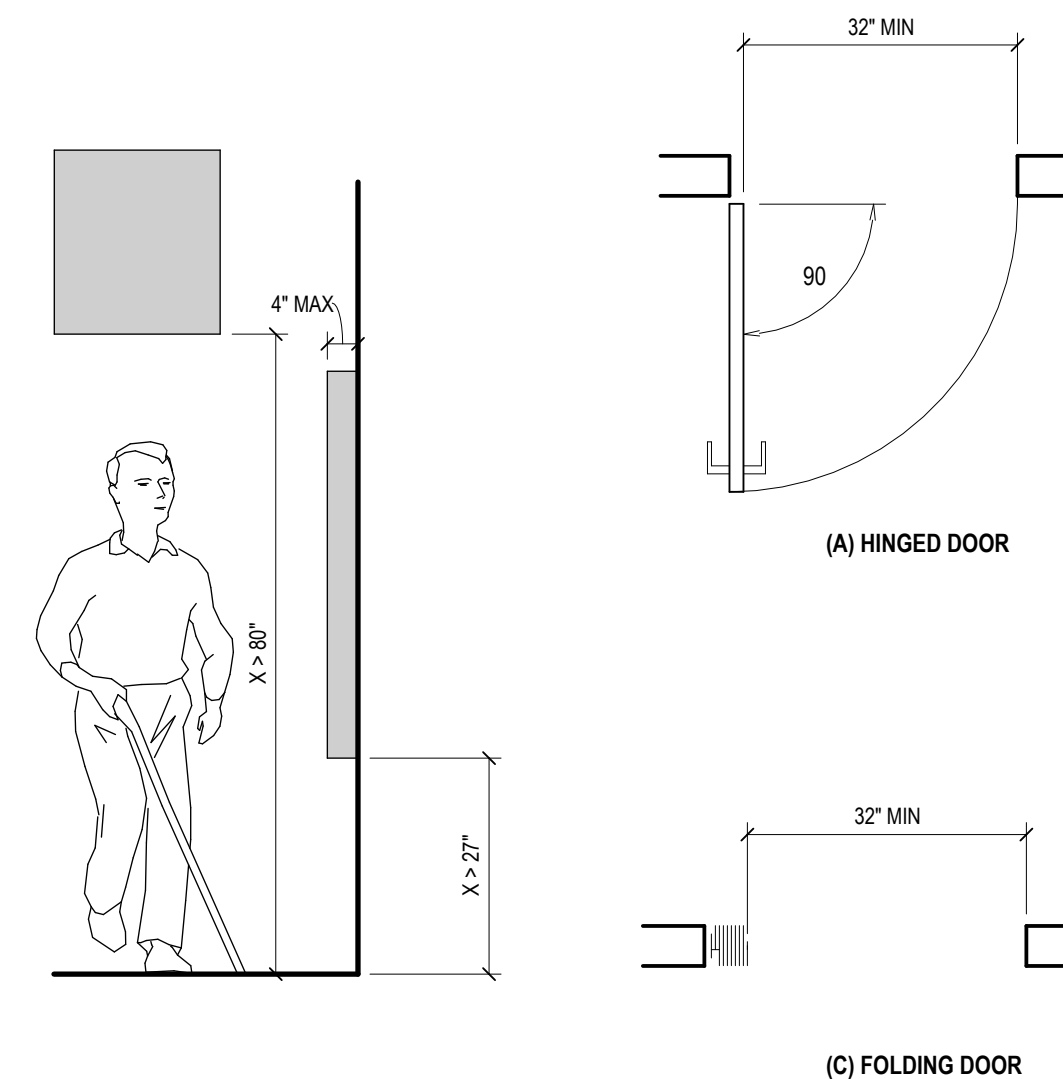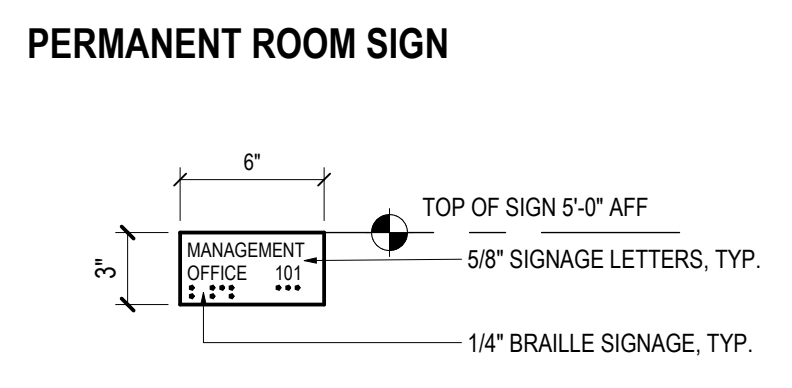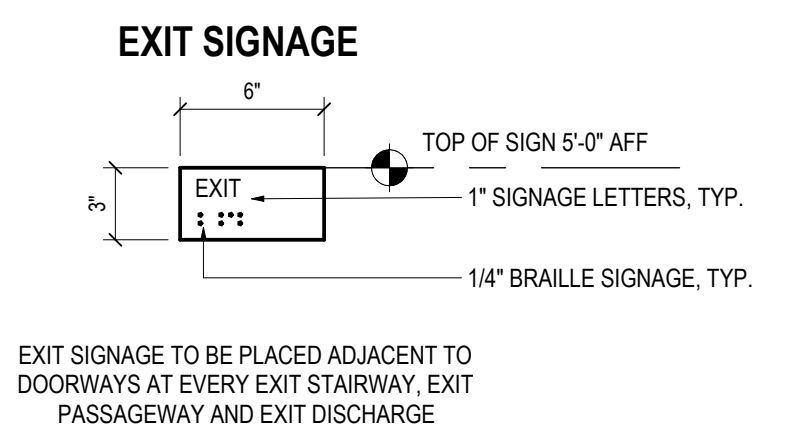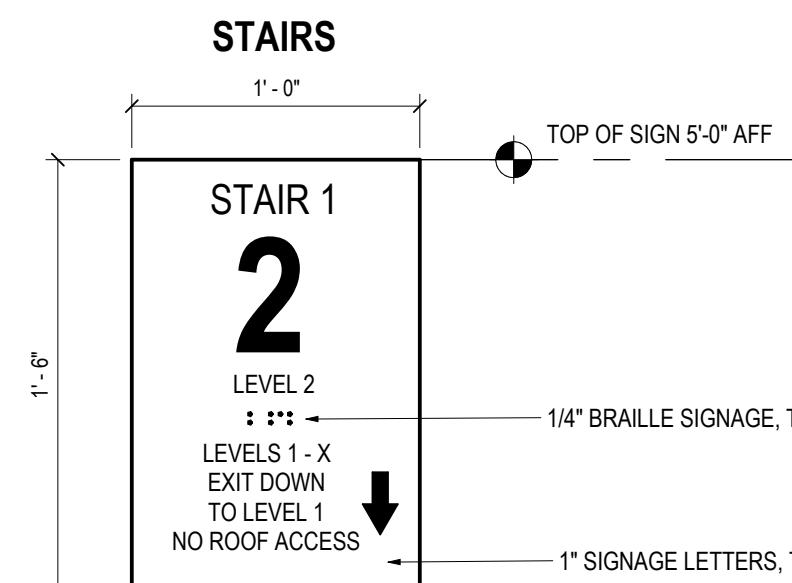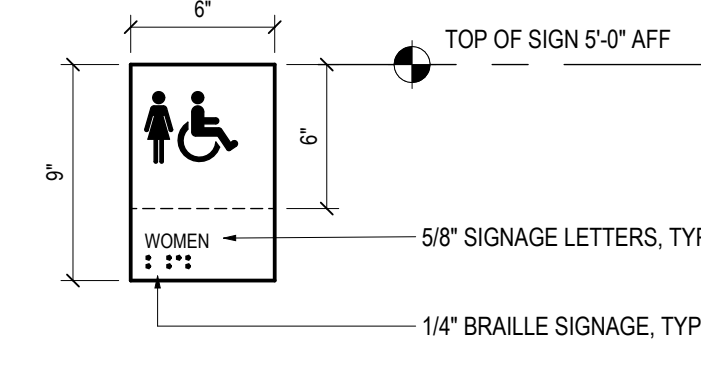

PROTRUDING OBJECTS CLEAR WIDTH OF DOORWAYS


KNEE AND TOE CLEARANCE

LAVATORIES AND SINKS

10/14/2024 5:05:38 PM C:\Private\mawm\Bent\Local\23024_00_3D\Community Church_andrew.mcdellan\FCLC.rvt



4539 HEDGEMORE DRIVE, SUITE 101
CHARLOTTE NC 28209
704.890.2553
WWW.OSSASTUDIO.COM

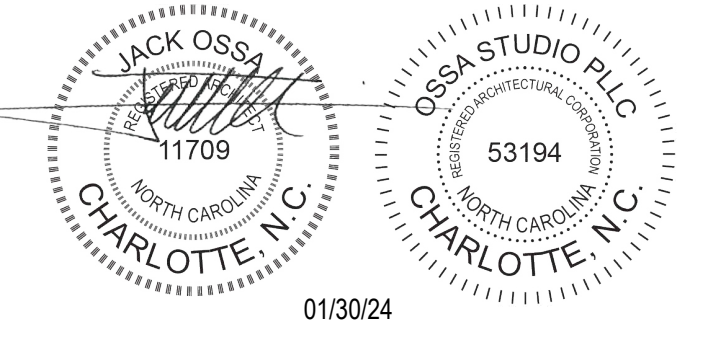

PROJECT TEAM
General Contractor
ECCLESIA CONSTRUCTION
www.ecclesiainc.com
803.327.5670
Civil Engineering
HILLIARD ENGINEERING, PLLC
www.hillardsgrp.com
919.352.2834
Structural Engineering
PROVIDENCE PARTNERS
www.providencepartnersinc.com
704.266.6621
Mechanical, Electrical, Plumbing & Fire Protection
ENGINEERING
www.engineer.com
704.287.2193

Date	Description
01/30/24	FOR CONSTRUCTION

3D
community church
making church come alive
658 GRAHAM ROAD
SANFORD NC 27311

Client
3D COMMUNITY CHURCH
Project Number
23024.00
Description
ACCESSIBILITY REFERENCE DETAILS

Scale
As indicated

A00.02

10/14/2024 5:05:39 PM C:\Private\Drawings\Local\23024.00_3D Community Church\andrew.mcdaniel\FCLC.rvt

N. PLUMBING FIXTURE REQUIREMENTS (TABLE 2902.1)

Table with columns for Water Closets (Urinals), Lavatories, Showers/Tubs, and Drinking Fountains, categorized by gender and fixture type (Existing, New, Required).

O. SPECIAL APPROVALS

LOCAL JURISDICTION, DEPARTMENT OF INSURANCE, OSC, DPI, DHHS, ETC.

P. ENERGY SUMMARY

ENERGY REQUIREMENTS: THE FOLLOWING DATA SHALL BE CONSIDERED MINIMUM AND ANY SPECIAL ATTRIBUTE REQUIRED TO MEET THE ENERGY CODE SHALL ALSO BE PROVIDED.

EXISTING BUILDING ENVELOPE COMPLIES WITH CODE: [] NO [] YES (THE REMAINDER OF THIS SECTION IS NOT APPLICABLE)

EXEMPT BUILDING: [] NO [] YES CODE OR STATUTORY REFERENCE:

CLIMATE ZONE: [] 3A [] 4A [] 5A

METHOD OF COMPLIANCE: ENERGY CODE: [] PERFORMANCE [] PRESCRIPTIVE ASHRAE 90.1: [] PERFORMANCE [] PRESCRIPTIVE OTHER: _____

THERMAL ENVELOPE (PRESCRIPTIVE METHOD ONLY)

ROOF/CILING ASSEMBLY (EACH ASSEMBLY): DESCRIPTION OF ASSEMBLY: METAL BUILDING ROOF U-VALUE OF TOTAL ASSEMBLY: U-0.037 R-VALUE OF INSULATION: R-19 + R-11 LS.

EXTERIOR WALLS (EACH ASSEMBLY): DESCRIPTION OF ASSEMBLY: METAL STUDS WITH RIGID INSULATION / EIFS U-VALUE OF TOTAL ASSEMBLY: U-0.064 R-VALUE OF INSULATION: R-13 + R-7.5ci

FLOORS OVER UNCONDITIONED SPACE (EACH ASSEMBLY): DESCRIPTION OF ASSEMBLY: CONCRETE SLAB ON GRADE U-VALUE OF TOTAL ASSEMBLY: F-0.520 R-VALUE OF INSULATION: R-15 for 24"

FLOORS SLAB ON GRADE: DESCRIPTION OF ASSEMBLY: CONCRETE SLAB ON GRADE U-VALUE OF TOTAL ASSEMBLY: F-0.520 R-VALUE OF INSULATION: R-15 for 24"

WALLS BELOW GRADE (EACH ASSEMBLY): DESCRIPTION OF ASSEMBLY: U-VALUE OF TOTAL ASSEMBLY: R-VALUE OF INSULATION:

FLOORS OVER UNCONDITIONED SPACE (EACH ASSEMBLY): DESCRIPTION OF ASSEMBLY: U-VALUE OF TOTAL ASSEMBLY: R-VALUE OF INSULATION:

FLOORS SLAB ON GRADE: DESCRIPTION OF ASSEMBLY: CONCRETE SLAB ON GRADE U-VALUE OF TOTAL ASSEMBLY: F-0.520 R-VALUE OF INSULATION: R-15 for 24"

WALLS BELOW GRADE (EACH ASSEMBLY): DESCRIPTION OF ASSEMBLY: U-VALUE OF TOTAL ASSEMBLY: R-VALUE OF INSULATION:

FLOORS OVER UNCONDITIONED SPACE (EACH ASSEMBLY): DESCRIPTION OF ASSEMBLY: U-VALUE OF TOTAL ASSEMBLY: R-VALUE OF INSULATION:

FLOORS SLAB ON GRADE: DESCRIPTION OF ASSEMBLY: CONCRETE SLAB ON GRADE U-VALUE OF TOTAL ASSEMBLY: F-0.520 R-VALUE OF INSULATION: R-15 for 24"

WALLS BELOW GRADE (EACH ASSEMBLY): DESCRIPTION OF ASSEMBLY: U-VALUE OF TOTAL ASSEMBLY: R-VALUE OF INSULATION:

G. ALLOWABLE HEIGHT

Table with columns: ALLOWABLE, SHOWN ON PLANS, CODE REFERENCE. Rows for Building Height in Feet (Table 504.3) and Building Height in Stories (Table 504.4).

1 Provide code reference if the "shown on plans" quantity is not based on table 504.3 or 504.4. 2 The maximum height of air traffic control towers must comply with Table 412.3.1. 3 The maximum height of open parking garages must comply with Table 406.5.4.

H. FIRE PROTECTION REQUIREMENTS

Table with columns: SEPARATION DISTANCE, RATING (REQUIRED, PROVIDED W/ REDUCTION), DETAIL # & SHEET #, DESIGN # FOR ASSEMBLY, DESIGN # FOR PENETRATION, DESIGN # FOR JOINTS. Rows include Structure/Columns/Girders/Trusses, Bearing Walls, Exterior Walls, Roof/Ceiling Assemblies, etc.

1 Indicate section number permitting reduction.

L. PERCENTAGE OF WALL OPENINGS

Table with columns: FIRE SEPARATION DISTANCE FROM PROPERTY LINES, DEGREE OF OPENINGS PROTECTION (TABLE 709.5), ALLOWABLE AREA (%), ACTUAL SHOWN ON PLANS (%). Rows for North, East, South, West walls.

J. LIFE SAFETY SYSTEM REQUIREMENTS

EMERGENCY LIGHTING [] NO [] YES EXIT SIGNS [] NO [] YES FIRE ALARM [] NO [] YES SMOKE DETECTION SYSTEMS: [] NO [] YES [] PARTIAL CARBON MONOXIDE DETECTION: [] NO [] YES

K. LIFE SAFETY PLAN REQUIREMENTS

■ FIRE AND/OR SMOKE RATED WALL LOCATIONS (CHAPTER 7) [] ASSUMED AND REAL PROPERTY LINE LOCATIONS (IF NOT ON THE SITE PLAN) [] EXTERIOR WALL OPENING AREA WITH RESPECT TO DISTANCE TO ASSUMED PROPERTY LINES (709.5) ■ OCCUPANCY USE FOR EACH AREA AS IT RELATES TO OCCUPANT LOAD CALCULATION (TABLE 1004.1.2) ■ OCCUPANT LOADS FOR EACH AREA ■ EXIT SIGN LOCATIONS (1013) ■ EXIT ACCESS TRAVEL DISTANCES (1017) ■ COMMON PATH OF TRAVEL DISTANCES (TABLES 1006.2.1 & 1006.3.2(1)) [] DEAD END LENGTHS (1020.4) ■ CLEAR EXIT WIDTHS FOR EACH EXIT DOOR ■ MAXIMUM CALCULATED OCCUPANT LOAD CAPACITY EACH EXIT DOOR CAN ACCOMMODATE BASED ON EGRESS WIDTH (1005.3) ■ ACTUAL OCCUPANT LOAD FOR EACH EXIT DOOR [] A SEPARATE SCHEMATIC PLAN INDICATING WHERE FIRE RATED FLOOR/CEILING AND/OR ROOF STRUCTURE IS PROVIDED FOR PURPOSES OF OCCUPANCY SEPARATION ■ LOCATION OF DOORS WITH PANIC HARDWARE (1010.1.10) [] LOCATION OF DOORS WITH DELAYED EGRESS LOCKS AND THE AMOUNT OF DELAY (1010.1.9.7) [] LOCATION OF DOORS WITH ELECTROMAGNETIC EGRESS LOCKS (1010.1.9.9) [] LOCATION OF DOORS EQUIPPED WITH HOLD-OPEN DEVICES [] LOCATION OF EMERGENCY ESCAPE WINDOWS (1030) [] THE SQUARE FOOTAGE OF EACH FIRE AREA (202) [] THE SQUARE FOOTAGE OF EACH SMOKE COMPARTMENT FOR OCCUPANCY CLASSIFICATION I-2 (407.5) [] NOTE ANY CODE EXCEPTIONS OR TABLE NOTES THAT MAY HAVE BEEN UTILIZED REGARDING THE ITEMS ABOVE.

L. ACCESSIBLE DWELLING UNITS (SECTION 1107)

Table with columns: TOTAL UNITS, ACCESSIBLE UNITS REQUIRED, TYPE A UNITS PROVIDED, TYPE B UNITS PROVIDED, TOTAL ACCESSIBLE UNITS PROVIDED. Row shows N/A for accessible units.

M. ACCESSIBLE PARKING (SECTION 1106)

Table with columns: LOT OR PARKING AREA, TOTAL # OF PARKING SPACES (REQUIRED, PROVIDED), # OF ACCESSIBLE SPACES PROVIDED (REGULAR WITH 5' AISLE, VAN SPACES WITH 13' AISLE, 8' AISLE), TOTAL # ACCESSIBLE PROVIDED. Row shows 6 total spaces, 2 accessible.

2018 APPENDIX B BUILDING CODE SUMMARY FOR ALL COMMERCIAL PROJECTS

EXCEPT 1 & 2-FAMILY DWELLINGS & TOWNHOUSES

A. PROJECT INFORMATION

NAME OF PROJECT: 3D COMMUNITY CHURCH ADDRESS: 658 GRAHAM ROAD SANFORD NC 27311 PROPOSED USE: CHURCH OWNER / AUTHORIZED AGENT: 3D COMMUNITY CHURCH / CHARLES HICKMAN EMAIL: PASTORCHARLIE@3DCOMMUNITYCHURCH.COM PHONE: 919.353.2060 OWNED BY: [] CITY [] COUNTY [] STATE [] PRIVATE CODE ENFORCEMENT JURISDICTION: [] CITY [] COUNTY [] STATE

B. DESIGN PROFESSIONAL INFORMATION

DESIGNER: Ossa Studio FIRM: JACK OSSA LICENSE: 11709 PHONE: 704.890.2053 EMAIL: JACK@OSSASTUDIO.COM ARCHITECTURAL: HILLIARD ENGINEERING JARROD HILLIARD 35670 919.352.2834 JHILLIARD@HILLIARDENGINEERING.COM CIVIL: ELECTRICIAN: GREGORY WILEY 31600 704.287.2193 GWILEY@ENGTECHTURE.COM FIRE ALARM: GREGORY WILEY 31600 704.287.2193 GREG.WILEY@ENGTECHTURE.COM PLUMBING: J. CHANTRY JOHNSON 44505 704.575.0305 CHANTRY_JOHNSON@ENGTECHTURE.COM MECHANICAL: J. CHANTRY JOHNSON 44505 704.575.0305 CHANTRY_JOHNSON@ENGTECHTURE.COM SPRINKLER: PROVIDENCE PARTNERS K. BRIAN CONE 36791 704.773.2925 BCONE@PROVIDENCEPARTNERSINC.COM OTHER:

C. CODE DATA

2018 NC BUILDING CODE: [] NEW BUILDING [] ADDITION [] 1ST TIME INTERIOR COMPLETION [] CORE & SHELL [] PHASE CONSTRUCTION CORE & SHELL 2018 NC EXISTING BUILDING CODE: [] N/A [] PRESCRIPTIVE [] REPAIR [] CHAPTER 14 [] ALTERATION LEVEL I [] ALTERATION LEVEL II [] ALTERATION LEVEL III [] HISTORIC PROPERTY [] CHANGE OF USE CONSTRUCTED (DATE): CURRENT OCCUPANCY(S) (CH 3): RENOVATED (DATE): PROPOSED OCCUPANCY(S) (CH 3):

RISK CATEGORY:

CURRENT [] I [] II [] III [] IV PROPOSED [] I [] II [] III [] IV

D. BASIC BUILDING DATA

CONSTRUCTION TYPE: [] I-A [] I-B [] II-A [] II-B [] III-A [] III-B [] IV [] V-A [] V-B SPRINKLERS: [] NO [] YES [] PARTIAL [] NFPA 13 [] NFPA13R [] NFPA13D STANDPIPES: [] NO [] YES CLASS: [] I [] II [] III [] WET [] DRY FIRE DISTRICT: [] NO [] YES FLOOD HAZARD AREA: [] NO [] YES SPECIAL INSPECTIONS REQUIRED: [] NO [] YES

E. GROSS BUILDING AREA

Table with columns: FLOOR, EXISTING (SF), NEW (SF), SUBTOTAL (SF). Row for 1ST FLOOR shows 11,898 SF. Total shows 11,898 SF.

F. ALLOWABLE AREA

PRIMARY OCCUPANCY CLASSIFICATION(S): ASSEMBLY (303) [] A-1 [] A-2 [] A-3 [] A-4 [] A-5 BUSINESS (304) [] B EDUCATIONAL (305) [] E FACTORY (306) [] F-1 MODERATE [] F-2 LOW HAZARDOUS (307) [] H-1 DETONATE [] H-2 DEFLAGRATE [] H-3 COMBUST [] H-4 HEALTH [] H-5 HPM INSTITUTIONAL (308) [] I-1 CONDITION: [] 1 [] 2 [] 1-2 CONDITION: [] 1 [] 2 [] 1-3 CONDITION: [] 1 [] 2 [] 3 [] 4 [] 5 [] I-4 [] M MERCANTILE (309) [] M RESIDENTIAL (310) [] R-1 [] R-2 [] R-3 [] R-4 STORAGE (311) [] S-1 MODERATE [] S-2 LOW [] HIGH-PILED [] PARKING GARAGE [] OPEN [] ENCLOSED [] REPAIR GARAGE UTILITY & MISC. (312) [] U ACCESSORY OCCUPANCY CLASSIFICATION(S): INCIDENTAL USES (TABLE 509): SPECIAL USES (CHAPTER 4): SPECIAL PROVISIONS (CHAPTER 5): MIXED OCCUPANCY: [] NO [] YES SEPARATION: 2 HR. EXCEPTION: [] NON-SEPARATED USE (508.3) [] SEPARATED USE (508.4)


Actual Area of Occupancy A / Allowable Area of Occupancy A + Actual Area of Occupancy B / Allowable Area of Occupancy B <= 1

Table with columns: STORY NO., DESCRIPTION & USE, AREA PER STORY (ACTUAL), AREA PER TABLE 506.2.4, AREA FOR FRONTAGE INCREASE 1.5, ALLOWABLE AREA OR UNLIMITED 2.3. Rows for 1ST FLOOR ASSEMBLY (A-3) and BUSINESS (B).

1 Frontage area increases from Section 506.2 are computed thus: a. Perimeter which fronts a public way or open space having 20 feet minimum width = (F) b. Total Building Perimeter = (P) c. Ratio (F/P) = (F/P) d. W = Minimum width of public way = (W) e. Percent of frontage increase I = 100 (F/P - 0.25) x W/30 = (%) 2 Unlimited area applicable under conditions of Section 507. 3 Maximum Building Area = total number of stories in the building x D (maximum 3 stories) (506.2). 4 The maximum area of open parking garages must comply with Table 406.5.4. The maximum area of air traffic control towers must comply with Table 412.3.1. 5 Frontage increase is based on the un sprinklered area value in Table 506.2.



4539 HEDGEMORE DRIVE, SUITE 101 CHARLOTTE NC 28209 704.890.2053 WWW.OSSASTUDIO.COM

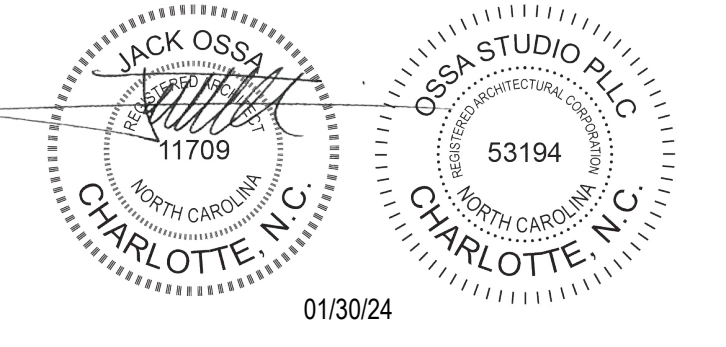

PROJECT TEAM General Contractor: ECCLESIA CONSTRUCTION www.ecclesiainc.com 803.327.5670 Civil Engineering: HILLIARD ENGINEERING, PLLC www.iaasgrp.com 919.352.2834 Structural Engineering: PROVIDENCE PARTNERS www.providencpartnersinc.com 704.266.6621 Mechanical, Electrical, Plumbing & Fire Protection: ENGTECHTURE www.engtechure.com 704.287.2193

Table with columns: Date, Description. Row: 01/30/24 FOR CONSTRUCTION, 1 05/8/24 PERMIT REVIEW COMMENTS

Project Name: 3D community church making church come alive 658 GRAHAM ROAD SANFORD NC 27311

Client: 3D COMMUNITY CHURCH

Project Number: 23024.00 Description: APPENDIX B


Scale:

A00.03



Ossa
STUDIO

4539 HEDGEMORE DRIVE, SUITE 101
CHARLOTTE NC 28209
704.890.2653
WWW.OSSASTUDIO.COM

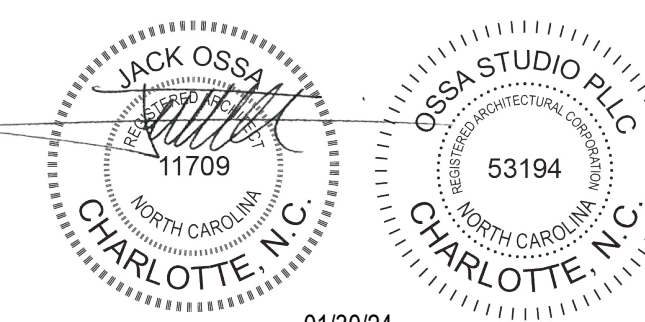

01/30/24

PROJECT TEAM

General Contractor
ECCLESIA CONSTRUCTION
www.ecclesiainc.com
803.327.5670

Civil Engineering
HILLIARD ENGINEERING, PLLC
www.hilliarde.com
919.352.2834

Structural Engineering
PROVIDENCE PARTNERS
www.providencepartnersinc.com
704.266.6621

Mechanical, Electrical, Plumbing & Fire Protection
ENGINEERING
www.engineer.com
704.287.2193

Date	Description
01/30/24	FOR CONSTRUCTION
1 05/8/24	PERMIT REVIEW COMMENTS
2 10/14/24	RTAP NO. 1

Project Name



community church
making church come alive

658 GRAHAM ROAD
SANFORD NC 27311

Client

3D COMMUNITY CHURCH

Project Number

23024.00


Description

LIFE SAFETY PLAN

Scale

As indicated

A00.04

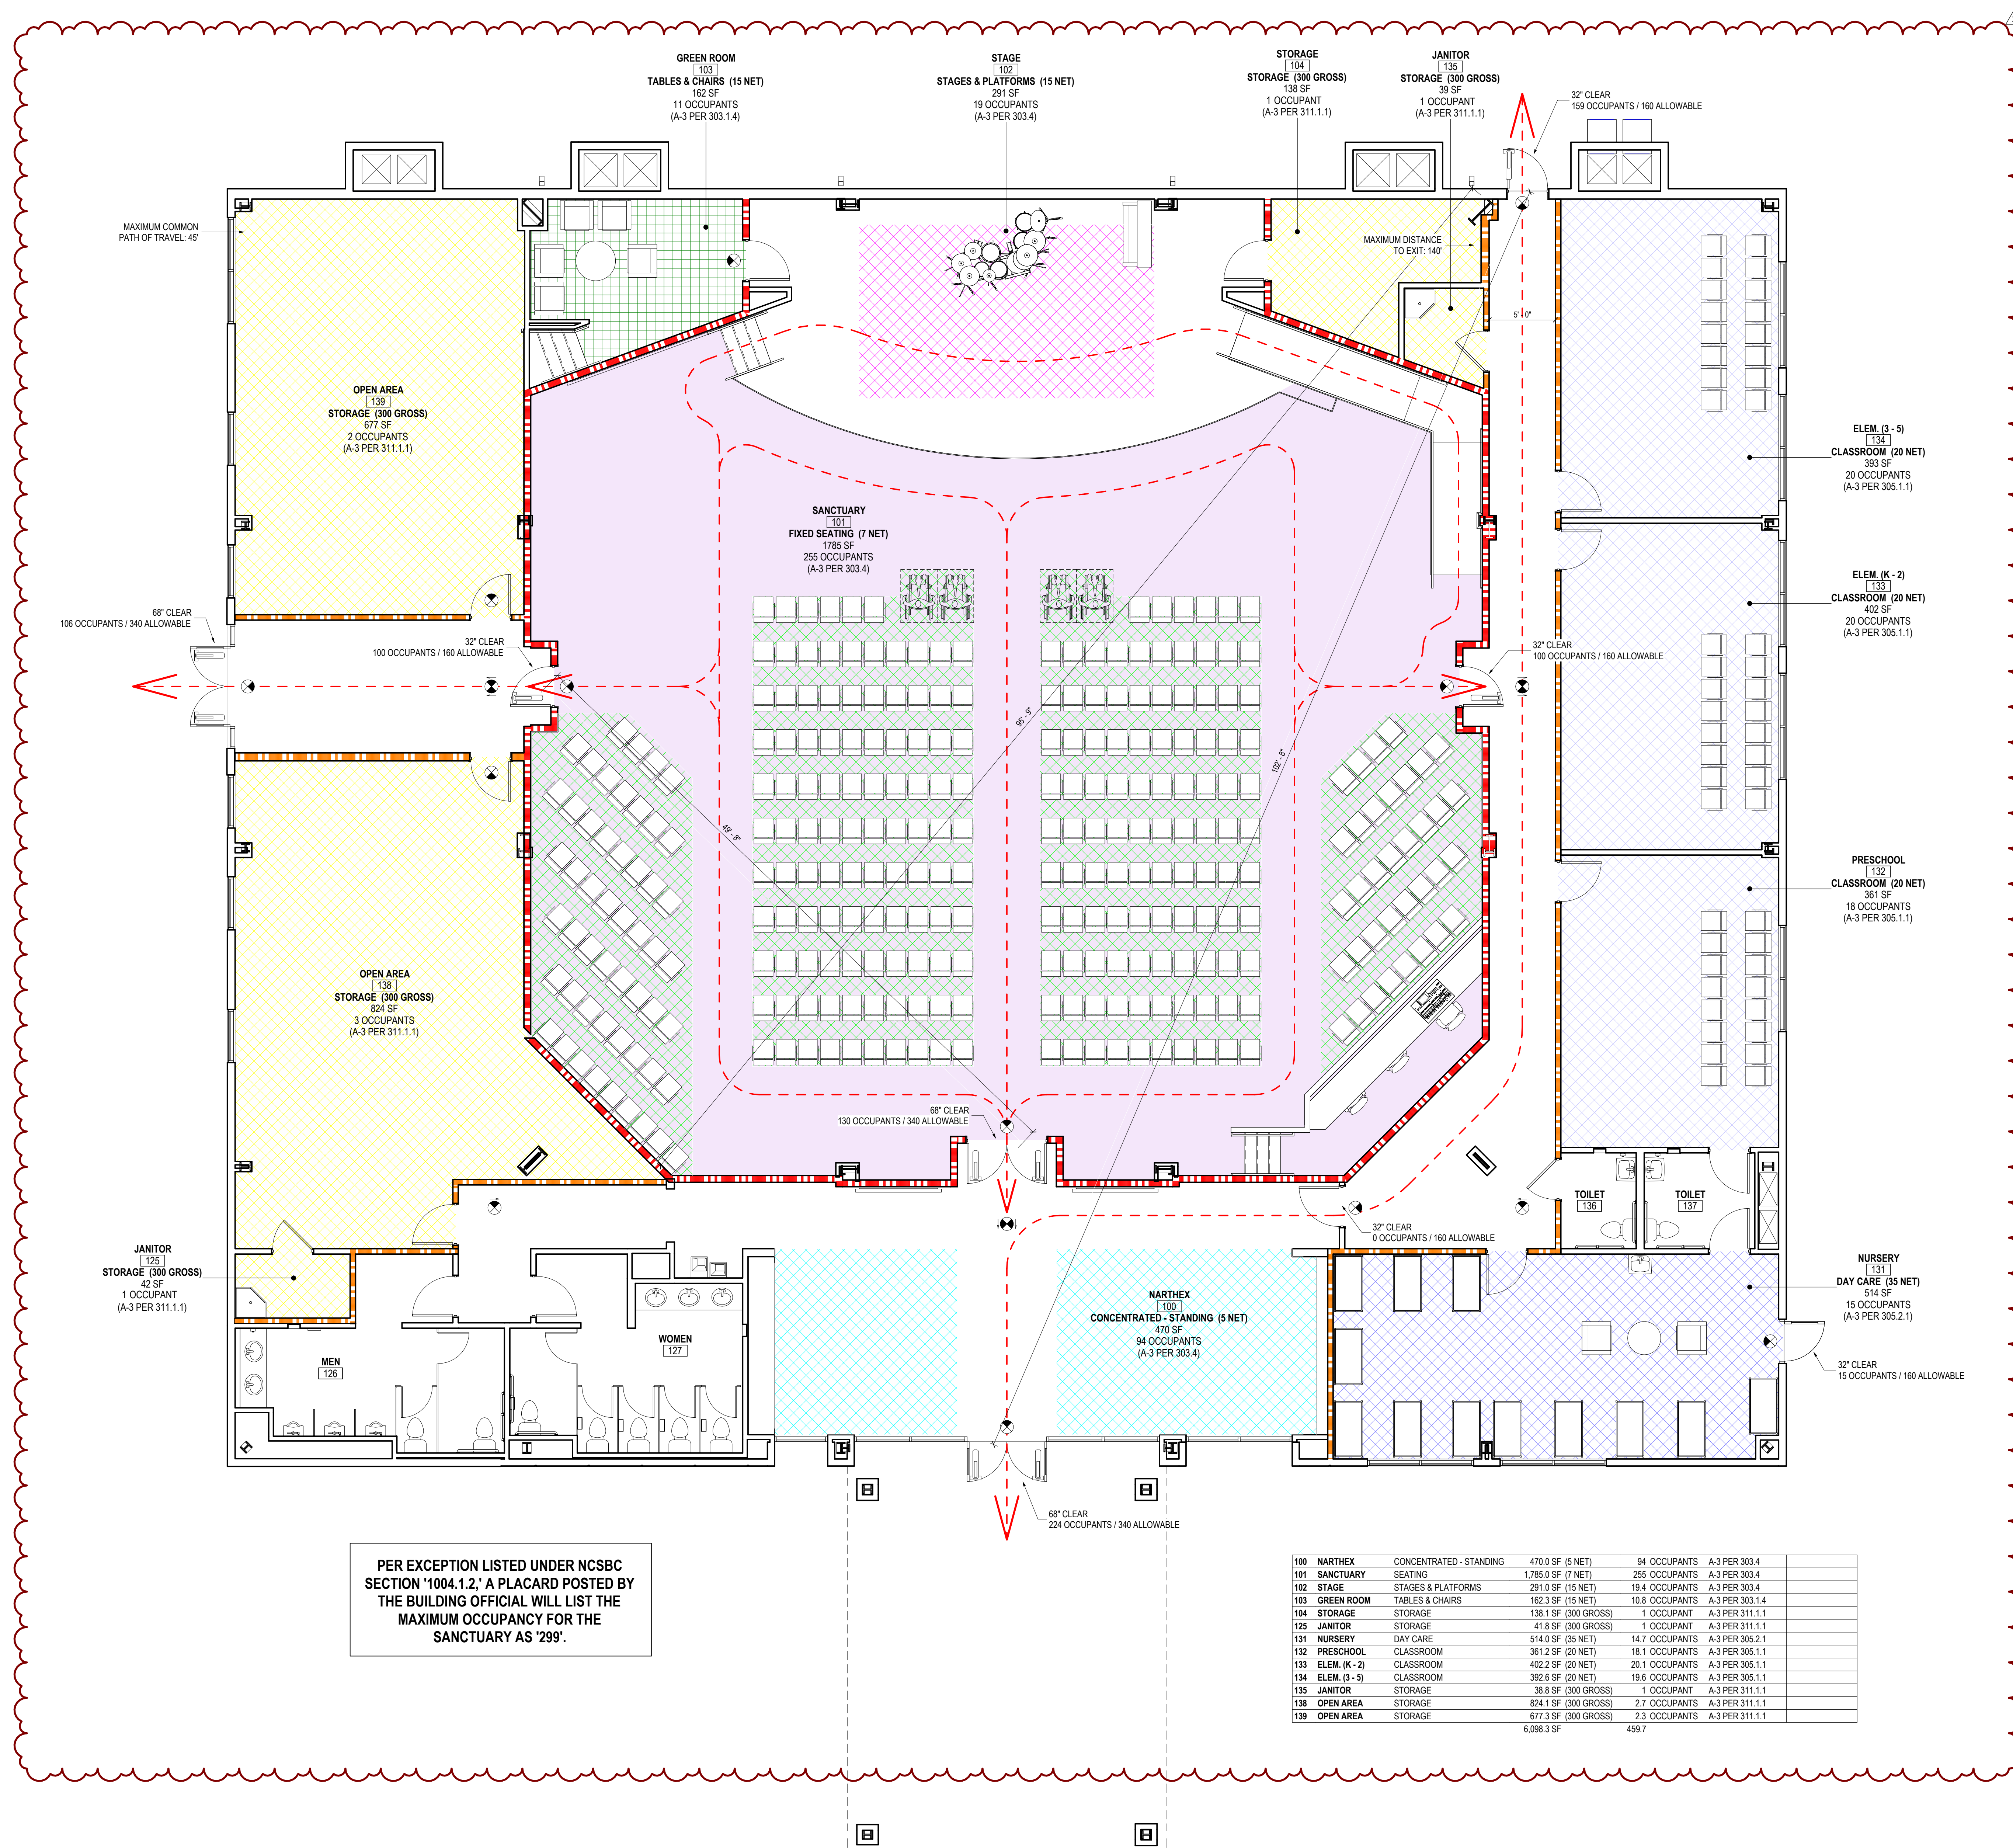

PER EXCEPTION LISTED UNDER NCSBC SECTION '1004.1.2,' A PLACARD POSTED BY THE BUILDING OFFICIAL WILL LIST THE MAXIMUM OCCUPANCY FOR THE SANCTUARY AS '299'.

Room Number	Room Name	Area	Net Area	Occupants	Code
100	NARTHEX	CONCENTRATED - STANDING	470.0 SF (5 NET)	94 OCCUPANTS	A-3 PER 303.4
101	SANCTUARY	SEATING	1,785.0 SF (7 NET)	295 OCCUPANTS	A-3 PER 303.4
102	STAGE	STAGES & PLATFORMS	291.0 SF (15 NET)	19.4 OCCUPANTS	A-3 PER 303.4
103	GREEN ROOM	TABLES & CHAIRS	162.3 SF (15 NET)	10.8 OCCUPANTS	A-3 PER 303.1.4
104	STORAGE	STORAGE	138.1 SF (300 GROSS)	1 OCCUPANT	A-3 PER 311.1.1
125	JANITOR	STORAGE	41.8 SF (300 GROSS)	1 OCCUPANT	A-3 PER 311.1.1
131	NURSERY	DAY CARE	514.0 SF (35 NET)	14.7 OCCUPANTS	A-3 PER 305.2.1
132	PRESCHOOL	CLASSROOM	361.2 SF (20 NET)	18.1 OCCUPANTS	A-3 PER 305.1.1
133	ELEM. (K - 2)	CLASSROOM	402.2 SF (20 NET)	20.1 OCCUPANTS	A-3 PER 305.1.1
134	ELEM. (3 - 5)	CLASSROOM	392.6 SF (20 NET)	19.6 OCCUPANTS	A-3 PER 305.1.1
135	JANITOR	STORAGE	38.8 SF (300 GROSS)	1 OCCUPANT	A-3 PER 311.1.1
138	OPEN AREA	STORAGE	824.1 SF (300 GROSS)	2.7 OCCUPANTS	A-3 PER 311.1.1
139	OPEN AREA	STORAGE	677.3 SF (300 GROSS)	2.3 OCCUPANTS	A-3 PER 311.1.1
			6,086.3 SF	459.7	

WALL LEGEND

- 1 HR. RATED PARTITION - UL419
- 2 HR. RATED PARTITION - UL419

CGC INC — 1/2 in. thick Type C, IP-X2 or IPC-AR, WRC, 5/8 in. thick Type AR, C, IP-AR, IP-X1, IP-X2, IPC-AR, SCX, SHX, WRX or WRC, 3/4 in. thick Types IP-X3 or ULTRACODE

UNITED STATES GYPSUM CO — 1/2 in. thick Type C, IP-X2, IPC-AR or WRC, 5/8 in. thick Type SCX, SHX, WRX, IP-X1, AR, C, WRX, FRX-G, IP-AR, IP-X2, IPC-AR; 3/4 in. thick Types IP-X3 or ULTRACODE

USG MEXICO S A DE C V — 1/2 in. thick Type C, IP-X2, IPC-AR or WRC, 5/8 in. thick Type AR, C, IP-AR, IP-X1, IP-X2, IPC-AR, SCX, SHX, WRX or WRC or 3/4 in. thick Types IP-X3 or ULTRACODE

When Item 7B, Steel Framing Members*, is used, Nonbearing Wall Rating is limited to 1 H. Min. stud depth is 3-1/2 in., min. thickness of insulation (Item 4) is 3 in., and two layers of gypsum board panels (1/2 in. or 5/8 in. thick) shall be attached to furring channels as described in Item 6. One layer of gypsum board panels (1/2 in. or 5/8 in. thick) attached to opposite side of stud without furring channels as described in Item 6.

CGC INC — Type SHX.

5A. Gypsum Board* — (As an alternate to Item 5) — 5/8 in. thick, 24 to 54 in. wide, applied horizontally as the outer layer to one side of the assembly. Secured as described in Item 6.

UNITED STATES GYPSUM CO — Type FRX-G, SHX.

USG MEXICO S A DE C V — Type SHX.

5B. Gypsum Board* — (Not Shown) — As an alternate to Item 5 when used as the base layer on one or both sides of wall when 5/8 in. or 3/4 in. thick products are specified. For direct attachment only to steel studs Item 2B, (not to be used with Item 3) - Nom 5/8 in. or 3/4 in. may be used as alternate to all 5/8 in. or 3/4 in. shown in Item 5, Wallboard Protection on Each Side of Wall table. Nom 5/8 in. or 3/4 in. thick lead backed gypsum panels with beveled, square or tapered edges, applied vertically. Vertical joints centered over studs and staggered min 1 stud cavity on opposite sides of studs. Gypsum board secured to 20 MSG steel studs Item 2B with 1-1/4 in. long Type S-12 steel screws spaced 8 in. OC at perimeter and 12 in. OC in the field. To be used with Lead Batten Strips (see Item 11) or Lead Discs or Tabs (see Item 12).

RAY-BAR ENGINEERING CORP — Type RB LBG

5C. Gypsum Board* — (For Use With Item 2C) Rating Limited to 1 Hour: 5/8 in. thick, 48 in. wide. Gypsum panels with beveled, square or tapered edges, applied vertically or horizontally. (Vertical Application) - The gypsum board is to be installed on each side of the studs with 1 in. long Type S coated steel screws spaced 8 in. OC starting 4 in. from the edge of the board at the vertical edges and 12 in. OC starting 6 in. from the edge of the board at the center of each board. Gypsum boards are to be secured to the top and bottom track with screws spaced 8 in. OC starting 4 in. from the board edge. Fasteners shall not penetrate through both the stud and the track at the same time. Vertical joints are to be centered over studs and staggered one stud cavity on opposite sides of studs. (Horizontal Application) - The gypsum board is to be installed on each side of the studs with 1 in. long Type S coated steel screws spaced 8 in. OC starting 4 in. from the edge of the board at the vertical edges and 12 in. OC starting 6 in. from the edge of the board at the center of each board. Gypsum boards are to be secured to the top and bottom track with screws spaced 8 in. OC starting 4 in. from the board edge. Fasteners shall not penetrate through both the stud and the track at the same time. All horizontal joints are to be backed as outlined under section VI of Volume 1 in the Fire Resistive Directory.

CGC INC — Type SCX.

UNITED STATES GYPSUM CO — Type SCX.

USG MEXICO S A DE C V — Type SCX.

5D. Gypsum Board* — (As an alternate to Item 5) — 5/8 in. thick, 48 in. wide, applied vertically or horizontally. Secured as described in Item 6. For use with Items 1 and 2 only.

UNITED STATES GYPSUM CO — Type USGX.

5E. Gypsum Board* — (Not Shown) — (As an alternate to Item 5 when used as the base layer on one or both sides of wall when 12 in. or 5/8 in. thick products are specified. For direct attachment only to steel studs Item 2B, not to be used with Item 3). Nominal 5/8 in. thick lead backed gypsum panels with beveled, square or tapered edges, applied vertically. Vertical joints centered over studs and staggered min 1 stud cavity on opposite sides of studs. Wallboard secured to studs with 1-1/4 in. long Type S-12 (or No. 6 by 1-1/4 in. long bugle head fine driller) steel screws spaced 8 in. OC at perimeter and 12 in. OC in the field.

NEW ENGLAND LEAD BURNING CO INC, DBA

NELCO — Nelco

5F. Gypsum Board* — (As an alternate to Item 5) — For use with Items 1G and 2F and limited to 1 Hour Rating only and gypsum panels with beveled, square or tapered edges, applied vertically, and fastened to the steel studs with 1 in. long Type S screws spaced 8 in. OC along vertical and bottom edges and 12 in. OC in the field. Vertical joints centered over studs and staggered one stud cavity on opposite sides of studs. Steel stud depth shall be a minimum 3-5/8 in.

UNITED STATES GYPSUM CO — 5/8 in. thick Type SCX.

5G. Gypsum Board* — (As an alternate to Item 5) — For use with Items 1G and 2F only. Gypsum panels with beveled, square or tapered edges, applied vertically or horizontally, as specified in the table below and fastened to the steel studs as described in Item 6. Vertical joints centered over studs and staggered one stud cavity on opposite sides of studs. Vertical joints in adjacent layers (multilayer systems) staggered one stud cavity. Horizontal joints need not be backed by steel framing. Horizontal edge joints and horizontal butt joints on opposite sides of studs need not be staggered. Horizontal edge joints and horizontal butt joints in adjacent layers (multilayer systems) staggered a min of 1/2 in. The thickness and number of layers for the 2, 3, 4 and 4 hr ratings are as follows:

Gypsum Board Protection on Each Side of Wall

Rating, Hr	Min Stud Depth, in. Item 2F	No. of Layers & Thickness of Panel	Min Thkns of Insulation (Item 4)
2	1-5/8	2 layers, 1/2 in. thick	Optional
2	1-5/8	2 layers, 5/8 in. thick	Optional
3	1-5/8	3 layers, 1/2 in. thick	Optional
3	1-5/8	3 layers, 5/8 in. thick	Optional
4	1-5/8	4 layers, 5/8 in. thick	Optional
4	1-5/8	4 layers, 1/2 in. thick	Optional

CGC INC — 1/2 in. thick Type C, IP-X2 or IPC-AR, 5/8 in. thick Type AR, C, IP-AR, IP-X1, IP-X2, IPC-AR, SCX, SHX, or 3/4 in. thick Types IP-X3 or ULTRACODE

UNITED STATES GYPSUM CO — 1/2 in. thick Type C, IP-X2, IPC-AR or 5/8 in. thick Type SCX, SHX, IP-X1, AR, C, , FRX-G, IP-AR, IP-X2, IPC-AR; 3/4 in. thick Types IP-X3 or ULTRACODE

USG MEXICO S A DE C V — 1/2 in. thick Type C, IP-X2, IPC-AR or 5/8 in. thick Type AR, C, IP-AR, IP-X1, IP-X2, IPC-AR, SCX, SHX, or 3/4 in. thick Types IP-X3 or ULTRACODE

5H. Gypsum Board* — (Not Shown) — As an alternate to Item 5 when used as the base layer on one or both sides of wall when 5/8 or 3/4 in. thick products are specified. For direct attachment only to steel studs Item 2B, (not to be used with Item 3) - Nom 5/8 or 3/4 in. may be used as alternate to all 5/8 or 3/4 in. shown in Item 5, Wallboard Protection on Each Side of Wall table. Nom 5/8 or 3/4 in. thick lead backed gypsum panels with beveled, square or tapered edges, applied vertically. Vertical joints centered over studs and staggered min 1 stud cavity on opposite sides of studs. Gypsum board secured to 20 MSG steel studs Item 2B with 1-1/4 in. long Type S-12 steel screws spaced 8 in. OC at perimeter and 12 in. OC in the field. To be used with Lead Batten Strips (see Item 11A) or Lead Discs (see Item 12A).

MAYCO INDUSTRIES INC — Type X-Ray Shielded Gypsum

5I. Gypsum Board* — (As an alternate to Item 5) - Nom. 5/8 in. thick gypsum panels with beveled, square or tapered edges installed as described in Item 5. Steel stud minimum depth shall be as indicated in Item 5.

CGC INC — Type ULX

UNITED STATES GYPSUM CO — Type ULX

USG MEXICO S A DE C V — Type ULX

6. Fasteners — (Not shown) — For use with Items 2 and 2F - Type S or S-12 steel screws used to attach panels to studs (Item 2) or furring channels (Item 7). Single layer systems: 1 in. long for 1/2 and 5/8 in. thick panels or 1-1/4 in. long for 3/4 in. thick panels, spaced 8 in. OC when panels are applied horizontally, or 8 in. OC along vertical and bottom edges and 12 in. OC in the field when panels are applied vertically. Two layer systems: First layer: 1 in. long for 1/2 and 5/8 in. thick panels or 1-1/4 in. long for 3/4 in. in. thick panels, spaced 16 in. OC. Second layer: 1-5/8 in. long for 1/2 in., 5/8 in. thick panels or 2-1/4 in. long for 3/4 in. thick panels, spaced 16 in. OC with screws offset 8 in. from first layer. Three-layer systems: First layer: 1 in. long for 1/2 in., 5/8 in. thick panels, spaced 24 in. OC. Second layer: 1-5/8 in. long for 1/2 in., 5/8 in. thick panels, spaced 24 in. OC. Third layer: 2-1/4 in. long for 1/2 in., 5/8 in. thick panels or 2-5/8 in. long for 5/8 in. thick panels, spaced 12 in. OC. Screws offset min 6 in. from layer below. Four-layer systems: First layer: 1 in. long for 1/2 in., 5/8 in. thick panels, spaced 24 in. OC. Second layer: 1-5/8 in. long for 1/2 in., 5/8 in. thick panels, spaced 24 in. OC. Third layer: 2-1/4 in. long for 1/2 in. thick panels or 2-5/8 in. long for 5/8 in. thick panels, spaced 24 in. OC. Fourth layer: 2-5/8 in. long for 1/2 in. thick panels or 3 in. long for 5/8 in. thick panels, spaced 12 in. OC. Screws offset min 6 in. from layer below.

6A. Fasteners — (Not shown) — For use with Item 2A - Type S or S-12 steel screws used to attach panels to studs (Item 2A). Single layer systems: 1 in. long for 1/2 and 5/8 in. thick panels or 1-1/4 in. long for 3/4 in. thick panels, spaced 1/2 in. OC with additional screws 1 in. and 2-1/2 in. from edges of the board when panels are horizontally, or 8 in. OC along vertical and bottom edges and 12 in. OC in the field when panels are applied vertically. Two layer systems applied vertically: First layer: 1 in. long for 1/2 and 5/8 in. thick panels or 1-1/4 in. long for 3/4 in. thick panels, spaced 16 in. OC. Second layer: 1-5/8 in. long for 1/2 in., 5/8 in. thick panels or 2-1/4 in. long for 3/4 in. thick panels, spaced 16 in. OC with screws offset 8 in. from first layer. Two layer systems applied horizontally: First layer: 1 in. long for 1/2 and 5/8 in. thick panels or 1-1/4 in. long for 3/4 in. thick panels, spaced 16 in. OC starting 8 in. from each edge of the board with an additional screw placed 1-1/4 in. from each edge of the board. Second layer: 1-5/8 in. long for 1/2 in., 5/8 in. thick panels or 2-1/4 in. long for 3/4 in. thick panels, spaced 16 in. OC starting 8 in. from each edge of the board with an additional screw placed 8 in. from first layer. Three-layer systems: First layer: 1 in. long for 1/2 in., 5/8 in. thick panels, spaced 24 in. OC. Second layer: 1-5/8 in. long for 1/2 in., 5/8 in. thick panels, spaced 24 in. OC. Third layer: 2-1/4 in. long for 1/2 in., 5/8 in. thick panels or 2-5/8 in. long for 5/8 in. thick panels, spaced 12 in. OC. Screws offset min 6 in. from layer below. For all layers, an additional screw shall be placed 1-1/4 in. from each edge of the board. Four-layer systems: First layer: 1 in. long for 1/2 in., 5/8 in. thick panels, spaced 24 in. OC. Second layer: 1-5/8 in. long for 1/2 in., 5/8 in. thick panels, spaced 24 in. OC. Third layer: 2-1/4 in. long for 1/2 in. thick panels or 2-5/8 in. long for 5/8 in. thick panels, spaced 24 in. OC. Fourth layer: 2-5/8 in. long for 1/2 in. thick panels or 3 in. long for 5/8 in. thick panels, spaced 12 in. OC. Screws offset min 6 in. from layer below. For all layers, an additional screw shall be placed 1-1/4 in. from each edge of the board.

7. Furring Channels — (Optional, not shown, for single or double layer systems) — Resilient furring channels fabricated from min 25 MSG corrosion-protected steel, spaced vertically a max of 24 in. OC. Flange portion attached to each intersecting stud with 1/2 in. long Type S-12 steel screws. Not for use with Item 5A and 5E.

7A. Framing Members* — (Not Shown) — (Optional on one or both sides, not shown, for single or double layer systems) — As an alternate to Item 7, furring channels and Steel Framing Members as described below:
a. Furring Channels — Formed of No. 25 MSG galv steel, 2-3/8 in. wide by 7/8 in. deep, spaced max. 24 in. OC perpendicular to studs. Channels secured to studs as described in Item 6. Gypsum board attached to furring channels as described in Item 6. Not for use with Item 5A and 5E.
b. Steel Framing Members* — Used to attach furring channels (Item 7A) to studs (Item 2). Clips spaced max. 48 in. OC. RSIC-1 clips secured to studs with No. 8 x 1-1/2 in. minimum self-drilling, S-12 steel screw through the center grommet. RSIC-V clips secured to studs with No. 8 x 9/16 in. minimum self-drilling, S-12 steel screw through the center hole. Furring channels are friction fitted into clips.
PAC INTERNATIONAL INC — Types RSIC-1, RSIC-V.

7B. Framing Members* — (Optional, Not Shown) — As an alternate to Item 7, for single or double layer systems, furring channels and Steel Framing Members on only one side of studs as described below:
a. Furring Channels — Formed of No. 25 MSG galv steel, spaced 24 in. OC perpendicular to studs. Channels secured to studs as described in Item 6. Batts and Blankets placed in stud cavity as described in Item 5. Two layers of gypsum board attached to furring channels as described in Item 5. Not for use with Item 5A and 5E.
b. Steel Framing Members* — Used to attach furring channels (Item 7B) to one side of studs (Item 2) only. Clips spaced 48 in. OC., and secured to studs with two No. 8 x 1-1/2 in. minimum self-drilling, S-12 steel screws, one through the hole at each end of the clip. Furring channels are friction fitted into clips.
KNETICS NOISE CONTROL, INC — Type Icomax

7C. Framing Members* — Optional - Not Shown - Used as an alternate method to attach resilient channels (Item 7). Clips attached at each intersection of the resilient channel and the steel studs (Item 2). Resilient channels are friction fitted into clips, and then clips are secured to the steel stud with min. 1 in. long Type S-12 steel screws through the center hole of the clip and the resilient channel flange.
KEENE BUILDING PRODUCTS CO INC — Type RC Assurance.

7D. Framing Members* — (Not Shown) — (Optional on one or both sides, not shown, for single or double layer systems) — As an alternate to Item 7, furring channels and Steel Framing Members as described below:
a. Furring Channels — Formed of No. 25 MSG galv steel, 2-3/8 in. wide by 7/8 in. deep, spaced max. 24 in. OC perpendicular to studs. Channels secured to studs as described in Item 6. Gypsum board attached to furring channels as described in Item 6. Not for use with Item 5A and 5E.
b. Steel Framing Members* — Used to attach furring channels (Item 7A) to studs (Item 2). Clips spaced max. 48 in. OC. GENIECLIPS secured to studs with No. 8 x 1-1/2 in. minimum self-drilling, S-12 steel screw through the center grommet. Furring channels are friction fitted into clips.
FLITECO INC — Type GENIECLIP.

8. Joint Tape and Compound — Vinyl or casein, dry or premixed joint compound applied in two coats to joints and screw heads of outer layers. Paper tape, nom 2 in. wide, embedded in first layer of compound over all joints of outer layer panels. Paper tape and joint compound may be omitted when gypsum panels are supplied with a square edge.

9. Siding, Brick or Stucco — (Optional, not shown) — Aluminum, vinyl or steel siding, brick veneer or stucco, meeting the requirements of local code agencies, installed over gypsum panels. Brick veneer attached to studs with corrugated metal wall ties attached to each stud with steel screws, not more than each sixth course of brick.

10. Caulking and Sealants* — (Optional, not shown) — A bead of acoustical sealant applied around the partition perimeter for sound control.
UNITED STATES GYPSUM CO — Type AS

11. Lead Batten Strips — (Not Shown, For Use With Item 5B) - Lead batten strips, min 1-1/2 in. wide, max 10 ft long with a max thickness of 0.125 in. Strips placed on the interior face of studs and attached from the exterior face of the stud with two 1 in. long Type S-12 pan head steel screws, one at the top of the strip and one at the bottom of the strip. Lead batten strips to have a purity of 99.9% meeting the Federal specification QQ-L-2011, Grade "C". Lead batten strips required behind vertical joints of lead backed gypsum wallboard (Item 5B) and optional at remaining stud locations. Required behind vertical joints.


11A. Lead Batten Strips — (Not Shown, For Use With Item 5H) Lead batten strips, 2 in. wide, max 10 ft long with a max thickness of 0.0625 in. Strips placed on the face of studs and attached to the stud with two min. 1 in. long min. Type S-8 pan head steel screws, one at the top of the strip and one at the bottom of the strip or with one min. 1 in. long min. Type S-8 pan head steel screw at the top of the strip. Lead batten strips to have a purity of 99.9% meeting the Federal specification QQ-L-2011, Grade "C". Lead batten strips required behind vertical joints of lead backed gypsum wallboard (Item 6) and optional at remaining stud locations.

12. Lead Discs or Tabs — (Not Shown, For Use With Item 5B) - Used in lieu of or in addition to the lead batten strips (Item 11) or optional at other locations - Max 3/4 in. diam by max 0.125 in. thick lead discs compression fitted or adhered over steel screw heads or max 1/2 in. by 1-1/4 in. by max 0.125 in. thick lead tabs placed on gypsum boards (Item 11) underneath screw locations prior to the installation of the screws. Lead discs or tabs to have a purity of 99.9% meeting the Federal specification QQ-L-2011, Grade "C".

12A. Lead Discs — (Not Shown, for use with Item 5H) Max 5/16 in. diam by max 0.0625 in. thick lead discs compression fitted or adhered over steel screw heads. Lead discs to have a purity of 99.9% meeting the Federal specification QQ-L-2011, Grade "C".

13. Lead Batten Strips — (Not Shown, For Use With Item 5E) Lead batten strips, 2 in. wide, max 10 ft long with a max thickness of 0.142 in. Strips placed on the face of studs and attached to the stud with two min. 1 in. long min. Type S-8 pan head steel screws, one at the top of the strip and one at the bottom of the strip or with one min. 1 in. long min. Type S-8 pan head steel screw at the top of the strip. Lead batten strips to have a purity of 99.9% meeting the Federal specification QQ-L-2011, Grade "C". Lead batten strips required behind vertical joints of lead backed gypsum wallboard (Item 5E) and optional at remaining stud locations.

14. Lead Tabs — (Not Shown, For Use With Item 5E) 2 in. wide, 5 in. long with a max thickness of 0.142 in. Tabs friction-fit around front face of the stud, folded back flange, and the back face of the stud. Tabs required at each location where a screw that secures the gypsum boards, Item 5E will penetrate the steel stud. Lead tabs to have a purity of 99.9% meeting the Federal specification QQ-L-2011, Grade "C". Lead tabs may be held in place with standard adhesive tape if necessary.
*bearing the UL Classification Mark

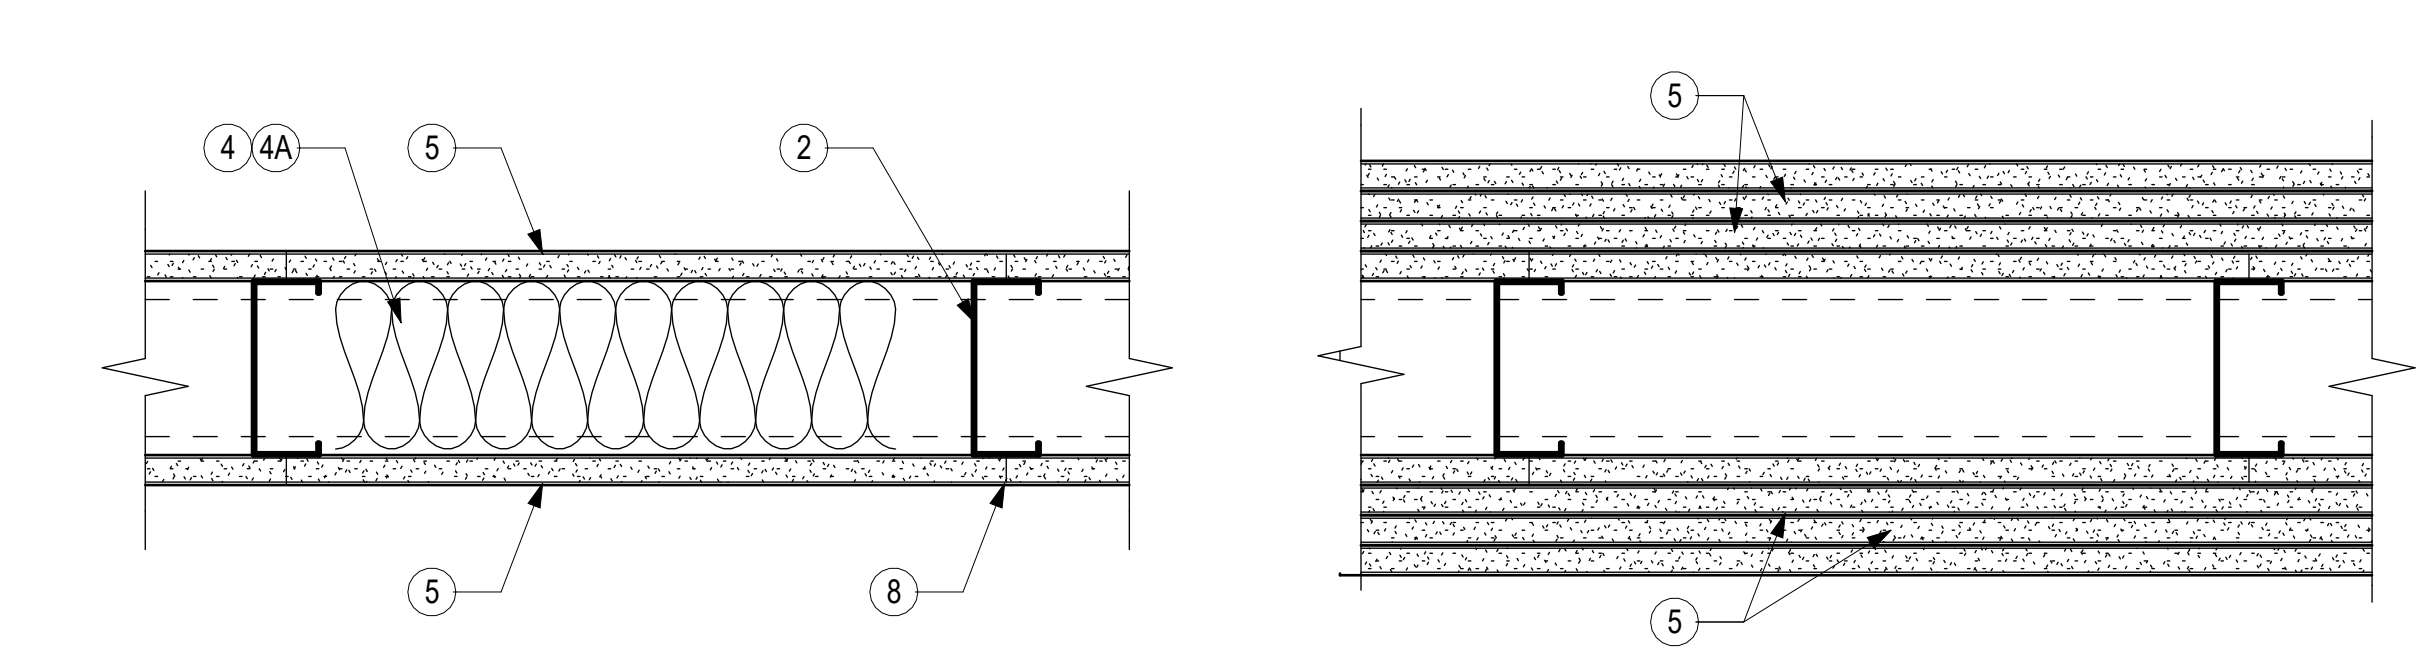

- Floor and Ceiling Runners — (Not shown) — For use with Item 2 - Channel shaped, fabricated from min 25 MSG corrosion-protected steel, min depth to accommodate stud size, with min 1-1/4 in. long legs, attached to floor and ceiling with fasteners 24 in. OC max.
- Framing Members* - Floor and Ceiling Runners — Not shown - In lieu of Item 1 — For use with Item 2A, proprietary channel shaped, min. 3-5/8 in. deep, fabricated from min. 0.015 in. (min bare metal thickness) galvanized steel, attached to floor and ceiling with fasteners 24 in. OC max. Effective thickness is 0.034 in. CLARKDIETRICH BUILDING SYSTEMS — UltraSTEEL®.
- Framing Members* - Floor and Ceiling Runners — (Not shown - In lieu of Item 1) — For use with Item 2A, proprietary channel shaped, min. 2-1/2 in. deep, fabricated from min. 0.015 in. (min bare metal thickness) galvanized steel, attached to floor and ceiling with fasteners 24 in. OC max. Effective thickness is 0.034 in. CLARKDIETRICH BUILDING SYSTEMS — UltraSTEEL®.
- Framing Members* - Floor and Ceiling Runners — Not shown - In lieu of Item 1 — For use with Item 2C, proprietary channel shaped runners, 3-5/8 in. deep attached to floor and ceiling with fasteners 24 in. OC max. CALIFORNIA EXPANDED METAL PRODUCTS CO — ViperTrack™
- CRACO MFG INC — SmartTrack™
MARINOWARE, DIV OF WARE INDUSTRIES
INC — Viper25™ Track
TELLING INDUSTRIES L L C — Viper25™ Track
- Framing Members* - Floor and Ceiling Runners — Not shown - In lieu of Item 1 — For use with Item 2D, proprietary channel shaped runners, 1-1/4 in. wide by 3-5/8 in. deep fabricated from min 0.020 in. thick galv steel, attached to floor and ceiling with fasteners spaced 24 in. OC max.
- CRACO MFG INC — SmartTrack™
MARINOWARE, DIV OF WARE INDUSTRIES
INC — Viper25™ Track
TELLING INDUSTRIES L L C — Viper25™ Track
- CRACO MFG INC — SmartTrack™
MARINOWARE, DIV OF WARE INDUSTRIES
INC — Viper25™ Track
TELLING INDUSTRIES L L C — Viper25™ Track
- Framing Members* - Floor and Ceiling Runners — (Not shown) — In lieu of Item 1 - Channel shaped, attached to floor and ceiling with fasteners 24 in. OC. max. ALLSTEEL & GYPSUM PRODUCTS INC — Type SUPREME Framing System
- CONSOLIDATED FABRICATORS CORP.
BUILDING PRODUCTS DIV — Type SUPREME Framing System
QUAL RUN BUILDING MATERIALS INC — Type SUPREME Framing System
SCAFFO STEEL STUD MANUFACTURING CO — Type SUPREME Framing System
STEEL CONSTRUCTION SYSTEMS INC — Type SUPREME Framing System
UNITED METAL PRODUCTS INC — Type SUPREME Framing System
- Floor and Ceiling Runners — (Not shown)—For use with Item 2B- Channel shaped, fabricated from min 20 MSG corrosion-protected or galv steel, min depth to accommodate stud size, with min 1 in. long legs, attached to floor and ceiling with fasteners spaced max 24 in. OC.
- Framing Members* - Floor and Ceiling Runners — (Not shown, As an alternate to Item 1) — For use with Items 2F, 5F or 5G or 5I only, channel shaped, fabricated from min. 0.015 in. (min bare metal thickness) galvanized steel, attached to floor and ceiling with fasteners 24 in. OC. max.
- CLARKDIETRICH BUILDING SYSTEMS — CD ProTRAK
DMFCOWBS L L C — ProTRAK
MBA BUILDING SUPPLIES — ProTRAK
SOUTHEASTERN STUD & COMPONENTS INC — ProTRAK
TELLING INDUSTRIES L L C — TRUE-TRACK™
- Framing Members* - Floor and Ceiling Runners — Not shown - In lieu of Item 1 — For use with Item 2G, proprietary channel shaped runners, minimum width to accommodate stud size, with 1-1/8 in. long legs fabricated from min 0.015 in. (min bare metal thickness) galv steel, attached to floor and ceiling with fasteners spaced 24 in. OC. max.


- Steel Studs — Channel shaped, fabricated from min 25 MSG corrosion-protected steel, min depth as indicated under Item 5, spaced a max of 24 in. OC. Studs to be cut 3/8 to 3/4 in. less than assembly height.
- Framing Members* - Steel Studs — In lieu of Item 2 - Proprietary channel shaped studs, min. depth as indicated under Item 5, fabricated from min. 0.015 in. (min bare metal thickness) galvanized steel, spaced a max of 24 in. OC. Studs to be cut 3/4 in. less than assembly height. Allowable use of studs is shown in the table below. For direct attachment of gypsum board only. Effective thickness is 0.034 in. CLARKDIETRICH BUILDING SYSTEMS — UltraSTEEL®.
- Steel Studs — (As an alternate to Item 2, For use with Items 5B & 5E) Channel shaped, fabricated from min 20 MSG corrosion-protected or galv steel, 3-1/2 in. min depth, spaced a max of 16 in. OC. Studs friction-fit into floor and ceiling runners. Studs to be cut 5/8 to 3/4 in. less than assembly height.
- Framing Members* - Steel Studs — (As an alternate to Item 2, For use with Items 5C or 5I) - Proprietary channel shaped studs, 3-5/8 in. deep spaced a max of 24 in. OC. Studs to be cut 3/4 in. less than the assembly height and installed with a 1/4 in. gap between the end of the stud and track at the bottom of the wall. For direct attachment of gypsum board only.
- CALIFORNIA EXPANDED METAL PRODUCTS CO — ViperStud™
CRACO MFG INC — SmartStud™
MARINOWARE, DIV OF WARE INDUSTRIES
INC — Viper25™
TELLING INDUSTRIES L L C — Viper25™
- Framing Members* - Metal Studs — Not shown - In lieu of Item 2 — For use with Item 1D, proprietary channel shaped steel studs, min depth as indicated under Item 5, spaced a max of 24 in. OC, fabricated from min 0.020 in. thick galv steel. Studs cut 3/8 in. to 3/4 in. less in lengths than assembly heights.
- MARINOWARE, DIV OF WARE INDUSTRIES
INC — Viper25™
TELLING INDUSTRIES L L C — Viper20™
- Framing Members* — Steel Studs — In lieu of Item 2 - For use with Item 1E- Channel shaped studs, min depth as indicated under Item 5, spaced a max of 24 in. OC. Studs to be cut 3/4 in. less than assembly height.
- ALLSTEEL & GYPSUM PRODUCTS INC — Type SUPREME Framing System
CONSOLIDATED FABRICATORS CORP.
BUILDING PRODUCTS DIV — Type SUPREME Framing System
QUAL RUN BUILDING MATERIALS INC — Type SUPREME Framing System
SCAFFO STEEL STUD MANUFACTURING CO — Type SUPREME Framing System
STEEL CONSTRUCTION SYSTEMS INC — Type SUPREME Framing System
UNITED METAL PRODUCTS INC — Type SUPREME Framing System
- Framing Members* — Steel Studs — (Not shown, As an alternate to Item 2) — For use with Items 1G, 5F or 5G or 5I only, channel shaped studs, min depth as indicated under Item 5F, 5G or 5I, fabricated from min. 0.015 in. (min bare metal thickness) galvanized steel, spaced a max of 24 in. OC. Studs to be cut 3/4 in. less than assembly height.
- CLARKDIETRICH BUILDING SYSTEMS — CD ProSTUD
DMFCOWBS L L C — ProSTUD
MBA BUILDING SUPPLIES — ProSTUD
SOUTHEASTERN STUD & COMPONENTS INC — ProSTUD
TELLING INDUSTRIES L L C — TRUE-STD™
- Framing Members* - Metal Studs — Not shown - In lieu of Item 2 — For use with Item 1H, proprietary channel shaped steel studs, minimum width indicated under Item 5, 1-1/4 in. deep fabricated from min 0.015 in. (min bare metal thickness) galvanized steel. Studs 3/8 in. to 3/4 in. less in lengths than assembly heights.
- Wood Structural Panel Sheathing — (Optional, For use with Item 5 Only) - (Not Shown) - 4 ft wide, 7/16 in. thick oriented strand board (OSB) or 15/32 in. thick structural 1 sheathing (plywood) complying with DOC P51 or PS2, or APA Standard PRP-108, manufactured with exterior glue, applied horizontally or vertically to the steel studs. Vertical joints centered on studs, and staggered one stud space from wallboard joints. Attached to studs with flat-head self-drilling tapping screws with a min. head diam. of 0.292 in. at maximum 6 in. OC, in the perimeter and 12 in. OC in the field. When used, fastener lengths for gypsum panels increased by min. 1/2 in.
- Batts and Blankets* — (Required as indicated under Item 5) — Mineral wool batts, friction fitted between studs and runners. Min nom thickness as indicated under Item 5. See Batts and Blankets (BKNV or BZJZ) Categories for names of Classified companies.
- Batts and Blankets* — (Optional) — Placed in stud cavities, any glass fiber or mineral wool insulation bearing the UL Classification Marking as to Surface Burning Characteristics and/or Fire Resistance. See Batts and Blankets (BKNV or BZJZ) Categories for names of Classified companies.
- Gypsum Board* — Gypsum panels with beveled, square or tapered edges, applied vertically or horizontally. Vertical joints centered over studs and staggered one stud cavity on opposite sides of studs. Vertical joints in adjacent layers (multilayer systems) staggered one stud cavity. Horizontal joints need not be backed by steel framing. Horizontal edge joints and horizontal butt joints on opposite sides of studs need not be staggered. Horizontal edge joints and horizontal butt joints in adjacent layers (multilayer systems) staggered a min of 1/2 in. The thickness and number of layers for the 1 hr, 2 hr, 3 hr and 4 hr ratings are as follows:

Gypsum Board Protection on Each Side of Wall

Rating, Hr	Min Stud Depth, in. Items 2, 2D, 2E, 2G and 2F	Min Stud Depth, in. Item 2A	No. of Layers & Thkns of Panel	Min Thkns of Insulation (Item 4)
1	3-1/2	3-5/8	1 layer, 5/8 in. thick	Optional
1	2-1/2	3-5/8	1 layer, 1/2 in. thick	1-1/2 in.
1	1-5/8	3-5/8	1 layer, 3/4 in. thick	Optional
2	1-5/8	2-1/2	2 layers, 1/2 in. thick	Optional
2	1-5/8	2-1/2	2 layers, 5/8 in. thick	Optional
2	3-1/2	3-5/8	1 layer, 3/4 in. thick	3 in.
3	1-5/8	2-1/2	3 layers, 1/2 in. thick	Optional
3	1-5/8	2-1/2	2 layers, 3/4 in. thick	Optional
3	1-5/8	2-1/2	3 layers, 5/8 in. thick	Optional
4	1-5/8	2-1/2	4 layers, 5/8 in. thick	Optional
4	1-5/8	2-1/2	4 layers, 1/2 in. thick	Optional
4	2-1/2	2-1/2	2 layers, 3/4 in. thick	2 in.



4539 HEDGEMORE DRIVE, SUITE 101
CHARLOTTE NC 28209
704.890.2653
WWW.OSSASTUDIO.COM

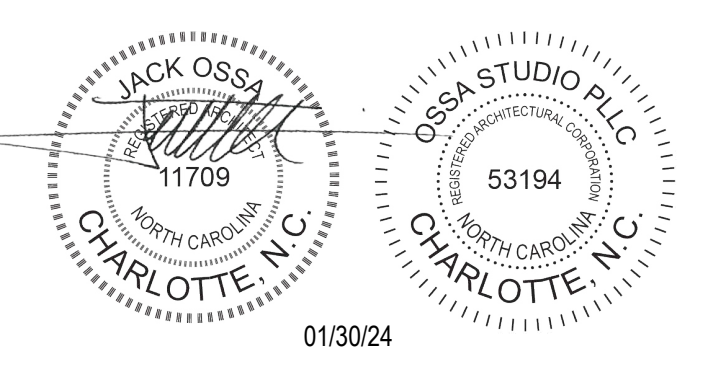

0130/24

PROJECT TEAM

General Contractor
ECCLESIA CONSTRUCTION
www.ecclesiaincconstruction.com
803.327.5670

Civil Engineering
HILLIARD ENGINEERING, PLLC
www.iseacorp.com
919.352.2834

Structural Engineering
PROVIDENCE PARTNERS
www.providencepartnersinc.com
704.266.6621

Mechanical, Electrical, Plumbing & Fire Protection
ENGINECTURE
www.enginecture.com
704.287.2193

Date	Description
01/30/24	FOR CONSTRUCTION

Project Name

community church
making church come alive
658 GRAHAM ROAD
SANFORD NC 27311

Client

3D COMMUNITY CHURCH

Project Number
23024.00

Description
UL PARTITION DETAILS

Scale
NOT TO SCALE


A00.07

© 2024 Ossa Studio



Ossa
STUDIO

4539 HEDGEMORE DRIVE, SUITE 101
CHARLOTTE NC 28209
704.890.2553
WWW.OSSASTUDIO.COM

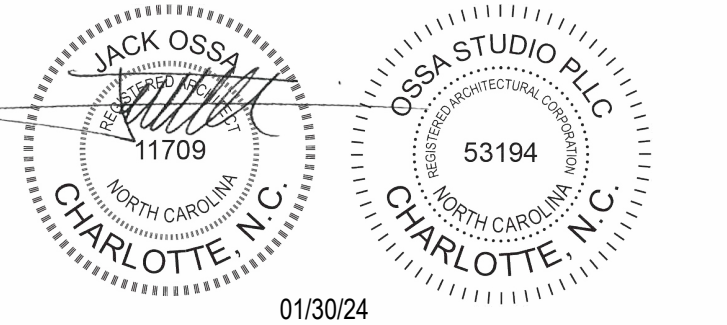

PROJECT TEAM


General Contractor
ECCLESIA CONSTRUCTION
www.ecclesiainc.com
803.327.5670

Civil Engineering
HILLIARD ENGINEERING, PLLC
www.hilliarde.com
919.352.2834


Structural Engineering
PROVIDENCE PARTNERS
www.providencepartnersinc.com
704.266.6621

Mechanical, Electrical, Plumbing & Fire Protection
ENGINEERING
www.engineering.com
704.287.2193

Date	Description
01/30/24	FOR CONSTRUCTION

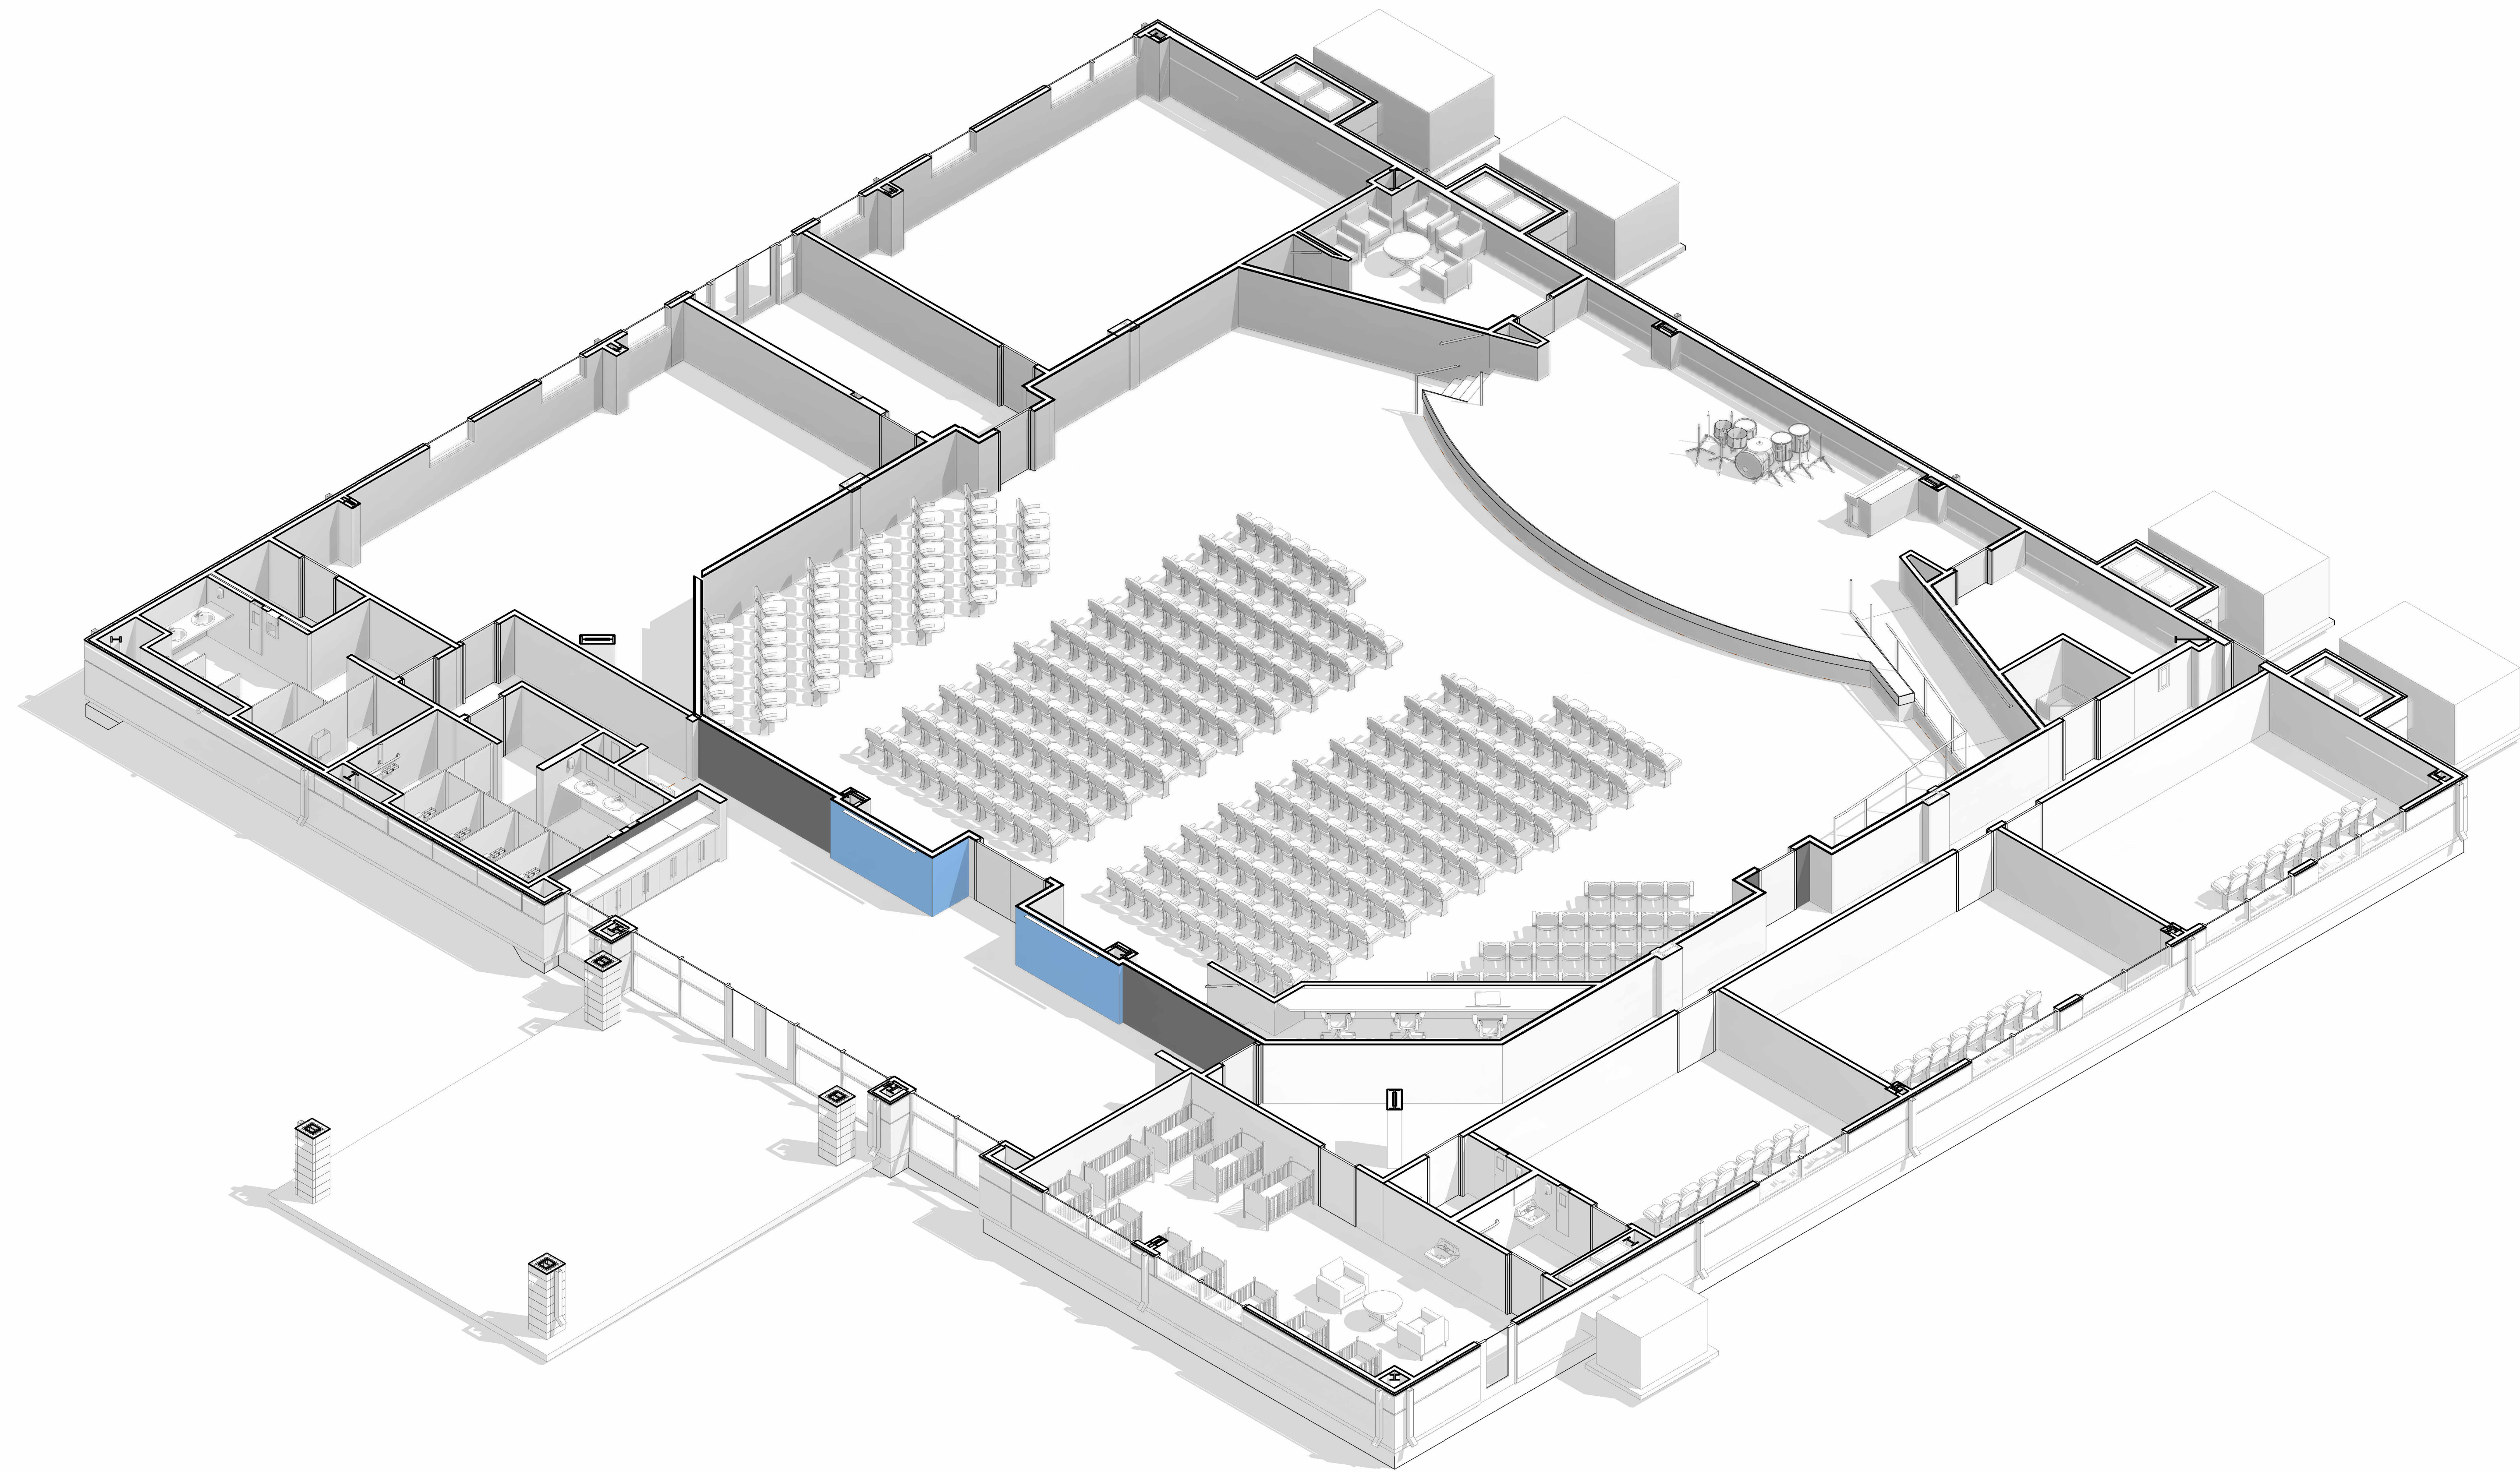

Project Name

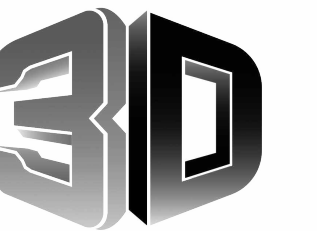

community church
making church come alive
658 GRAHAM ROAD
SANFORD NC 27311

Client

3D COMMUNITY CHURCH

Project Number

23024.00

Description

3D PLAN SECTION


Scale

A01.01



Ossa
STUDIO

4539 HEDGEMORE DRIVE, SUITE 101
CHARLOTTE NC 28209
704.890.2553
WWW.OSSASTUDIO.COM

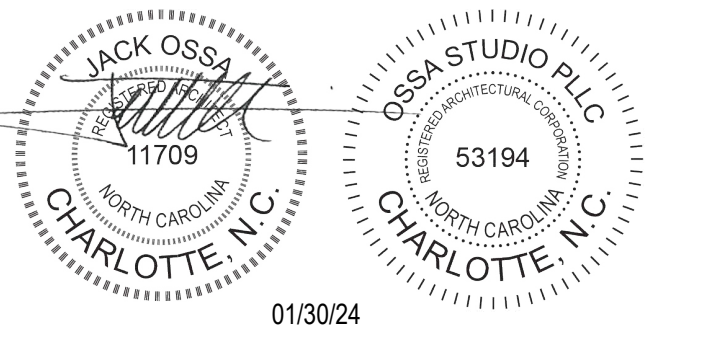

PROJECT TEAM

General Contractor
ECCLESIA CONSTRUCTION
www.ecclesiainc.com
803.327.5670


Civil Engineering
HILLIARD ENGINEERING, PLLC
www.hilliarde.com
919.352.2834

Structural Engineering
PROVIDENCE PARTNERS
www.providencpartnersinc.com
704.266.6621

Mechanical, Electrical, Plumbing & Fire Protection
ENGINEERING
www.engineering.com
704.287.2193

Date	Description
01/30/24	FOR CONSTRUCTION

Project Name

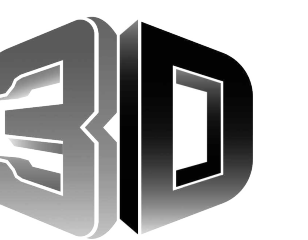

community church
making church come alive
658 GRAHAM ROAD
SANFORD NC 27311

Client

3D COMMUNITY CHURCH

Project Number

23024.00

Description

EXTERIOR RENDERINGS


Scale

A01.02



Ossa
STUDIO

4539 HEDGEMORE DRIVE, SUITE 101
CHARLOTTE NC 28209
704.890.2553
WWW.OSSASTUDIO.COM

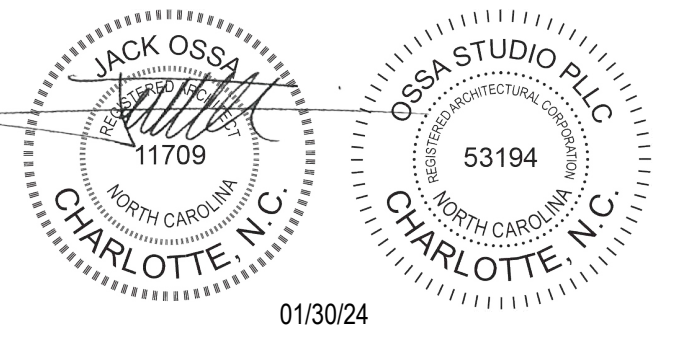

PROJECT TEAM

General Contractor
ECCLESIA CONSTRUCTION
www.ecclesiainc.com
803.327.5670


Civil Engineering
HILLIARD ENGINEERING, PLLC
www.hilliardepp.com
919.352.2834

Structural Engineering
PROVIDENCE PARTNERS
www.providencpartnersinc.com
704.266.6621

Mechanical, Electrical, Plumbing & Fire Protection
ENGINEERING
www.engineer.com
704.287.2193

Date	Description
01/30/24	FOR CONSTRUCTION

Project Name

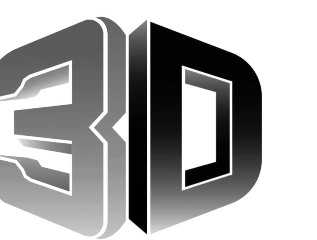

community church
making church come alive

658 GRAHAM ROAD
SANFORD NC 27311

Client

3D COMMUNITY CHURCH

Project Number

23024.00


Description

ARCHITECTURAL SITE PLAN

Scale


3/32" = 1'-0"

A02.00

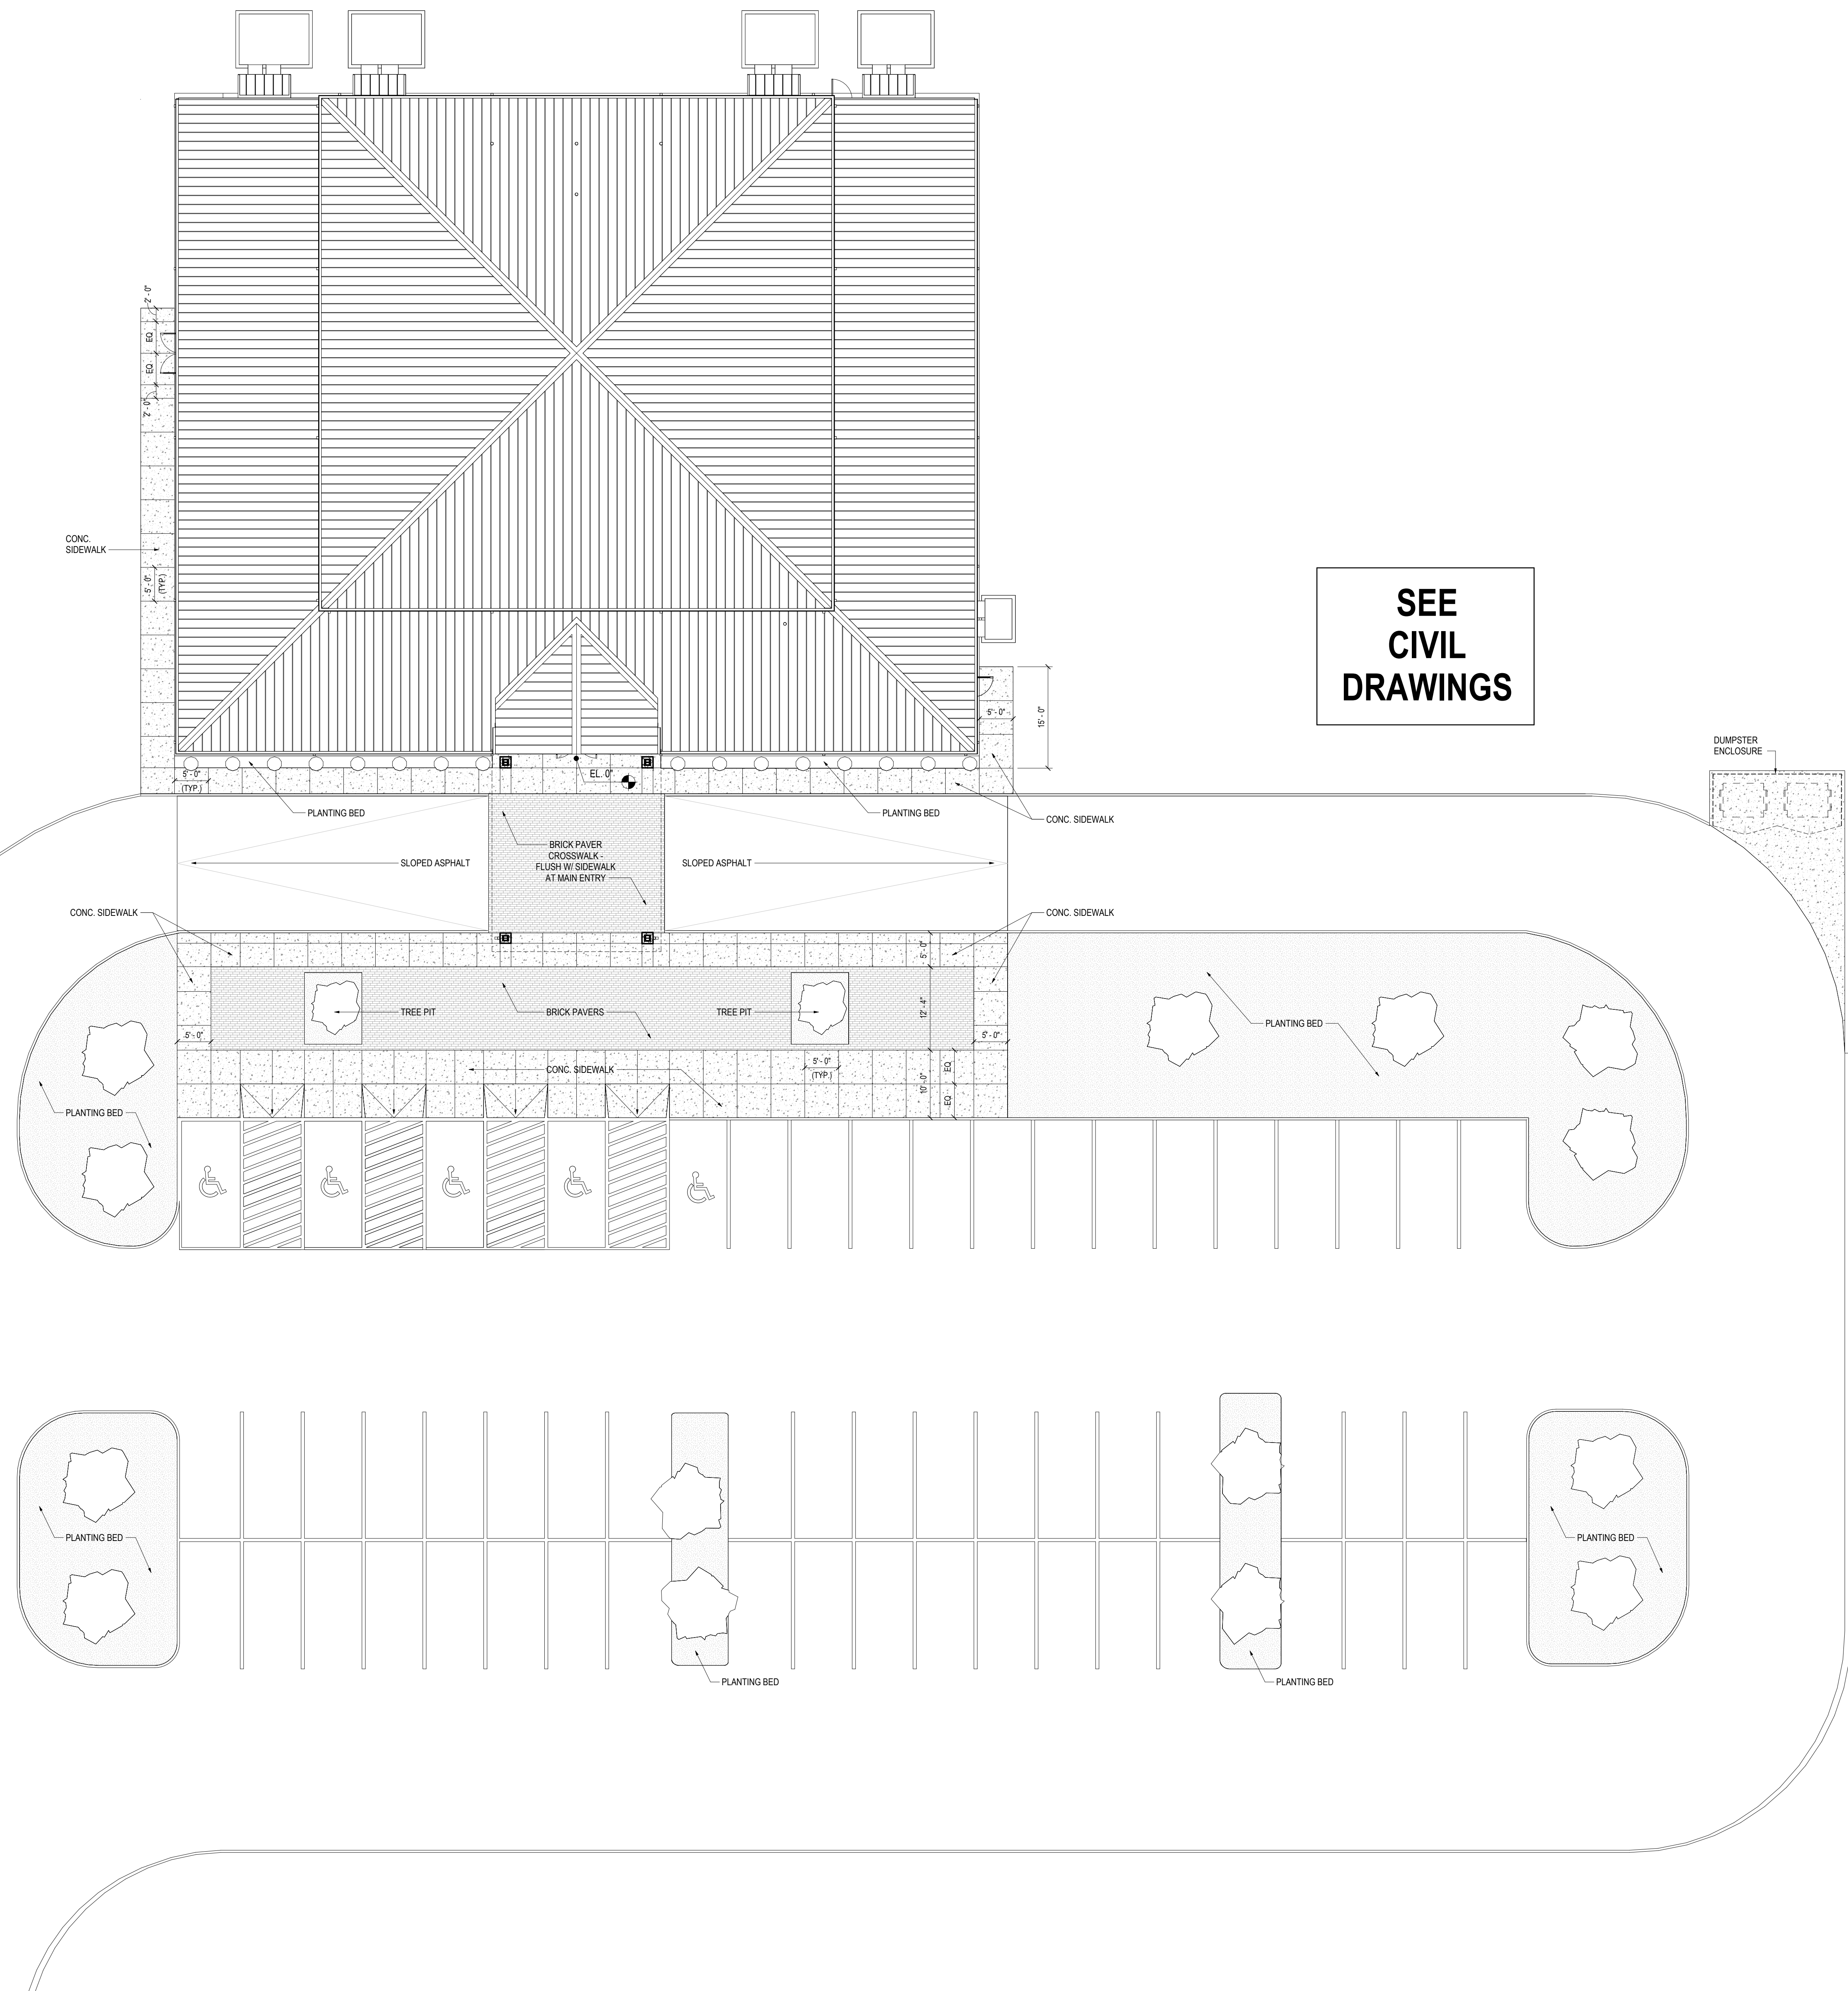

01 ARCHITECTURAL SITE PLAN

SCALE: 3/32" = 1'-0"

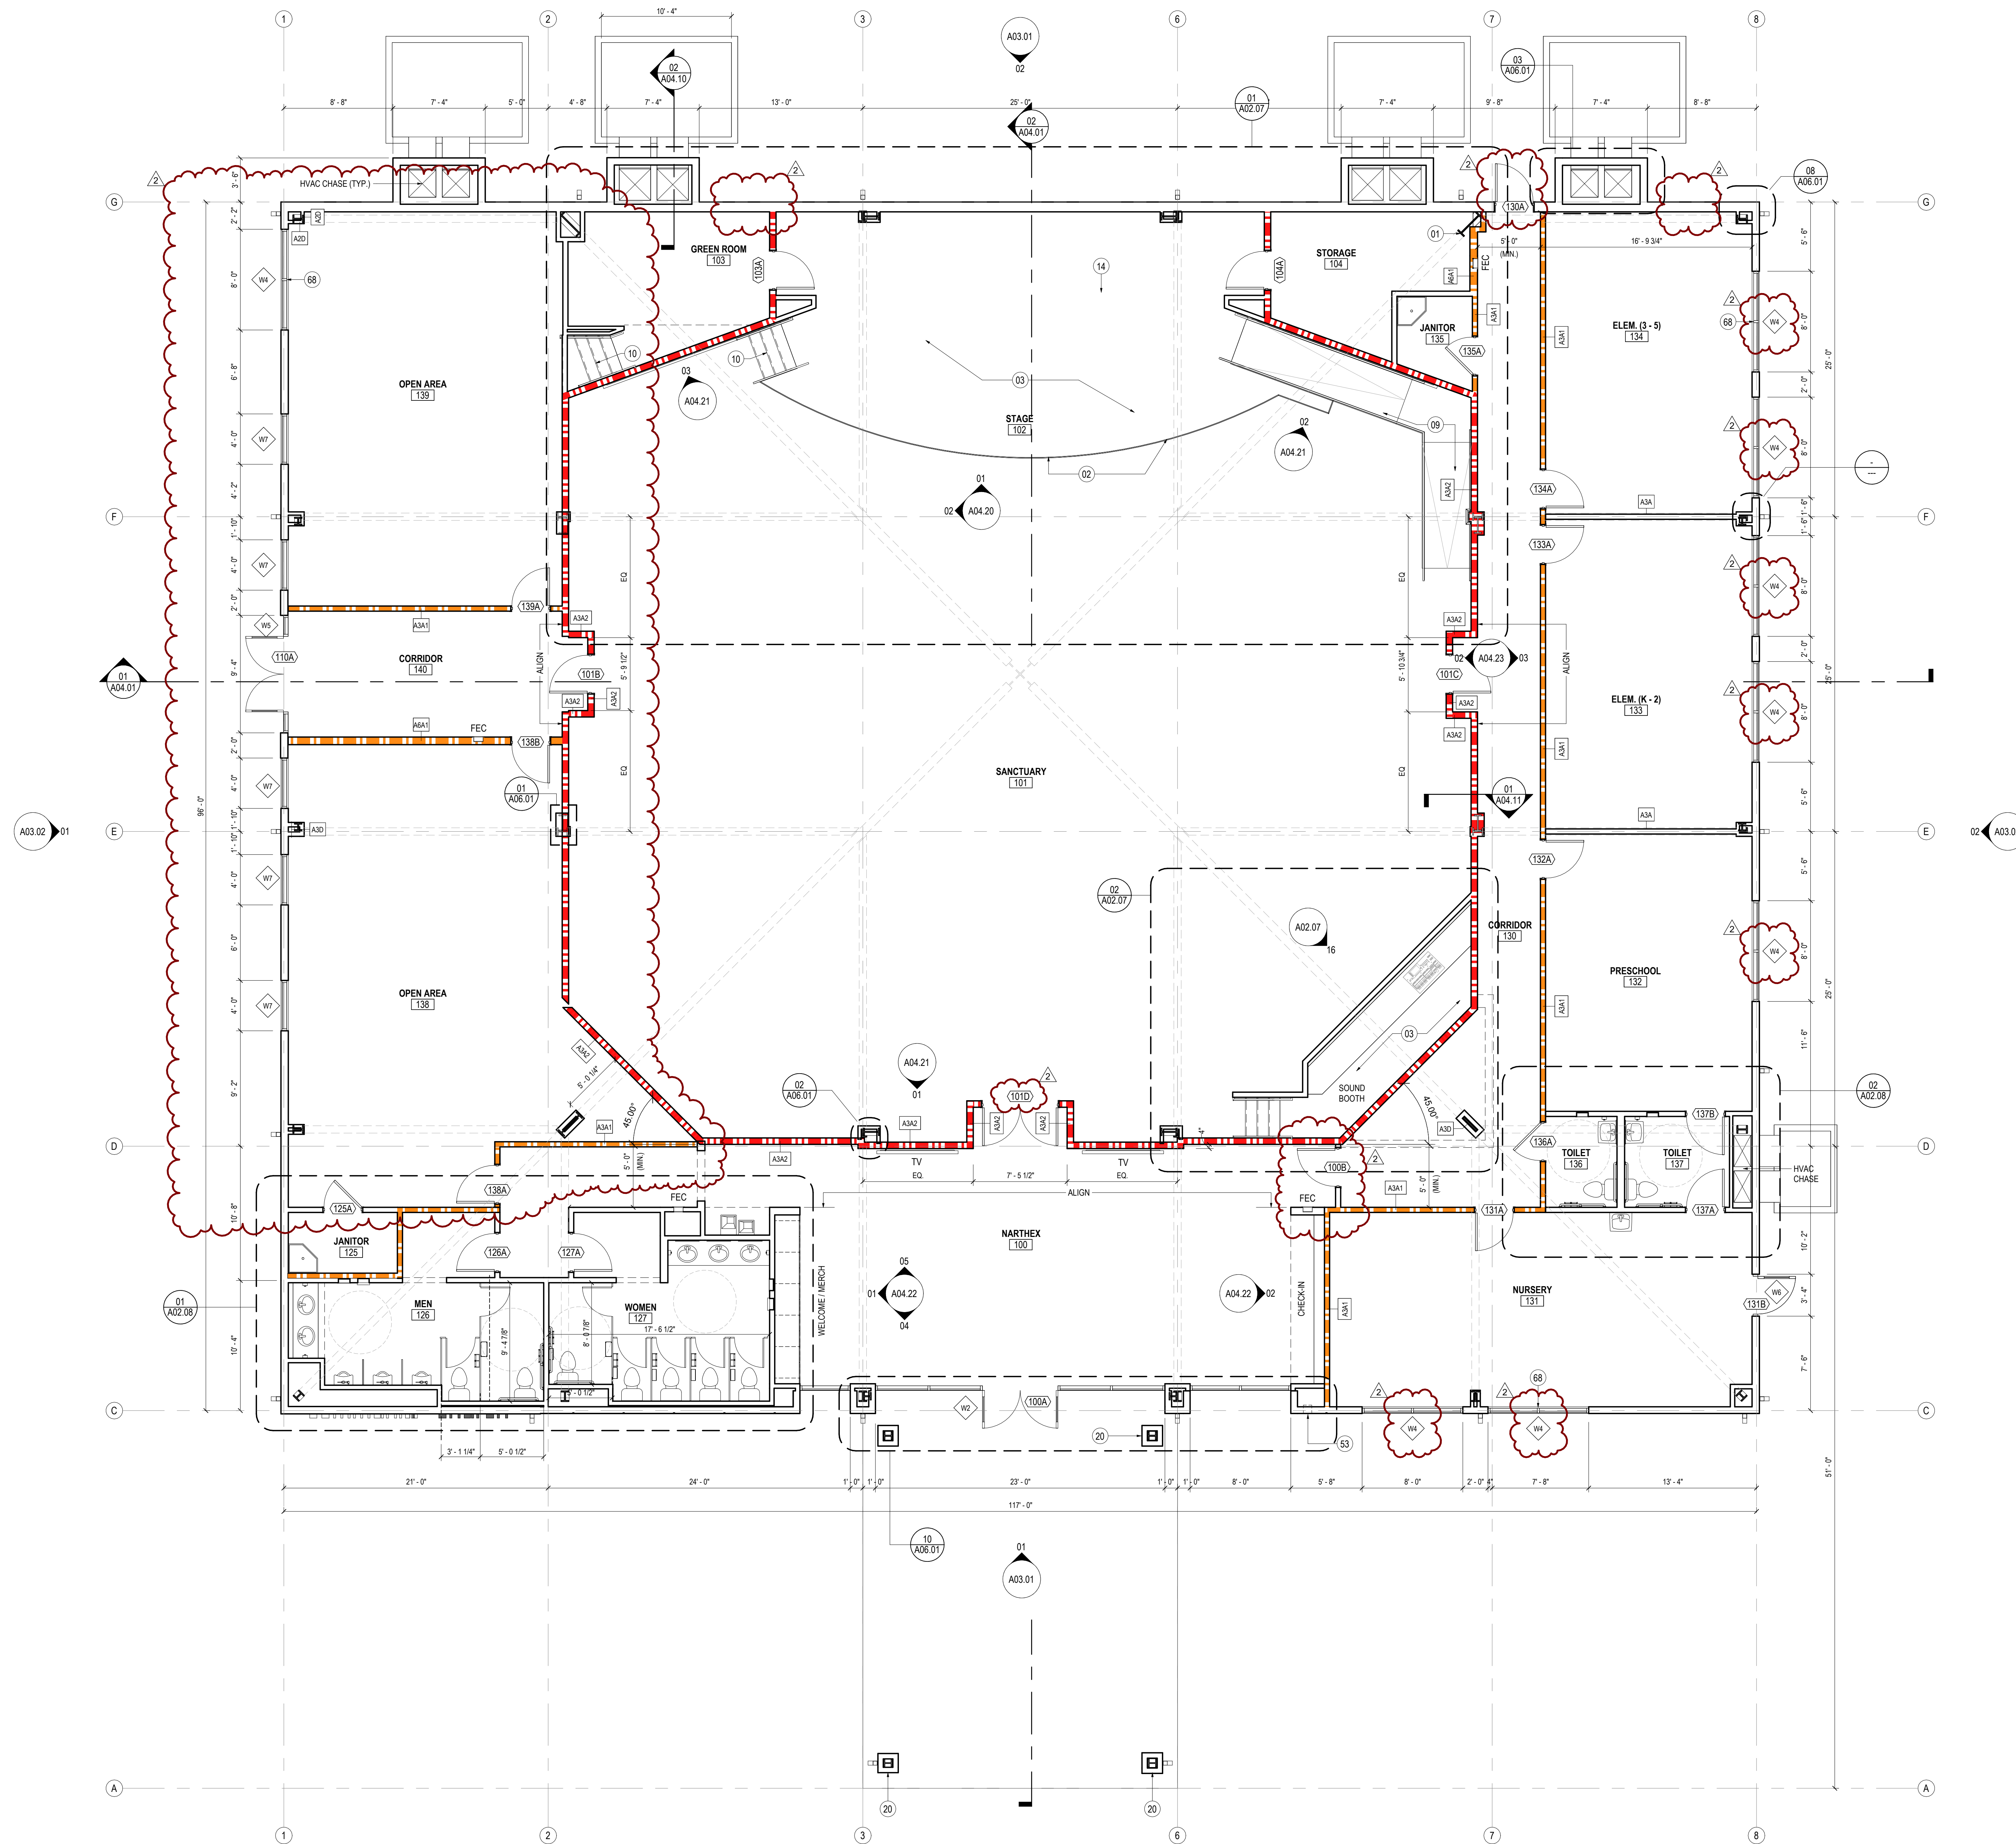

SHEET NOTES

- 01 STRUCT. STL. - PAINT BLACK WHERE EXPOSED
- 02 GWB AND MDF STAGE APRON - PAINT BLACK
- 03 ELEVATED FLOOR w/ LVT FINISH ON 1/4" T. TEMPERED MASONITE, 1/2" HOMASOTE, AND 3/4" FRP PLYWOOD ON MTL. STUD FRAMING (SEE STRUCT.)
- 04 SLOPED GWB "CLOUD" AT UNDERSIDE OF STL. STRUCT.
- 07 MTL. PANEL CEILING SYSTEM MTL. BLDG. MANUF. LIGHTING TRUSS (SEE STRUCT.)
- 08 RAMP w/ LVT FINISH ON (2) LAYERS 3/4" FRP PLYWOOD ON MTL. STUD FRAMING (SEE STRUCT.)
- 09 STAIR w/ LVT FINISH ON (2) LAYERS 3/4" FRP PLYWOOD ON MTL. STUD FRAMING (SEE STRUCT.)
- 11 GWB CONTROL JOINT
- 12 EXPOSED ROOF INSULATION
- 13 MTL. Z PURLIN (TYP.)
- 14 SUSPENDED PROJECTION SCREEN
- 15 LED CYLINDER PENDANT LIGHT FIXTURE (TYP.) (SEE ELEC.)
- 16 LED WALL SCONCE LIGHT FIXTURE (TYP.) (SEE ELEC.)
- 17 RECTANGULAR BEAM LED LIGHT FIXTURE (TYP.) (SEE ELEC.)
- 18 RECESSED LED LIGHT FIXTURE (TYP.) (SEE ELEC.)
- 20 8"x16"x4" CMU (PROVIDE TIES PER MANUF. REQS.) ON MTL. STUD FURRING AT STL. COLUMN
- 21 E.I.F.S. - 1-1/2" R-7.5 RIGID INSUL. AND 5/8" SHEATHING ON 3-5/8" MTL. STUD FRAMING W/ R-13 BLANKET INSUL.
- 22 REVEAL (TYP.)
- 23 8"x16"x4" CMU (PROVIDE TIES PER MANUF. REQS.) W/ 1-1/2" AIR SPACE, 2" RIGID INSUL., AND 5/8" SHEATHING ON 3-5/8" MTL. STUD FRAMING
- 24 STANDING SEAM MTL. ROOF (OWNER FURNISHED)
- 25 CONT. R-11 VINYL-FACED BLANKET INSUL ON R-3 THERMAL SPACER BLOCKS (THERMAL SPACER BLOCKS TYP. AT EA. PURLIN)
- 26 R-19 FIBERGLASS BLANKET INSUL. BET. PURLINS (PROVIDE LONGITUDINAL AND TRANSVERSE MTL. SUPPORT BANDING)
- 27 CONT. BLACK FIBER-REINFORCED VAPOR BARRIER MEMBRANE AT BOTTOM OF PURLINS
- 28 GUTTER AND FLASHING BY MTL. BLDG. MANUF.
- 29 DOWNSPOUTS BY MTL. BLDG. MANUF. (TYP.)
- 31 3/8" T. x 24" D. CLEAR TEMPERED GLASS SHELVES (TYP.)
- 32 ADJUSTABLE SHELF BRACKETS & FLUSH-MOUNTED SHELF TRACKS (TYP.)
- 33 RAKES INSIDE WALL MOUNT EH COUNTER SUPPORT BRACKETS
- 34 OPEN TO UPPER ROOF ABOVE
- 35 MTL. C PURLIN BY MTL. BLDG. MANUF.
- 36 PRE-FIN. COUNTER FLASHING
- 37 TIE-IN TRIM BY MTL. BLDG. MANUF.
- 38 BACK-UP PLATE BY MTL. BLDG. MANUF.
- 39 OUTSIDE MTL. CLOSURE BY MTL. BLDG. MANUF.
- 41 STL. SPANREL ANGLE AT BOTTOM OF MTL. Z PURLINS BY MTL. BLDG. MANUFACTURER
- 42 COMPRESSIBLE FILLER
- 43 NEW CONC. SIDEWALK
- 44 ALUM. DOOR AS SCHEDULED
- 45 DOOR THRESHOLD AS SCHEDULED - SET ON FULL BED OF MASTIC
- 46 TURNED-DOWN CONC. SLAB (SEE STRUCT.)
- 47 STRUCT. STL. COLUMN
- 48 STRUCT. STL. MOMENT FRAME - PAINT BLACK WHERE EXPOSED
- 49 SOUND ATTENUATION BLANKET (TYP.)
- 51 LINEAR SLOT RETURN (SEE MECH.)
- 52 MTL. SUPPORT BANDING - SPACE AS DIMENSIONED ON ENLARGED RCP (TYP.)
- 53 UNHINGED / RECESSED KNOXBOX (ALUM. FIN.)
- 54 FLUID-APPLIED AIR BARRIER MEMBRANE
- 55 JOINT SEALANT AND BACKER ROD
- 56 ALUM. STOREFRONT SYSTEM
- 57 E.I.F.S. - 1-1/2" R-7.5 RIGID INSUL. AND 5/8" SHEATHING ON 6" MTL. STUD FRAMING W/ R-13 BLANKET INSUL.
- 59 E.I.F.S. DRAINABLE TRACK
- 60 THRU-WALL STAINLESS STL. FLASHING W/ DRIP EDGE - FLASHED INTO AIR AND WATER BARRIER MEMBRANE
- 61 R-19 FIBERGLASS BLANKET INSUL. BET. MTL. STUD FRAMING (PROVIDE LONGITUDINAL AND TRANSVERSE MTL. SUPPORT BANDING)
- 62 STANDING SEAM MTL. ROOF (OWNER FURNISHED) ON 3/4" FRP PLYWOOD ON 6" MTL. STUD FRAMING
- 68 ROLLERSHADE AT EA. EXT. WINDOW (TYP.)
- 69 EAVE TRIM, PANEL CAP TRIM, AND FLASHING BY MTL. BLDG. MANUF.
- 70 MTL. STUD BRACE (SEE STRUCT.)

GENERAL NOTES


- A DO NOT SCALE DRAWINGS. WRITTEN DIMENSIONS GOVERN. IN CASE OF CONFLICT, NOTIFY ARCHITECT PRIOR TO PARTITION INSTALLATION.
- B PROVIDE MINBLINDS AT ALL EXTERIOR WINDOWS
- C ALL DIMENSIONS AND ALIGNMENTS ARE TO FINISHED FACE OF WALL, INCLUDING FINISHED FACE OF MILLWORK PANELING WHERE OCCURS
- D PROVIDE FIRE RETARDANT TREATED 3/4" PLYWOOD BLOCKING AS REQUIRED FOR: WALL HUNG MILLWORK AND EQUIPMENT
- E ALL FINISHES TO MEET NCSCB CHAPTER 8 TABLE 803.11 INTERIOR WALL AND CEILING REQUIREMENTS BY OCCUPANCY

WALL LEGEND

- 1 HR. RATED PARTITION - UL419
- 2 HR. RATED PARTITION - UL419



4539 HEDGEMORE DRIVE, SUITE 101
CHARLOTTE NC 28209
704.890.2653
WWW.OSSASTUDIO.COM

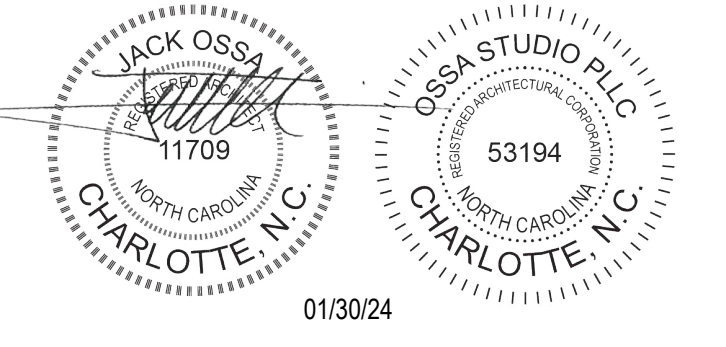

PROJECT TEAM

- General Contractor**
ECCLESIA CONSTRUCTION
www.ecclesiainc.com
803.327.5670
- Civil Engineering**
HILLIARD ENGINEERING, PLLC
www.hilliardepp.com
919.352.2834
- Structural Engineering**
PROVIDENCE PARTNERS
www.providencpartnersinc.com
704.266.6621
- Mechanical, Electrical, Plumbing & Fire Protection**
ENGINEERING
www.engineering.com
704.287.2193

Date	Description
01/30/24	FOR CONSTRUCTION
05/8/24	PERMIT REVIEW COMMENTS
10/14/24	RTAP NO. 1

Project Name

community church
making church come alive

658 GRAHAM ROAD
SANFORD NC 27311

Client

3D COMMUNITY CHURCH

Project Number

23024.00


Description

CONSTRUCTION PLAN

Scale

As indicated

A02.01

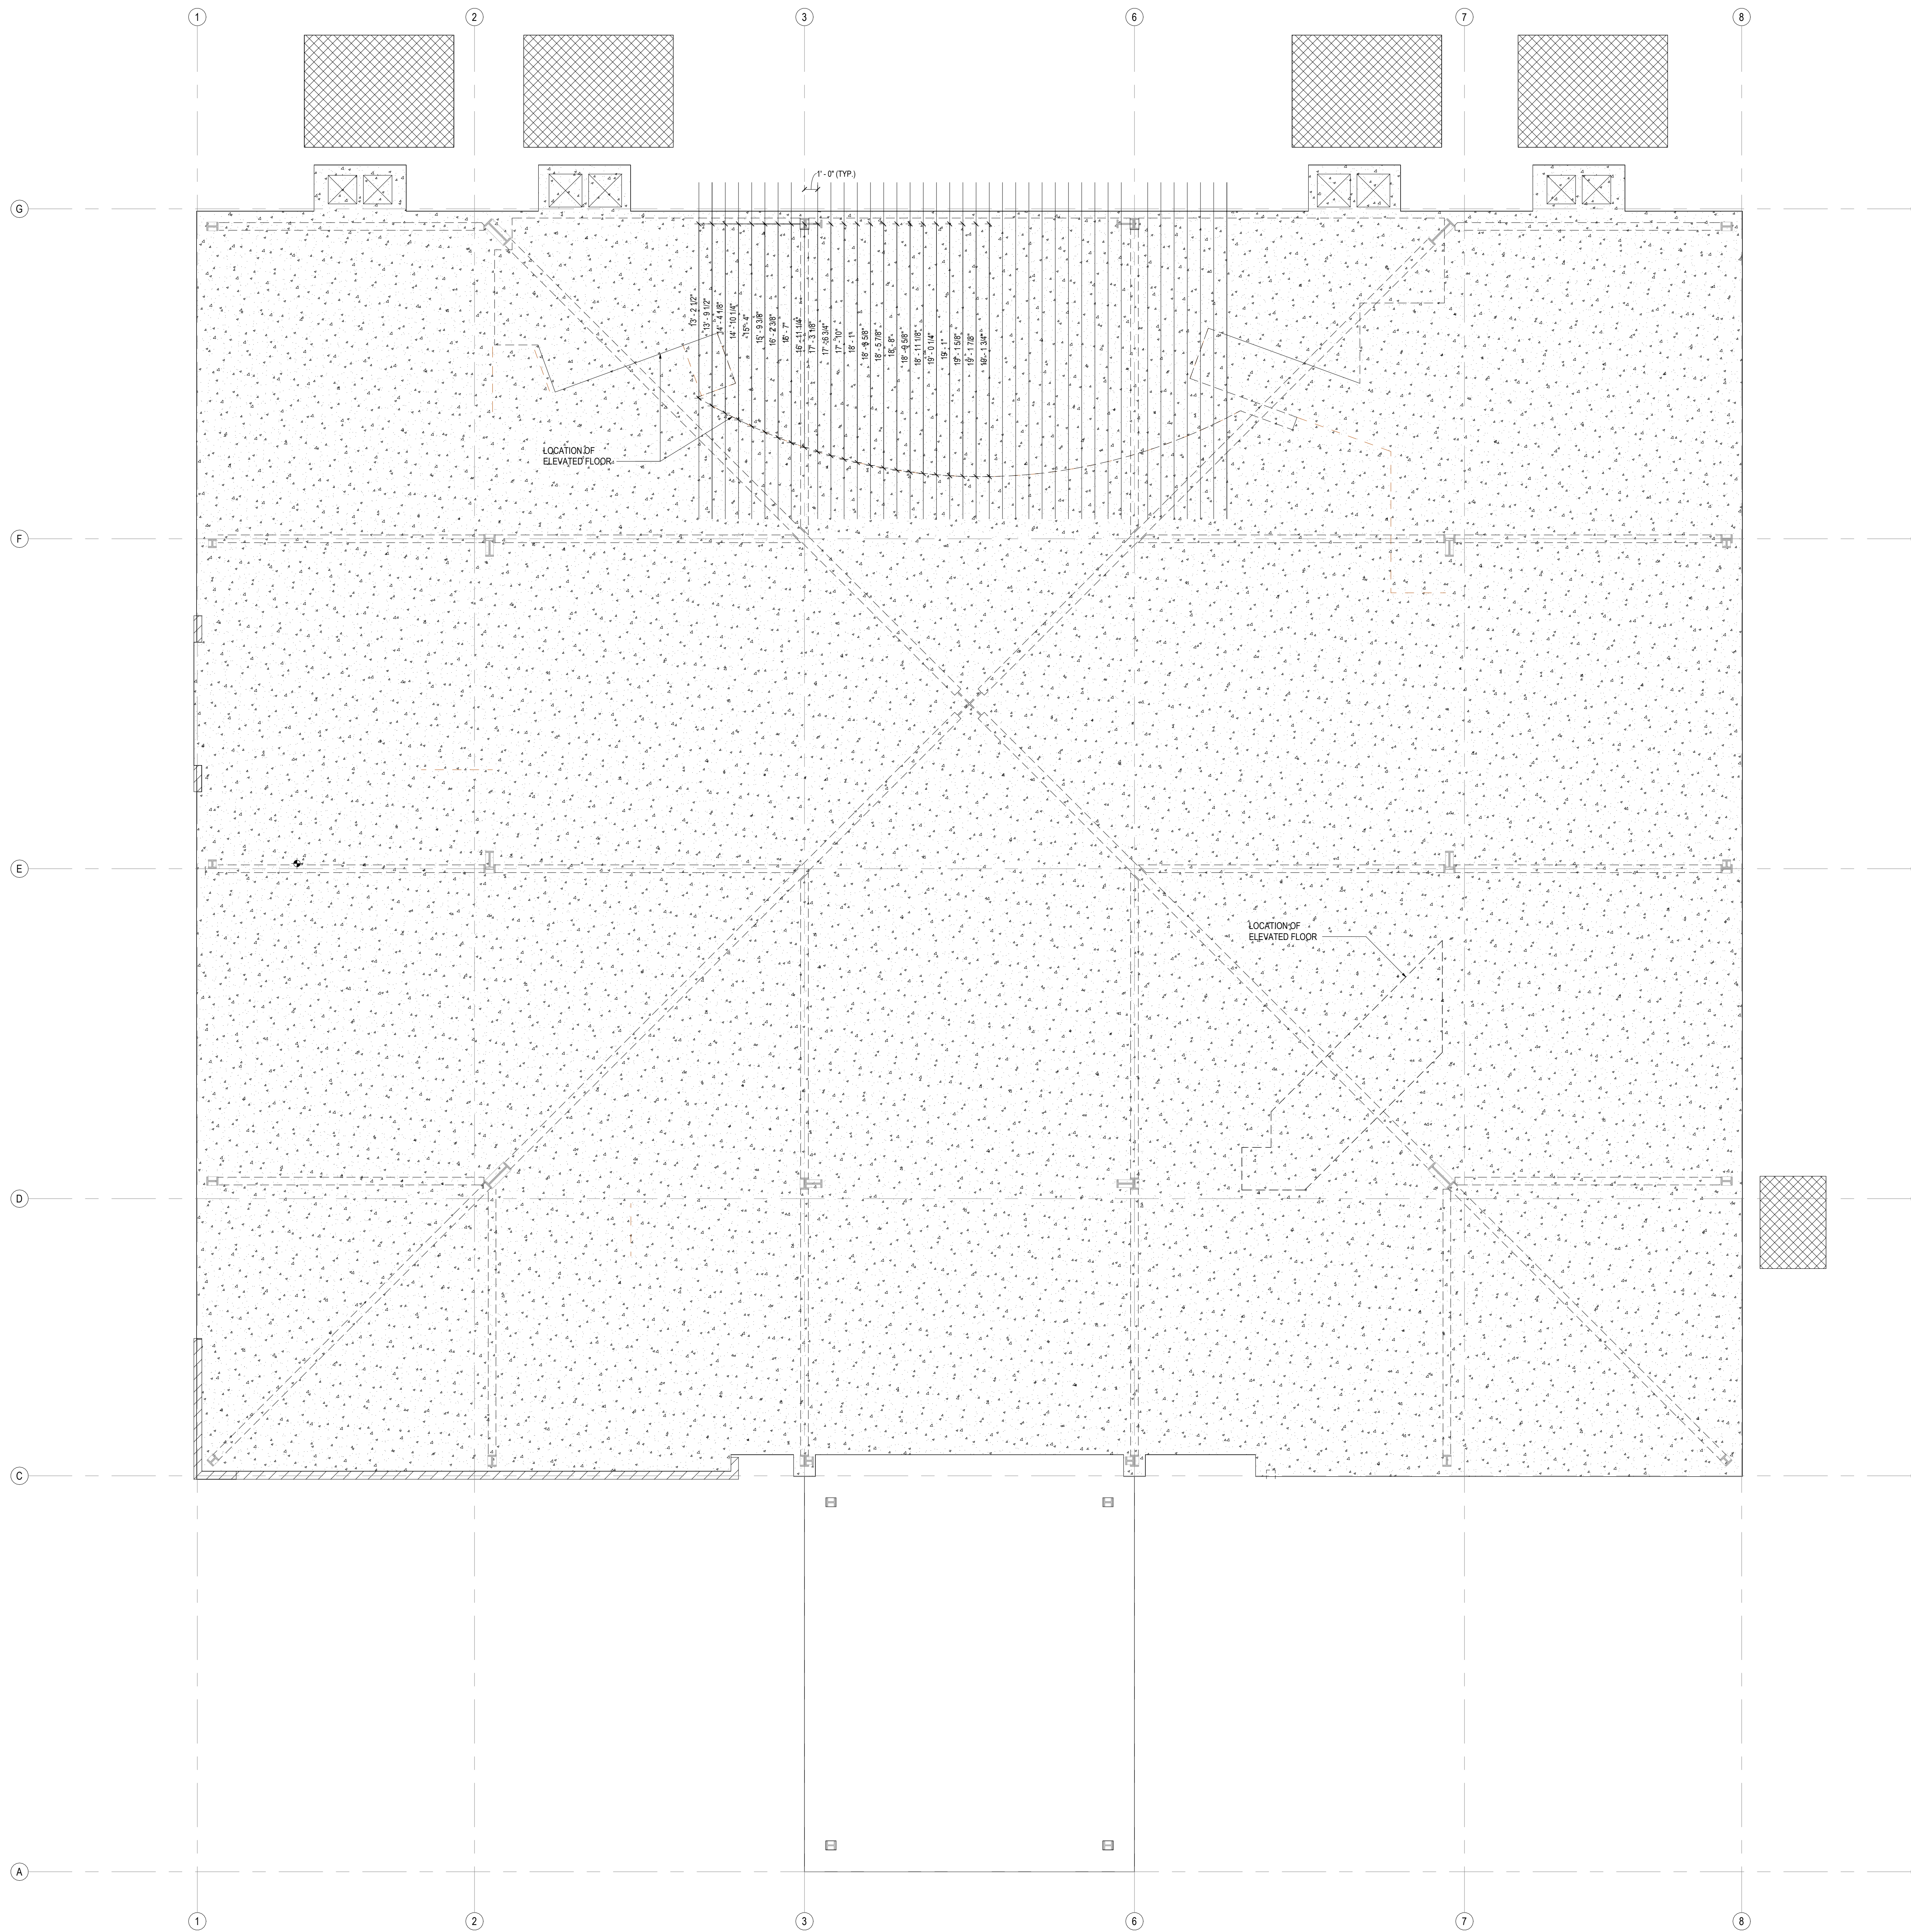

SHEET NOTES


- 01 STRUCT. STL. - PAINT BLACK WHERE EXPOSED
- 02 GWB AND MDF STAGE APRON - PAINT BLACK
- 03 ELEVATED FLOOR w/ LVT FINISH ON 1/4" T. TEMPERED MASONITE, 1/2" HOMASOTE, AND 3/4" FRP PLYWOOD ON MTL. STUD FRAMING (SEE STRUCT.)
- 04 SLOPED GWB "CLOUD" AT UNDERSIDE OF STL. STRUCT.
- 07 MTL. PANEL CEILING SYSTEM MTL. BLDG. MANUF.
- 08 LIGHTING TRUSS (SEE STRUCT.)
- 09 RAMP w/ LVT FINISH ON (2) LAYERS 3/4" FRP PLYWOOD ON MTL. STUD FRAMING (SEE STRUCT.)
- 10 STAIR w/ LVT FINISH ON (2) LAYERS 3/4" FRP PLYWOOD ON MTL. STUD FRAMING (SEE STRUCT.)
- 11 GWB CONTROL JOINT
- 12 EXPOSED ROOF INSULATION
- 13 MTL. Z PURLIN (TYP.)
- 14 SUSPENDED PROJECTION SCREEN
- 15 LED CYLINDER PENDANT LIGHT FIXTURE (TYP.) (SEE ELEC.)
- 16 LED WALL SCONCE LIGHT FIXTURE (TYP.) (SEE ELEC.)
- 17 RECTANGULAR BEAM LED LIGHT FIXTURE (TYP.) (SEE ELEC.)
- 18 RECESSED LED LIGHT FIXTURE (TYP.) (SEE ELEC.)
- 20 8"x16"x4" CMU (PROVIDE TIES PER MANUF. REQS.) ON MTL. STUD FURRING AT STL. COLUMN
- 21 E.F.S. - 1-1/2" R-7.5 RIGID INSUL. AND 5/8" SHEATHING ON 3/8" MTL. STUD FRAMING W/ R-13 BLANKET INSUL.
- 22 REVEAL (TYP.)
- 23 8"x16"x4" CMU (PROVIDE TIES PER MANUF. REQS.) W/ 1-1/2" AIR SPACE, 2" RIGID INSUL., AND 5/8" SHEATHING ON 3/8" MTL. STUD FRAMING
- 24 STANDING SEAM MTL. ROOF (OWNER FURNISHED)
- 25 CONT. R-11 VINYL-FACED BLANKET INSUL ON R-3 THERMAL SPACER BLOCKS (THERMAL SPACER BLOCKS TYP. AT EA. PURLIN)
- 26 R-19 FIBERGLASS BLANKET INSUL. BET. PURLINS (PROVIDE LONGITUDINAL AND TRANSVERSE MTL. SUPPORT BANDING)
- 27 CONT. BLACK FIBER-REINFORCED VAPOR BARRIER MEMBRANE AT BOTTOM OF PURLINS
- 28 GUTTER AND FLASHING BY MTL. BLDG. MANUF.
- 29 DOWNSPOUTS BY MTL. BLDG. MANUF. (TYP.)
- 31 3/8" T. x 24" D. CLEAR TEMPERED GLASS SHELVES (TYP.)
- 32 ADJUSTABLE SHELF BRACKETS & FLUSH-MOUNTED SHELF TRACKS (TYP.)
- 33 RAKES INSIDE WALL MOUNT EH COUNTER SUPPORT BRACKETS
- 34 OPEN TO UPPER ROOF ABOVE
- 35 MTL. C PURLIN BY MTL. BLDG. MANUF.
- 36 PRE-FIN. COUNTER FLASHING
- 37 TIE-IN TRIM BY MTL. BLDG. MANUF.
- 38 BACK-UP PLATE BY MTL. BLDG. MANUF.
- 39 OUTSIDE MTL. CLOSURE BY MTL. BLDG. MANUF.
- 41 STL. SPANDREL ANGLE AT BOTTOM OF MTL. Z PURLINS BY MTL. BLDG. MANUFACTURER
- 42 COMPRESSIBLE FILLER
- 43 NEW CONC. SIDEWALK
- 44 ALUM. DOOR AS SCHEDULED
- 45 DOOR THRESHOLD AS SCHEDULED - SET ON FULL BED OF MASTIC
- 46 TURNED-DOWN CONC. SLAB (SEE STRUCT.)
- 47 STRUCT. STL. COLUMN
- 48 STRUCT. STL. MOMENT FRAME - PAINT BLACK WHERE EXPOSED
- 49 SOUND ATTENUATION BLANKET (TYP.)
- 51 LINEAR SLOT RETURN (SEE MECH.)
- 52 MTL. SUPPORT BANDING - SPACE AS DIMENSIONED ON ENLARGED RCP (TYP.)
- 53 UNHINGED / RECESSED KNOXBOX (ALUM. FIN.)
- 54 FLUID-APPLIED AIR BARRIER MEMBRANE
- 55 JOINT SEALANT AND BACKER ROD
- 56 ALUM. STOREFRONT SYSTEM
- 57 E.F.S. - 1-1/2" R-7.5 RIGID INSUL. AND 5/8" SHEATHING ON 6" MTL. STUD FRAMING W/ R-13 BLANKET INSUL.
- 59 E.F.S. DRAINABLE TRACK
- 60 THRU-WALL STAINLESS STL. FLASHING W/ DRIP EDGE - FLASHED INTO AIR AND WATER BARRIER MEMBRANE
- 61 R-19 FIBERGLASS BLANKET INSUL. BET. MTL. STUD FRAMING (PROVIDE LONGITUDINAL AND TRANSVERSE MTL. SUPPORT BANDING)
- 62 STANDING SEAM MTL. ROOF (OWNER FURNISHED) ON 3/4" FRP PLYWOOD ON 6" MTL. STUD FRAMING
- 68 ROLLERSHADE AT EA. EXT. WINDOW (TYP.)
- 69 EAVE TRIM, PANEL CAP TRIM, AND FLASHING BY MTL. BLDG. MANUF.
- 70 MTL. STUD BRACE (SEE STRUCT.)

LEGEND

- CONC. SLAB - FINISH FLOOR (0'-0") (SEE STRUCT. DWGS.)
- BRICK SUPPORT LEDGE (0'-8") (SEE STRUCT. DWGS.)
- MECH / ELEC. SLAB (SEE STRUCT. DWGS.)
- SLAB CORE FOR ELEC. OUTLET



4539 HEDGEMORE DRIVE, SUITE 101
CHARLOTTE NC 28209
704.890.2653
WWW.OSSASTUDIO.COM

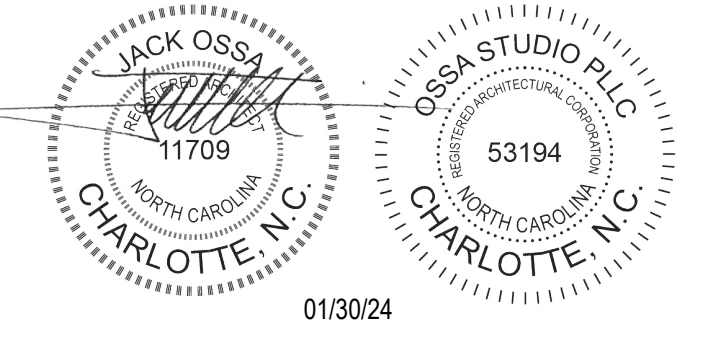

PROJECT TEAM

- General Contractor**
ECCLESIA CONSTRUCTION
www.ecclesiainc.com
803.327.5670
- Civil Engineering**
HILLIARD ENGINEERING, PLLC
www.hilliardepp.com
919.352.2834
- Structural Engineering**
PROVIDENCE PARTNERS
www.providencpartnersinc.com
704.266.6621
- Mechanical, Electrical, Plumbing & Fire Protection**
ENGINEERING
www.engineering.com
704.287.2193

Date	Description
10/30/24	FOR CONSTRUCTION

3D
community church
making church come *alive*
658 GRAHAM ROAD
SANFORD NC 27311


Client
3D COMMUNITY CHURCH

Project Number
23024.00

Description
SLAB PLAN

Scale
As indicated

A02.02

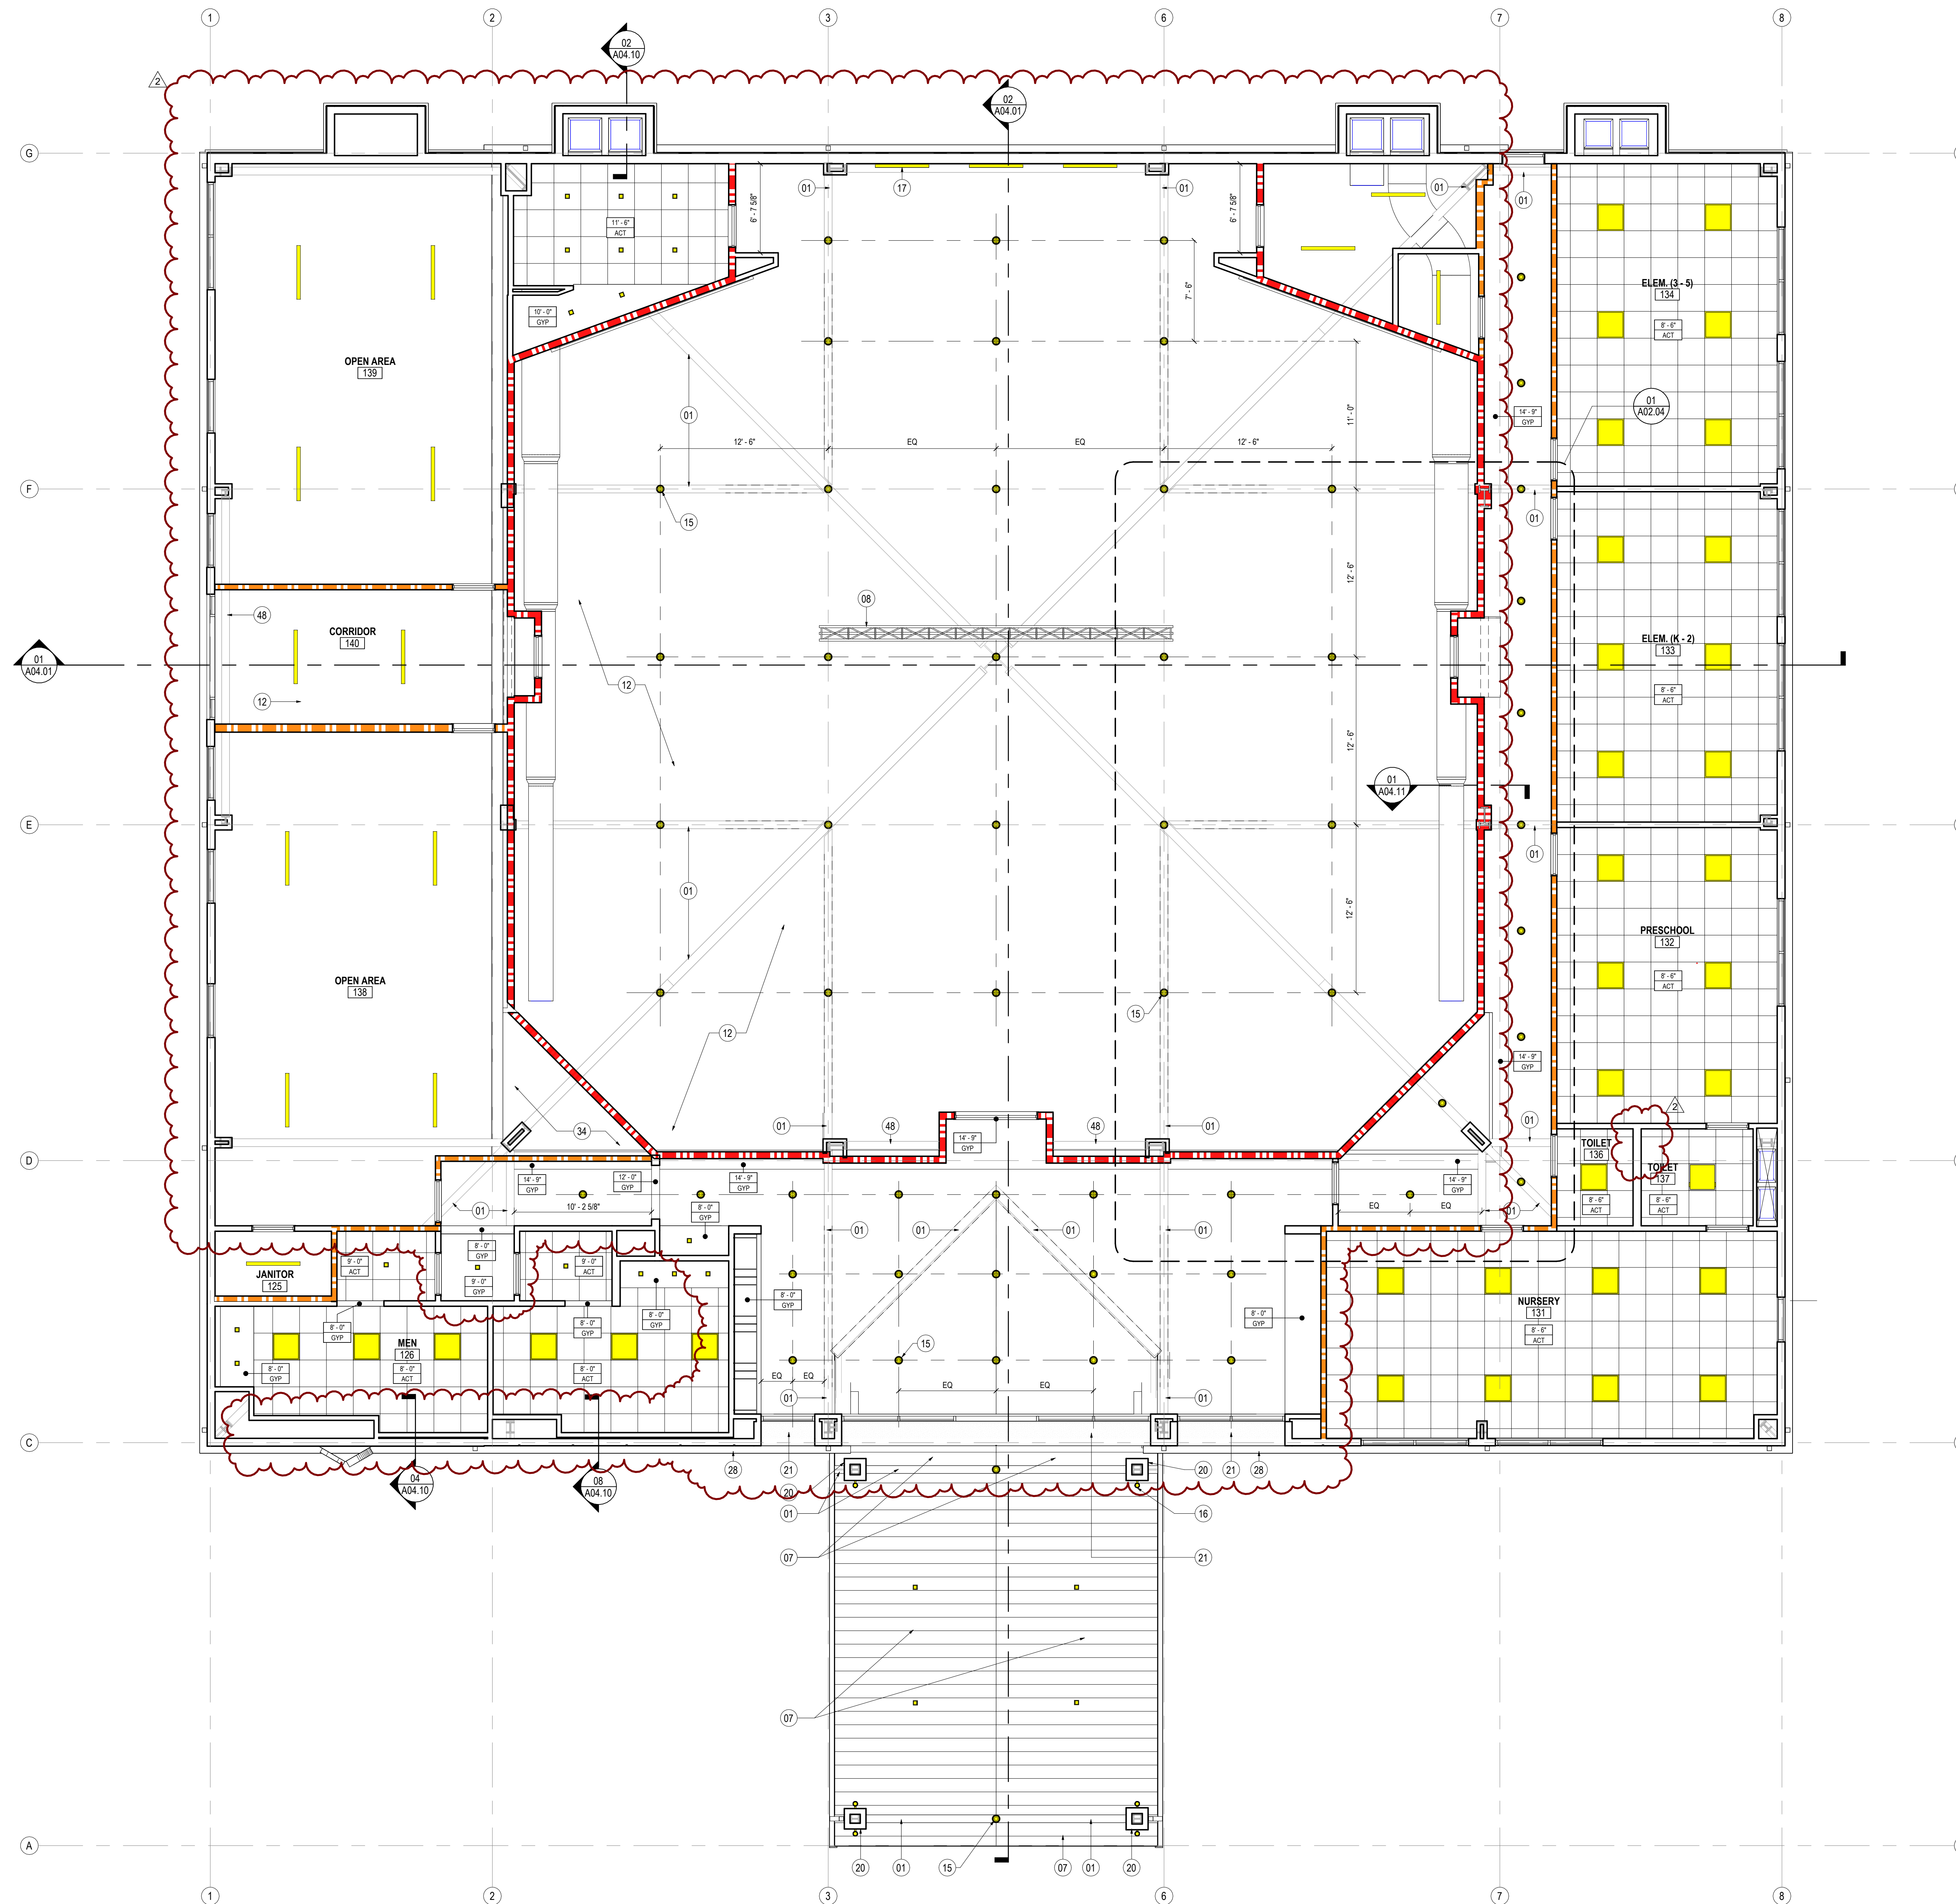


SHEET NOTES

- 01 STRUCT. STL. - PAINT BLACK WHERE EXPOSED
- 02 GWB AND MDF STAGE APRON - PAINT BLACK
- 03 ELEVATED FLOOR w/ LVT FINISH ON 1/4" T. TEMPERED MASONITE, 1/2" HOMASOTE, AND 3/4" FRP PLYWOOD ON MTL. STUD FRAMING (SEE STRUCT.)
- 04 SLOPED GWB "CLOUD" AT UNDERSIDE OF STL. STRUCT.
- 07 MTL. PANEL CEILING SYSTEM MTL. BLDG. MANUF.
- 08 LIGHTING TRUSS (SEE STRUCT.)
- 09 RAMP w/ LVT FINISH ON (2) LAYERS 3/4" FRP PLYWOOD ON MTL. STUD FRAMING (SEE STRUCT.)
- 10 STAIR w/ LVT FINISH ON (2) LAYERS 3/4" FRP PLYWOOD ON MTL. STUD FRAMING (SEE STRUCT.)
- 11 GWB CONTROL JOINT
- 12 EXPOSED ROOF INSULATION
- 13 MTL. Z PURLIN (TYP.)
- 14 SUSPENDED PROJECTION SCREEN
- 15 LED CYLINDER PENDANT LIGHT FIXTURE (TYP.) (SEE ELEC.)
- 16 LED WALL SCONCE LIGHT FIXTURE (TYP.) (SEE ELEC.)
- 17 RECTANGULAR BEAM LED LIGHT FIXTURE (TYP.) (SEE ELEC.)
- 18 RECESSED LED LIGHT FIXTURE (TYP.) (SEE ELEC.)
- 20 8"x16"x4" CMU (PROVIDE TIES PER MANUF. REQS.) ON MTL. STUD FURRING AT STL. COLUMN
- 21 E.I.F.S. - 1-1/2" R-7.5 RIGID INSUL. AND 5/8" SHEATHING ON 3-5/8" MTL. STUD FRAMING W/ R-13 BLANKET INSUL.
- 22 REVEAL (TYP.)
- 23 8"x16"x4" CMU (PROVIDE TIES PER MANUF. REQS.) W/ 1-1/2" AIR SPACE, 2" RIGID INSUL., AND 5/8" SHEATHING ON 3-5/8" MTL. STUD FRAMING
- 24 STANDING SEAM MTL. ROOF (OWNER FURNISHED)
- 25 CONT. R-11 VINYL-FACED BLANKET INSUL. ON R-3 THERMAL SPACER BLOCKS (THERMAL SPACER BLOCKS TYP. AT EA. PURLIN)
- 26 R-19 FIBERGLASS BLANKET INSUL. BET. PURLINS (PROVIDE LONGITUDINAL AND TRANSVERSE MTL. SUPPORT BANDING)
- 27 CONT. BLACK FIBER-REINFORCED VAPOR BARRIER MEMBRANE AT BOTTOM OF PURLINS
- 28 GUTTER AND FLASHING BY MTL. BLDG. MANUF.
- 29 DOWNSPOUTS BY MTL. BLDG. MANUF. (TYP.)
- 31 3/8" T. x 24" D. CLEAR TEMPERED GLASS SHELVES (TYP.)
- 32 ADJUSTABLE SHELF BRACKETS & FLUSH-MOUNTED SHELF TRACKS (TYP.)
- 33 RACKS INSIDE WALL MOUNT EH COUNTER SUPPORT BRACKETS
- 34 OPEN TO UPPER ROOF ABOVE
- 35 MTL. C PURLIN BY MTL. BLDG. MANUF.
- 36 PRE-FIN. COUNTER FLASHING
- 37 TIE-IN TRIM BY MTL. BLDG. MANUF.
- 38 BACK-UP PLATE BY MTL. BLDG. MANUF.
- 39 OUTSIDE MTL. CLOSURE BY MTL. BLDG. MANUF.
- 41 STL. SPANDREL ANGLE AT BOTTOM OF MTL. Z PURLINS BY MTL. BLDG. MANUFACTURER
- 42 COMPRESSIBLE FILLER
- 43 NEW CONC. SIDEWALK
- 44 ALUM. DOOR AS SCHEDULED
- 45 DOOR THRESHOLD AS SCHEDULED - SET ON FULL BED OF MASTIC
- 46 TURNED-DOWN CONC. SLAB (SEE STRUCT.)
- 47 STRUCT. STL. COLUMN
- 48 STRUCT. STL. MOMENT FRAME - PAINT BLACK WHERE EXPOSED
- 49 SOUND ATTENUATION BLANKET (TYP.)
- 51 LINEAR SLOT RETURN (SEE MECH.)
- 52 MTL. SUPPORT BANDING - SPACE AS DIMENSIONED ON ENLARGED RCP (TYP.)
- 53 UNHINGED / RECESSED KNOXBOX (ALUM. FIN.)
- 54 FLUID-APPLIED AIR BARRIER MEMBRANE
- 55 JOINT SEALANT AND BACKER ROD
- 56 ALUM. STOREFRONT SYSTEM
- 57 E.I.F.S. - 1-1/2" R-7.5 RIGID INSUL. AND 5/8" SHEATHING ON 6" MTL. STUD FRAMING W/ R-13 BLANKET INSUL.
- 59 E.I.F.S. DRAINABLE TRACK
- 60 THRU-WALL STAINLESS STL. FLASHING W/ DRIP EDGE - FLASHED INTO AIR AND WATER BARRIER MEMBRANE
- 61 R-19 FIBERGLASS BLANKET INSUL. BET. MTL. STUD FRAMING (PROVIDE LONGITUDINAL AND TRANSVERSE MTL. SUPPORT BANDING)
- 62 STANDING SEAM MTL. ROOF (OWNER FURNISHED) ON 3/4" FRP PLYWOOD ON 6" MTL. STUD FRAMING
- 68 ROLLERSHADE AT EA. EXT. WINDOW (TYP.)
- 69 EAVE TRIM, PANEL CAP TRIM, AND FLASHING BY MTL. BLDG. MANUF.
- 70 MTL. STUD BRACE (SEE STRUCT.)



4539 HEDGEMORE DRIVE, SUITE 101
CHARLOTTE NC 28209
704.890.2653
WWW.OSSASTUDIO.COM

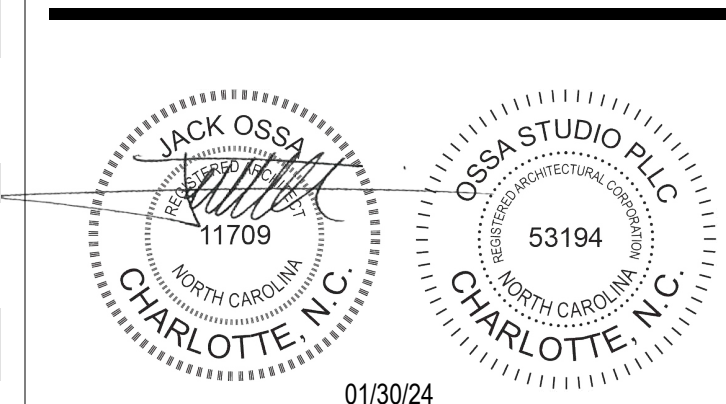

- PROJECT TEAM**
- General Contractor**
ECCLESIA CONSTRUCTION
www.ecclesiainc.com
803.327.5670
 - Civil Engineering**
HILLIARD ENGINEERING, PLLC
www.heaecorp.com
919.352.2834
 - Structural Engineering**
PROVIDENCE PARTNERS
www.providencpartnersinc.com
704.266.6621
 - Mechanical, Electrical, Plumbing & Fire Protection**
ENGINECTURE
www.enginecture.com
704.287.2193

Date	Description
01/30/24	FOR CONSTRUCTION
05/8/24	PERMIT REVIEW COMMENTS
10/14/24	RTAP NO. 1


Project Name
3D
community church
making church come alive
658 GRAHAM ROAD
SANFORD NC 27311

Client
3D COMMUNITY CHURCH
Project Number
23024.00
Description
REFLECTED CEILING PLAN

Scale
As indicated

A02.03

10/14/2024 5:08:16 PM L:\Private\Drawings\Local\2024\00_3D\Community Church\andrew.mcdellan\FHLC.rvt

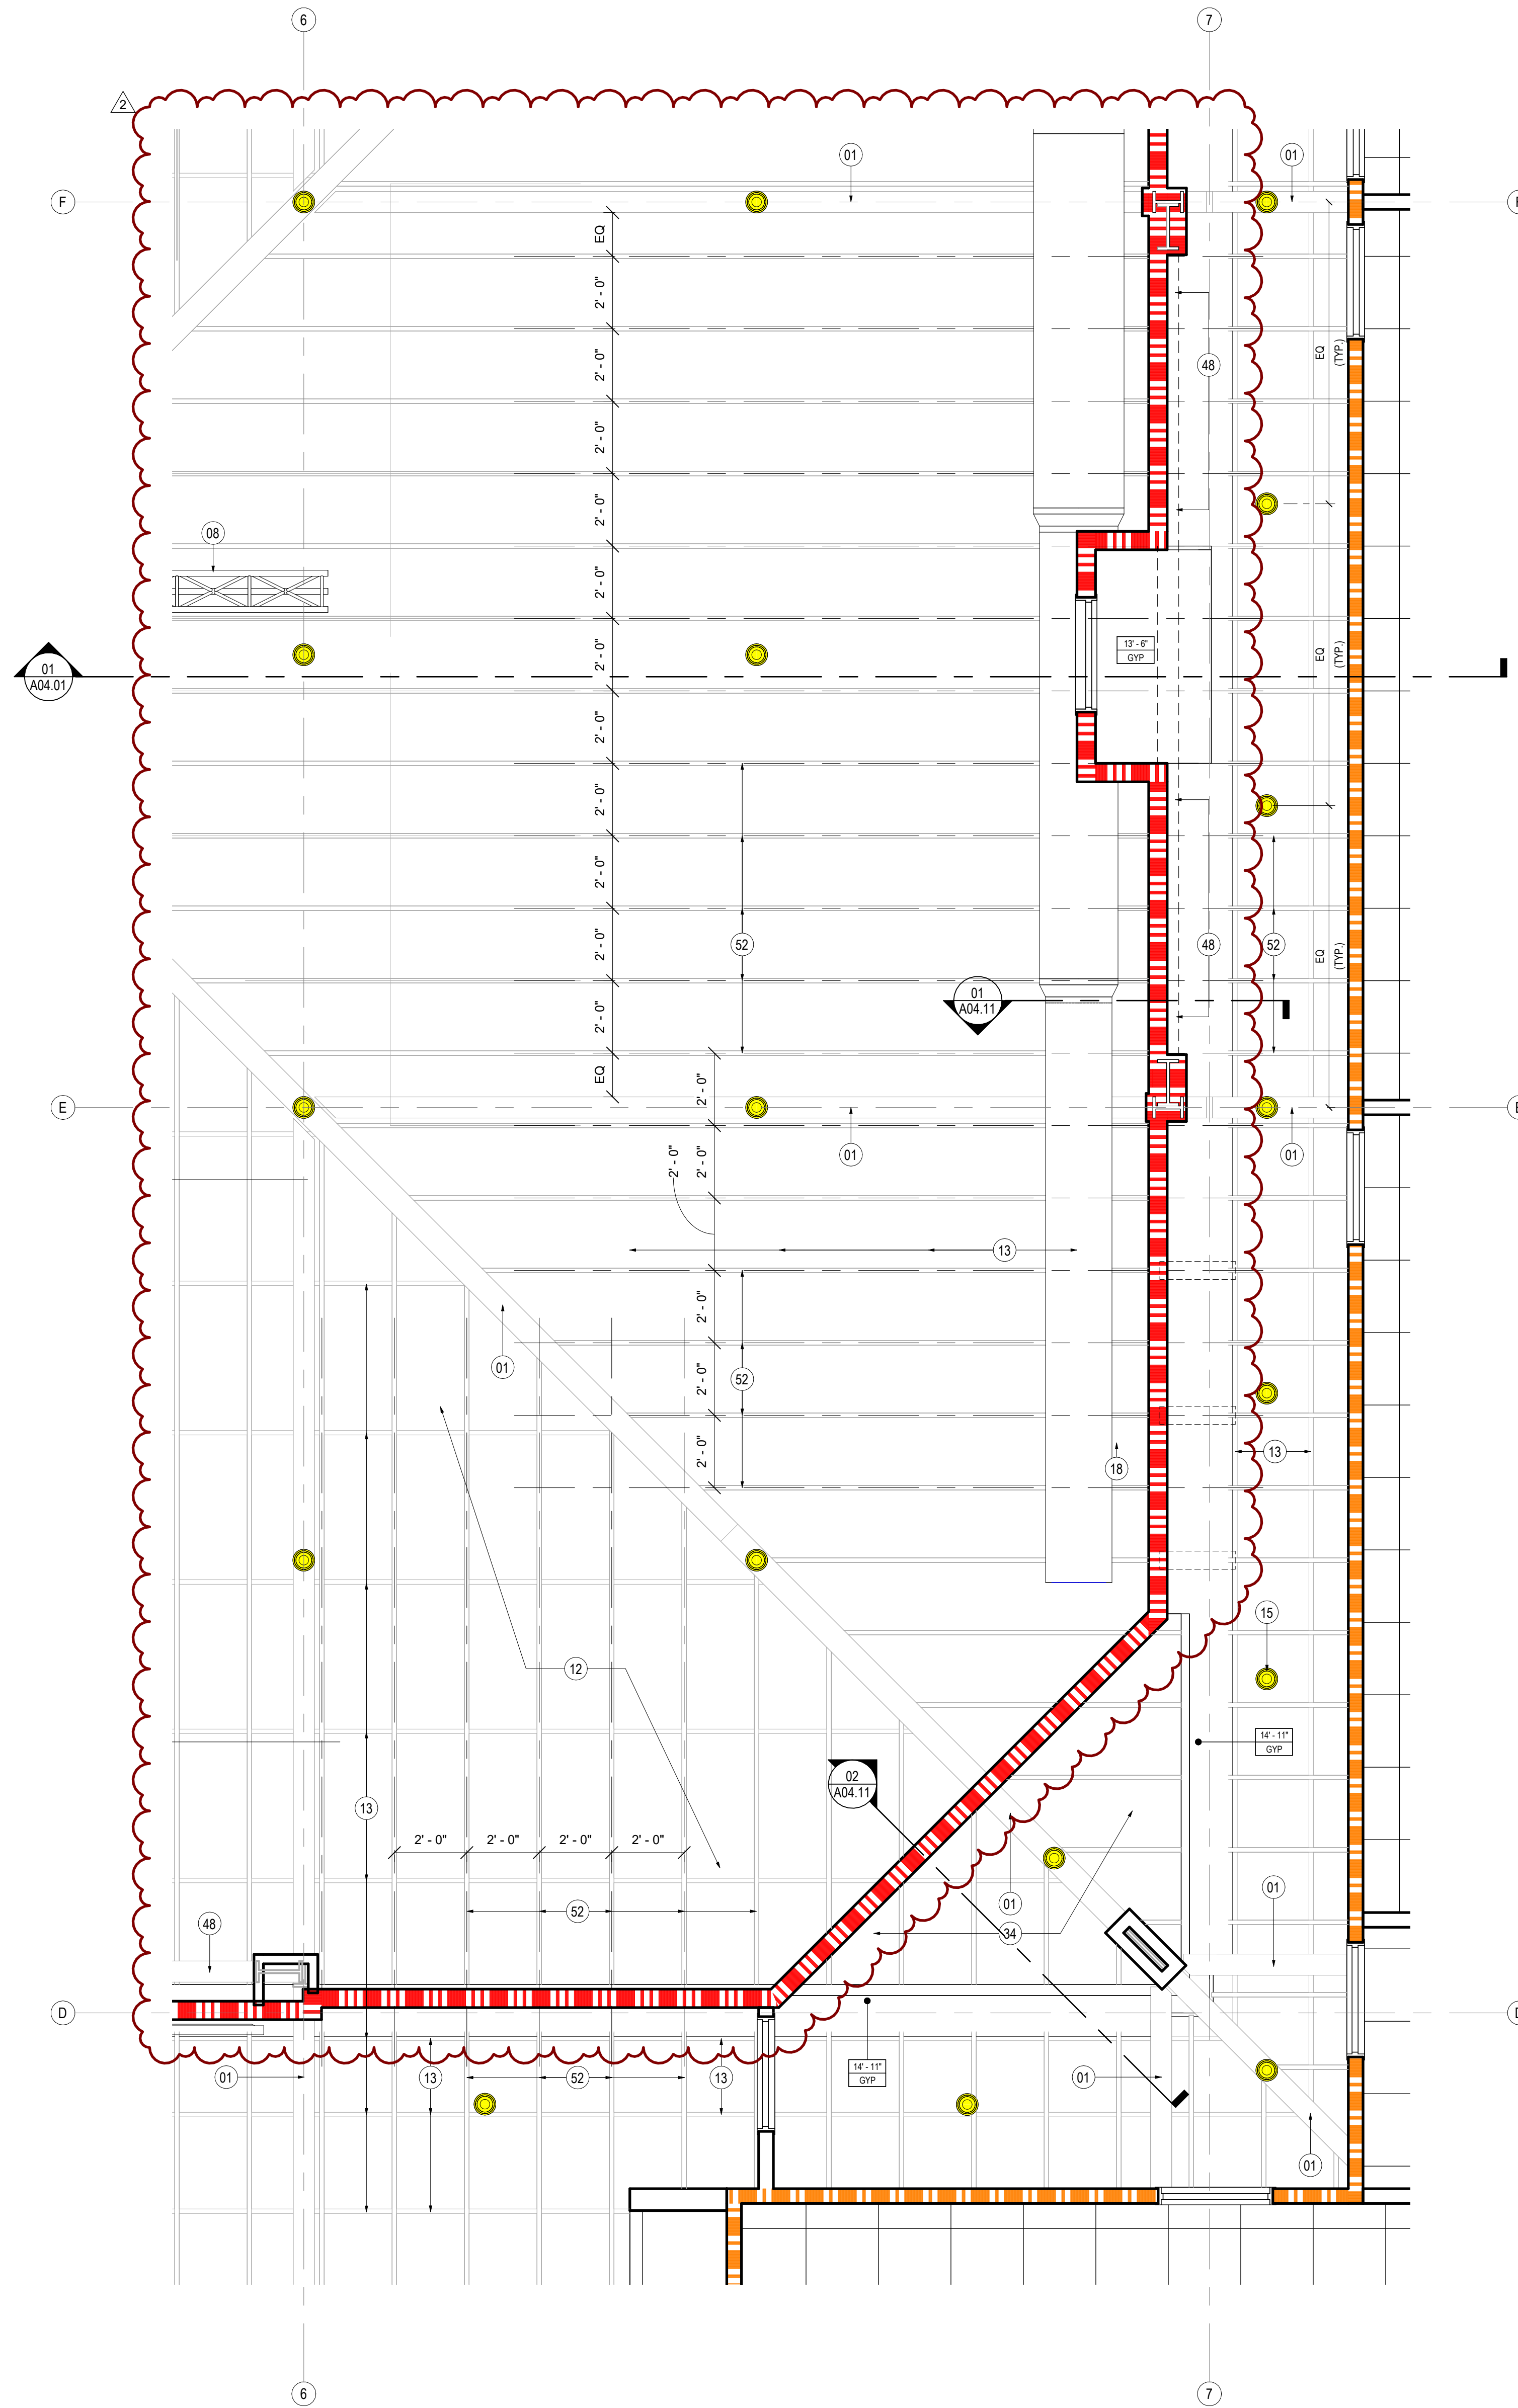


01 ENLARGED REFLECTED CEILING PLAN
SCALE: 3/8" = 1'-0"

SHEET NOTES

- 01 STRUCT. STL. - PAINT BLACK WHERE EXPOSED
- 02 GWB AND MDF STAGE APRON - PAINT BLACK
- 03 ELEVATED FLOOR w/ LVT FINISH ON 1/4" T. TEMPERED MASONITE, 1/2" HOMASOTE, AND 3/4" FRT PLYWOOD ON MTL. STUD FRAMING (SEE STRUCT.)
- 04 SLOPED GWB "CLOUD" AT UNDERSIDE OF STL. STRUCT.
- 07 MTL. PANEL CEILING SYSTEM MTL. BLDG. MANUF. LIGHTING TRUSS (SEE STRUCT.)
- 09 RAMP w/ LVT FINISH ON (2) LAYERS 3/4" FRT PLYWOOD ON MTL. STUD FRAMING (SEE STRUCT.)
- 10 STAIR w/ LVT FINISH ON (2) LAYERS 3/4" FRT PLYWOOD ON MTL. STUD FRAMING (SEE STRUCT.)
- 11 GWB CONTROL JOINT
- 12 EXPOSED ROOF INSULATION
- 13 MTL. Z PURLIN (TYP.)
- 14 SUSPENDED PROJECTION SCREEN (SEE ELEC.)
- 15 LED CYLINDER PENDANT LIGHT FIXTURE (TYP.) (SEE ELEC.)
- 16 LED WALL SCONCE LIGHT FIXTURE (TYP.) (SEE ELEC.)
- 17 RECTANGULAR BEAM LED LIGHT FIXTURE (TYP.) (SEE ELEC.)
- 18 RECESSED LED LIGHT FIXTURE (TYP.) (SEE ELEC.)
- 20 8"x16"x4" CMU (PROVIDE TIES PER MANUF. REQS.) ON MTL. STUD FURRING AT STL. COLUMN
- 21 E.I.F.S. - 1-1/2" R-7.5 RIGID INSUL. AND 5/8" SHEATHING ON 3-5/8" MTL. STUD FRAMING W/ R-13 BLANKET INSUL.
- 22 REVEAL (TYP.)
- 23 8"x16"x4" CMU (PROVIDE TIES PER MANUF. REQS.) W/ 1-1/2" AIR SPACE, 2" RIGID INSUL., AND 5/8" SHEATHING ON 3-5/8" MTL. STUD FRAMING
- 24 STANDING SEAM MTL. ROOF (OWNER FURNISHED)
- 25 CONT. R-11 VINYL-FACED BLANKET INSUL ON R-3 THERMAL SPACER BLOCKS (THERMAL SPACER BLOCKS TYP. AT EA. PURLIN)
- 26 R-19 FIBERGLASS BLANKET INSUL. BET. PURLINS (PROVIDE LONGITUDINAL AND TRANSVERSE MTL. SUPPORT BANDING)
- 27 CONT. BLACK FIBER-REINFORCED VAPOR BARRIER MEMBRANE AT BOTTOM OF PURLINS
- 28 GUTTER AND FLASHING BY MTL. BLDG. MANUF.
- 29 DOWNSPOUTS BY MTL. BLDG. MANUF. (TYP.)
- 31 3/8" T. x 24" D. CLEAR TEMPERED GLASS SHELVES (TYP.)
- 32 ADJUSTABLE SHELF BRACKETS & FLUSH-MOUNTED SHELF TRACKS (TYP.)
- 33 RAKES INSIDE WALL MOUNT EH COUNTER SUPPORT BRACKETS
- 34 OPEN TO UPPER ROOF ABOVE
- 35 MTL. C PURLIN BY MTL. BLDG. MANUF.
- 36 PRE-FIN. COUNTER FLASHING
- 37 TIE-IN TRIM BY MTL. BLDG. MANUF.
- 38 BACK-UP PLATE BY MTL. BLDG. MANUF.
- 39 OUTSIDE MTL. CLOSURE BY MTL. BLDG. MANUF.
- 41 STL. SPANDEK ANGLE AT BOTTOM OF MTL. Z PURLINS BY MTL. BLDG. MANUFACTURER
- 42 COMPRESSIBLE FILLER
- 43 NEW CONC. SIDEWALK
- 44 ALUM. DOOR AS SCHEDULED
- 45 DOOR THRESHOLD AS SCHEDULED - SET ON FULL BED OF MASTIC
- 46 TURNED-DOWN CONC. SLAB (SEE STRUCT.)
- 47 STRUCT. STL. COLUMN
- 48 STRUCT. STL. MOMENT FRAME - PAINT BLACK WHERE EXPOSED
- 49 SOUND ATTENUATION BLANKET (TYP.)
- 51 LINEAR SLOT RETURN (SEE MECH.)
- 52 MTL. SUPPORT BANDING - SPACE AS DIMENSIONED ON ENLARGED RCP (TYP.)
- 53 UNHINGED / RECESSED KNOXBOX (ALUM. FIN.)
- 54 FLUID-APPLIED AIR BARRIER MEMBRANE
- 55 JOINT SEALANT AND BACKER ROD
- 56 ALUM. STOREFRONT SYSTEM
- 57 E.I.F.S. - 1-1/2" R-7.5 RIGID INSUL. AND 5/8" SHEATHING ON 6" MTL. STUD FRAMING W/ R-13 BLANKET INSUL.
- 59 E.I.F.S. DRAINABLE TRACK
- 60 THRU-WALL STAINLESS STL. FLASHING W/ DRIP EDGE - FLASHED INTO AIR AND WATER BARRIER MEMBRANE
- 61 R-19 FIBERGLASS BLANKET INSUL. BET. MTL. STUD FRAMING (PROVIDE LONGITUDINAL AND TRANSVERSE MTL. SUPPORT BANDING)
- 62 STANDING SEAM MTL. ROOF (OWNER FURNISHED) ON 3/4" FRT PLYWOOD ON 6" MTL. STUD FRAMING
- 68 ROLLERSHADE AT EA. EXT. WINDOW (TYP.)
- 69 EAVE TRIM, PANEL, CAP TRIM, AND FLASHING BY MTL. BLDG. MANUF.
- 70 MTL. STUD BRACE (SEE STRUCT.)



4539 HEDGEMORE DRIVE, SUITE 101
CHARLOTTE NC 28209
704.890.2653
WWW.OSSASTUDIO.COM

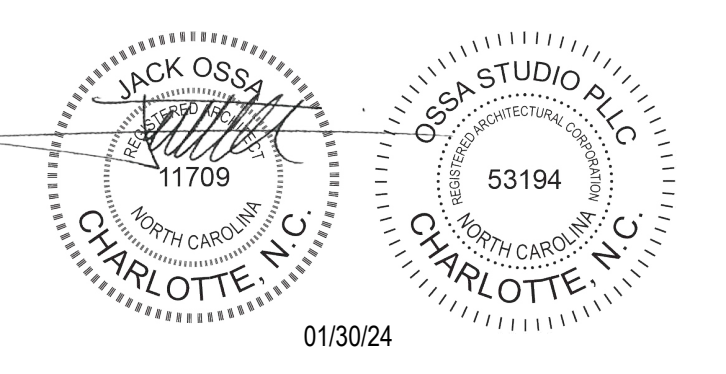

PROJECT TEAM

- General Contractor**
ECCLESIA CONSTRUCTION
www.ecclesiainc.com
803.327.5670
- Civil Engineering**
HILLIARD ENGINEERING, PLLC
www.ihacorp.com
919.352.2834
- Structural Engineering**
PROVIDENCE PARTNERS
www.providencepartnersinc.com
704.266.6621
- Mechanical, Electrical, Plumbing & Fire Protection**
ENGINEERING
www.engineering.com
704.287.2193

Date	Description
10/30/24	FOR CONSTRUCTION
2 10/14/24	RTAP NO. 1

Project Name

community church
making church come alive
658 GRAHAM ROAD
SANFORD NC 27311

Client
3D COMMUNITY CHURCH

Project Number
23024.00

Description
ENLARGED REFLECTED CEILING PLAN

Scale
3/8" = 1'-0"

A02.04


SHEET NOTES

- 100 PROVIDE 1/2" TILE UP TO 5'-0" AT ALL WALLS
- 101 SCHLUTER SCHIENE STRIP FLOOR TRANSITION
- 102 RUBBER FLOOR TRANSITION STRIP



**Ossa
STUDIO**

4539 HEDGEMORE DRIVE, SUITE 101
CHARLOTTE NC 28209
704.890.2653
WWW.OSSASTUDIO.COM

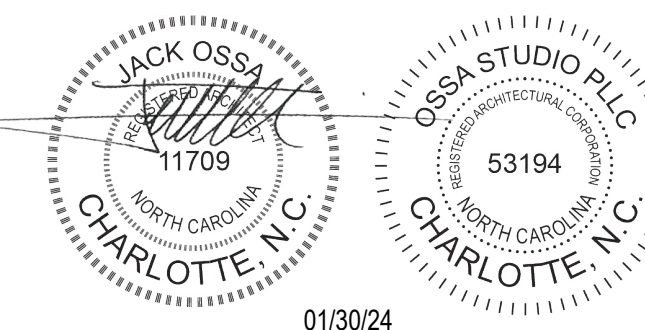

PROJECT TEAM

General Contractor
ECCLESIA CONSTRUCTION
www.ecclesiainc.com
803.327.5670


Civil Engineering
HILLIARD ENGINEERING, PLLC
www.hilliardepp.com
919.352.2834

Structural Engineering
PROVIDENCE PARTNERS
www.providencpartnersinc.com
704.266.6621

Mechanical, Electrical, Plumbing & Fire Protection
ENGINEERING
www.engineering.com
704.287.2193

Date Description

Date	Description
01/30/24	FOR CONSTRUCTION
2 10/14/24	RTAP NO. 1

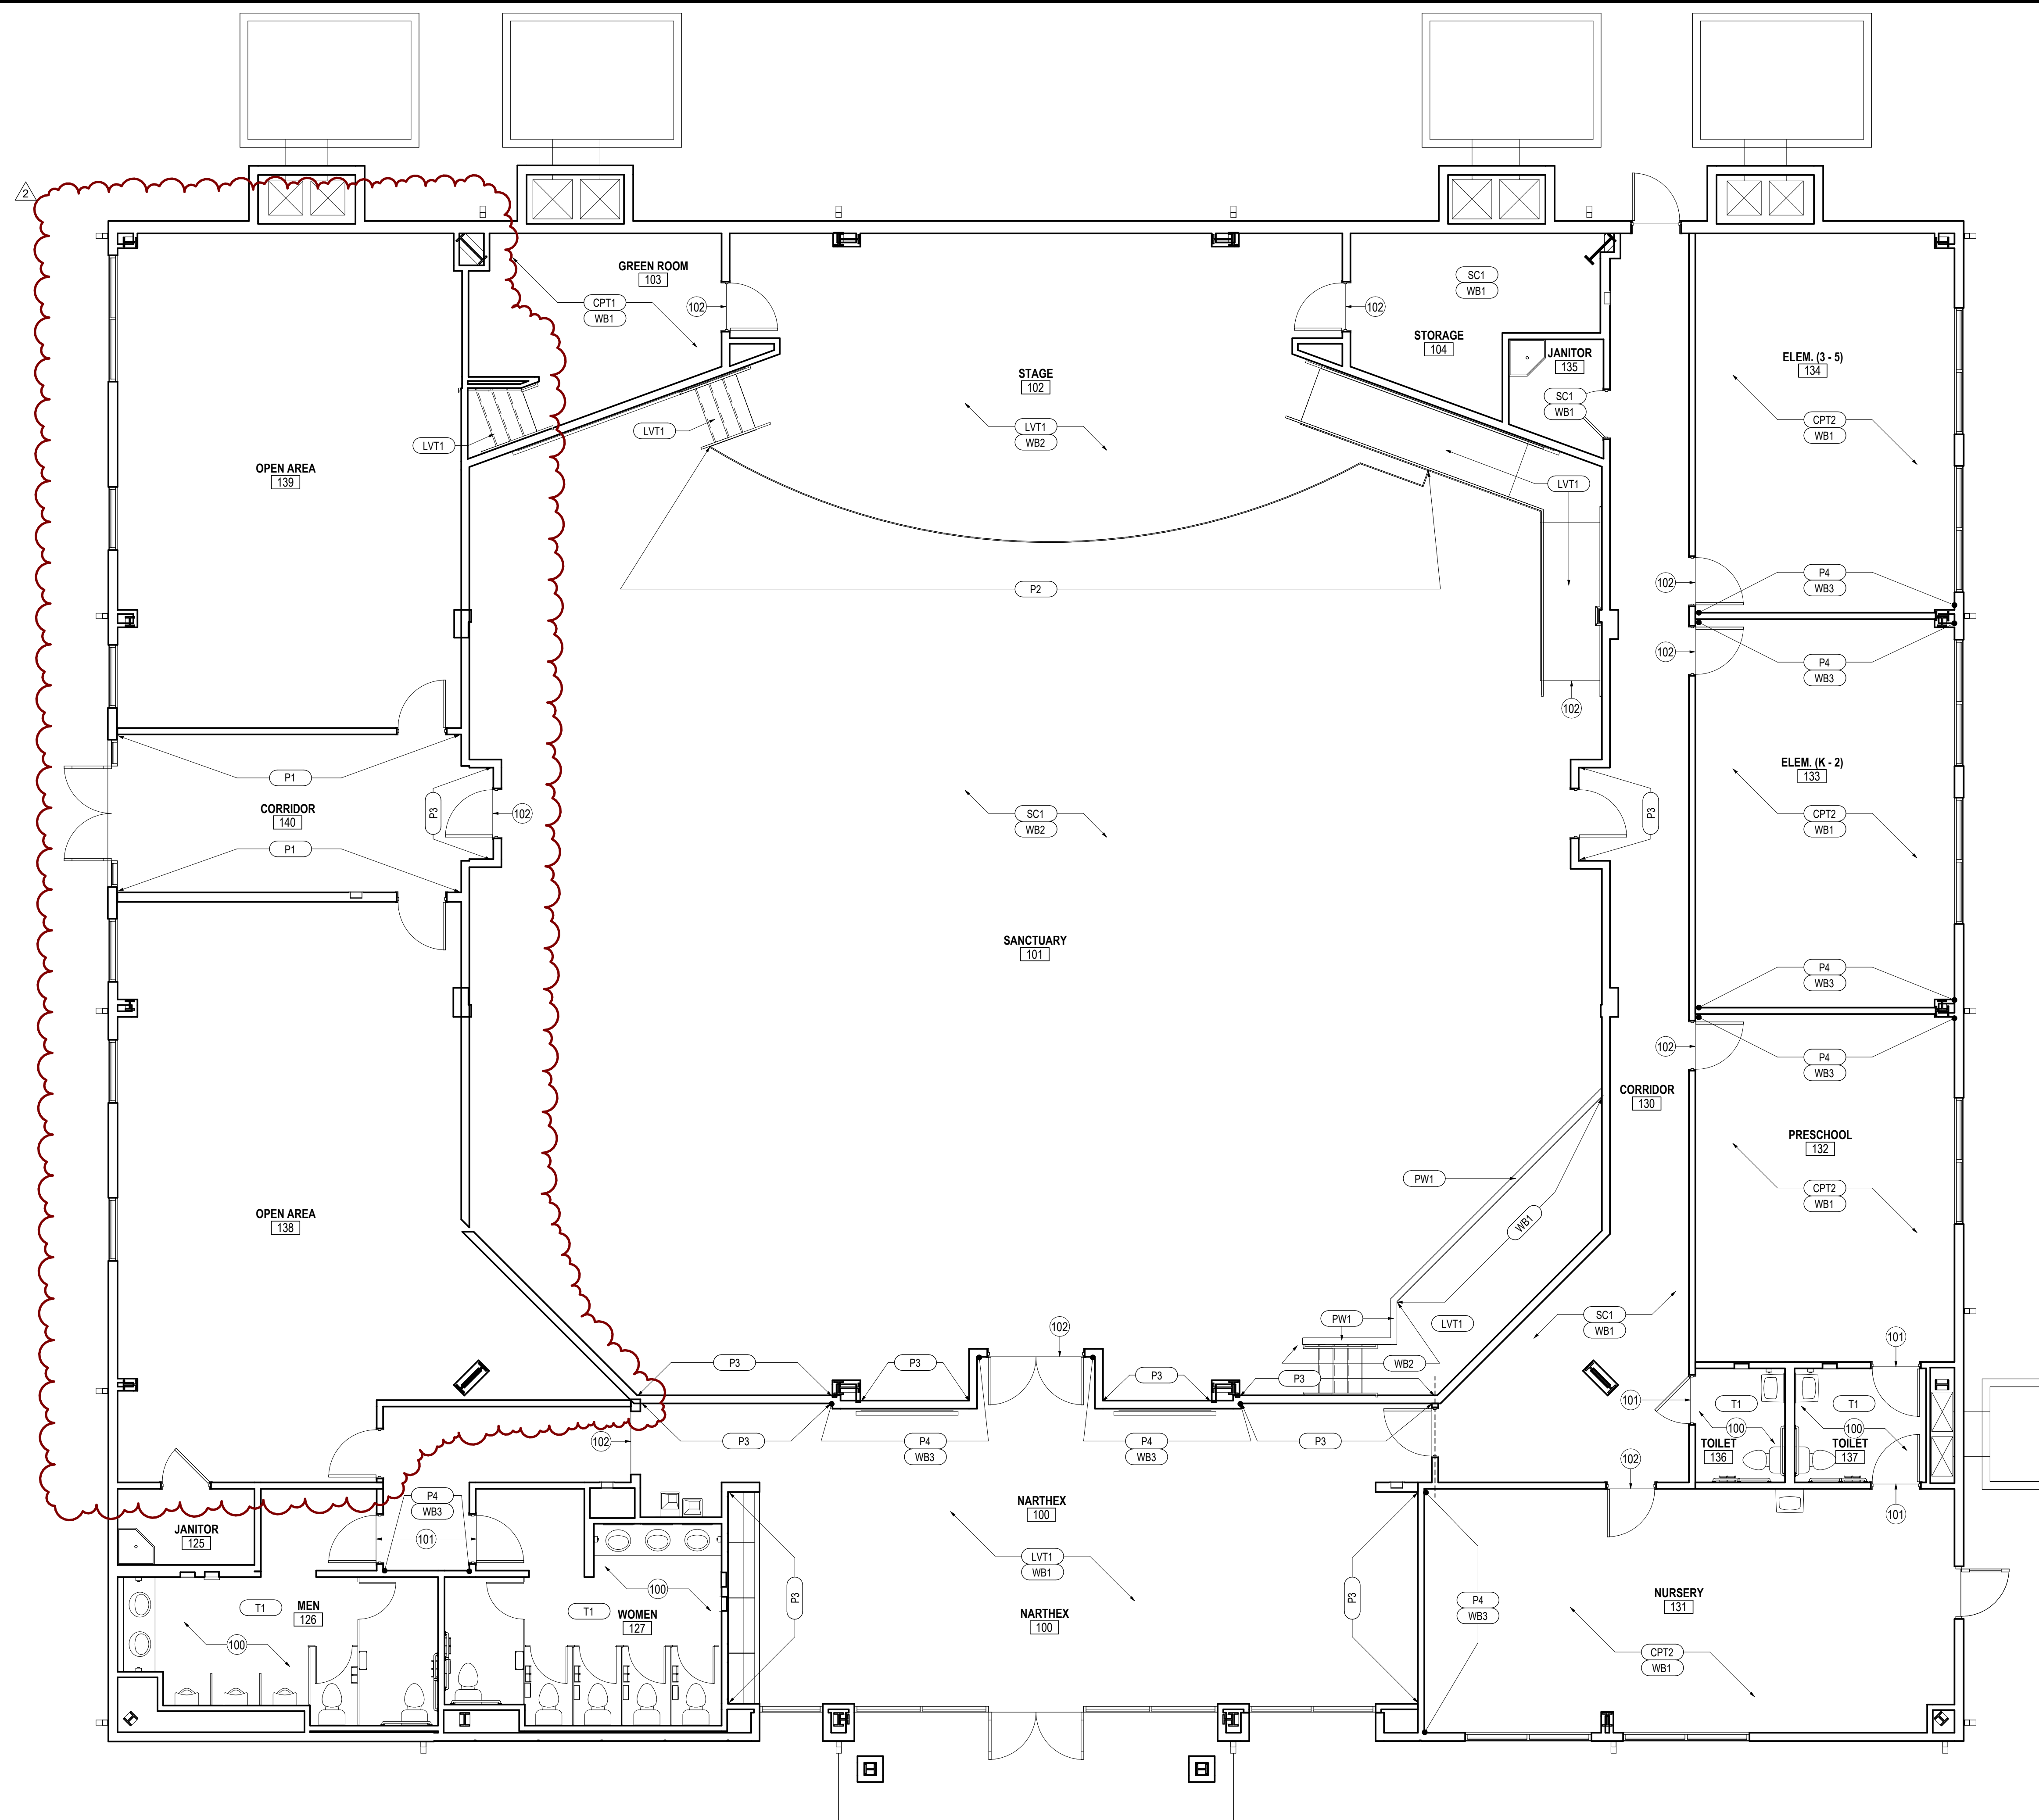

MATERIALS SCHEDULE

TAG	DESCRIPTION	MANUFACTURER	NAME	COMMENTS	CONTACT
ACT1	ACOUSTICAL CEILING TILE	ARMSTRONG	CORTEGA #769	24" x 24" - 15/16" PRELUDE XL GRID	
AG1	PRE-FIN ALUMINUM GUTTER	-	-	OWNER FURNISHED	
AP1	SUSPENDED ACOUSTICAL PANEL SYSTEM	ACOUSTICAL PRODUCTS & SYSTEMS	ECCOCORE	AME-08 ANTIQUE WHITE	SCOTT REASON sreason@bbbyrd.com
AS1	ALUMINUM STOREFRONT	YKK	THERMALLY BROKEN	ANODIZED ALUMINUM FINISH - 6 1/4" x 2 1/2" MULLION	
CMU1	CONCRETE MASONRY UNIT	JOHNSON CONCRETE PRODUCTS	BLACK BOULDER JCL-3621	8"x16"x4" GROUND FACE (STACK BOND) w/ HOLCIM SANTEE BLACK S MORTAR	
CPT1	CARPET TILE - GRAY	TARKETT	TARKETT	MONOLITHIC - PROVIDE TARKETT METAL EDGE TRANSITION STRIP AT ALL TRANSITIONS	2'-0" x 2'-0" TILES
CPT2	CARPET TILE - BLUE	TARKETT	TARKETT	MONOLITHIC - PROVIDE TARKETT METAL EDGE TRANSITION STRIP AT ALL TRANSITIONS	2'-0" x 2'-0" TILES
EIFS1	EXTERIOR INSULATION FINISHING SYSTEM	DRYVIT	DPR FINISHES	SANDBLAST - 626A Cloudy Day	
EIFS2	EXTERIOR INSULATION FINISHING SYSTEM	DRYVIT	DPR FINISHES	SANDBLAST - 621 Whale Gray	
GL1	1" INSULATED GLASS	GUARDIAN - SUNGUARD	SNX 6227	TEMPERED LOW E	TYPICAL AT EXTERIOR WALL
GL2	INTERIOR GLASS	-	1/4" TEMPERED GLASS	-	
LVT1	LUXURY VINYL TILE	TARKETT	10' LATITUDE WOOD 4692	6"x6"	
P1	PAINT - WHITE	SHERWIN WILLIAMS	SW 6196 FROSTY WHITE	WALLS : EGGSHELL - DOORS, FRAMES, TRIM : SEMI-GLOSS	
P2	PAINT - BLACK	SHERWIN WILLIAMS	TBD	WALLS : EGGSHELL - DOORS, FRAMES, TRIM : SEMI-GLOSS	
P3	PAINT - DARK GRAY	SHERWIN WILLIAMS	SW 7045 SOFTWARE	WALLS : EGGSHELL - DOORS, FRAMES, TRIM : SEMI-GLOSS	
P4	PAINT - BLUE	SHERWIN WILLIAMS	SW 6958 DYNAMIC BLUE	WALLS : EGGSHELL - DOORS, FRAMES, TRIM : SEMI-GLOSS	
PL1	PLASTIC LAMINATE	FORMICA	FORMICA	FORMICA	
PW1	PAINTED WOOD CAP	-	PAINTED TO MATCH WALL	1X WOOD	
RL1	PRE-FIN ALUMINUM DOWNSPOUT	-	OWNER FURNISHED	-	
SC1	SEALED CONCRETE - SCARIFY TO AN EVEN FLAT SURFACE	-	-	-	
SS1	SOLID SURFACE	FORMICA	406 LUNA BRITTE WHITE	25" X COUNTERTOP LENGTH	1 1/2" FRONT
SS2	SOLID SURFACE	FORMICA	406 LUNA BRITTE WHITE	10" X COUNTERTOP LENGTH - PROVIDE PLYWOOD BACKING	1 1/2" FRONT
SSM1	STANDING SEAM METAL ROOF	-	OWNER FURNISHED	-	
T1	CERAMIC TILE	CROSSVILLE	MAGMA AV295	PROVIDE ANTI-FRACTURE MEMBRANE - STRAIGHT STACK - GROUT: MAPEI 107	PROVIDE SCHLUTER STRIP AT ALL EDGES
T2	CERAMIC TILE	CROSSVILLE	FLANNEL SUIT AV317	PROVIDE ANTI-FRACTURE MEMBRANE - STRAIGHT STACK - GROUT: MAPEI 107	PROVIDE SCHLUTER STRIP AT ALL EDGES
WB1	WALL - GRAY	TARKETT	PERCEPTIONS	RWDC CONTOUR 1A5 COLONIAL GRAY	4.25"
WB2	APPLIED 1/2" MDF	-	PAINTED TO MATCH WALL	SEMI-GLOSS	12" TALL
WB3	WALL BASE - BLUE	TARKETT	PERCEPTIONS	RWDC 18 CONTOUR 18 NAVY BLUE	4.25"

FINISH SCHEDULE

NUMBER	NAME	FLOOR	WALL BASE	WALL FINISH	CEILING	COMMENTS
100	NARTHEX	LVT1	WB1	P1/P3/P4	GWB / OPEN TO STRUCTURE	
101	SANCTUARY	SC1	WB2	P1/P3	GWB / OPEN TO STRUCTURE	
102	STAGE	SC1	WB2	P1	GWB / OPEN TO STRUCTURE	
103	GREEN ROOM	CPT1	WB1	P1	ACT1	
104	STORAGE	SC1	WB1	P1	OPEN TO STRUCTURE	
125	JANITOR	SC1	WB1	P1	OPEN TO STRUCTURE	
126	MEN	T1	-	P1/P4	ACT1 / GWB	
127	WOMEN	T1	-	P1/P4	ACT1 / GWB	
130	CORRIDOR	SC1	WB1	P1/P3	OPEN TO STRUCTURE / GWB	
131	NURSERY	CPT1	WB1	P1/P4	ACT1	
132	PRESCHOOL	CPT1	WB1	P1/P4	ACT1	
133	ELEM (K-2)	CPT1	WB1	P1/P4	ACT1	
134	ELEM (3-5)	CPT1	WB1	P1/P4	ACT1	
135	JANITOR	SC1	WB1	P1	OPEN TO STRUCTURE	
136	TOILET	T1	-	P1	GWB	
137	TOILET	T1	-	P1	GWB	
138	OPEN AREA	SC1	-	P1	OPEN TO STRUCTURE	
139	OPEN AREA	SC1	-	P1	OPEN TO STRUCTURE	
140	CORRIDOR	SC1	WB1	P1	OPEN TO STRUCTURE	

10/14/2024 5:08:18 PM C:\ProgramData\Bentley\Local\23024_00_3D_Community Church_ardew.mcd\sheet\FCLC.rvt

Project Name



community church
making church come alive

658 GRAHAM ROAD
SANFORD NC 27311

Client

3D COMMUNITY CHURCH

Project Number

23024.00


Description

FINISH PLAN

Scale

3/16" = 1'-0"

A02.05

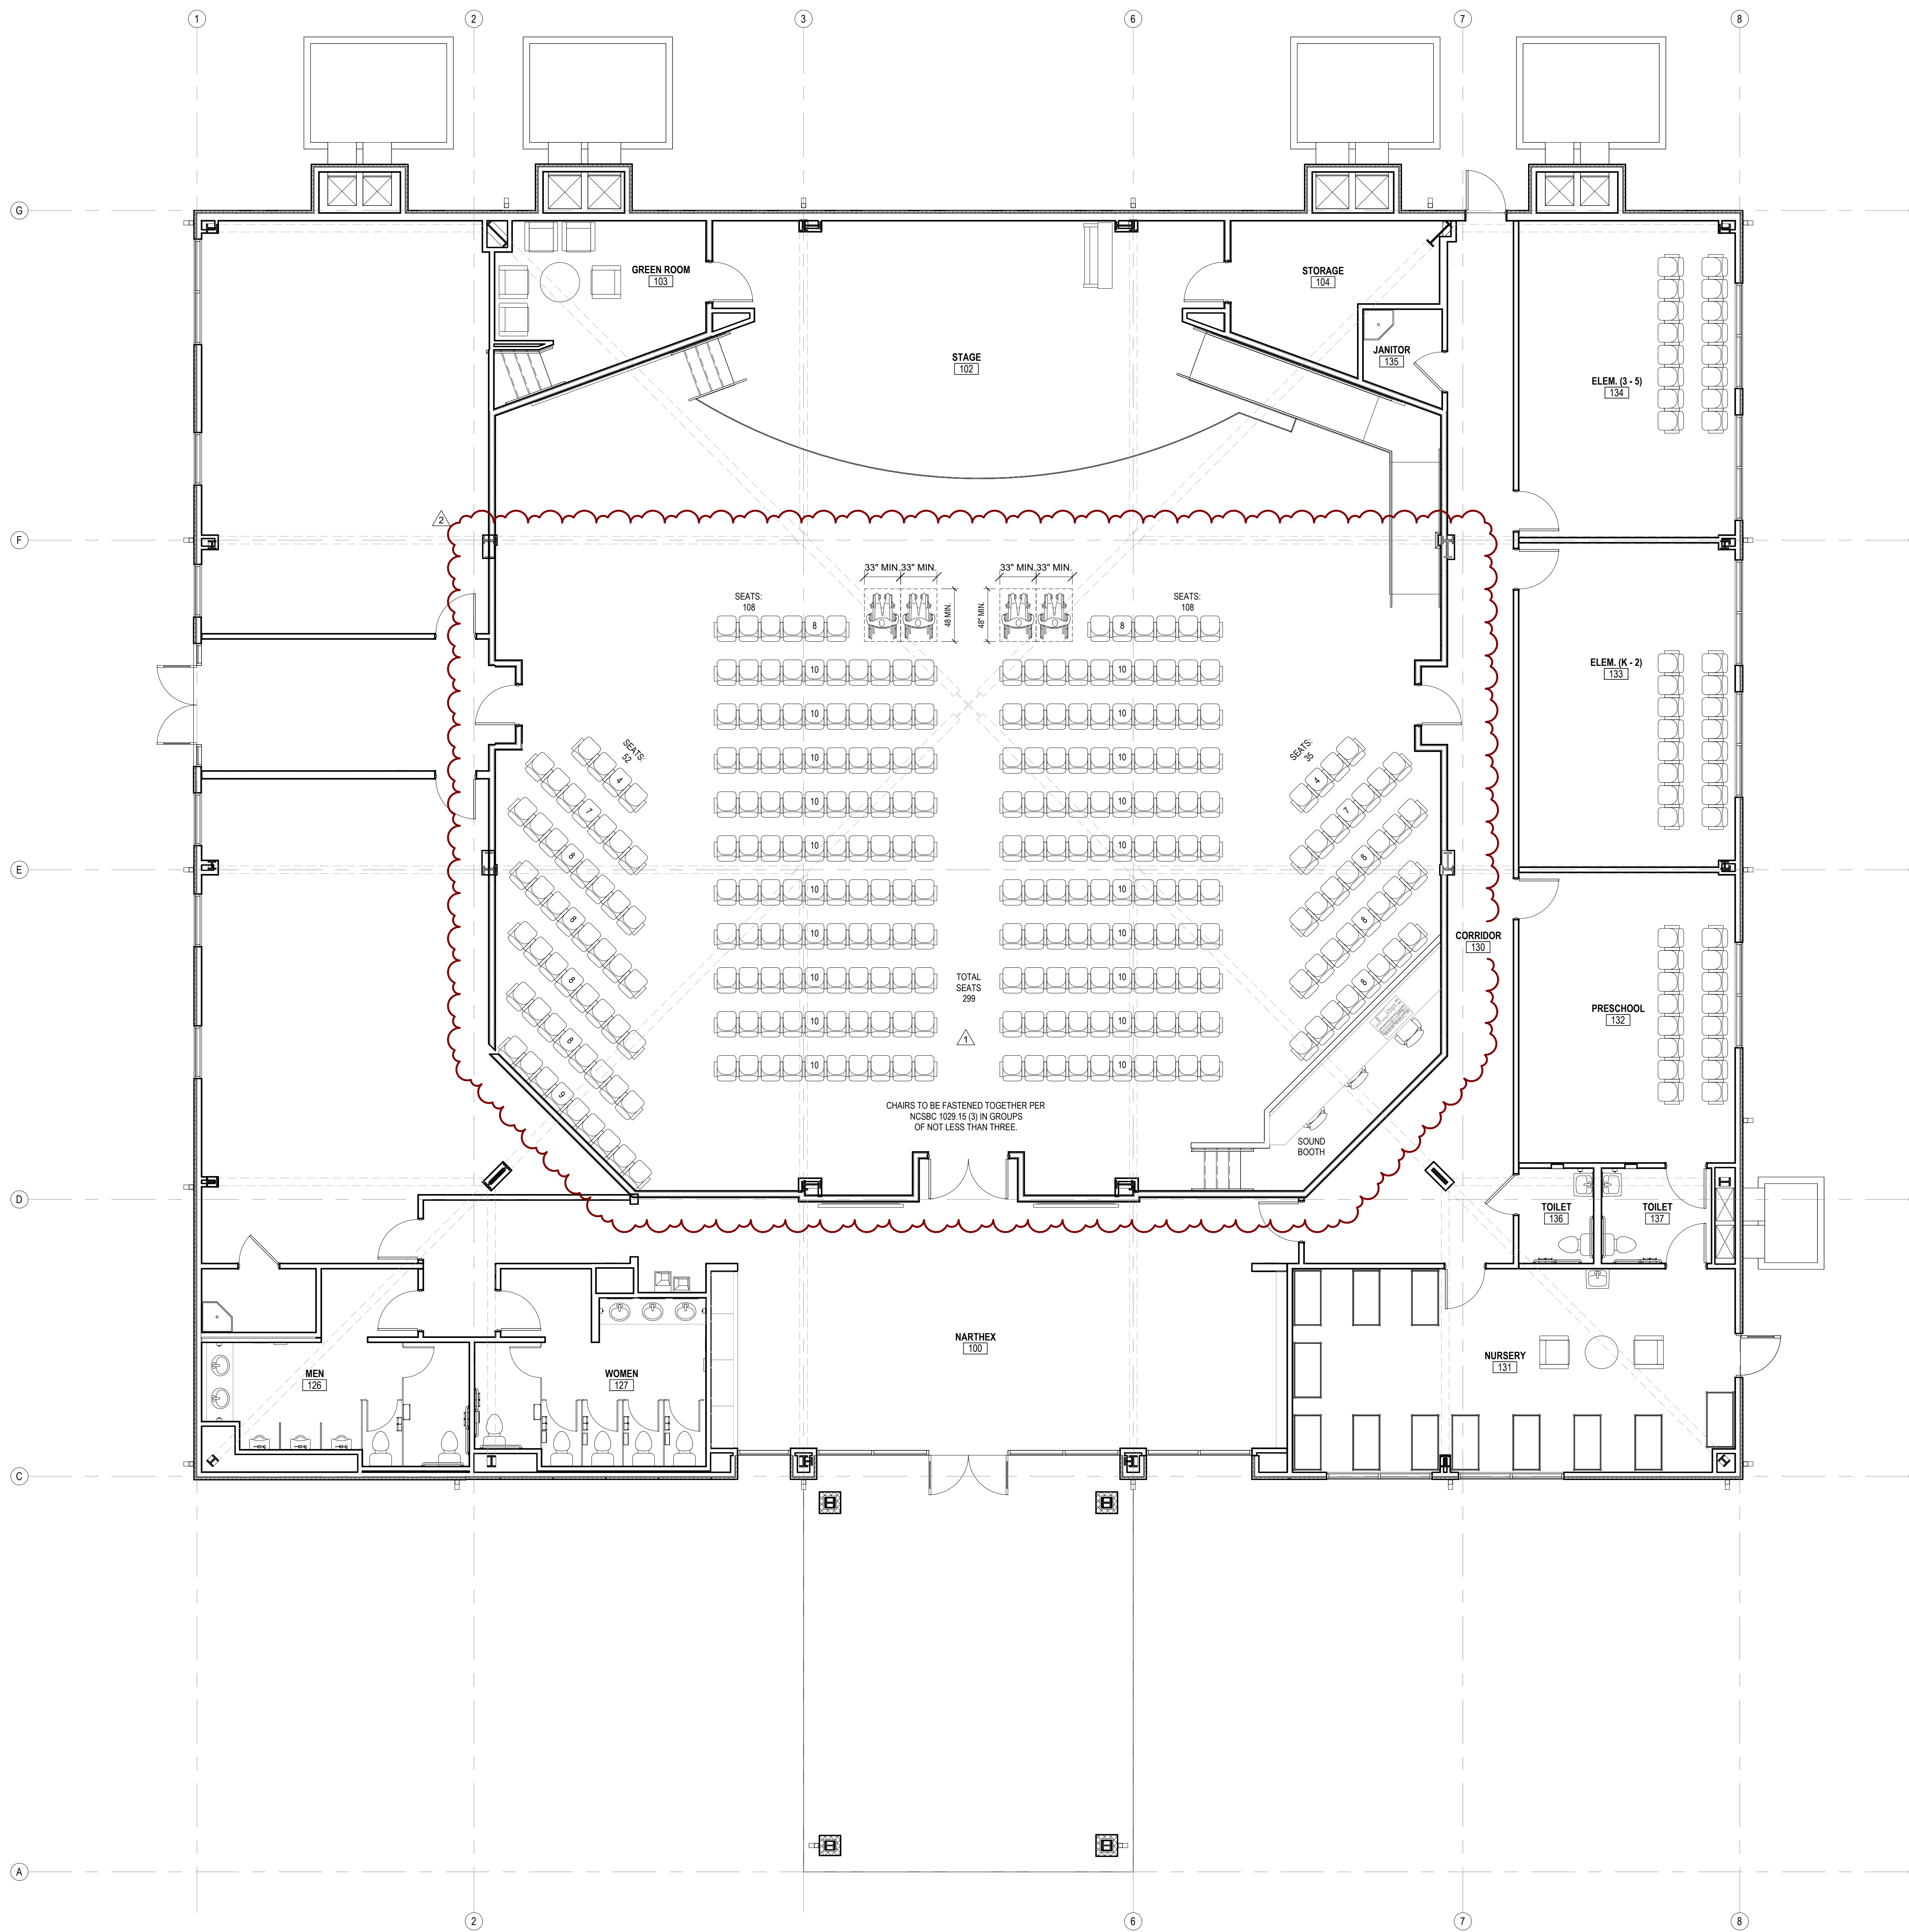


10/14/2024 5:08:19 PM C:\Private\Drawings\3D\Community Church\3D\Community Church\3D\Community Church\3D\Community Church\Furniture\A02.06.rvt



Ossa
STUDIO

4539 HEDGEMORE DRIVE, SUITE 101
CHARLOTTE NC 28209
704.890.2553
WWW.OSSASTUDIO.COM

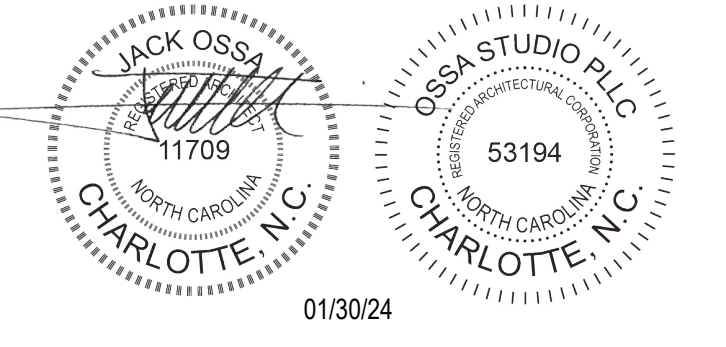

PROJECT TEAM

General Contractor
ECCLESIA CONSTRUCTION
www.ecclesiainc.com
803.327.5670

Civil Engineering
HILLIARD ENGINEERING, PLLC
www.hilliardepp.com
919.352.2834

Structural Engineering
PROVIDENCE PARTNERS
www.providencepartnersinc.com
704.266.6621

Mechanical, Electrical, Plumbing & Fire Protection
ENGINEERING
www.engineering.com
704.287.2193

Date	Description
01/30/24	FOR CONSTRUCTION
1 05/8/24	PERMIT REVIEW COMMENTS
2 10/14/24	RTAP NO. 1

Project Name



community church
making church come alive
658 GRAHAM ROAD
SANFORD NC 27311

Client

3D COMMUNITY CHURCH

Project Number

23024.00


Description

FURNITURE PLAN


Scale

3/16" = 1'-0"


A02.06

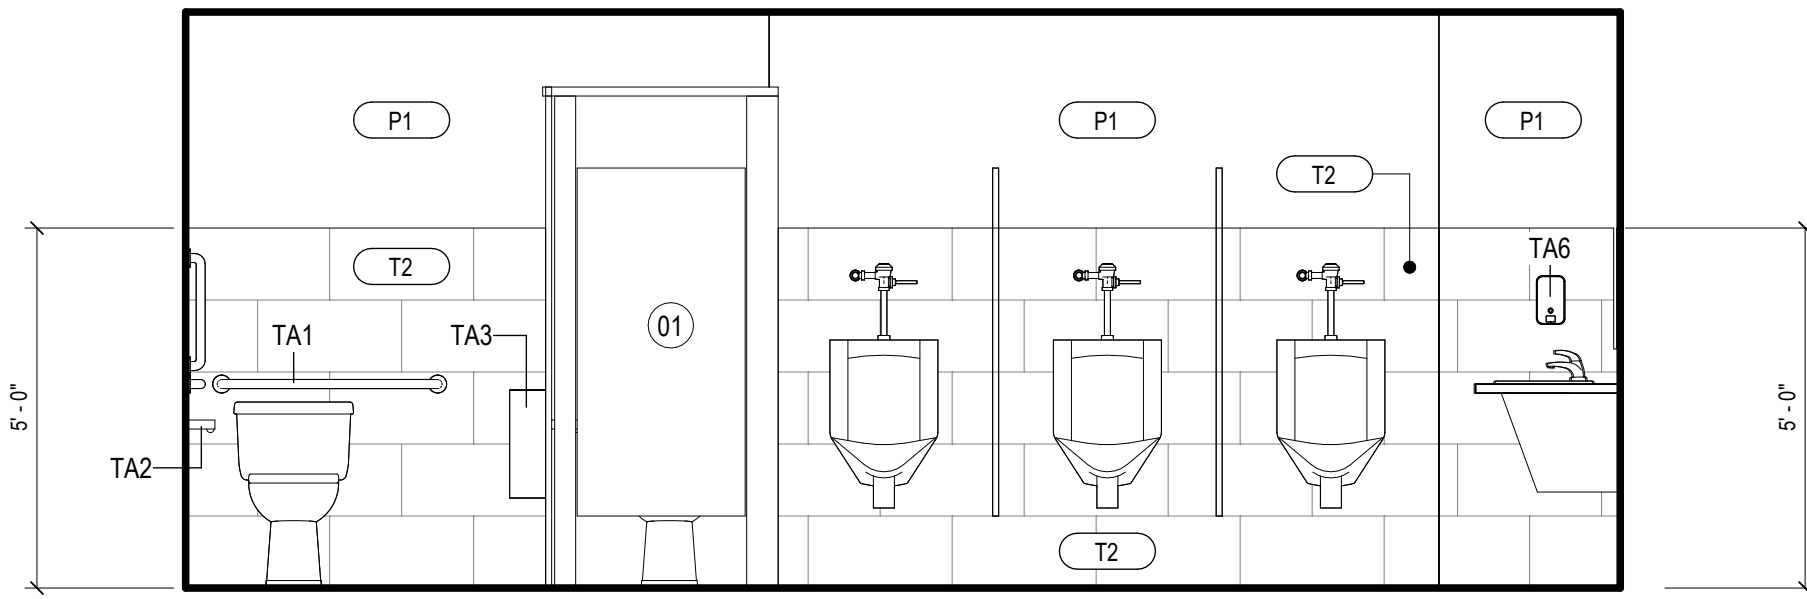


14 INTERIOR ELEVATION K
SCALE: 3/8" = 1'-0"

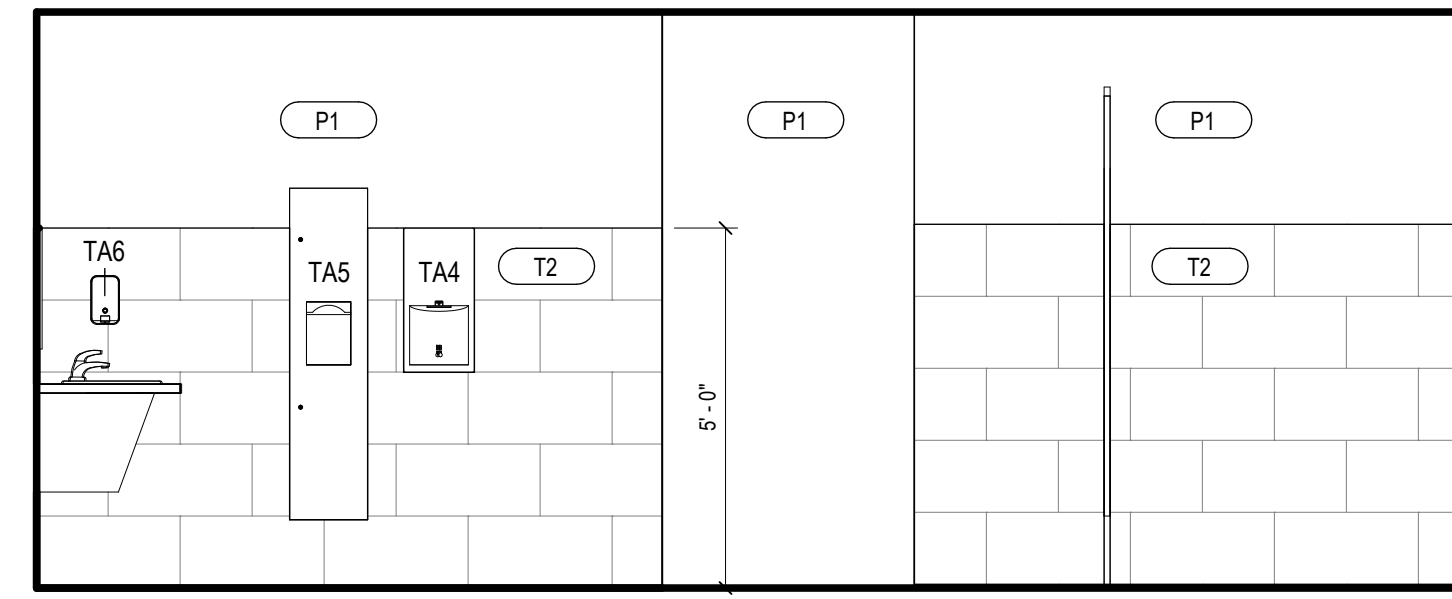

10 INTERIOR ELEVATION G
SCALE: 3/8" = 1'-0"

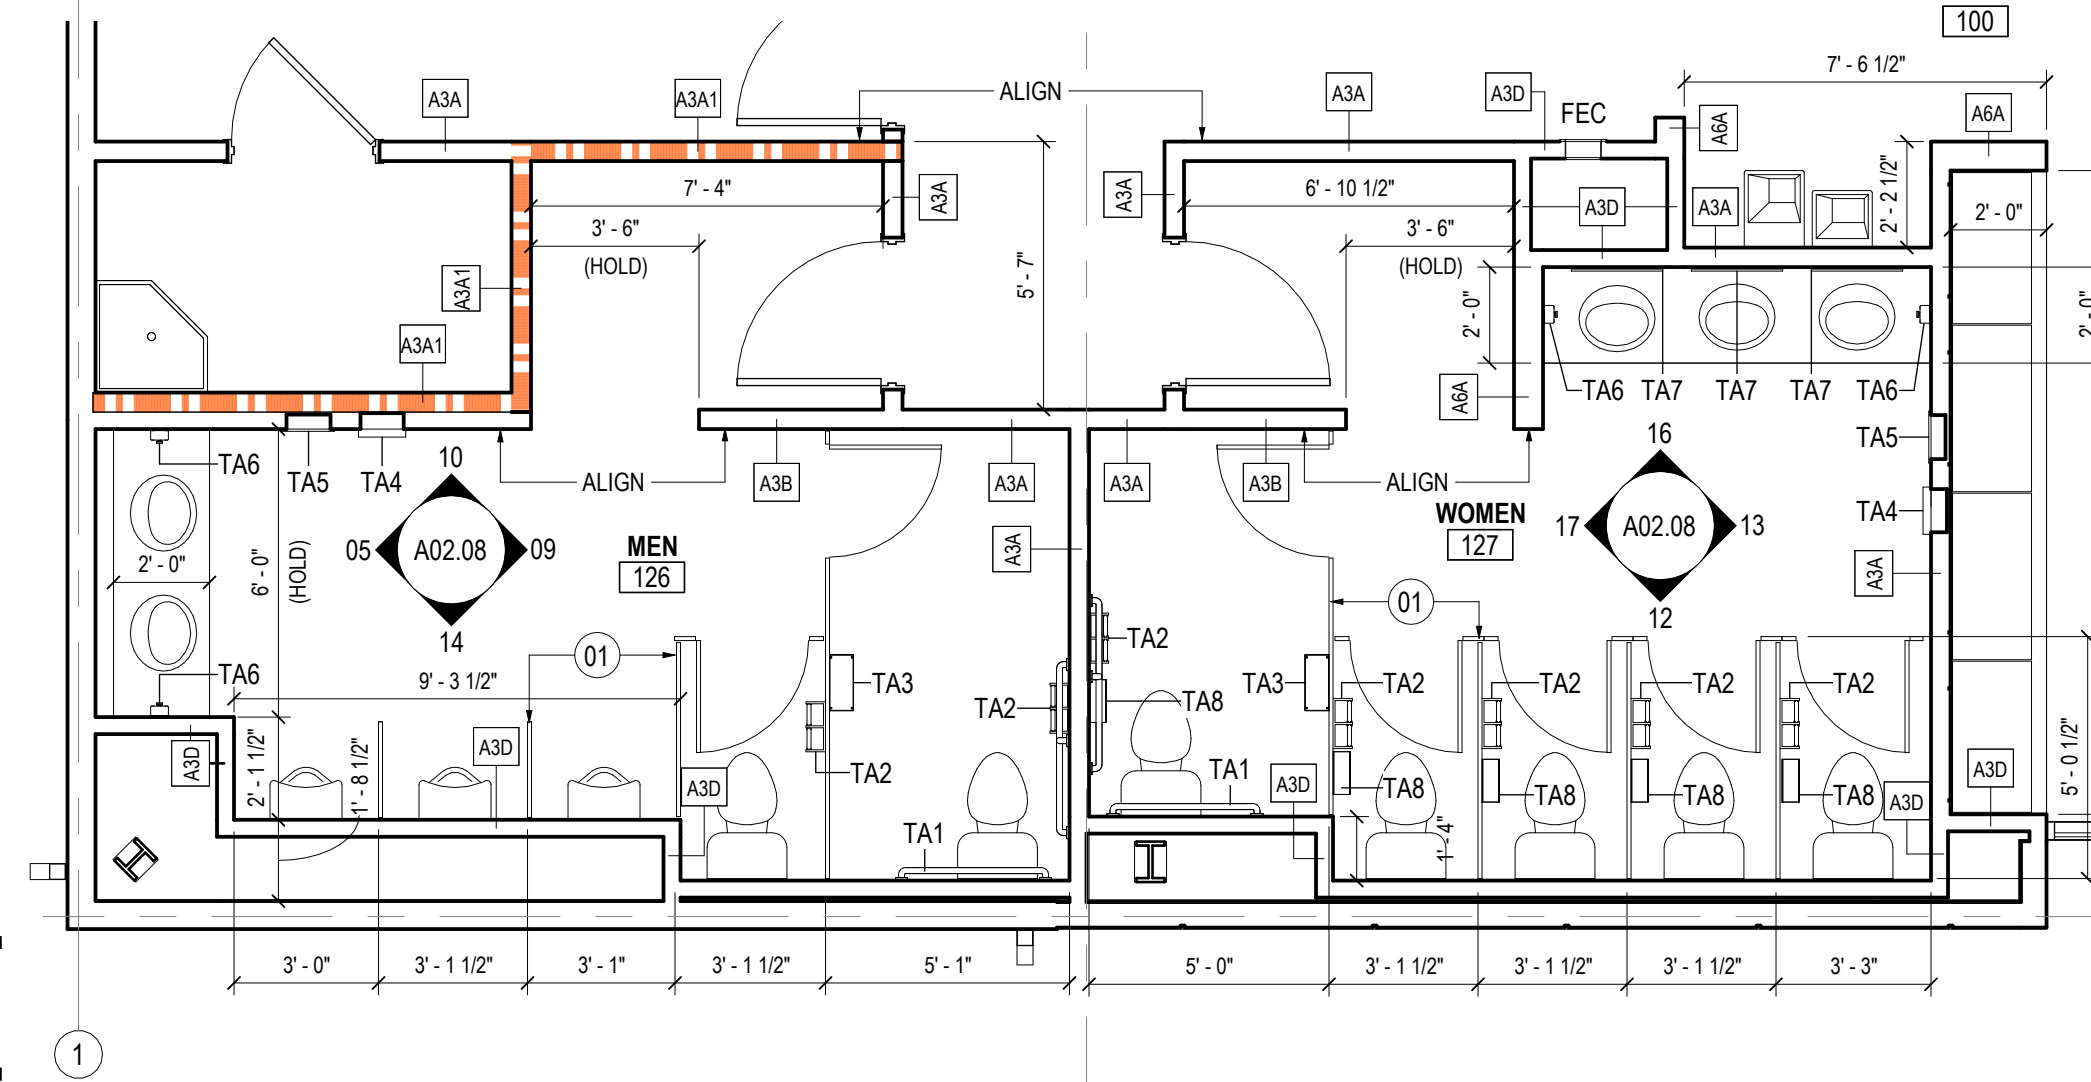

01 ENLARGED PLAN
SCALE: 1/4" = 1'-0"

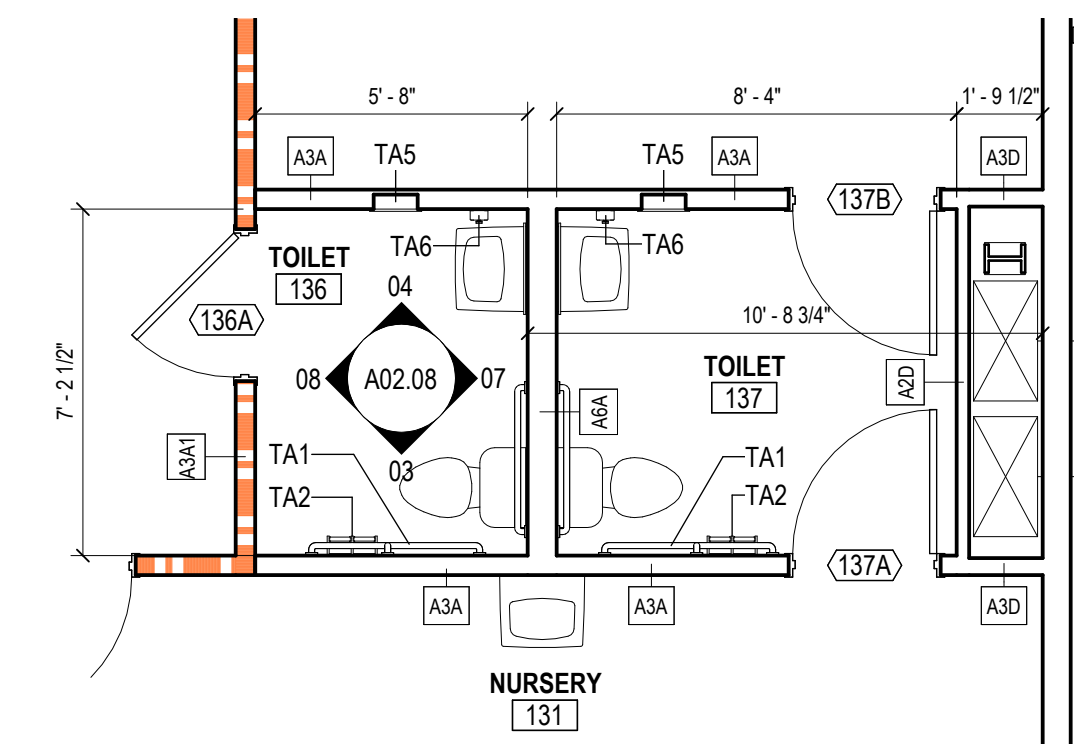


02 ENLARGED TOILETS PLAN
SCALE: 1/4" = 1'-0"

SHEET NOTES

01 STAINLESS STEEL TOILET PARTITIONS



4539 HEDGEMORE DRIVE, SUITE 101
CHARLOTTE NC 28209
704.890.2553
WWW.OSSASTUDIO.COM

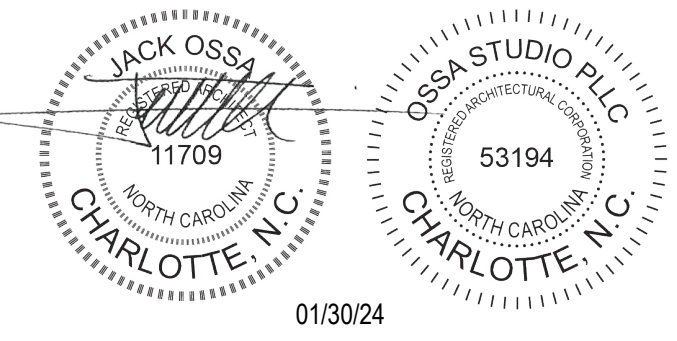

PROJECT TEAM

General Contractor
ECCLESIA CONSTRUCTION
www.ecclesiainc.com
803.327.5670


Civil Engineering
HILLIARD ENGINEERING, PLLC
www.hilliardep.com
919.352.2834

Structural Engineering
PROVIDENCE PARTNERS
www.providencpartnersinc.com
704.266.6621

Mechanical, Electrical, Plumbing & Fire Protection
ENGINEERING
www.engineer.com
704.287.2193

Date	Description
01/30/24	FOR CONSTRUCTION


GENERAL NOTES

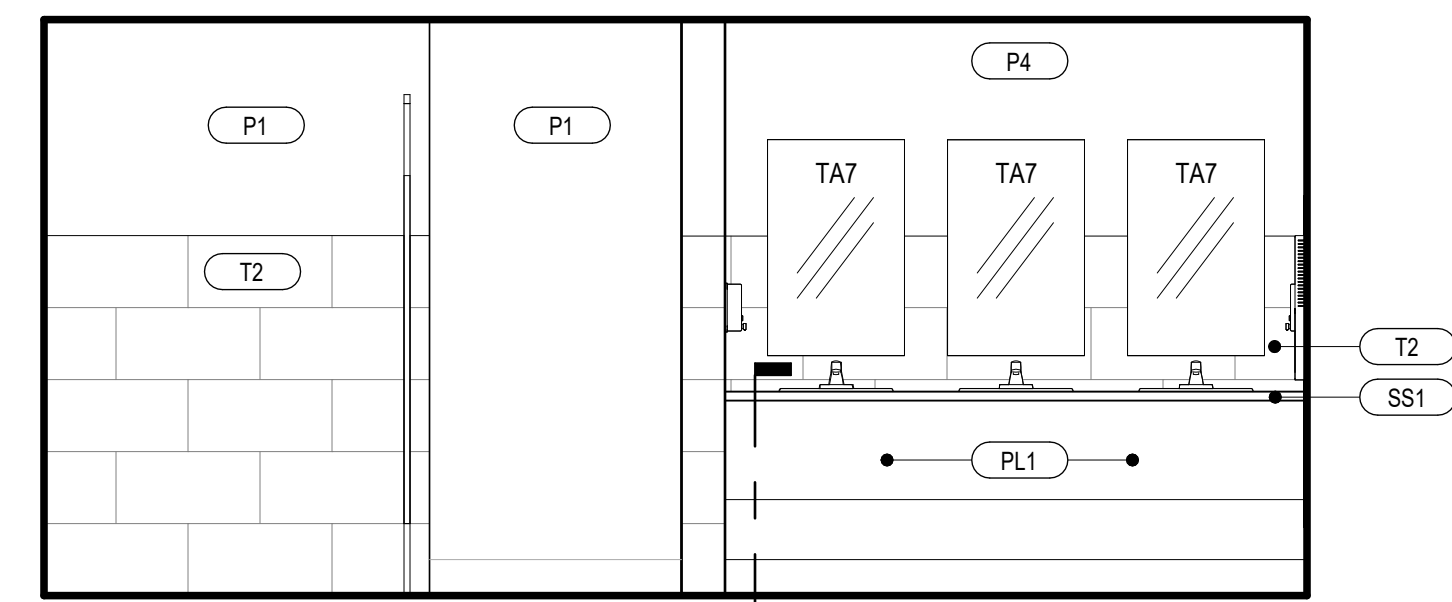


16 INTERIOR ELEVATION M
SCALE: 3/8" = 1'-0"




12 INTERIOR ELEVATION I
SCALE: 3/8" = 1'-0"

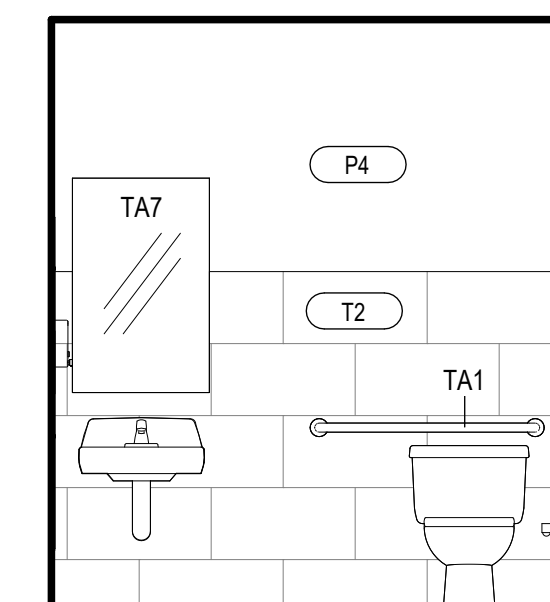


07 INTERIOR ELEVATION D
SCALE: 3/8" = 1'-0"

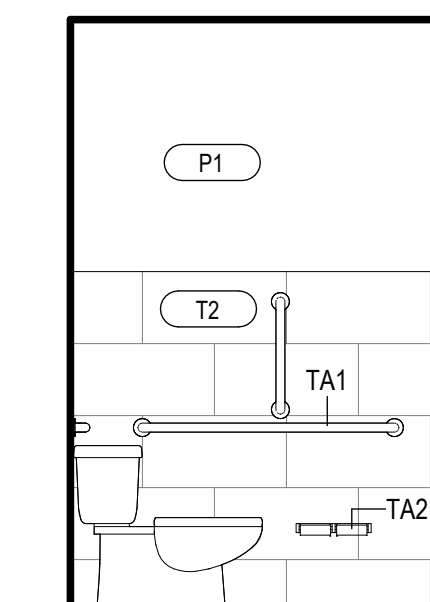


03 INTERIOR ELEVATION A
SCALE: 3/8" = 1'-0"

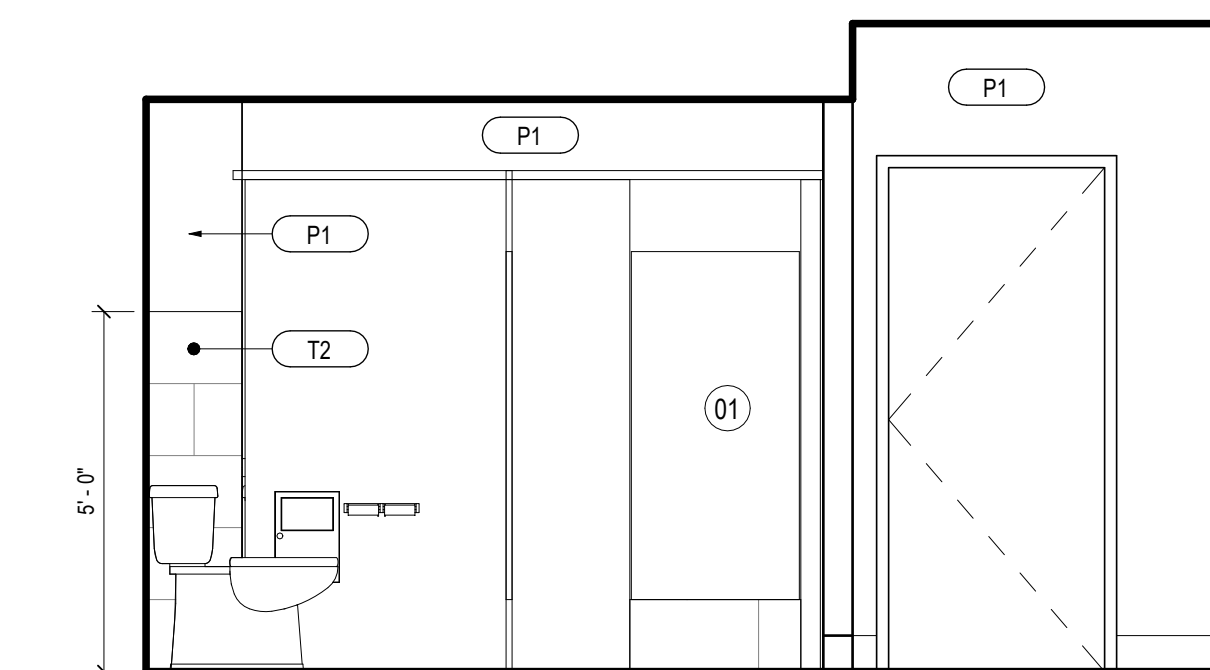


17 INTERIOR ELEVATION N
SCALE: 3/8" = 1'-0"

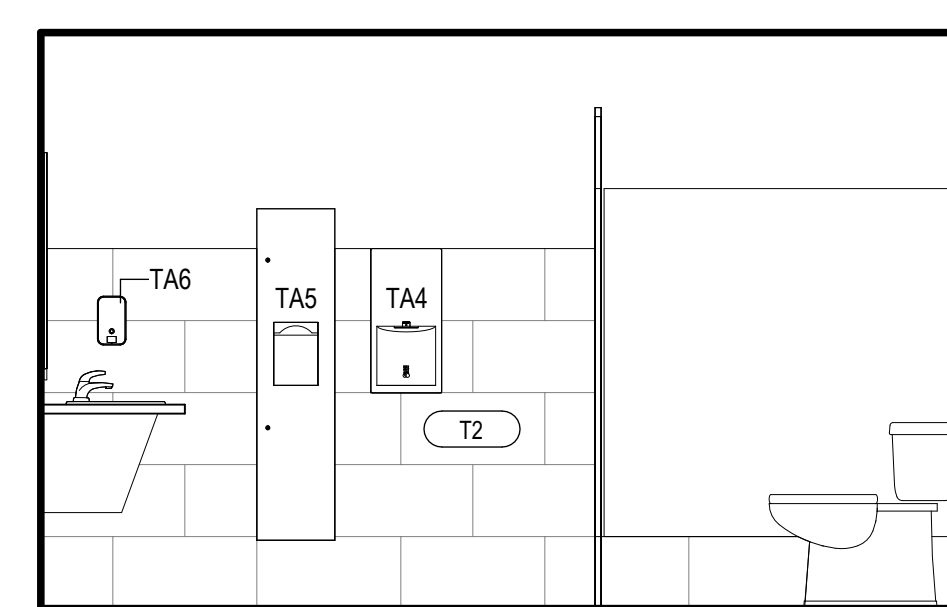

13 INTERIOR ELEVATION J
SCALE: 3/8" = 1'-0"

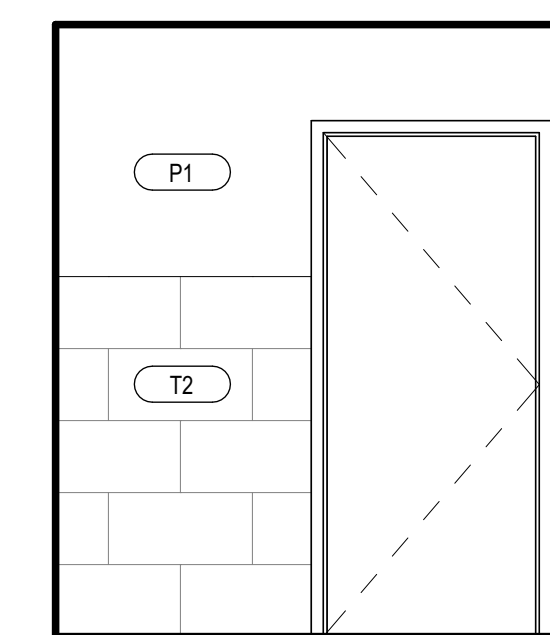


08 INTERIOR ELEVATION E
SCALE: 3/8" = 1'-0"

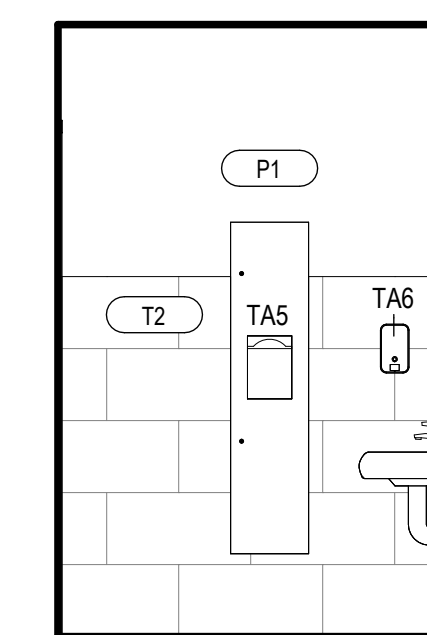


04 INTERIOR ELEVATION B
SCALE: 3/8" = 1'-0"

ID	DESCRIPTION	MANUFACTURER	MODEL	COMMENTS
FEC	Wall Mounted Fire Extinguisher Cabinet	Babcock-Davis	BFC3C	
TA1	42" 36" AND 18" ADA GRAB BARS	BOBRICK		
TA2	TOILET TISSUE DISPENSER	BOBRICK	B-2740	
TA3	MOUNTED WASTE RECEPTACLE	BOBRICK	B-279	
TA4	HAND DRYER	BOBRICK	B-3725 115V	
TA5	PAPER TOWEL DISPENSE / WASTE RECEPTACLE	BOBRICK	B-38034	
TA6	SOAP DISPENSER	BOBRICK	B-2111	
TA7	WALL MOUNTED MIRROR	BOBRICK	B-165 2436	
TAB	SANITARY NAPKIN DISPOSAL	BOBRICK	B-3613	

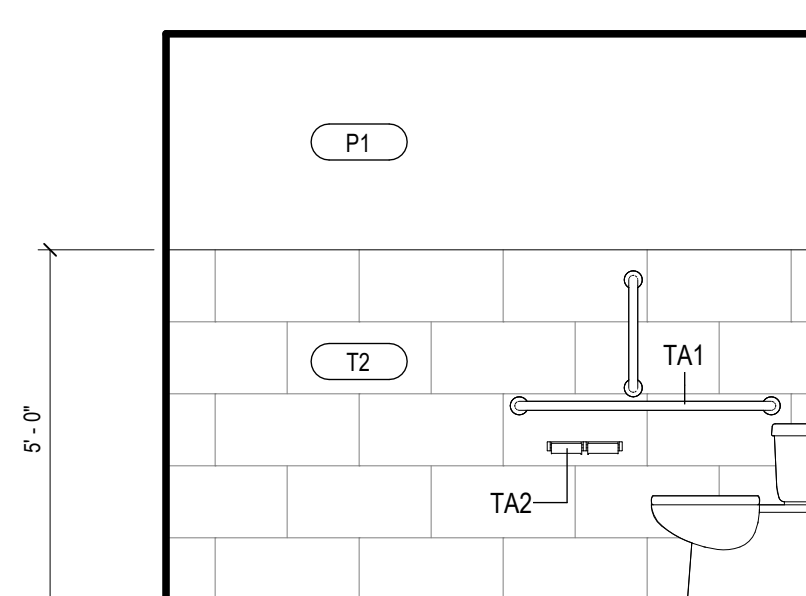


09 INTERIOR ELEVATION F
SCALE: 3/8" = 1'-0"

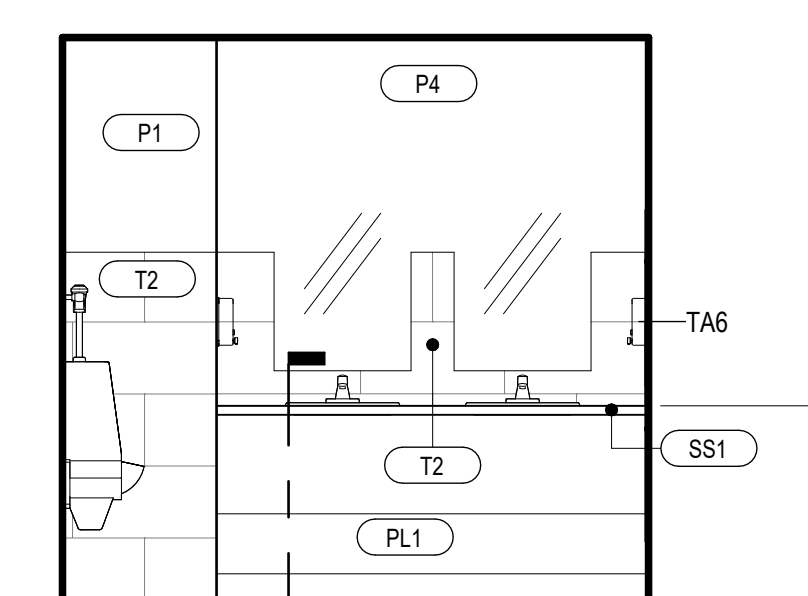


05 INTERIOR ELEVATION C
SCALE: 3/8" = 1'-0"

A02.08

MATERIALS SCHEDULE						
TAG	DESCRIPTION	MANUFACTURER	NAME	COMMENTS	CONTACT	
ACT1	ACOUSTICAL CEILING TILE	ARMSTRONG	CORTEGA #789	24" x 24" - 15/16" PRELUDE XL GRID		
AG1	PRE-FIN. ALUMINUM GUTTER			OWNER FURNISHED		
AP1	SUSPENDED ACOUSTICAL PANEL SYSTEM	ACOUSTICAL PRODUCTS & SYSTEMS	ECOCORE	AME-08 ANTIQUE WHITE		SCOTT REASON sreason@biboyd.com
AS1	ALUMINUM STOREFRONT	YKK	THERMALLY BROKEN	ANODIZED ALUMINUM FINISH - 6 1/4"x2 1/2" MULLION		
CMU1	CONCRETE MASONRY UNIT	JOHNSON CONCRETE PRODUCTS	BLACK BOULDER JCL-3621	8"x16"x4" GROUND FACE (STACK BOND) w/ HOLCIM SANTEE BLACK S MORTAR		
CP11	CARPET TILE - GRAY	TARKETT	AGGREGATE 11016 ANCHOR BOLT 28301	MONOLITHIC - PROVIDE TARKETT METAL EDGE TRANSITION STRIP AT ALL TRANSITIONS	2'-0" x 2'-0" TILES	
CP12	CARPET TILE - BLUE	TARKETT	CHAIN REACTION 11183 SHUTTLE SAPPHIRE 72207	MONOLITHIC - PROVIDE TARKETT METAL EDGE TRANSITION STRIP AT ALL TRANSITIONS	2'-0" x 2'-0" TILES	
EIFS1	EXTERIOR INSULATION FINISHING SYSTEM	DRYVIT	DPR FINISHES	SANDBLAST - .626A Cloudy Day		
EIFS2	EXTERIOR INSULATION FINISHING SYSTEM	DRYVIT	DPR FINISHES	SANDBLAST - .621 White Gray		
GL1	1" INSULATED GLASS	GUARDIAN - SUNGUARD	SNX 6227	TEMPERED LOW E		TYPICAL AT EXTERIOR WALL
GL2	INTERIOR GLASS		1/4" TEMPERED GLASS			
LVT1	LUXURY VINYL TILE	TARKETT	ID LATITUDE WOOD #692	6"x6"		
P1	PAINT - WHITE	SHERWIN WILLIAMS	SW 6196 FROSTY WHITE	WALLS - EGGSHELL - DOORS, FRAMES, TRIM : SEMIGLOSS		
P2	PAINT - BLACK	SHERWIN WILLIAMS	TBD	WALLS - EGGSHELL - DOORS, FRAMES, TRIM : SEMIGLOSS		
P3	PAINT - DARK GRAY	SHERWIN WILLIAMS	SW 7045 SOFTWARE	WALLS - EGGSHELL - DOORS, FRAMES, TRIM : SEMIGLOSS		
P4	PAINT - BLUE	SHERWIN WILLIAMS	SW 6958 DYNAMIC BLUE	WALLS - EGGSHELL - DOORS, FRAMES, TRIM : SEMIGLOSS		
PL1	PLASTIC LAMINATE	FORMICA	5795 NG	WALLS - EGGSHELL - DOORS, FRAMES, TRIM : SEMIGLOSS		
PW1	PAINTED WOOD CAP			PAINTED TO MATCH WALL		
RL1	PRE-FIN. ALUMINUM DOWNSPOUT			OWNER FURNISHED		
SC1	SEALED CONCRETE - SCARIFY TO AN EVEN FLAT SURFACE					
SS1	SOLID SURFACE	FORMICA	406 LUNA BRITTE WHITE	26" X COUNTERTOP LENGTH		1 1/2" FRONT
SS2	SOLID SURFACE	FORMICA	406 LUNA BRITTE WHITE	10" X COUNTERTOP LENGTH - PROVIDE PLYWOOD BACKING		1 1/2" FRONT
SSM1	STANDING SEAM METAL ROOF			OWNER FURNISHED		
T1	CERAMIC TILE	CROSSVILLE	MAGMA AV295	PROVIDE ANTIFRACTURE MEMBRANE - STRAIGHT STACK - GROUT: MAPEI 107 IRON-FER-HIERRO		PROVIDE SCHLUTER STRIP AT ALL EDGES
T2	CERAMIC TILE	CROSSVILLE	FLANNEL SUIT AV317	PROVIDE ANTIFRACTURE MEMBRANE - STRAIGHT STACK - GROUT: MAPEI 107 IRON-FER-HIERRO		PROVIDE SCHLUTER STRIP AT ALL EDGES
WB1	WALL - GRAY	TARKETT	PERCEPTIONS	RWDC CONTOUR TAS COLONIAL GRAY		4'25"
WB2	APPLIED 1/2" MDF			PAINTED TO MATCH WALL		12" TALL
WB3	WALL BASE - BLUE	TARKETT	PERCEPTIONS	RWDC 18 CONTOUR 18 NAVY BLUE		4'25"

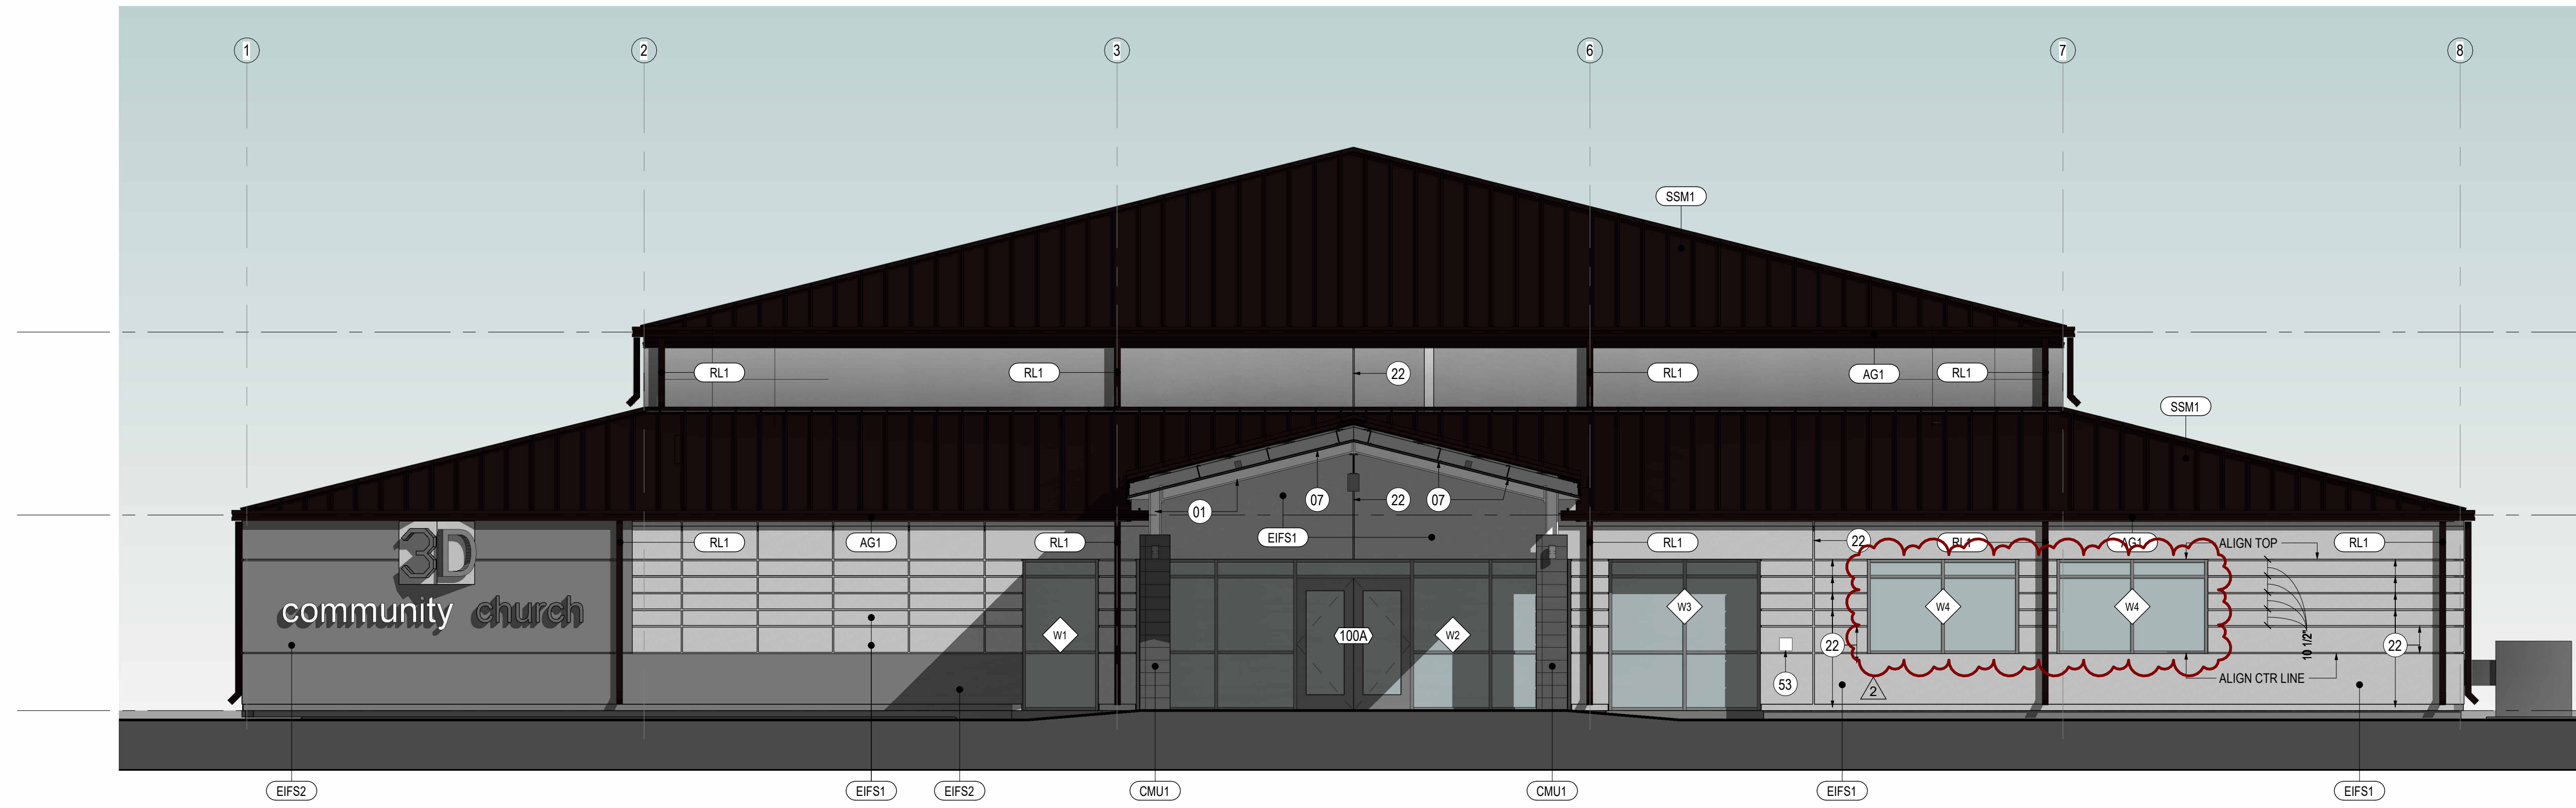

01 FRONT ELEVATION
SCALE: 3/16" = 1'-0"

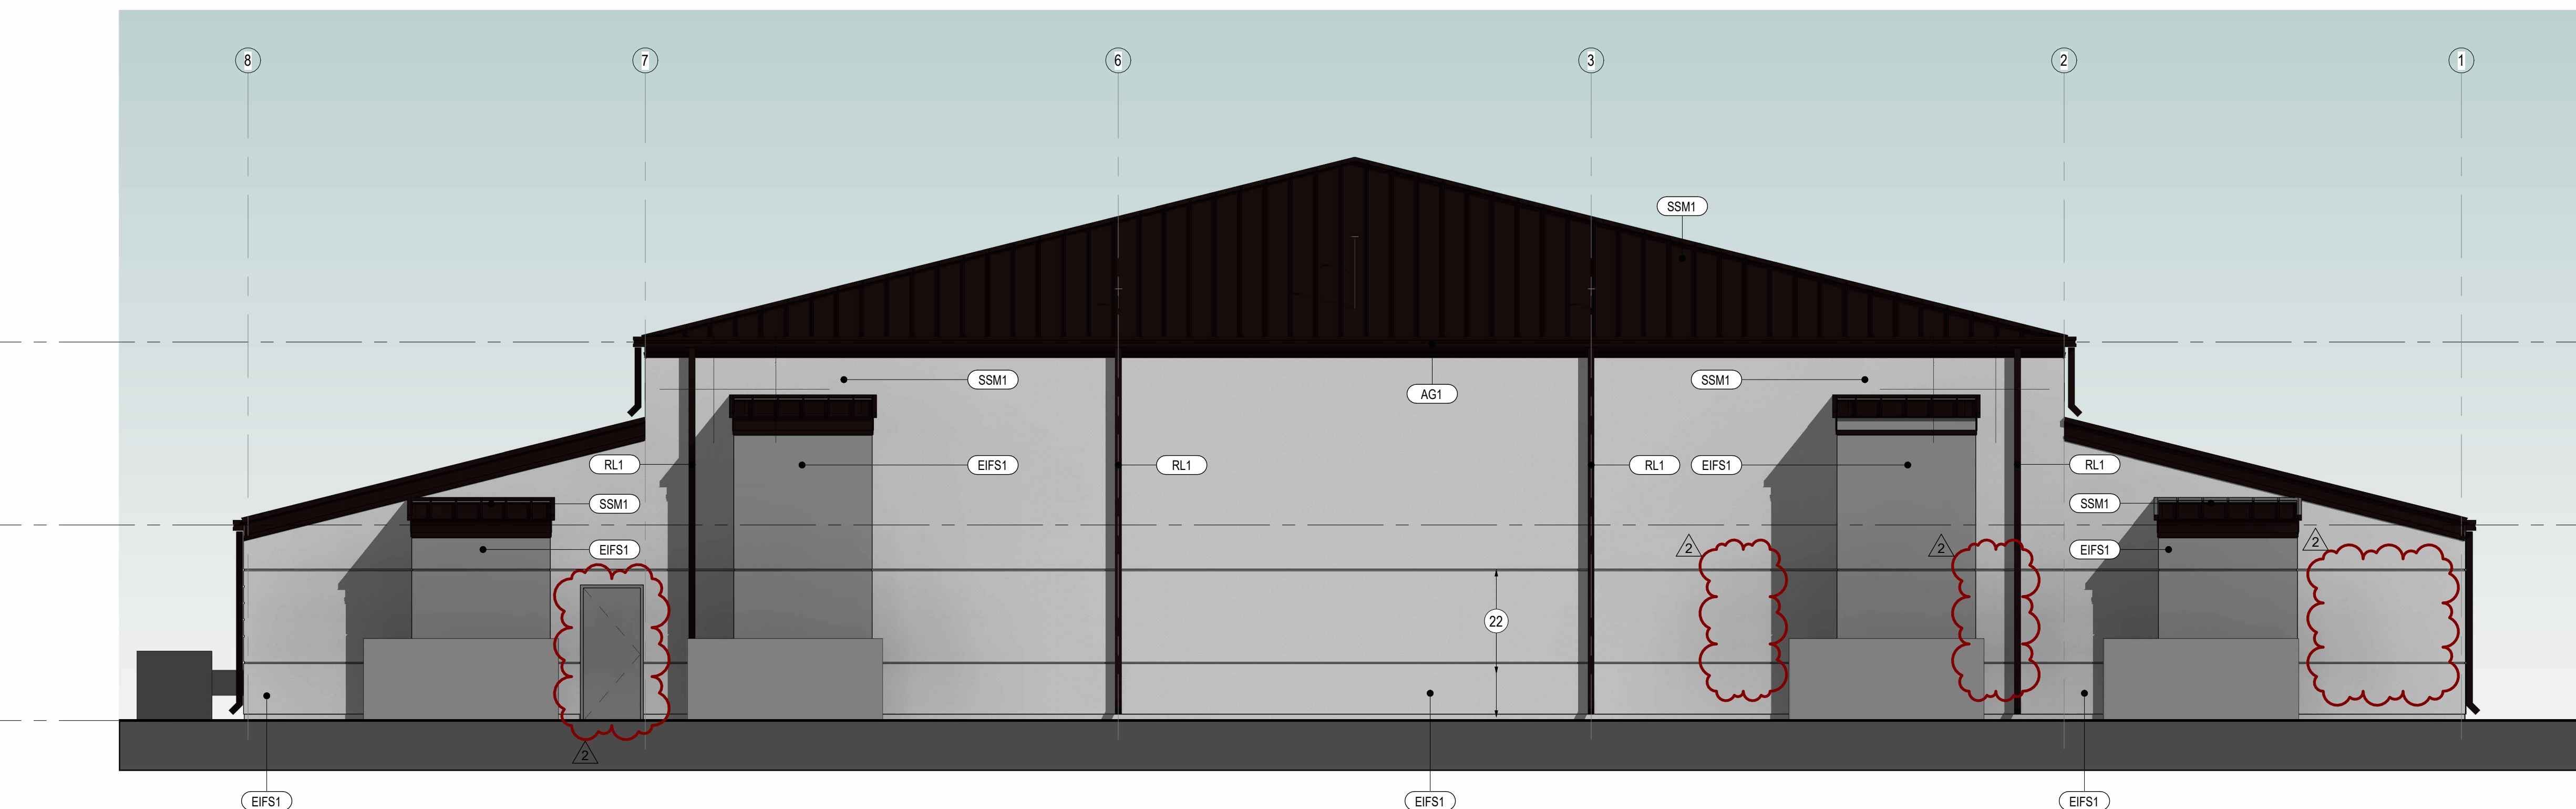


02 REAR ELEVATION
SCALE: 3/16" = 1'-0"

SHEET NOTES

- 01 STRUCT. STL. - PAINT BLACK WHERE EXPOSED
- 02 GWB AND MDF STAGE APRON - PAINT BLACK
- 03 ELEVATED FLOOR w/ LVT FINISH ON 1/4" T. TEMPERED MASONITE, 1/2" HOMASOTE, AND 3/4" FRT PLYWOOD ON MTL. STUD FRAMING (SEE STRUCT.)
- 04 SLOPED GWB "CLOUD" AT UNDERSIDE OF STL. STRUCT.
- 07 MTL PANEL CEILING SYSTEM MTL. BLDG. MANUF. LIGHTING TRUSS (SEE STRUCT.)
- 08 RAMP w/ LVT FINISH ON (2) LAYERS 3/4" FRT PLYWOOD ON MTL. STUD FRAMING (SEE STRUCT.)
- 10 STAIR w/ LVT FINISH ON (2) LAYERS 3/4" FRT PLYWOOD ON MTL. STUD FRAMING (SEE STRUCT.)
- 11 GWB CONTROL JOINT
- 12 EXPOSED ROOF INSULATION
- 13 MTL Z PURLIN (TYP.)
- 14 SUSPENDED PROJECTION SCREEN
- 15 LED CYLINDER PENDANT LIGHT FIXTURE (TYP.) (SEE ELEC.)
- 16 LED WALL SCONCE LIGHT FIXTURE (TYP.) (SEE ELEC.)
- 17 RECTANGULAR BEAM LED LIGHT FIXTURE (TYP.) (SEE ELEC.)
- 18 RECESSED LED LIGHT FIXTURE (TYP.) (SEE ELEC.)
- 20 8"x16"x4" CMU (PROVIDE TIES PER MANUF. REQS) ON MTL. STUD FURRING AT STL. COLUMN
- 21 E.F.S. - 1-1/2" R-7.5 RIGID INSUL AND 5/8" SHEATHING ON 3-5/8" MTL. STUD FRAMING W/ R-13 BLANKET INSUL.
- 22 REVEAL (TYP.)
- 23 8"x16"x4" CMU (PROVIDE TIES PER MANUF. REQS) W/ 1-1/2" AIR SPACE, 2" RIGID INSUL., AND 5/8" SHEATHING ON 3-5/8" MTL. STUD FRAMING W/ R-13 BLANKET INSUL.
- 24 STANDING SEAM MTL. ROOF (OWNER FURNISHED)
- 25 CONT. R-11 VINYL-FACED BLANKET INSUL ON R-3 THERMAL SPACER BLOCKS (THERMAL SPACER BLOCKS TYP. AT EA. PURLIN)
- 26 R-19 FIBERGLASS BLANKET INSUL. BET. PURLINS (PROVIDE LONGITUDINAL AND TRANSVERSE MTL. SUPPORT BANDING)
- 27 CONT. BLACK FIBER-REINFORCED VAPOR BARRIER MEMBRANE AT BOTTOM OF PURLINS
- 28 GUTTER AND FLASHING BY MTL. BLDG. MANUF.
- 29 DOWNSPOUTS BY MTL. BLDG. MANUF. (TYP.)
- 31 3/8" T. x 2 1/4" D. CLEAR TEMPERED GLASS SHELVES (TYP.)
- 32 ADJUSTABLE SHELF BRACKETS & FLUSH-MOUNTED SHELF TRACKS (TYP.)
- 33 RAKES INSIDE WALL MOUNT EH COUNTER SUPPORT BRACKETS
- 34 OPEN TO UPPER ROOF ABOVE
- 35 MTL. C. PURLIN BY MTL. BLDG. MANUF.
- 36 PRE-FIN. COUNTER FLASHING
- 37 TIE-IN TRIM BY MTL. BLDG. MANUF.
- 38 BACK-UP PLATE BY MTL. BLDG. MANUF.
- 39 OUTSIDE MTL. CLOSURE BY MTL. BLDG. MANUF.
- 41 STL. SPANREL ANGLE AT BOTTOM OF MTL. Z PURLINS BY MTL. BLDG. MANUFACTURER
- 42 COMPRESSIBLE FILLER
- 43 NEW CONC. SIDEWALK
- 44 ALUM. DOOR AS SCHEDULED
- 45 DOOR THRESHOLD AS SCHEDULED - SET ON FULL BED OF MASTIC
- 46 TURNED-DOWN CONC. SLAB (SEE STRUCT.)
- 47 STRUCT. STL. COLUMN
- 48 STRUCT. STL. MOMENT FRAME - PAINT BLACK WHERE EXPOSED
- 49 SOUND ATTENUATION BLANKET (TYP.)
- 51 LINEAR SLOT RETURN (SEE MECH.)
- 52 MTL. SUPPORT BANDING - SPACE AS DIMENSIONED ON ENLARGED RCP (TYP.)
- 53 UNHINGED / RECESSED KNOXBOX (ALUM. FIN.)
- 54 FLUID-APPLIED AIR BARRIER MEMBRANE
- 55 JOINT SEALANT AND BACKER ROD
- 56 ALUM. STOREFRONT SYSTEM
- 57 E.F.S. - 1-1/2" R-7.5 RIGID INSUL AND 5/8" SHEATHING ON 6" MTL. STUD FRAMING W/ R-13 BLANKET INSUL.
- 59 E.F.S. DRAINABLE TRACK
- 60 THRU-WALL STAINLESS STL. FLASHING W/ DRIP EDGE - FLASHED INTO AIR AND WATER BARRIER MEMBRANE
- 61 R-19 FIBERGLASS BLANKET INSUL. BET. MTL. STUD FRAMING (PROVIDE LONGITUDINAL AND TRANSVERSE MTL. SUPPORT BANDING)
- 62 STANDING SEAM MTL. ROOF (OWNER FURNISHED) ON 3/4" FRT PLYWOOD ON 6" MTL. STUD FRAMING
- 68 ROLLERSHADE AT EA. EXT. WINDOW (TYP.)
- 69 EAVE TRIM, PANEL CAP TRIM, AND FLASHING BY MTL. BLDG. MANUF.
- 70 MTL. STUD BRACE (SEE STRUCT.)



4539 HEDGEMORE DRIVE, SUITE 101
CHARLOTTE NC 28209
704.890.2853
WWW.OSSASTUDIO.COM

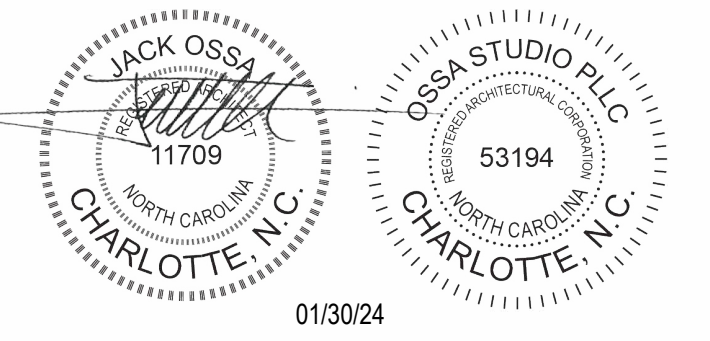


PROJECT TEAM

- General Contractor**
ECCLESIA CONSTRUCTION
www.ecclesiainc.com
803.327.5670
- Civil Engineering**
HILLIARD ENGINEERING, PLLC
www.heaecpp.com
919.352.2834
- Structural Engineering**
PROVIDENCE PARTNERS
www.providencpartnersinc.com
704.266.6621
- Mechanical, Electrical, Plumbing & Fire Protection**
ENGINEERING
www.egntecture.com
704.287.2193

Date	Description
01/30/24	FOR CONSTRUCTION
2 10/14/24	RTAP NO. 1

Project Name

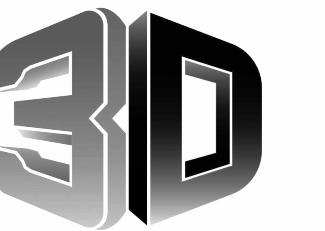

community church
making church come alive
658 GRAHAM ROAD
SANFORD NC 27311

Client

3D COMMUNITY CHURCH

Project Number

23024.00

Description

EXTERIOR ELEVATIONS

Scale

3/16" = 1'-0"

A03.01


SHEET NOTES

- 01 STRUCT. STL. - PAINT BLACK WHERE EXPOSED
- 02 GWB AND MDF STAGE APRON - PAINT BLACK
- 03 ELEVATED FLOOR w/ LVT FINISH ON 1/4" T. TEMPERED MASONITE, 1/2" HOMASOTE, AND 3/4" FRP PLYWOOD ON MTL. STUD FRAMING (SEE STRUCT.)
- 04 SLOPED GWB "CLOUD" AT UNDERSIDE OF STL. STRUCT.
- 07 MTL PANEL CEILING SYSTEM MTL. BLDG. MANUF. LIGHTING TRUSS (SEE STRUCT.)
- 09 RAMP w/ LVT FINISH ON (2) LAYERS 3/4" FRP PLYWOOD ON MTL. STUD FRAMING (SEE STRUCT.)
- 10 STAIR w/ LVT FINISH ON (2) LAYERS 3/4" FRP PLYWOOD ON MTL. STUD FRAMING (SEE STRUCT.)
- 11 GWB CONTROL JOINT
- 12 EXPOSED ROOF INSULATION
- 13 MTL Z PURLIN (TYP.)
- 14 SUSPENDED PROJECTION SCREEN
- 15 LED CYLINDER PENDANT LIGHT FIXTURE (TYP.) (SEE ELEC.)
- 16 LED WALL SCONCE LIGHT FIXTURE (TYP.) (SEE ELEC.)
- 17 RECTANGULAR BEAM LED LIGHT FIXTURE (TYP.) (SEE ELEC.)
- 18 RECESSED LED LIGHT FIXTURE (TYP.) (SEE ELEC.)
- 20 8"x16"x4" CMU (PROVIDE TIES PER MANUF. REQS.) ON MTL. STUD FURRING AT STL. COLUMN
- 21 E.F.S. - 1-1/2" R-7.5 RIGID INSUL. AND 5/8" SHEATHING ON 3-5/8" MTL. STUD FRAMING W/ R-13 BLANKET INSUL.
- 22 REVEAL (TYP.)
- 23 8"x16"x4" CMU (PROVIDE TIES PER MANUF. REQS.) W/ 1-1/2" AIR SPACE, 2" RIGID INSUL., AND 5/8" SHEATHING ON 3-5/8" MTL. STUD FRAMING W/ R-13 BLANKET INSUL.
- 24 STANDING SEAM MTL. ROOF (OWNER FURNISHED)
- 25 CONT. R-11 VINYL-FACED BLANKET INSUL ON R-3 THERMAL SPACER BLOCKS (THERMAL SPACER BLOCKS TYP. AT EA. PURLIN)
- 26 R-19 FIBERGLASS BLANKET INSUL. BET. PURLINS (PROVIDE LONGITUDINAL AND TRANSVERSE MTL. SUPPORT BANDING)
- 27 CONT. BLACK FIBER-REINFORCED VAPOR BARRIER MEMBRANE AT BOTTOM OF PURLINS
- 28 GUTTER AND FLASHING BY MTL. BLDG. MANUF.
- 29 DOWNSPOUTS BY MTL. BLDG. MANUF. (TYP.)
- 31 3/8" T. x 2 1/4" D. CLEAR TEMPERED GLASS SHELVES (TYP.)
- 32 ADJUSTABLE SHELF BRACKETS & FLUSH-MOUNTED SHELF TRACKS (TYP.)
- 33 RAKES INSIDE WALL MOUNT EH COUNTER SUPPORT BRACKETS
- 34 OPEN TO UPPER ROOF ABOVE
- 35 MTL. C PURLIN BY MTL. BLDG. MANUF.
- 36 PRE-FIN. COUNTER FLASHING
- 37 TIE-IN TRIM BY MTL. BLDG. MANUF.
- 38 BACK-UP PLATE BY MTL. BLDG. MANUF.
- 39 OUTSIDE MTL. CLOSURE BY MTL. BLDG. MANUF.
- 41 STL. SPANDREL ANGLE AT BOTTOM OF MTL. Z PURLINS BY MTL. BLDG. MANUFACTURER
- 42 COMPRESSIBLE FILLER
- 43 NEW CONC. SIDEWALK
- 44 ALUM. DOOR AS SCHEDULED
- 45 DOOR THRESHOLD AS SCHEDULED - SET ON FULL BED OF MASTIC
- 46 TURNED-DOWN CONC. SLAB (SEE STRUCT.)
- 47 STRUCT. STL. COLUMN
- 48 STRUCT. STL. MOMENT FRAME - PAINT BLACK WHERE EXPOSED
- 49 SOUND ATTENUATION BLANKET (TYP.)
- 51 LINEAR SLOT RETURN (SEE MECH.)
- 52 MTL. SUPPORT BANDING - SPACE AS DIMENSIONED ON ENLARGED RCP (TYP.)
- 53 UNHINGED / RECESSED KNOXBOX (ALUM. FIN.)
- 54 FLUID-APPLIED AIR BARRIER MEMBRANE
- 55 JOINT SEALANT AND BACKER ROD
- 56 ALUM. STOREFRONT SYSTEM
- 57 E.F.S. - 1-1/2" R-7.5 RIGID INSUL. AND 5/8" SHEATHING ON 6" MTL. STUD FRAMING W/ R-13 BLANKET INSUL.
- 59 E.F.S. DRAINABLE TRACK
- 60 THRU-WALL STAINLESS STL. FLASHING W/ DRIP EDGE - FLASHED INTO AIR AND WATER BARRIER MEMBRANE
- 61 R-19 FIBERGLASS BLANKET INSUL. BET. MTL. STUD FRAMING (PROVIDE LONGITUDINAL AND TRANSVERSE MTL. SUPPORT BANDING)
- 62 STANDING SEAM MTL. ROOF (OWNER FURNISHED) ON 3/4" FRP PLYWOOD ON 6" MTL. STUD FRAMING
- 68 ROLLERSHADE AT EA. EXT. WINDOW (TYP.)
- 69 EAVE TRIM, PANEL CAP TRIM, AND FLASHING BY MTL. BLDG. MANUF.
- 70 MTL. STUD BRACE (SEE STRUCT.)

MATERIALS SCHEDULE					
TAG	DESCRIPTION	MANUFACTURER	NAME	COMMENTS	CONTACT
ACT1	ACOUSTICAL CEILING TILE	ARMSTRONG	CORTEGA #769	24" x 24", - 15/16" PRELUDE XL GRID	
AG1	PRE-FIN. ALUMINUM GUTTER	-	-	OWNER FURNISHED	
AP1	SUSPENDED ACOUSTICAL PANEL SYSTEM	ACOUSTICAL PRODUCTS & SYSTEMS	ECOCORE	AME-08 ANTIQUE WHITE	SCOTT REASON sreason@bbwyd.com
AS1	ALUMINUM STOREFRONT	YKK	THERMALLY BROKEN	ANODIZED ALUMINUM FINISH - 6 1/4" x 1/2" MULLION	
CMU1	CONCRETE MASONRY UNIT	JOHNSON CONCRETE PRODUCTS	BLACK BOULDER JCL-3621	8"x16"x4" GROUND FACE (STACK BOND) w/ HOLCIM SANTEE BLACK S MORTAR	
CPT1	CARPET TILE - GRAY	TARKETT	AGGREGATE 11016 ANCHOR BOLT 28301	MONOLITHIC - PROVIDE TARKETT METAL EDGE TRANSITION STRIP AT ALL TRANSITIONS	2'-0" x 2'-0" TILES
CPT2	CARPET TILE - BLUE	TARKETT	CHAIN REACTION 11683 SHUTTLE SAPPHIRE Y2207	MONOLITHIC - PROVIDE TARKETT METAL EDGE TRANSITION STRIP AT ALL TRANSITIONS	2'-0" x 2'-0" TILES
EFS1	EXTERIOR INSULATION FINISHING SYSTEM	DRYVIT	DPR FINISHES	SANDBLAST - 626A Cloudy Day	
EFS2	EXTERIOR INSULATION FINISHING SYSTEM	DRYVIT	DPR FINISHES	SANDBLAST - 621 White Gray	
GL1	1" INSULATED GLASS	GUARDIAN - SUNGUARD	SNX 6227	TEMPERED LOW E	TYPICAL AT EXTERIOR WALL
GL2	INTERIOR GLASS	-	1/4" TEMPERED GLASS	-	
LVT1	LUXURY VINYL TILE	TARKETT	10 LATITUDE WOOD 4692	6"x6"	
P1	PAINT - WHITE	SHERWIN WILLIAMS	SW 6186 FROSTY WHITE	WALLS : EGG-SHELL - DOORS, FRAMES, TRIM : SEMI-GLOSS	
P2	PAINT - BLACK	SHERWIN WILLIAMS	TBD	WALLS : EGG-SHELL - DOORS, FRAMES, TRIM : SEMI-GLOSS	
P3	PAINT - DARK GRAY	SHERWIN WILLIAMS	SW 7045 SOFTWARE	WALLS : EGG-SHELL - DOORS, FRAMES, TRIM : SEMI-GLOSS	
P4	PAINT - BLUE	SHERWIN WILLIAMS	SW 6958 DYNAMIC BLUE	WALLS : EGG-SHELL - DOORS, FRAMES, TRIM : SEMI-GLOSS	
PL1	PLASTIC LAMINATE	FORMICA	5735 NG	WALLS : EGG-SHELL - DOORS, FRAMES, TRIM : SEMI-GLOSS	
PM1	PAINTED WOOD CAP	-	-	PAINTED TO MATCH WALL	
RL1	PRE-FIN. ALUMINUM DOWNSPOUT	-	-	1X WOOD OWNER FURNISHED	
SC1	SEALED CONCRETE - SCARIFY TO AN EVEN FLAT SURFACE	-	-	-	
SS1	SOLID SURFACE	FORMICA	406 LUNA BRITTE WHITE	25" X COUNTERTOP LENGTH	1 1/2" FRONT
SS2	SOLID SURFACE	FORMICA	406 LUNA BRITTE WHITE	10" X COUNTERTOP LENGTH - PROVIDE PLYWOOD BACKING	1 1/2" FRONT
SSM1	STANDING SEAM METAL ROOF	-	-	OWNER FURNISHED	
T1	CERAMIC TILE	CROSSVILLE	MAGMA AV295	PROVIDE ANTI-FRACTURE MEMBRANE - STRAIGHT STACK - GROUT: MAPEI 107 IRON-FER-HIERRO	PROVIDE SCHLUTER STRIP AT ALL EDGES
T2	CERAMIC TILE	CROSSVILLE	FLANNEL SUIT AV317	PROVIDE ANTI-FRACTURE MEMBRANE - STRAIGHT STACK - GROUT: MAPEI 107 IRON-FER-HIERRO	PROVIDE SCHLUTER STRIP AT ALL EDGES
WB1	WALL - GRAY	TARKETT	PERCEPTIONS	RWDC CONTOUR TAS COLONIAL GRAY	4.25"
WB2	APPLIED 1/2" MDF	-	-	PAINTED TO MATCH WALL	12" TALL
WB3	WALL BASE - BLUE	TARKETT	PERCEPTIONS	RWDC 18 CONTOUR 18 NAVY BLUE	4.25"




4539 HEDGEMORE DRIVE, SUITE 101
CHARLOTTE NC 28209
704.890.2653
WWW.OSSASTUDIO.COM

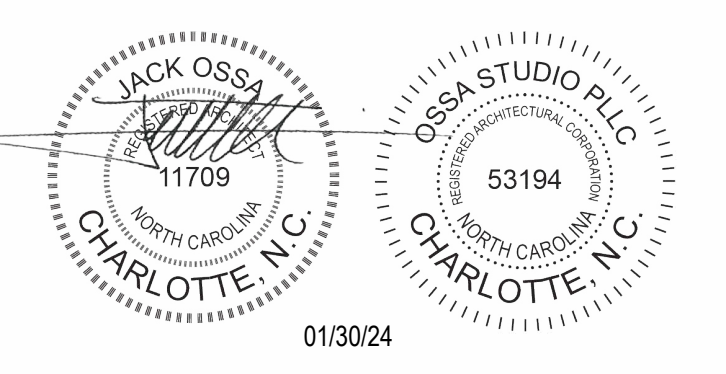


- PROJECT TEAM**
- General Contractor**
ECCLESIA CONSTRUCTION
www.ecclesiainc.com
803.327.5670
- Civil Engineering**
HILLIARD ENGINEERING, PLLC
www.hilliardep.com
919.352.2834
- Structural Engineering**
PROVIDENCE PARTNERS
www.providencepartnersinc.com
704.266.6621
- Mechanical, Electrical, Plumbing & Fire Protection**
ENGINEERING
www.engineering.com
704.287.2193

Date	Description
01/30/24	FOR CONSTRUCTION
2 10/14/24	RTAP NO. 1

01 LEFT ELEVATION
SCALE: 3/16" = 1'-0"

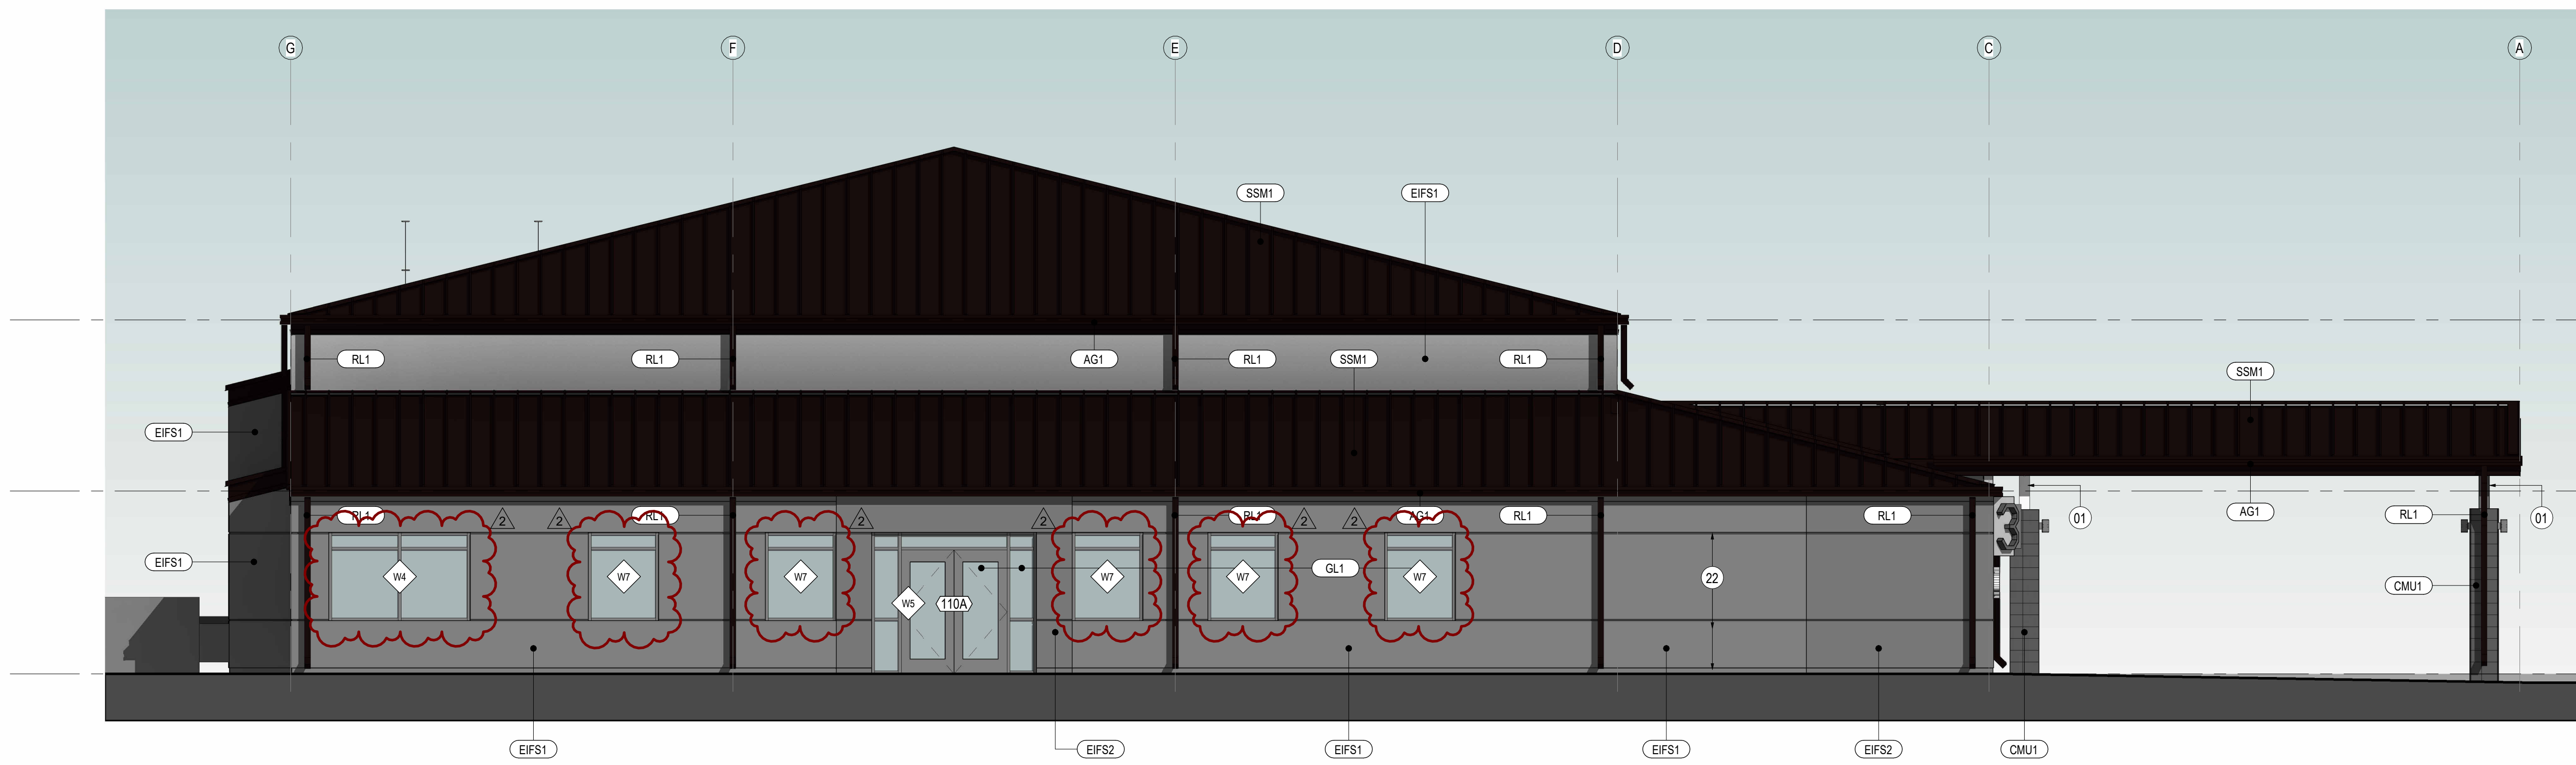

02 RIGHT ELEVATION
SCALE: 3/16" = 1'-0"

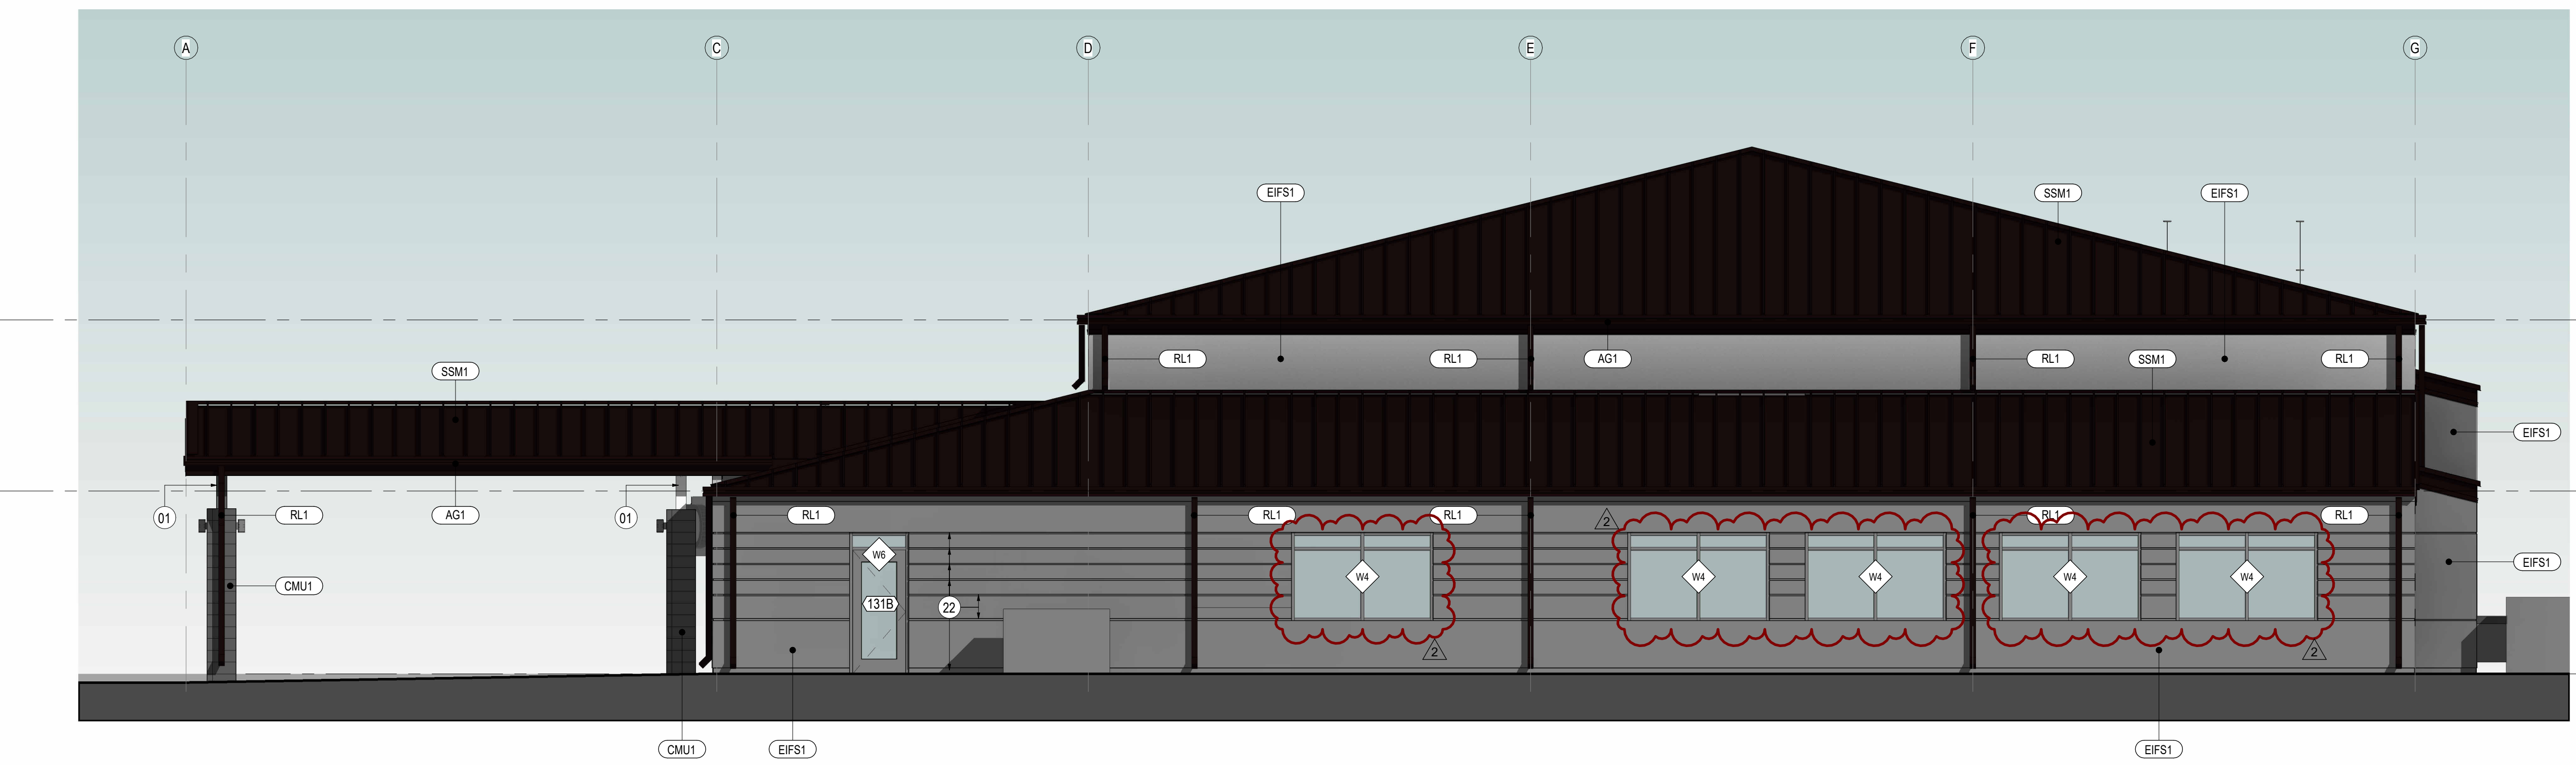

Project Name

3D
community church
making church come alive
658 GRAHAM ROAD
SANFORD NC 27311

Client

3D COMMUNITY CHURCH

Project Number

23024.00

Description

EXTERIOR ELEVATIONS

Scale
3/16" = 1'-0"


A03.02

10/14/2024 5:07:01 PM C:\Private\Drawings\Local\23024.00_3D Community Church\exterior\01\FHCL.rvt



Ossa
STUDIO

4539 HEDGEMORE DRIVE, SUITE 101
CHARLOTTE NC 28209
704.890.2553
WWW.OSSASTUDIO.COM

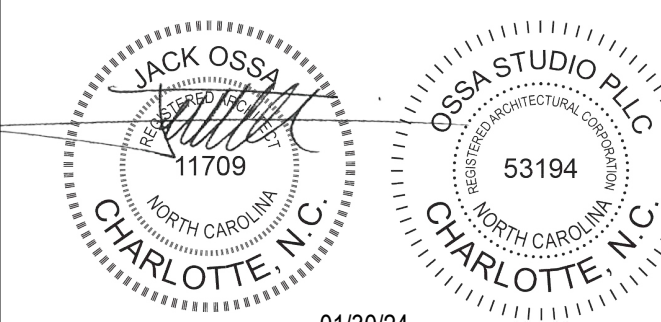

PROJECT TEAM

General Contractor
ECCLESIA CONSTRUCTION
www.ecclesiainc.com
803.327.5670


Civil Engineering
HILLIARD ENGINEERING, PLLC
www.hilliardepp.com
919.352.2834

Structural Engineering
PROVIDENCE PARTNERS
www.providencpartnersinc.com
704.266.6621


Mechanical, Electrical, Plumbing & Fire Protection
ENGINEERING
www.engineering.com
704.287.2193

Date	Description
01/30/24	FOR CONSTRUCTION
1 05/8/24	PERMIT REVIEW COMMENTS

GENERAL NOTES

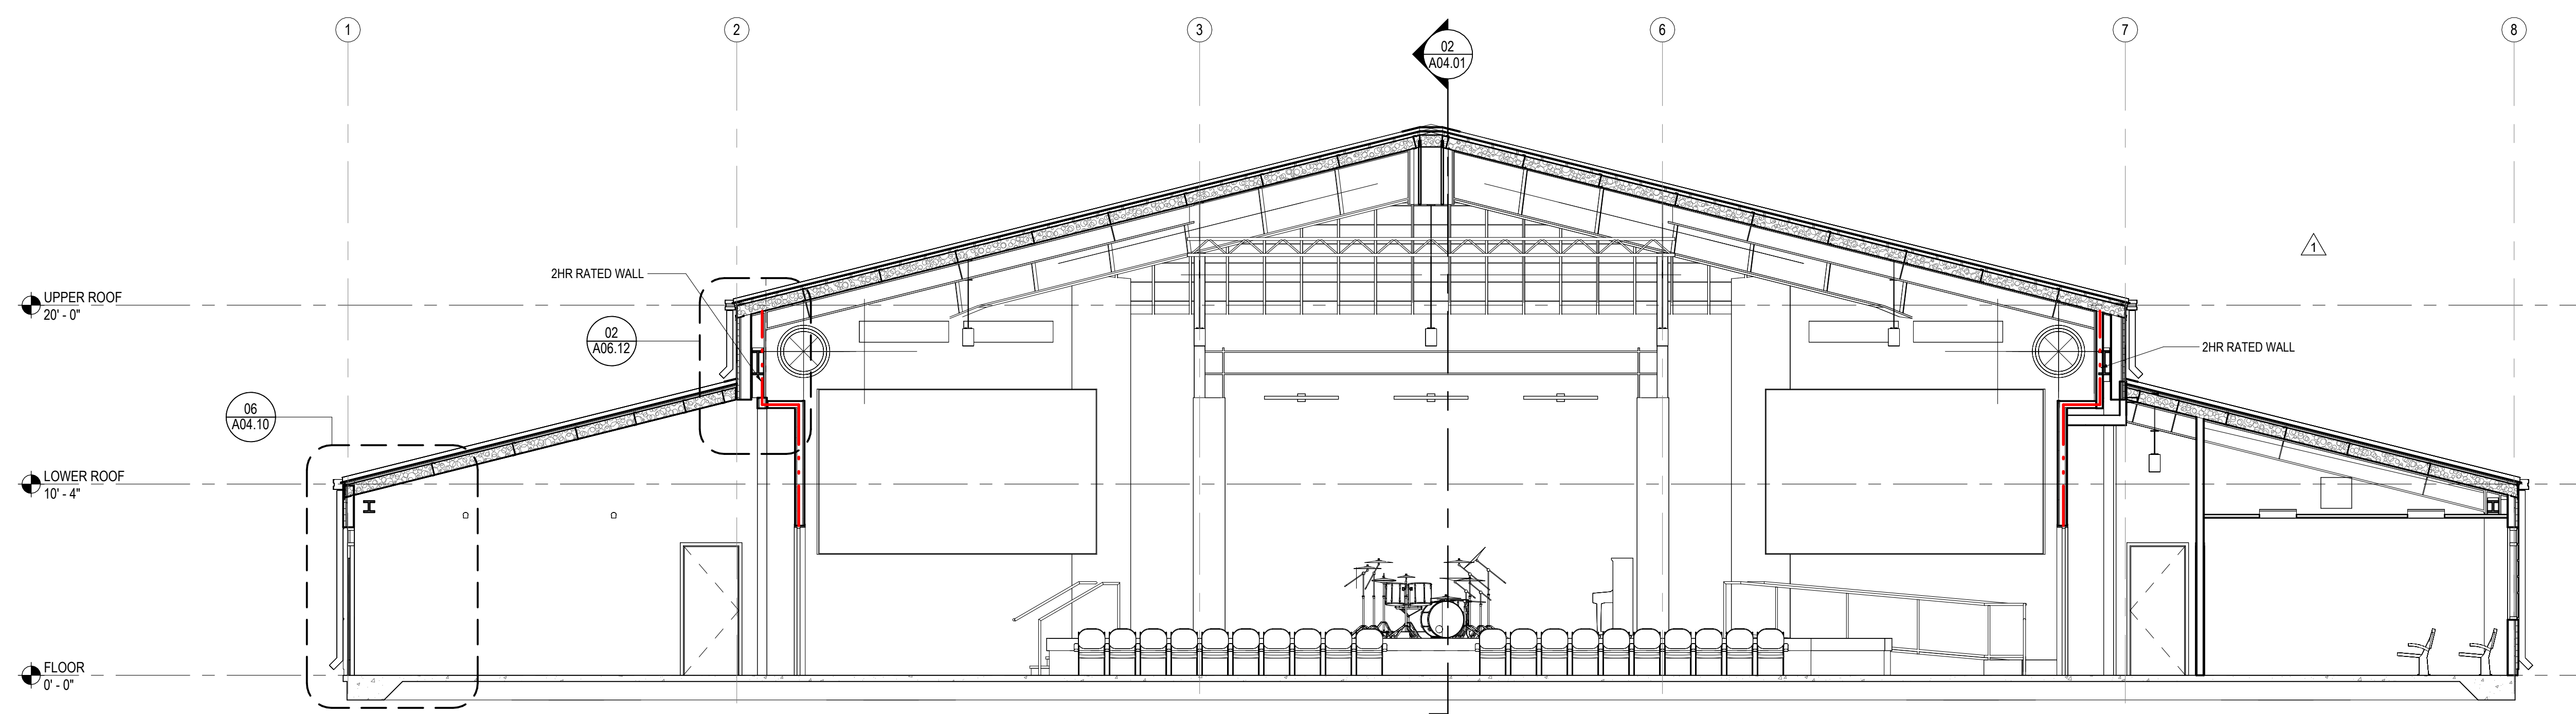

01 Section 1
SCALE: 3/16" = 1'-0"

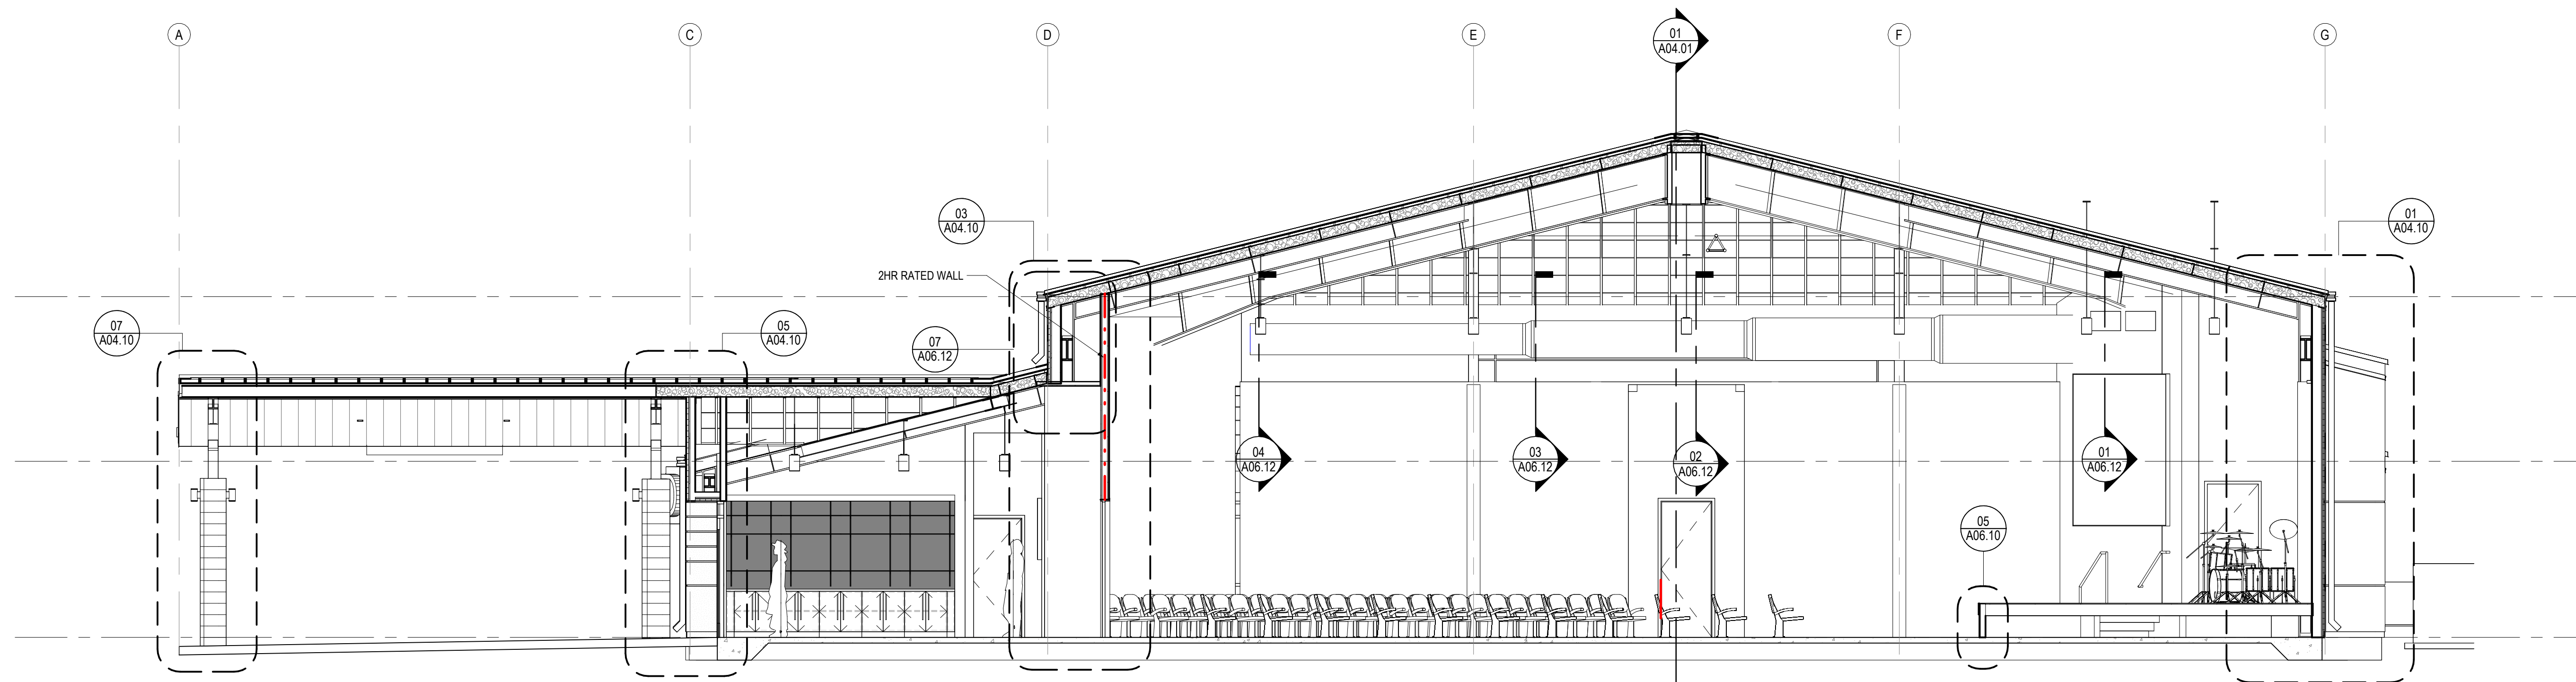

02 Section 2
SCALE: 3/16" = 1'-0"

Project Name



community church
making church come alive

658 GRAHAM ROAD
SANFORD NC 27311

Client

3D COMMUNITY CHURCH

Project Number

23024.00

Description

SECTIONS

Scale

3/16" = 1'-0"


A04.01

SHEET NOTES

- 01 STRUCT. STL. - PAINT BLACK WHERE EXPOSED
- 02 GWB AND MDF STAGE APRON - PAINT BLACK
- 03 ELEVATED FLOOR w/ LVT FINISH ON 1/4" T. TEMPERED MASONITE, 1/2" HOMASOTE, AND 3/4" FRP PLYWOOD ON MTL. STUD FRAMING (SEE STRUCT.)
- 04 SLOPED GWB "CLOUD" AT UNDERSIDE OF STL. STRUCT.
- 07 MTL. PANEL CEILING SYSTEM MTL. BLDG. MANUF. LIGHTING TRUSS (SEE STRUCT.)
- 08 RAMP w/ LVT FINISH ON (2) LAYERS 3/4" FRP PLYWOOD ON MTL. STUD FRAMING (SEE STRUCT.)
- 09 STAIR w/ LVT FINISH ON (2) LAYERS 3/4" FRP PLYWOOD ON MTL. STUD FRAMING (SEE STRUCT.)
- 11 GWB CONTROL JOINT
- 12 EXPOSED ROOF INSULATION
- 13 MTL. Z PURLIN (TYP.)
- 14 SUSPENDED PROJECTION SCREEN (SEE ELEC.)
- 15 LED CYLINDER PENDANT LIGHT FIXTURE (TYP.) (SEE ELEC.)
- 16 LED WALL SCONCE LIGHT FIXTURE (TYP.) (SEE ELEC.)
- 17 RECTANGULAR BEAM LED LIGHT FIXTURE (TYP.) (SEE ELEC.)
- 18 RECESSED LED LIGHT FIXTURE (TYP.) (SEE ELEC.)
- 20 8"x16"x4" CMU (PROVIDE TIES PER MANUF. REQS.) ON MTL. STUD FURRING AT STL. COLUMN
- 21 E.F.S. - 1-1/2" R-7.5 RIGID INSUL. AND 5/8" SHEATHING ON 3-5/8" MTL. STUD FRAMING W/ R-13 BLANKET INSUL.
- 22 REVEAL (TYP.)
- 23 8"x16"x4" CMU (PROVIDE TIES PER MANUF. REQS.) W/ 1-1/2" AIR SPACE, 2" RIGID INSUL., AND 5/8" SHEATHING ON 3-5/8" MTL. STUD FRAMING
- 24 STANDING SEAM MTL. ROOF (OWNER FURNISHED)
- 25 CONT. R-11 VINYL-FACED BLANKET INSUL. ON R-3 THERMAL SPACER BLOCKS (THERMAL SPACER BLOCKS TYP. AT EA. PURLIN)
- 26 R-19 FIBERGLASS BLANKET INSUL. BET. PURLINS (PROVIDE LONGITUDINAL AND TRANSVERSE MTL. SUPPORT BANDING)
- 27 CONT. BLACK FIBER-REINFORCED VAPOR BARRIER MEMBRANE AT BOTTOM OF PURLINS
- 28 GUTTER AND FLASHING BY MTL. BLDG. MANUF.
- 29 DOWNSPOUTS BY MTL. BLDG. MANUF. (TYP.)
- 31 3/8" T. x 24" D. CLEAR TEMPERED GLASS SHELVES (TYP.)
- 32 ADJUSTABLE SHELF BRACKETS & FLUSH-MOUNTED SHELF TRACKS (TYP.)
- 33 RAKES INSIDE WALL MOUNT EH COUNTER SUPPORT BRACKETS
- 34 OPEN TO UPPER ROOF ABOVE
- 35 MTL. C PURLIN BY MTL. BLDG. MANUF.
- 36 PRE-FIN. COUNTER FLASHING
- 37 TIE-IN TRIM BY MTL. BLDG. MANUF.
- 38 BACK-UP PLATE BY MTL. BLDG. MANUF.
- 39 OUTSIDE MTL. CLOSURE BY MTL. BLDG. MANUF.
- 41 STL. SPANDREL ANGLE AT BOTTOM OF MTL. Z PURLINS BY MTL. BLDG. MANUFACTURER
- 42 COMPRESSIBLE FILLER
- 43 NEW CONC. SIDEWALK
- 44 ALUM. DOOR AS SCHEDULED
- 45 DOOR THRESHOLD AS SCHEDULED - SET ON FULL BED OF MASTIC
- 46 TURNED-DOWN CONC. SLAB (SEE STRUCT.)
- 47 STRUCT. STL. COLUMN
- 48 STRUCT. STL. MOMENT FRAME - PAINT BLACK WHERE EXPOSED
- 49 SOUND ATTENUATION BLANKET (TYP.)
- 51 LINEAR SLOT RETURN (SEE MECH.)
- 52 MTL. SUPPORT BANDING - SPACE AS DIMENSIONED ON ENLARGED RCP (TYP.)
- 53 UNHINGED / RECESSED KNOXBOX (ALUM. FIN.)
- 54 FLUID-APPLIED AIR BARRIER MEMBRANE
- 55 JOINT SEALANT AND BACKER ROD
- 56 ALUM. STOREFRONT SYSTEM
- 57 E.F.S. - 1-1/2" R-7.5 RIGID INSUL. AND 5/8" SHEATHING ON 6" MTL. STUD FRAMING W/ R-13 BLANKET INSUL.
- 59 E.F.S. DRAINABLE TRACK
- 60 THRU-WALL STAINLESS STL. FLASHING W/ DRIP EDGE - FLASHED INTO AIR AND WATER BARRIER MEMBRANE
- 61 R-19 FIBERGLASS BLANKET INSUL. BET. MTL. STUD FRAMING (PROVIDE LONGITUDINAL AND TRANSVERSE MTL. SUPPORT BANDING)
- 62 STANDING SEAM MTL. ROOF (OWNER FURNISHED) ON 3/4" FRP PLYWOOD ON 6" MTL. STUD FRAMING
- 68 ROLLERSHADE AT EA. EXT. WINDOW (TYP.)
- 69 EAVE TRIM, PANEL, CAP TRIM, AND FLASHING BY MTL. BLDG. MANUF.
- 70 MTL. STUD BRACE (SEE STRUCT.)



4539 HEDGEMORE DRIVE, SUITE 101
CHARLOTTE NC 28209
704.890.2853
WWW.OSSASTUDIO.COM

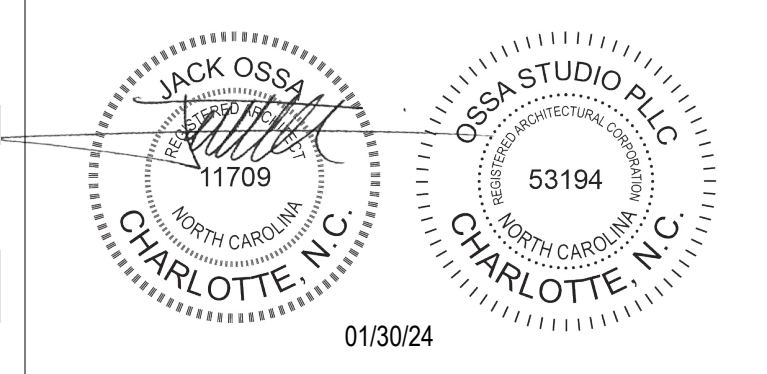

PROJECT TEAM

- General Contractor**
ECCLESIA CONSTRUCTION
www.ecclesiainc.com
803.327.5670
- Civil Engineering**
HILLIARD ENGINEERING, PLLC
www.hilliardepp.com
919.352.2834
- Structural Engineering**
PROVIDENCE PARTNERS
www.providencpartnersinc.com
704.266.6621
- Mechanical, Electrical, Plumbing & Fire Protection**
ENGINEERING
www.engineering.com
704.287.2193

Date	Description
01/30/24	FOR CONSTRUCTION
1 05/28/24	PERMIT REVIEW COMMENTS

Project Name

3D
community church
making church come alive
658 GRAHAM ROAD
SANFORD NC 27311

Client

3D COMMUNITY CHURCH

Project Number

23024.00


Description

WALL SECTIONS


Scale

1/2" = 1'-0"


A04.10

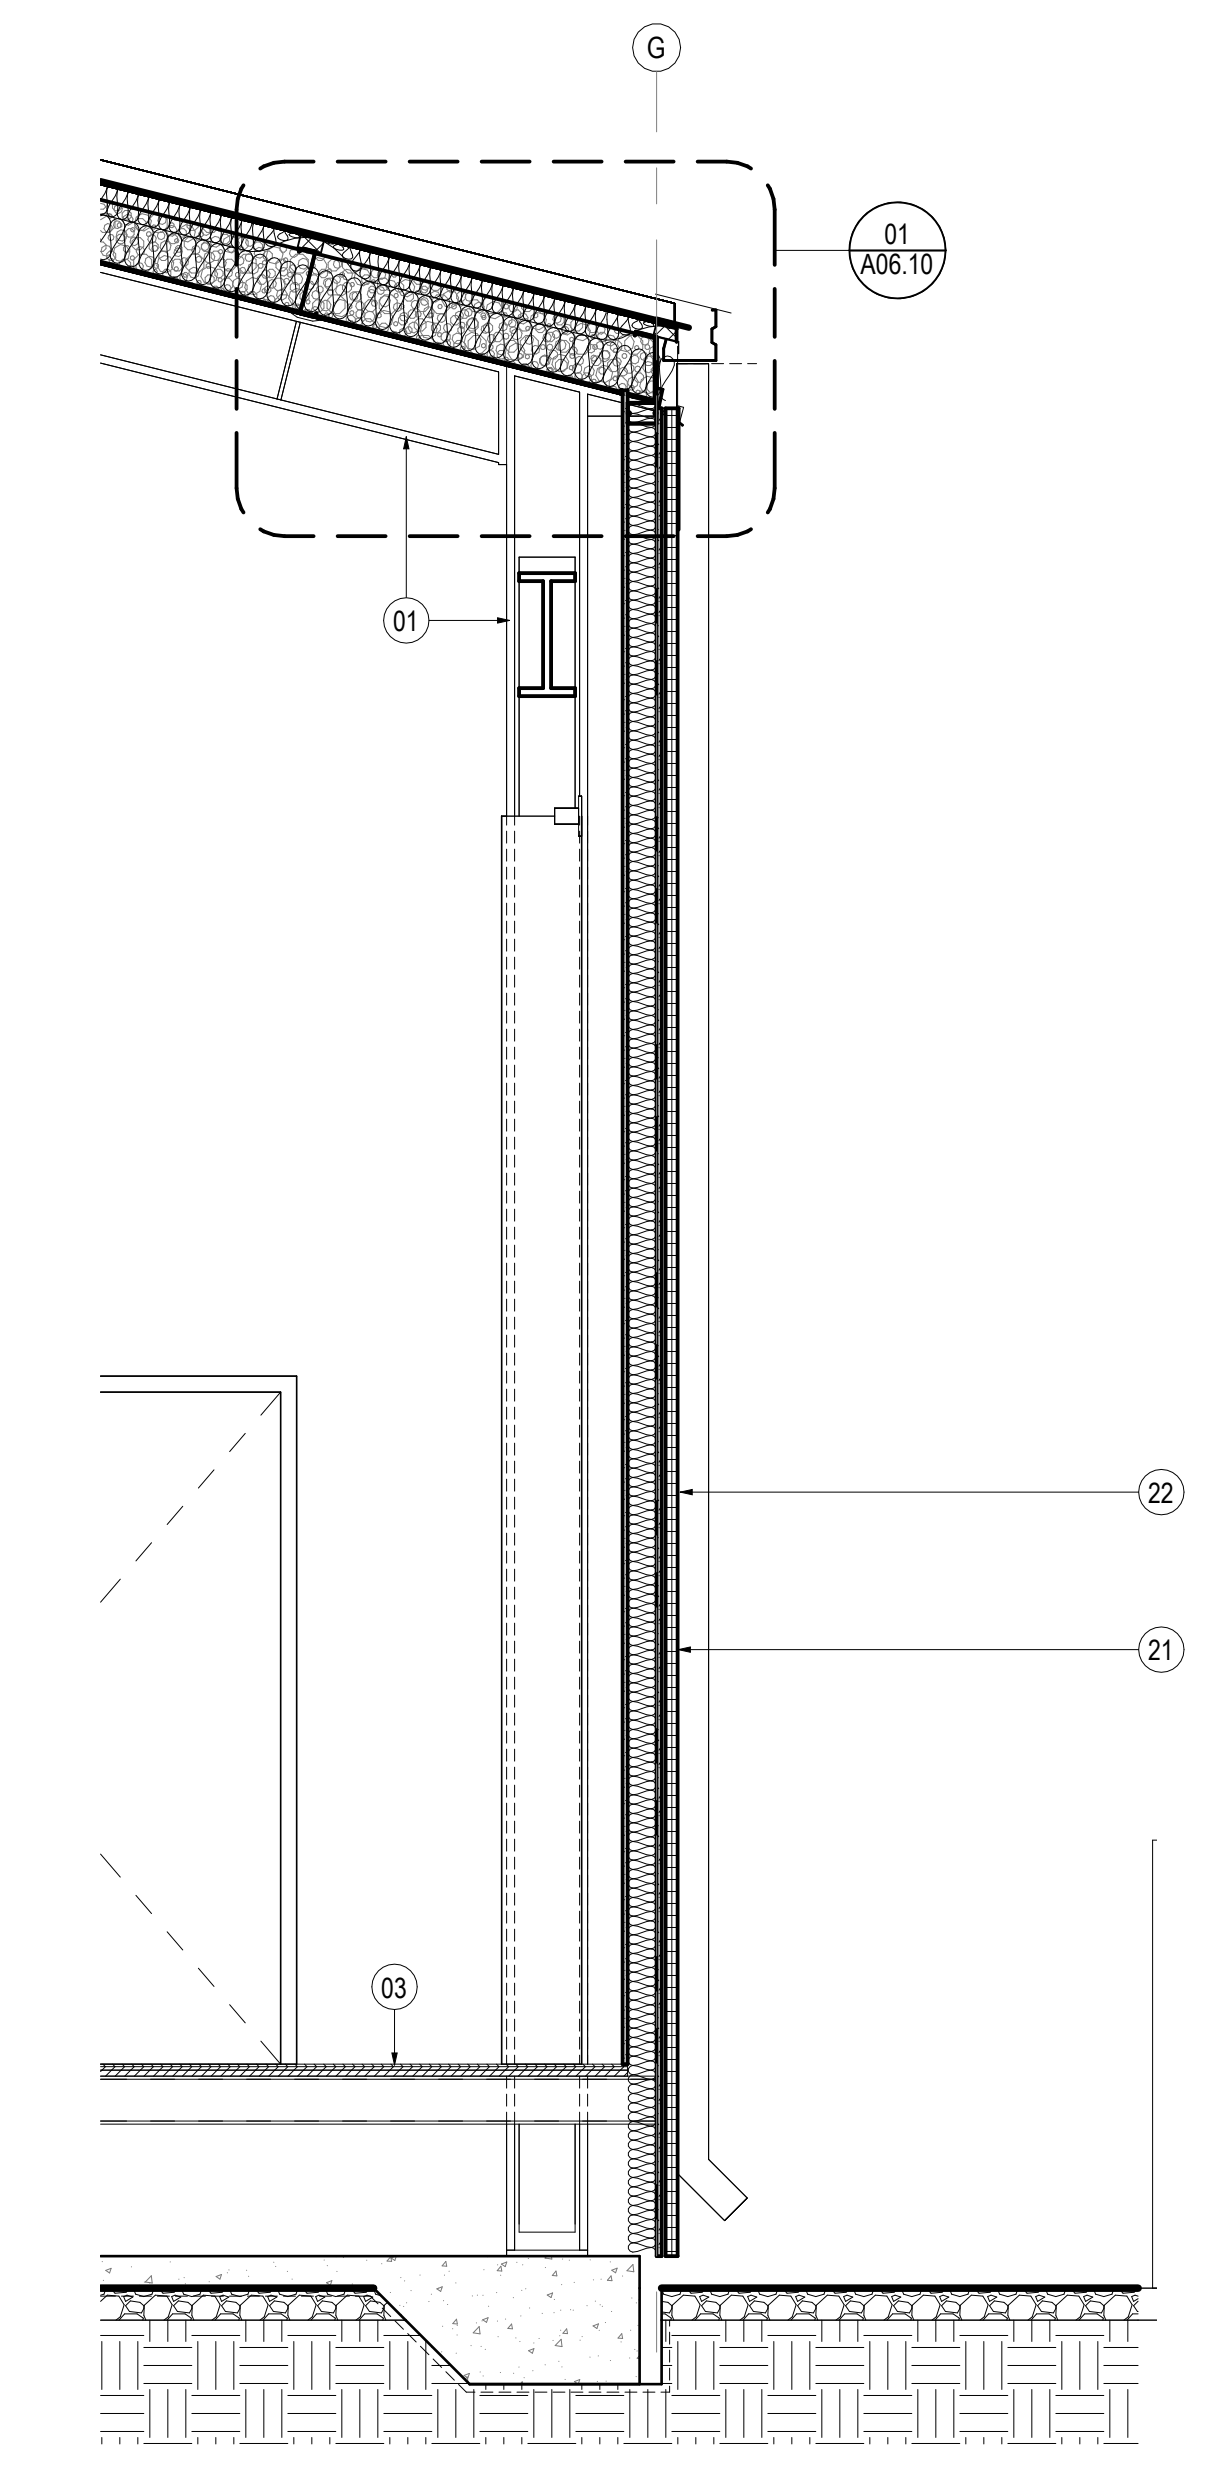


01 NORTH WALL AT STAGE
SCALE: 1/2" = 1'-0"

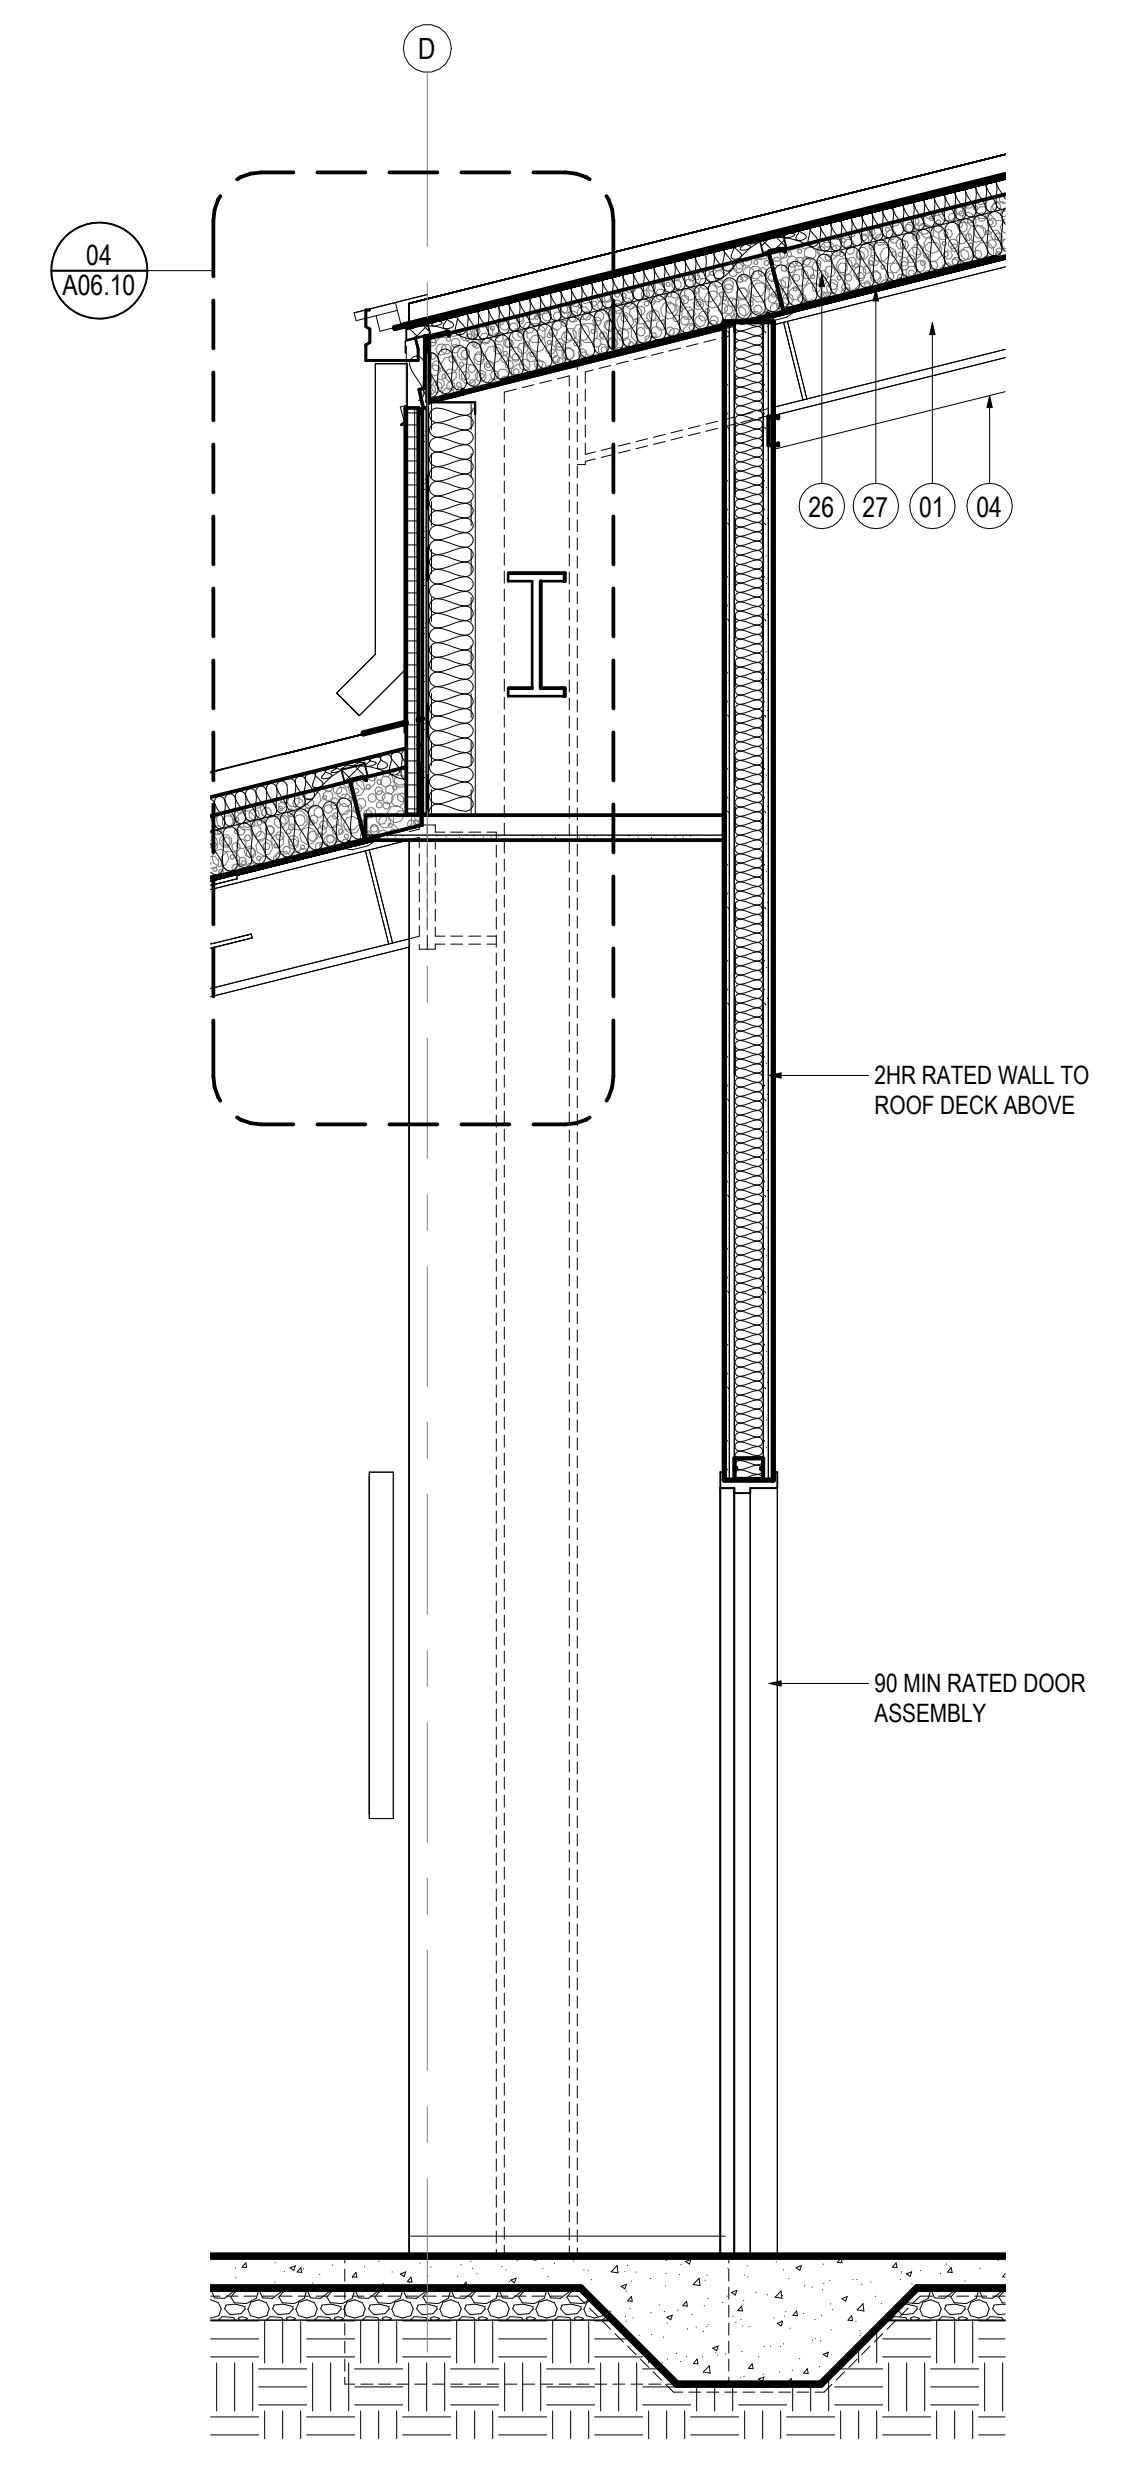


03 WALL AT NARTHEX / SANCTUARY
SCALE: 1/2" = 1'-0"

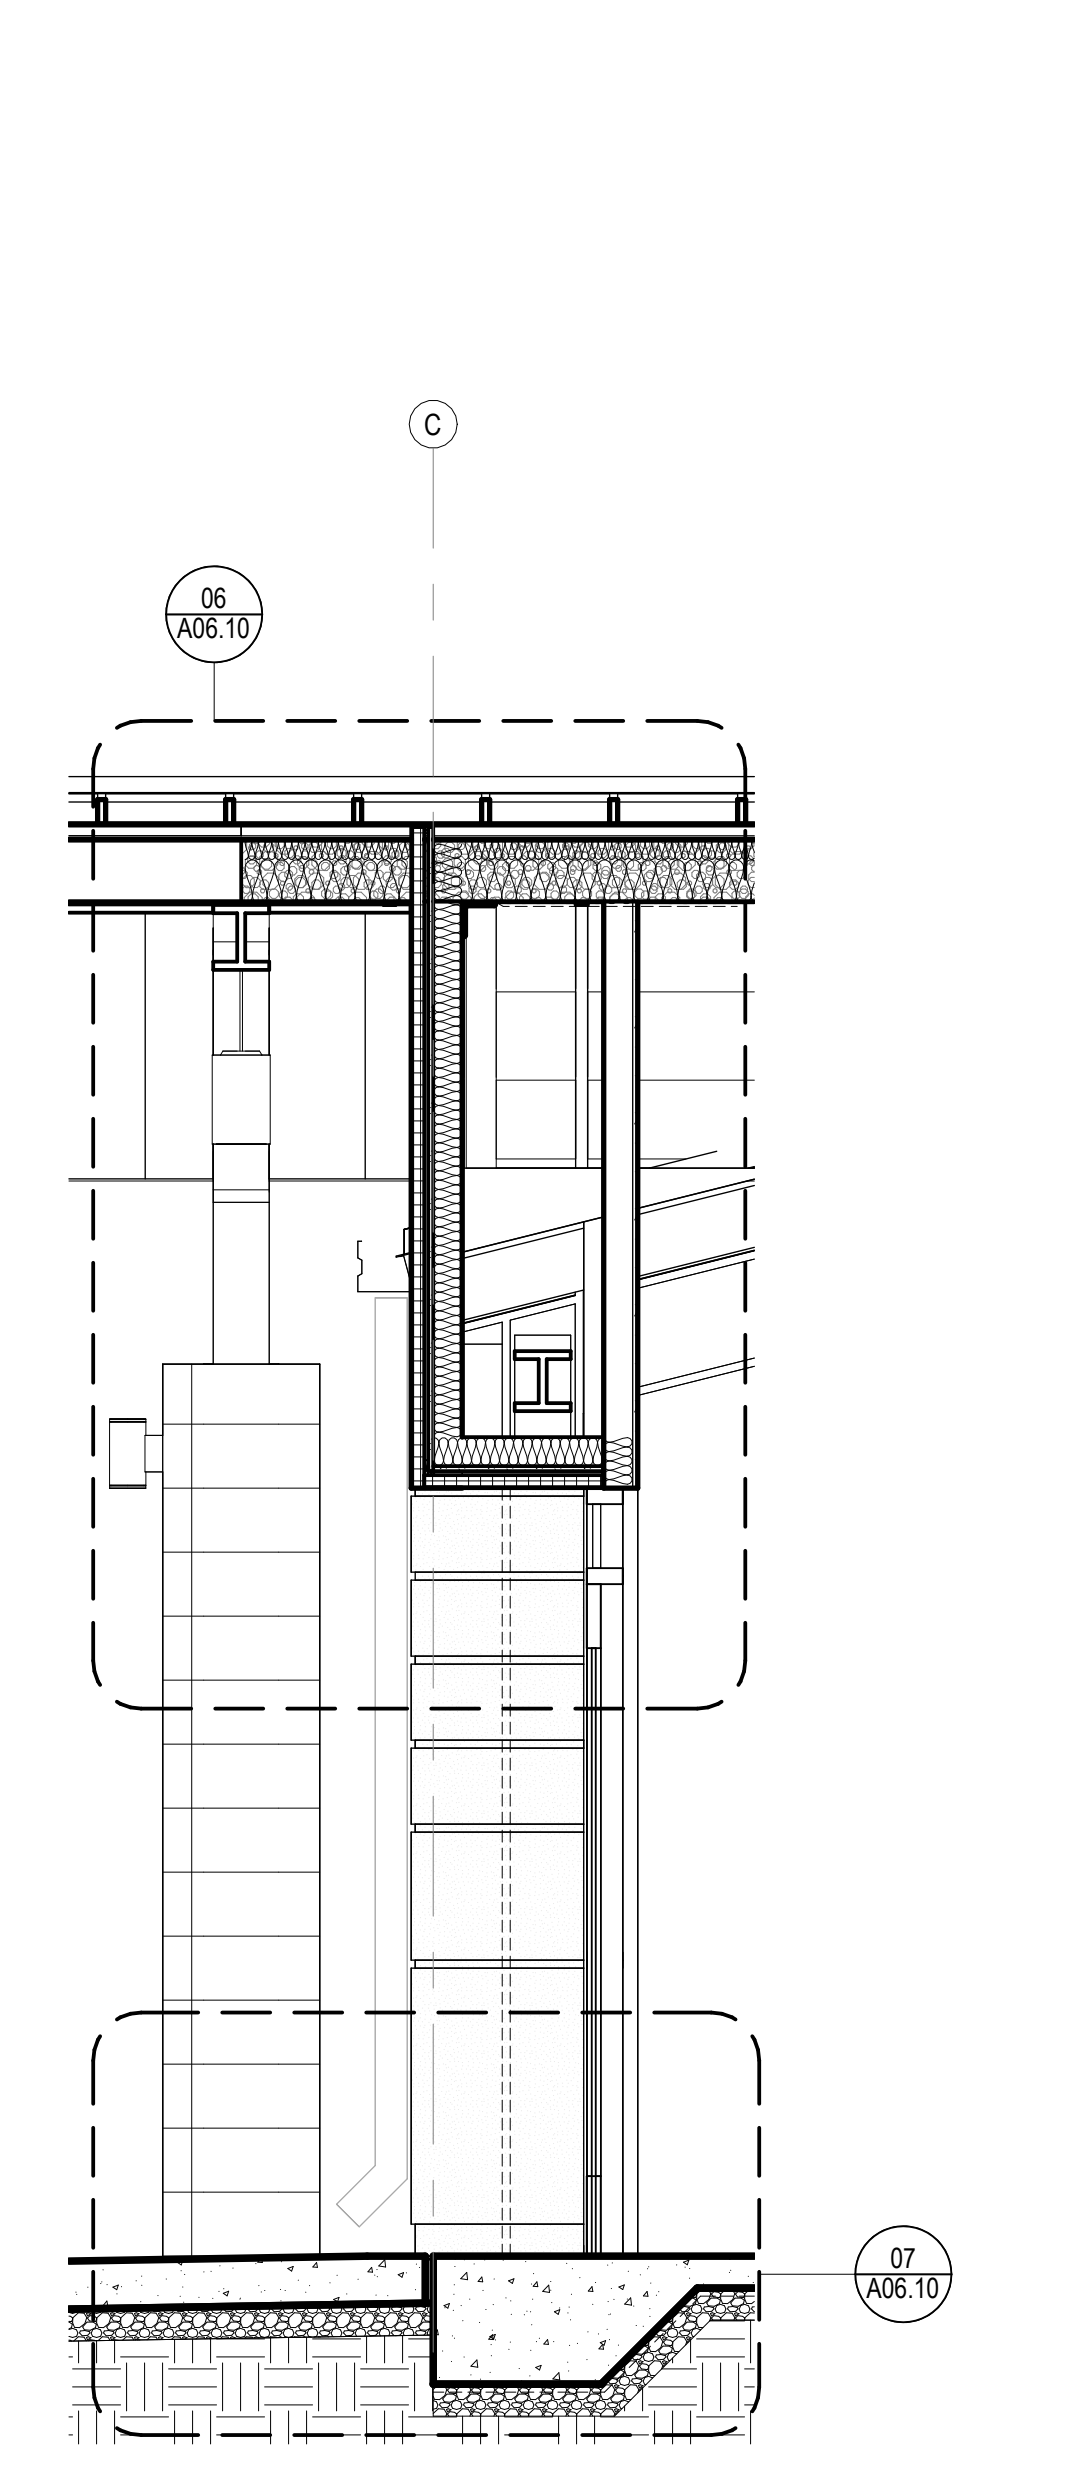


05 WALL AT MAIN ENTRY
SCALE: 1/2" = 1'-0"

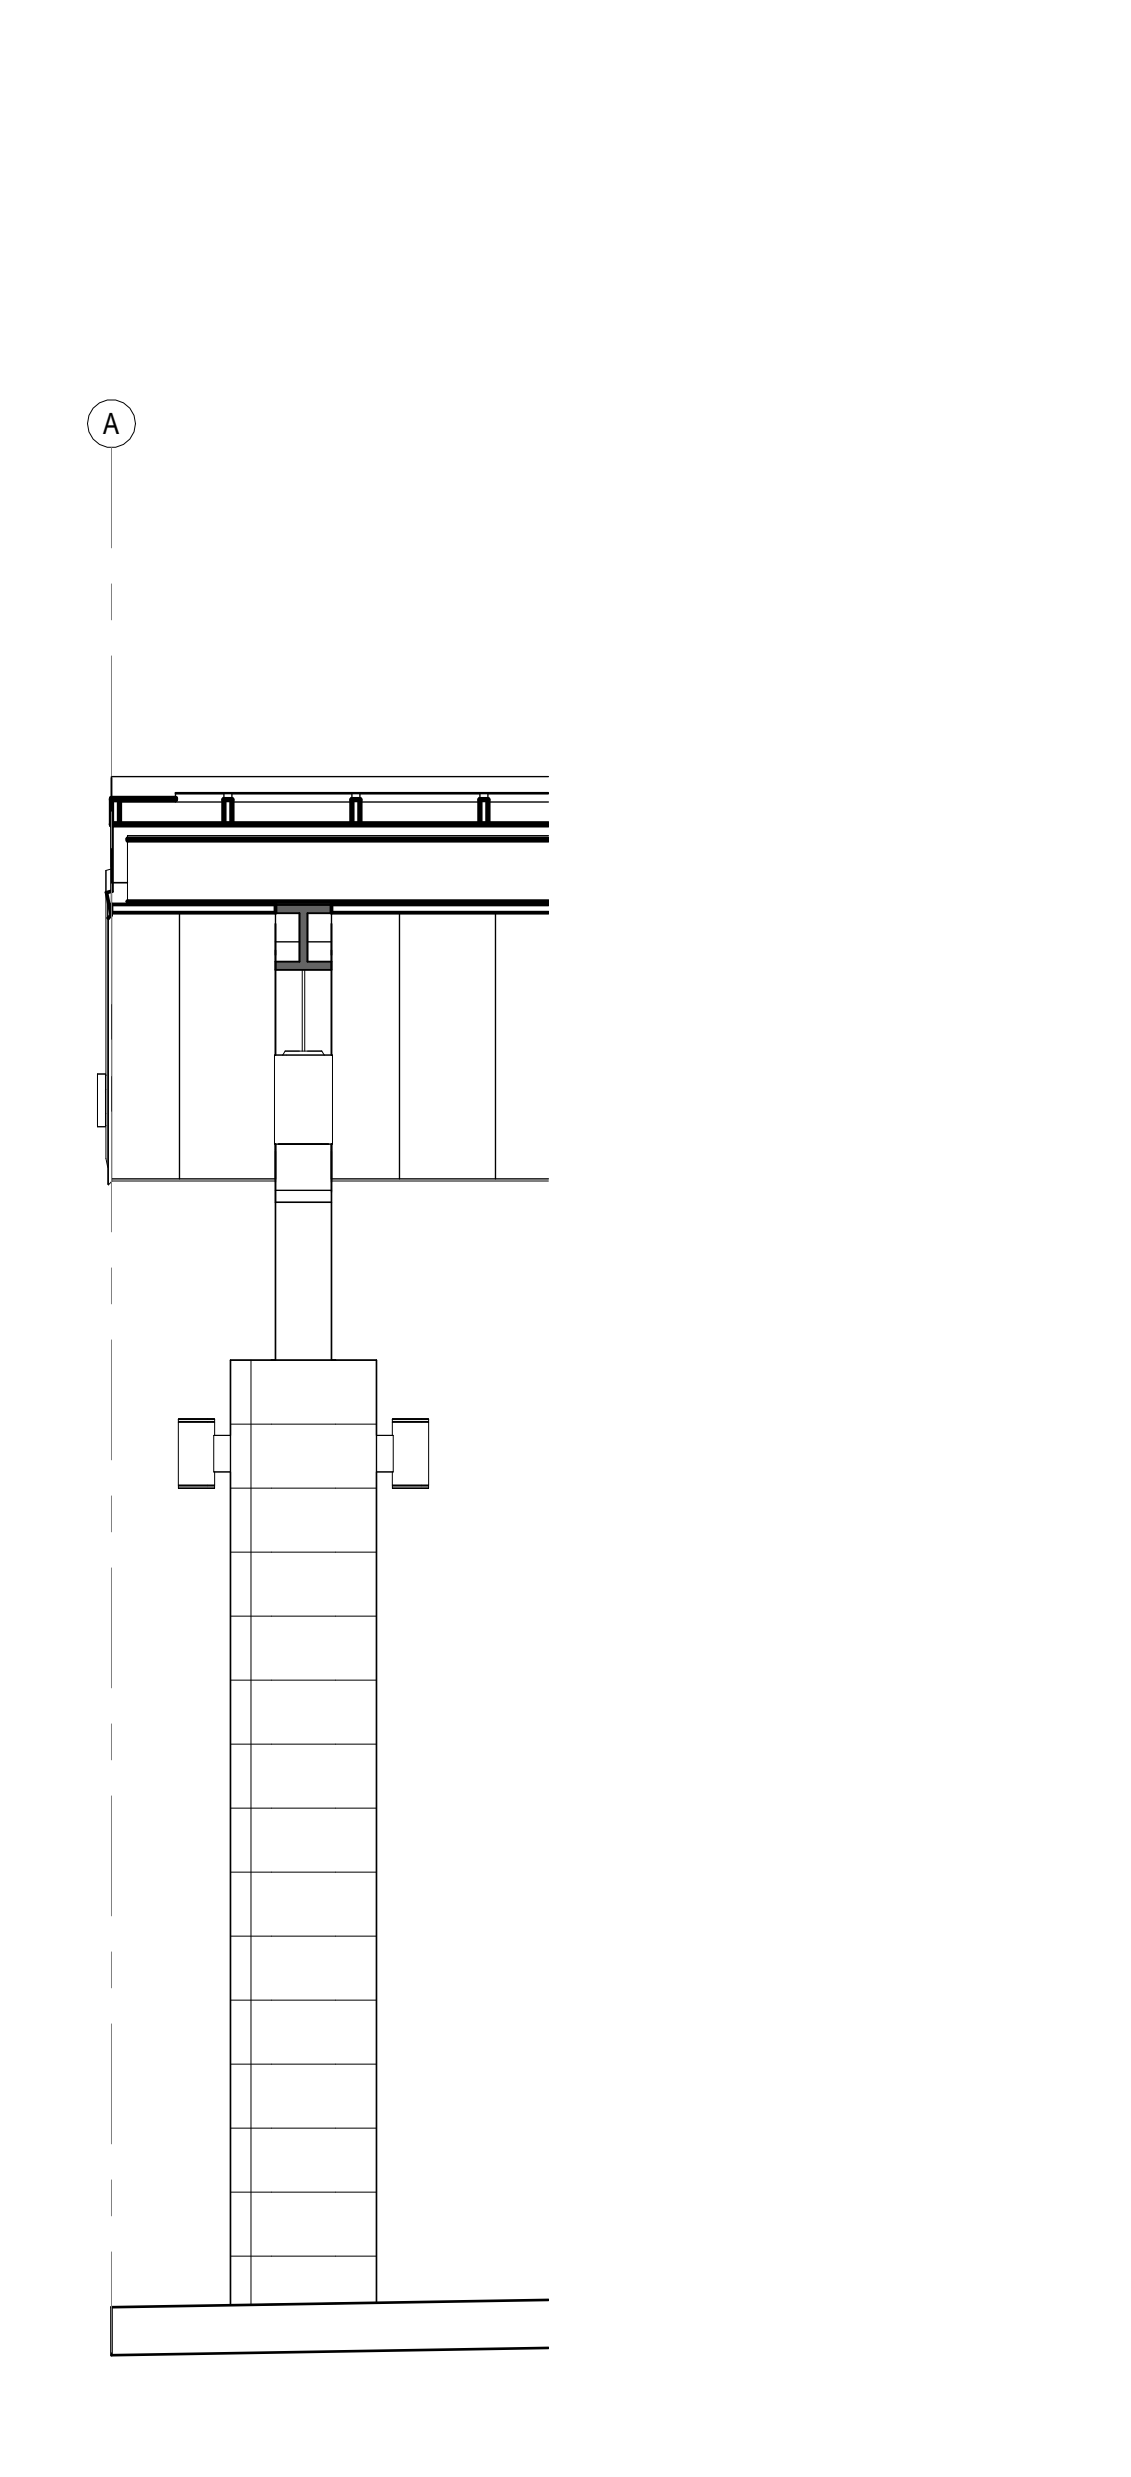


07 EDGE OF COVERED DRIVE
SCALE: 1/2" = 1'-0"

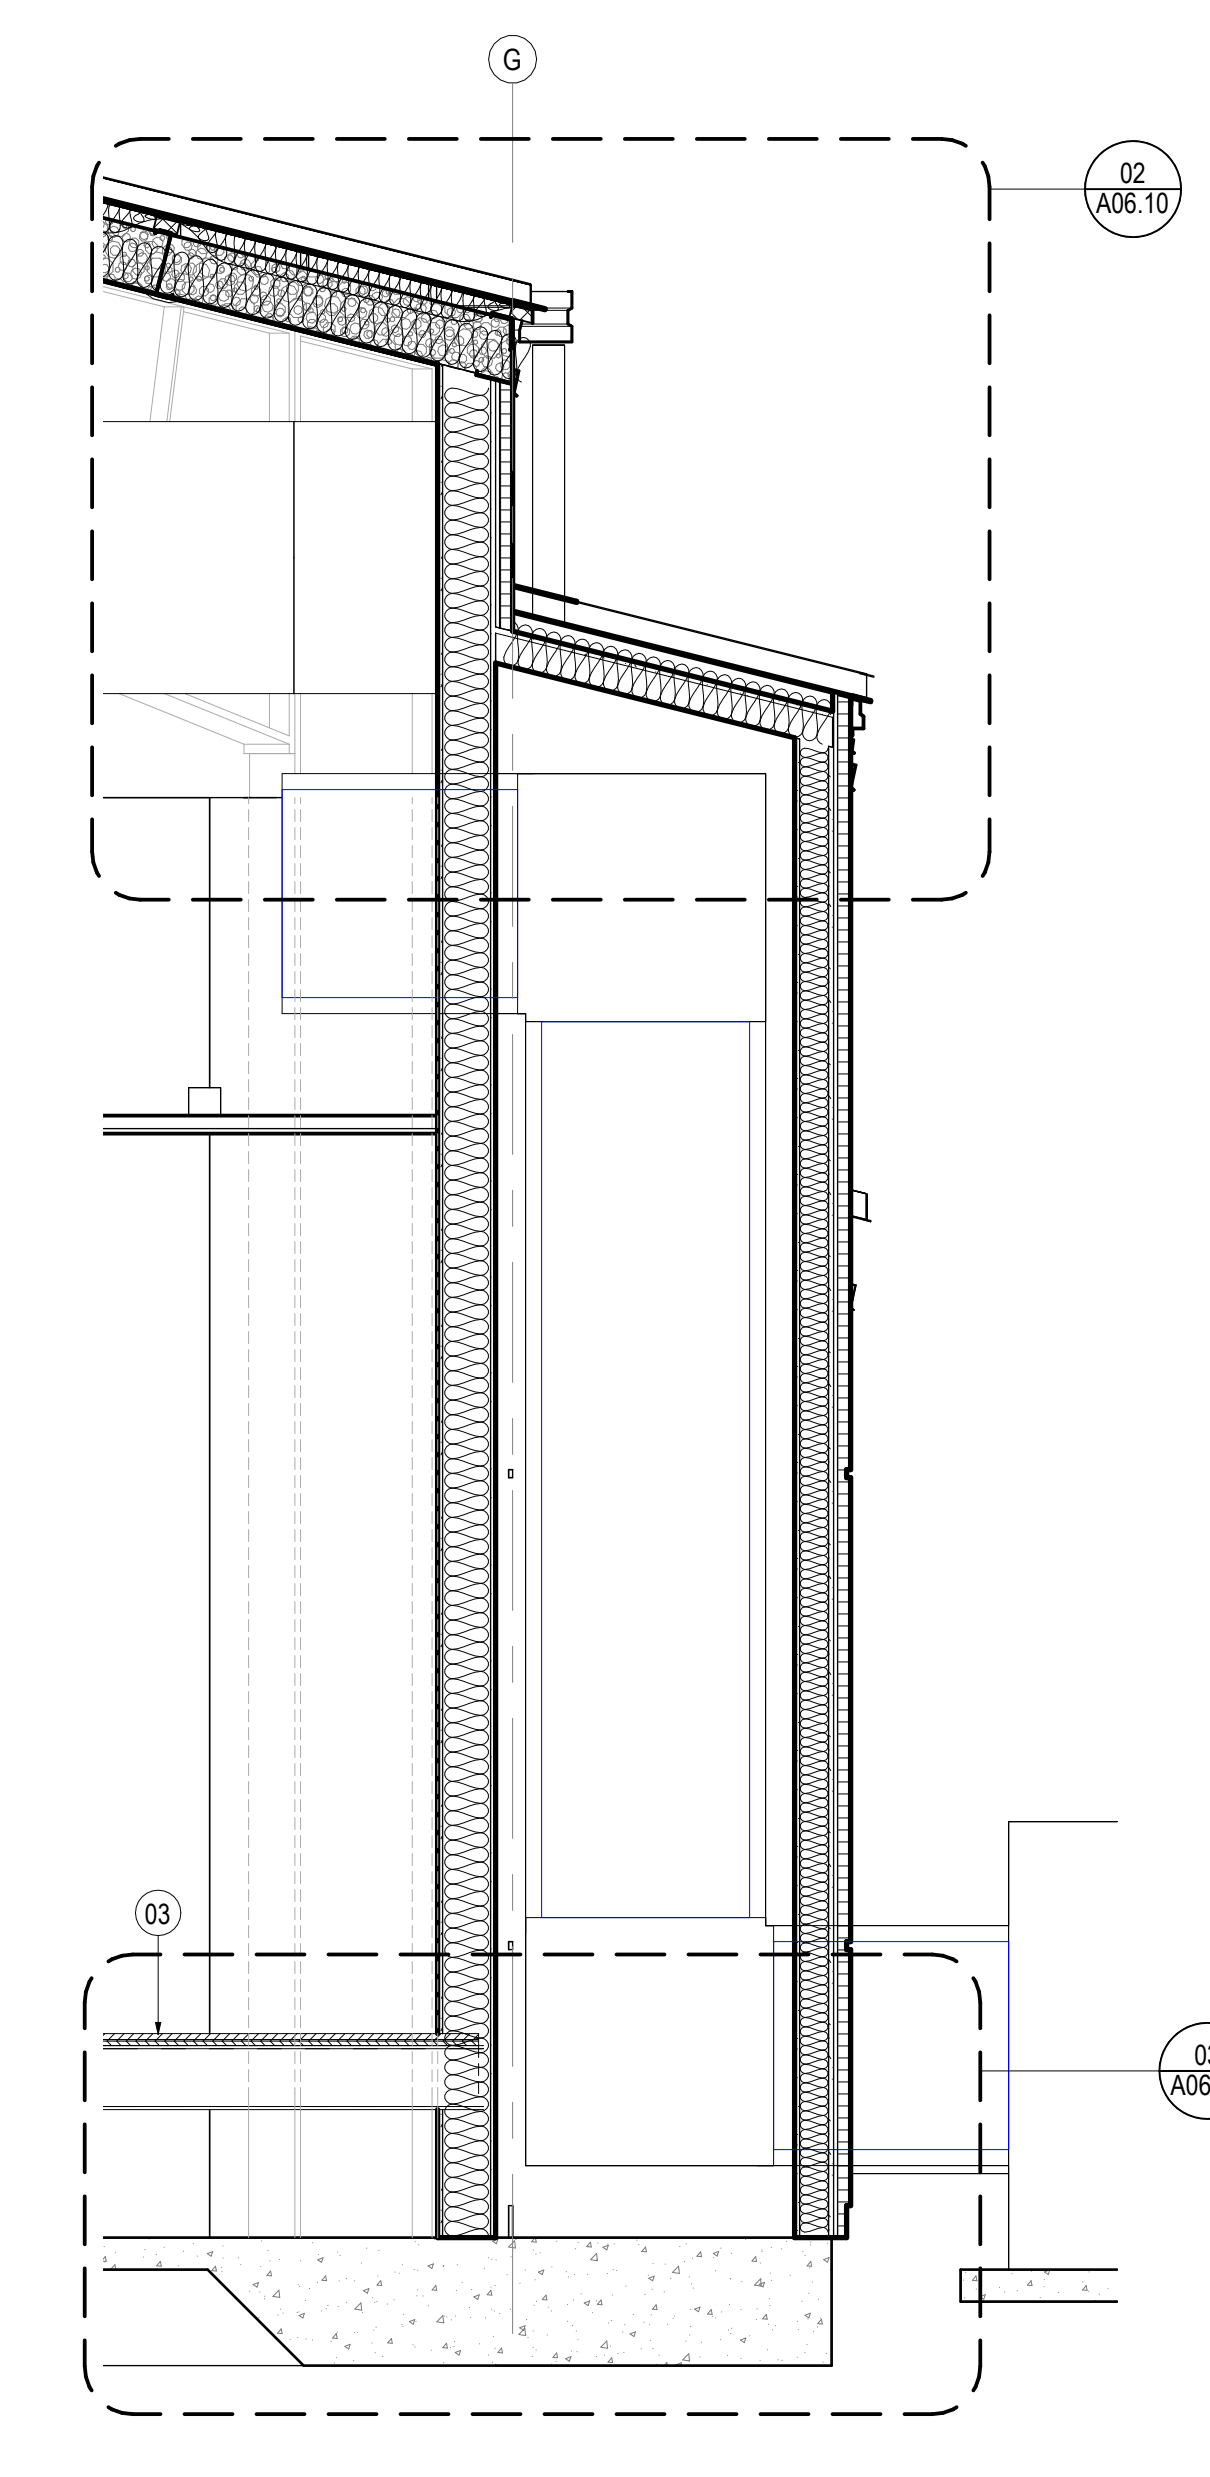


02 NORTH WALL AT HVAC CHASE
SCALE: 1/2" = 1'-0"

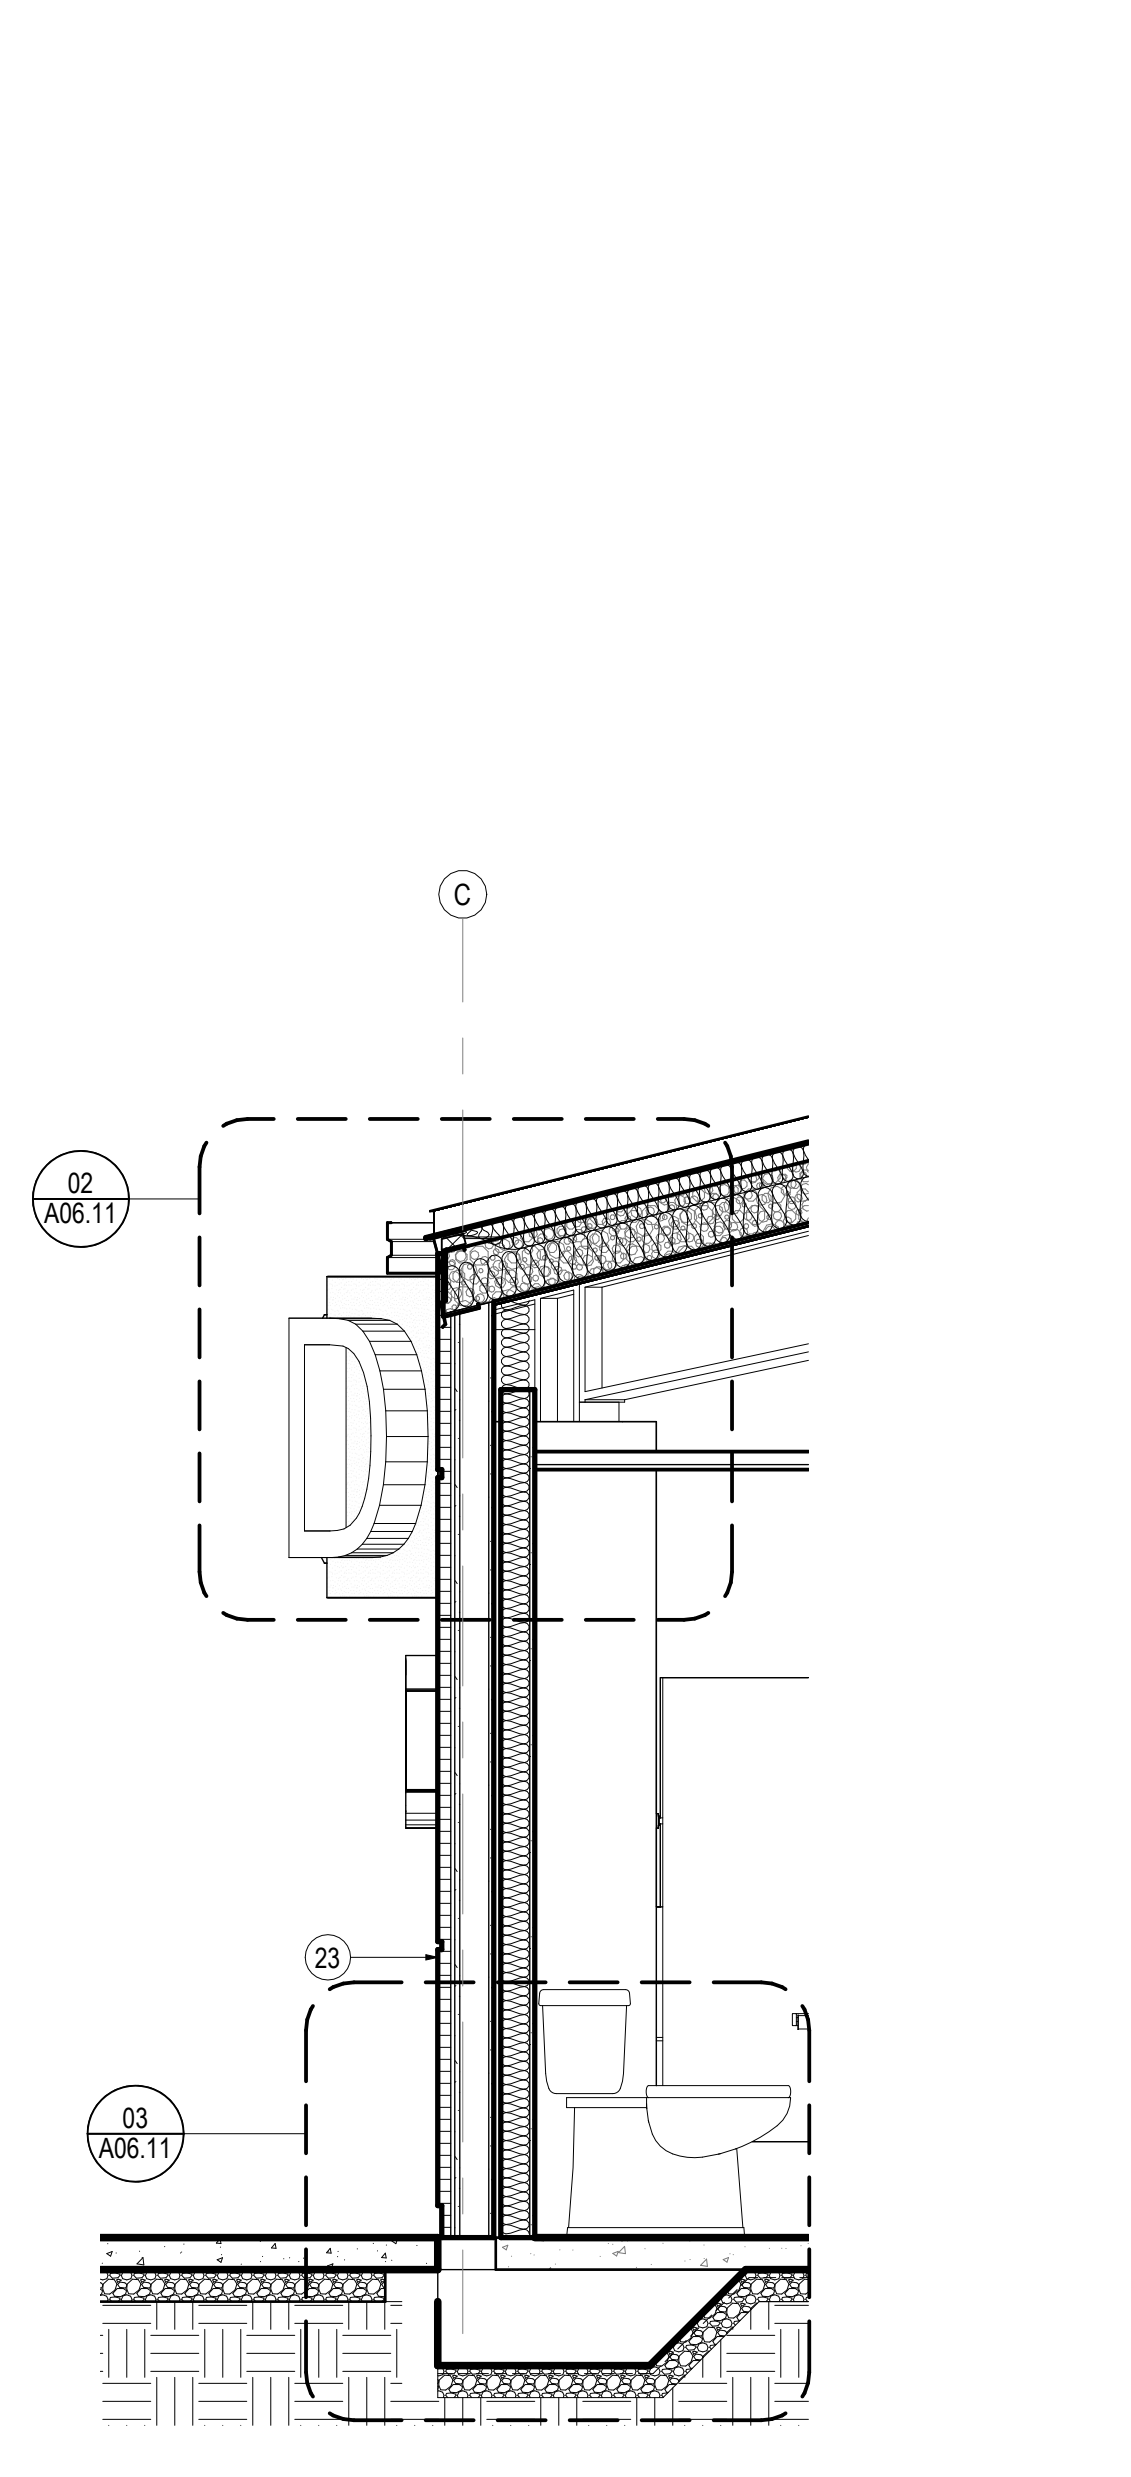


04 SOUTH WALL AT RESTROOMS
SCALE: 1/2" = 1'-0"

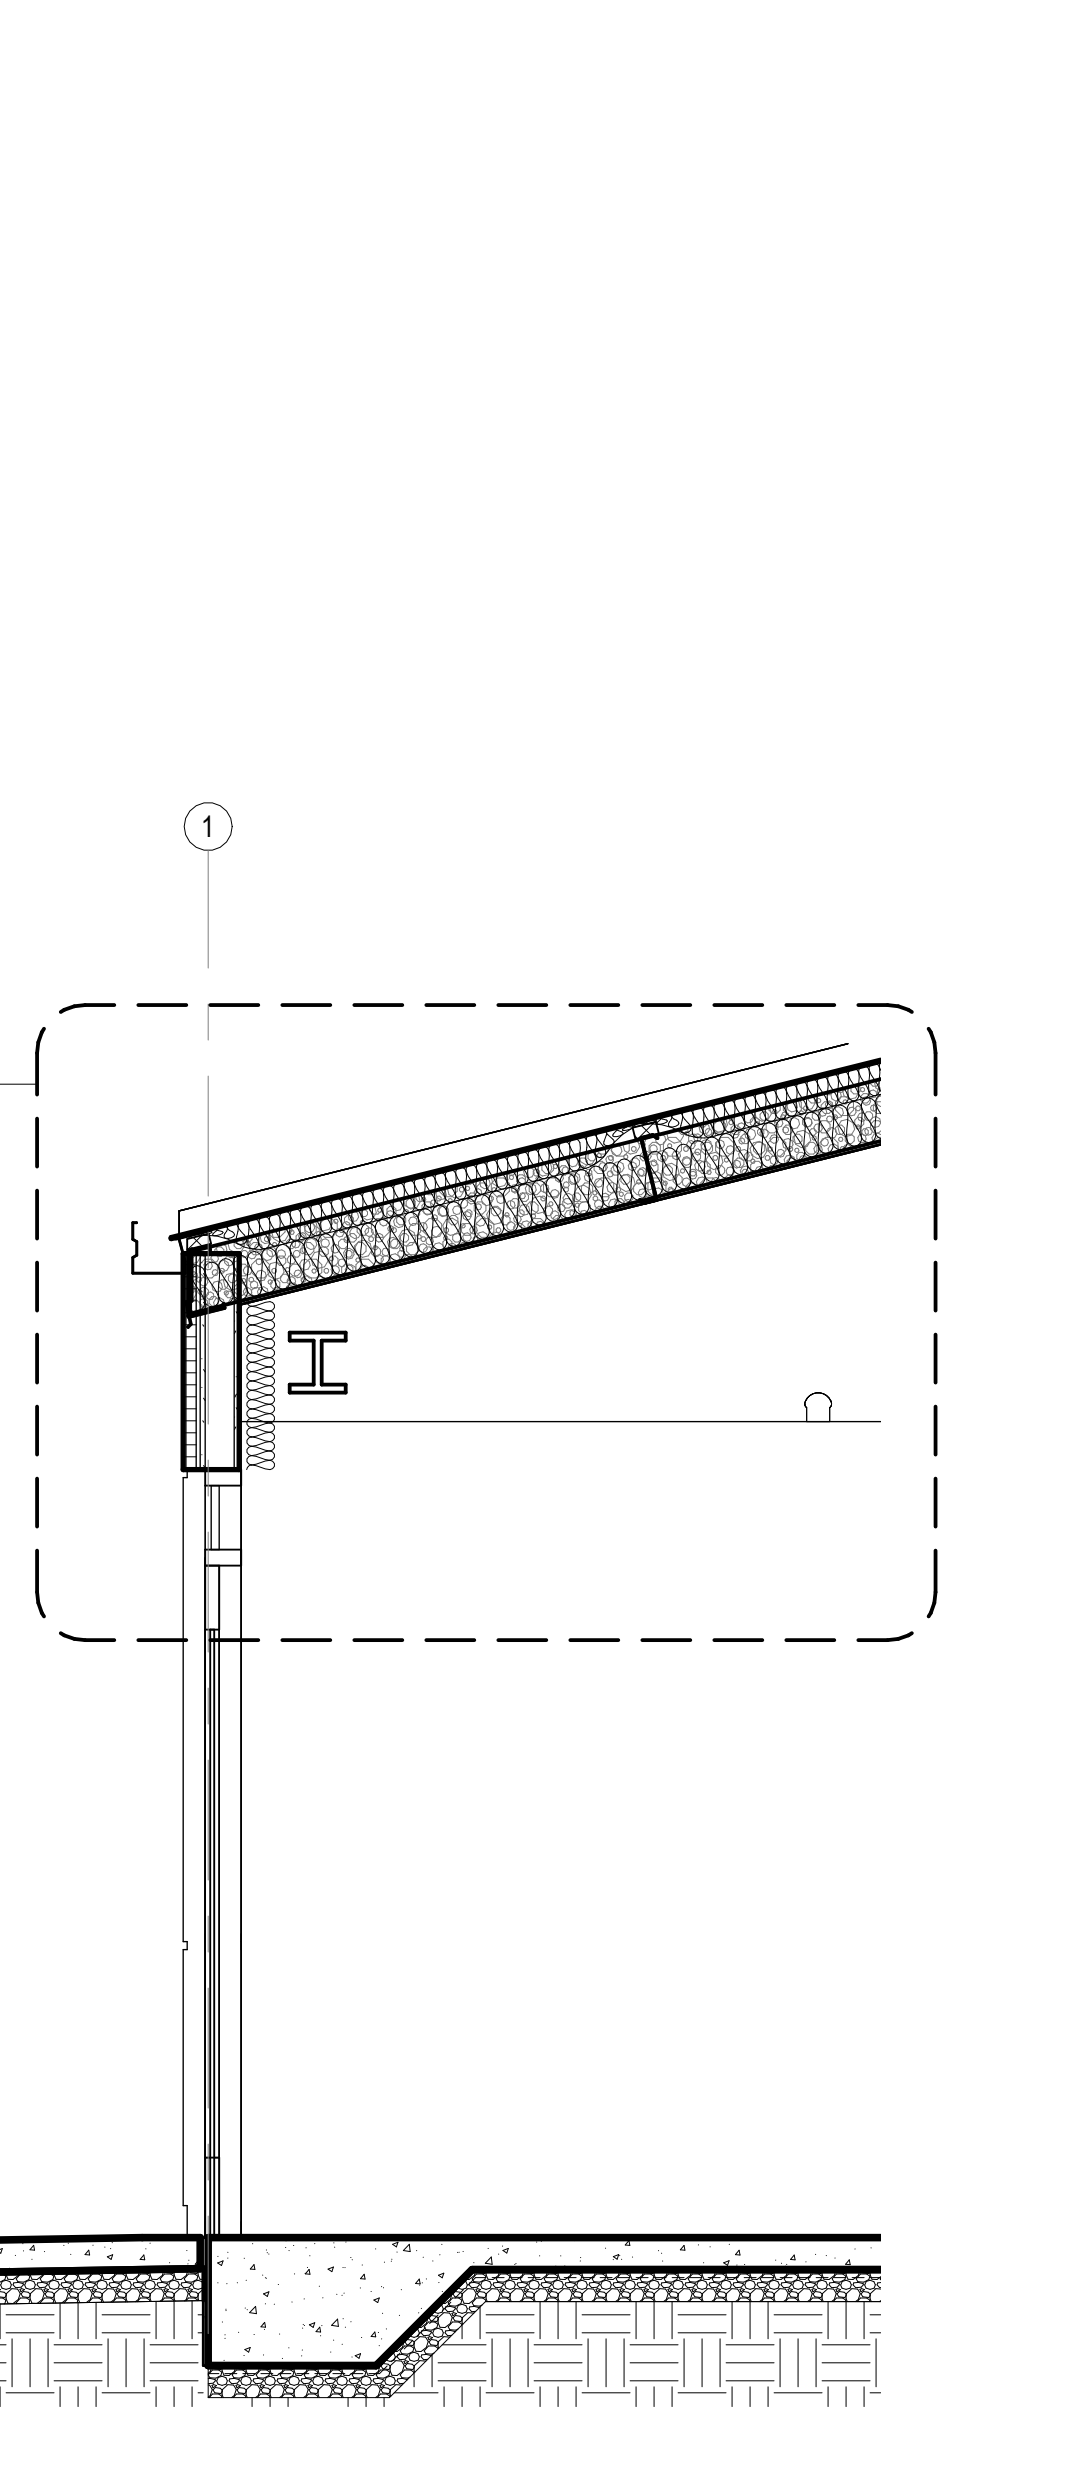


06 WALL AT LOBBY ENTRY
SCALE: 1/2" = 1'-0"

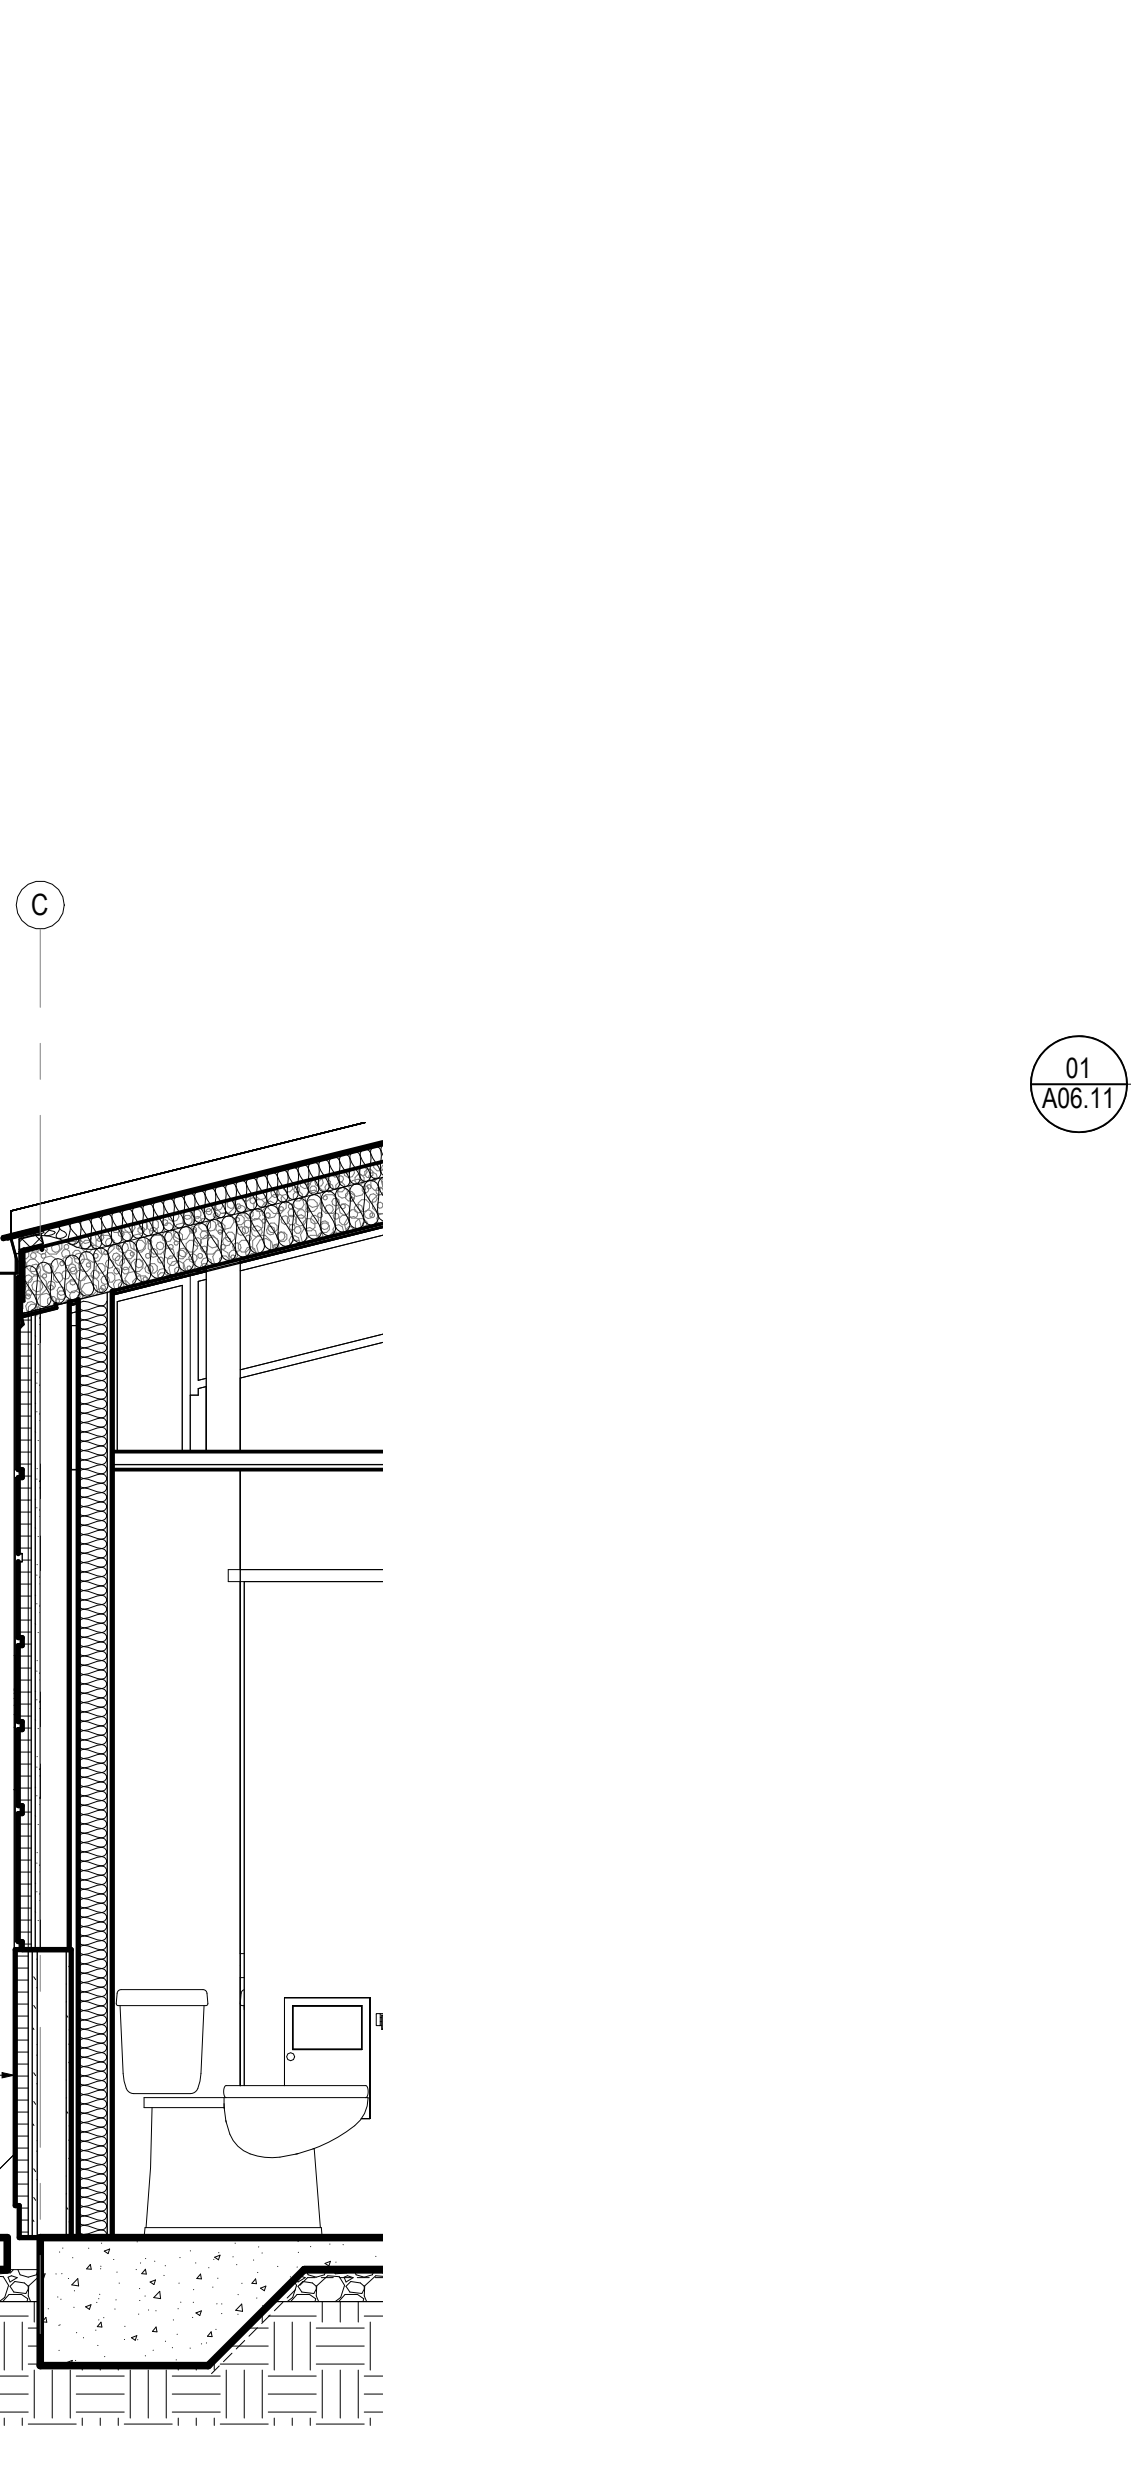

08 SOUTH WALL AT EIFS
SCALE: 1/2" = 1'-0"

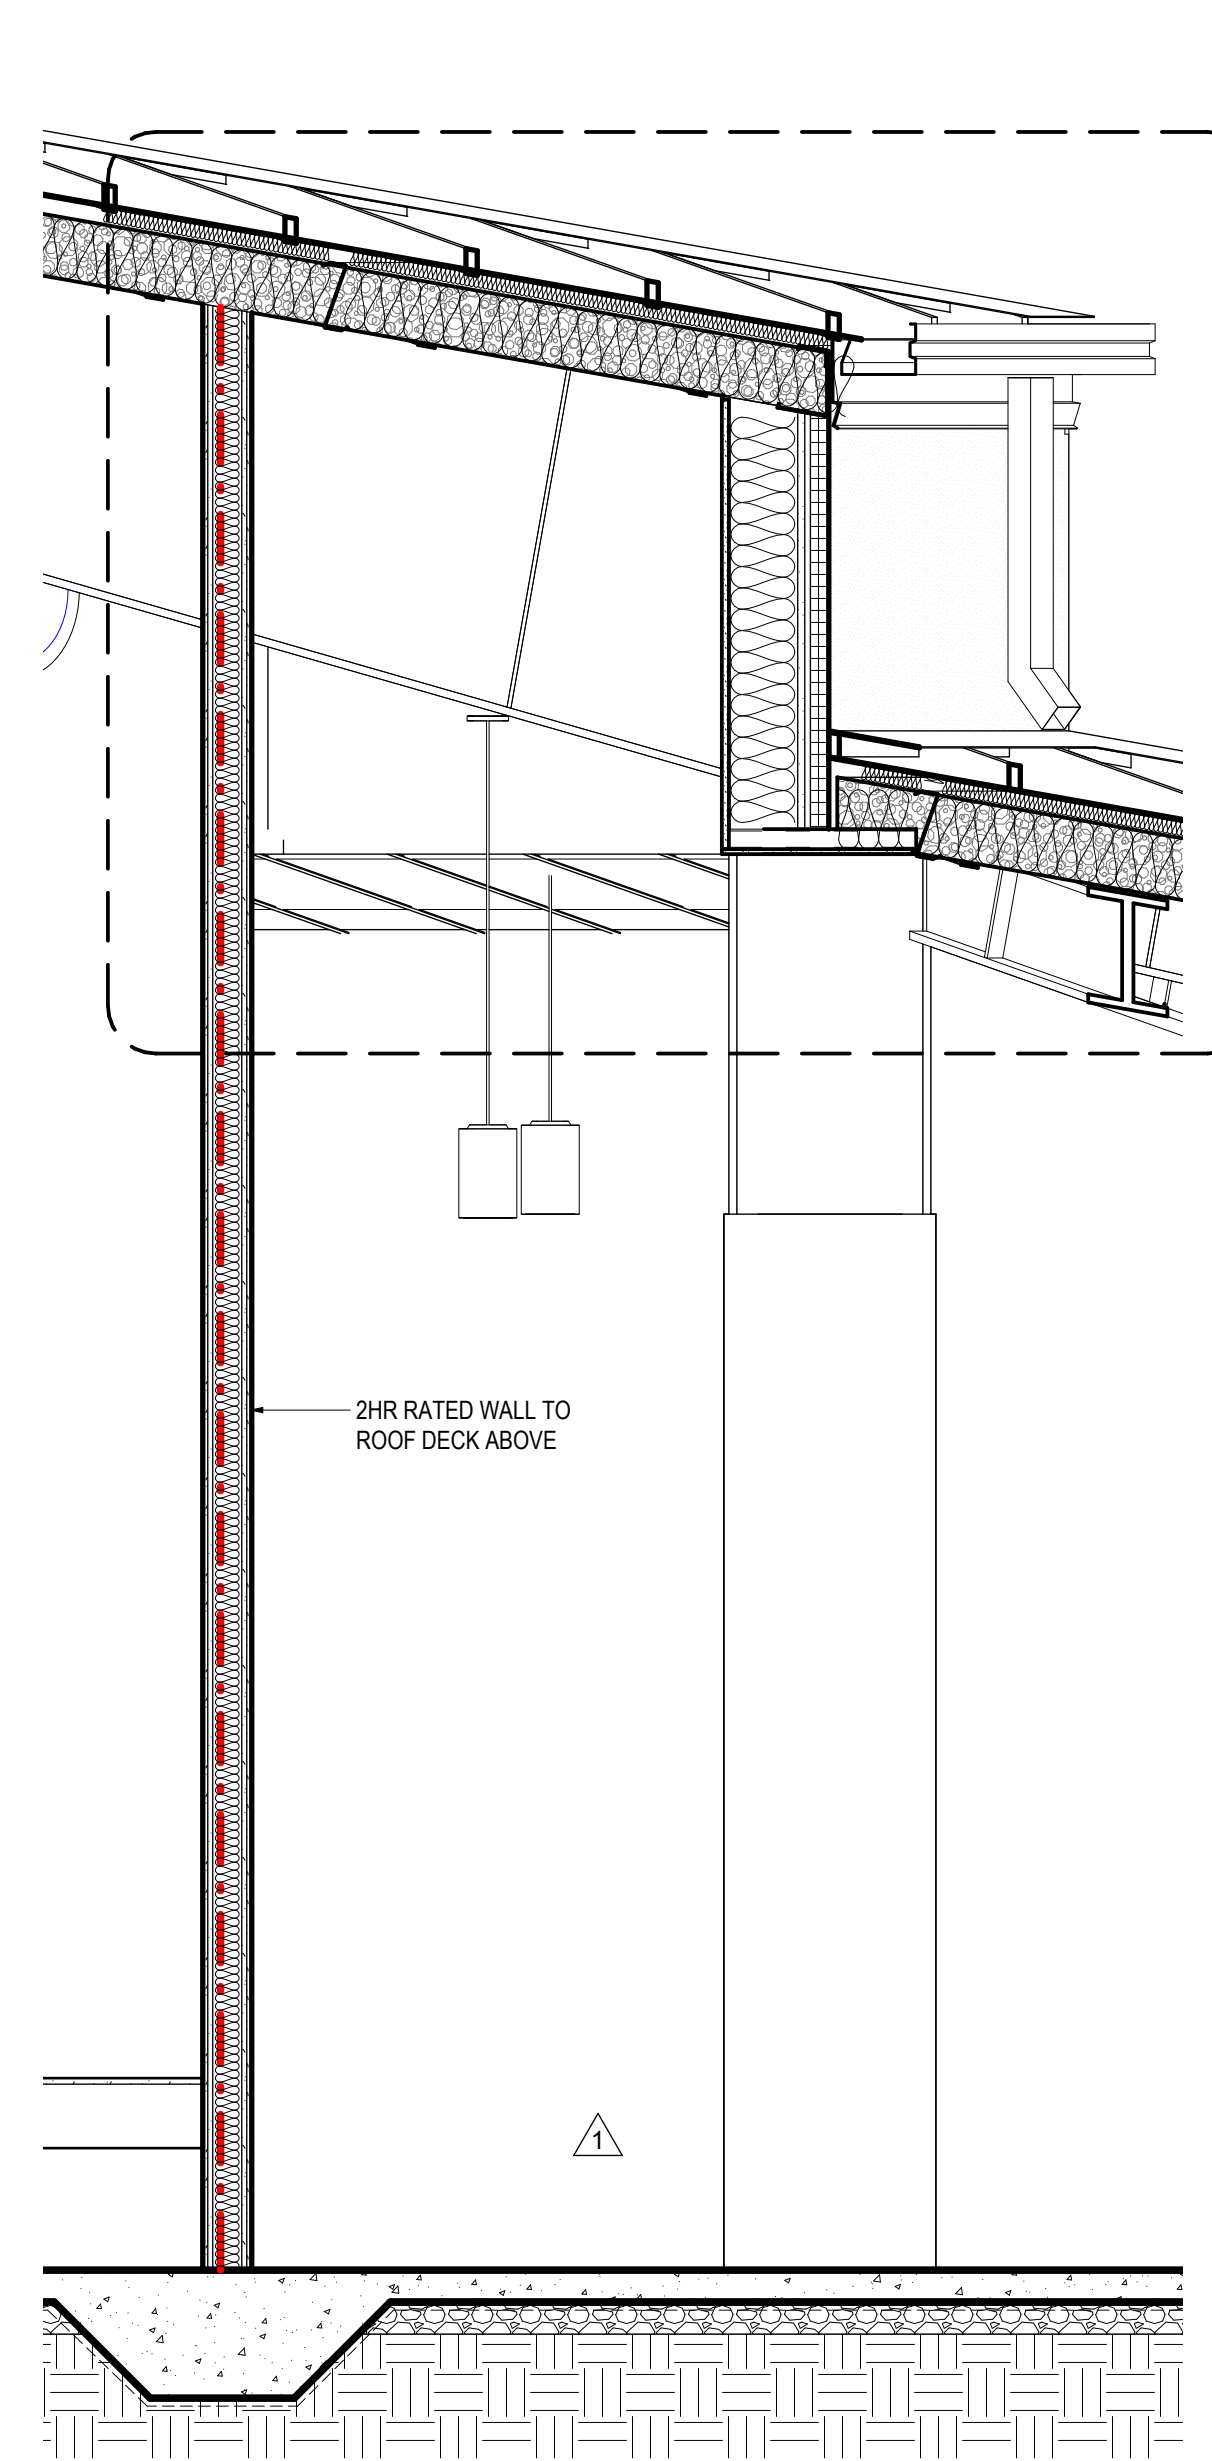

02 SANCTUARY AT CHAMFERED CORNER
SCALE: 1/2" = 1'-0"

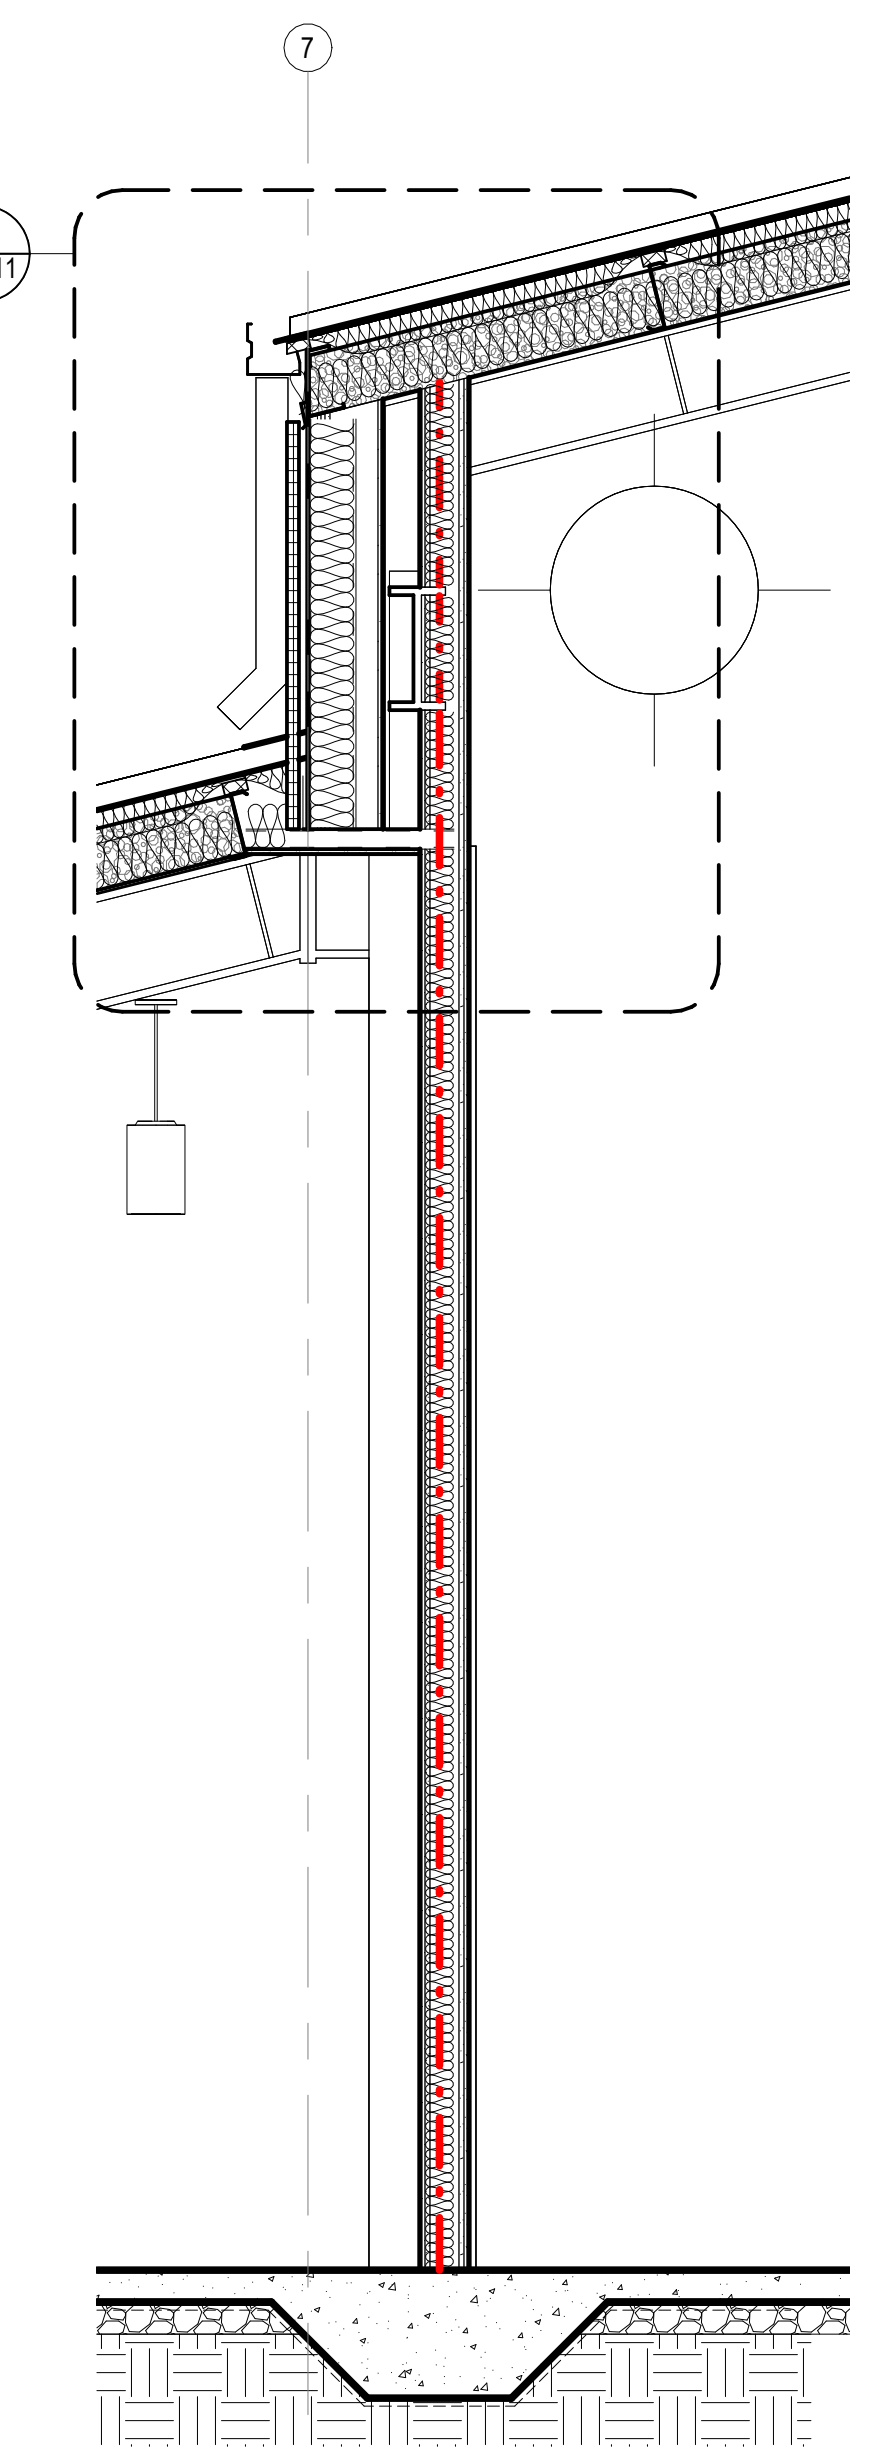


01 EAST / WEST SANCTUARY WALL
SCALE: 1/2" = 1'-0"

SHEET NOTES

- 01 STRUCT. STL. - PAINT BLACK WHERE EXPOSED
- 02 GWB AND MDF STAGE APRON - PAINT BLACK
- 03 ELEVATED FLOOR w/ LVT FINISH ON 1/4" T. TEMPERED MASONITE, 1/2" HOMASOTE, AND 3/4" FRT PLYWOOD ON MTL. STUD FRAMING (SEE STRUCT.)
- 04 SLOPED GWB "CLOUD" AT UNDERSIDE OF STL. STRUCT.
- 07 MTL. PANEL CEILING SYSTEM MTL. BLDG. MANUF. LIGHTING TRUSS (SEE STRUCT.)
- 08 RAMP w/ LVT FINISH ON (2) LAYERS 3/4" FRT PLYWOOD ON MTL. STUD FRAMING (SEE STRUCT.)
- 09 STAIR w/ LVT FINISH ON (2) LAYERS 3/4" FRT PLYWOOD ON MTL. STUD FRAMING (SEE STRUCT.)
- 11 GWB CONTROL JOINT
- 12 EXPOSED ROOF INSULATION
- 13 MTL. Z PURLIN (TYP.)
- 14 SUSPENDED PROJECTION SCREEN
- 15 LED CYLINDER PENDANT LIGHT FIXTURE (TYP.) (SEE ELEC.)
- 16 LED WALL SCONCE LIGHT FIXTURE (TYP.) (SEE ELEC.)
- 17 RECTANGULAR BEAM LED LIGHT FIXTURE (TYP.) (SEE ELEC.)
- 18 RECESSED LED LIGHT FIXTURE (TYP.) (SEE ELEC.)
- 20 8"x16"x4" CMU (PROVIDE TIES PER MANUF. REQS.) ON MTL. STUD FURRING AT STL. COLUMN
- 21 E.I.F.S. - 1-1/2" R-7.5 RIGID INSUL. AND 5/8" SHEATHING ON 3-5/8" MTL. STUD FRAMING W/ R-13 BLANKET INSUL.
- 22 REVEAL (TYP.)
- 23 8"x16"x4" CMU (PROVIDE TIES PER MANUF. REQS.) W/ 1-1/2" AIR SPACE, 2" RIGID INSUL., AND 5/8" SHEATHING ON 3-5/8" MTL. STUD FRAMING
- 24 STANDING SEAM MTL. ROOF (OWNER FURNISHED)
- 25 CONT. R-11 VINYL-FACED BLANKET INSUL. ON R-3 THERMAL SPACER BLOCKS (THERMAL SPACER BLOCKS TYP. AT EA. PURLIN)
- 26 R-19 FIBERGLASS BLANKET INSUL. BET. PURLINS (PROVIDE LONGITUDINAL AND TRANSVERSE MTL. SUPPORT BANDING)
- 27 CONT. BLACK FIBER-REINFORCED VAPOR BARRIER MEMBRANE AT BOTTOM OF PURLINS
- 28 GUTTER AND FLASHING BY MTL. BLDG. MANUF.
- 29 DOWNSPOUTS BY MTL. BLDG. MANUF. (TYP.)
- 31 3/8" T. x 24" D. CLEAR TEMPERED GLASS SHELVES (TYP.)
- 32 ADJUSTABLE SHELF BRACKETS & FLUSH-MOUNTED SHELF TRACKS (TYP.)
- 33 RAKES INSIDE WALL MOUNT EH COUNTER SUPPORT BRACKETS
- 34 OPEN TO UPPER ROOF ABOVE
- 35 MTL. C PURLIN BY MTL. BLDG. MANUF.
- 36 PRE-FIN. COUNTER FLASHING
- 37 TIE-IN TRIM BY MTL. BLDG. MANUF.
- 38 BACK-UP PLATE BY MTL. BLDG. MANUF.
- 39 OUTSIDE MTL. CLOSURE BY MTL. BLDG. MANUF.
- 41 STL. SPANDREL ANGLE AT BOTTOM OF MTL. Z PURLINS BY MTL. BLDG. MANUFACTURER
- 42 COMPRESSIBLE FILLER
- 43 NEW CONC. SIDEWALK
- 44 ALUM. DOOR AS SCHEDULED
- 45 DOOR THRESHOLD AS SCHEDULED - SET ON FULL BED OF MASTIC
- 46 TURNED-DOWN CONC. SLAB (SEE STRUCT.)
- 47 STRUCT. STL. COLUMN
- 48 STRUCT. STL. MOMENT FRAME - PAINT BLACK WHERE EXPOSED
- 49 SOUND ATTENUATION BLANKET (TYP.)
- 51 LINEAR SLOT RETURN (SEE MECH.)
- 52 MTL. SUPPORT BANDING - SPACE AS DIMENSIONED ON ENLARGED RCP (TYP.)
- 53 UNHINGED / RECESSED KNOXBOX (ALUM. FIN.)
- 54 FLUID-APPLIED AIR BARRIER MEMBRANE
- 55 JOINT SEALANT AND BACKER ROD
- 56 ALUM. STOREFRONT SYSTEM
- 57 E.I.F.S. - 1-1/2" R-7.5 RIGID INSUL. AND 5/8" SHEATHING ON 6" MTL. STUD FRAMING W/ R-13 BLANKET INSUL.
- 59 E.I.F.S. DRAINABLE TRACK
- 60 THRU-WALL STAINLESS STL. FLASHING W/ DRIP EDGE - FLASHED INTO AIR AND WATER BARRIER MEMBRANE
- 61 R-19 FIBERGLASS BLANKET INSUL. BET. MTL. STUD FRAMING (PROVIDE LONGITUDINAL AND TRANSVERSE MTL. SUPPORT BANDING)
- 62 STANDING SEAM MTL. ROOF (OWNER FURNISHED) ON 3/4" FRT PLYWOOD ON 6" MTL. STUD FRAMING
- 68 ROLLERSHADE AT EA. EXT. WINDOW (TYP.)
- 69 EAVE TRIM, PANEL CAP TRIM, AND FLASHING BY MTL. BLDG. MANUF.
- 70 MTL. STUD BRACE (SEE STRUCT.)



4539 HEDGEMORE DRIVE, SUITE 101
CHARLOTTE NC 28209
704.890.2653
WWW.OSSASTUDIO.COM

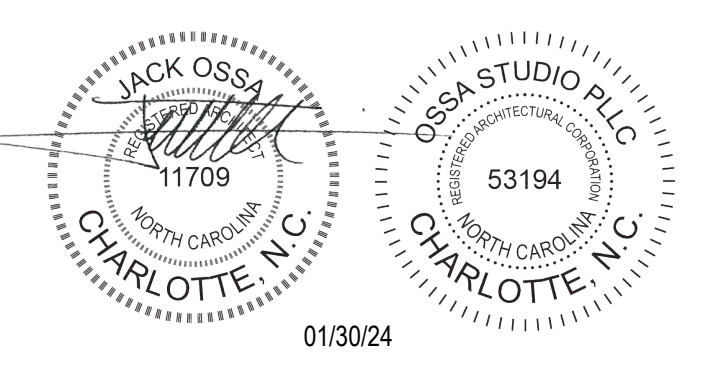


PROJECT TEAM

- General Contractor**
ECCLESIA CONSTRUCTION
www.ecclesiainc.com
803.327.5670
- Civil Engineering**
HILLIARD ENGINEERING, PLLC
www.hilliardepp.com
919.352.2834
- Structural Engineering**
PROVIDENCE PARTNERS
www.providencpartnersinc.com
704.266.6621
- Mechanical, Electrical, Plumbing & Fire Protection**
ENGINEERING
www.engineer.com
704.287.2193

Date	Description
01/30/24	FOR CONSTRUCTION
1 05/8/24	PERMIT REVIEW COMMENTS

Project Name

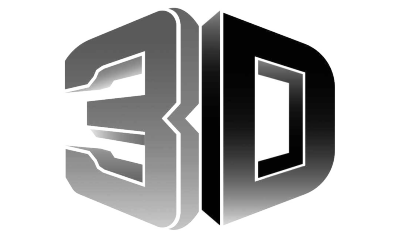

making church come **alive**
658 GRAHAM ROAD
SANFORD NC 27311

Client

3D COMMUNITY CHURCH

Project Number

23024.00


Description

WALL SECTIONS


Scale

1/2" = 1'-0"

A04.11

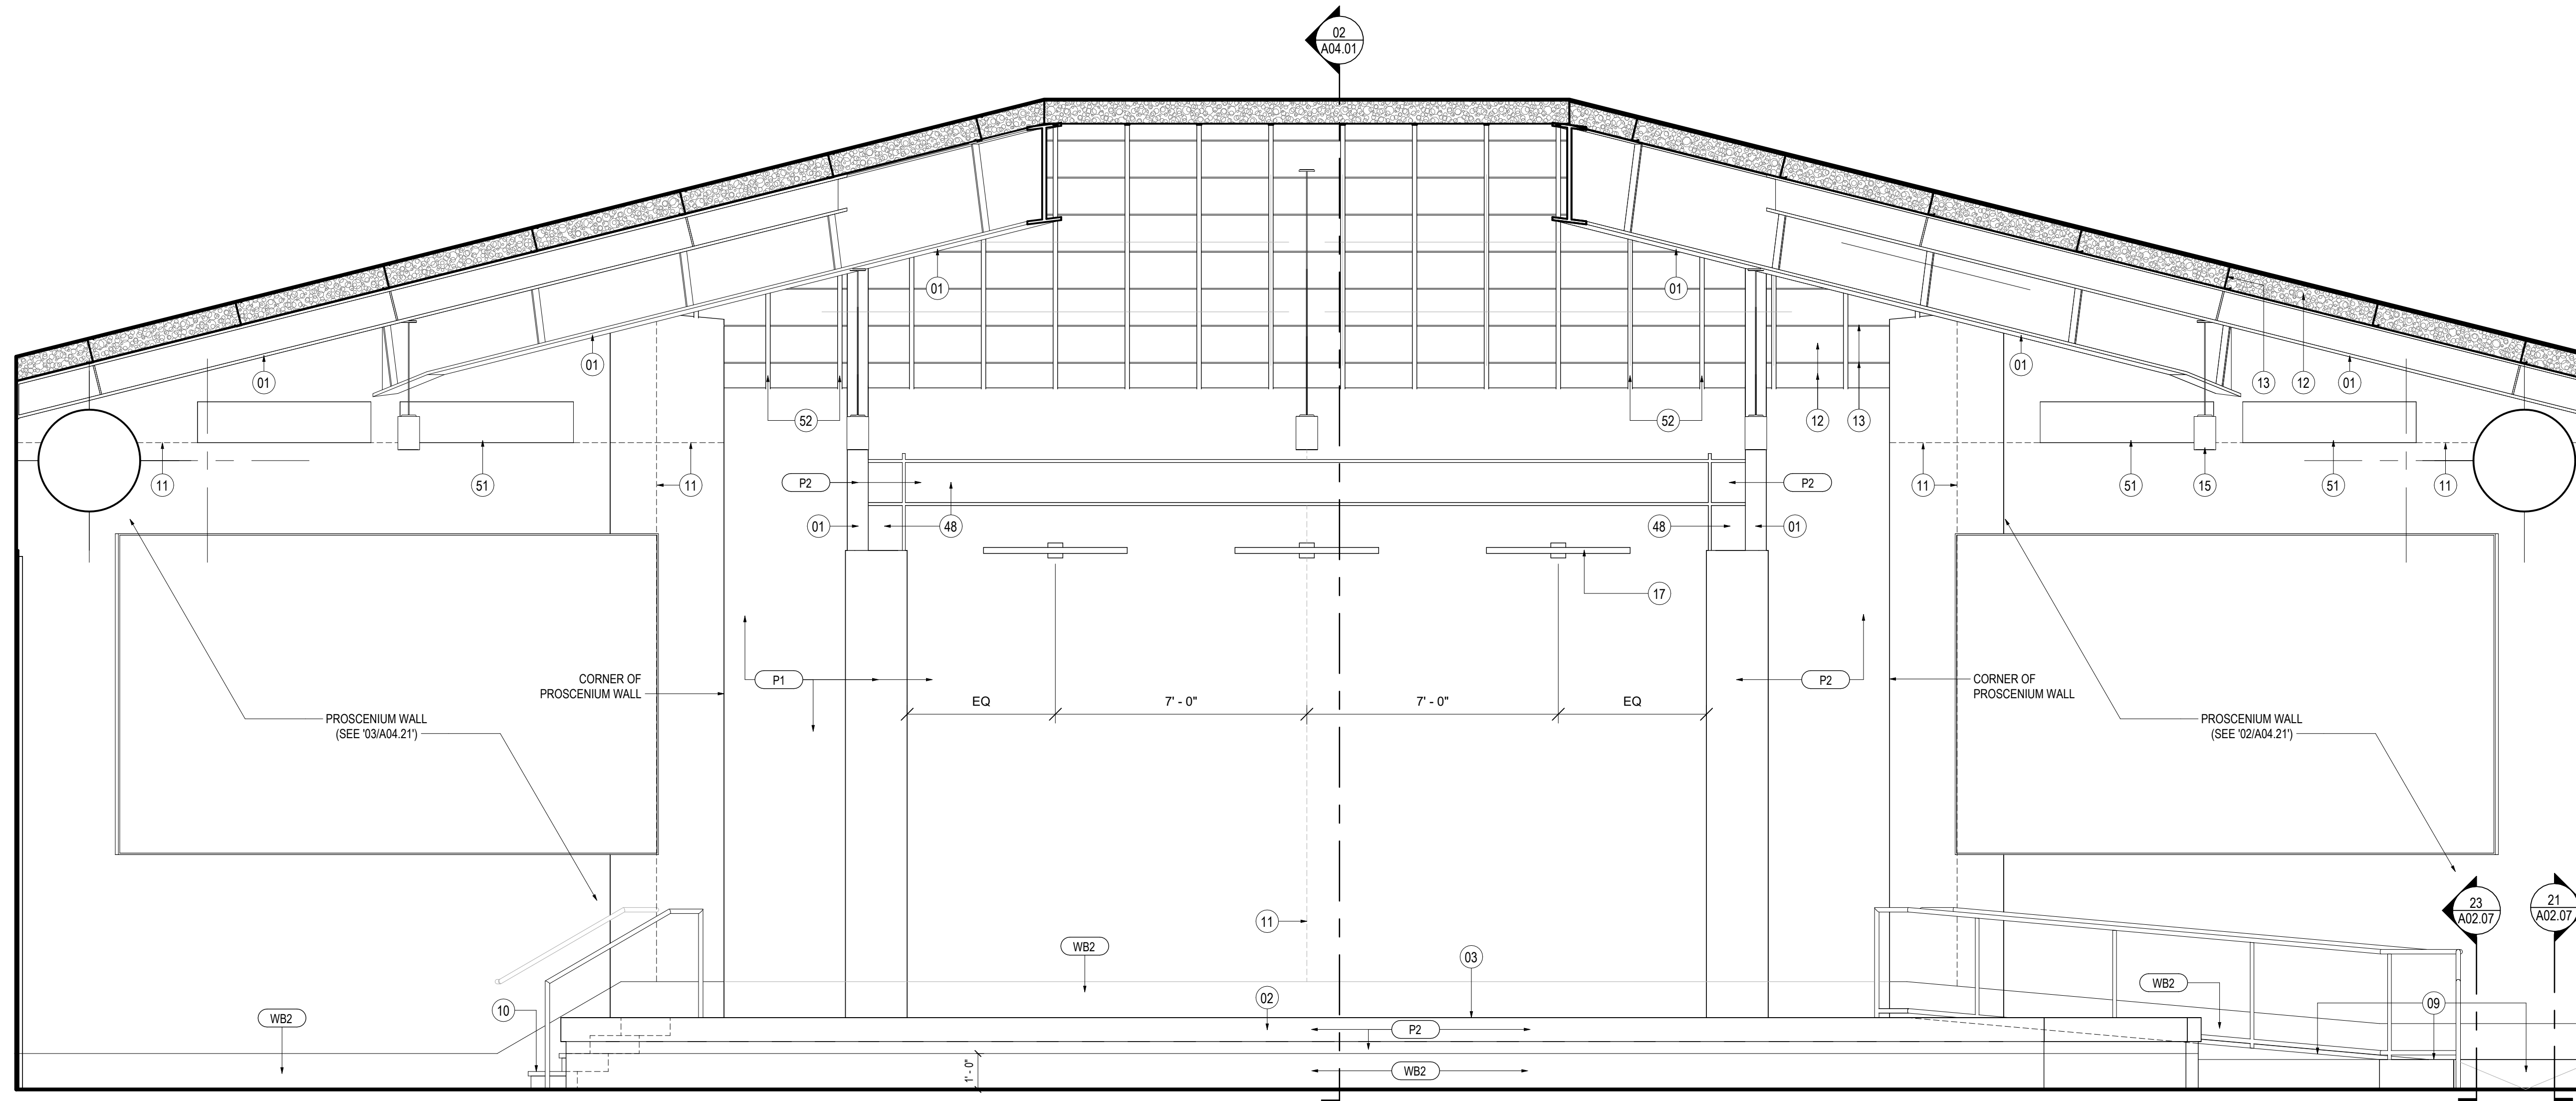

01 SANCTUARY STAGE
SCALE: 3/8" = 1'-0"

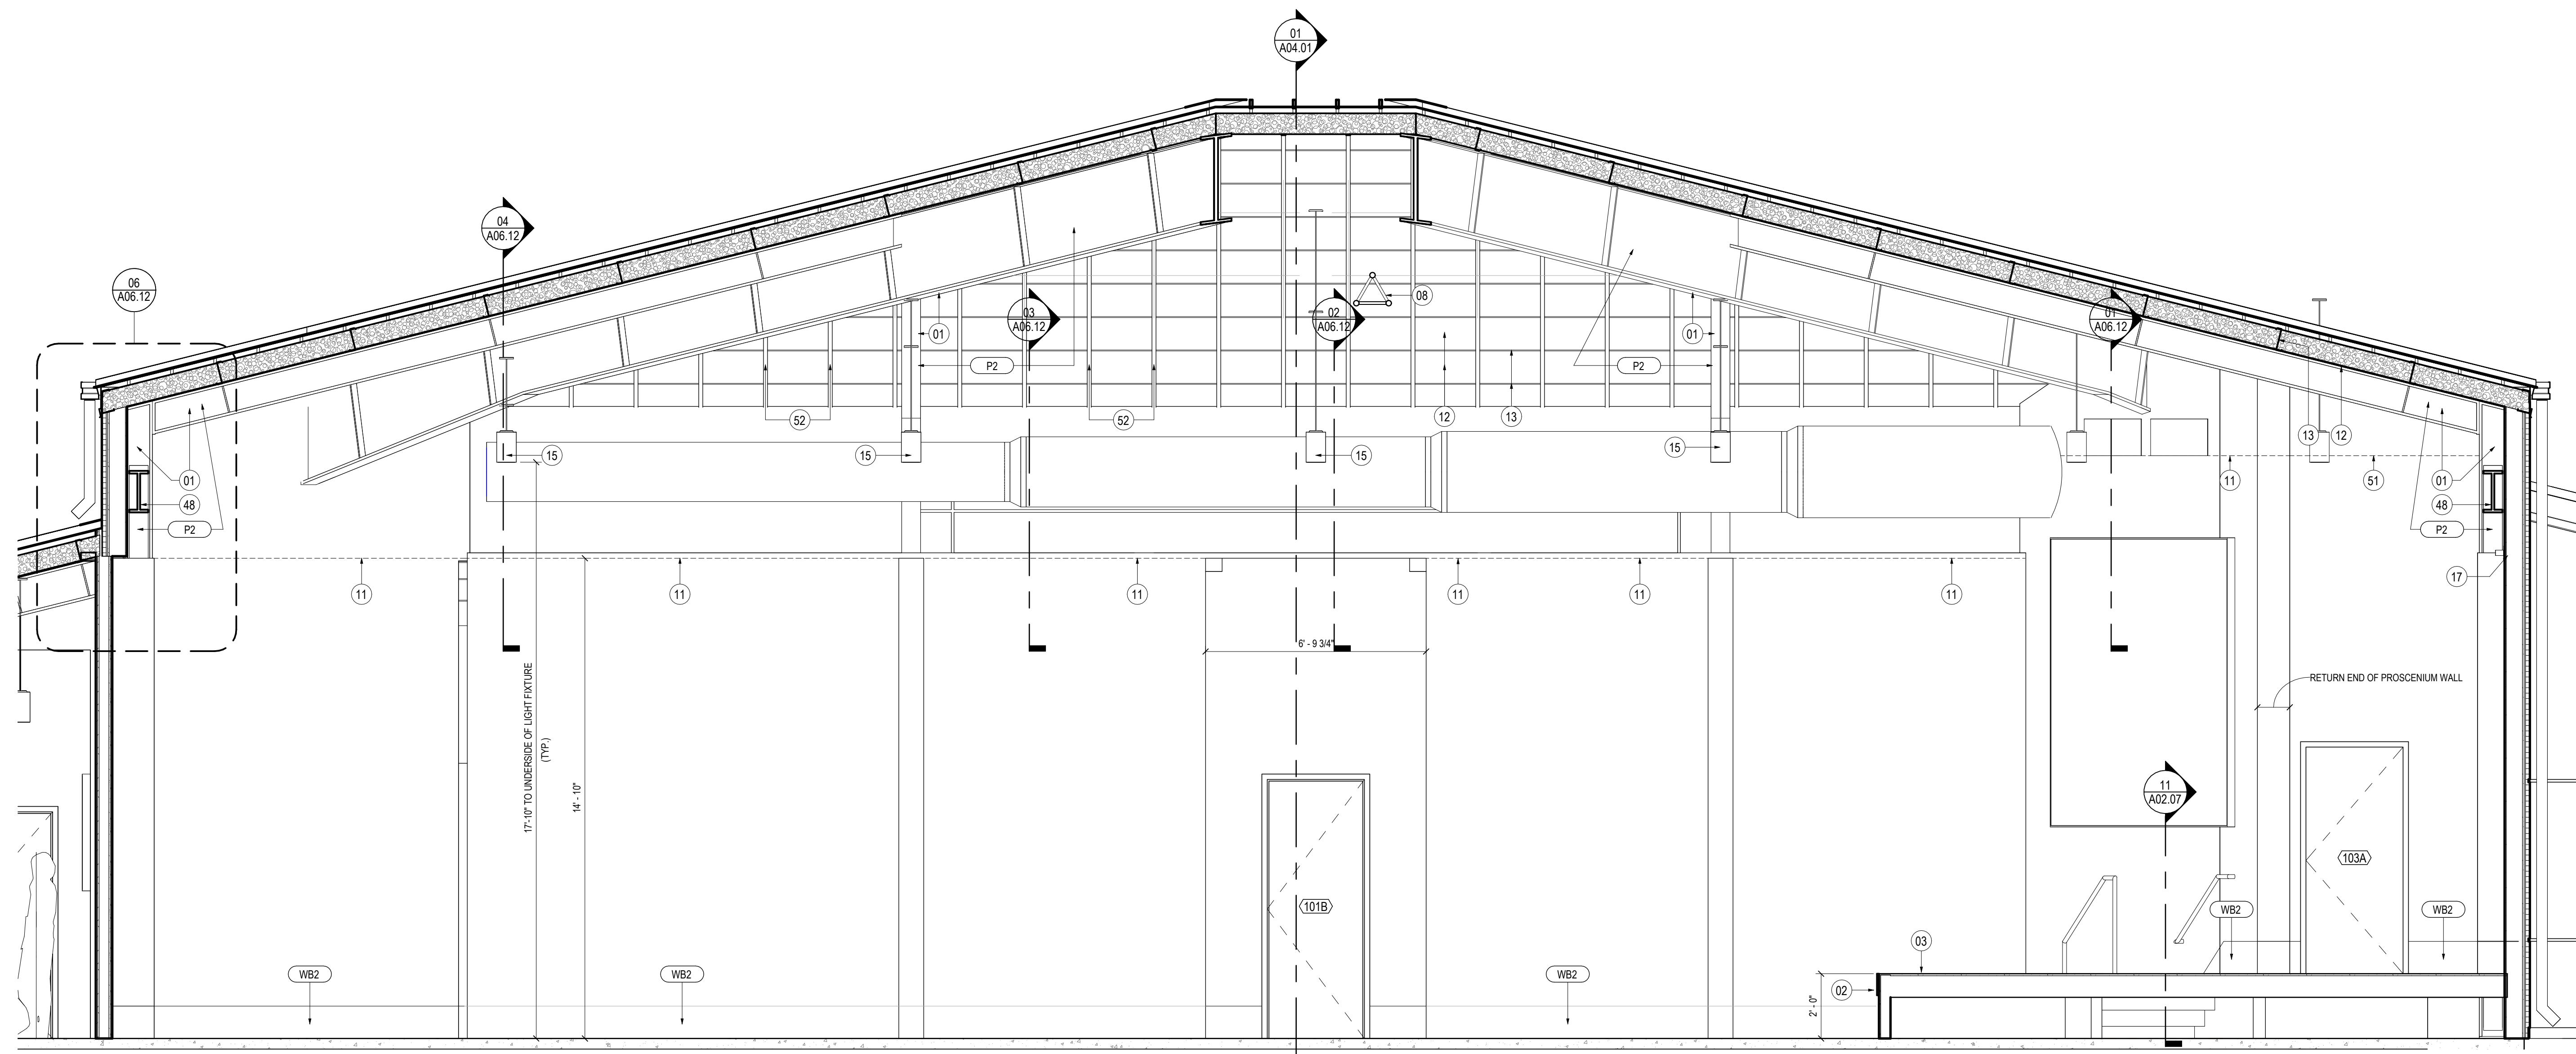


02 SANCTUARY (LEFT WALL)
SCALE: 3/8" = 1'-0"

SHEET NOTES

- 01 STRUCT. STL. - PAINT BLACK WHERE EXPOSED
- 02 GWB AND MDF STAGE APRON - PAINT BLACK
- 03 ELEVATED FLOOR w/ LVT FINISH ON 1/4" T. TEMPERED MASONITE, 1/2" HOMASOTE, AND 3/4" FRT PLYWOOD ON MTL. STUD FRAMING (SEE STRUCT.)
- 04 SLOPED GWB "CLOUD" AT UNDERSIDE OF STL. STRUCT.
- 07 MTL. PANEL CEILING SYSTEM MTL. BLDG. MANUF. LIGHTING TRUSS (SEE STRUCT.)
- 08 RAMP w/ LVT FINISH ON (2) LAYERS 3/4" FRT PLYWOOD ON MTL. STUD FRAMING (SEE STRUCT.)
- 09 STAIR w/ LVT FINISH ON (2) LAYERS 3/4" FRT PLYWOOD ON MTL. STUD FRAMING (SEE STRUCT.)
- 11 GWB CONTROL JOINT
- 12 EXPOSED ROOF INSULATION
- 13 MTL. Z PURLIN (TYP.)
- 14 SUSPENDED PROJECTION SCREEN (SEE ELEC.)
- 15 LED CYLINDER PENDANT LIGHT FIXTURE (TYP.) (SEE ELEC.)
- 16 LED WALL SCONCE LIGHT FIXTURE (TYP.) (SEE ELEC.)
- 17 RECTANGULAR BEAM LED LIGHT FIXTURE (TYP.) (SEE ELEC.)
- 18 RECESSED LED LIGHT FIXTURE (TYP.) (SEE ELEC.)
- 20 8"x16"x4" CMU (PROVIDE TIES PER MANUF. REQS.) ON MTL. STUD FURRING AT STL. COLUMN
- 21 E.I.F.S. - 1-1/2" R-7.5 RIGID INSUL. AND 5/8" SHEATHING ON 3-5/8" MTL. STUD FRAMING W/ R-13 BLANKET INSUL.
- 22 REVEAL (TYP.)
- 23 8"x16"x4" CMU (PROVIDE TIES PER MANUF. REQS.) W/ 1-1/2" AIR SPACE, 2" RIGID INSUL., AND 5/8" SHEATHING ON 3-5/8" MTL. STUD FRAMING W/ R-13 BLANKET INSUL.
- 24 STANDING SEAM MTL. ROOF (OWNER FURNISHED)
- 25 CONT. R-11 VINYL-FACED BLANKET INSUL. ON R-3 THERMAL SPACER BLOCKS (THERMAL SPACER BLOCKS TYP. AT EA. PURLIN)
- 26 R-19 FIBERGLASS BLANKET INSUL. BET. PURLINS (PROVIDE LONGITUDINAL AND TRANSVERSE MTL. SUPPORT BANDING)
- 27 CONT. BLACK FIBER-REINFORCED VAPOR BARRIER MEMBRANE AT BOTTOM OF PURLINS
- 28 CUTTER AND FLASHING BY MTL. BLDG. MANUF.
- 29 DOWNSPOUTS BY MTL. BLDG. MANUF. (TYP.)
- 31 3/8" T. x 24" D. CLEAR TEMPERED GLASS SHELVES (TYP.)
- 32 ADJUSTABLE SHELF BRACKETS & FLUSH-MOUNTED SHELF TRACKS (TYP.)
- 33 RACKS INSIDE WALL MOUNT EH COUNTER SUPPORT BRACKETS
- 34 OPEN TO UPPER ROOF ABOVE
- 35 MTL. C PURLIN BY MTL. BLDG. MANUF.
- 36 PRE-FIN. COUNTER FLASHING
- 37 TIE-IN TRIM BY MTL. BLDG. MANUF.
- 38 BACK-UP PLATE BY MTL. BLDG. MANUF.
- 39 OUTSIDE MTL. CLOSURE BY MTL. BLDG. MANUF.
- 41 STL. SPANDREL ANGLE AT BOTTOM OF MTL. Z PURLINS BY MTL. BLDG. MANUFACTURER
- 42 COMPRESSIBLE FILLER
- 43 NEW CONC. SIDEWALK
- 44 ALUM. DOOR AS SCHEDULED
- 45 DOOR THRESHOLD AS SCHEDULED - SET ON FULL BED OF MASTIC
- 46 TURNED-DOWN CONC. SLAB (SEE STRUCT.)
- 47 STRUCT. STL. COLUMN
- 48 STRUCT. STL. MOMENT FRAME - PAINT BLACK WHERE EXPOSED
- 49 SOUND ATTENUATION BLANKET (TYP.)
- 51 LINEAR SLOT RETURN (SEE MECH.)
- 52 MTL. SUPPORT BANDING - SPACE AS DIMENSIONED ON ENLARGED RCP (TYP.)
- 53 UNHINGED / RECESSED KNOXBOX (ALUM. FIN.)
- 54 FLUID-APPLIED AIR BARRIER MEMBRANE
- 55 JOINT SEALANT AND BACKER ROD
- 56 ALUM. STOREFRONT SYSTEM
- 57 E.I.F.S. - 1-1/2" R-7.5 RIGID INSUL. AND 5/8" SHEATHING ON 6" MTL. STUD FRAMING W/ R-13 BLANKET INSUL.
- 59 E.I.F.S. DRAINABLE TRACK
- 60 THRU-WALL STAINLESS STL. FLASHING W/ DRIP EDGE - FLASHED INTO AIR AND WATER BARRIER MEMBRANE
- 61 R-19 FIBERGLASS BLANKET INSUL. BET. MTL. STUD FRAMING (PROVIDE LONGITUDINAL AND TRANSVERSE MTL. SUPPORT BANDING)
- 62 STANDING SEAM MTL. ROOF (OWNER FURNISHED) ON 3/4" FRT PLYWOOD ON 6" MTL. STUD FRAMING
- 68 ROLLERSHADE AT EA. EXT. WINDOW (TYP.)
- 69 EAVE TRIM, PANEL CAP TRIM, AND FLASHING BY MTL. BLDG. MANUF.
- 70 MTL. STUD BRACE (SEE STRUCT.)



4539 HEDGEMORE DRIVE, SUITE 101
CHARLOTTE NC 28209
704.890.2553
WWW.OSSASTUDIO.COM

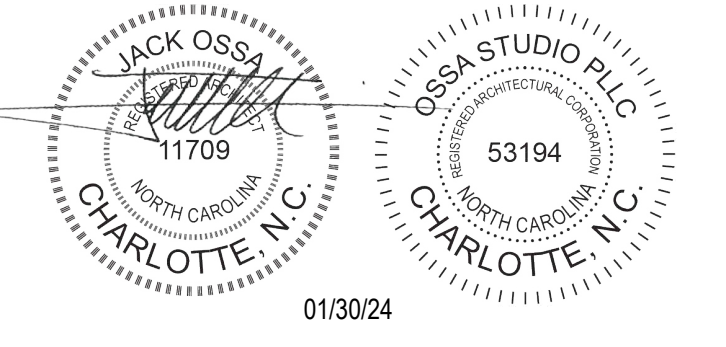

PROJECT TEAM

- General Contractor**
ECCLESIA CONSTRUCTION
www.ecclesiainc.com
803.327.5670
- Civil Engineering**
HILLIARD ENGINEERING, PLLC
www.hilliardep.com
919.352.2834
- Structural Engineering**
PROVIDENCE PARTNERS
www.providencepartnersinc.com
704.266.6621
- Mechanical, Electrical, Plumbing & Fire Protection**
ENGINEERING
www.engineering.com
704.287.2193

Date	Description
10/30/24	FOR CONSTRUCTION

Project Name

3D
community church
making church come alive
658 GRAHAM ROAD
SANFORD NC 27311

Client

3D COMMUNITY CHURCH

Project Number

23024.00

Description


INTERIOR ELEVATIONS

Scale

3/8" = 1'-0"

A04.20

10/14/2024 5:07:10 PM C:\Private\Drawings\Local\23024.00_3D Community Church\interior\04.20\01.dwg

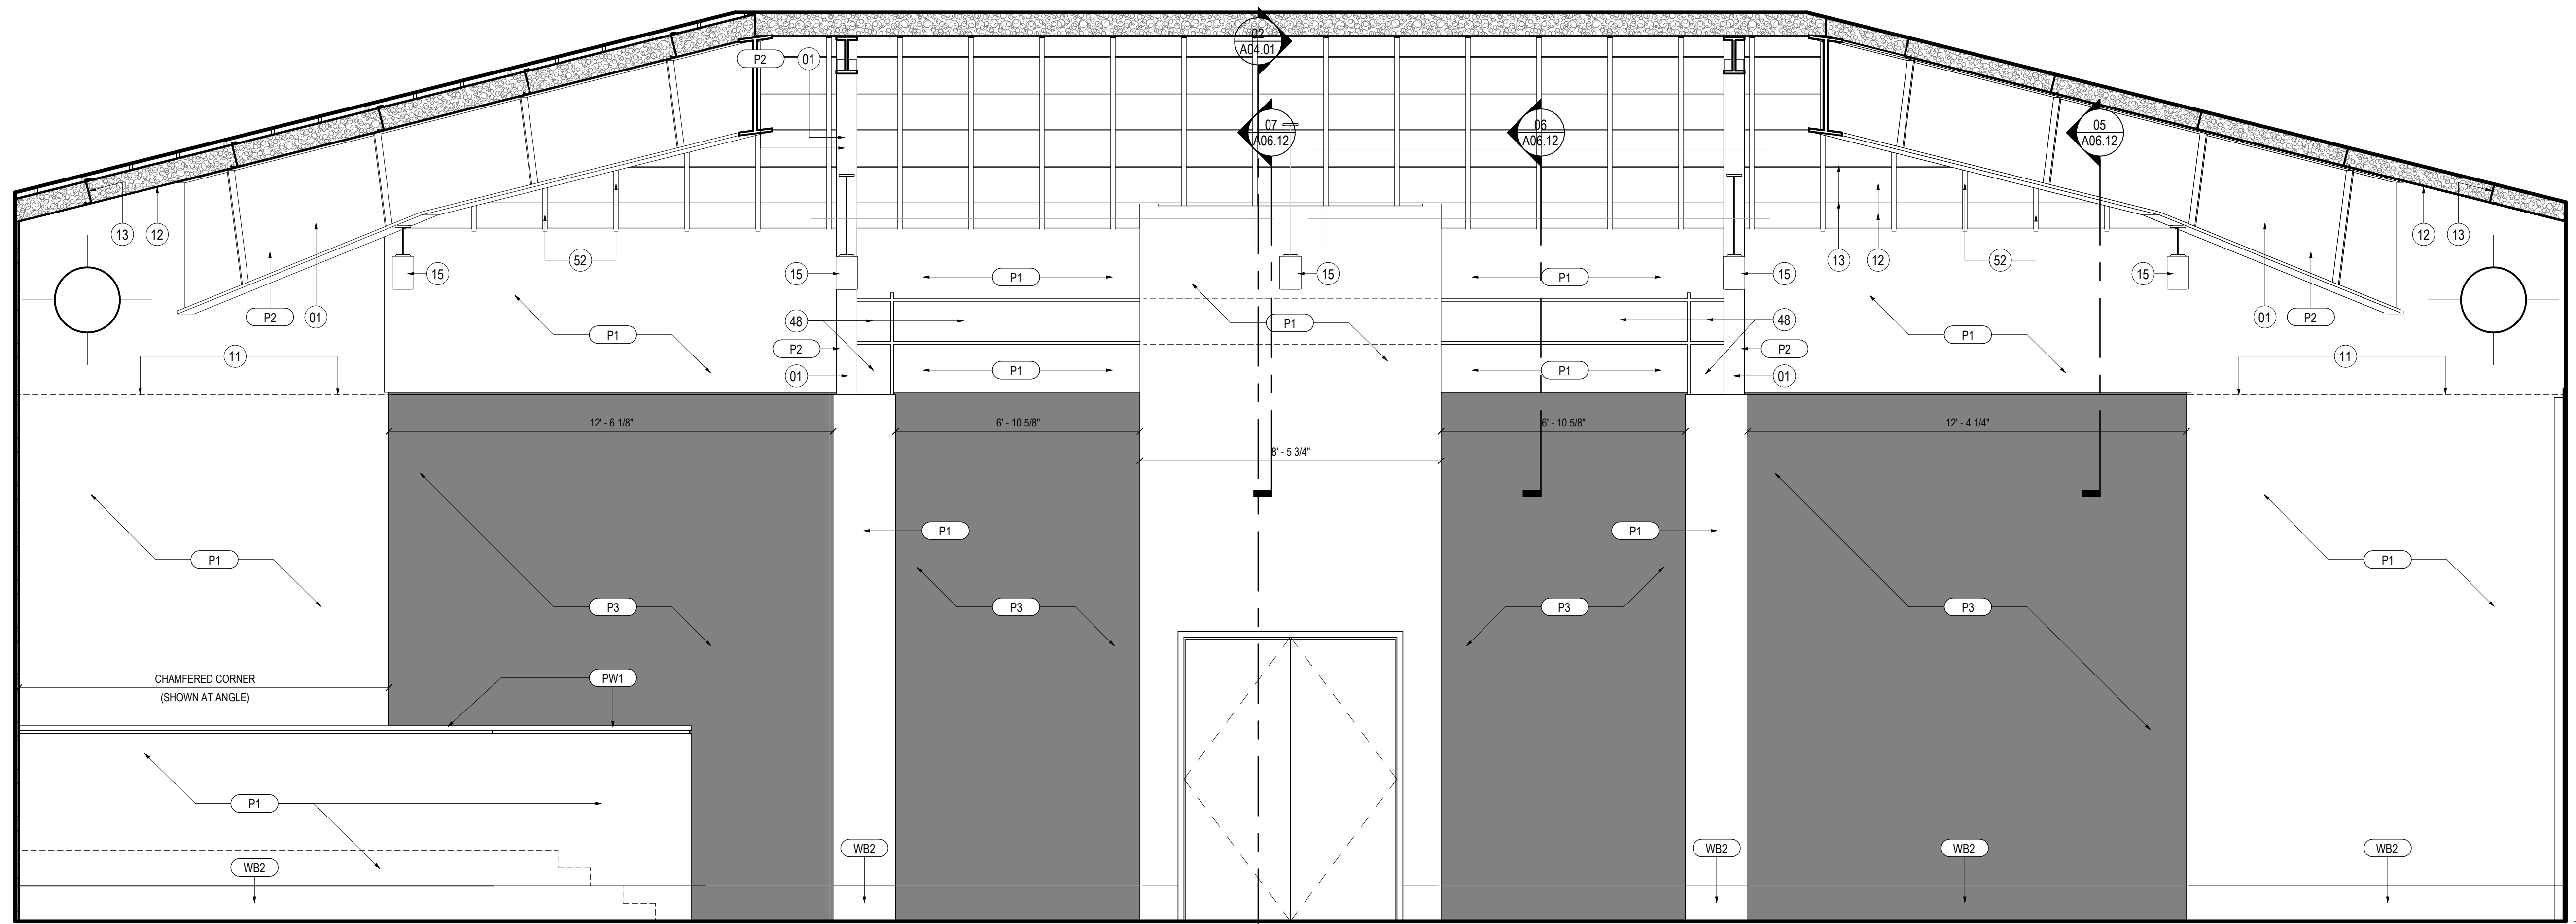


01 SANCTUARY (ENTRY WALL)
SCALE: 3/8" = 1'-0"

SHEET NOTES

- 01 STRUCT. STL. - PAINT BLACK WHERE EXPOSED
- 02 GWB AND MDF STAGE APRON - PAINT BLACK
- 03 ELEVATED FLOOR w/ LVT FINISH ON 1/4" T. TEMPERED MASONITE, 1/2" HOMASOTE, AND 3/4" FRP PLYWOOD ON MTL. STUD FRAMING (SEE STRUCT.)
- 04 SLOPED GWB "CLOUD" AT UNDERSIDE OF STL. STRUCT.
- 07 MTL. PANEL CEILING SYSTEM MTL. BLDG. MANUF. LIGHTING TRUSS (SEE STRUCT.)
- 09 RAMP w/ LVT FINISH ON (2) LAYERS 3/4" FRP PLYWOOD ON MTL. STUD FRAMING (SEE STRUCT.)
- 10 STAIR w/ LVT FINISH ON (2) LAYERS 3/4" FRP PLYWOOD ON MTL. STUD FRAMING (SEE STRUCT.)
- 11 GWB CONTROL JOINT
- 12 EXPOSED ROOF INSULATION
- 13 MTL. Z PURLIN (TYP.)
- 14 SUSPENDED PROJECTION SCREEN (SEE ELEC.)
- 15 LED CYLINDER PENDANT LIGHT FIXTURE (TYP.) (SEE ELEC.)
- 16 LED WALL SCONCE LIGHT FIXTURE (TYP.) (SEE ELEC.)
- 17 RECTANGULAR BEAM LED LIGHT FIXTURE (TYP.) (SEE ELEC.)
- 18 RECESSED LED LIGHT FIXTURE (TYP.) (SEE ELEC.)
- 20 8"x16"x4" CMU (PROVIDE TIES PER MANUF. REQS.) ON MTL. STUD FURRING AT STL. COLUMN
- 21 E.I.F.S. - 1-1/2" R-7.5 RIGID INSUL. AND 5/8" SHEATHING ON 3/8" MTL. STUD FRAMING W/ R-13 BLANKET INSUL.
- 22 REVEAL (TYP.)
- 23 8"x16"x4" CMU (PROVIDE TIES PER MANUF. REQS.) W/ 1-1/2" AIR SPACE, 2" RIGID INSUL., AND 5/8" SHEATHING ON 3/8" MTL. STUD FRAMING
- 24 STANDING SEAM MTL. ROOF (OWNER FURNISHED)
- 25 CONT. R-11 VINYL-FACED BLANKET INSUL. ON R-3 THERMAL SPACER BLOCKS (THERMAL SPACER BLOCKS TYP. AT EA. PURLIN)
- 26 R-19 FIBERGLASS BLANKET INSUL. BET. PURLINS (PROVIDE LONGITUDINAL AND TRANSVERSE MTL. SUPPORT BANDING)
- 27 CONT. BLACK FIBER-REINFORCED VAPOR BARRIER MEMBRANE AT BOTTOM OF PURLINS
- 28 GUTTER AND FLASHING BY MTL. BLDG. MANUF.
- 29 DOWNSPOUTS BY MTL. BLDG. MANUF. (TYP.)
- 31 3/8" T. x 24" D. CLEAR TEMPERED GLASS SHELVES (TYP.)
- 32 ADJUSTABLE SHELF BRACKETS & FLUSH-MOUNTED SHELF TRACKS (TYP.)
- 33 RAKES INSIDE WALL MOUNT EH COUNTER SUPPORT BRACKETS
- 34 OPEN TO UPPER ROOF ABOVE
- 35 MTL. C PURLIN BY MTL. BLDG. MANUF.
- 36 PRE-FIN. COUNTER FLASHING
- 37 TIE-IN TRIM BY MTL. BLDG. MANUF.
- 38 BACK-UP PLATE BY MTL. BLDG. MANUF.
- 39 OUTSIDE MTL. CLOSURE BY MTL. BLDG. MANUF.
- 41 STL. SPANDEL ANGLE AT BOTTOM OF MTL. Z PURLINS BY MTL. BLDG. MANUFACTURER
- 42 COMPRESSIBLE FILLER
- 43 NEW CONC. SIDEWALK
- 44 ALUM. DOOR AS SCHEDULED
- 45 DOOR THRESHOLD AS SCHEDULED - SET ON FULL BED OF MASTIC
- 46 TURNED-DOWN CONC. SLAB (SEE STRUCT.)
- 47 STRUCT. STL. COLUMN
- 48 STRUCT. STL. MOMENT FRAME - PAINT BLACK WHERE EXPOSED
- 49 SOUND ATTENUATION BLANKET (TYP.)
- 51 LINEAR SLOT RETURN (SEE MECH.)
- 52 MTL. SUPPORT BANDING - SPACE AS DIMENSIONED ON ENLARGED RCP (TYP.)
- 53 UNHINGED / RECESSED KNOXBOX (ALUM. FIN.)
- 54 FLUID-APPLIED AIR BARRIER MEMBRANE
- 55 JOINT SEALANT AND BACKER ROD
- 56 ALUM. STOREFRONT SYSTEM
- 57 E.I.F.S. - 1-1/2" R-7.5 RIGID INSUL. AND 5/8" SHEATHING ON 6" MTL. STUD FRAMING W/ R-13 BLANKET INSUL.
- 59 E.I.F.S. DRAINABLE TRACK
- 60 THRU-WALL STAINLESS STL. FLASHING W/ DRIP EDGE - FLASHED INTO AIR AND WATER BARRIER MEMBRANE
- 61 R-19 FIBERGLASS BLANKET INSUL. BET. MTL. STUD FRAMING (PROVIDE LONGITUDINAL AND TRANSVERSE MTL. SUPPORT BANDING)
- 62 STANDING SEAM MTL. ROOF (OWNER FURNISHED) ON 3/4" FRP PLYWOOD ON 6" MTL. STUD FRAMING
- 68 ROLLERSHADE AT EA. EXT. WINDOW (TYP.)
- 69 EAVE TRIM, PANEL CAP TRIM, AND FLASHING BY MTL. BLDG. MANUF.
- 70 MTL. STUD BRACE (SEE STRUCT.)



4539 HEDGEMORE DRIVE, SUITE 101
CHARLOTTE NC 28209
704.890.2553
WWW.OSSASTUDIO.COM

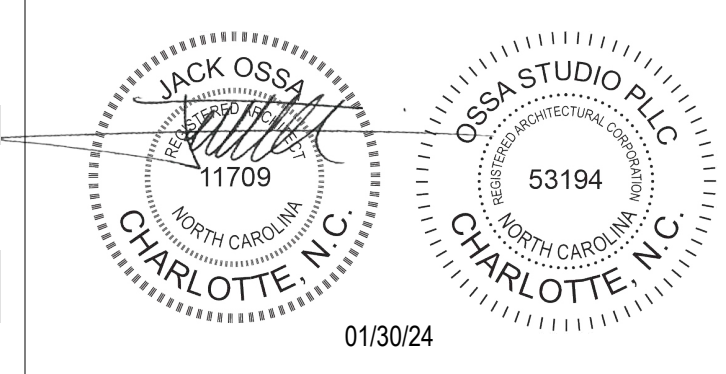

PROJECT TEAM

- General Contractor**
ECCLESIA CONSTRUCTION
www.ecclesiainc.com
803.327.5670
- Civil Engineering**
HILLIARD ENGINEERING, PLLC
www.hilliardep.com
919.352.2834
- Structural Engineering**
PROVIDENCE PARTNERS
www.providencepartnersinc.com
704.266.6621
- Mechanical, Electrical, Plumbing & Fire Protection**
ENGINEERING
www.engineering.com
704.287.2193

Date	Description
10/30/24	FOR CONSTRUCTION

Project Name

3D
community church
making church come alive
658 GRAHAM ROAD
SANFORD NC 27311

Client

3D COMMUNITY CHURCH

Project Number

23024.00


Description

INTERIOR ELEVATIONS


Scale

3/8" = 1'-0"


A04.21

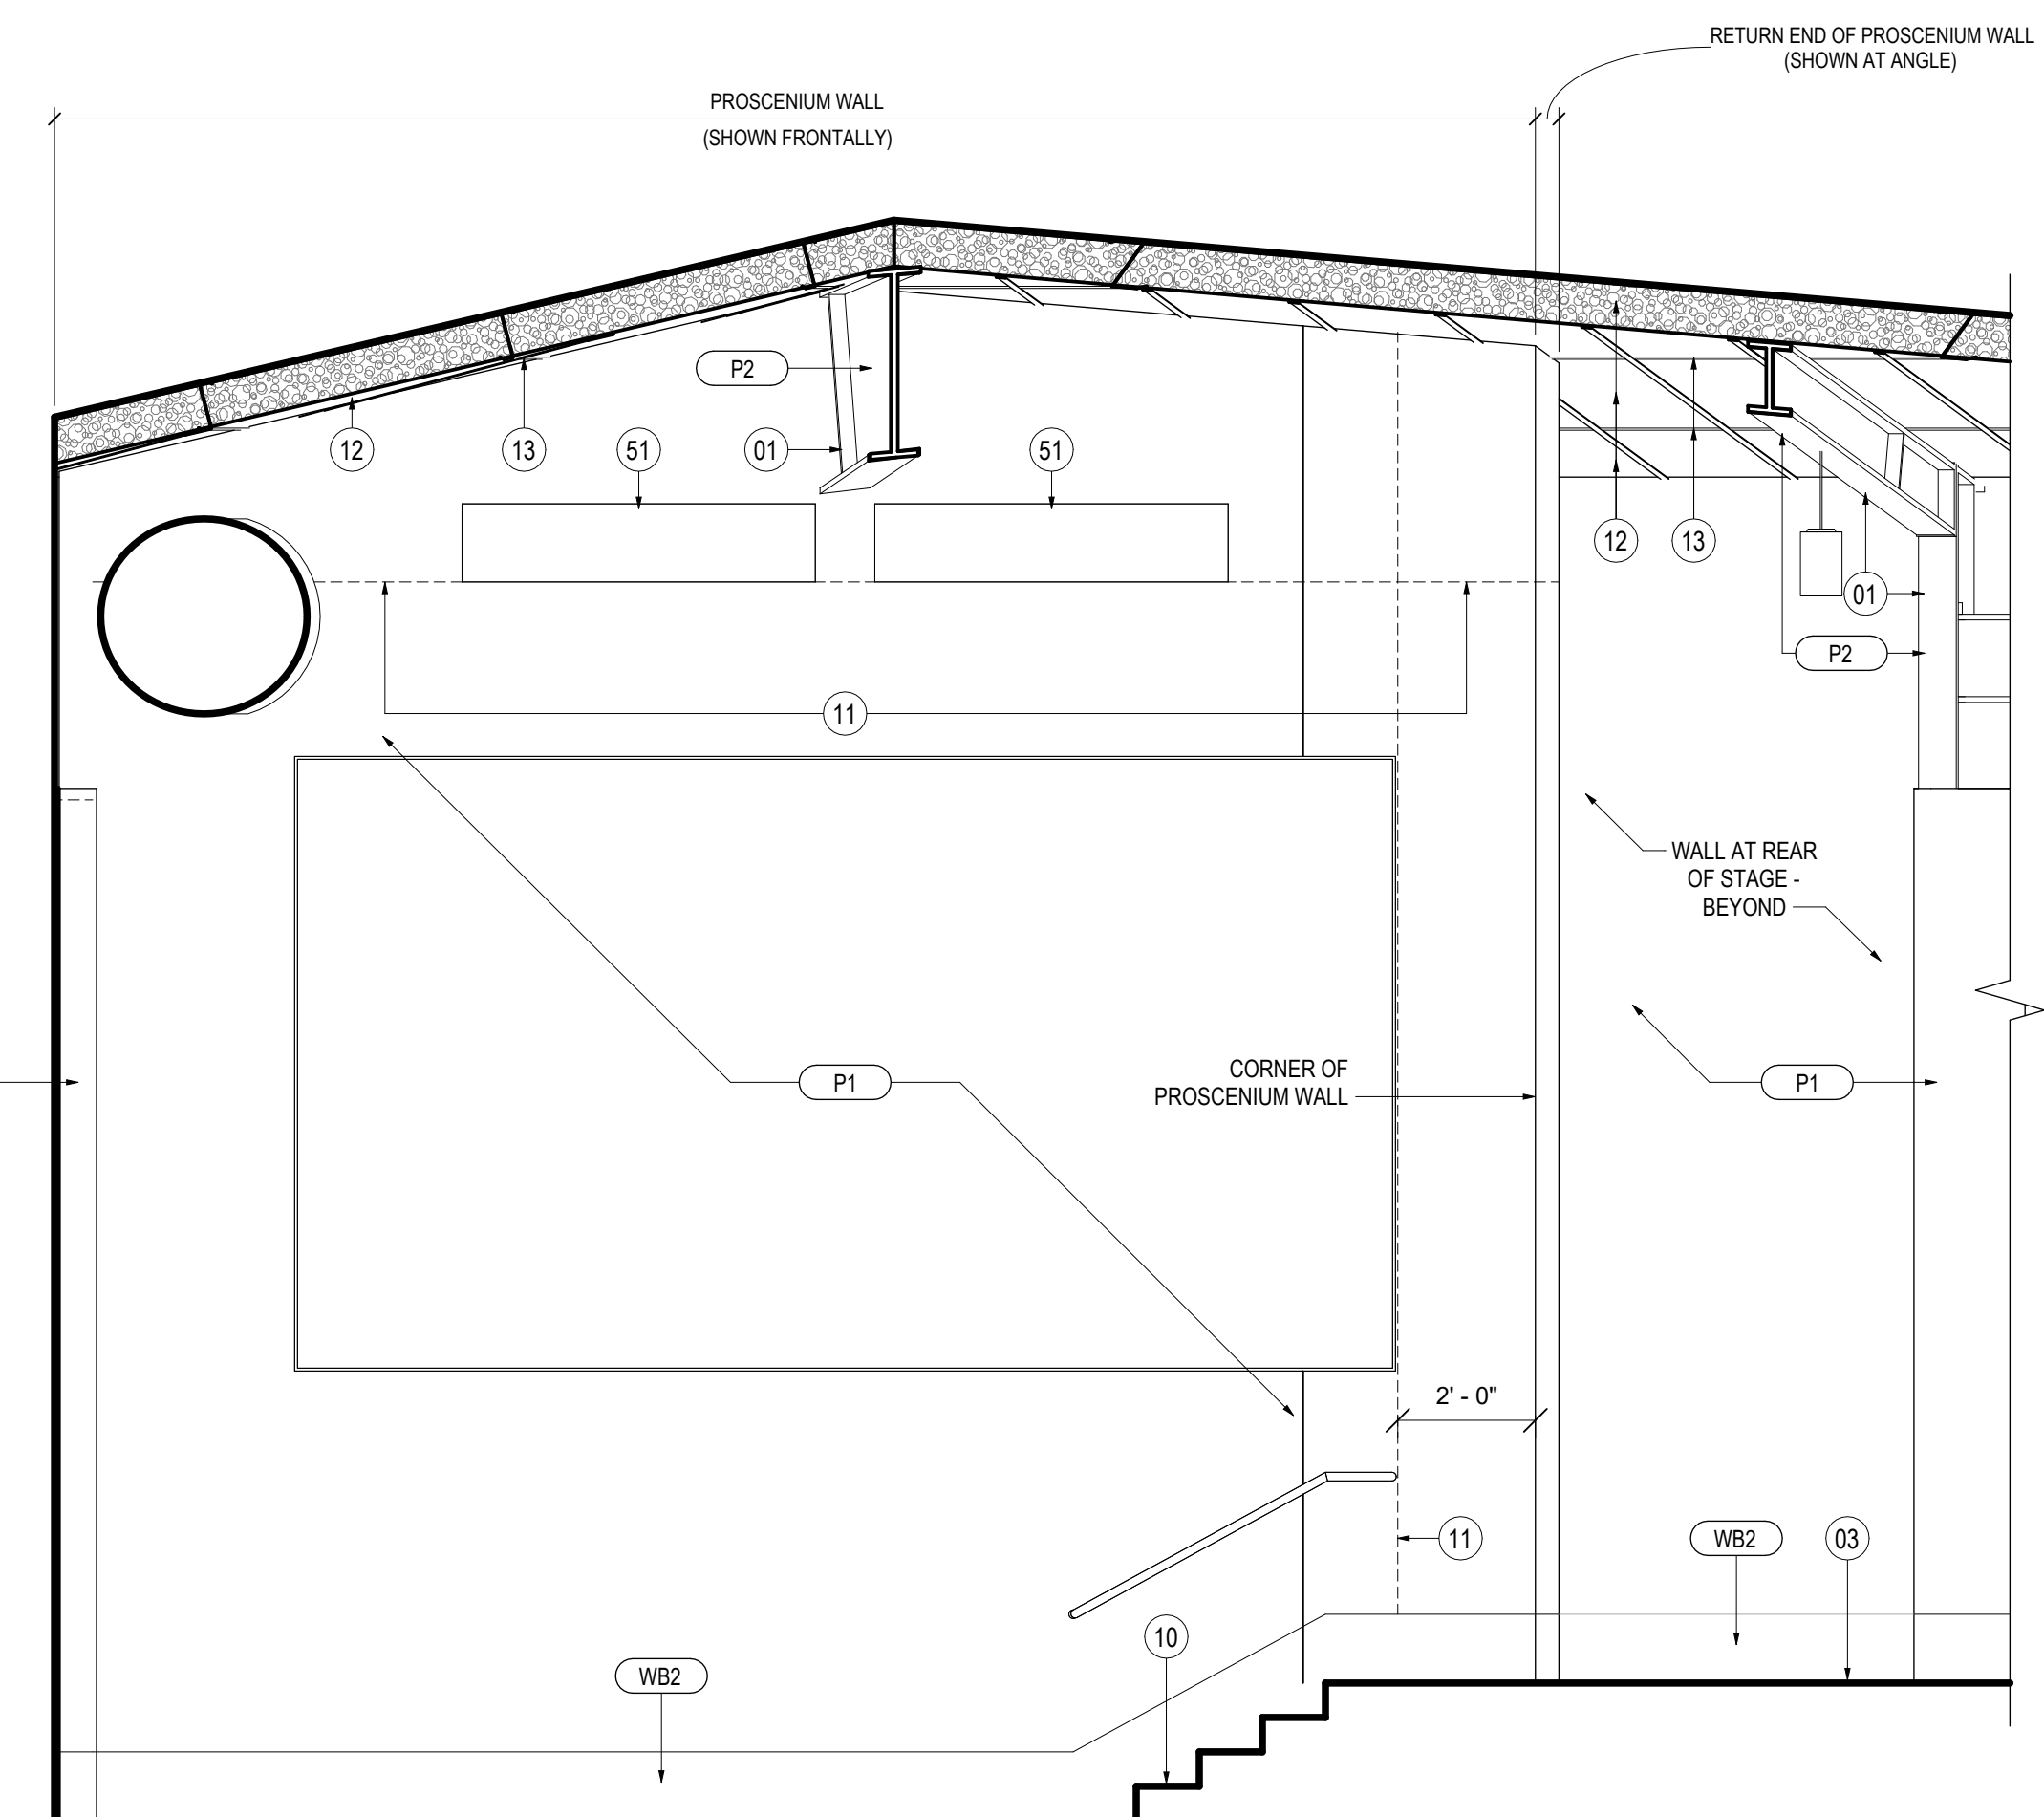


03 PROSCENIUM WALL (LEFT)
SCALE: 3/8" = 1'-0"

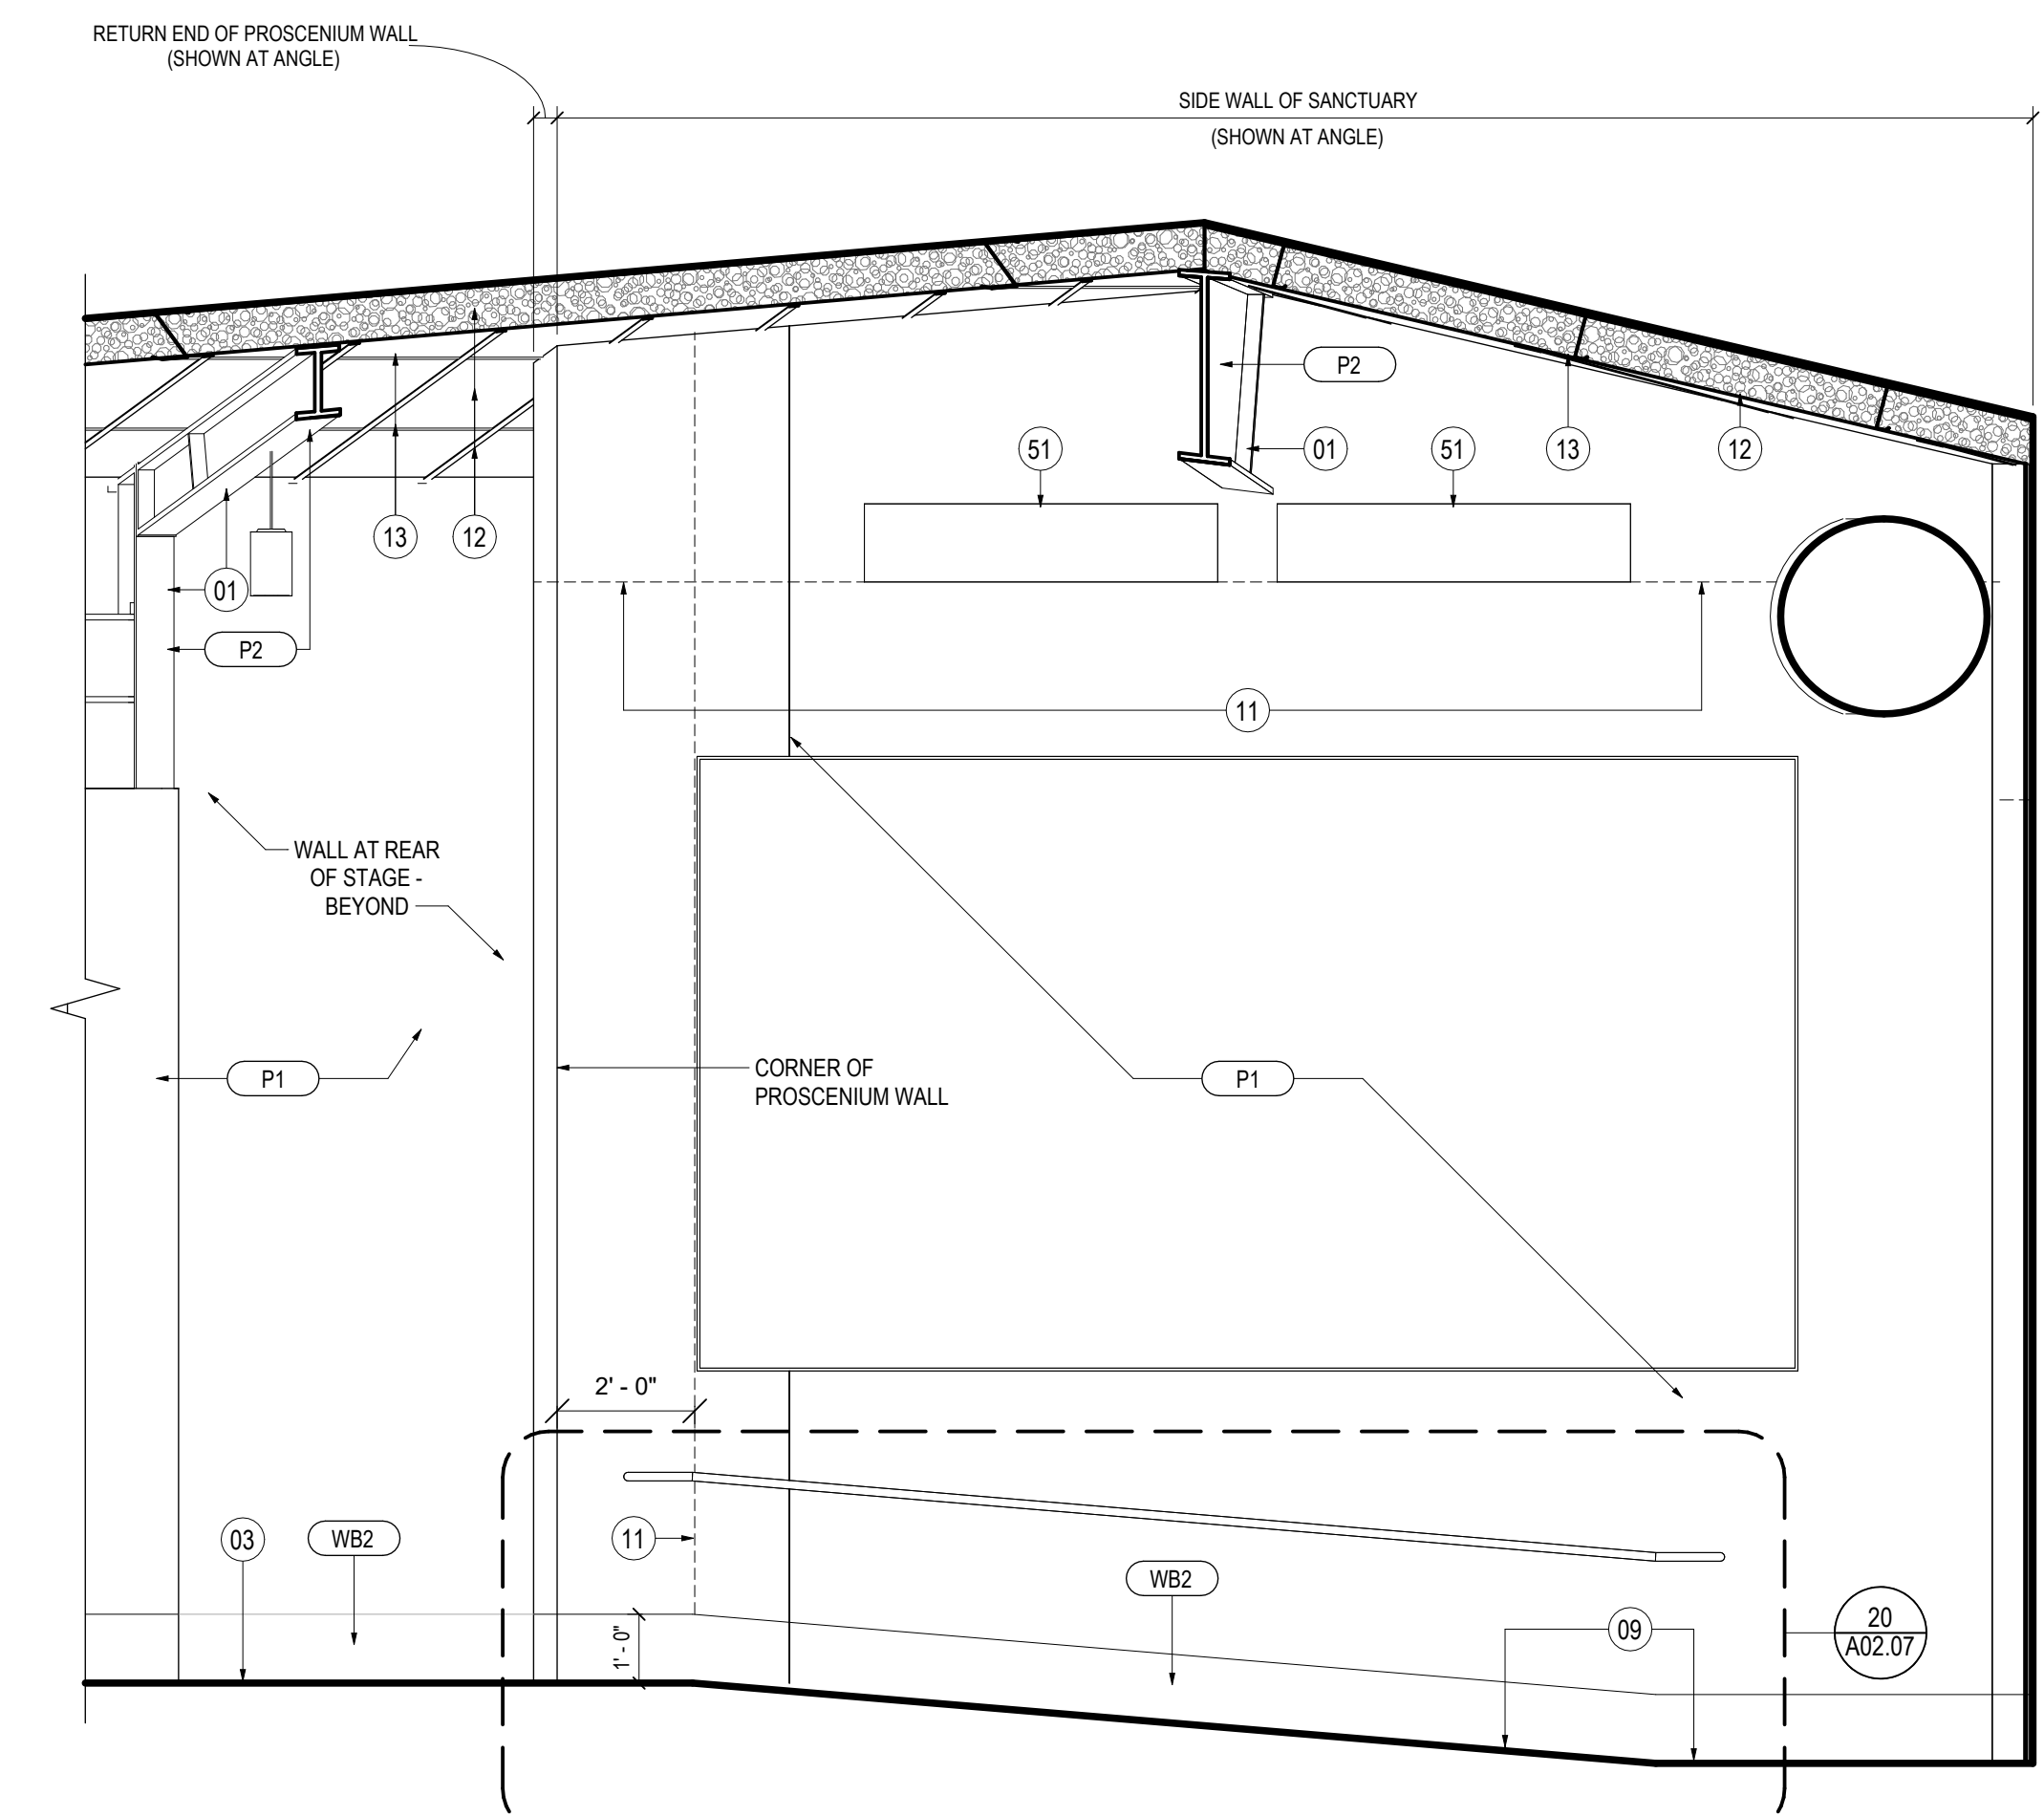


02 PROSCENIUM WALL (RIGHT)
SCALE: 3/8" = 1'-0"

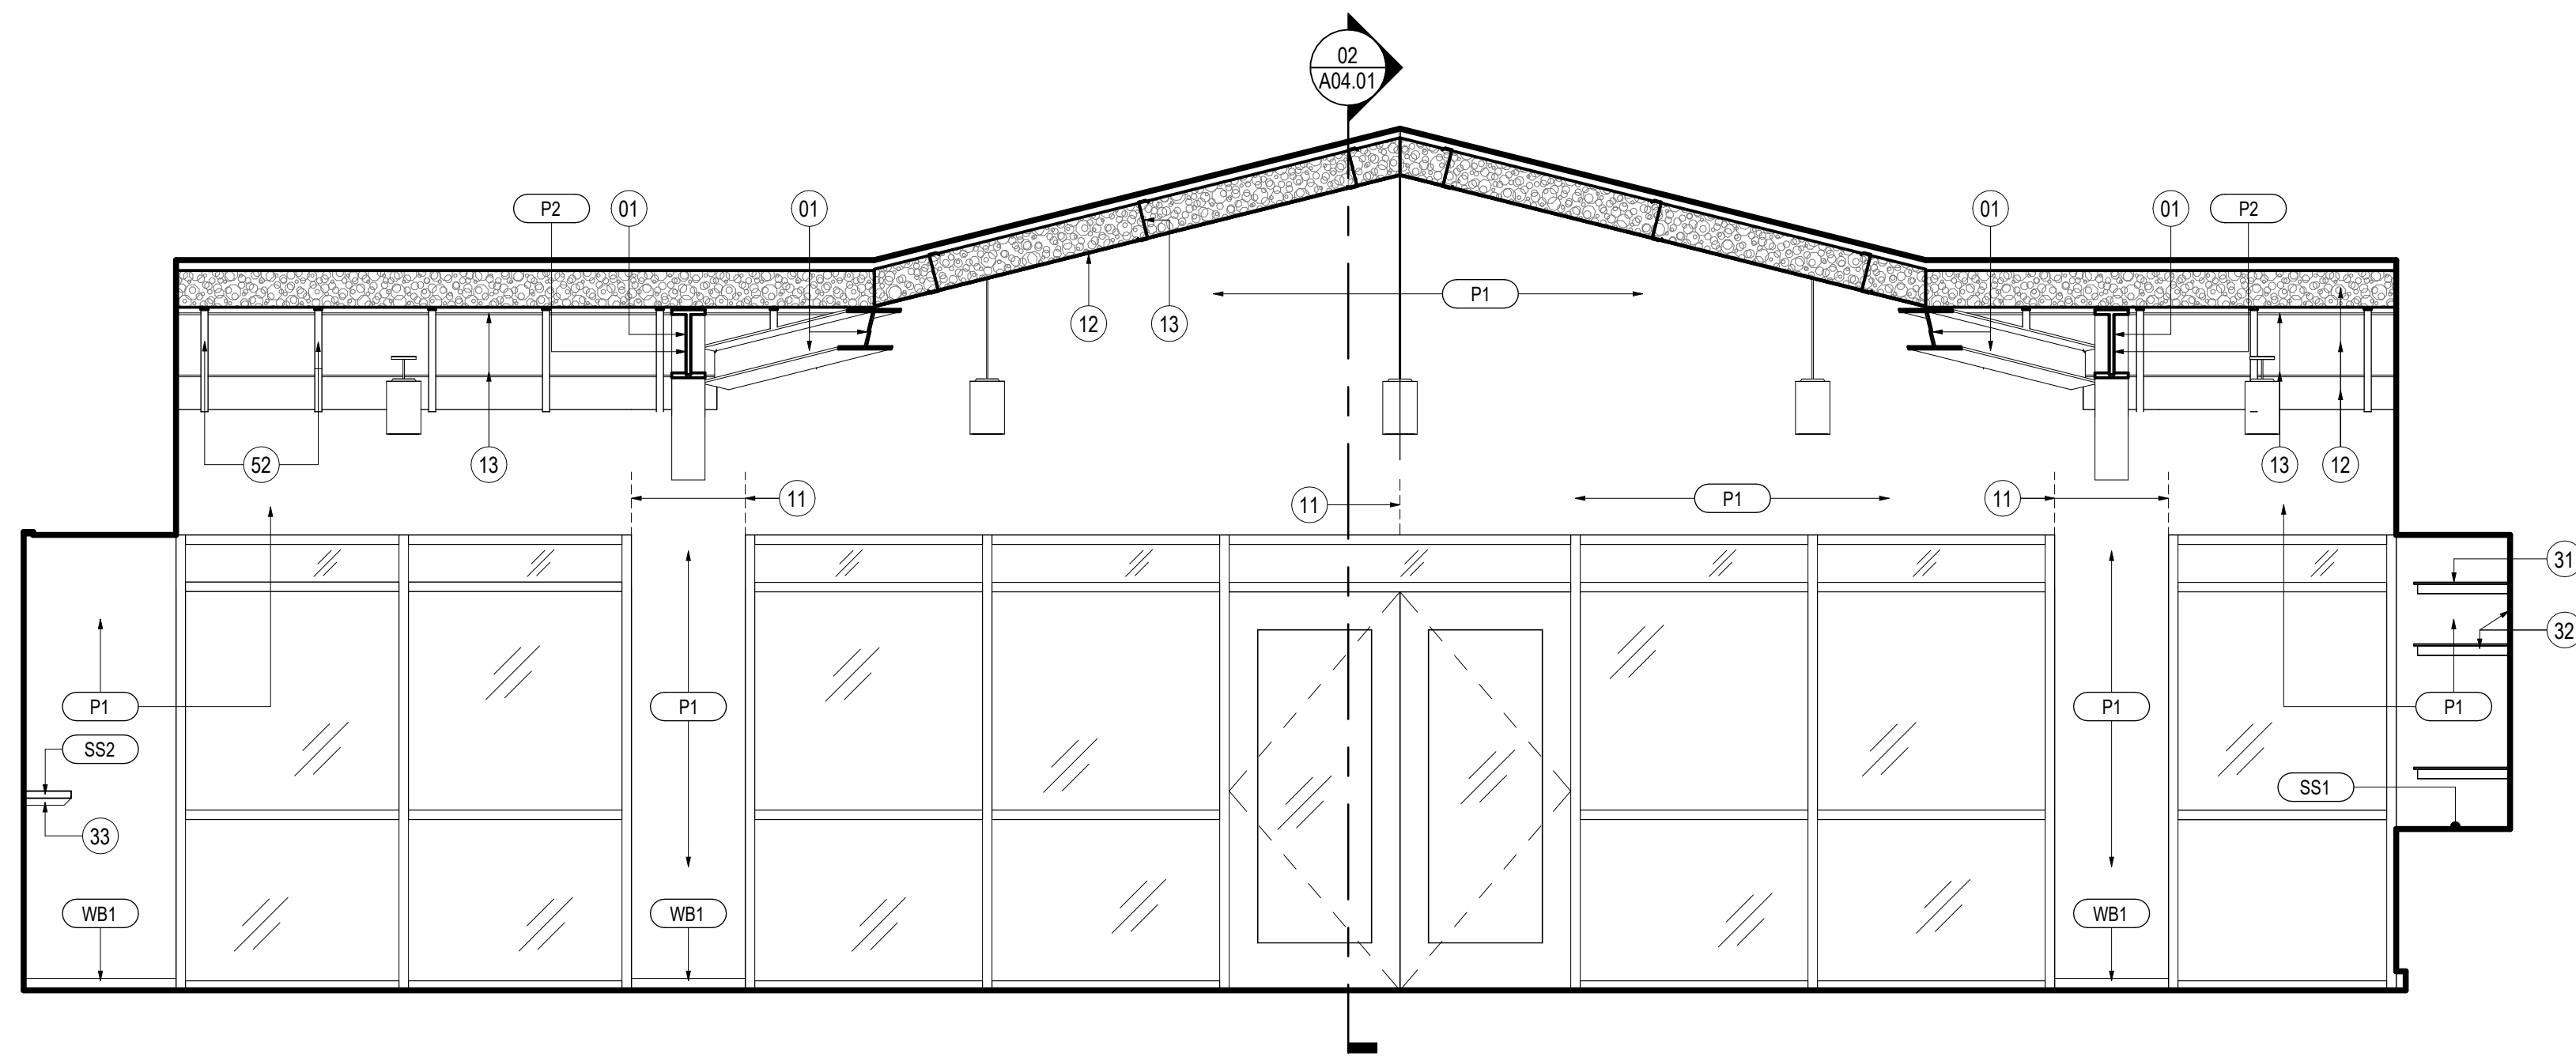


04 NARTHEX (ENTRY WALL)
SCALE: 3/8" = 1'-0"

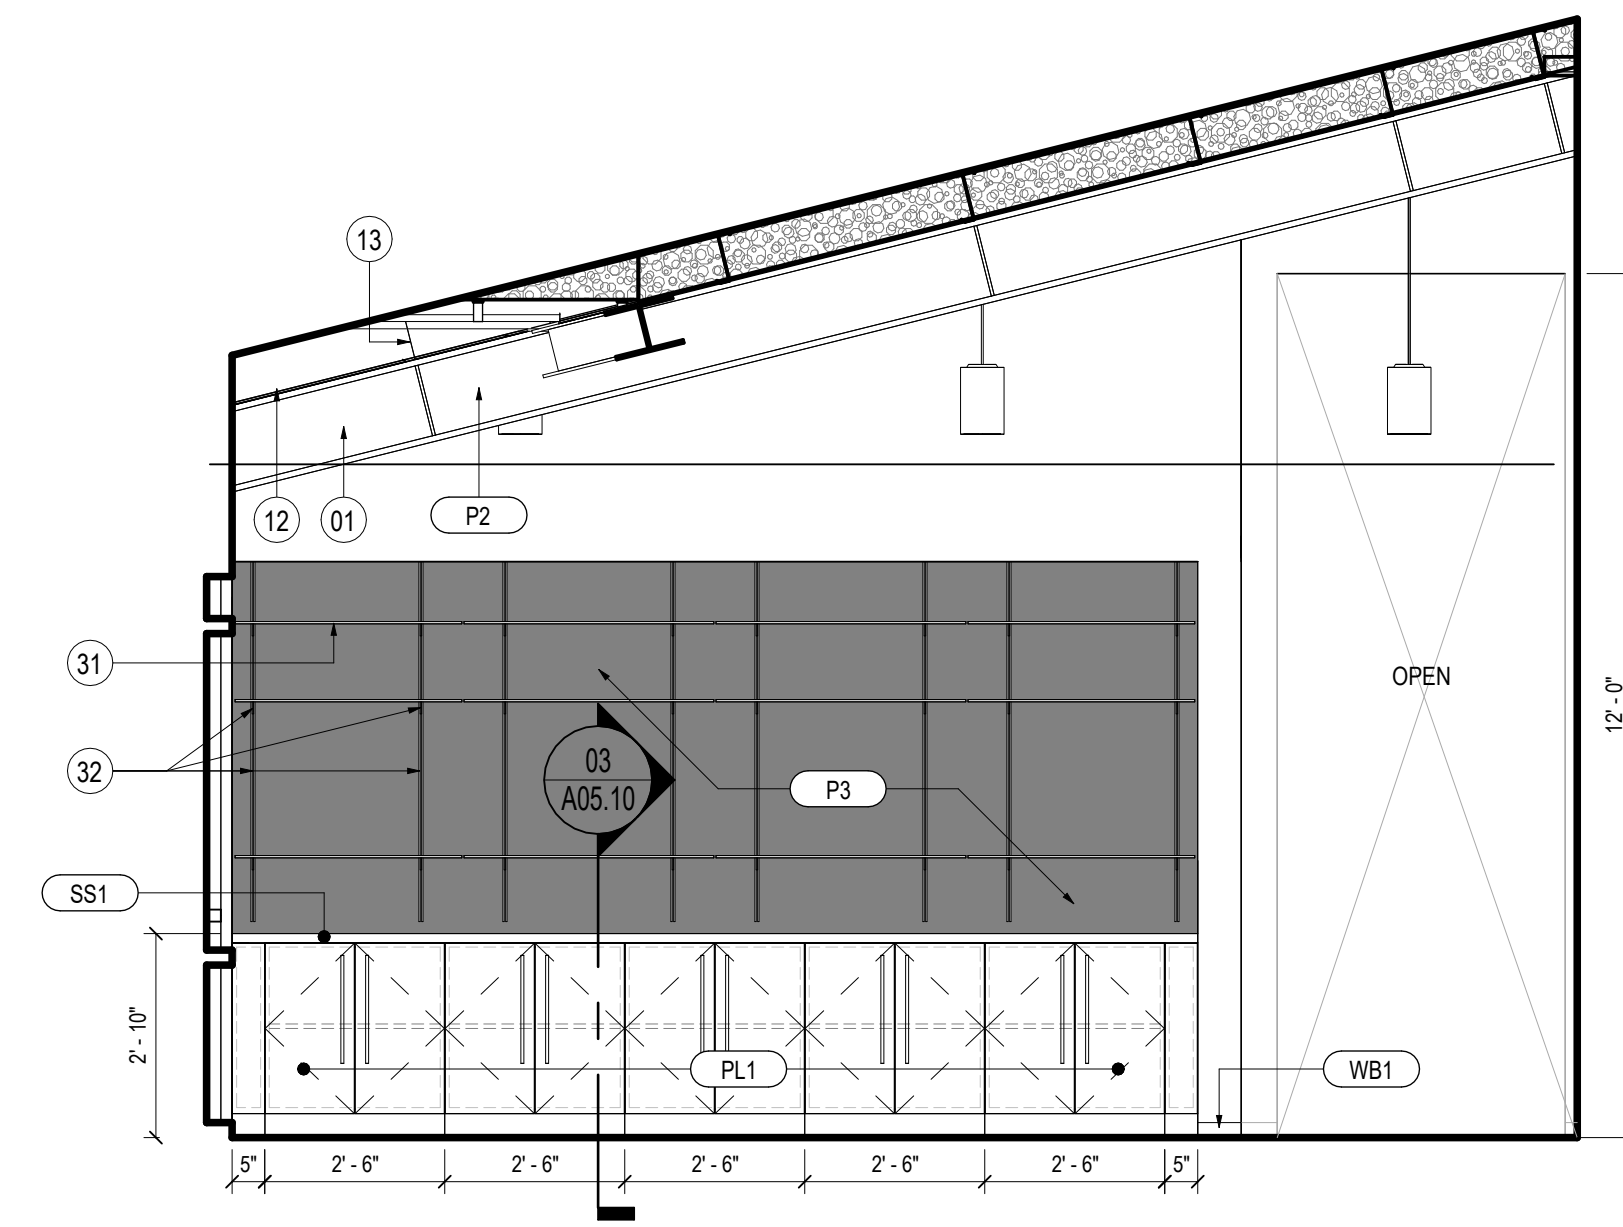

01 NARTHEX (LEFT WALL)
SCALE: 3/8" = 1'-0"

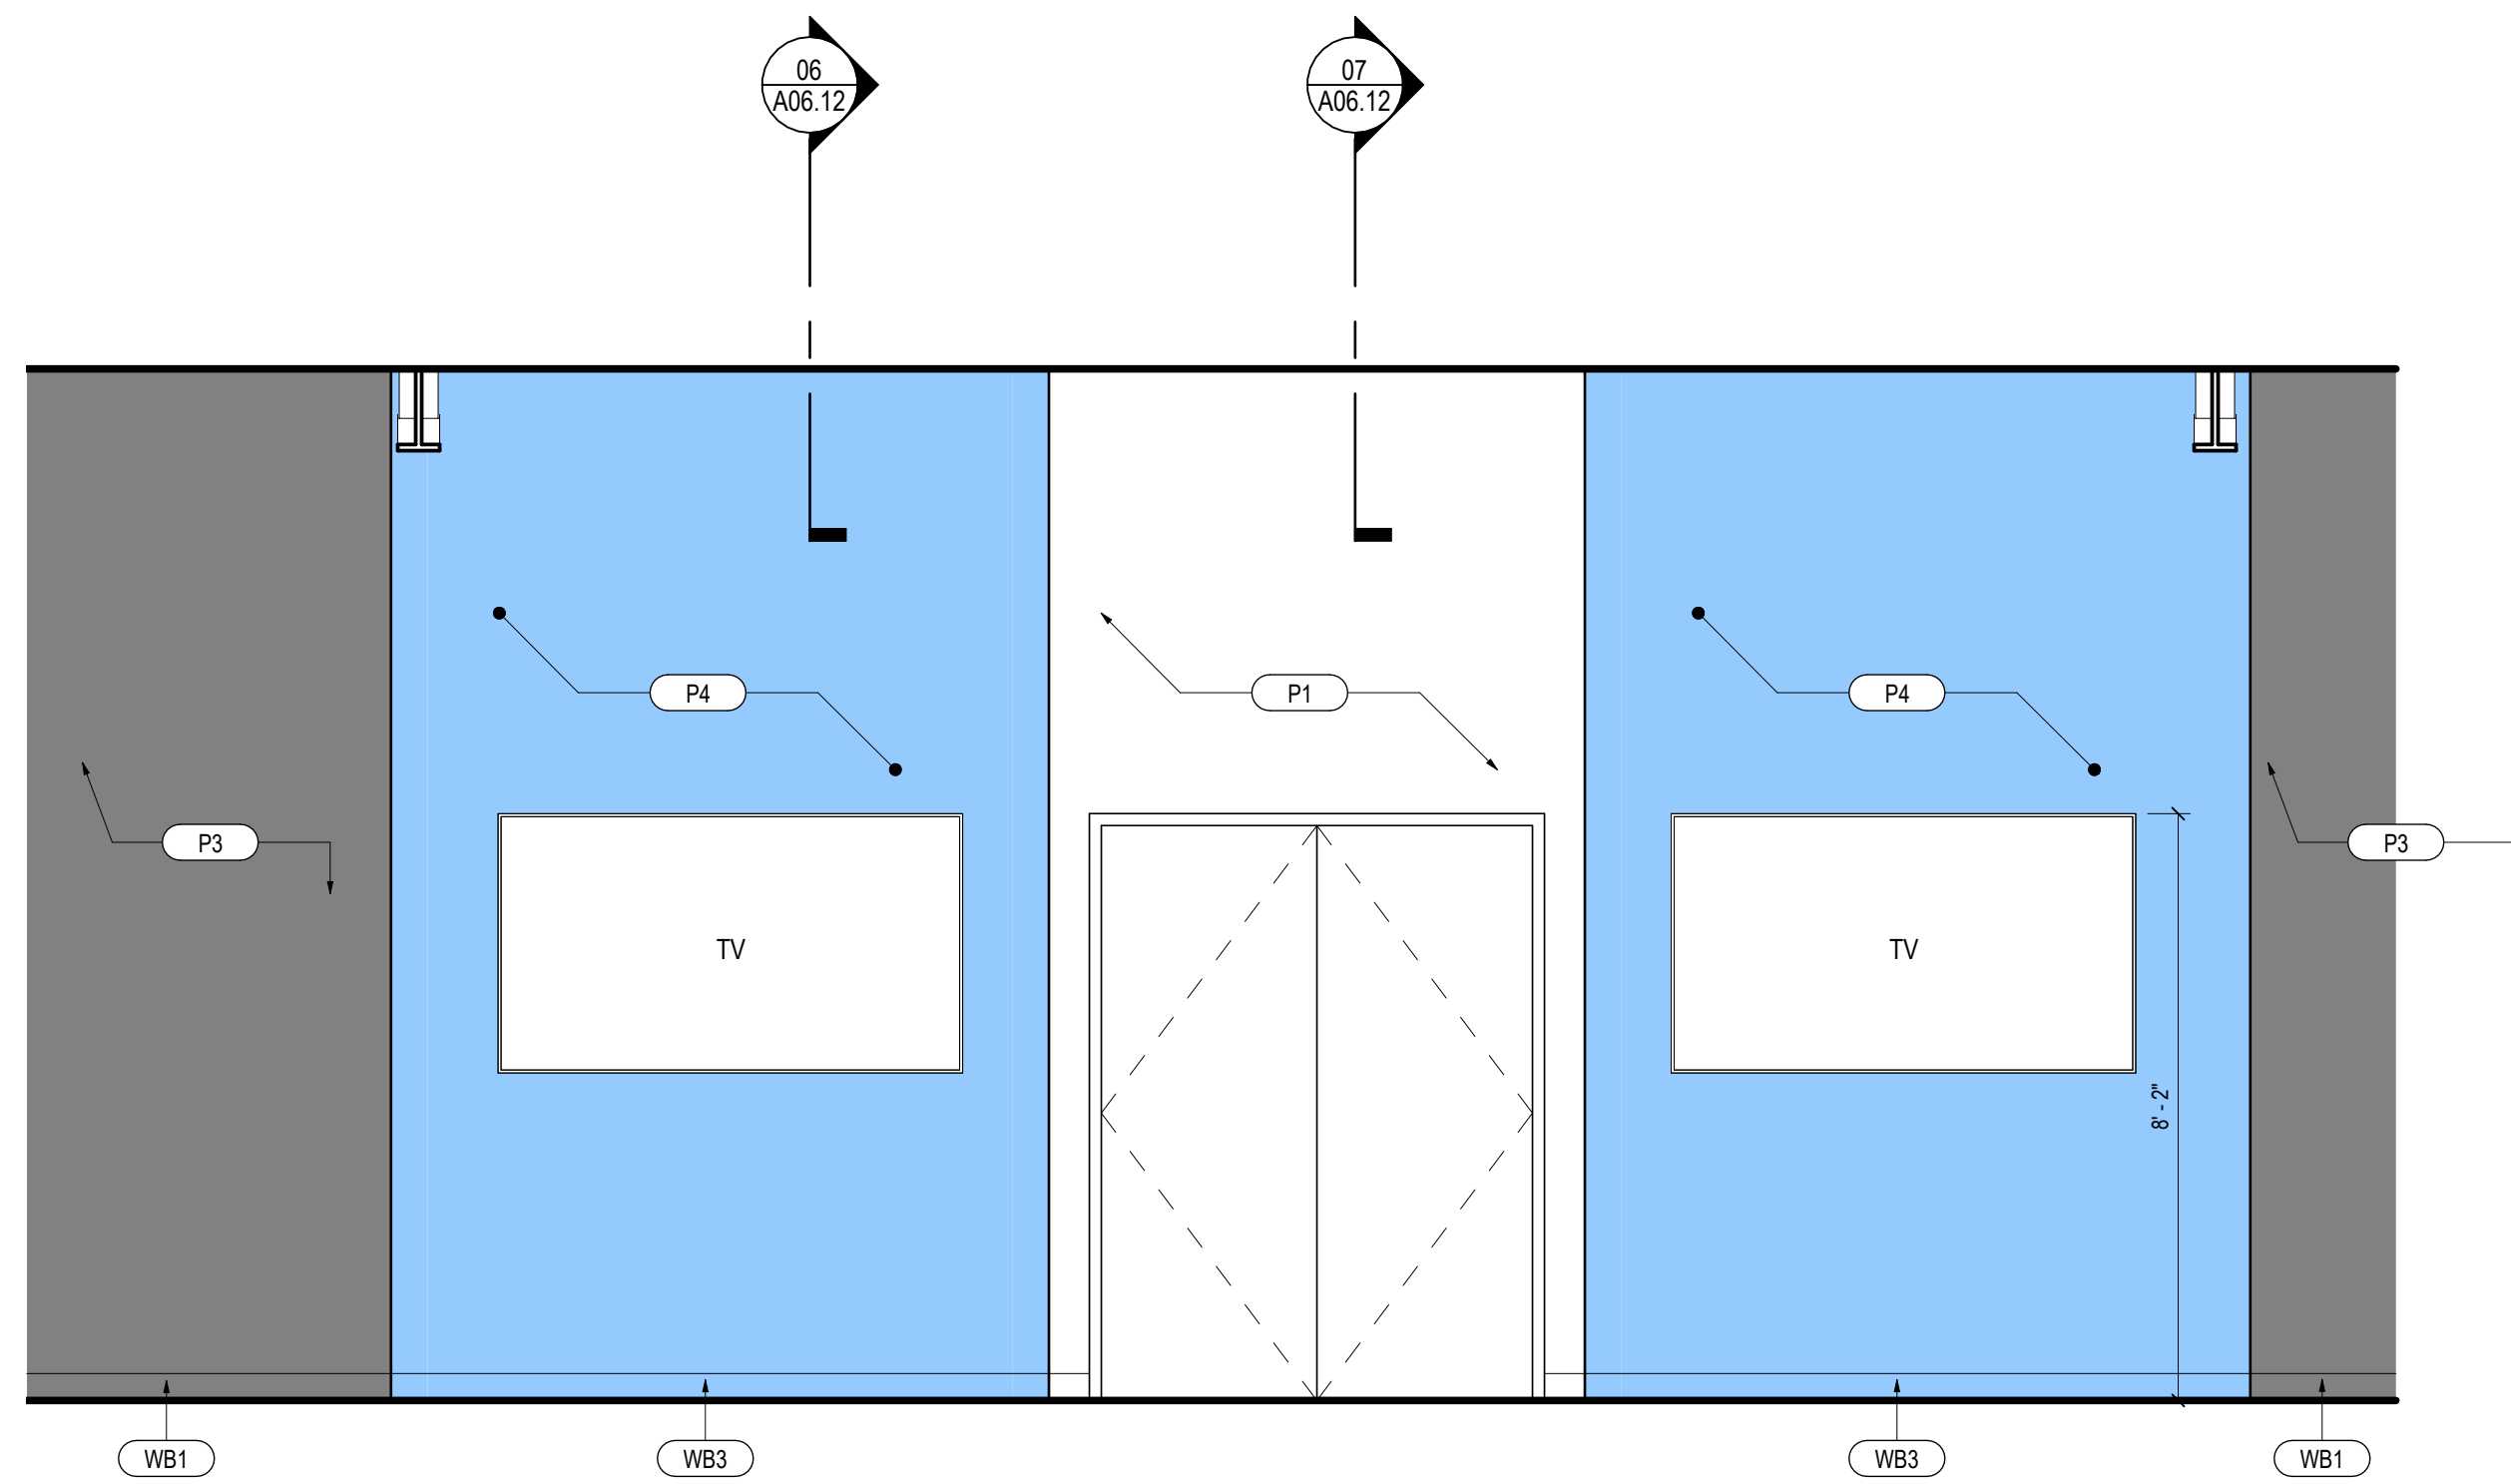

05 INTERIOR ELEVATION
SCALE: 3/8" = 1'-0"

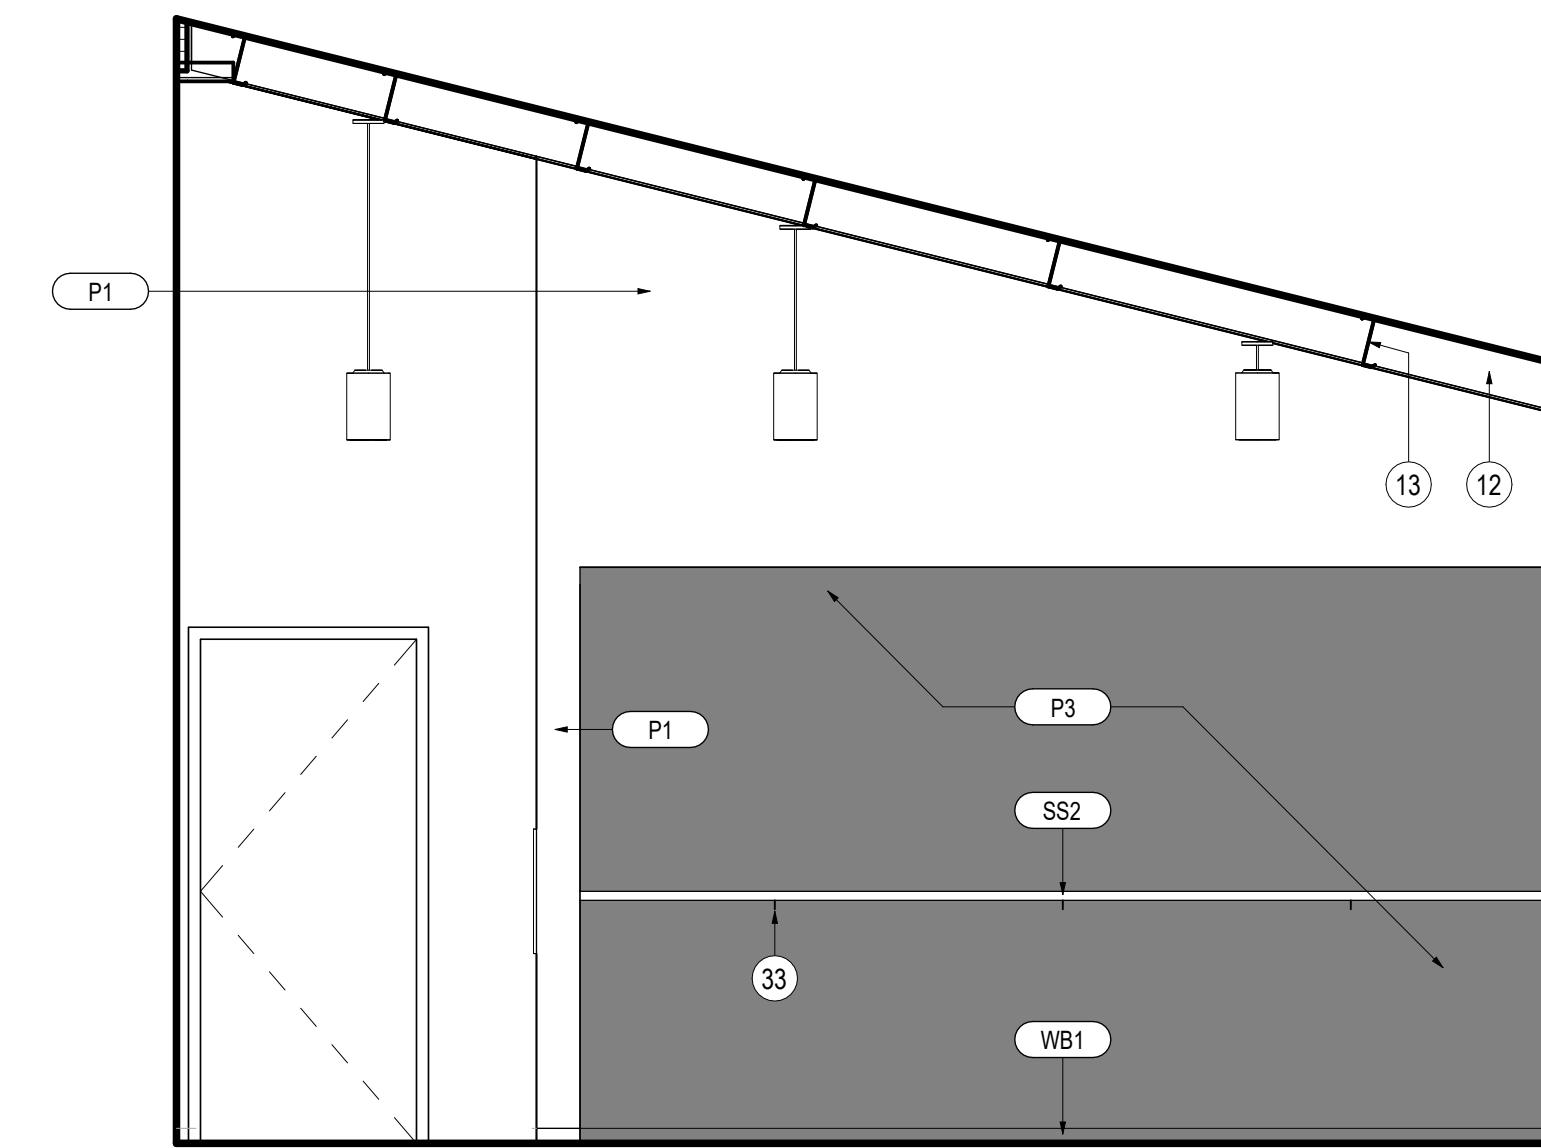


02 NARTHEX (RIGHT WALL)
SCALE: 3/8" = 1'-0"

SHEET NOTES

- 01 STRUCT. STL. - PAINT BLACK WHERE EXPOSED
- 02 GWB AND MDF STAGE APRON - PAINT BLACK
- 03 ELEVATED FLOOR w/ LVT FINISH ON 1/4" T. TEMPERED MASONITE, 1/2" HOMASOTE, AND 3/4" FRP PLYWOOD ON MTL. STUD FRAMING (SEE STRUCT.)
- 04 SLOPED GWB "CLOUD" AT UNDERSIDE OF STL. STRUCT.
- 07 MTL. PANEL CEILING SYSTEM MTL. BLDG. MANUF. LIGHTING TRUSS (SEE STRUCT.)
- 08 RAMP w/ LVT FINISH ON (2) LAYERS 3/4" FRP PLYWOOD ON MTL. STUD FRAMING (SEE STRUCT.)
- 10 STAIR w/ LVT FINISH ON (2) LAYERS 3/4" FRP PLYWOOD ON MTL. STUD FRAMING (SEE STRUCT.)
- 11 GWB CONTROL JOINT
- 12 EXPOSED ROOF INSULATION
- 13 MTL. Z PURLIN (TYP.)
- 14 SUSPENDED PROJECTION SCREEN
- 15 LED CYLINDER PENDANT LIGHT FIXTURE (TYP.) (SEE ELEC.)
- 16 LED WALL SCONCE LIGHT FIXTURE (TYP.) (SEE ELEC.)
- 17 RECTANGULAR BEAM LED LIGHT FIXTURE (TYP.) (SEE ELEC.)
- 18 RECESSED LED LIGHT FIXTURE (TYP.) (SEE ELEC.)
- 20 8"x16"x4" CMU (PROVIDE TIES PER MANUF. REQS.) ON MTL. STUD FURRING AT STL. COLUMN
- 21 E.F.S. - 1-1/2" R-5 RIGID INSUL. AND 5/8" SHEATHING ON 3-5/8" MTL. STUD FRAMING W/ R-13 BLANKET INSUL.
- 22 REVEAL (TYP.)
- 23 8"x16"x4" CMU (PROVIDE TIES PER MANUF. REQS.) W/ 1-1/2" AIR SPACE, 2" RIGID INSUL., AND 5/8" SHEATHING ON 3-5/8" MTL. STUD FRAMING
- 24 STANDING SEAM MTL. ROOF (OWNER FURNISHED)
- 25 CONT. R-11 VINYL-FACED BLANKET INSUL ON R-3 THERMAL SPACER BLOCKS (THERMAL SPACER BLOCKS TYP. AT EA. PURLIN)
- 26 R-19 FIBERGLASS BLANKET INSUL. BET. PURLINS (PROVIDE LONGITUDINAL AND TRANSVERSE MTL. SUPPORT BANDING)
- 27 CONT. BLACK FIBER-REINFORCED VAPOR BARRIER MEMBRANE AT BOTTOM OF PURLINS
- 28 GUTTER AND FLASHING BY MTL. BLDG. MANUF.
- 29 DOWNSPOUTS BY MTL. BLDG. MANUF. (TYP.)
- 31 3/8" T. x 24" D. CLEAR TEMPERED GLASS SHELVES (TYP.)
- 32 ADJUSTABLE SHELF BRACKETS & FLUSH-MOUNTED SHELF TRACKS (TYP.)
- 33 RAKES INSIDE WALL MOUNT EH COUNTER SUPPORT BRACKETS
- 34 OPEN TO UPPER ROOF ABOVE
- 35 MTL. C PURLIN BY MTL. BLDG. MANUF.
- 36 PRE-FIN. COUNTER FLASHING
- 37 TIE-IN TRIM BY MTL. BLDG. MANUF.
- 38 BACK-UP PLATE BY MTL. BLDG. MANUF.
- 39 OUTSIDE MTL. CLOSURE BY MTL. BLDG. MANUF.
- 41 STL. SPANDREL ANGLE AT BOTTOM OF MTL. Z PURLINS BY MTL. BLDG. MANUFACTURER
- 42 COMPRESSIBLE FILLER
- 43 NEW CONC. SIDEWALK
- 44 ALUM. DOOR AS SCHEDULED
- 45 DOOR THRESHOLD AS SCHEDULED - SET ON FULL BED OF MASTIC
- 46 TURNED-DOWN CONC. SLAB (SEE STRUCT.)
- 47 STRUCT. STL. COLUMN
- 48 STRUCT. STL. MOMENT FRAME - PAINT BLACK WHERE EXPOSED
- 49 SOUND ATTENUATION BLANKET (TYP.)
- 51 LINEAR SLOT RETURN (SEE MECH.)
- 52 MTL. SUPPORT BANDING - SPACE AS DIMENSIONED ON ENLARGED RCP (TYP.)
- 53 UNHINGED / RECESSED KNOXBOX (ALUM. FIN.)
- 54 FLUID-APPLIED AIR BARRIER MEMBRANE
- 55 JOINT SEALANT AND BACKER ROD
- 56 ALUM. STOREFRONT SYSTEM
- 57 E.F.S. - 1-1/2" R-5 RIGID INSUL. AND 5/8" SHEATHING ON 6" MTL. STUD FRAMING W/ R-13 BLANKET INSUL.
- 59 E.F.S. DRAINABLE TRACK
- 60 THRU-WALL STAINLESS STL. FLASHING W/ DRIP EDGE - FLASHED INTO AIR AND WATER BARRIER MEMBRANE
- 61 R-19 FIBERGLASS BLANKET INSUL. BET. MTL. STUD FRAMING (PROVIDE LONGITUDINAL AND TRANSVERSE MTL. SUPPORT BANDING)
- 62 STANDING SEAM MTL. ROOF (OWNER FURNISHED) ON 3/4" FRP PLYWOOD ON 6" MTL. STUD FRAMING
- 68 ROLLERSHADE AT EA. EXT. WINDOW (TYP.)
- 69 EAVE TRIM, PANEL CAP TRIM, AND FLASHING BY MTL. BLDG. MANUF.
- 70 MTL. STUD BRACE (SEE STRUCT.)



4539 HEDGEMORE DRIVE, SUITE 101
CHARLOTTE NC 28209
704.890.2653
WWW.OSSASTUDIO.COM

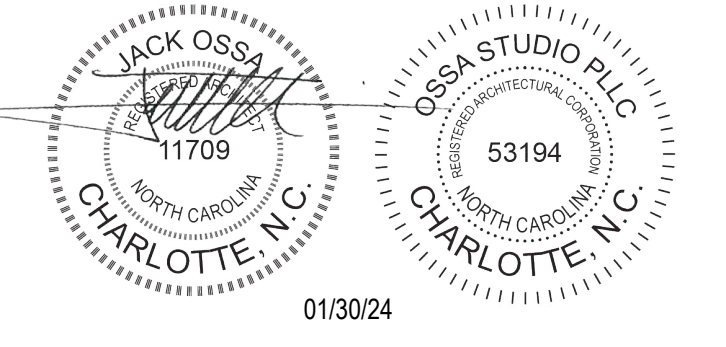

PROJECT TEAM

General Contractor
ECCLESIA CONSTRUCTION
www.ecclesiainc.com
803.327.5670

Civil Engineering
HILLIARD ENGINEERING, PLLC
www.hilliardep.com
919.352.2834

Structural Engineering
PROVIDENCE PARTNERS
www.providencpartnersinc.com
704.266.6621

Mechanical, Electrical, Plumbing & Fire Protection
ENGINEERING
www.engineering.com
704.287.2193

Date	Description
10/30/24	FOR CONSTRUCTION

Project Name

3D
community church
making church come alive
658 GRAHAM ROAD
SANFORD NC 27311

Client

3D COMMUNITY CHURCH

Project Number
23024.00

Description
INTERIOR ELEVATIONS

Scale
3/8" = 1'-0"


A04.22

SHEET NOTES

- 01 STRUCT. STL. - PAINT BLACK WHERE EXPOSED
- 02 GWB AND MDF STAGE APRON - PAINT BLACK
- 03 ELEVATED FLOOR w/ LVT FINISH ON 1/4" T. TEMPERED MASONITE, 1/2" HOMASOTE, AND 3/4" FRP PLYWOOD ON MTL. STUD FRAMING (SEE STRUCT.)
- 04 SLOPED GWB "CLOUD" AT UNDERSIDE OF STL. STRUCT.
- 07 MTL. PANEL CEILING SYSTEM MTL. BLDG. MANUF. LIGHTING TRUSS (SEE STRUCT.)
- 08 RAMP w/ LVT FINISH ON (2) LAYERS 3/4" FRP PLYWOOD ON MTL. STUD FRAMING (SEE STRUCT.)
- 09 STAIR w/ LVT FINISH ON (2) LAYERS 3/4" FRP PLYWOOD ON MTL. STUD FRAMING (SEE STRUCT.)
- 11 GWB CONTROL JOINT
- 12 EXPOSED ROOF INSULATION
- 13 MTL. Z PURLIN (TYP.)
- 14 SUSPENDED PROJECTION SCREEN
- 15 LED CYLINDER PENDANT LIGHT FIXTURE (TYP.) (SEE ELEC.)
- 16 LED WALL SCONCE LIGHT FIXTURE (TYP.) (SEE ELEC.)
- 17 RECTANGULAR BEAM LED LIGHT FIXTURE (TYP.) (SEE ELEC.)
- 18 RECESSED LED LIGHT FIXTURE (TYP.) (SEE ELEC.)
- 20 8"x16"x4" CMU (PROVIDE TIES PER MANUF. REQS.) ON MTL. STUD FURRING AT STL. COLUMN
- 21 E.I.F.S. - 1-1/2" R-7.5 RIGID INSUL. AND 5/8" SHEATHING ON 3-5/8" MTL. STUD FRAMING W/ R-13 BLANKET INSUL.
- 22 REVEAL (TYP.)
- 23 8"x16"x4" CMU (PROVIDE TIES PER MANUF. REQS.) W/ 1-1/2" AIR SPACE, 2" RIGID INSUL., AND 5/8" SHEATHING ON 3-5/8" MTL. STUD FRAMING
- 24 STANDING SEAM MTL. ROOF (OWNER FURNISHED)
- 25 CONT. R-11 VINYL-FACED BLANKET INSUL. ON R-3 THERMAL SPACER BLOCKS (THERMAL SPACER BLOCKS TYP. AT EA. PURLIN)
- 26 R-19 FIBERGLASS BLANKET INSUL. BET. PURLINS (PROVIDE LONGITUDINAL AND TRANSVERSE MTL. SUPPORT BANDING)
- 27 CONT. BLACK FIBER-REINFORCED VAPOR BARRIER MEMBRANE AT BOTTOM OF PURLINS
- 28 GUTTER AND FLASHING BY MTL. BLDG. MANUF.
- 29 DOWNSPOUTS BY MTL. BLDG. MANUF. (TYP.)
- 31 3/8" T. x 24" D. CLEAR TEMPERED GLASS SHELVES (TYP.)
- 32 ADJUSTABLE SHELF BRACKETS & FLUSH-MOUNTED SHELF TRACKS (TYP.)
- 33 RAKES INSIDE WALL MOUNT EH COUNTER SUPPORT BRACKETS
- 34 OPEN TO UPPER ROOF ABOVE
- 35 MTL. C PURLIN BY MTL. BLDG. MANUF.
- 36 PRE-FIN. COUNTER FLASHING
- 37 TIE-IN TRIM BY MTL. BLDG. MANUF.
- 38 BACK-UP PLATE BY MTL. BLDG. MANUF.
- 39 OUTSIDE MTL. CLOSURE BY MTL. BLDG. MANUF.
- 41 STL. SPANDREL ANGLE AT BOTTOM OF MTL. Z PURLINS BY MTL. BLDG. MANUFACTURER
- 42 COMPRESSIBLE FILLER
- 43 NEW CONC. SIDEWALK
- 44 ALUM. DOOR AS SCHEDULED
- 45 DOOR THRESHOLD AS SCHEDULED - SET ON FULL BED OF MASTIC
- 46 TURNED-DOWN CONC. SLAB (SEE STRUCT.)
- 47 STRUCT. STL. COLUMN
- 48 STRUCT. STL. MOMENT FRAME - PAINT BLACK WHERE EXPOSED
- 49 SOUND ATTENUATION BLANKET (TYP.)
- 51 LINEAR SLOT RETURN (SEE MECH.)
- 52 MTL. SUPPORT BANDING - SPACE AS DIMENSIONED ON ENLARGED RCP (TYP.)
- 53 UNHINGED / RECESSED KNOXBOX (ALUM. FIN.)
- 54 FLUID-APPLIED AIR BARRIER MEMBRANE
- 55 JOINT SEALANT AND BACKER ROD
- 56 ALUM. STOREFRONT SYSTEM
- 57 E.I.F.S. - 1-1/2" R-7.5 RIGID INSUL. AND 5/8" SHEATHING ON 6" MTL. STUD FRAMING W/ R-13 BLANKET INSUL.
- 59 E.I.F.S. DRAINABLE TRACK
- 60 THRU-WALL STAINLESS STL. FLASHING W/ DRIP EDGE - FLASHED INTO AIR AND WATER BARRIER MEMBRANE
- 61 R-19 FIBERGLASS BLANKET INSUL. BET. MTL. STUD FRAMING (PROVIDE LONGITUDINAL AND TRANSVERSE MTL. SUPPORT BANDING)
- 62 STANDING SEAM MTL. ROOF (OWNER FURNISHED) ON 3/4" FRP PLYWOOD ON 6" MTL. STUD FRAMING
- 68 ROLLERSHADE AT EA. EXT. WINDOW (TYP.)
- 69 EAVE TRIM, PANEL, CAP TRIM, AND FLASHING BY MTL. BLDG. MANUF.
- 70 MTL. STUD BRACE (SEE STRUCT.)




4539 HEDGEMORE DRIVE, SUITE 101
CHARLOTTE NC 28209
704.890.2653
WWW.OSSASTUDIO.COM

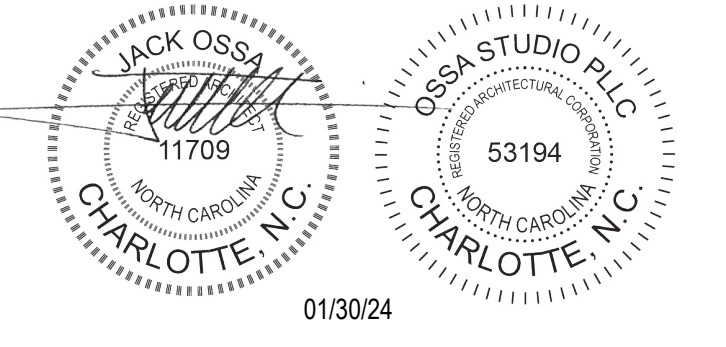

PROJECT TEAM


- General Contractor**
ECCLESIA CONSTRUCTION
www.ecclesiainc.com
803.327.5670
- Civil Engineering**
HILLIARD ENGINEERING, PLLC
www.iseacorp.com
919.352.2834
- Structural Engineering**
PROVIDENCE PARTNERS
www.providencepartnersinc.com
704.266.6621
- Mechanical, Electrical, Plumbing & Fire Protection**
ENGINEERING
www.engineering.com
704.287.2193

Date	Description
01/30/24	FOR CONSTRUCTION

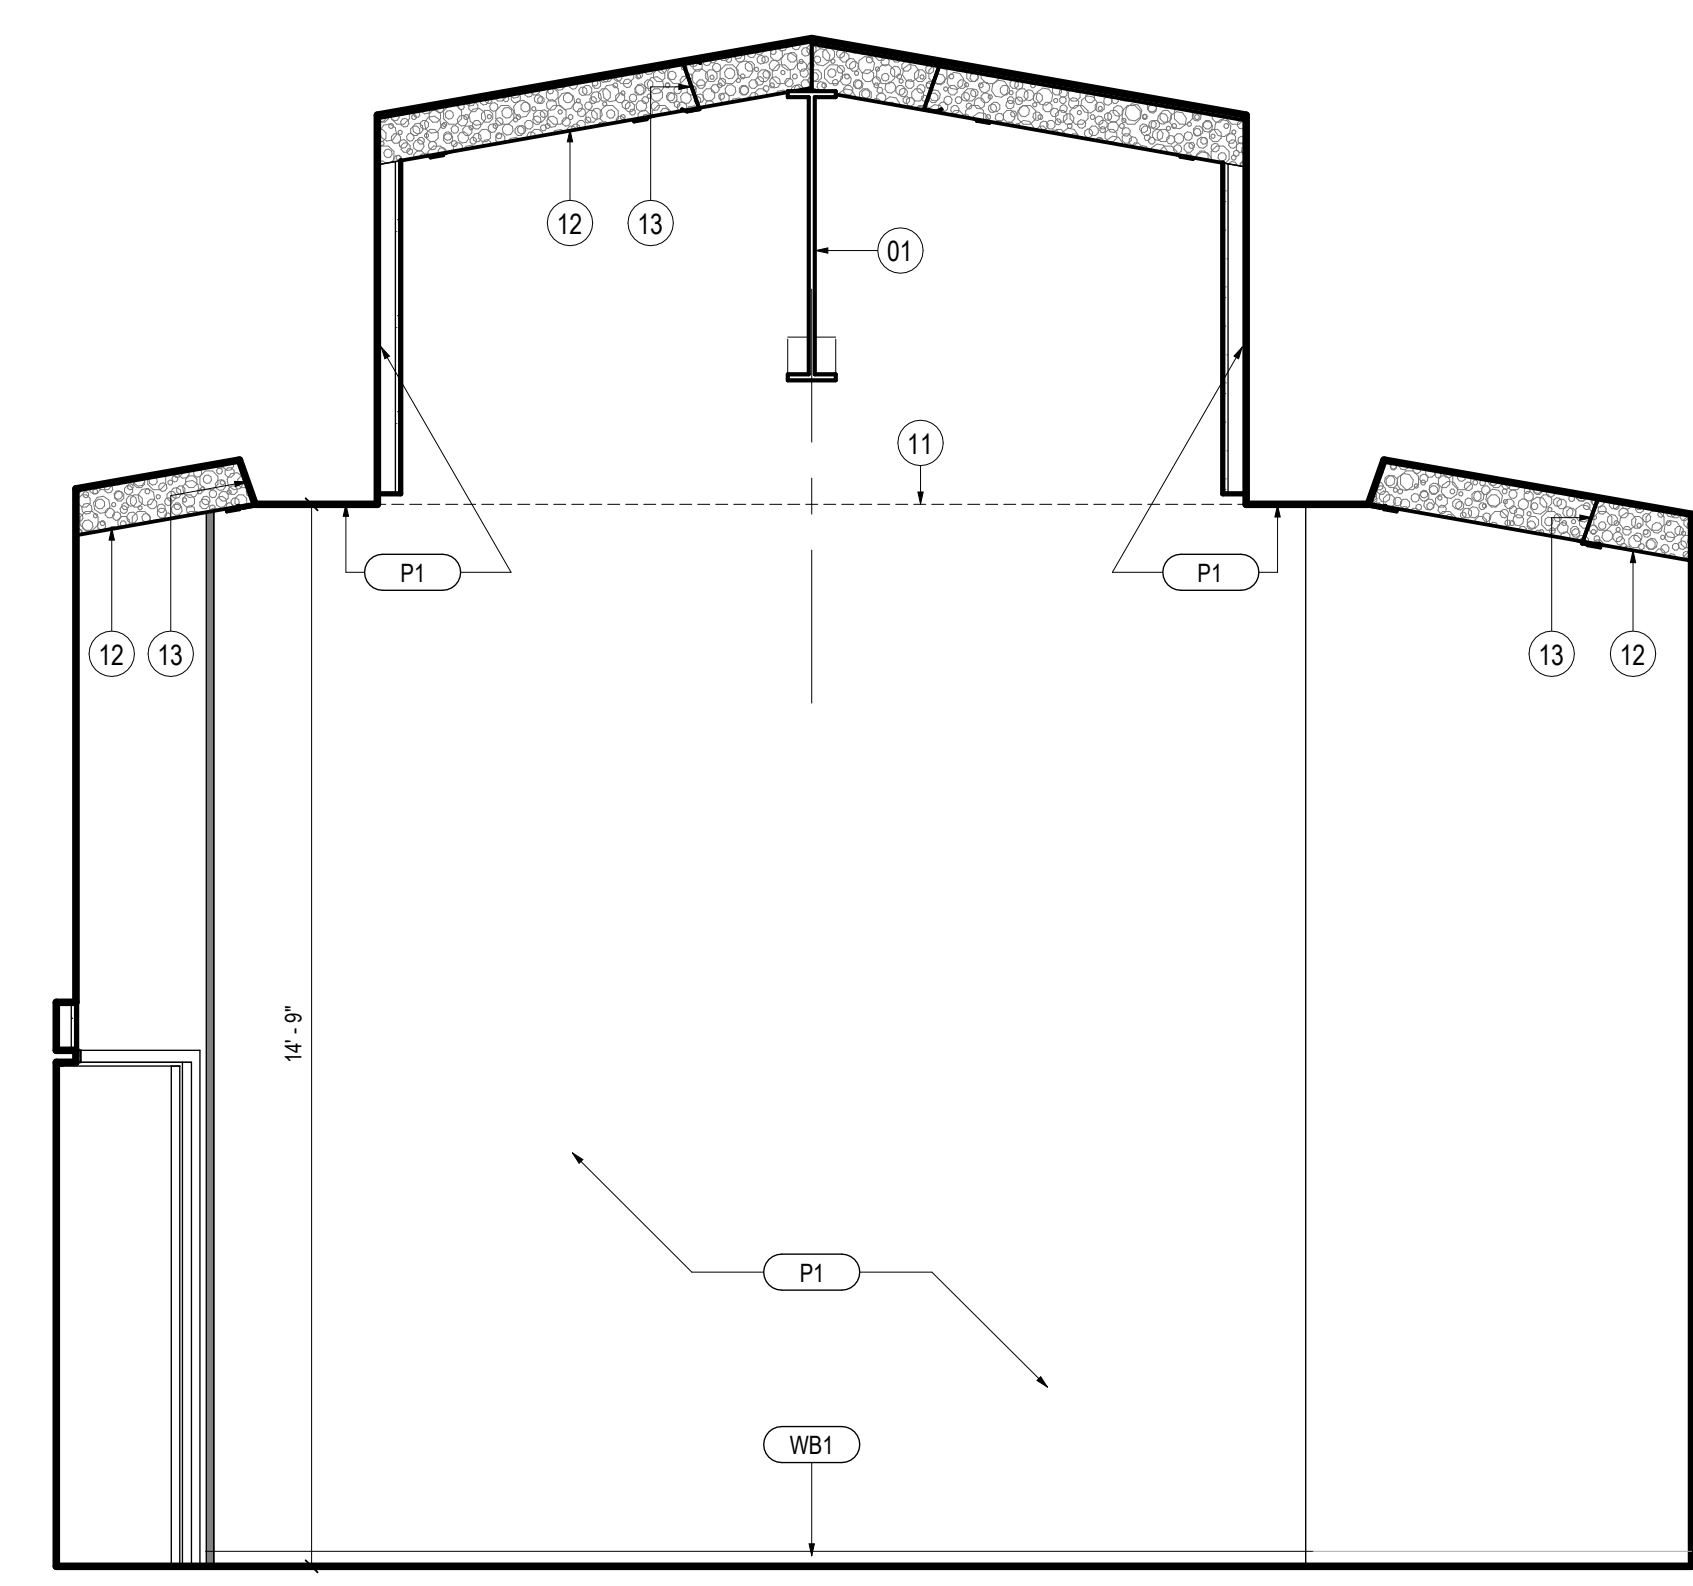


01 CHAMFERED CORNERS AT AT CORRIDORS 120 & 130

SCALE: 3/8" = 1'-0"

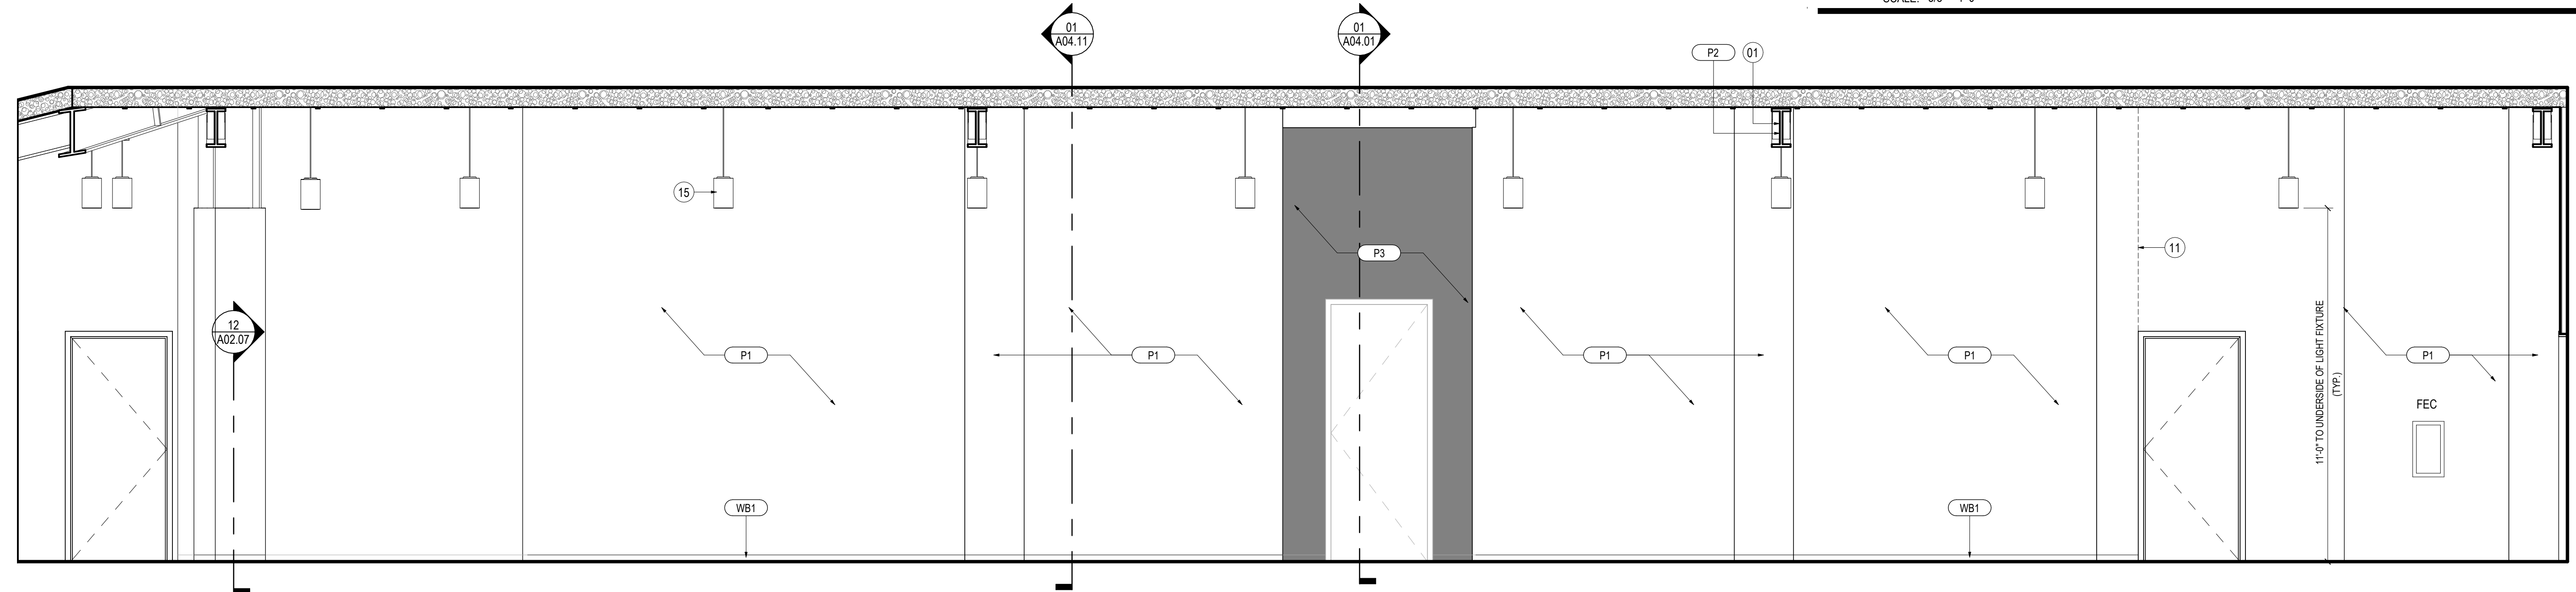

02 CLASSROOM CORRIDOR (LOOKING WEST)

SCALE: 3/8" = 1'-0"

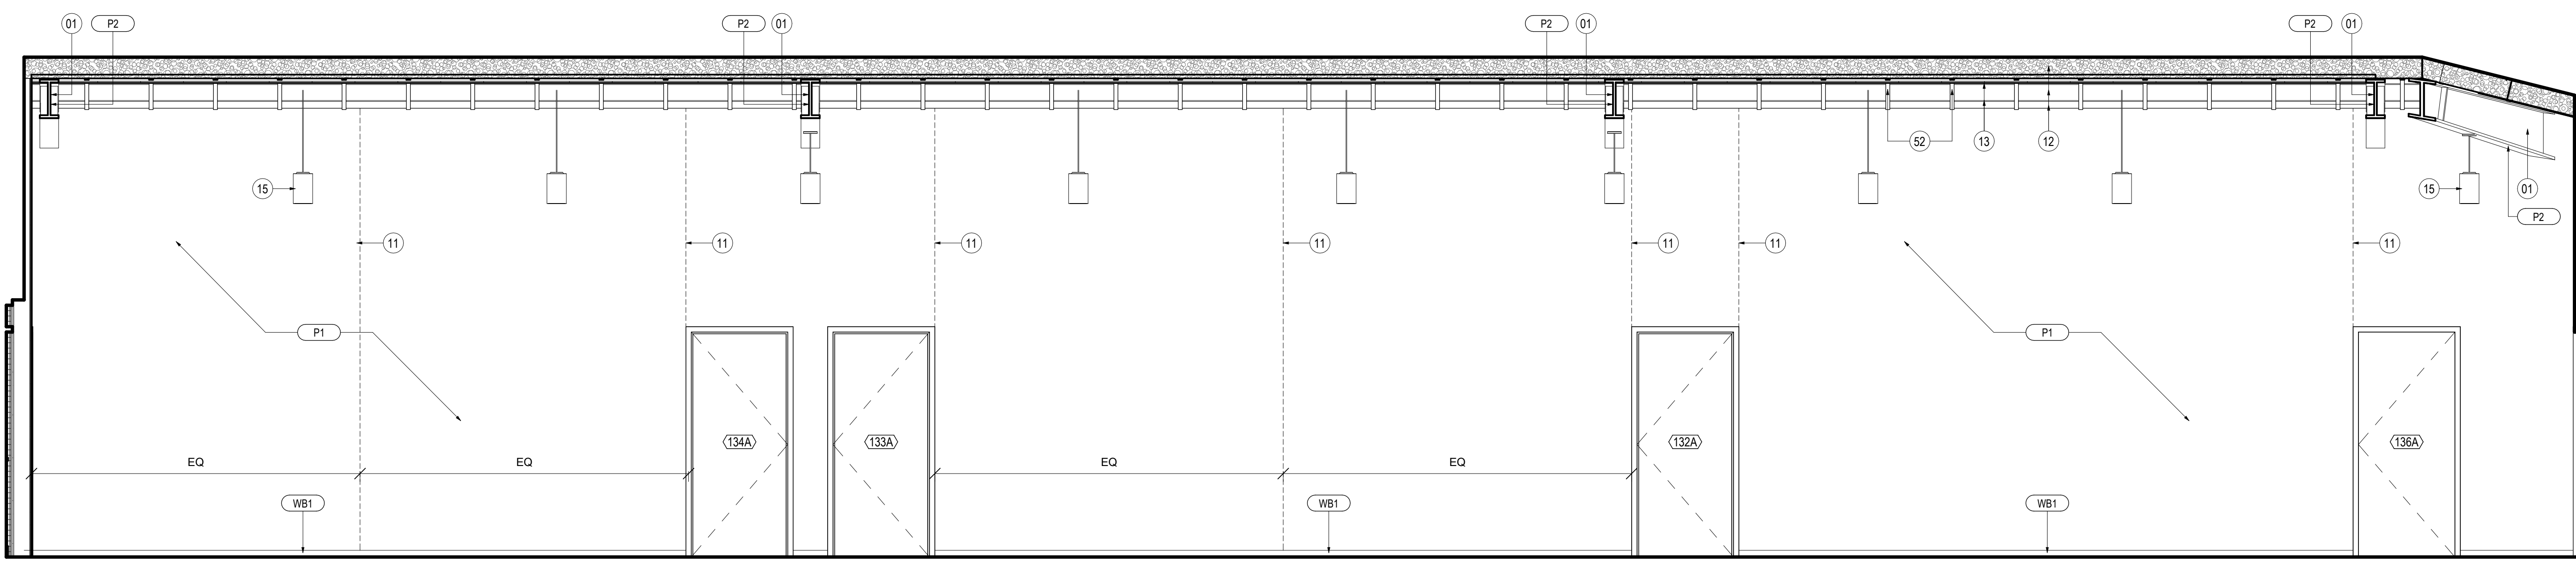

03 CLASSROOM CORRIDOR (LOOKING EAST)

SCALE: 3/8" = 1'-0"

Project Name

3D
community church
making church come alive
658 GRAHAM ROAD
SANFORD NC 27311

Client

3D COMMUNITY CHURCH

Project Number

23024.00

Description


INTERIOR ELEVATIONS

Scale

3/8" = 1'-0"

A04.23

10/14/2024 5:07:16 PM C:\Private\Drawings\Bentley\Local\23024.00_3D Community Church_interior.mcd\A04.23.rvt

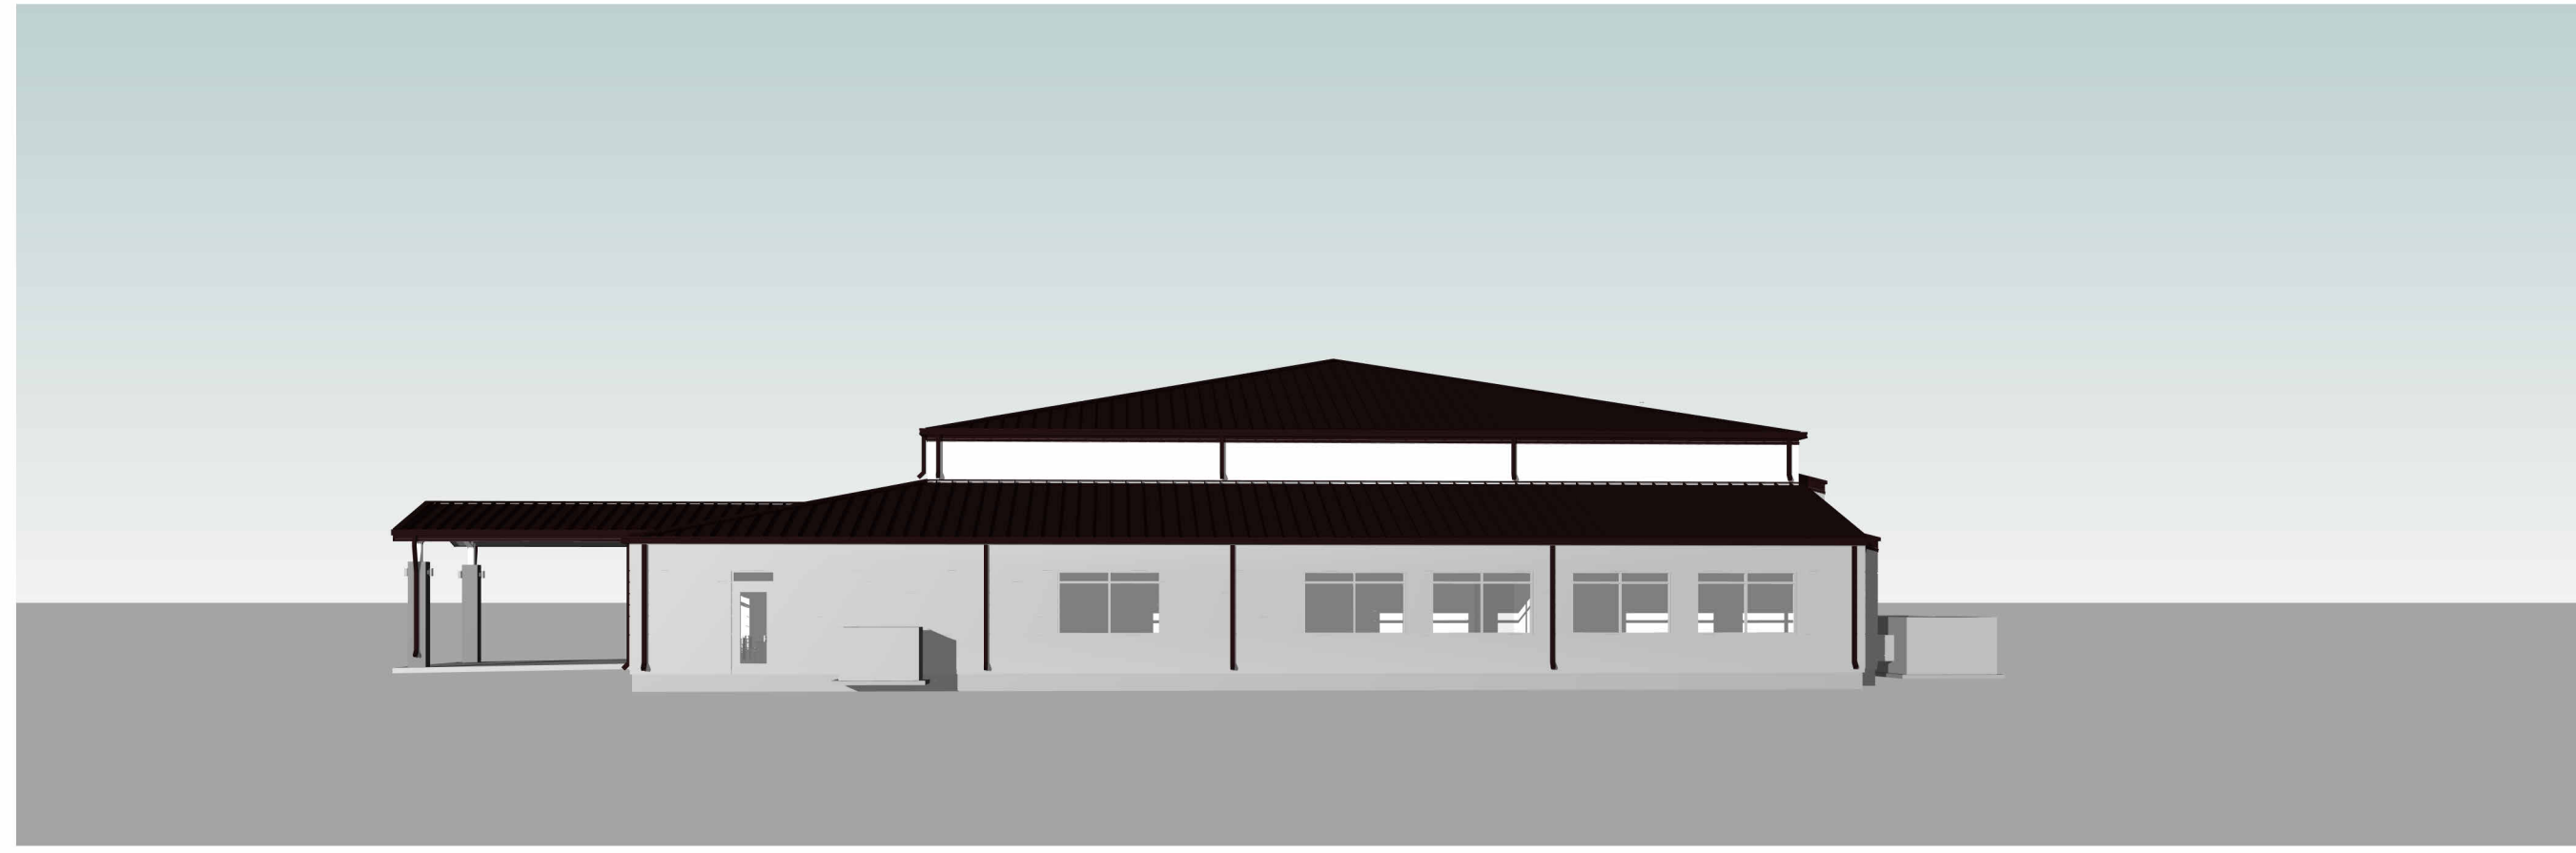

05 RIGHT SIDE PERSPECTIVE - 1
SCALE:




01 FRONT PERSPECTIVE - 1
SCALE:



06 FRONT PERSPECTIVE - 4
SCALE:



07 FRONT PERSPECTIVE - 5
SCALE:

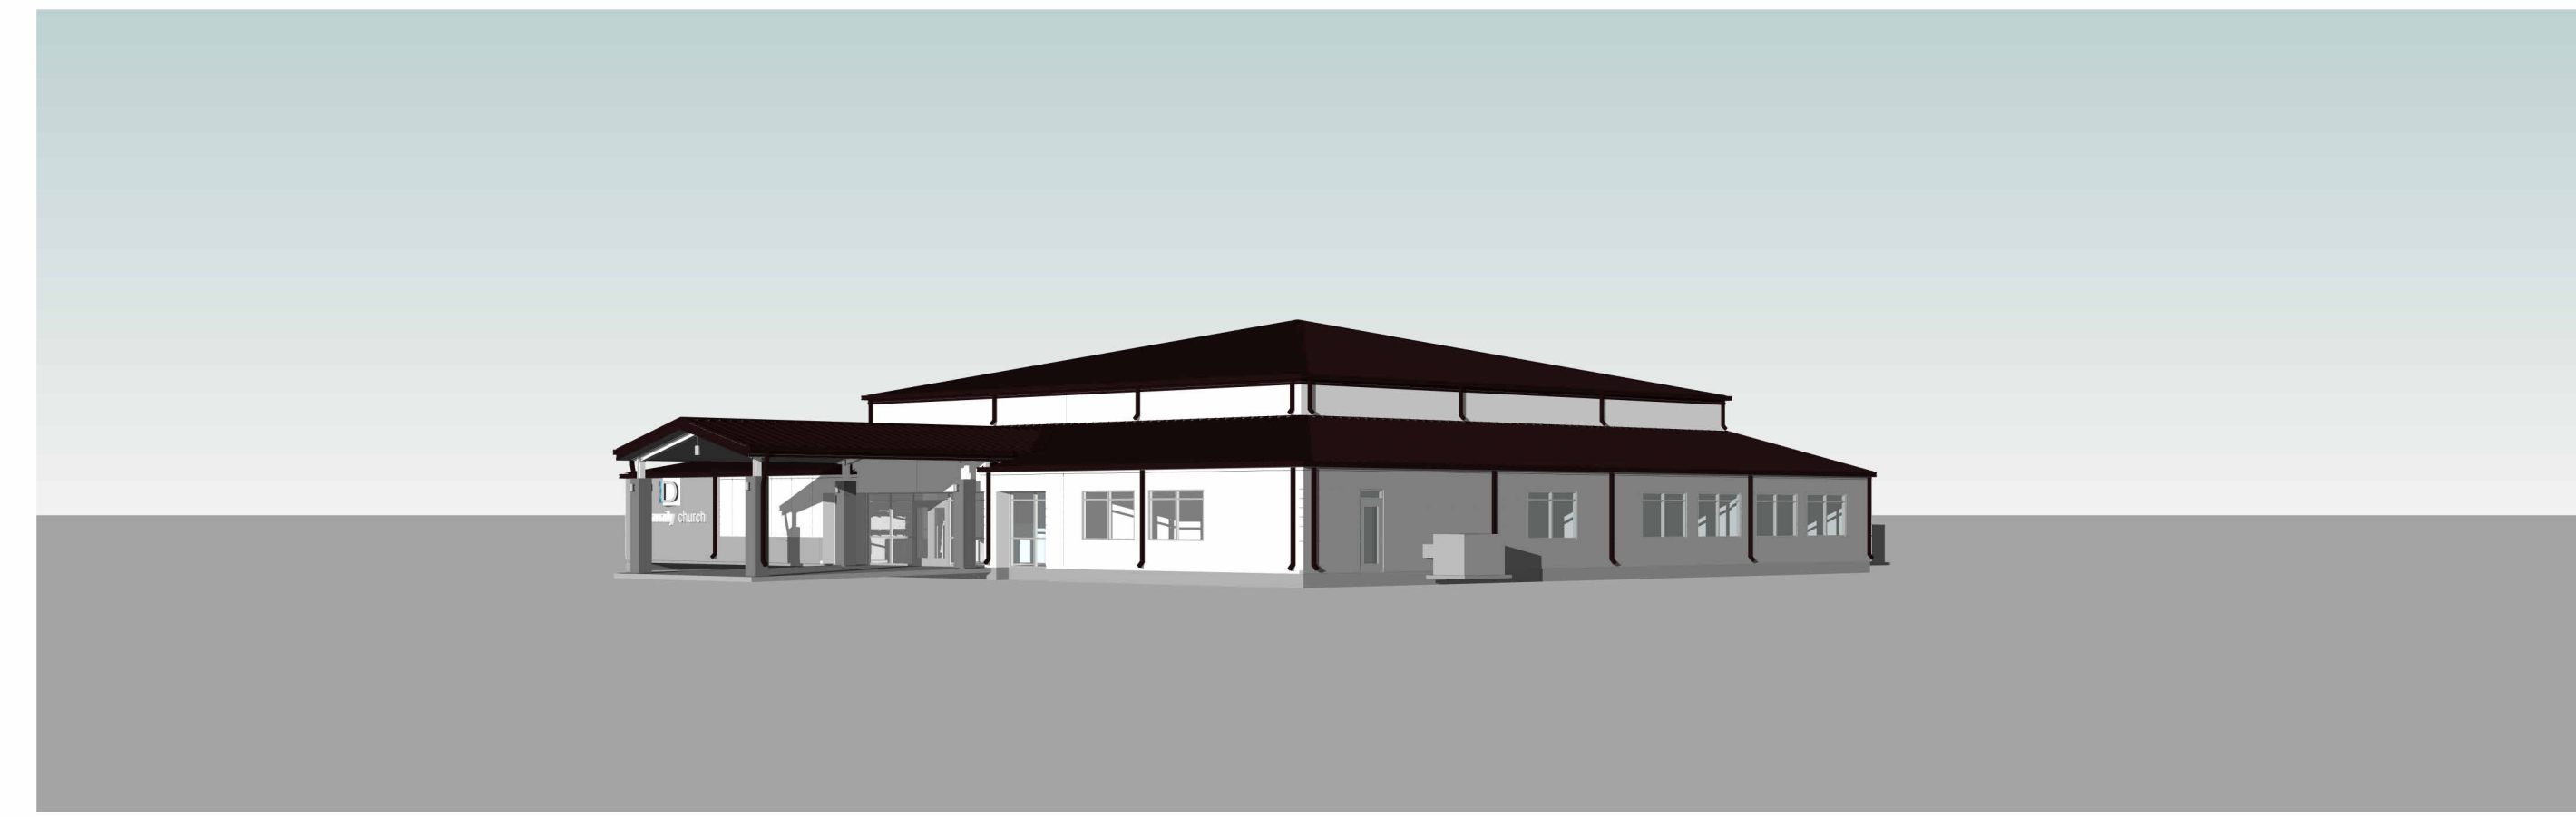

02 FRONT PERSPECTIVE - 2
SCALE:



03 FRONT PERSPECTIVE - 3
SCALE:




04 LEFT SIDE PERSPECTIVE - 1
SCALE:



Ossa
STUDIO

4539 HEDGEMORE DRIVE, SUITE 101
CHARLOTTE NC 28209
704.890.2553
WWW.OSSASTUDIO.COM

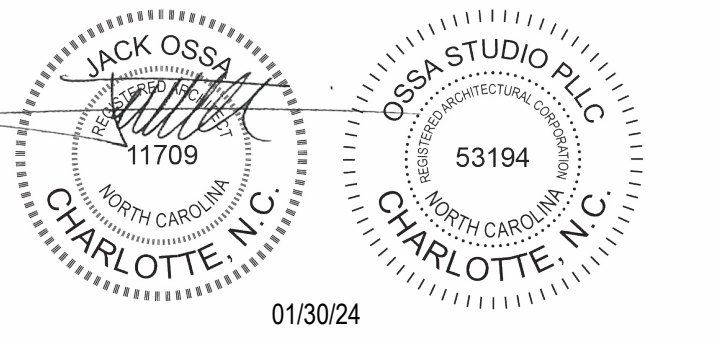

PROJECT TEAM

General Contractor
ECCLESIA CONSTRUCTION
www.ecclesiainc.com
803.327.5670


Civil Engineering
HILLIARD ENGINEERING, PLLC
www.hilliarde.com
919.352.2834

Structural Engineering
PROVIDENCE PARTNERS
www.providencepartnersinc.com
704.266.6621

Mechanical, Electrical, Plumbing & Fire Protection
ENGINEERING
www.engineering.com
704.287.2193

Date	Description
01/30/24	FOR CONSTRUCTION

Project Name

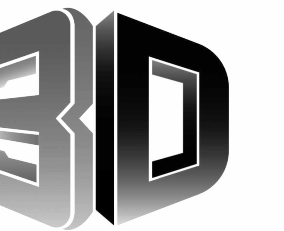

community church
making church come alive
658 GRAHAM ROAD
SANFORD NC 27311

Client

3D COMMUNITY CHURCH

Project Number

23024.00

Description

EXTERIOR VIEWS


Scale

A05.01



Ossa
STUDIO

4539 HEDGEMORE DRIVE, SUITE 101
CHARLOTTE NC 28209
704.890.2553
WWW.OSSASTUDIO.COM

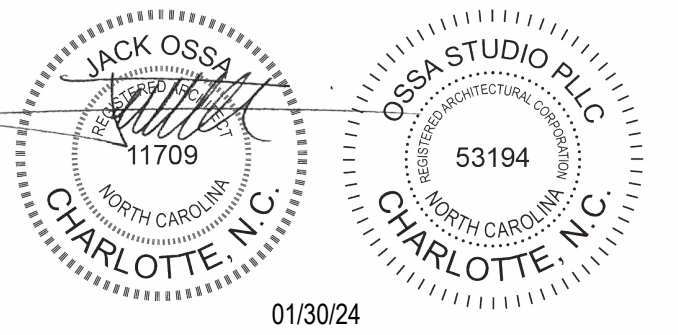

01/30/24

PROJECT TEAM

General Contractor
ECCLESIA CONSTRUCTION
www.ecclesiainc.com
803.327.5670


Civil Engineering
HILLIARD ENGINEERING, PLLC
www.hilliarde.com
919.352.2834

Structural Engineering
PROVIDENCE PARTNERS
www.providencpartnersinc.com
704.266.6621

Mechanical, Electrical, Plumbing & Fire Protection
ENGINEERING
www.engineering.com
704.287.2193

Date	Description
01/30/24	FOR CONSTRUCTION

Project Name

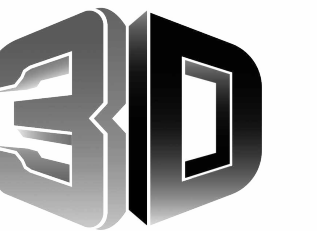

community church
making church come alive

658 GRAHAM ROAD
SANFORD NC 27311

Client

3D COMMUNITY CHURCH

Project Number

23024.00



Description

INTERIOR VIEWS

Scale


A05.03

© 2024 Ossa Studio

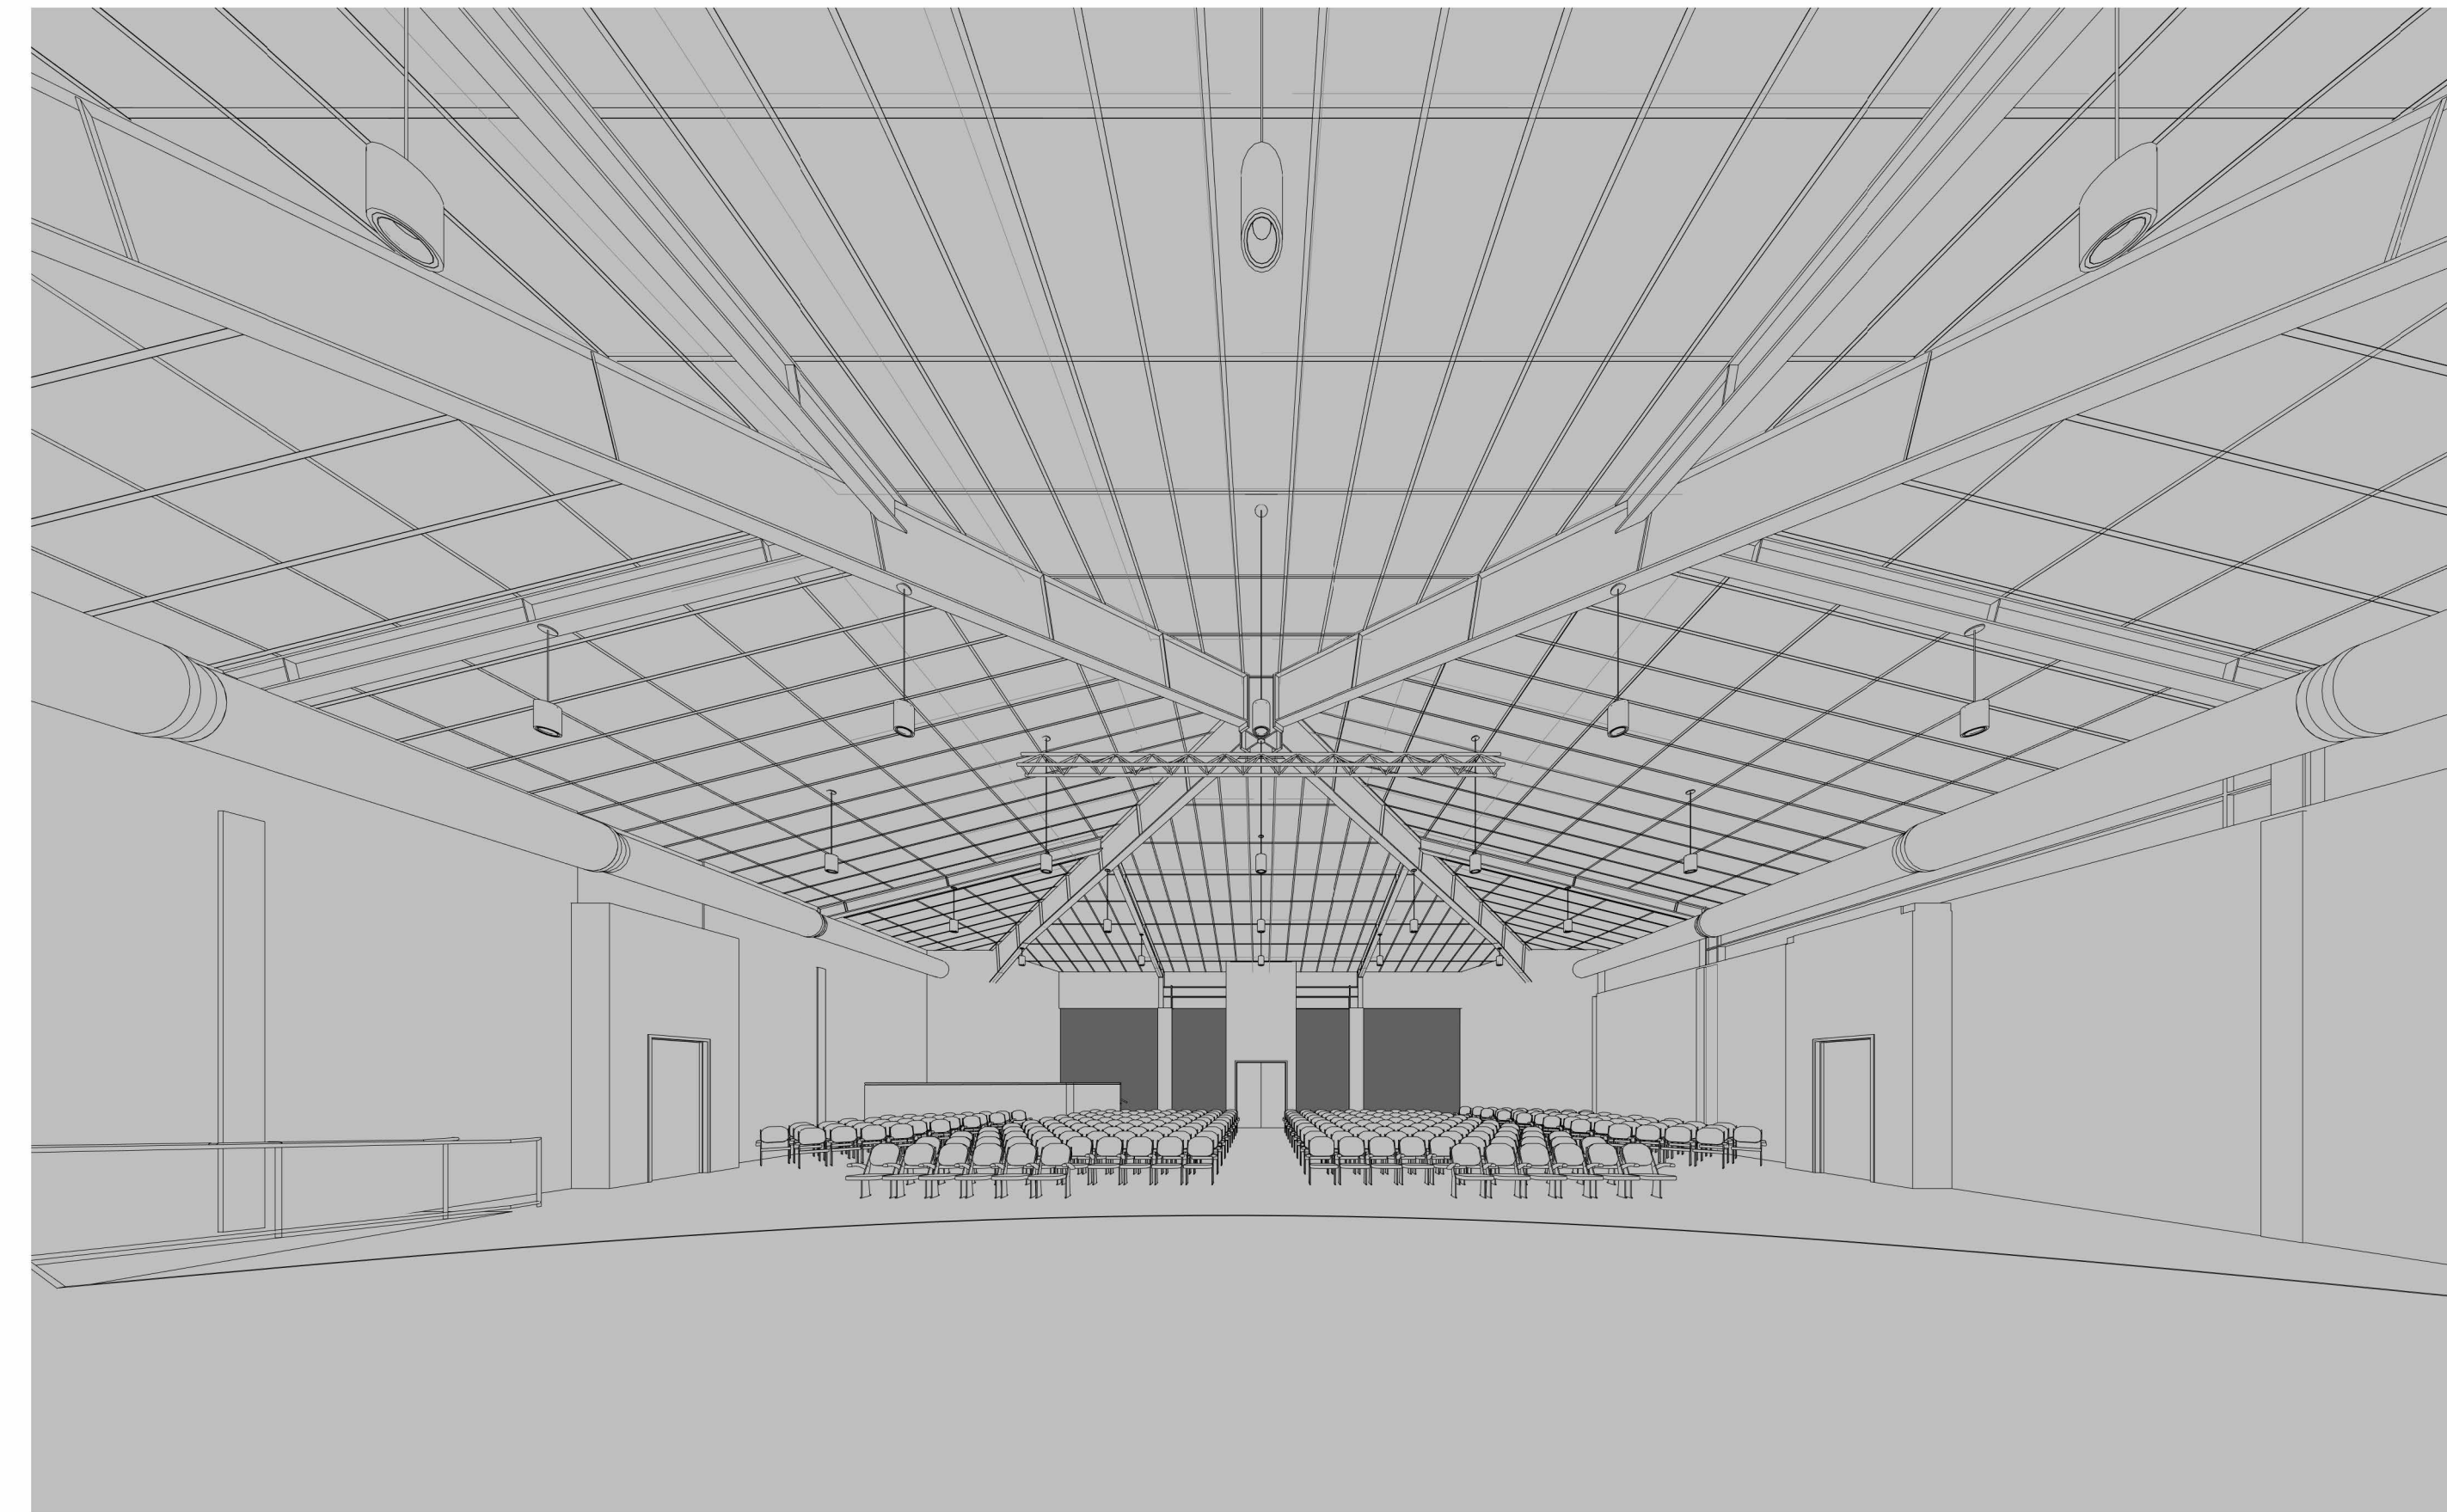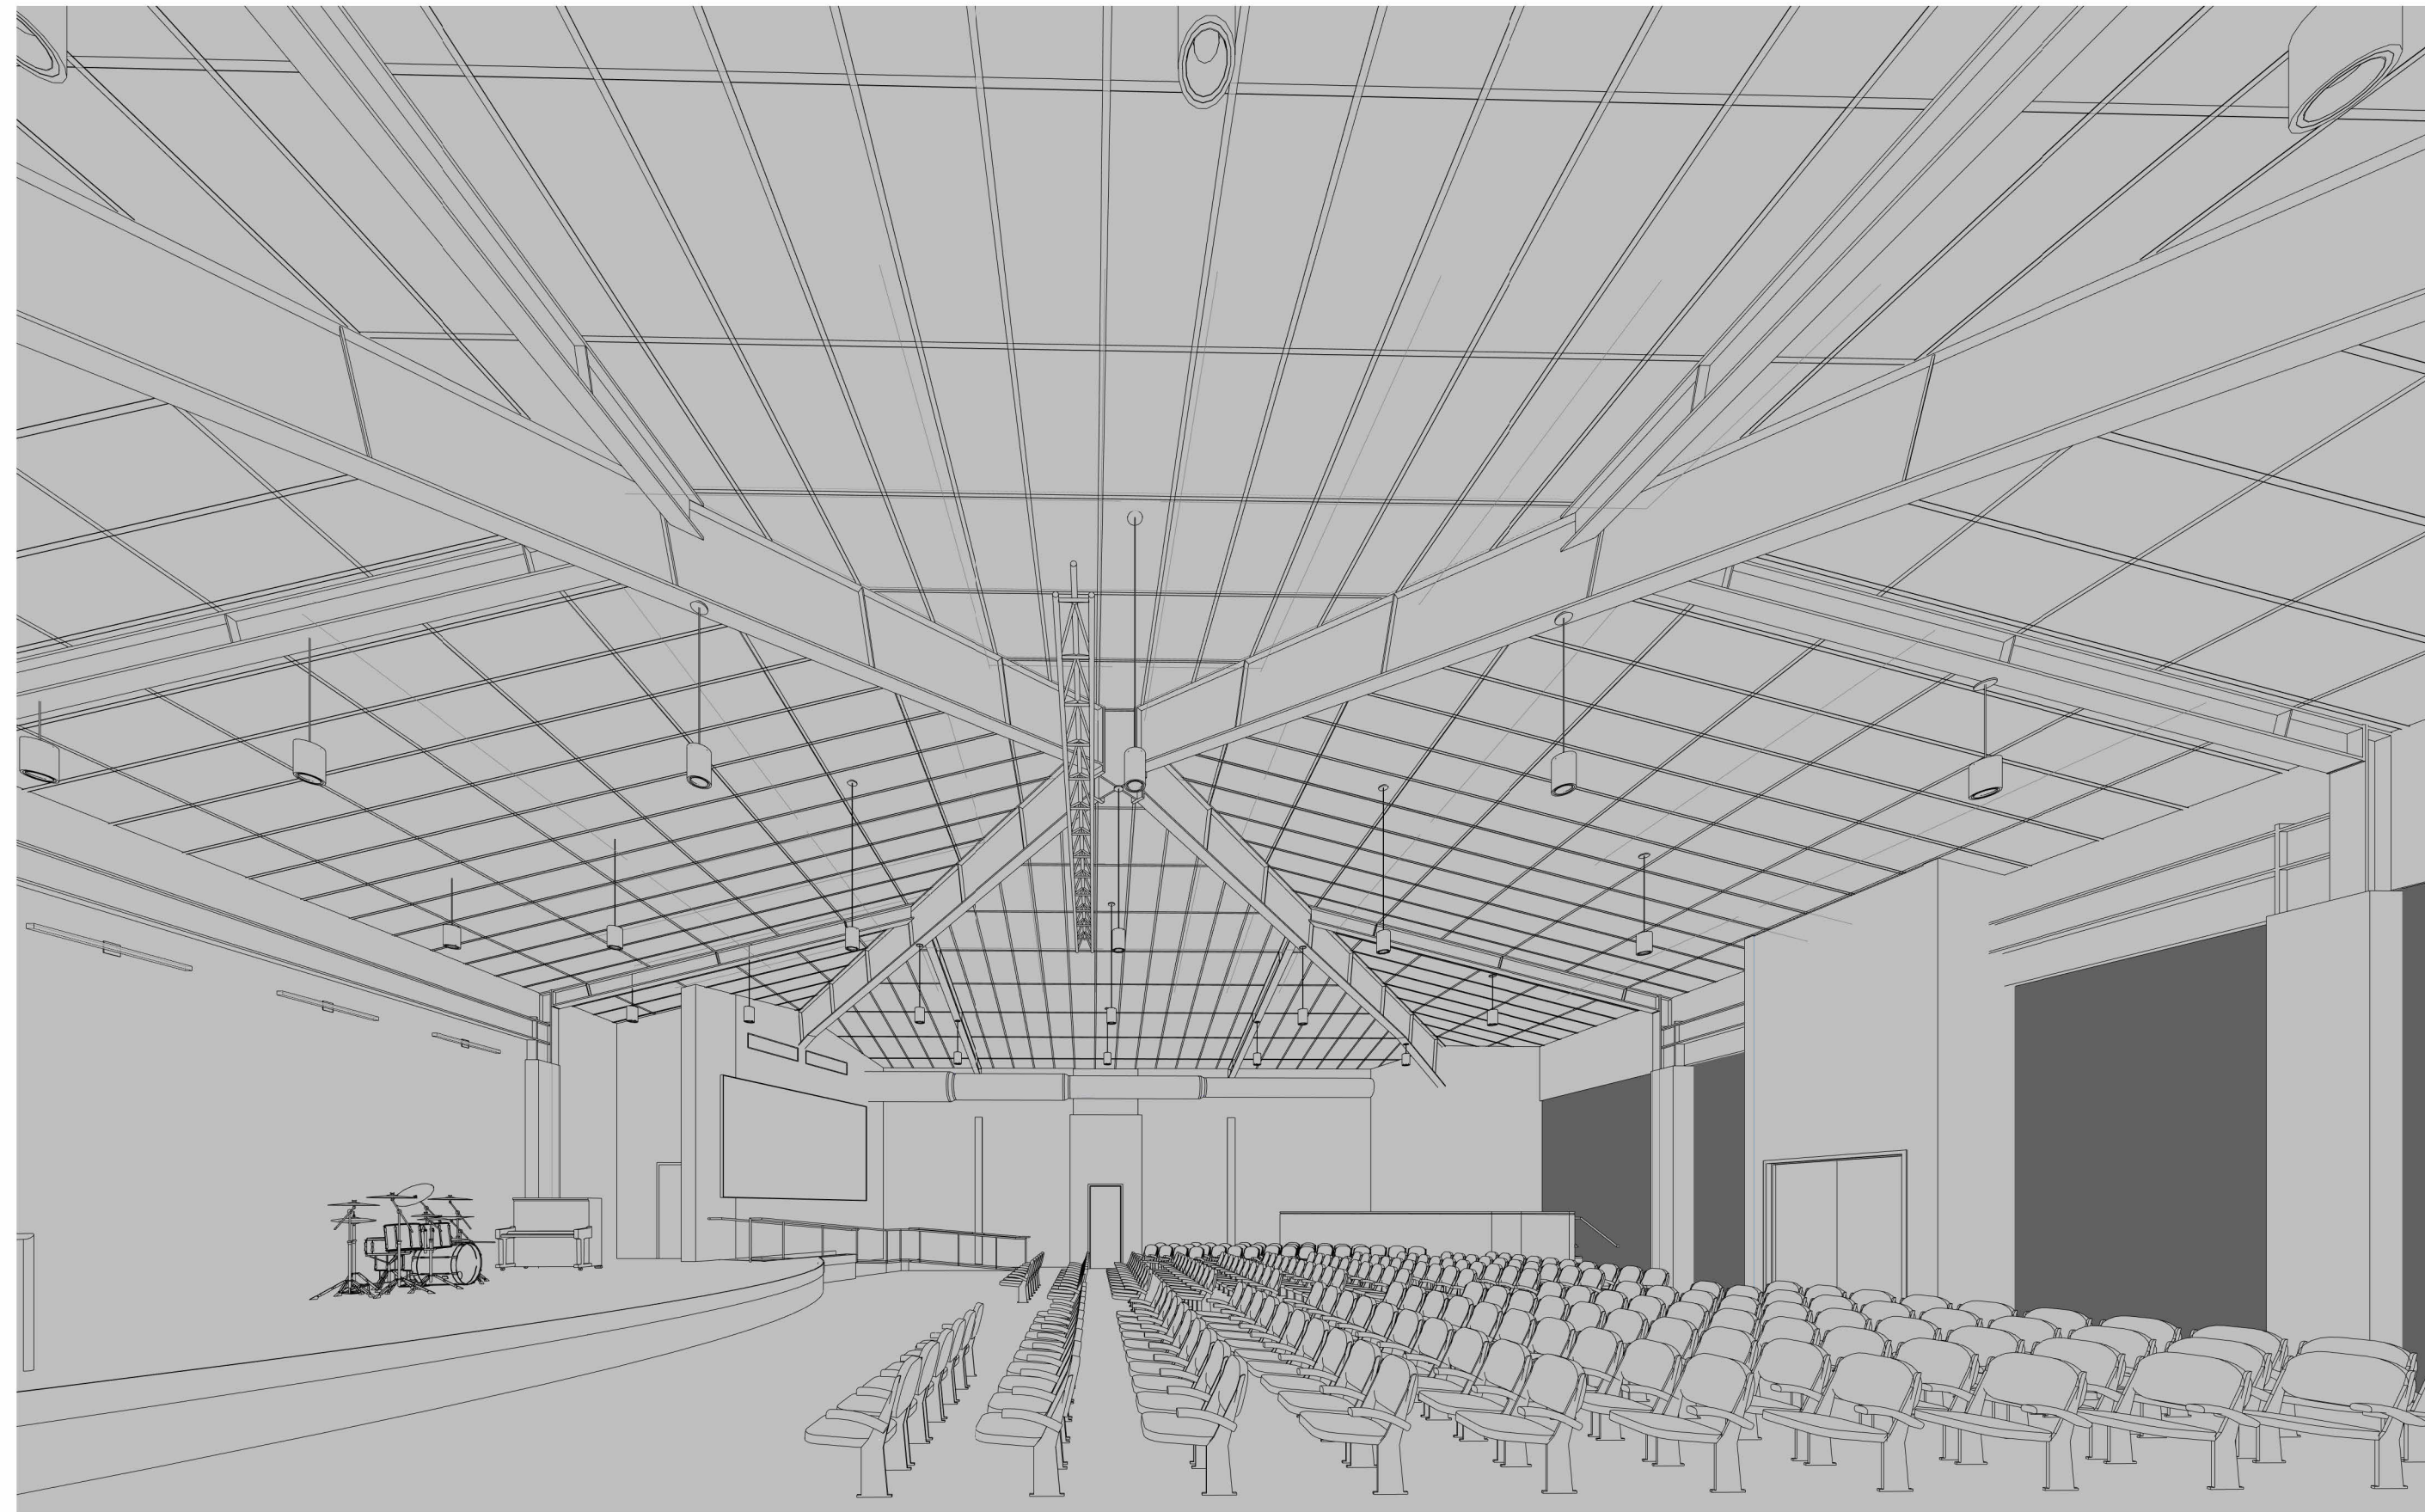

03 SANCTUARY - PERSPECTIVE 3
SCALE:

01 SANCTUARY - PERSPECTIVE FROM STAGE
SCALE:

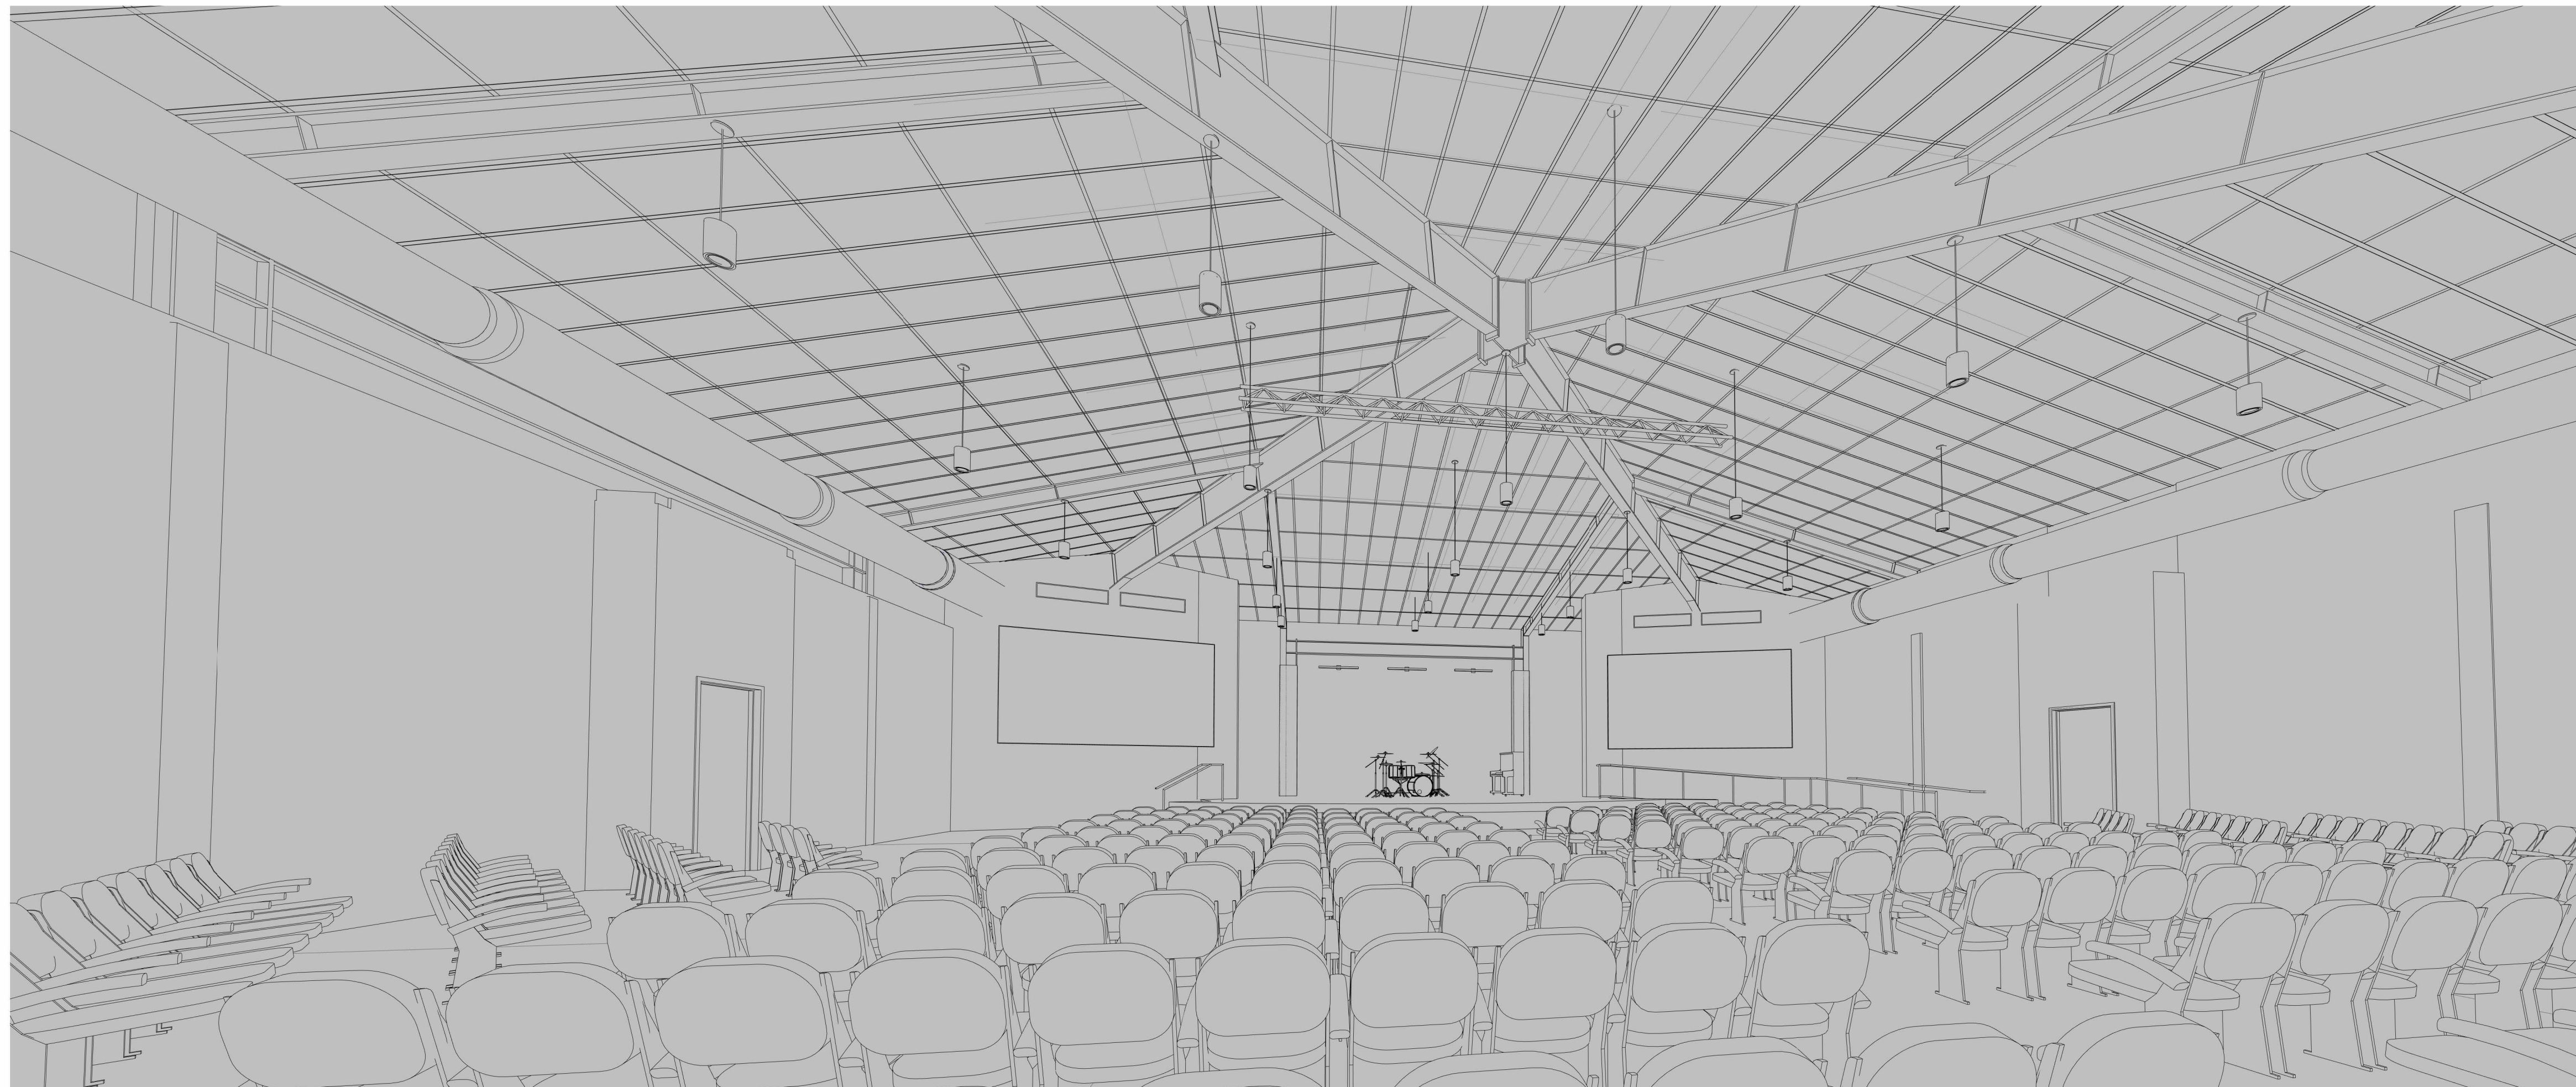


02 SANCTUARY - PERSPECTIVE 2
SCALE:



Ossa
STUDIO

4539 HEDGEMORE DRIVE, SUITE 101
CHARLOTTE NC 28209
704.890.2553
WWW.OSSASTUDIO.COM

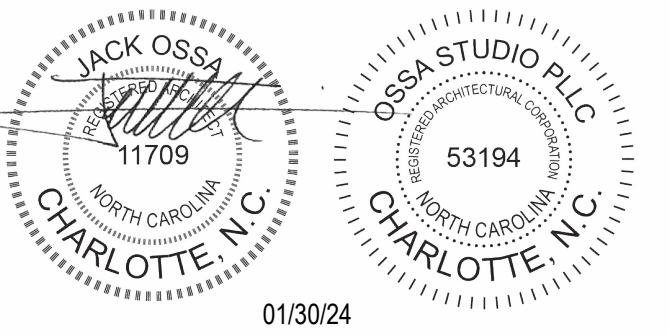

PROJECT TEAM

General Contractor
ECCLESIA CONSTRUCTION
www.ecclesiainc.com
803.327.5670


Civil Engineering
HILLIARD ENGINEERING, PLLC
www.hilliarde.com
919.352.2834

Structural Engineering
PROVIDENCE PARTNERS
www.providencpartnersinc.com
704.266.6621

Mechanical, Electrical, Plumbing & Fire Protection
ENGINEERING
www.engineering.com
704.287.2193

△ Date	Description
01/30/24	FOR CONSTRUCTION

Project Name

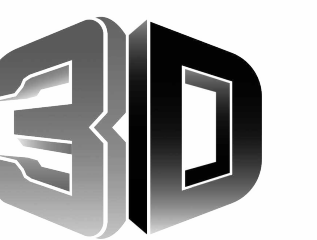

community church
making church come alive

658 GRAHAM ROAD
SANFORD NC 27311

Client

3D COMMUNITY CHURCH

Project Number


23024.00

Description


INTERIOR VIEWS

Scale


A05.04

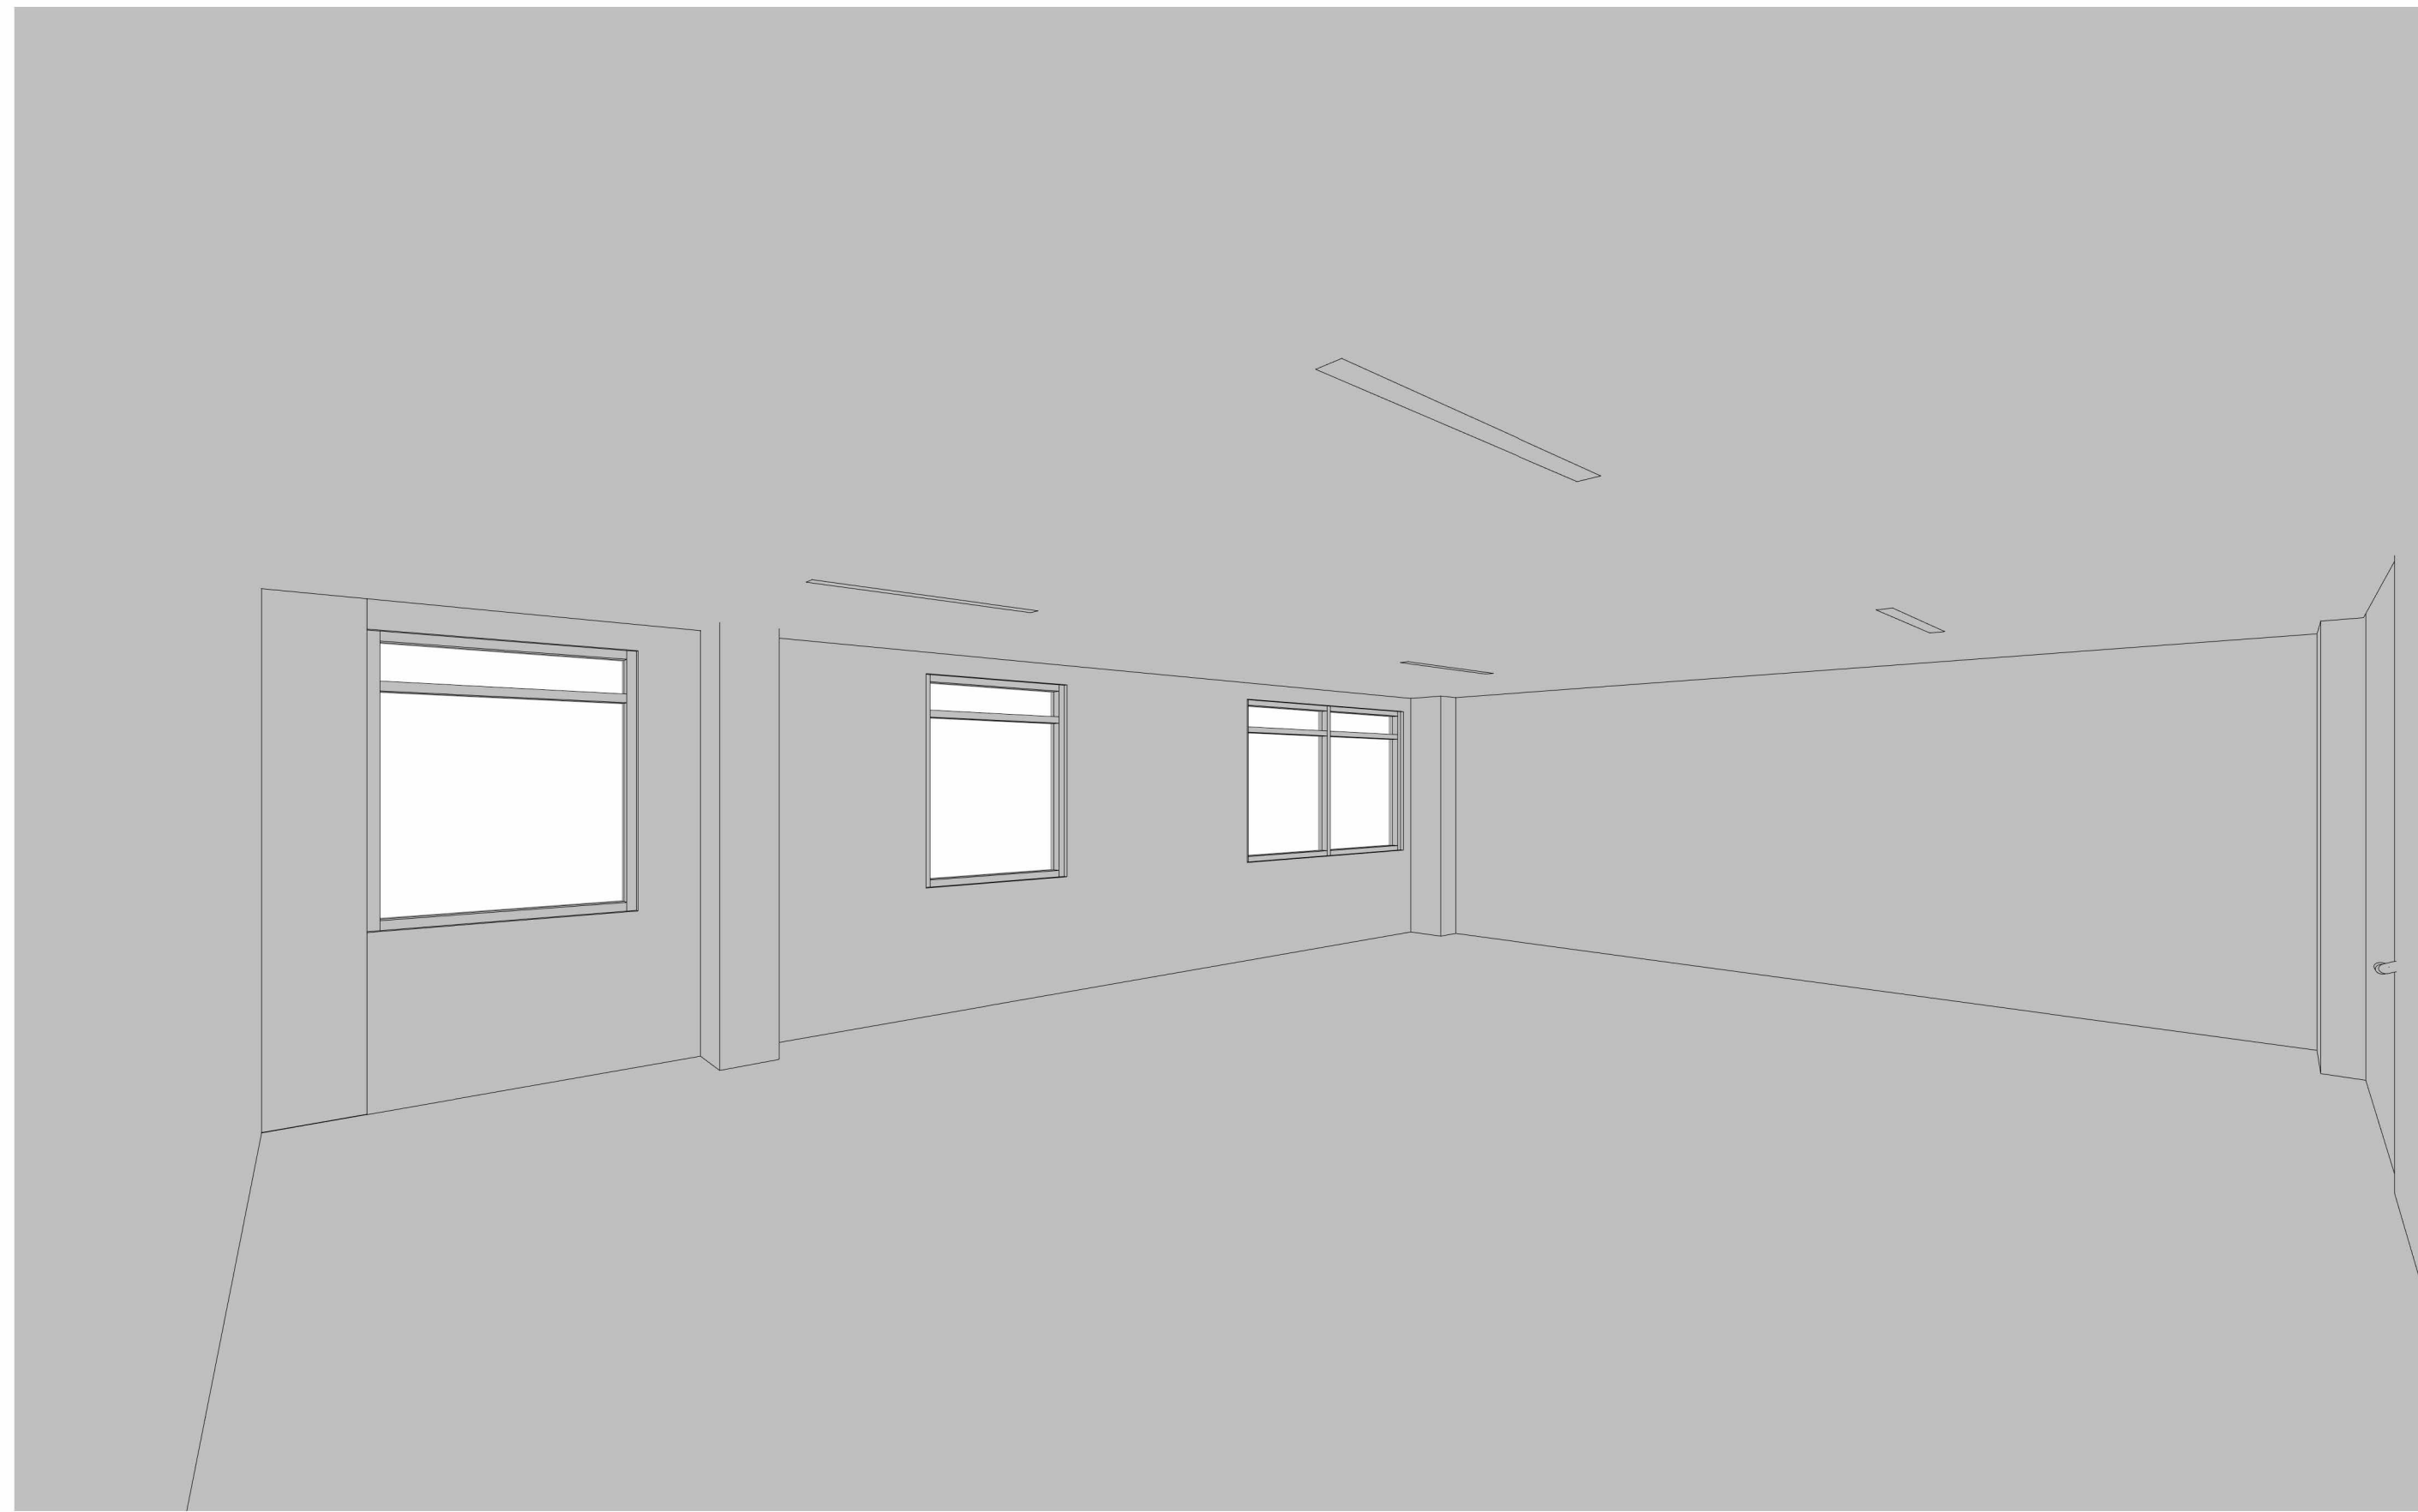


03 SHARED OFFICE - PERSPECTIVE VIEW
SCALE:

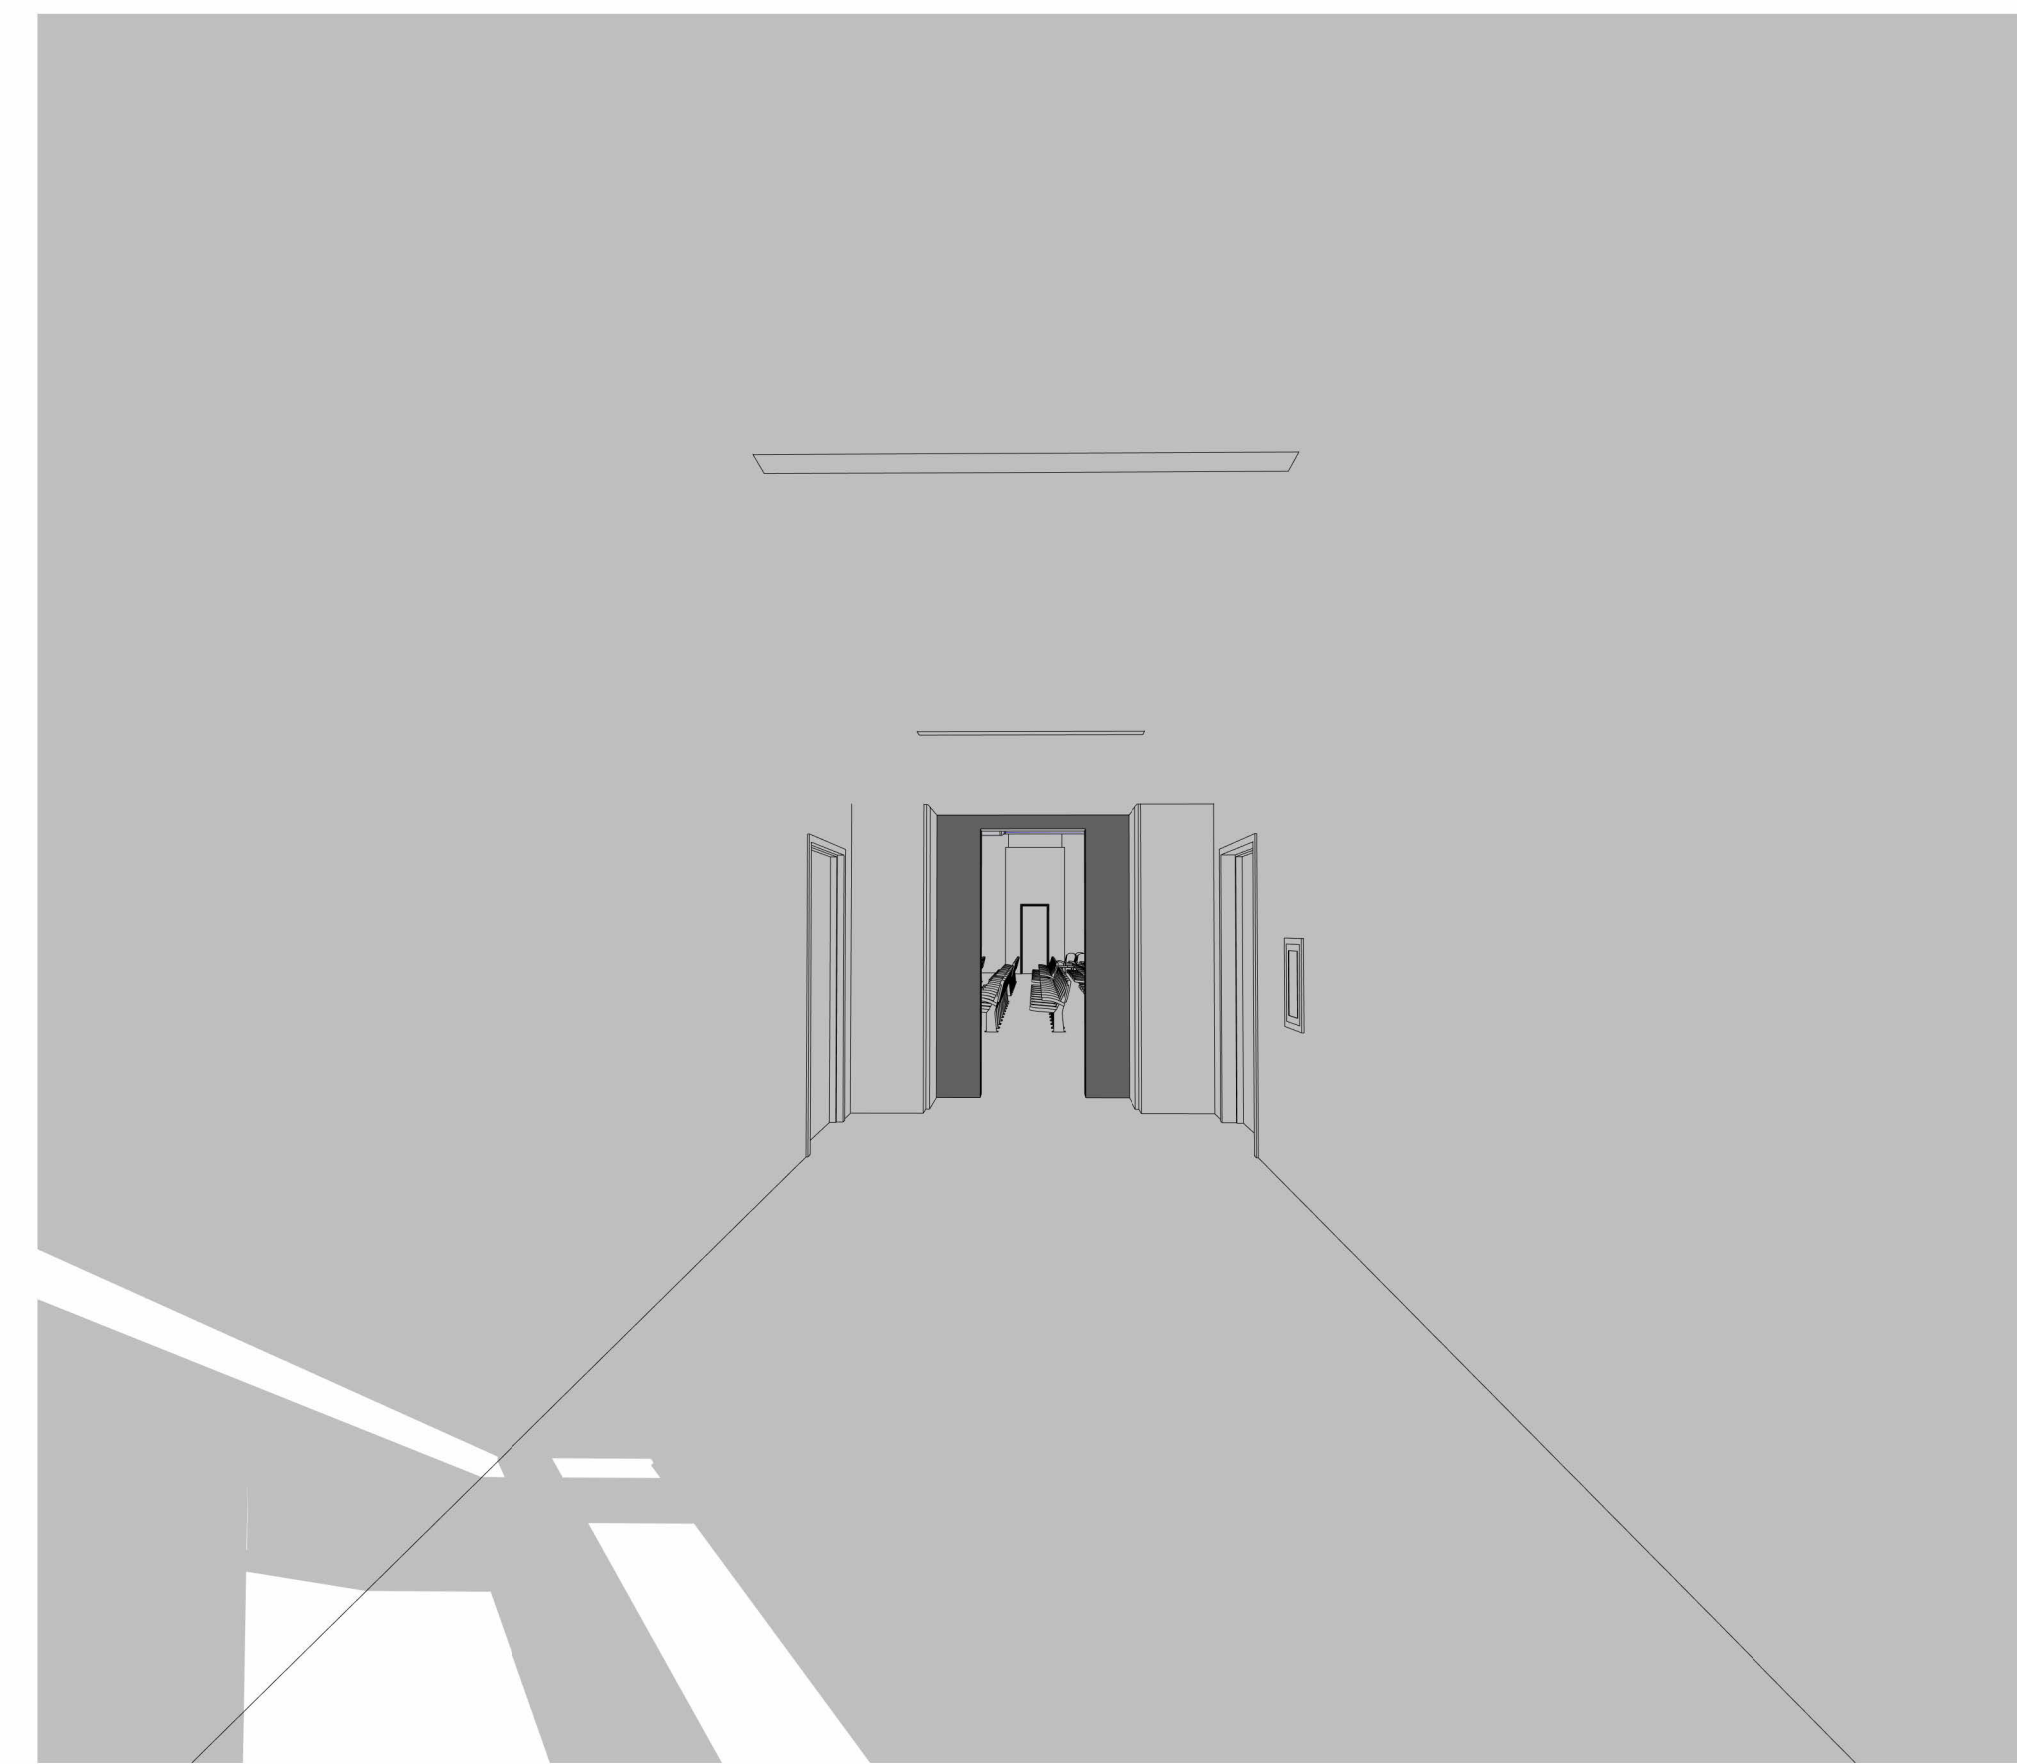


01 LOBBY - PERSPECTIVE AT SANCTUARY ENTRY
SCALE:

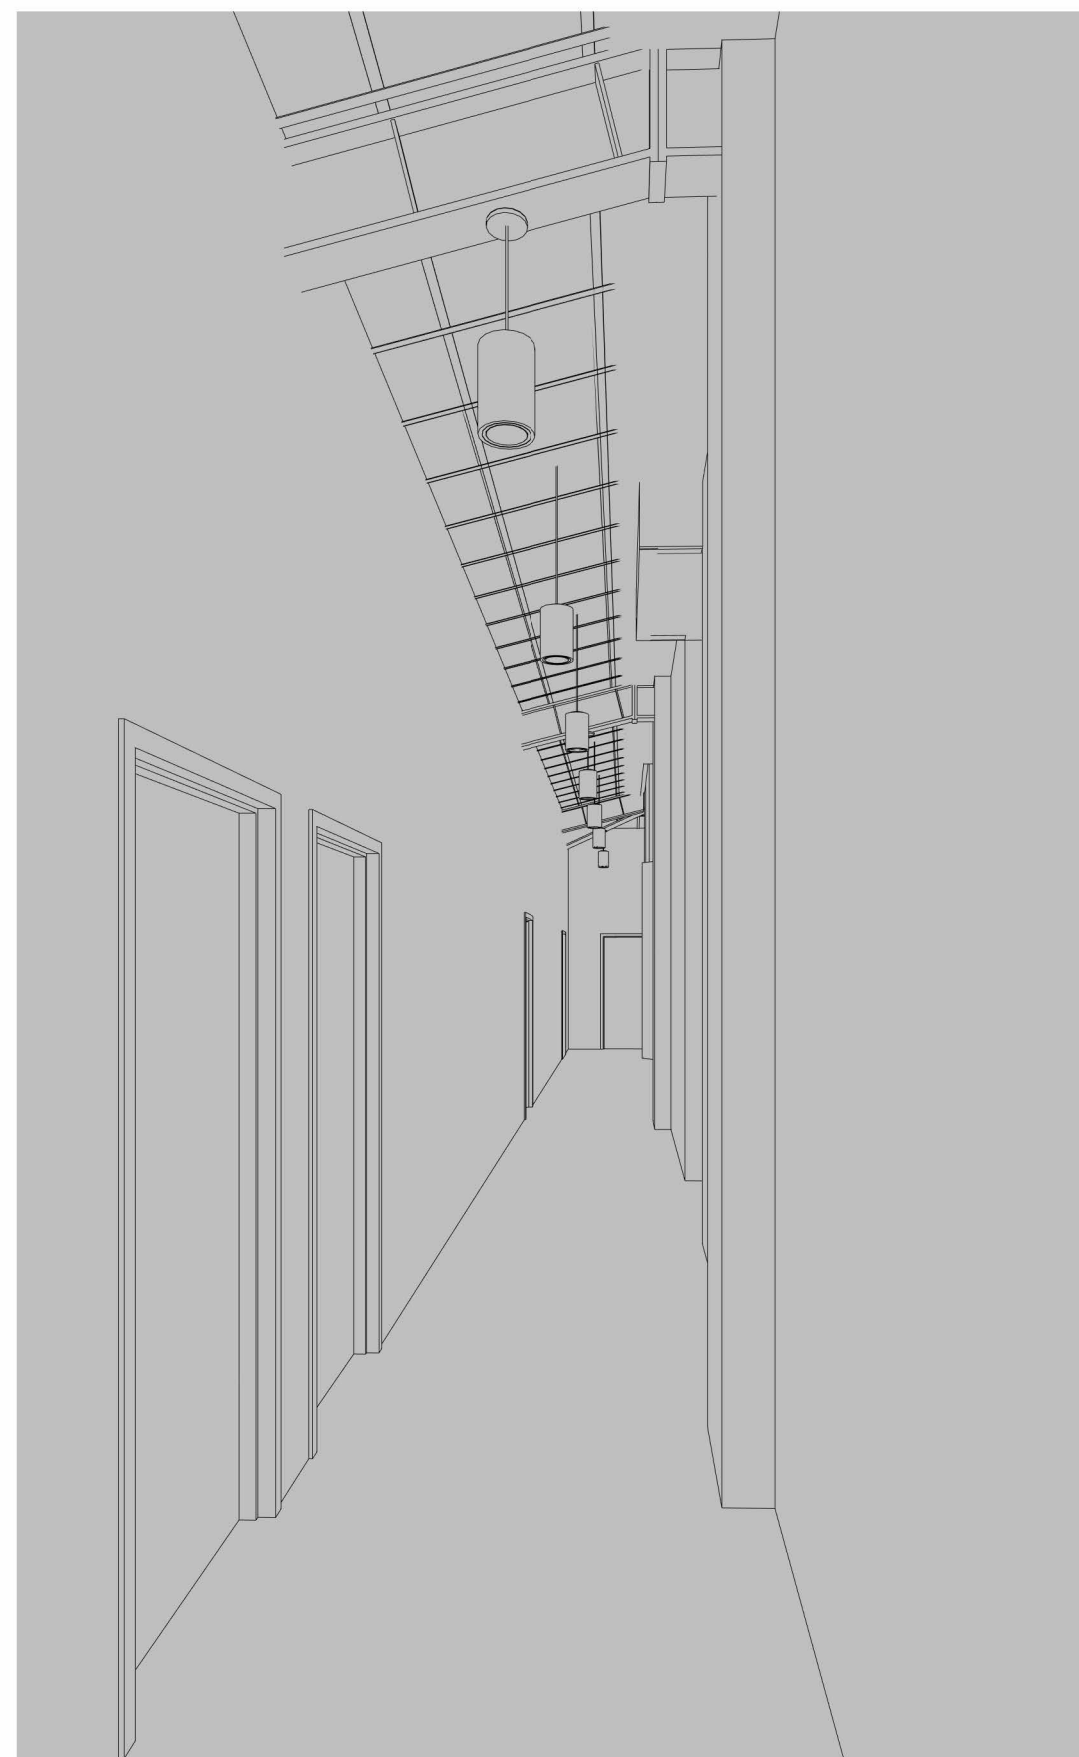

05 CHILD CARE CORRIDOR - PERSPECTIVE
SCALE:

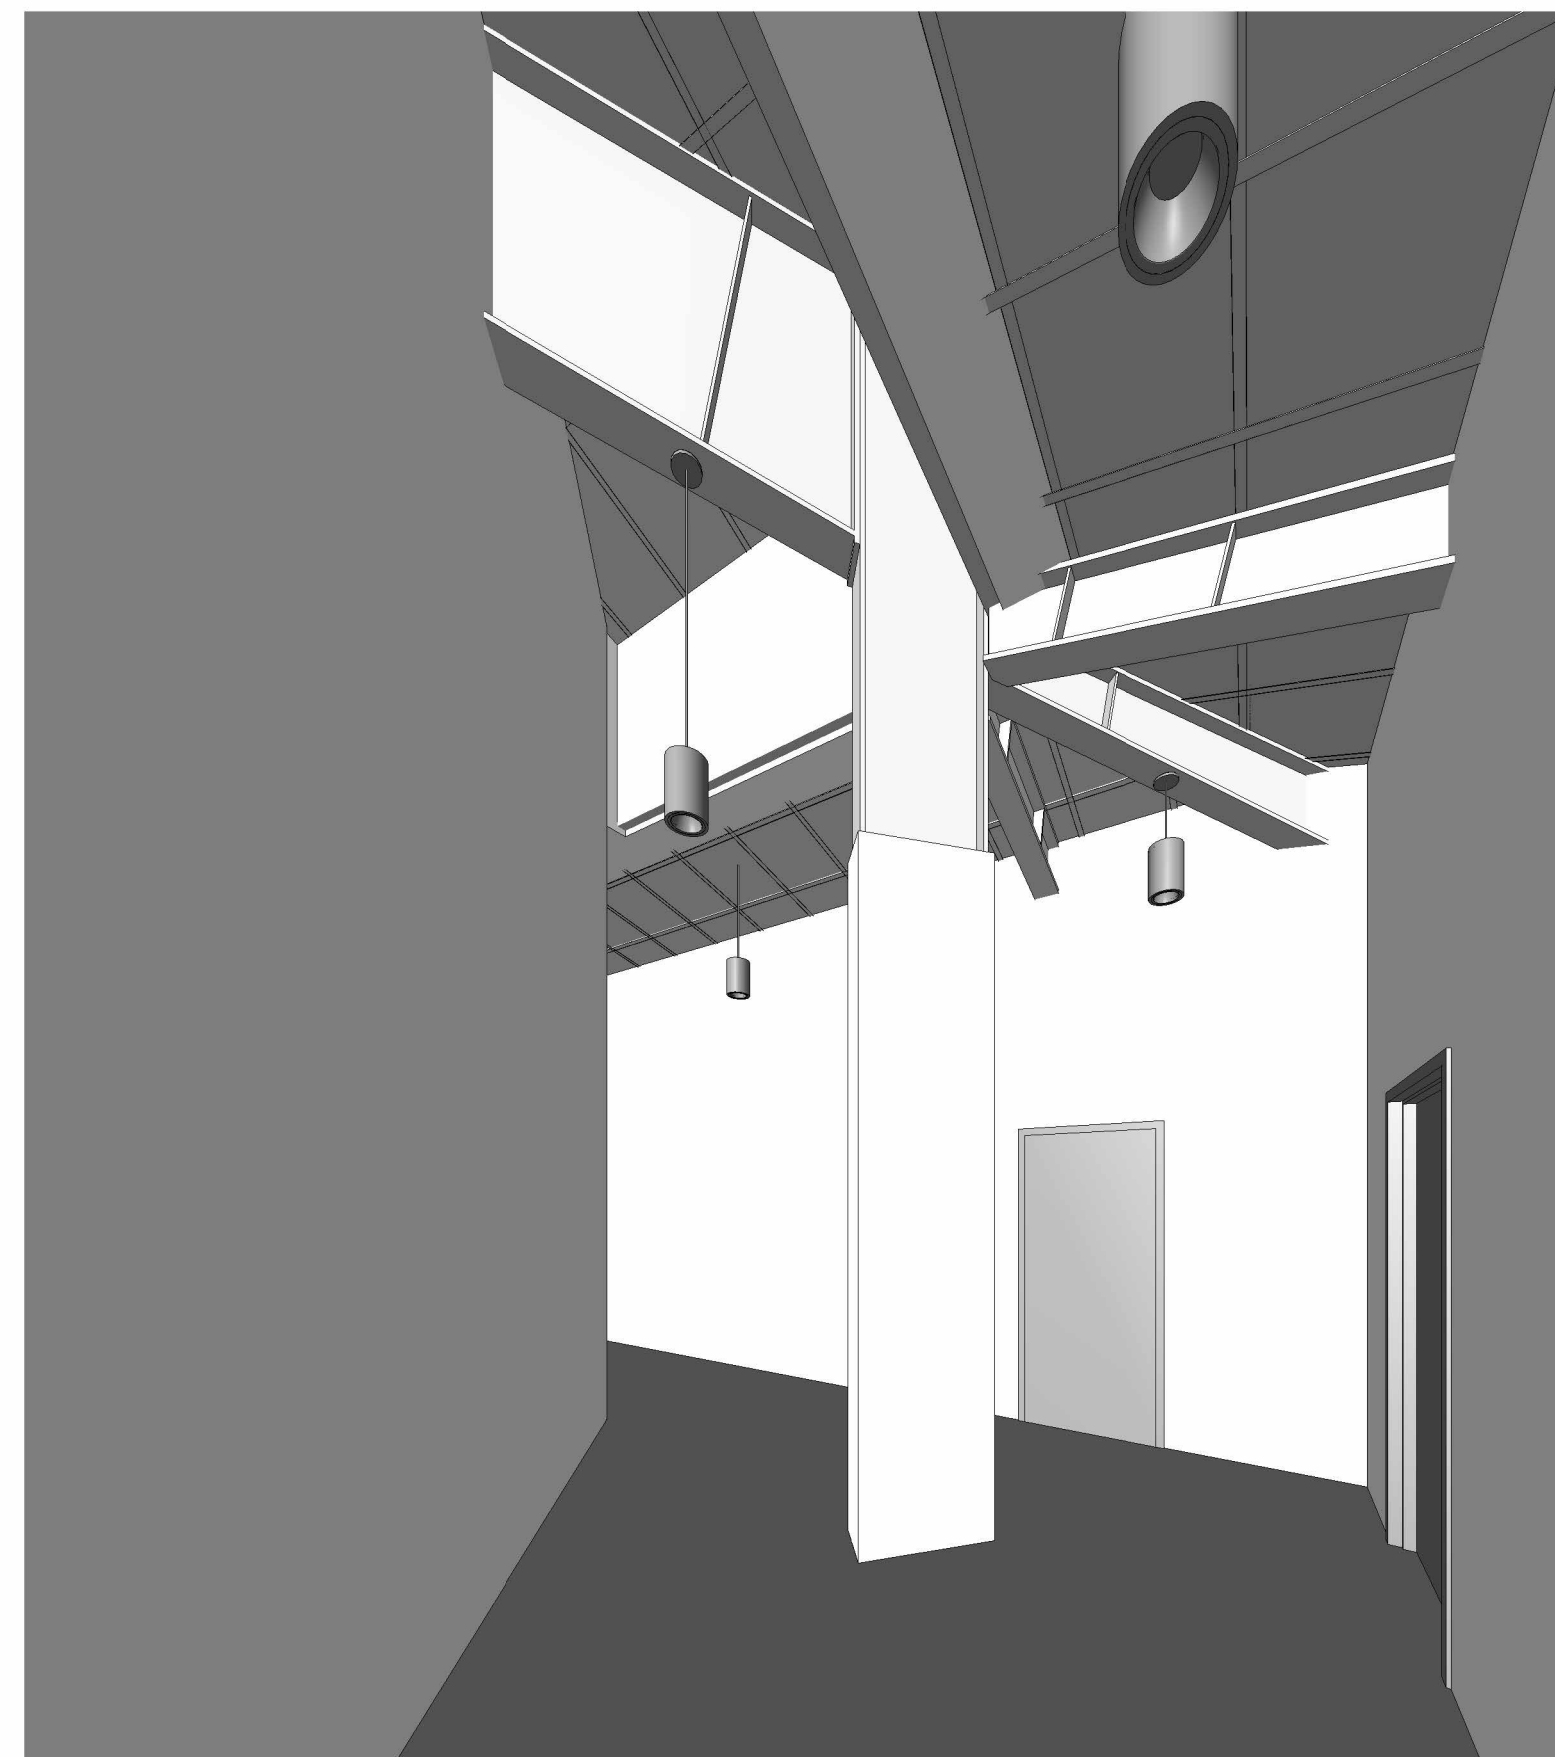


04 CHILD CARE CORRIDOR - PERSPECTIVE AT NURSERY ENTRY
SCALE:

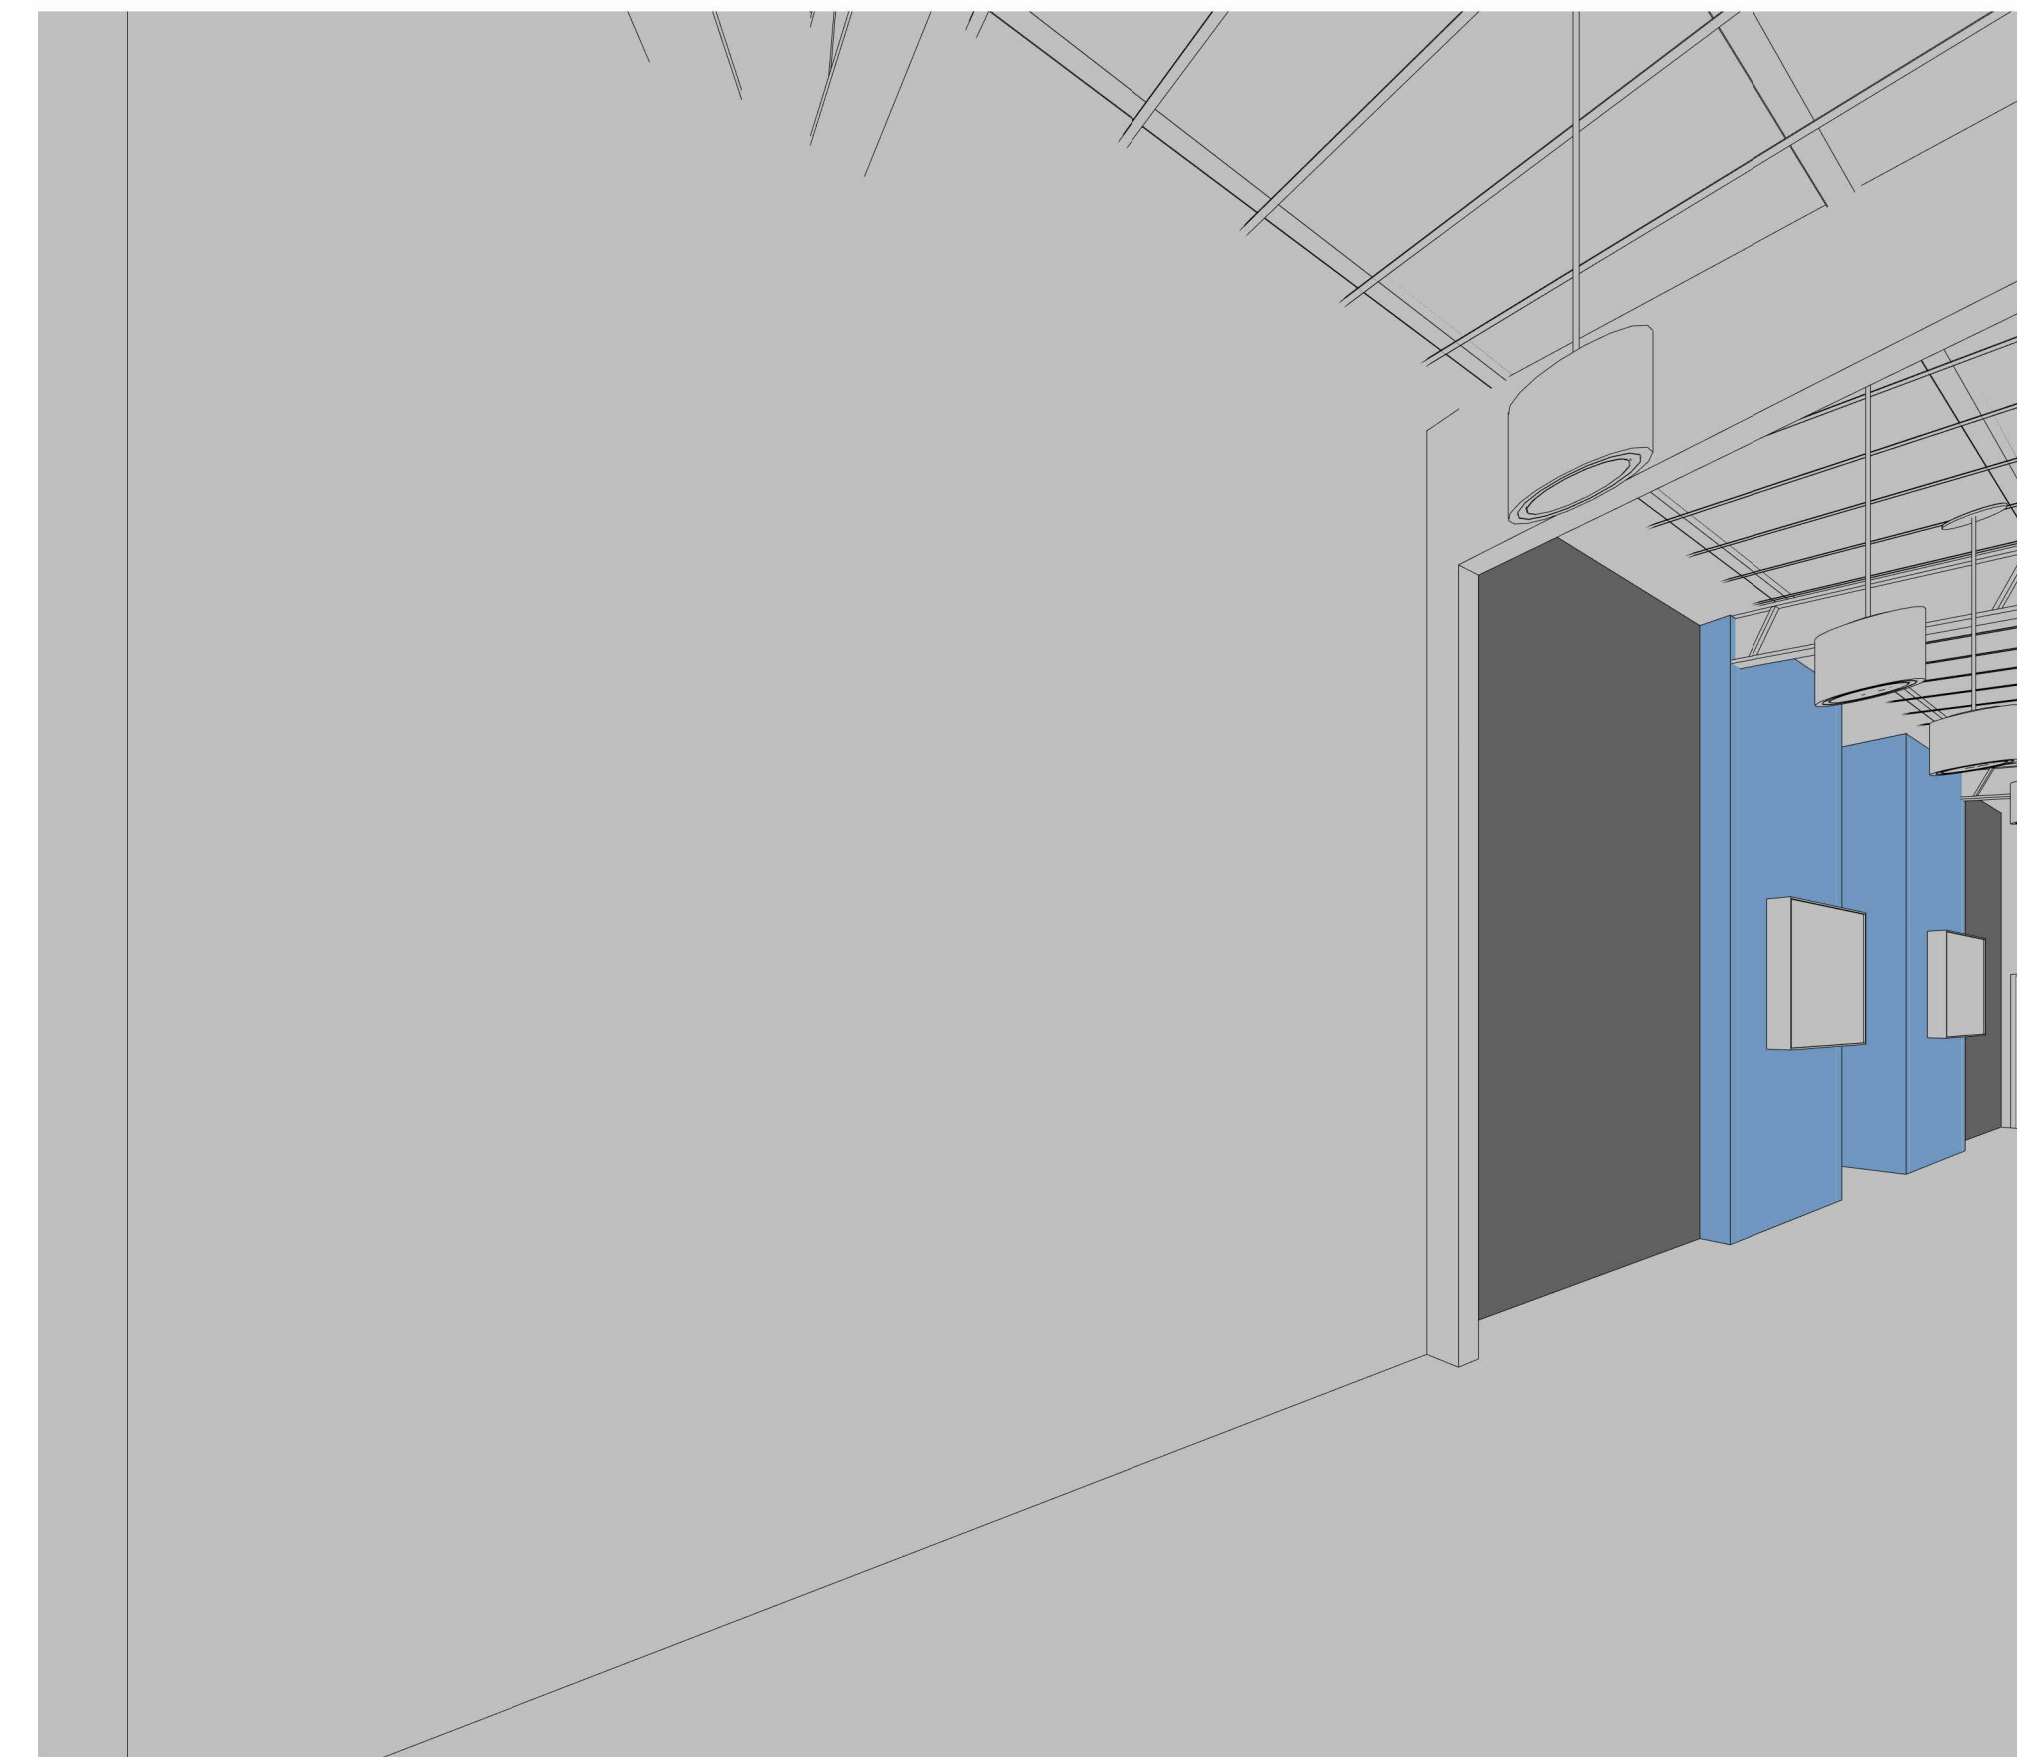


02 OFFICE CORRIDOR - PERSPECTIVE AT CORNER
SCALE:


10/14/2024 5:08:03 PM C:\ProgramData\Autodesk\LT2024\00_30\Community Church\andrew.mcdellan\FHC.rvt

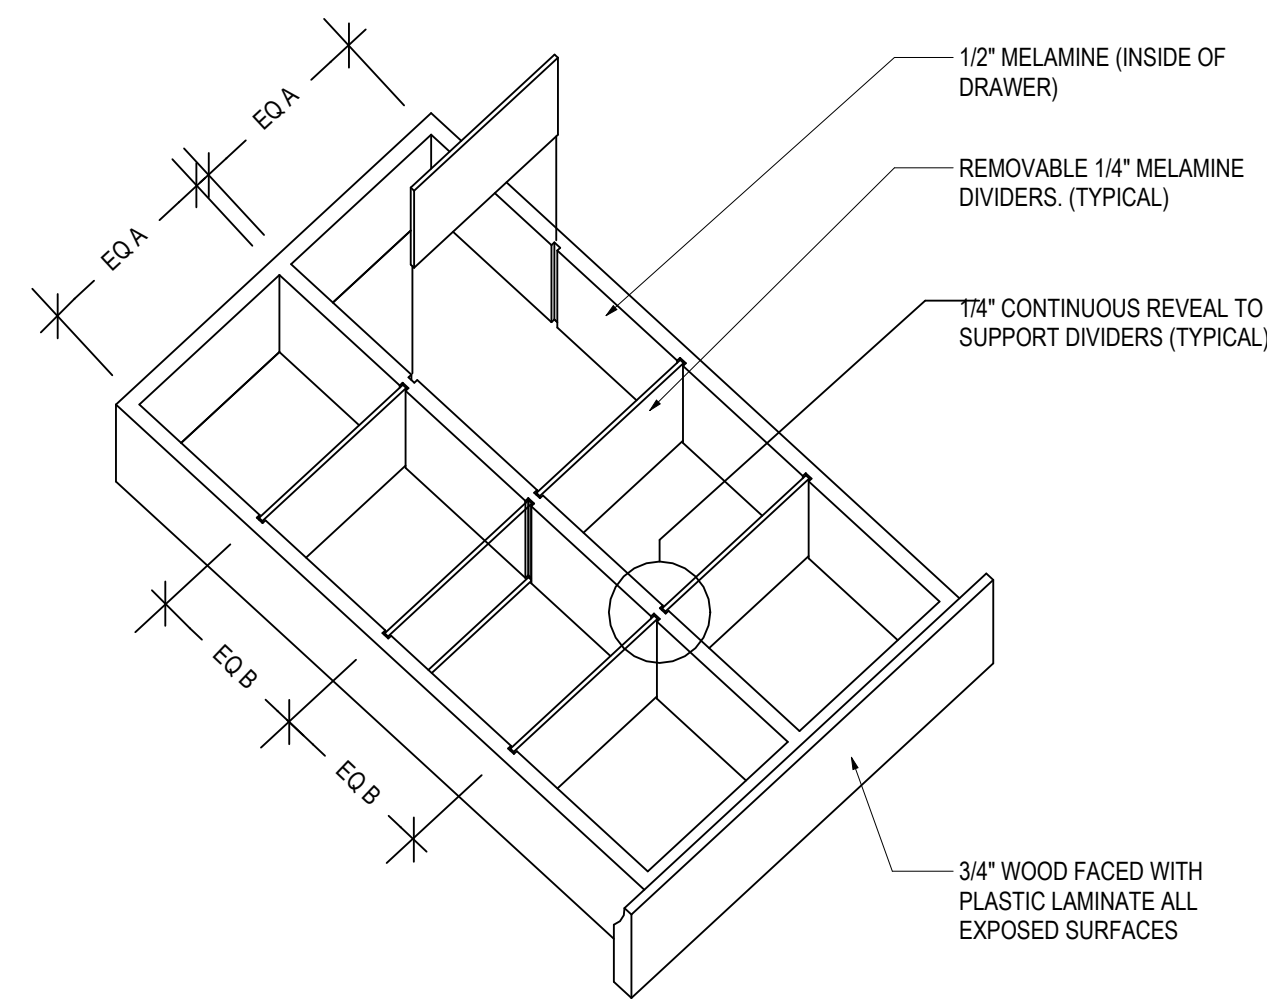


08 CONDIMENT DRAWER DIVIDERS
SCALE: 1 1/2" = 1'-0"

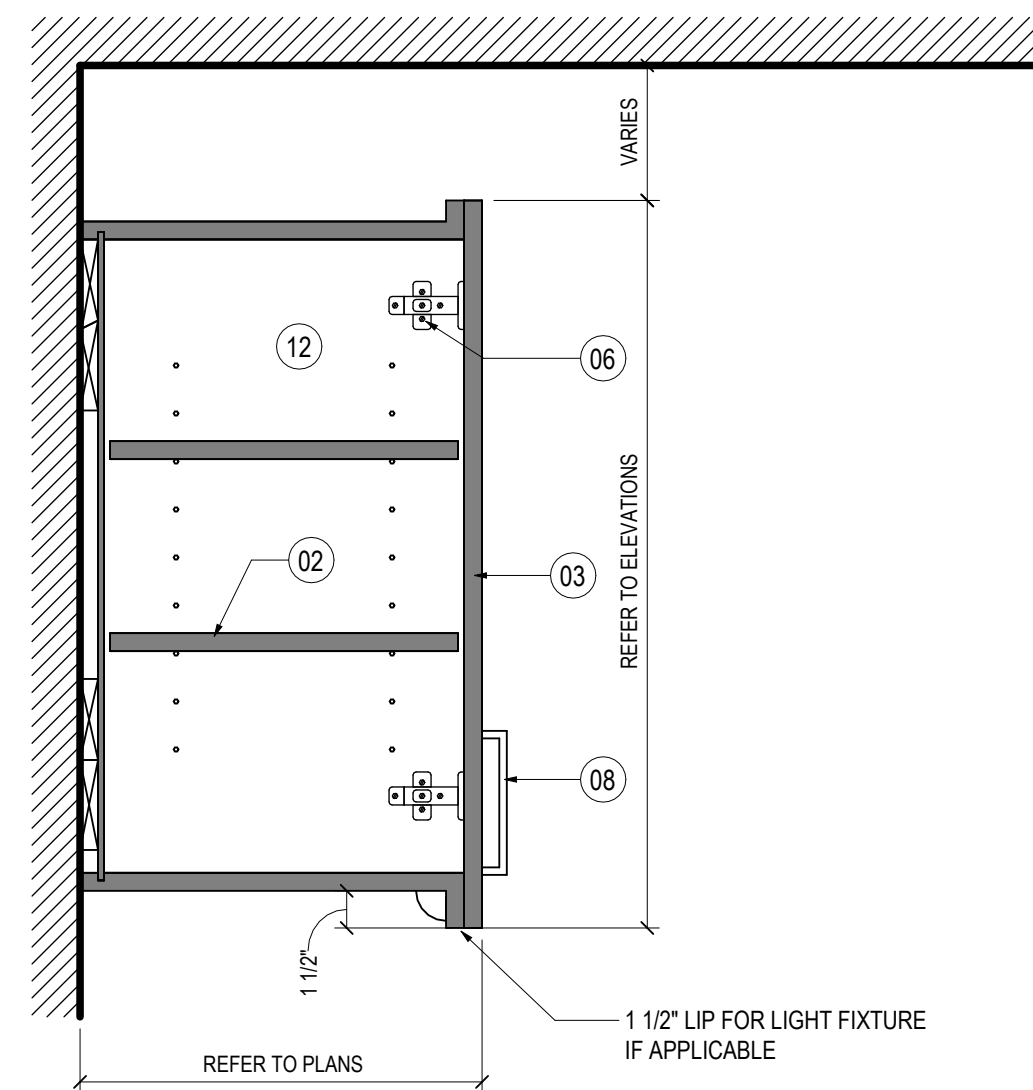


09 UPPER CABINET W/ DOOR
SCALE: 1 1/2" = 1'-0"

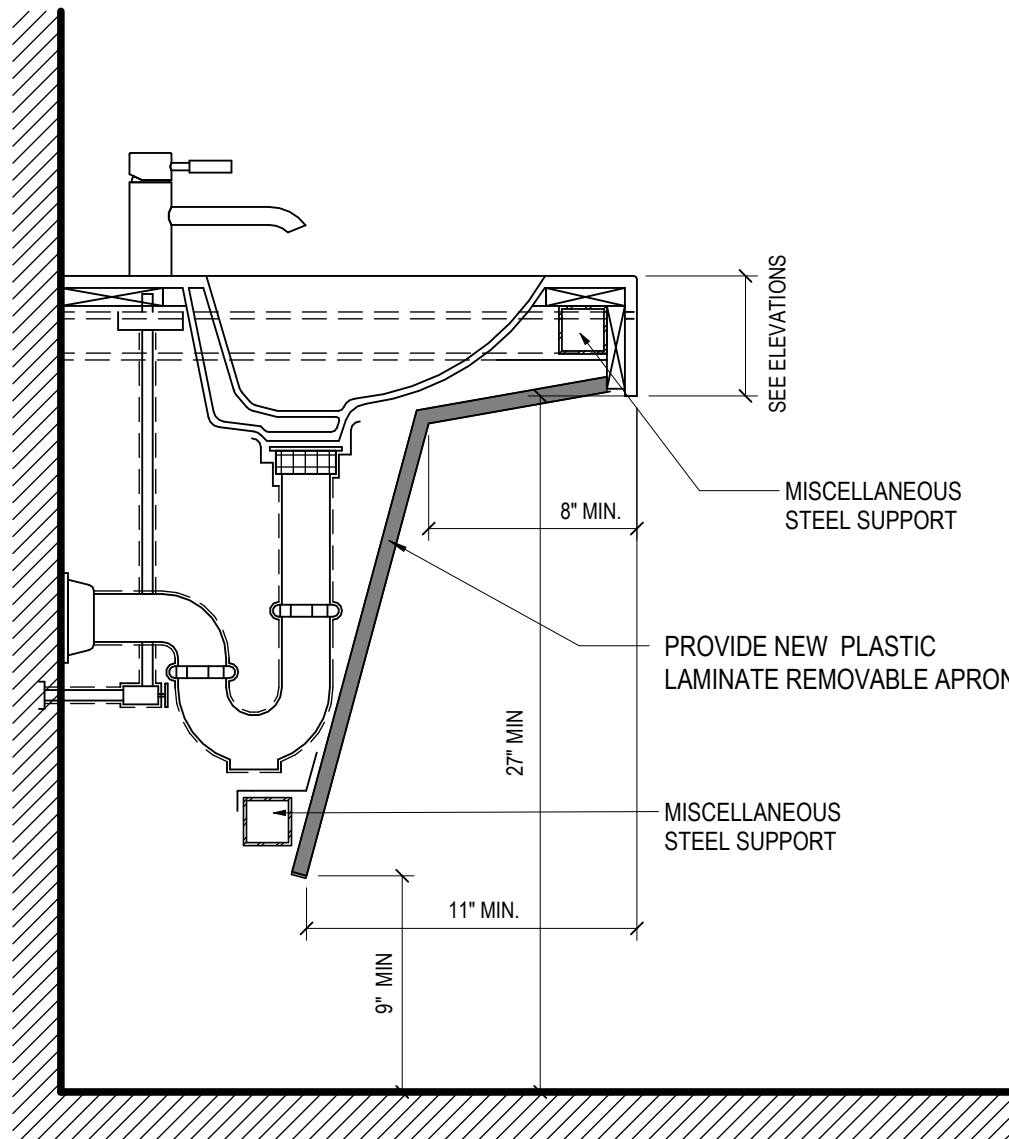


05 RESTROOM SINK
SCALE: 1 1/2" = 1'-0"

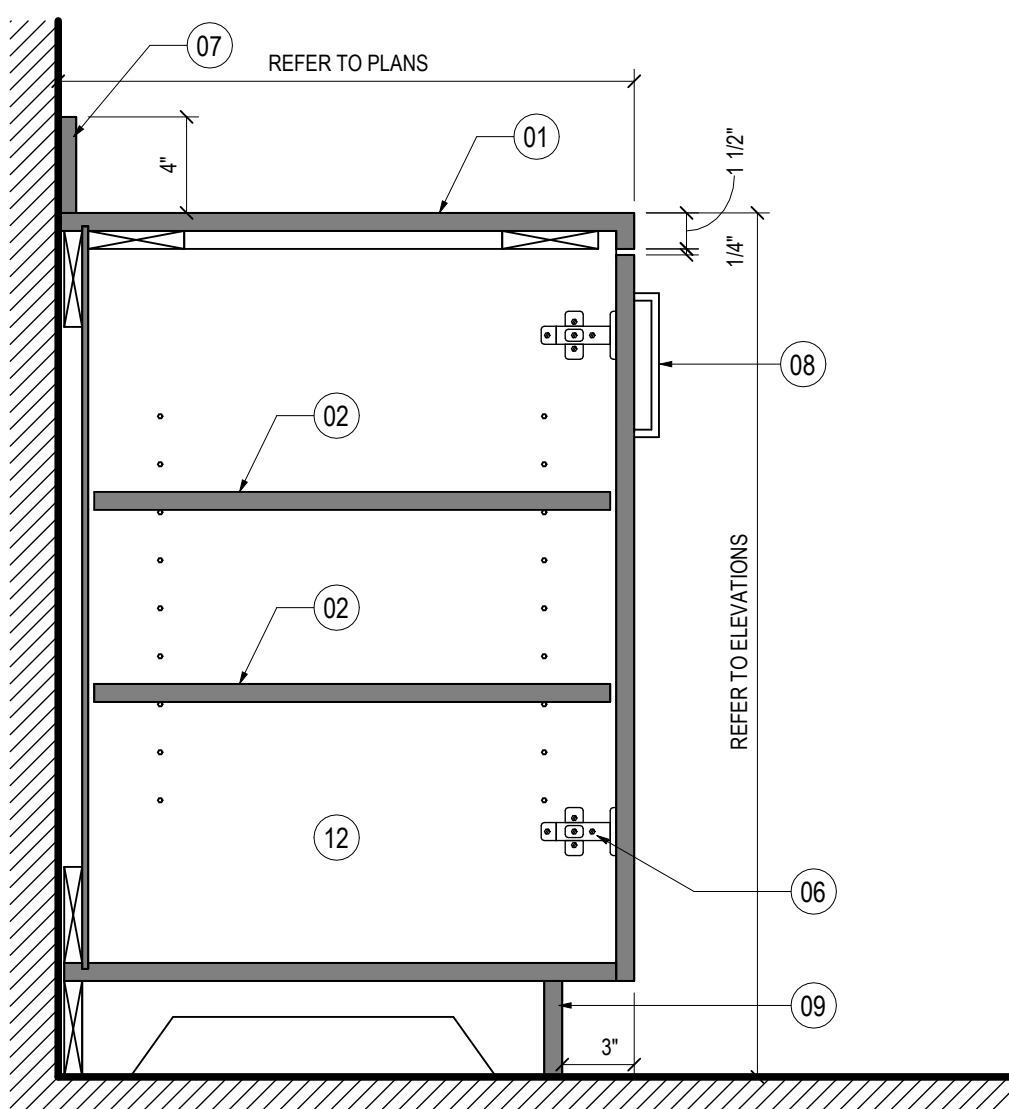


06 COUNTERTOP WITH ONE DOOR
SCALE: 1 1/2" = 1'-0"

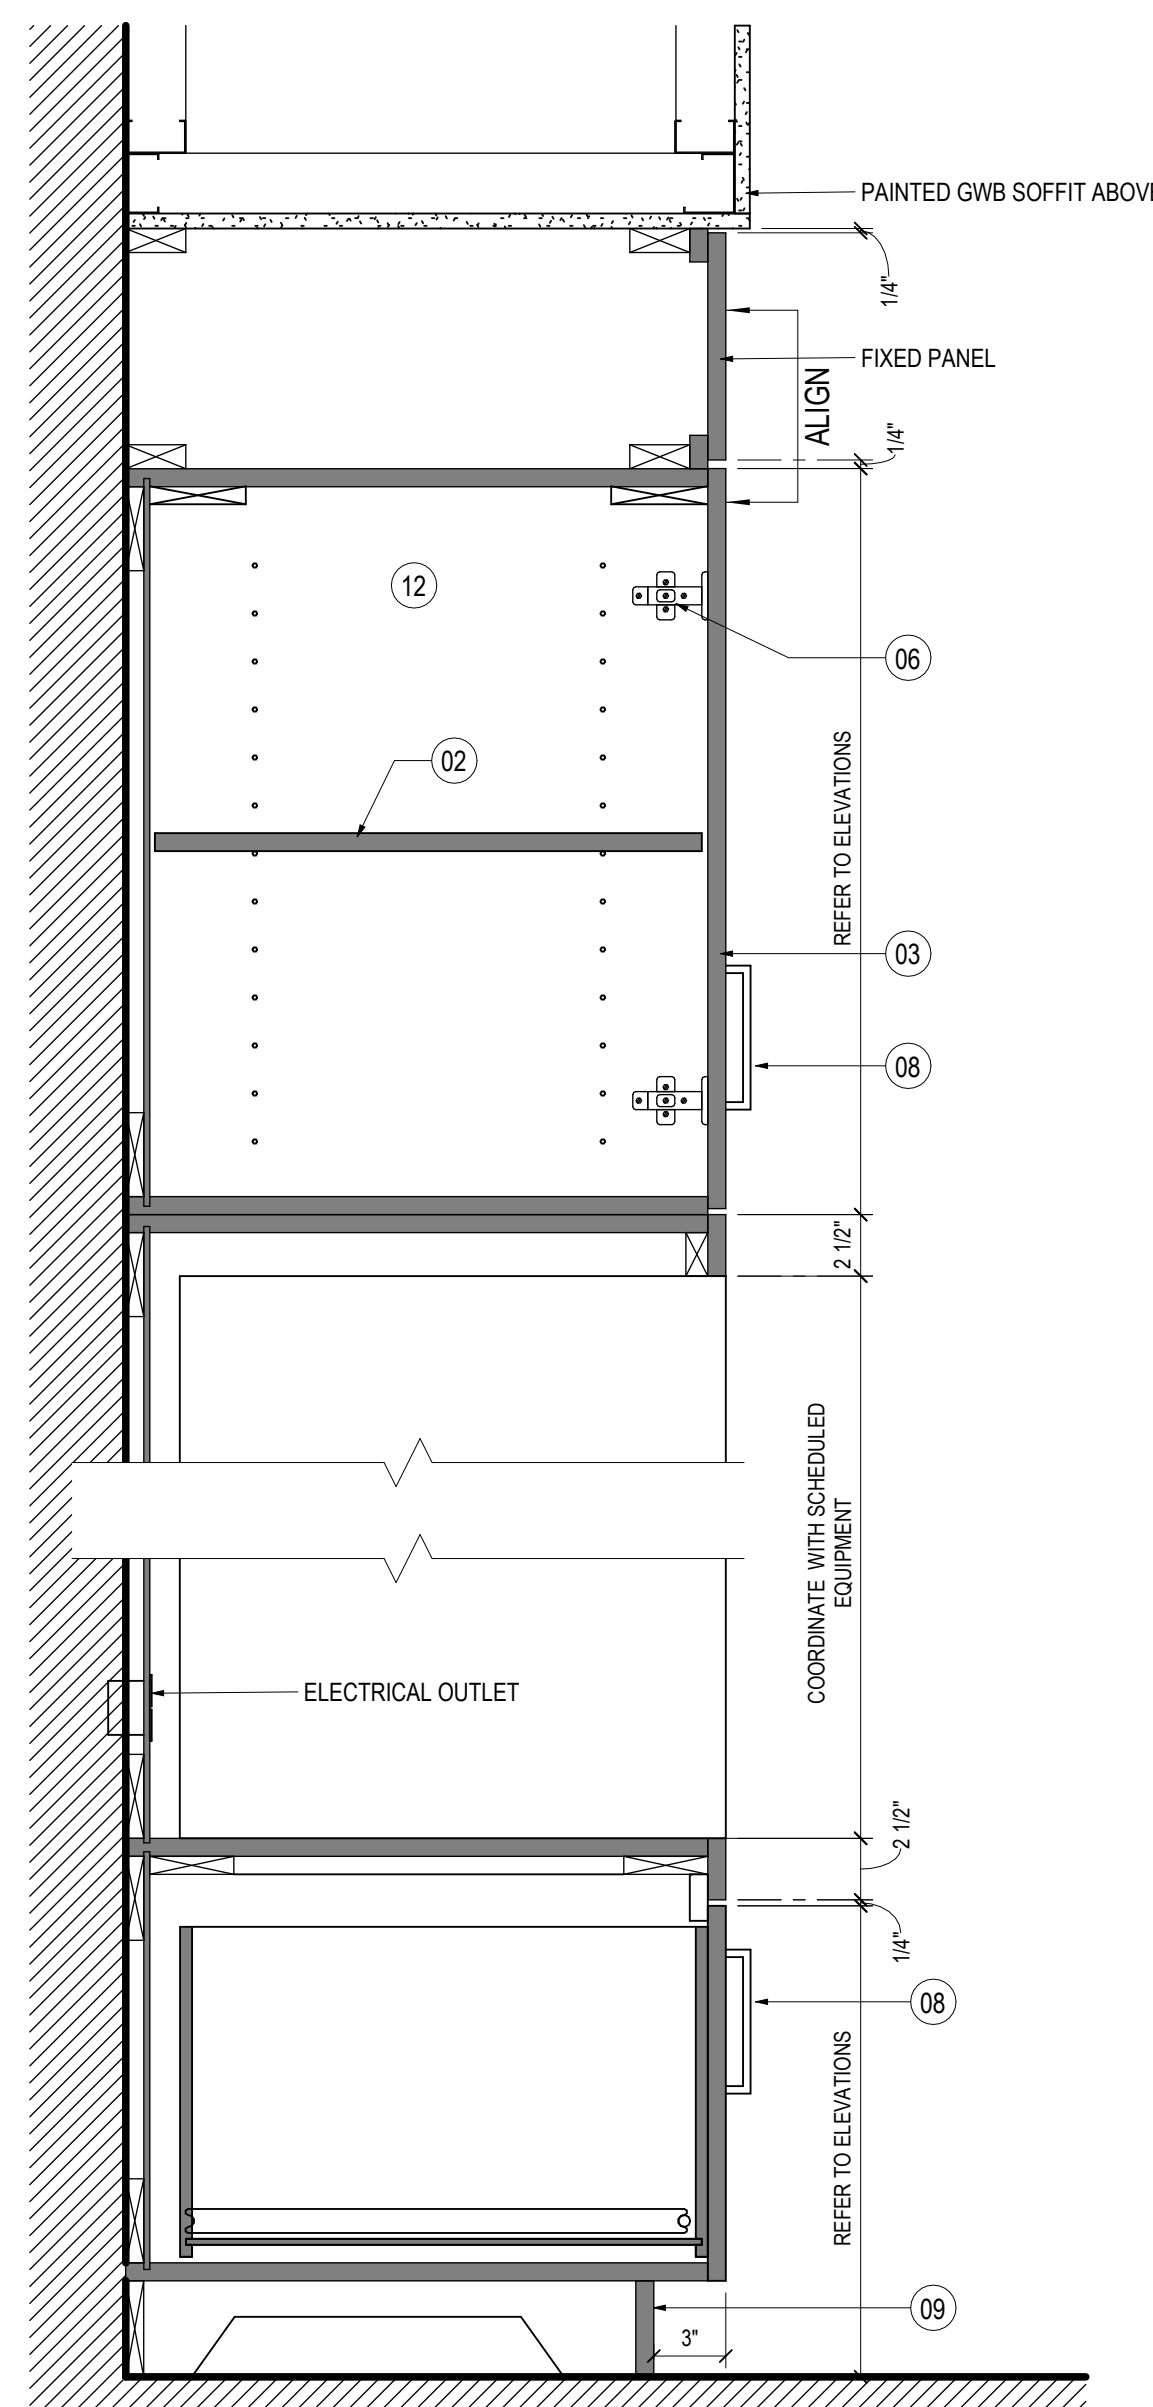


07 MICROWAVE OVEN TALL CABINET
SCALE: 1 1/2" = 1'-0"

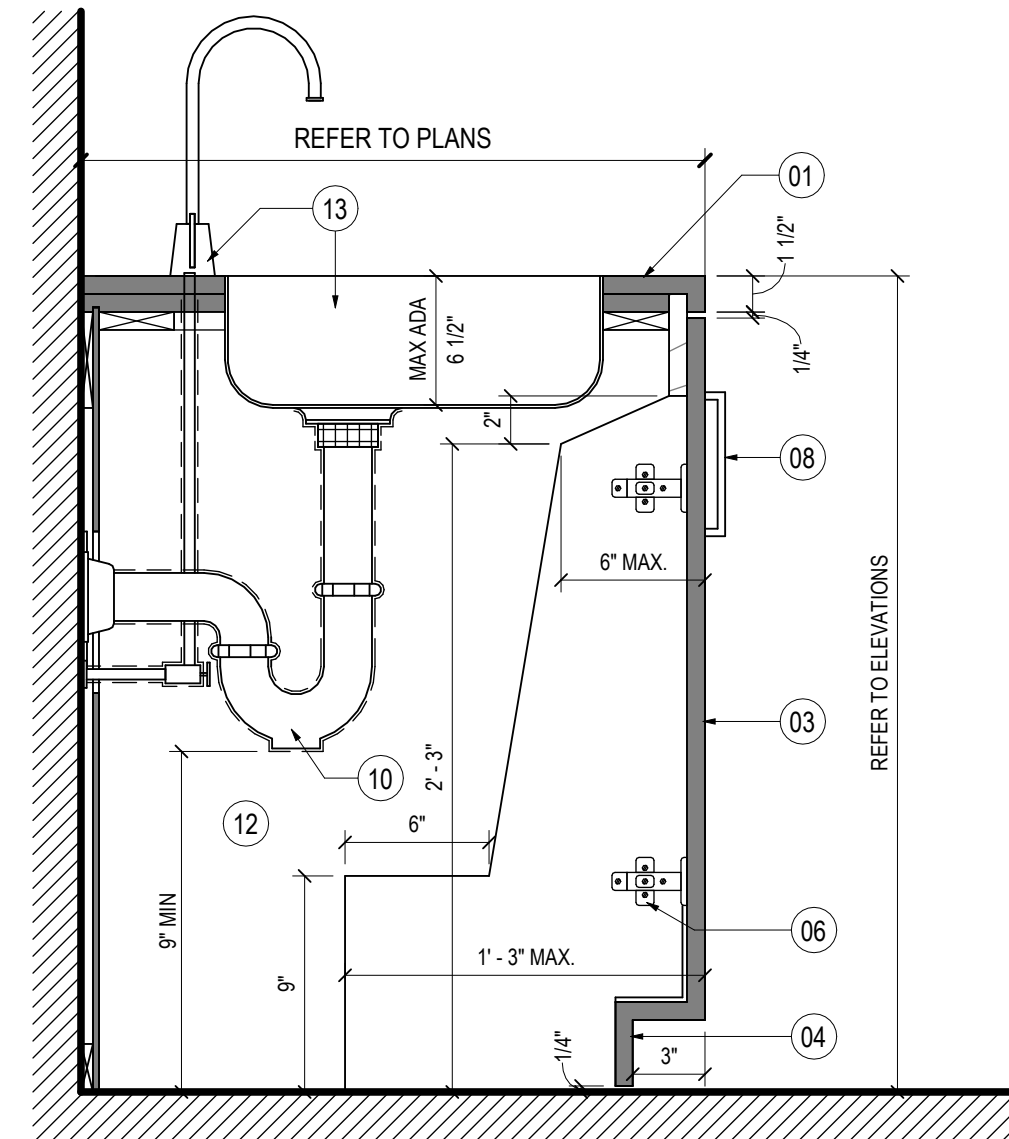


01 CABINET WITH SINK
SCALE: 1 1/2" = 1'-0"

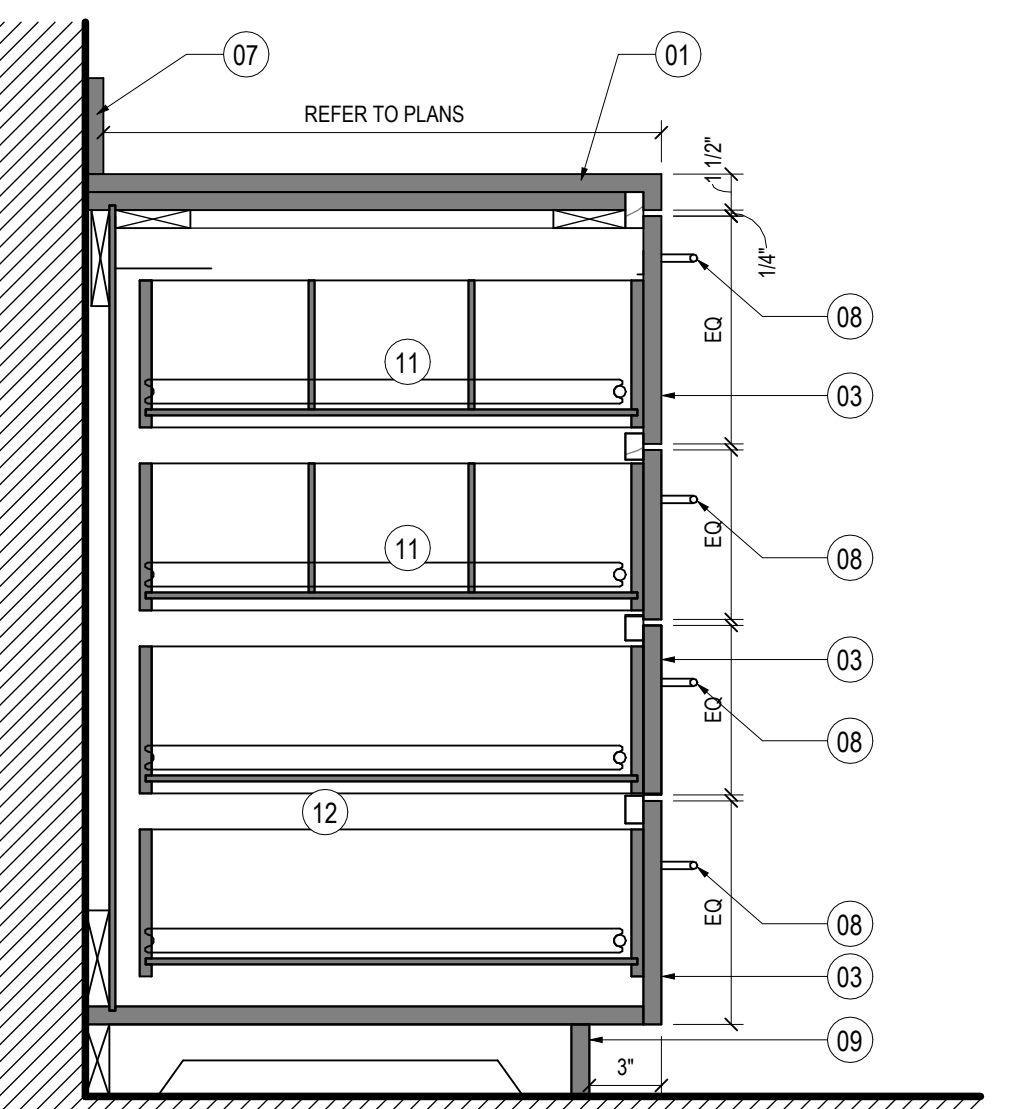

02 BREAKROOM CABINET W/ DRAWERS
SCALE: 1 1/2" = 1'-0"

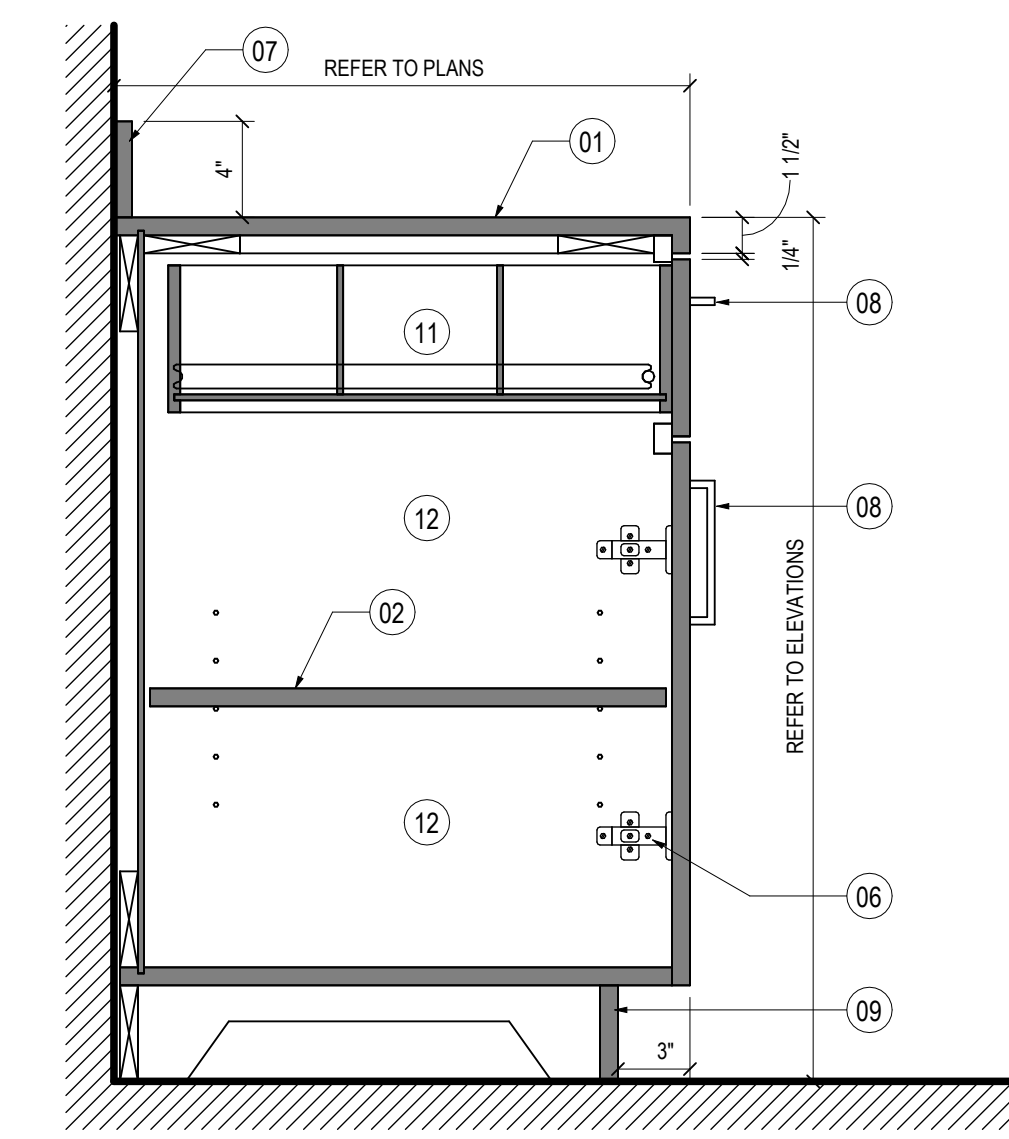

03 COUNTERTOP WITH ONE DRAWER
SCALE: 1 1/2" = 1'-0"

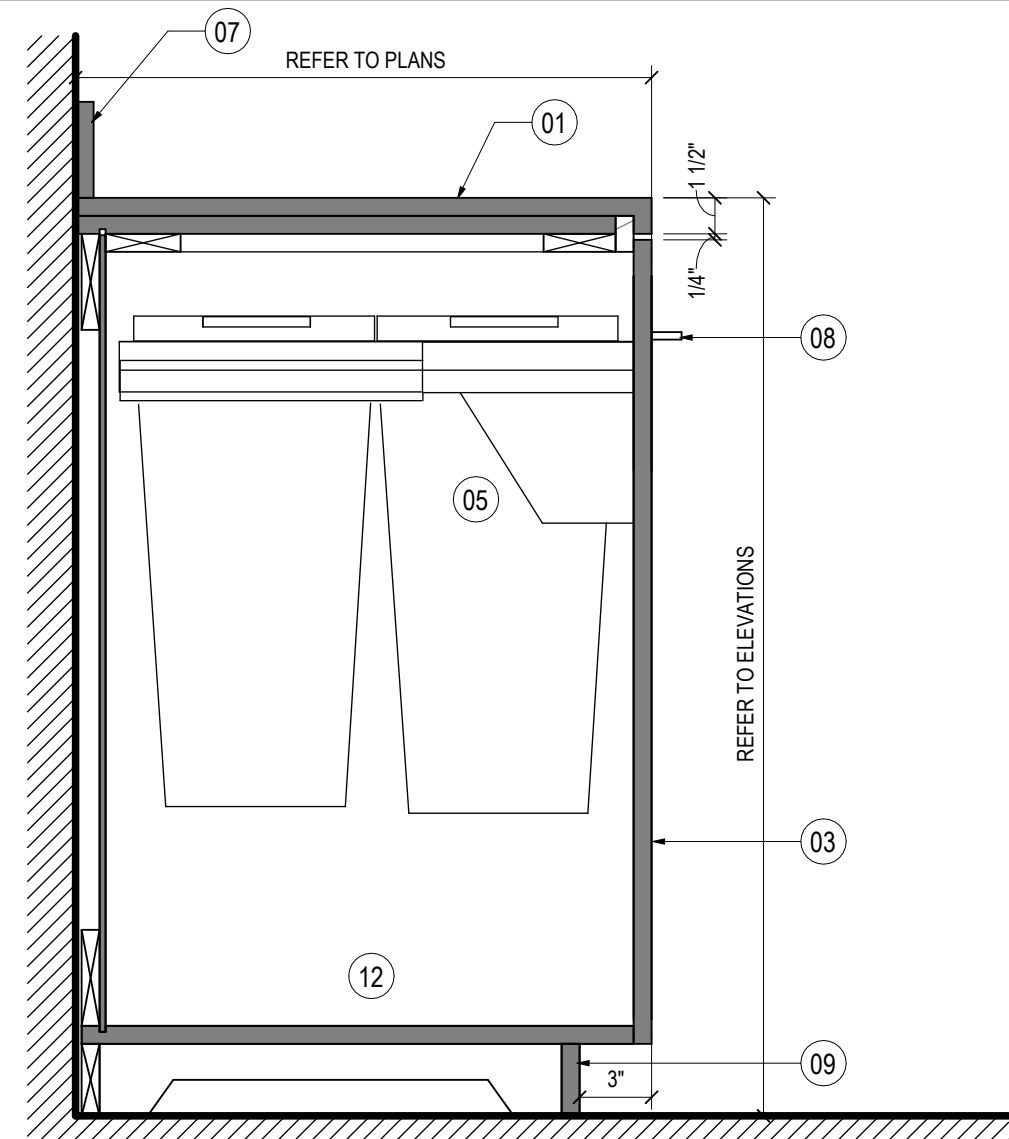

04 PULL-OUT TRASH CABINET
SCALE: 1 1/2" = 1'-0"

SHEET NOTES


- 01 COUNTERTOP AS SCHEDULED - SEE INTERIOR ELEVATIONS
- 02 ADJUSTABLE WHITE MELAMINE SHELVING
- 03 FRONT PANEL AS SCHEDULED
- 04 INTEGRAL TOE KICK - NOTCH AS REQUIRED TO ALLOW DOORS TO SWING OPEN
- 05 INTEGRATED DOUBLE WASTE BIN SYSTEM - HAFELE #50274.252 WITH OVERTRAVEL SLIDES
- 06 CONCEALED EUROPEAN HINGES - TYP.
- 07 BACKSLASH - SEE INTERIOR ELEVATIONS IF REQUIRED
- 08 DOOR PULL - BERENSON - CONTEMPORARY ADVANTAGE ONE #9012-4BPN-P
- 09 SCRIBE STRIP - BLACK PLASTIC LAMINATE - TYP.
- 10 PIPE INSULATION
- 11 REMOVABLE DRAWER DIVIDERS
- 12 WHITE MELAMINE INTERIOR SURFACE - TYP.
- 13 SINK AND FAUCET AS SCHEDULED
- 14 FILE CABINET DRAWER WITH HANGING RAILS
- 15 STAINLESS STEEL GROMET TRASH RING

MILLWORK NOTES

- A ANY SHELF EXCEEDING 36" IN WIDTH TO BE 1" THICK.
- B ALL DOOR AND DRAWER FRONTS TO BE 3/4" PARTICLE BOARD WITH PLASTIC LAMINATE (OR WOOD VENEER) ON 2 SIDES AND PLASTIC LAMINATE (OR WOOD VENEER) ON ALL 4 EDGES.
- C DOOR HINGES TO BE EQUAL TO BLUM 90A8530 & 91A8530 170 DEGREE HINGES, TYP. - USE THREE HINGES ON DOORS OVER 42" HIGH.
- D DRAWERS TO BE CONSTRUCTED USING 1/2" PARTICLE BOARD SIDES, FRONT, AND REAR PANELS WITH 1/4" LUALUN PLYWOOD BOTTOMS UNO. FRONT PANEL TO BE 3/4" PARTICLE BOARD.
- E DRAWERS TO BE ON SLIDES EQUAL TO BLUM 430E SERIES W/ FULL EXTENSION AND SOFT CLOSE.
- F ALL EXPOSED SURFACES OF CABINETS TO BE COVERED IN PLASTIC LAMINATE (OR WOOD VENEER) UNLESS NOTED OTHERWISE. CABINET INTERIORS TO BE MELAMINE, COLOR AS NOTED, COVERED PARTICLE BOARD UNLESS NOTED OTHERWISE.
- G ADJUSTABLE SHELF SUPPORT EQUAL TO BLUM NO. 34 0040
- H ALL PLASTIC LAMINATE MILLWORK COUNTERTOPS AND BACKSLASHES AT WET LOCATIONS TO BE PLASTIC LAMINATE OVER 3/4" THICK MARINE GRADE PLYWOOD, TYP.
- I HARDWARE TO INCLUDE PULLS, CONCEALED HINGES, HEAVY DUTY FULL EXTENSION DRAWER SLIDES, FULLY RECESSED CAM-TYPE LOCKS AND DRILLED HOLE AND CLIP SHELF SUPPORTS.
- J PROVIDE ADEQUATE SUPPORT FOR ALL COUNTERTOPS, EVEN WHEN NOT SPECIFICALLY SHOWN IN ELEVATIONS. ALL EXPOSED SUPPORTS SHALL MATCH FINISHED MATERIAL.
- K MILLWORK MATERIAL QUALITY AND CONSTRUCTION TO BE IN ACCORDANCE WITH AWI STANDARDS FOR PREMIUM GRADE ASSEMBLY AND INSTALLATION.
- L INSTALLED MILLWORK SHALL BE SCRIBED TO ADJACENT FINISHED SURFACES. FILLER PANELS SHALL NOT BE LARGER THAN 1'.



4539 HEDGEMORE DRIVE, SUITE 101
CHARLOTTE NC 28209
704.890.2553
WWW.OSSASTUDIO.COM

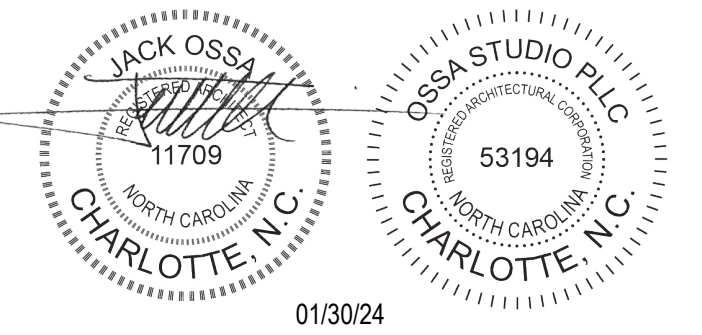

PROJECT TEAM

General Contractor
ECCLESIA CONSTRUCTION
www.ecclesiainc.com
803.327.5670

Civil Engineering
HILLIARD ENGINEERING, PLLC
www.hillardspp.com
919.352.2834

Structural Engineering
PROVIDENCE PARTNERS
www.providencepartnersinc.com
704.266.6621

Mechanical, Electrical, Plumbing & Fire Protection
ENGINEERING
www.engineering.com
704.287.2193

Date	Description
01/30/24	FOR CONSTRUCTION

Project Name



community church
making church come alive
658 GRAHAM ROAD
SANFORD NC 27311

Client

3D COMMUNITY CHURCH

Project Number

23024.00


Description

MILLWORK DETAILS


Scale

As indicated


A05.10

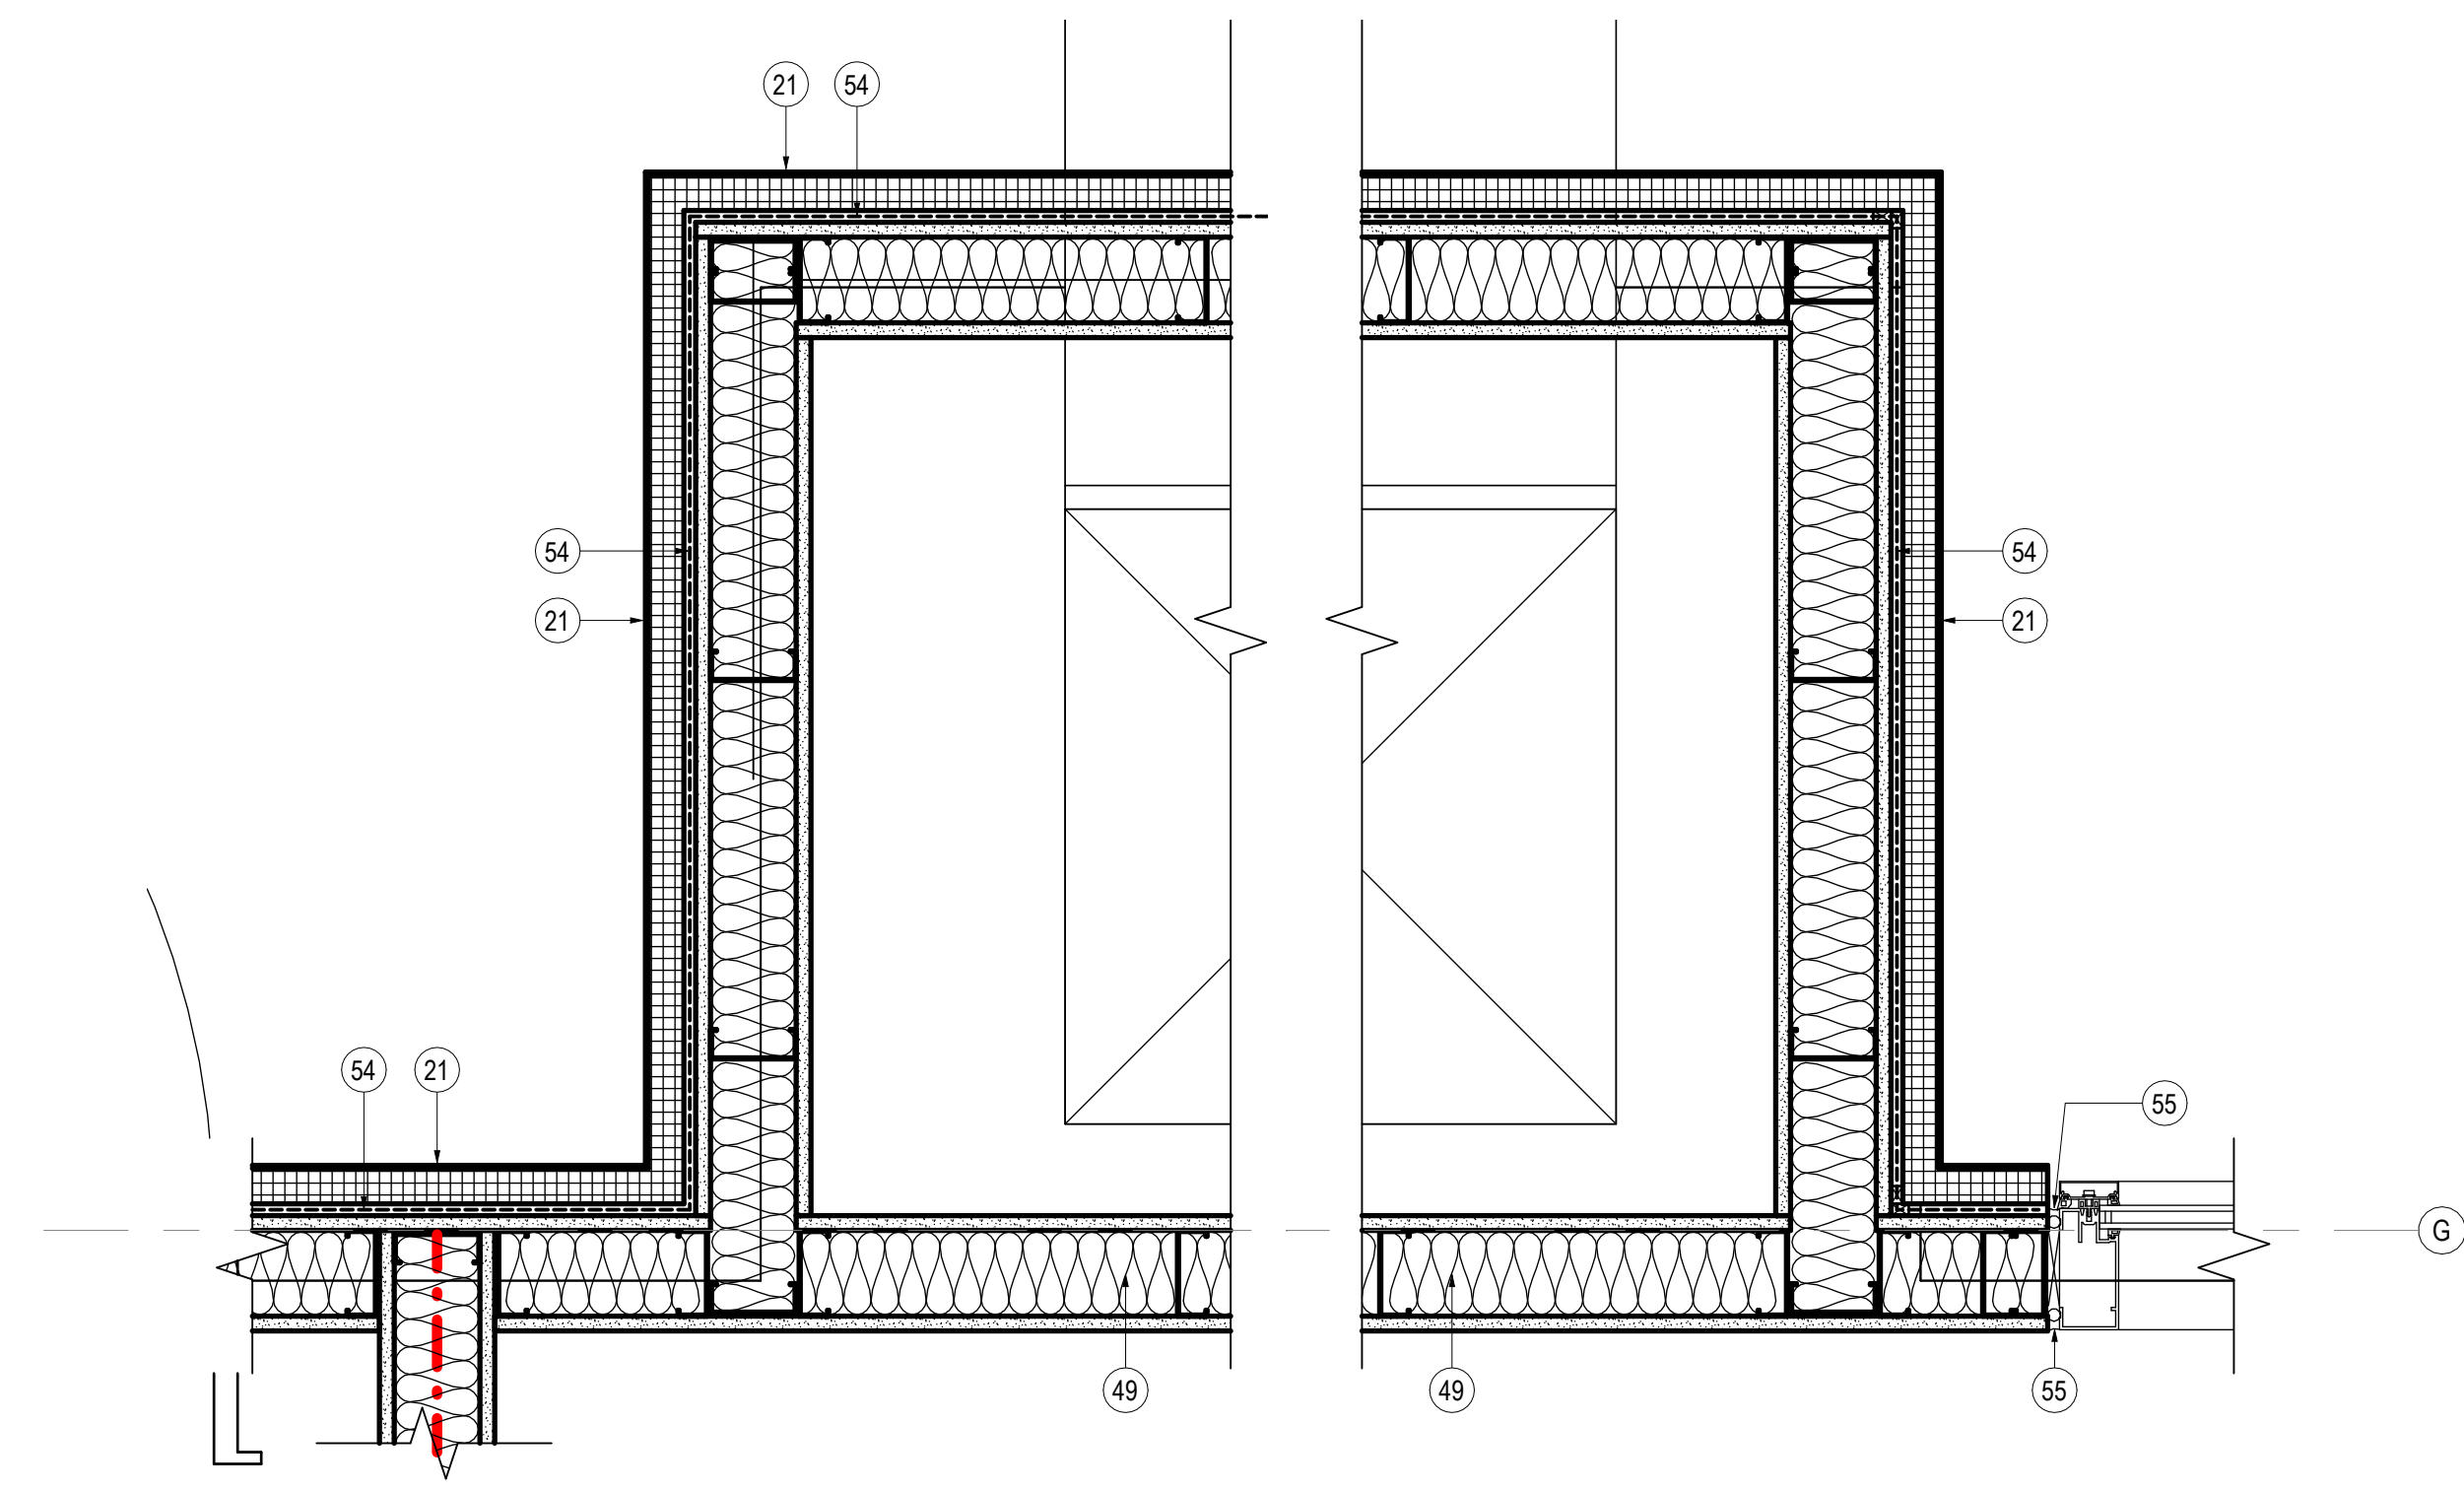


03 HVAC SHAFT
SCALE: 1 1/2" = 1'-0"

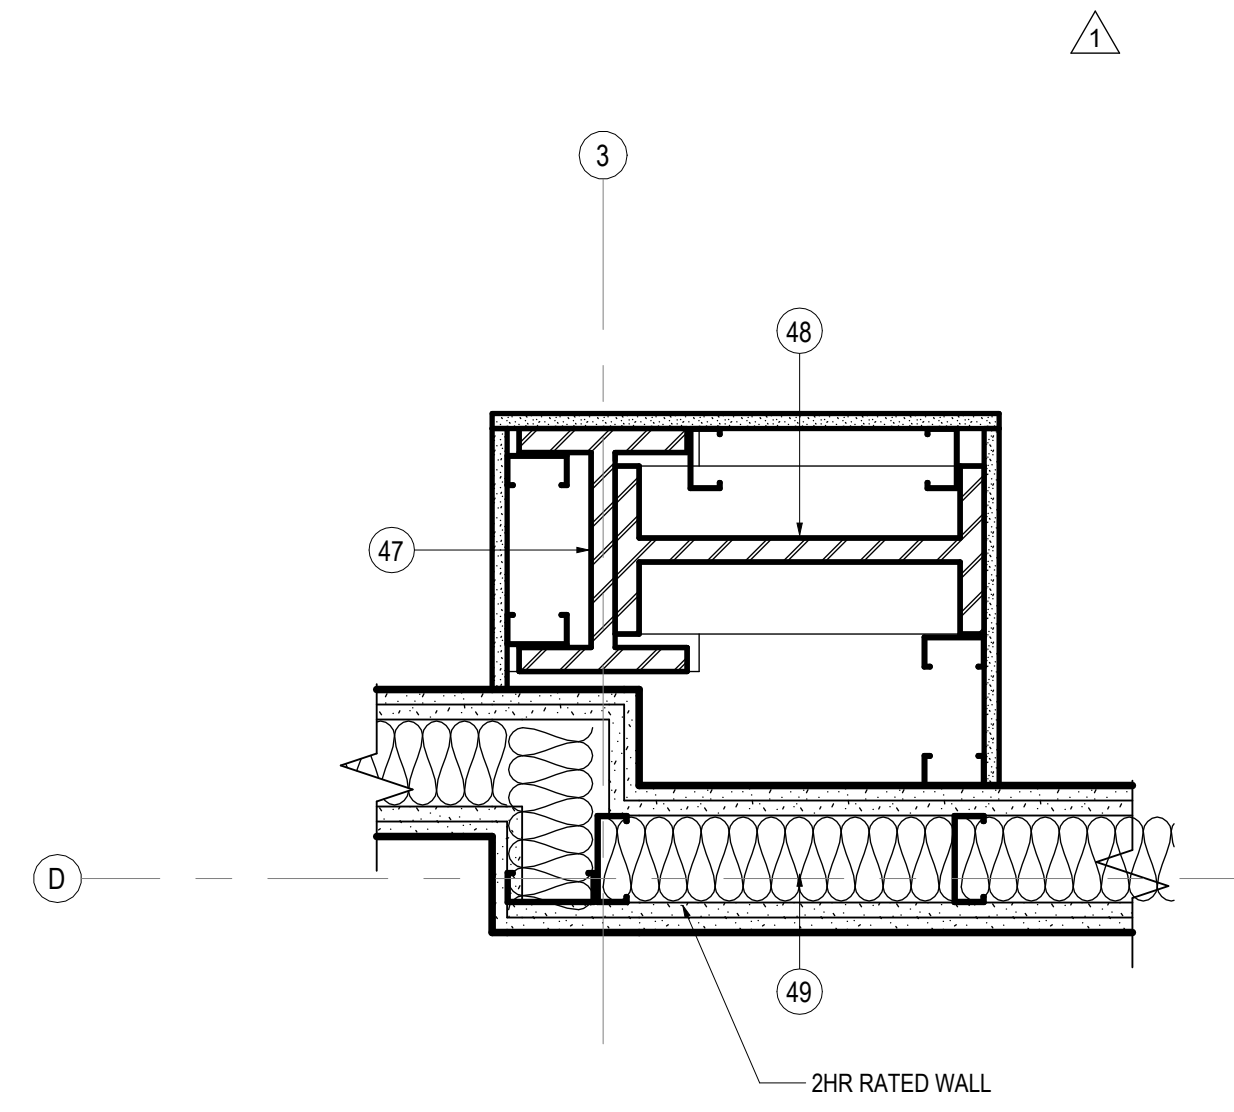


02 COLUMN ENCLOSURE
SCALE: 1 1/2" = 1'-0"

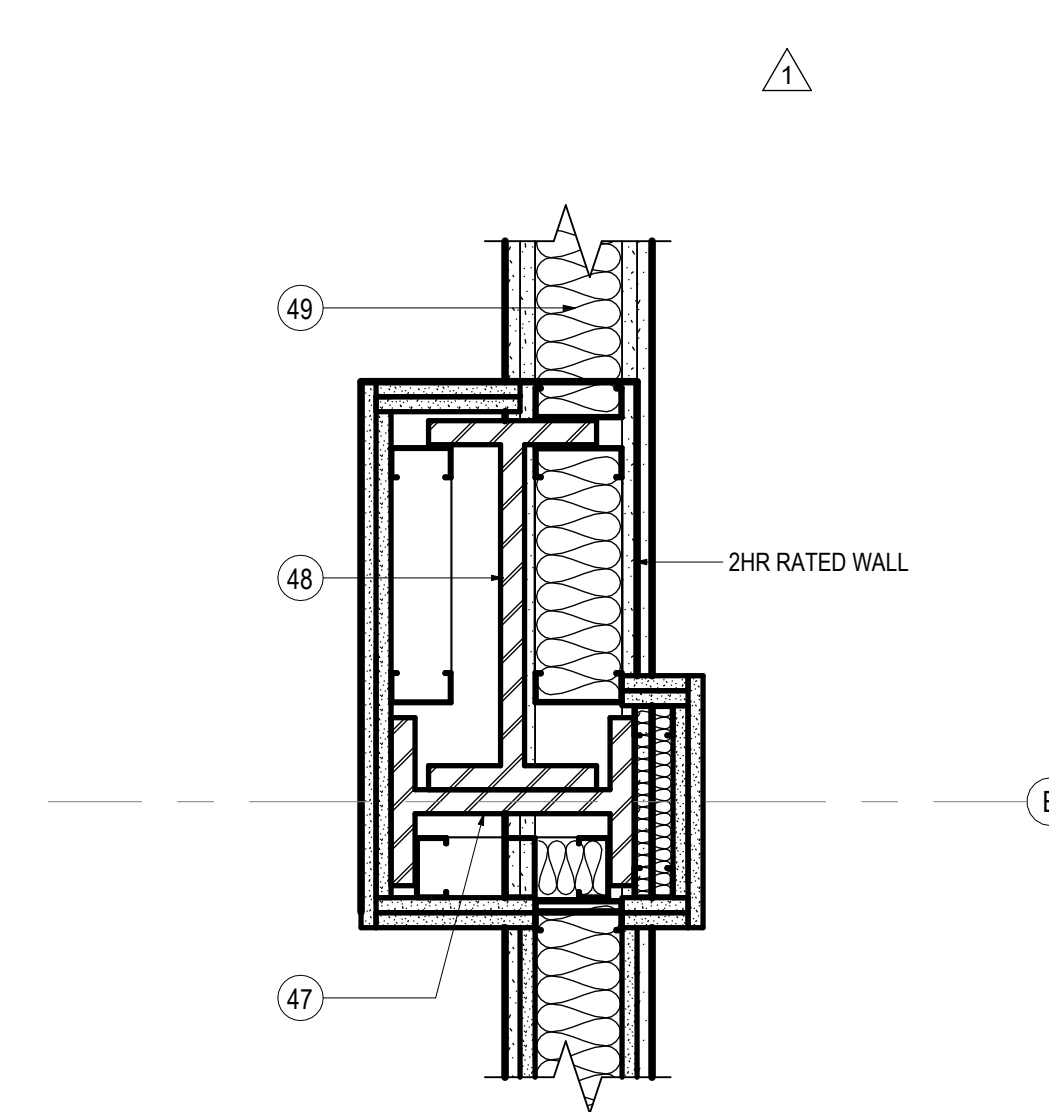

01 COLUMN ENCLOSURE
SCALE: 1 1/2" = 1'-0"

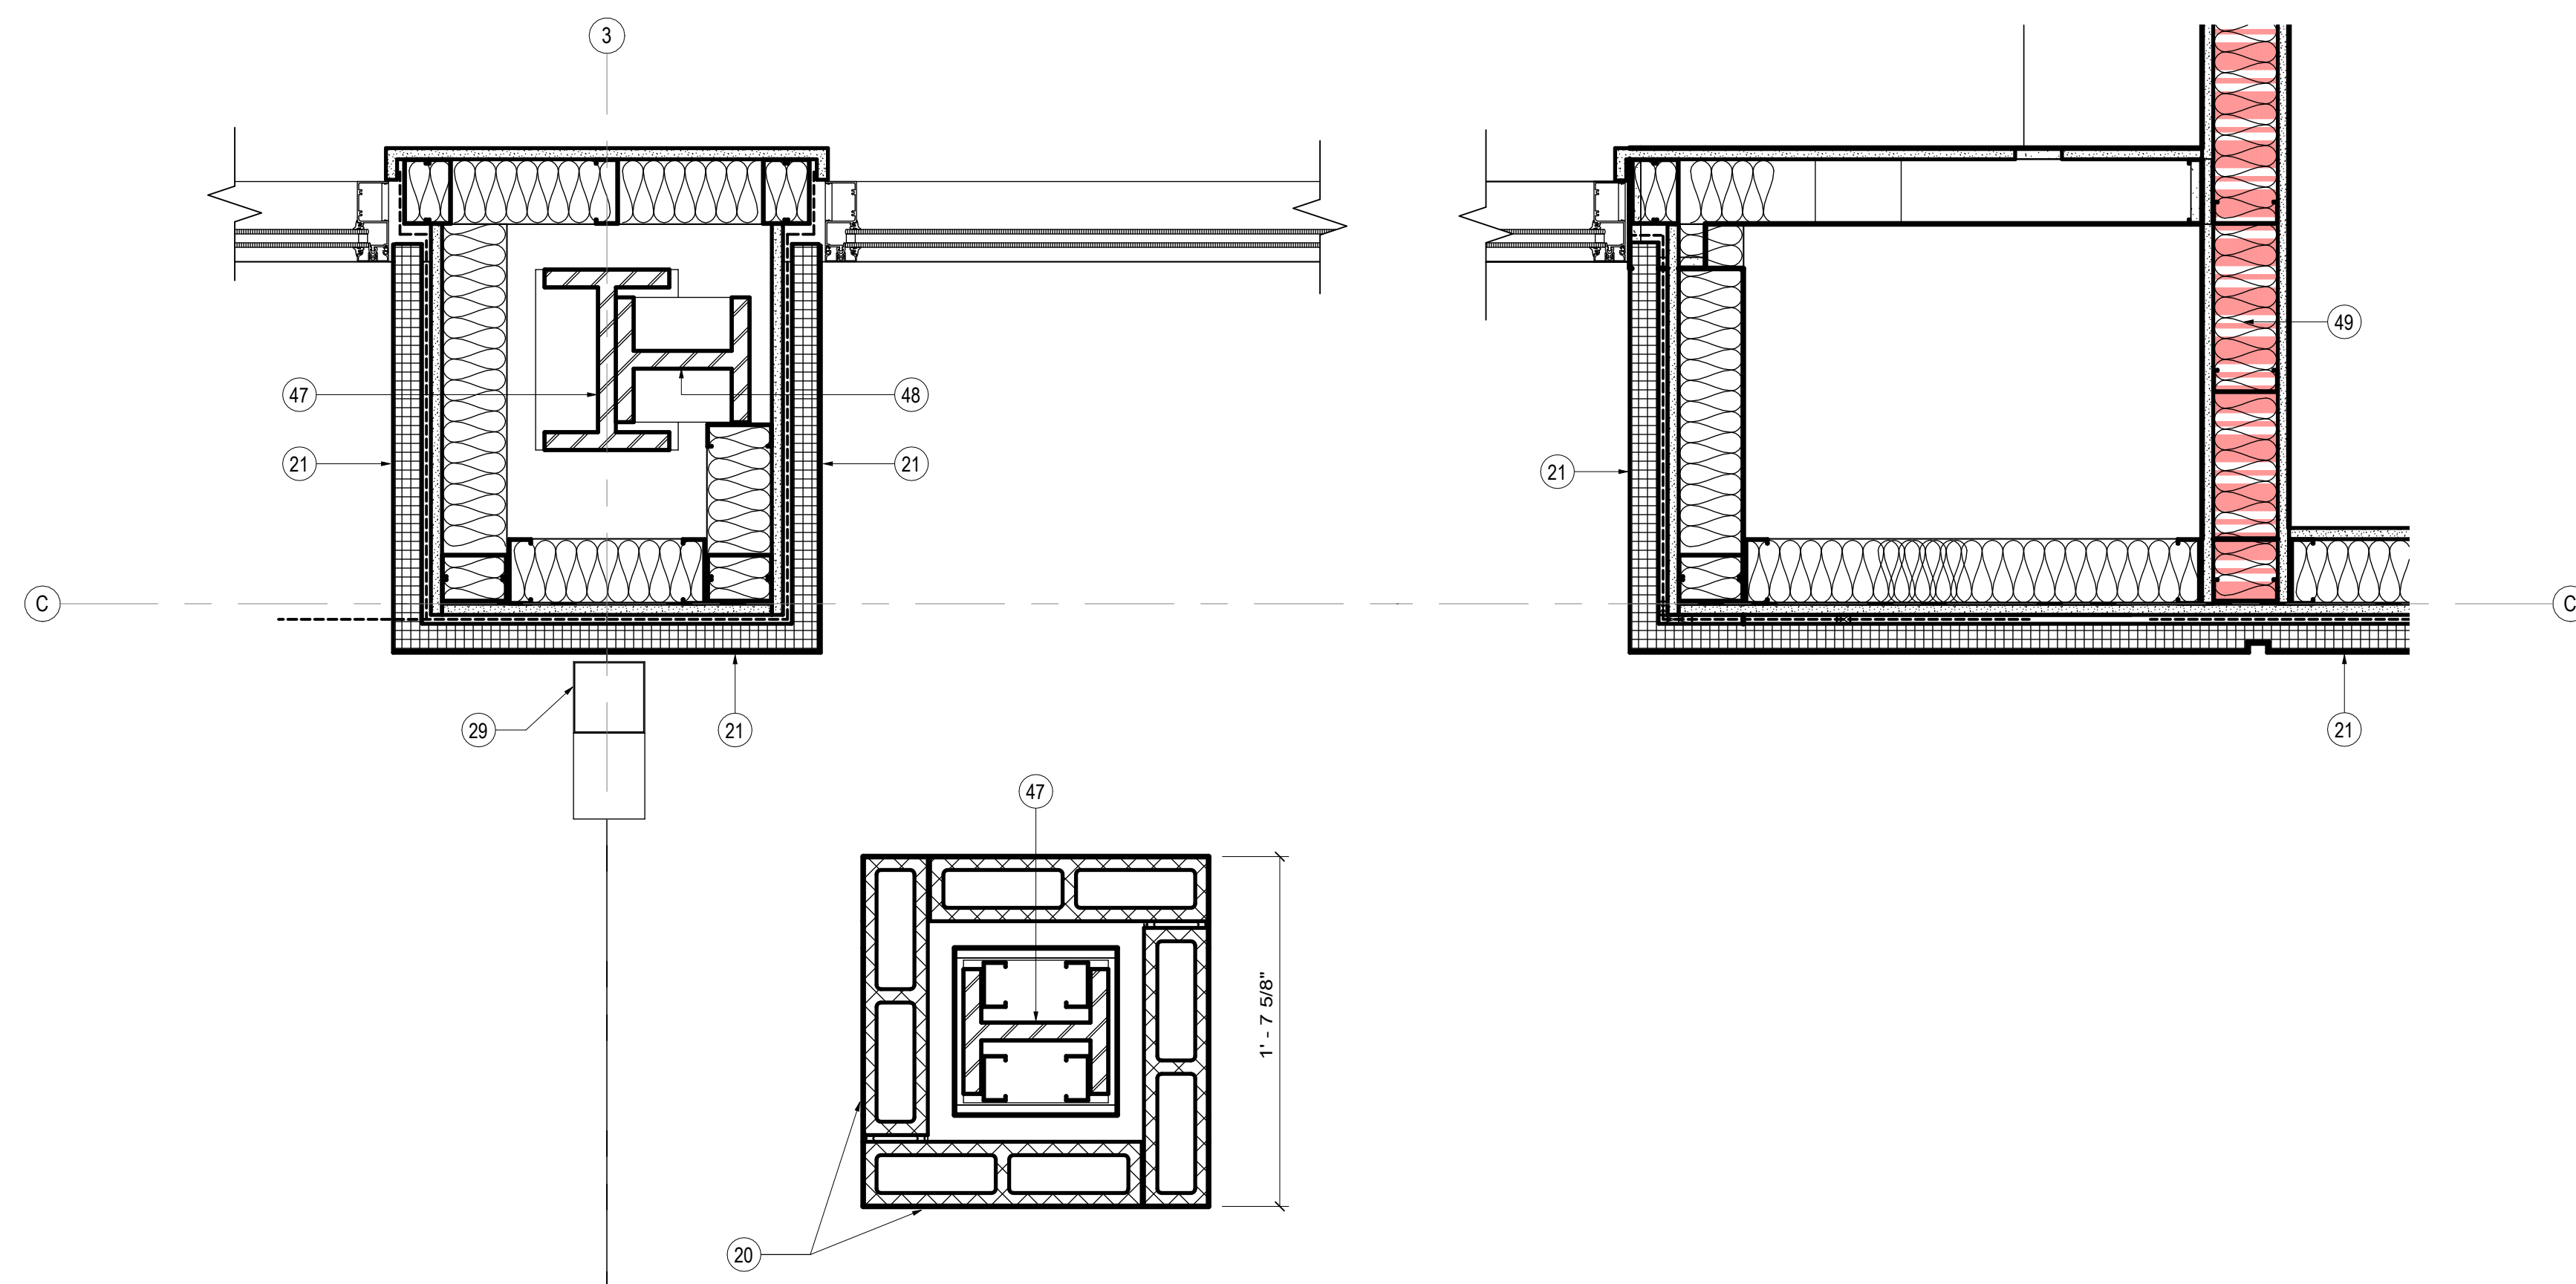

10 FRONT ENTRY AT THE NARTHEX
SCALE: 1 1/2" = 1'-0"

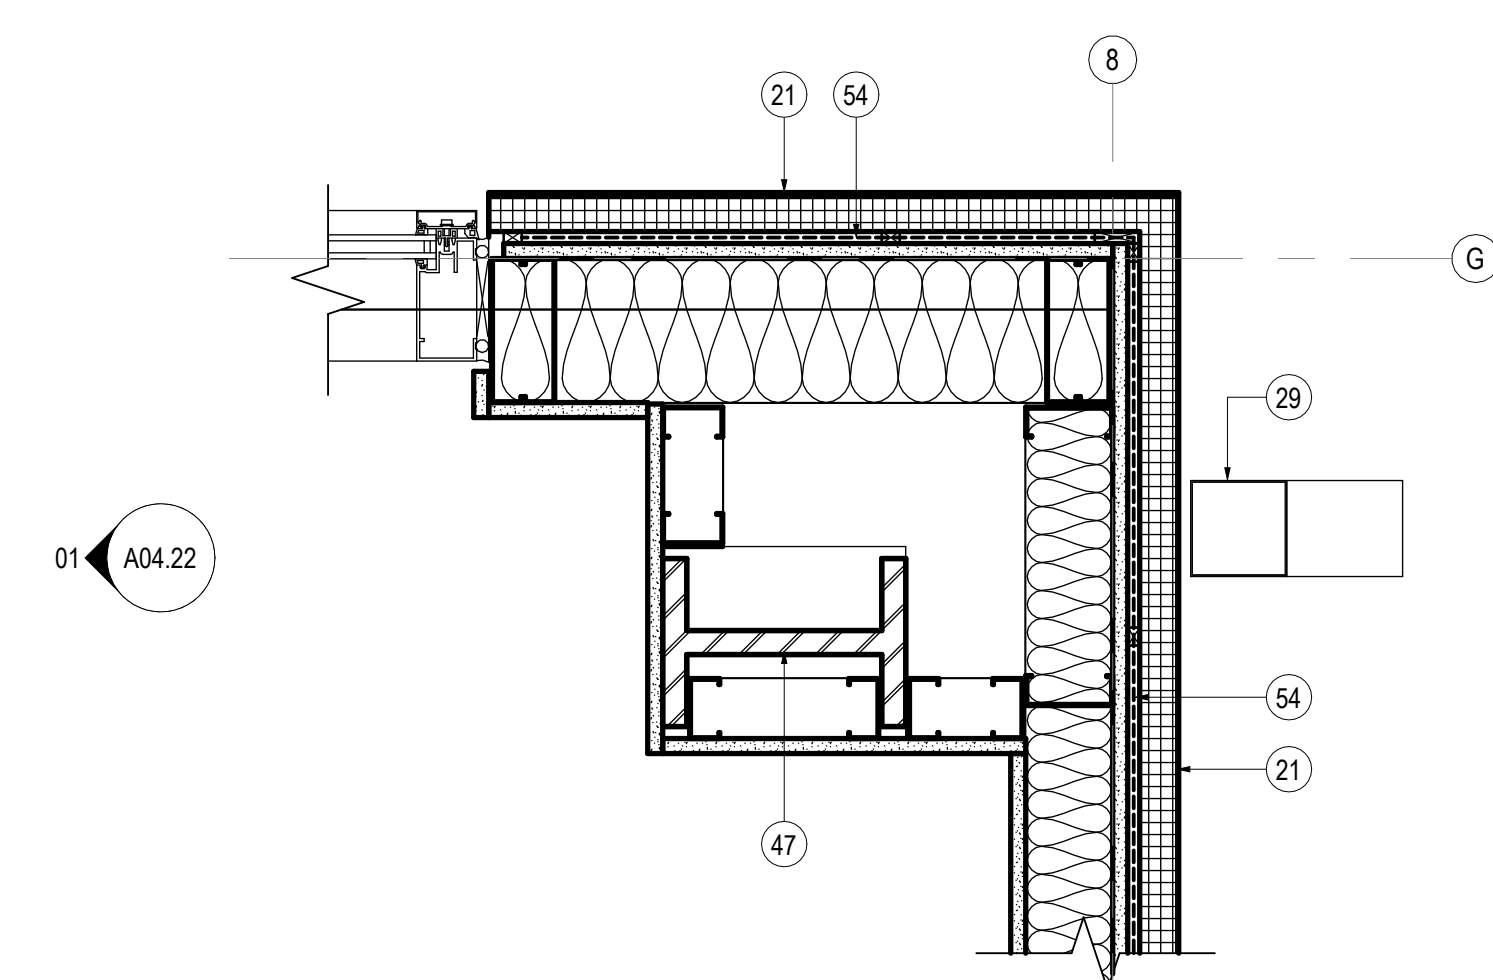


08 COLUMN ENCLOSURE
SCALE: 1 1/2" = 1'-0"

SHEET NOTES

- 01 STRUCT. STL. - PAINT BLACK WHERE EXPOSED
- 02 GWB AND MDF STAGE APRON - PAINT BLACK
- 03 ELEVATED FLOOR w/ LVT FINISH ON 1/4" T. TEMPERED MASONITE, 1/2" HOMASOTE, AND 3/4" FRP PLYWOOD ON MTL. STUD FRAMING (SEE STRUCT.)
- 04 SLOPED GWB "CLOUD" AT UNDERSIDE OF STL. STRUCT.
- 07 MTL. PANEL CEILING SYSTEM MTL. BLDG. MANUF. LIGHTING TRUSS (SEE STRUCT.)
- 08 RAMP w/ LVT FINISH ON (2) LAYERS 3/4" FRP PLYWOOD ON MTL. STUD FRAMING (SEE STRUCT.)
- 09 STAIR w/ LVT FINISH ON (2) LAYERS 3/4" FRP PLYWOOD ON MTL. STUD FRAMING (SEE STRUCT.)
- 11 GWB CONTROL JOINT
- 12 EXPOSED ROOF INSULATION
- 13 MTL. Z PURLIN (TYP.)
- 14 SUSPENDED PROJECTION SCREEN
- 15 LED CYLINDER PENDANT LIGHT FIXTURE (TYP.) (SEE ELEC.)
- 16 LED WALL SCONCE LIGHT FIXTURE (TYP.) (SEE ELEC.)
- 17 RECTANGULAR BEAM LED LIGHT FIXTURE (TYP.) (SEE ELEC.)
- 18 RECESSED LED LIGHT FIXTURE (TYP.) (SEE ELEC.)
- 20 8"x16"x4" CMU (PROVIDE TIES PER MANUF. REQS.) ON MTL. STUD FURRING AT STL. COLUMN
- 21 E.I.F.S. - 1-1/2" R-7.5 RIGID INSUL. AND 5/8" SHEATHING ON 3-5/8" MTL. STUD FRAMING W/ R-13 BLANKET INSUL.
- 22 REVEAL (TYP.)
- 23 8"x16"x4" CMU (PROVIDE TIES PER MANUF. REQS.) W/ 1-1/2" AIR SPACE, 2" RIGID INSUL., AND 5/8" SHEATHING ON 3-5/8" MTL. STUD FRAMING
- 24 STANDING SEAM MTL. ROOF (OWNER FURNISHED)
- 25 CONT. R-11 VINYL-FACED BLANKET INSUL. ON R-3 THERMAL SPACER BLOCKS (THERMAL SPACER BLOCKS TYP. AT EA. PURLIN)
- 26 R-19 FIBERGLASS BLANKET INSUL. BET. PURLINS (PROVIDE LONGITUDINAL AND TRANSVERSE MTL. SUPPORT BANDING)
- 27 CONT. BLACK FIBER-REINFORCED VAPOR BARRIER MEMBRANE AT BOTTOM OF PURLINS
- 28 GUTTER AND FLASHING BY MTL. BLDG. MANUF.
- 29 DOWNSPOUTS BY MTL. BLDG. MANUF. (TYP.)
- 31 3/8" T. x 24" D. CLEAR TEMPERED GLASS SHELVES (TYP.)
- 32 ADJUSTABLE SHELF BRACKETS & FLUSH-MOUNTED SHELF TRACKS (TYP.)
- 33 RAKES INSIDE WALL MOUNT EH COUNTER SUPPORT BRACKETS
- 34 OPEN TO UPPER ROOF ABOVE
- 35 MTL. C PURLIN BY MTL. BLDG. MANUF.
- 36 PRE-FIN. COUNTER FLASHING
- 37 TIE-IN TRIM BY MTL. BLDG. MANUF.
- 38 BACK-UP PLATE BY MTL. BLDG. MANUF.
- 39 OUTSIDE MTL. CLOSURE BY MTL. BLDG. MANUF.
- 41 STL. SPANDREL ANGLE AT BOTTOM OF MTL. Z PURLINS BY MTL. BLDG. MANUFACTURER
- 42 COMPRESSIBLE FILLER
- 43 NEW CONC. SIDEWALK
- 44 ALUM. DOOR AS SCHEDULED
- 45 DOOR THRESHOLD AS SCHEDULED - SET ON FULL BED OF MASTIC
- 46 TURNED-DOWN CONC. SLAB (SEE STRUCT.)
- 47 STRUCT. STL. COLUMN
- 48 STRUCT. STL. MOMENT FRAME - PAINT BLACK WHERE EXPOSED
- 49 SOUND ATTENUATION BLANKET (TYP.)
- 51 LINEAR SLOT RETURN (SEE MECH.)
- 52 MTL. SUPPORT BANDING - SPACE AS DIMENSIONED ON ENLARGED RCP (TYP.)
- 53 UNHINGED / RECESSED KNOXBOX (ALUM. FIN.)
- 54 FLUID-APPLIED AIR BARRIER MEMBRANE
- 55 JOINT SEALANT AND BACKER ROD
- 56 ALUM. STOREFRONT SYSTEM
- 57 E.I.F.S. - 1-1/2" R-7.5 RIGID INSUL. AND 5/8" SHEATHING ON 6" MTL. STUD FRAMING W/ R-13 BLANKET INSUL.
- 59 E.I.F.S. DRAINABLE TRACK
- 60 THRU-WALL STAINLESS STL. FLASHING W/ DRIP EDGE - FLASHED INTO AIR AND WATER BARRIER MEMBRANE
- 61 R-19 FIBERGLASS BLANKET INSUL. BET. MTL. STUD FRAMING (PROVIDE LONGITUDINAL AND TRANSVERSE MTL. SUPPORT BANDING)
- 62 STANDING SEAM MTL. ROOF (OWNER FURNISHED) ON 3/4" FRP PLYWOOD ON 6" MTL. STUD FRAMING
- 68 ROLLERSHADE AT EA. EXT. WINDOW (TYP.)
- 69 EAVE TRIM, PANEL CAP TRIM, AND FLASHING BY MTL. BLDG. MANUF.
- 70 MTL. STUD BRACE (SEE STRUCT.)



4539 HEDGEMORE DRIVE, SUITE 101
CHARLOTTE NC 28209
704.890.2653
WWW.OSSASTUDIO.COM

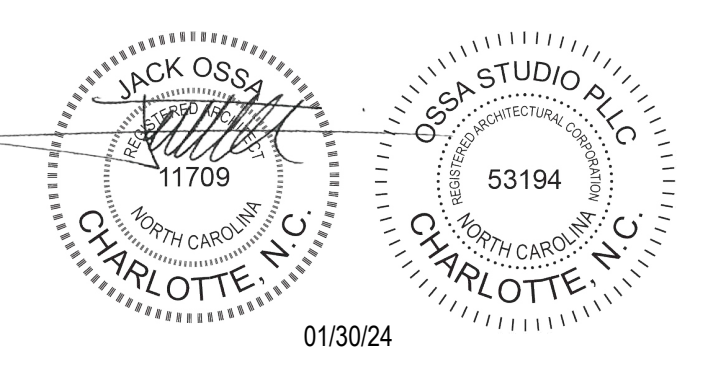

PROJECT TEAM

General Contractor
ECCLESIA CONSTRUCTION
www.ecclesiainc.com
803.327.5670

Civil Engineering
HILLIARD ENGINEERING, PLLC
www.iseasgrp.com
919.352.2834

Structural Engineering
PROVIDENCE PARTNERS
www.providencpartnersinc.com
704.266.6621

Mechanical, Electrical, Plumbing & Fire Protection
ENGINEERING
www.engineering.com
704.287.2193

Date	Description
01/30/24	FOR CONSTRUCTION
1 05/8/24	PERMIT REVIEW COMMENTS

Project Name

3D
community church
making church come alive
658 GRAHAM ROAD
SANFORD NC 27311

Client

3D COMMUNITY CHURCH

Project Number
23024.00

Description
PLAN DETAILS


Scale
1 1/2" = 1'-0"

A06.01



Ossa
STUDIO

4539 HEDGEMORE DRIVE, SUITE 101
CHARLOTTE NC 28209
704.890.2653
WWW.OSSASTUDIO.COM

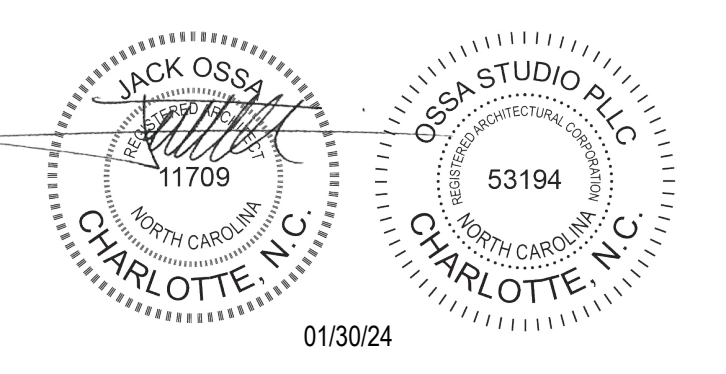

PROJECT TEAM

General Contractor
ECCLESIA CONSTRUCTION
www.ecclesiainc.com
803.327.5670

Civil Engineering
HILLIARD ENGINEERING, PLLC
www.hilliardepp.com
919.352.2834

Structural Engineering
PROVIDENCE PARTNERS
www.providencepartnersinc.com
704.266.6621

Mechanical, Electrical, Plumbing & Fire Protection
ENGINEERING
www.egengineering.com
704.287.2193

Date	Description
01/30/24	FOR CONSTRUCTION

Project Name

3D
community church
making church come alive

658 GRAHAM ROAD
SANFORD NC 27311

Client

3D COMMUNITY CHURCH

Project Number
23024.00


Description
SECTION DETAILS

Scale
1 1/2" = 1'-0"


A06.10

- 01 STRUCT. STL. - PAINT BLACK WHERE EXPOSED
- 02 GWB AND MDF STAGE APRON - PAINT BLACK
- 03 ELEVATED FLOOR w/ LVT FINISH ON 1/4" T. TEMPERED MASONITE, 1/2" HOMASOTE, AND 3/4" FRT PLYWOOD ON MTL. STUD FRAMING (SEE STRUCT.)
- 04 SLOPED GWB "CLOUD" AT UNDERSIDE OF STL. STRUCT.
- 07 MTL. PANEL CEILING SYSTEM MTL. BLDG. MANUF. LIGHTING TRUSS (SEE STRUCT.)
- 08 RAMP w/ LVT FINISH ON (2) LAYERS 3/4" FRT PLYWOOD ON MTL. STUD FRAMING (SEE STRUCT.)
- 10 STAIR w/ LVT FINISH ON (2) LAYERS 3/4" FRT PLYWOOD ON MTL. STUD FRAMING (SEE STRUCT.)
- 11 GWB CONTROL JOINT
- 12 EXPOSED ROOF INSULATION
- 13 MTL. Z PURLIN (TYP.)
- 14 SUSPENDED PROJECTION SCREEN
- 15 LED CYLINDER PENDANT LIGHT FIXTURE (TYP.) (SEE ELEC.)
- 16 LED WALL SCONCE LIGHT FIXTURE (TYP.) (SEE ELEC.)
- 17 RECTANGULAR BEAM LED LIGHT FIXTURE (TYP.) (SEE ELEC.)
- 18 RECESSED LED LIGHT FIXTURE (TYP.) (SEE ELEC.)
- 20 8"x16"x4" CMU (PROVIDE TIES PER MANUF. RECS.) ON MTL. STUD FURRING AT STL. COLUMN
- 21 E.F.S. - 1-1/2" R-7.5 RIGID INSUL. AND 5/8" SHEATHING ON 3-5/8" MTL. STUD FRAMING W/ R-13 BLANKET INSUL.
- 22 REVEAL (TYP.)
- 23 8"x16"x4" CMU (PROVIDE TIES PER MANUF. RECS.) W/ 1-1/2" AIR SPACE, 2" RIGID INSUL., AND 5/8" SHEATHING ON 3-5/8" MTL. STUD FRAMING W/ R-13 BLANKET INSUL.
- 24 STANDING SEAM MTL. ROOF (OWNER FURNISHED)
- 25 CONT. R-11 VINYL-FACED BLANKET INSUL ON R-3 THERMAL SPACER BLOCKS (THERMAL SPACER BLOCKS TYP. AT EA. PURLIN)
- 26 R-19 FIBERGLASS BLANKET INSUL. BET. PURLINS (PROVIDE LONGITUDINAL AND TRANSVERSE MTL. SUPPORT BANDING)
- 27 CONT. BLACK FIBER-REINFORCED VAPOR BARRIER MEMBRANE AT BOTTOM OF PURLINS
- 28 GUTTER AND FLASHING BY MTL. BLDG. MANUF.
- 29 DOWNSPOUTS BY MTL. BLDG. MANUF. (TYP.)
- 31 3/8" T. x 24" D. CLEAR TEMPERED GLASS SHELVES (TYP.)
- 32 ADJUSTABLE SHELF BRACKETS & FLUSH-MOUNTED SHELF TRACKS (TYP.)
- 33 RAKES INSIDE WALL MOUNT EH COUNTER SUPPORT BRACKETS
- 34 OPEN TO UPPER ROOF ABOVE
- 35 MTL. C PURLIN BY MTL. BLDG. MANUF.
- 36 PRE-FIN. COUNTER FLASHING
- 37 TIE-IN TRIM BY MTL. BLDG. MANUF.
- 38 BACK-UP PLATE BY MTL. BLDG. MANUF.
- 39 OUTSIDE MTL. CLOSURE BY MTL. BLDG. MANUF.
- 41 STL. SPANDREL ANGLE AT BOTTOM OF MTL. Z PURLINS BY MTL. BLDG. MANUFACTURER
- 42 COMPRESSIBLE FILLER
- 43 NEW CONC. SIDEWALK
- 44 ALUM. DOOR AS SCHEDULED
- 45 DOOR THRESHOLD AS SCHEDULED - SET ON FULL BED OF MASTIC
- 46 TURNED-DOWN CONC. SLAB (SEE STRUCT.)
- 47 STRUCT. STL. COLUMN
- 48 STRUCT. STL. MOMENT FRAME - PAINT BLACK WHERE EXPOSED
- 49 SOUND ATTENUATION BLANKET (TYP.)
- 51 LINEAR SLOT RETURN (SEE MECH.)
- 52 MTL. SUPPORT BANDING - SPACE AS DIMENSIONED ON ENLARGED RCP (TYP.)
- 53 UNHINGED / RECESSED KNOXBOX (ALUM. FIN.)
- 54 FLUID-APPLIED AIR BARRIER MEMBRANE
- 55 JOINT SEALANT AND BACKER ROD
- 56 ALUM. STOREFRONT SYSTEM
- 57 E.F.S. - 1-1/2" R-7.5 RIGID INSUL. AND 5/8" SHEATHING ON 6" MTL. STUD FRAMING W/ R-13 BLANKET INSUL.
- 59 E.F.S. DRAINABLE TRACK
- 60 THRU-WALL STAINLESS STL. FLASHING W/ DRIP EDGE - FLASHED INTO AIR AND WATER BARRIER MEMBRANE
- 61 R-19 FIBERGLASS BLANKET INSUL. BET. MTL. STUD FRAMING (PROVIDE LONGITUDINAL AND TRANSVERSE MTL. SUPPORT BANDING)
- 62 STANDING SEAM MTL. ROOF (OWNER FURNISHED) ON 3/4" FRT PLYWOOD ON 6" MTL. STUD FRAMING
- 68 ROLLERSHADE AT EA. EXT. WINDOW (TYP.)
- 69 EAVE TRIM, PANEL CAP TRIM, AND FLASHING BY MTL. BLDG. MANUF.
- 70 MTL. STUD BRACE (SEE STRUCT.)

01 NORTH WALL AT STAGE - Callout 1
SCALE: 1 1/2" = 1'-0"

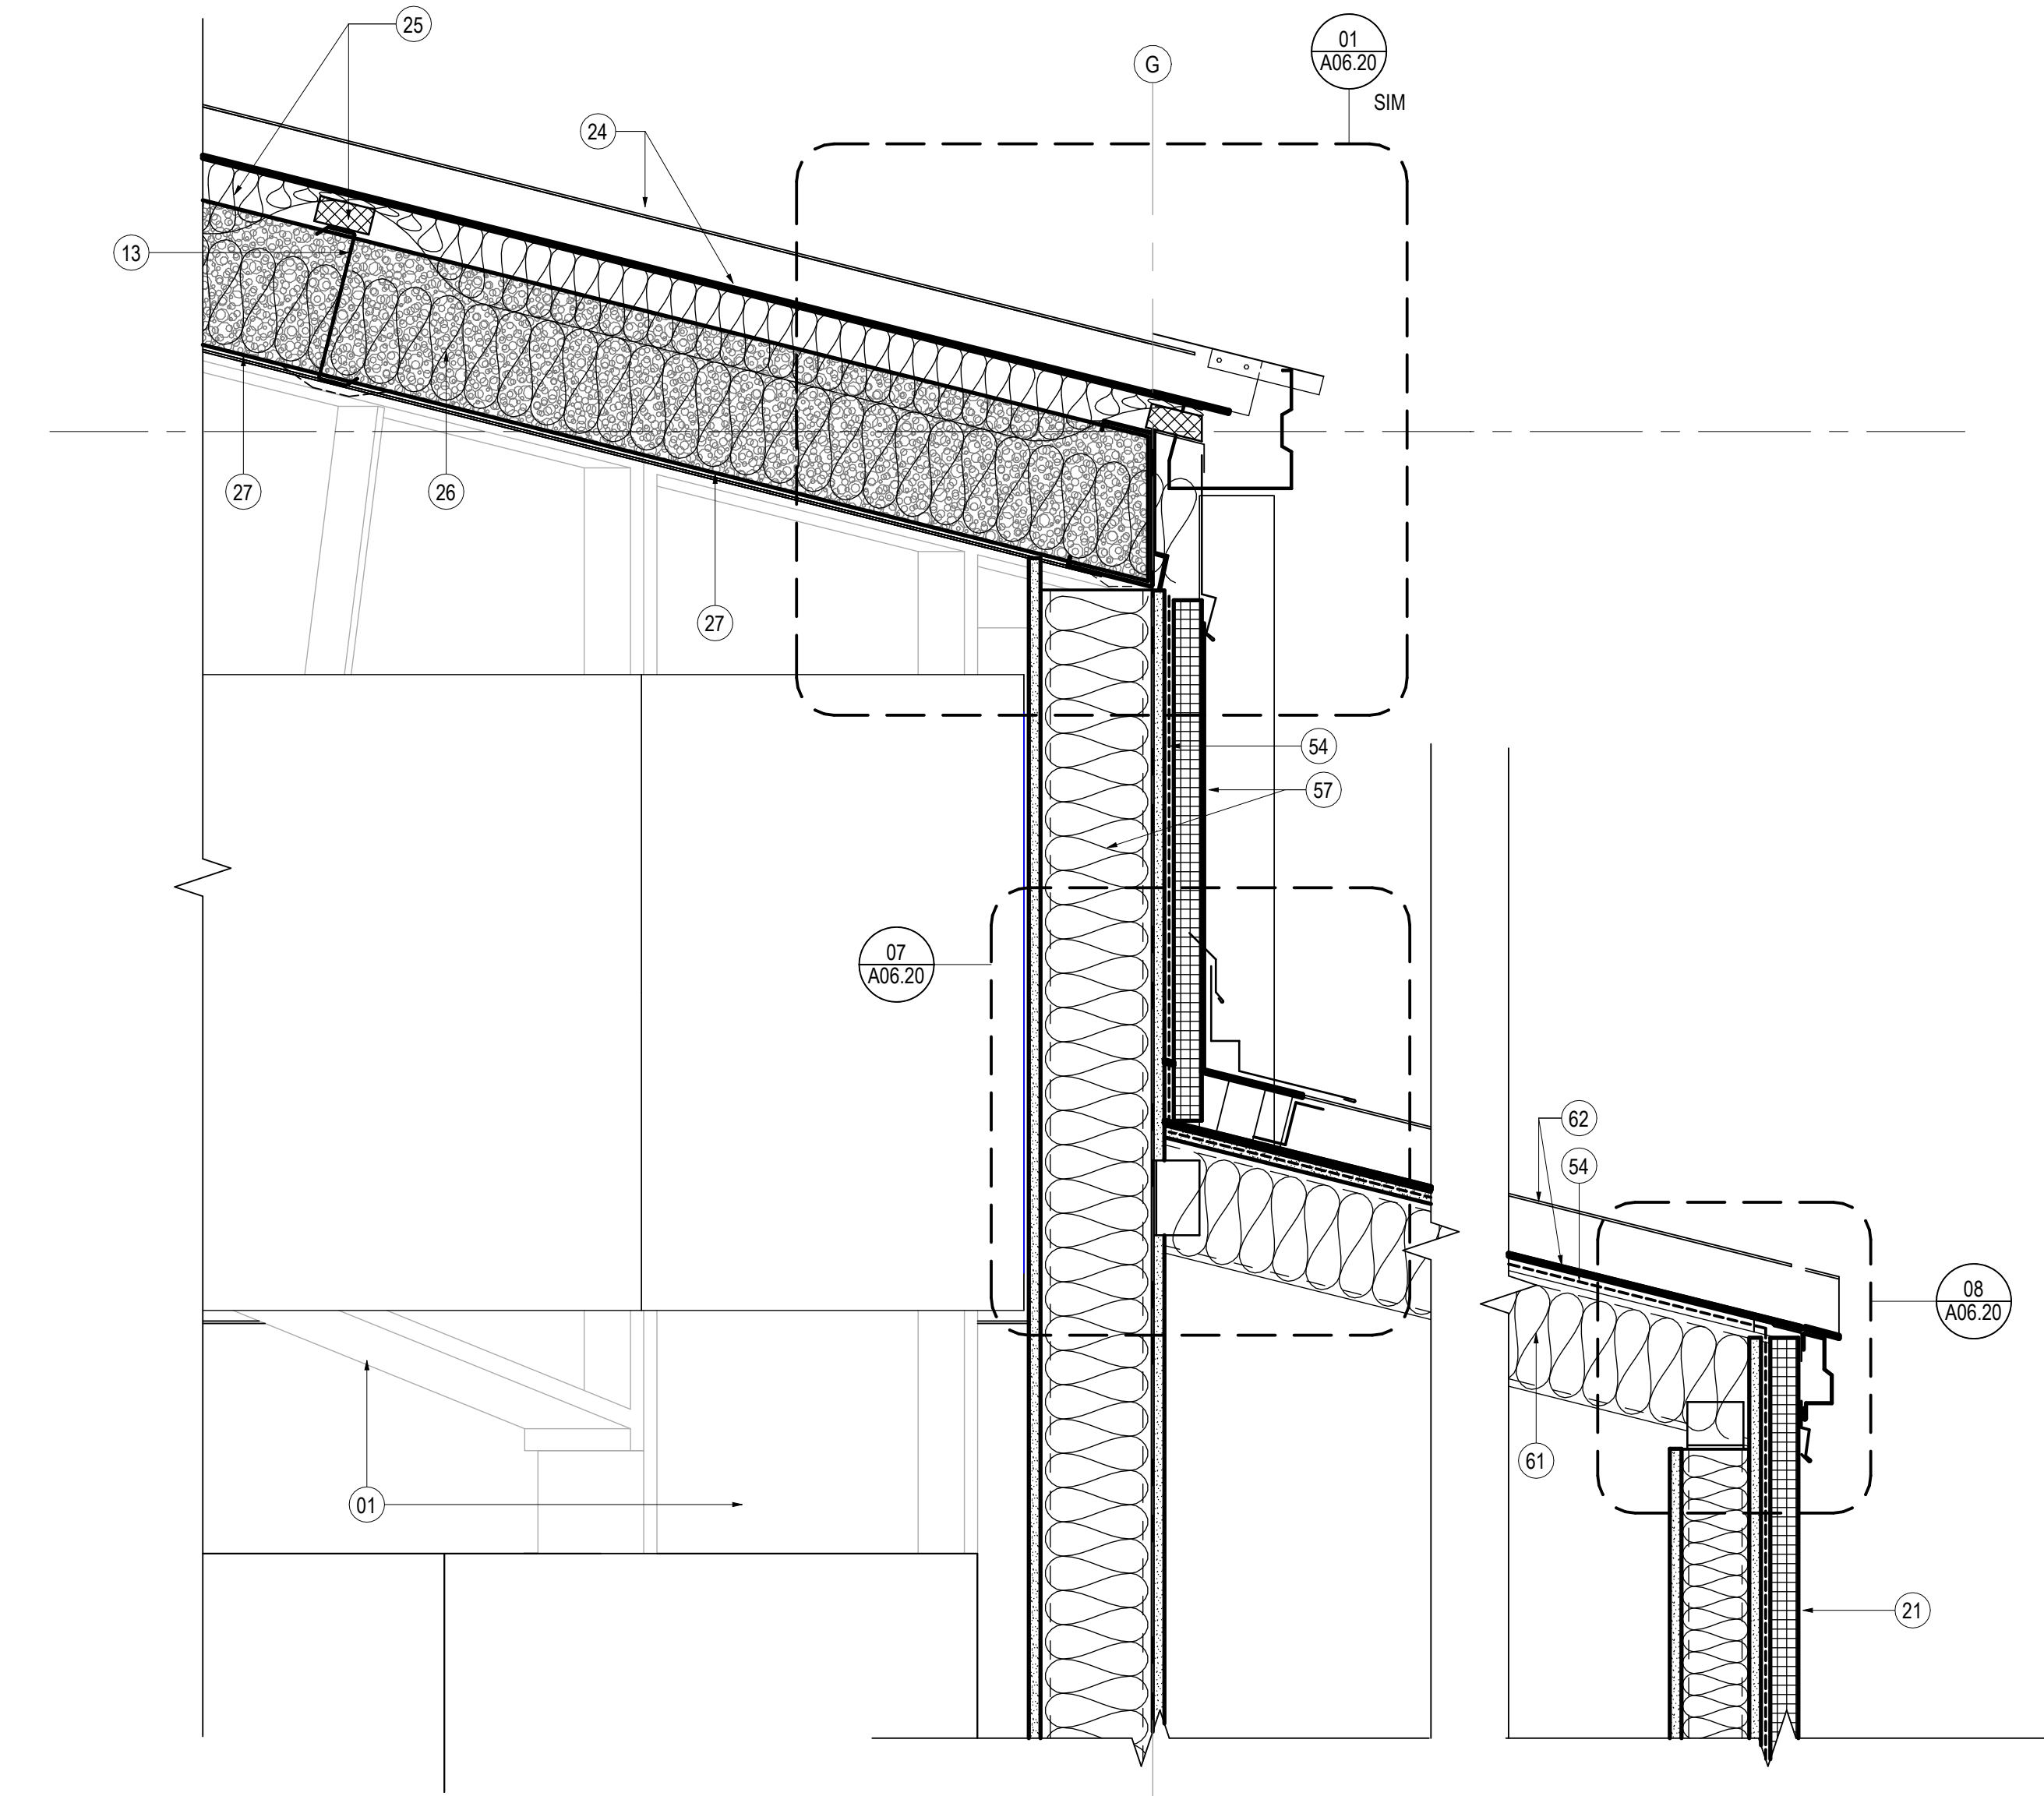


02 NORTH WALL AT HVAC CHASE - Callout 1
SCALE: 1 1/2" = 1'-0"

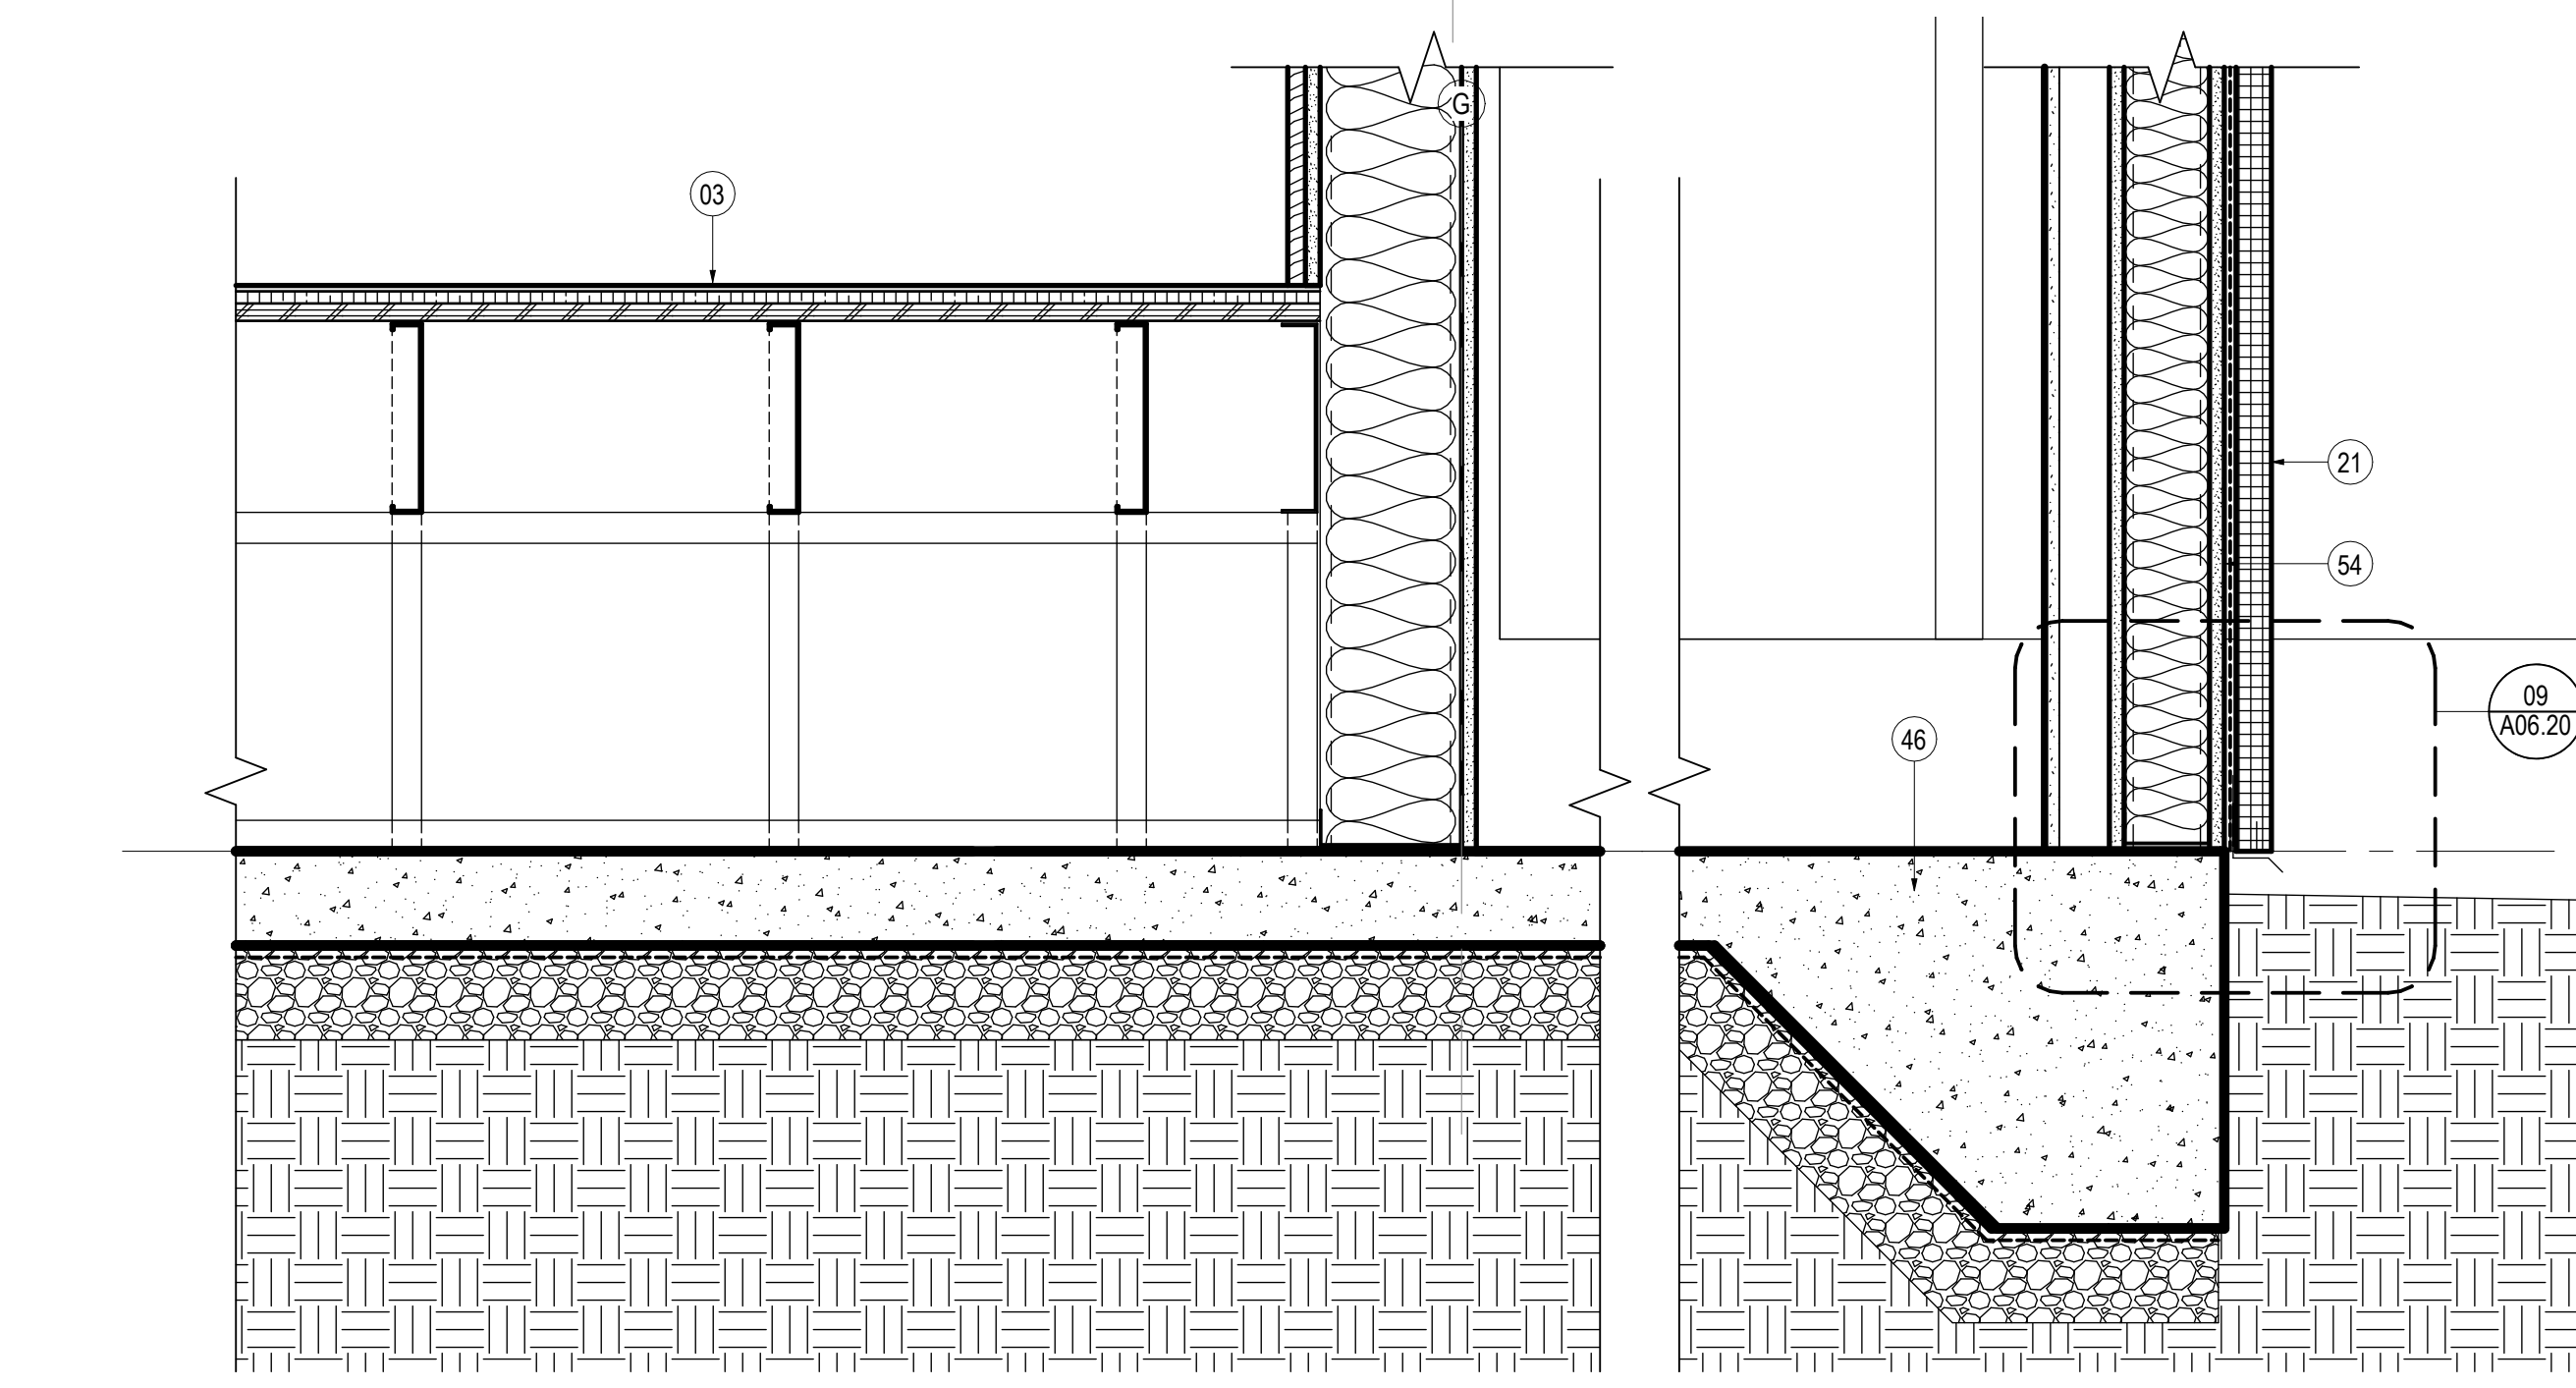


03 NORTH WALL AT HVAC CHASE - Callout 2
SCALE: 1 1/2" = 1'-0"




04 WALL AT NARTHEX / SANCTUARY - Callout 1
SCALE: 1 1/2" = 1'-0"

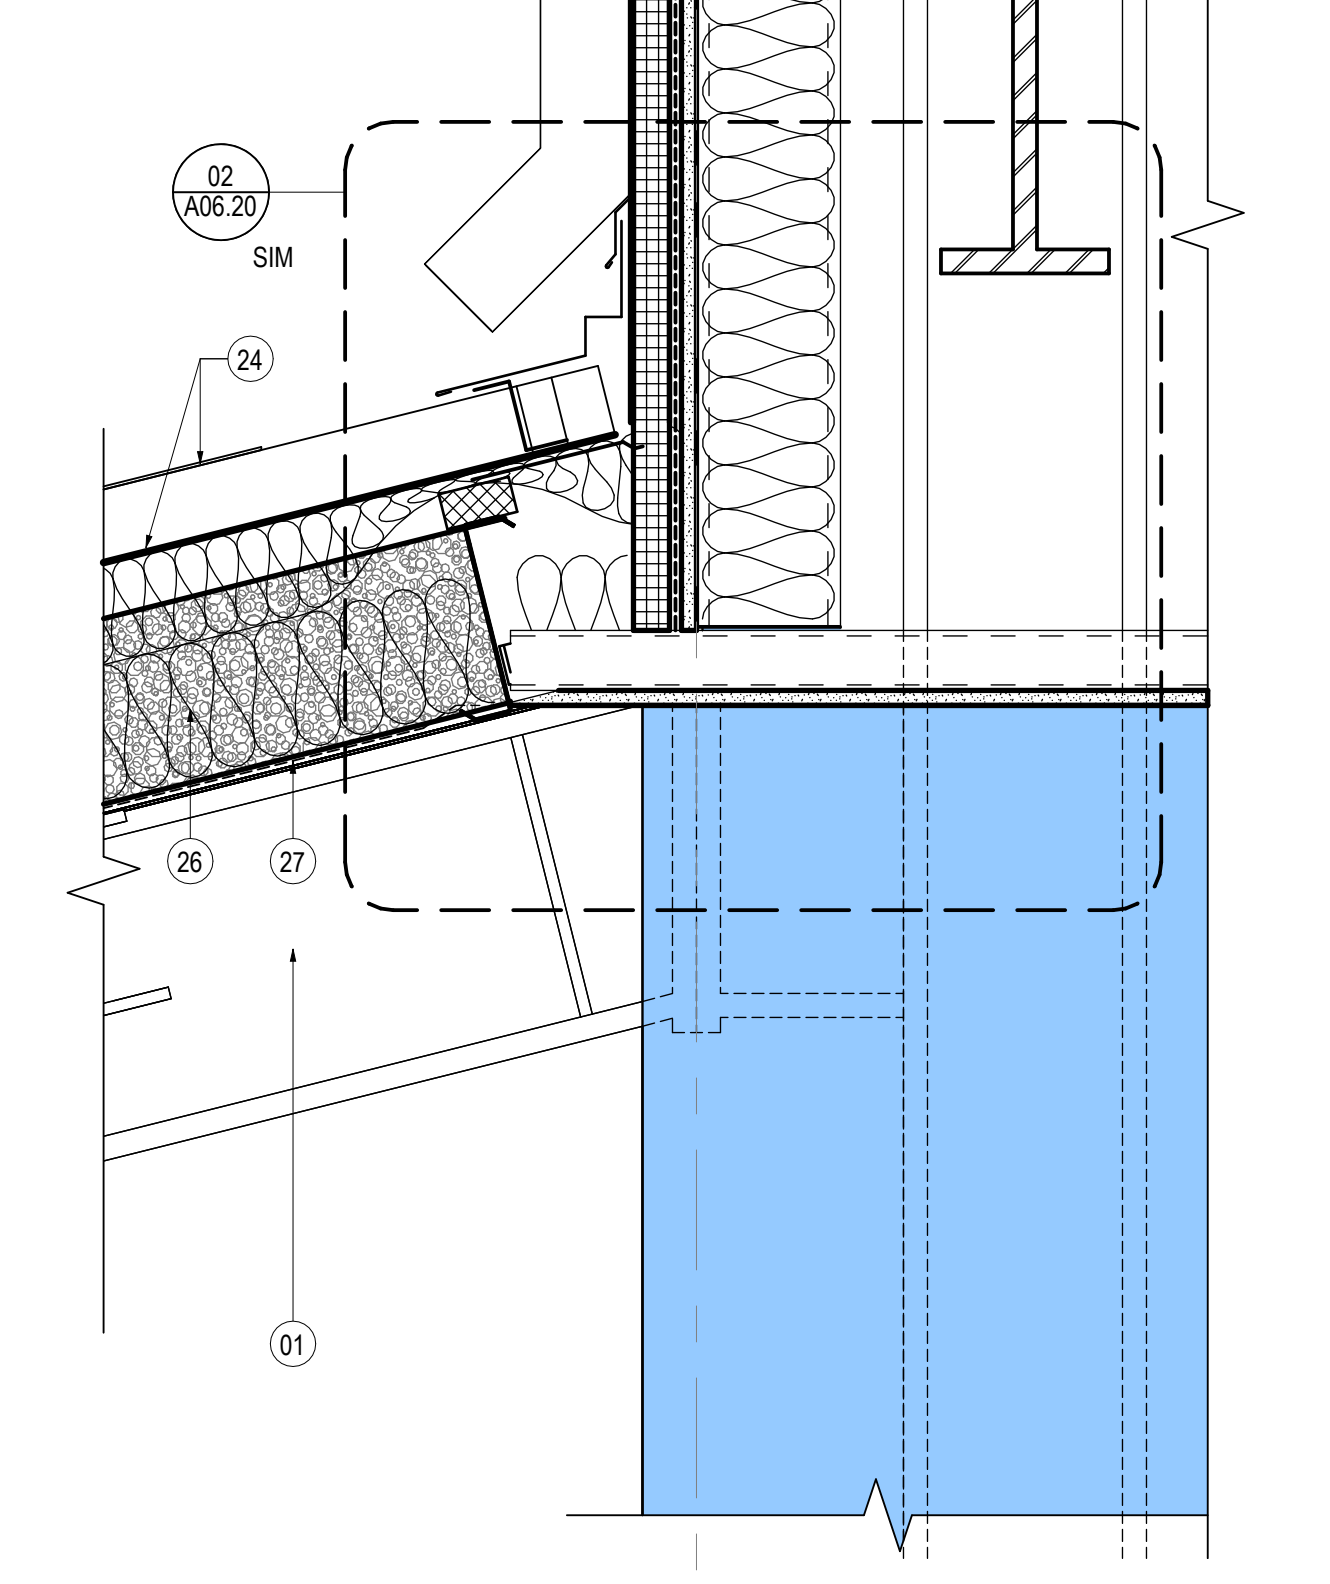


04 WALL AT NARTHEX / SANCTUARY - Callout 1
SCALE: 1 1/2" = 1'-0"

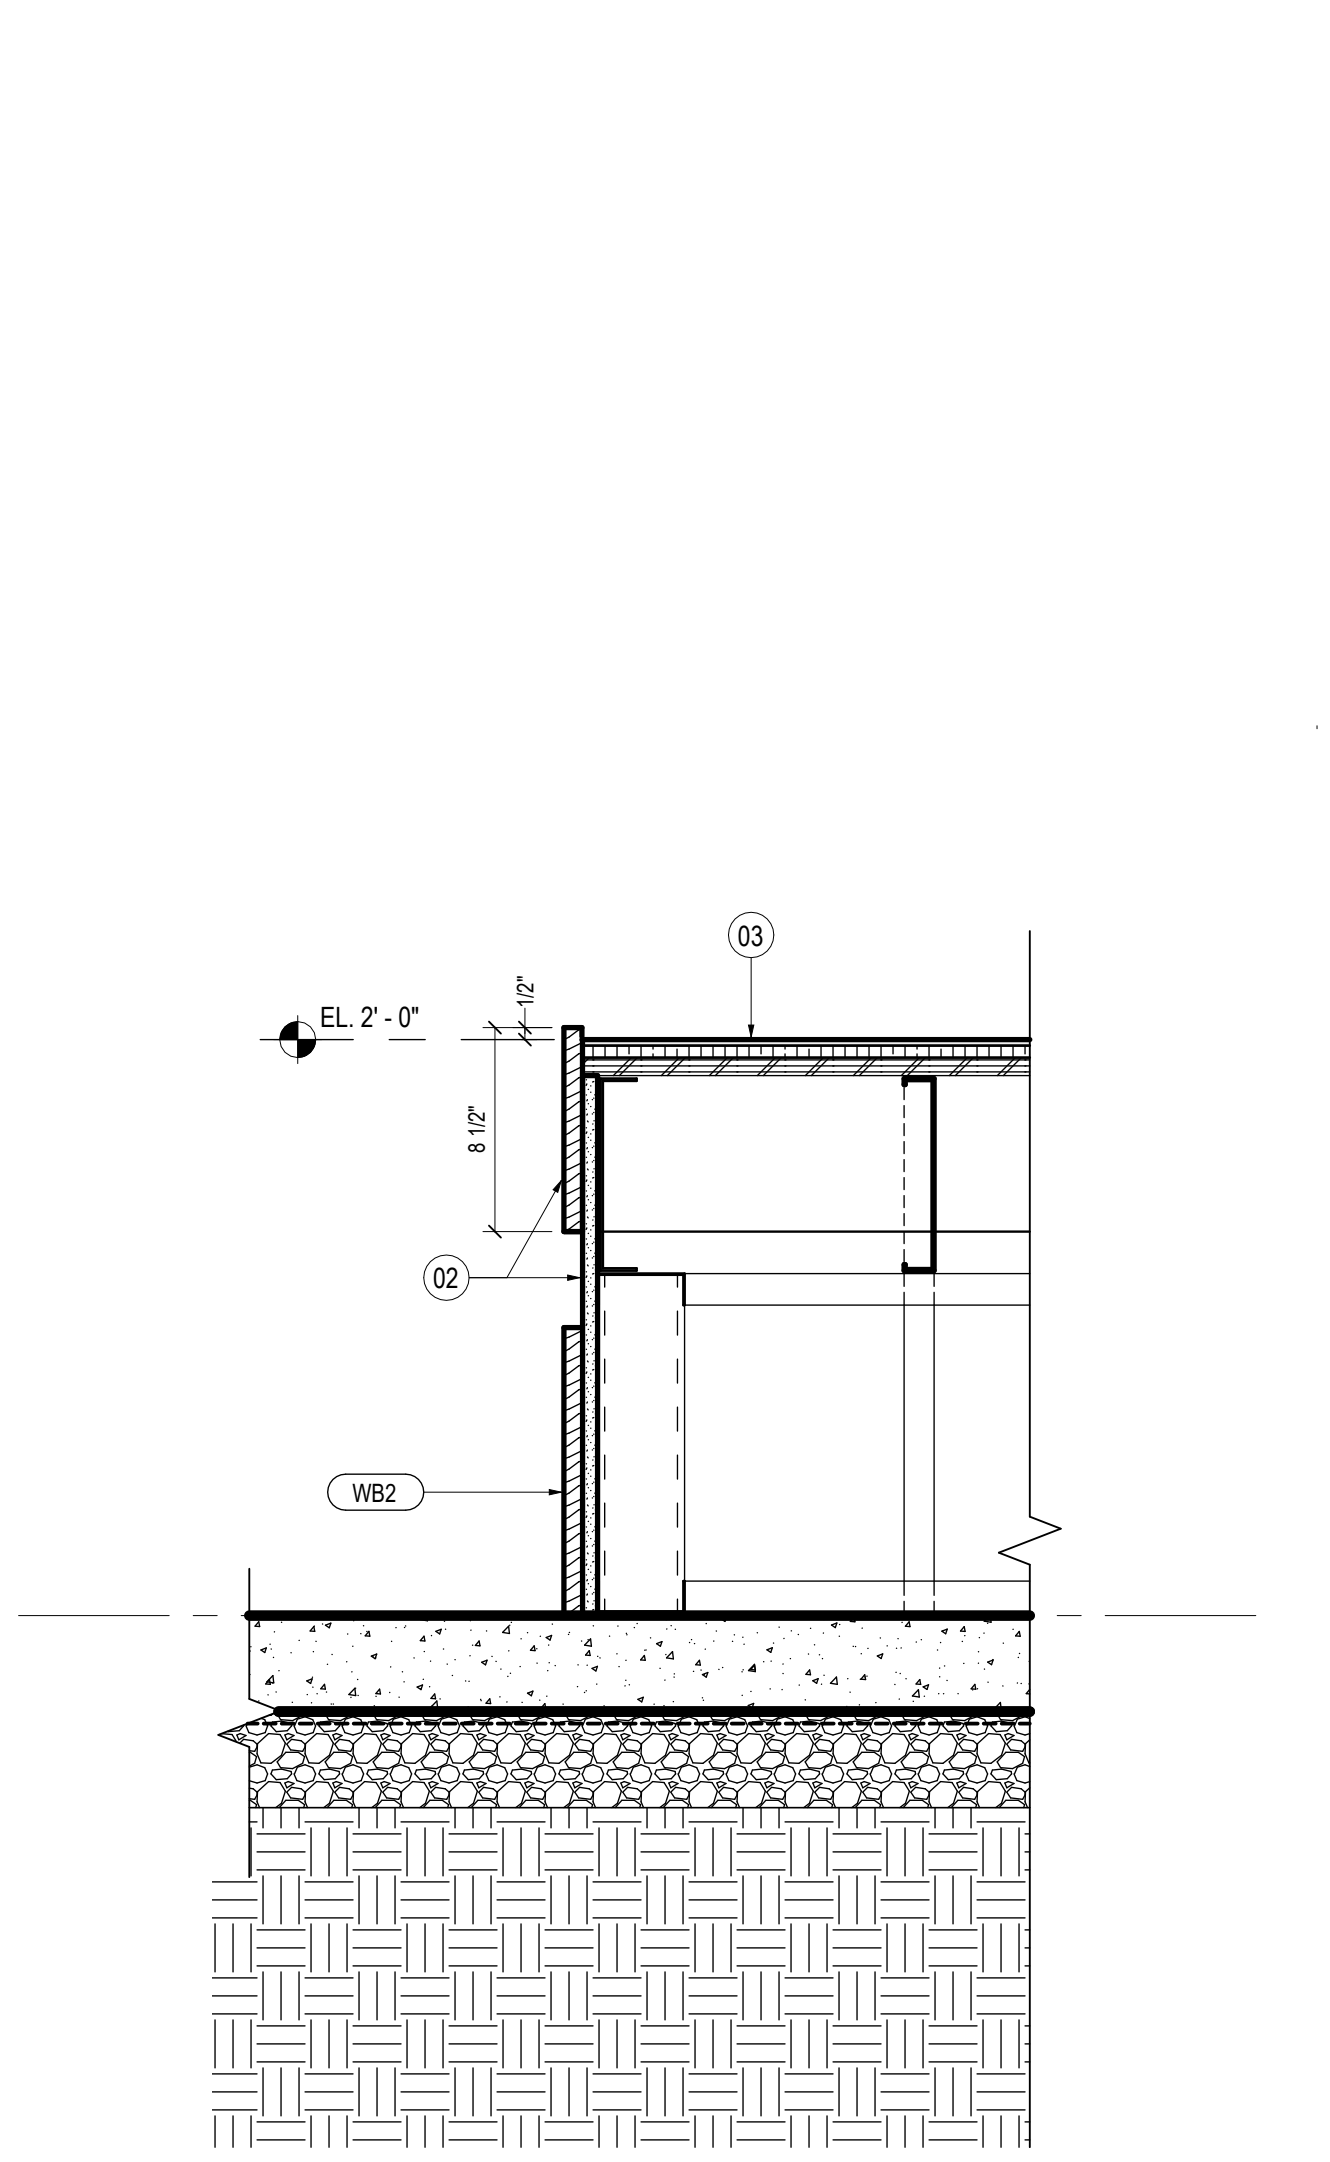

05 Section 2 - Callout 1
SCALE: 1 1/2" = 1'-0"

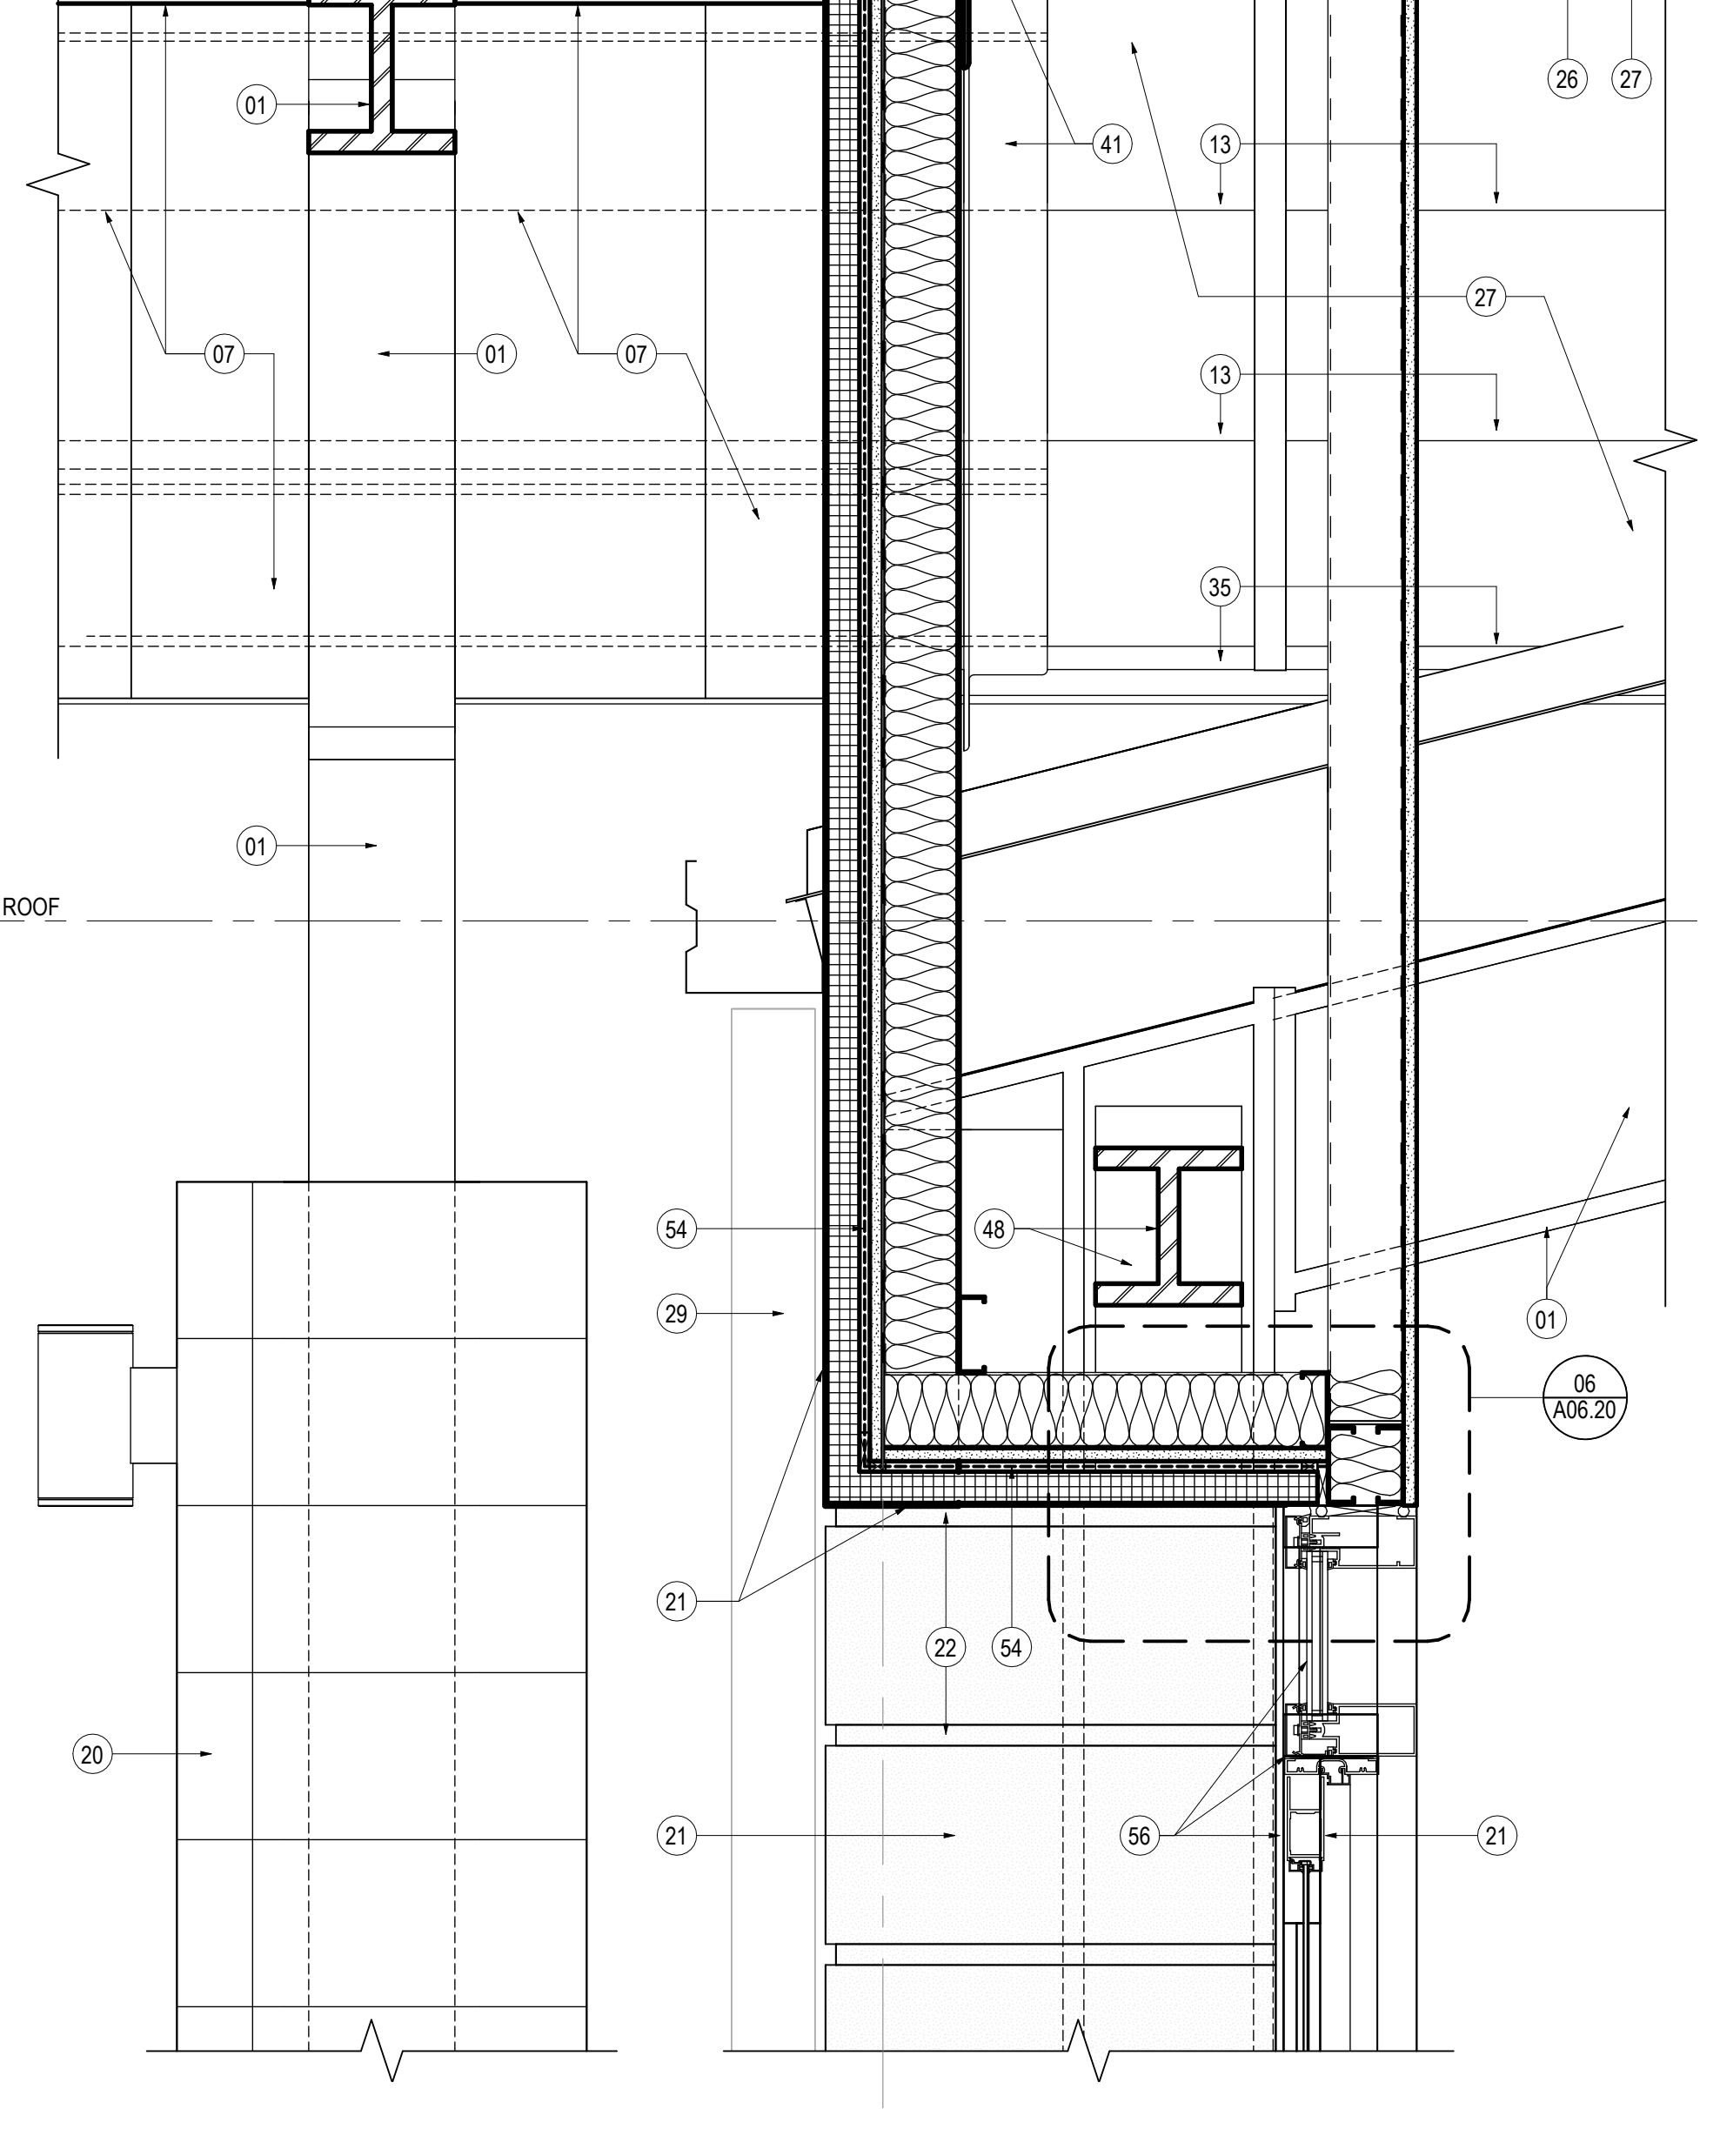


06 WALL AT MAIN ENTRY - Callout 1
SCALE: 1 1/2" = 1'-0"

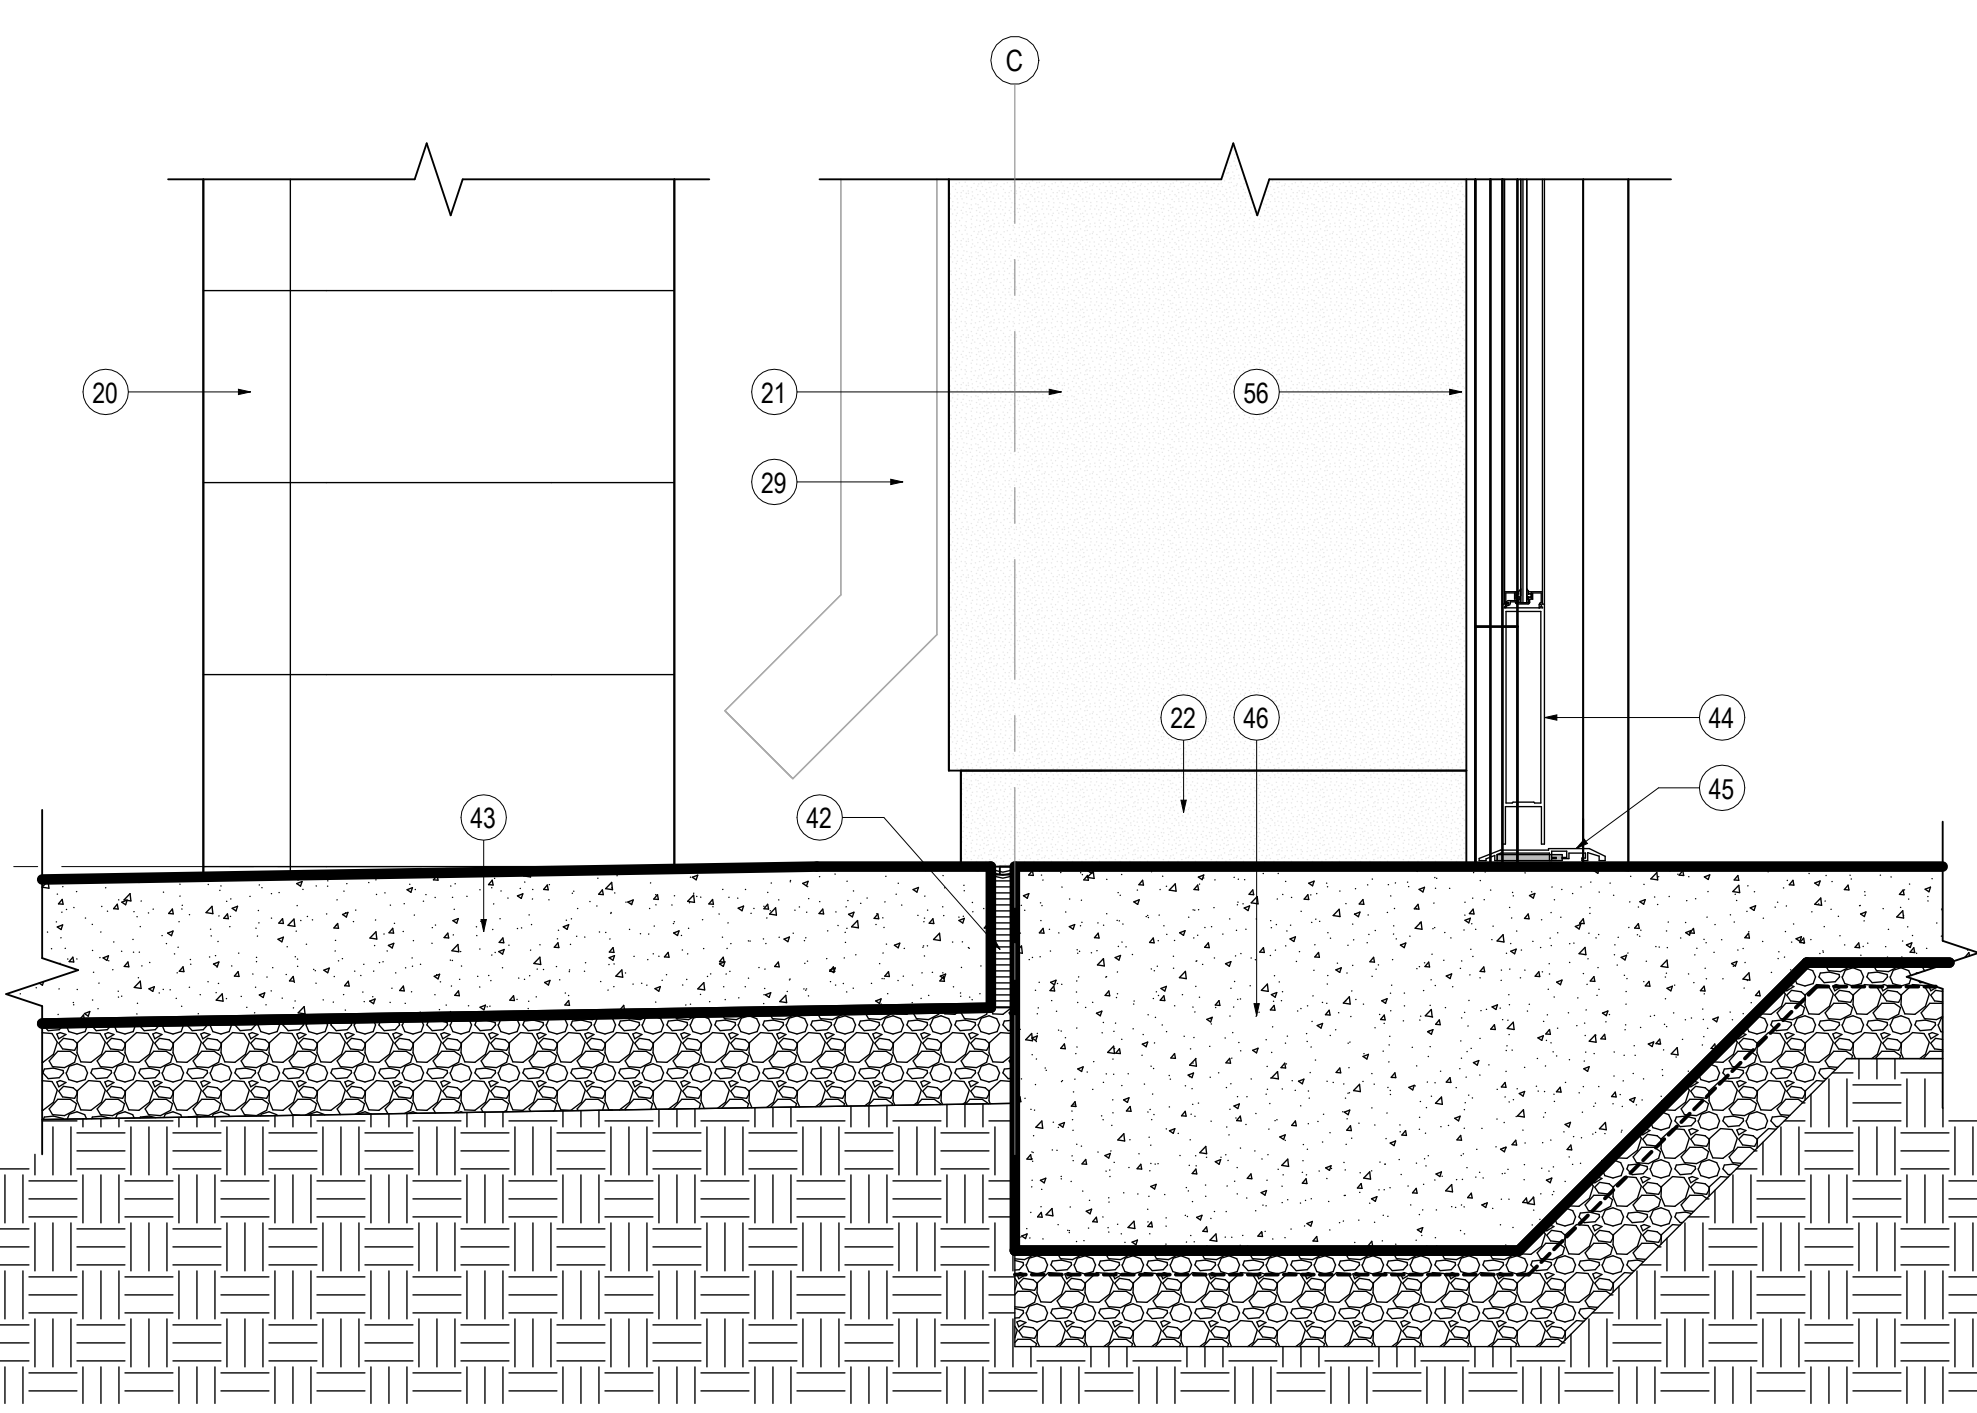


07 WALL AT MAIN ENTRY - Callout 2
SCALE: 1 1/2" = 1'-0"




KEY PLAN

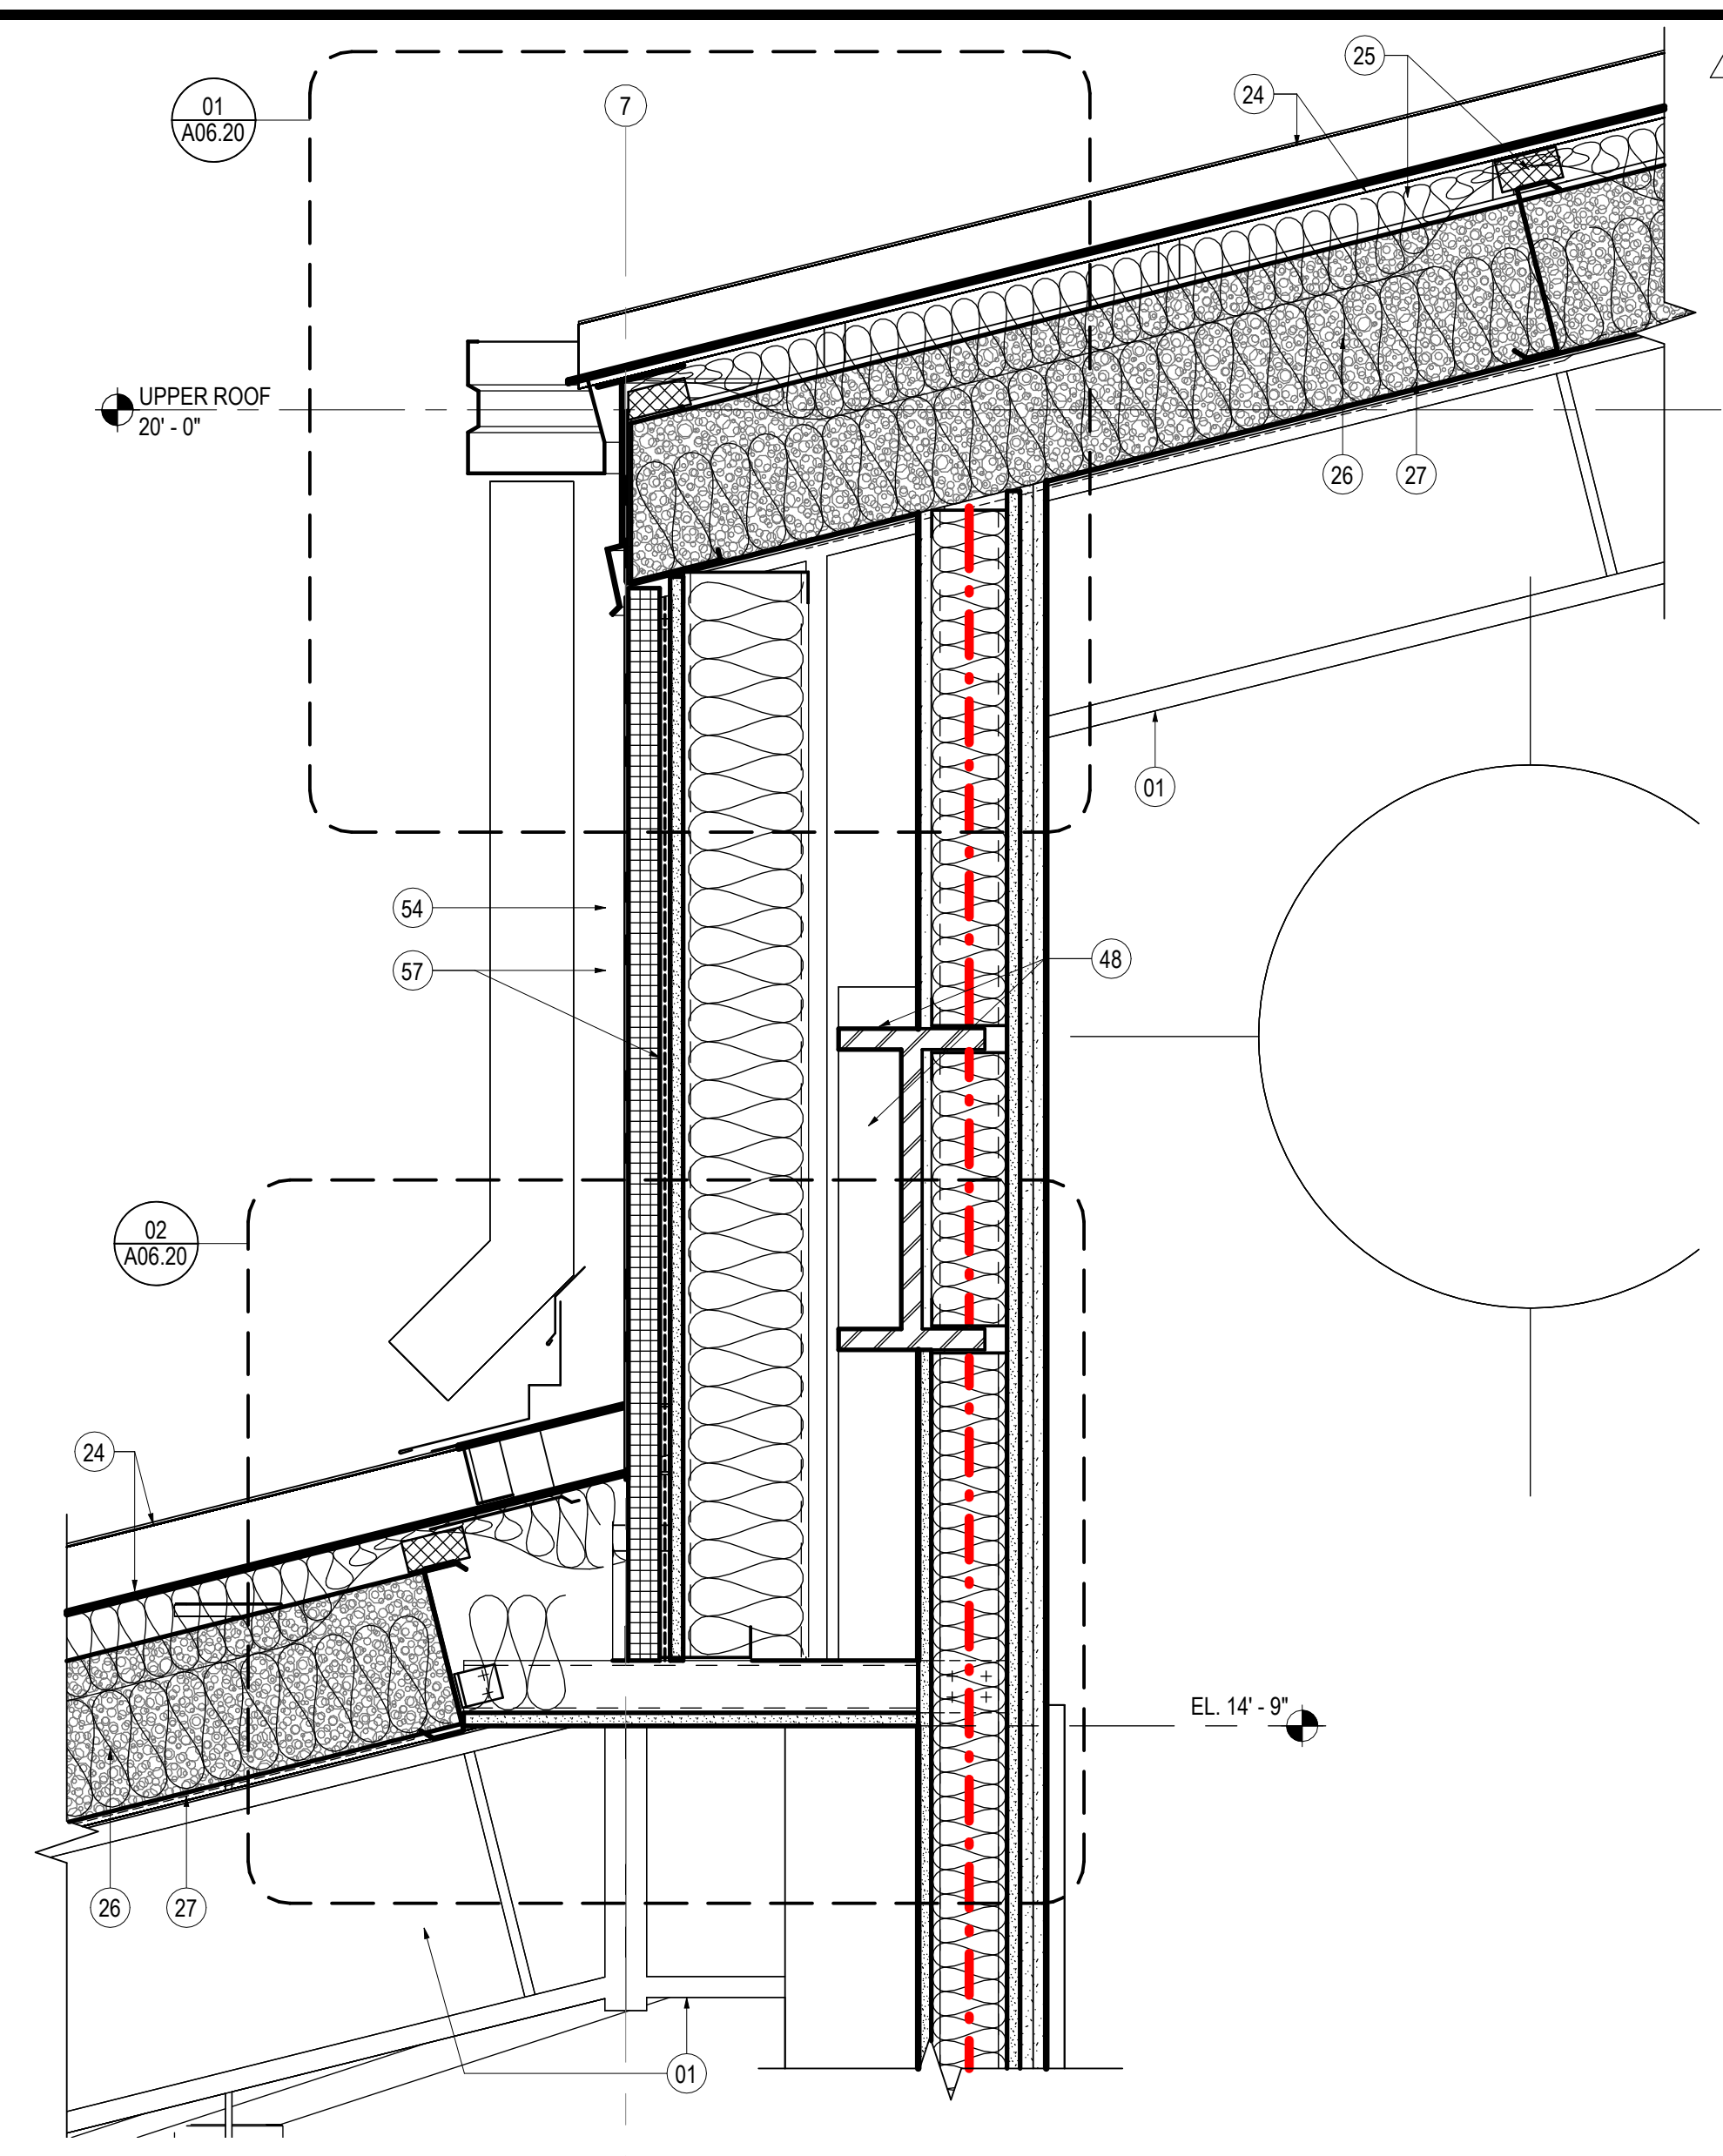


04 EAST / WEST SANCTUARY WALL - Callout 1
SCALE: 1 1/2" = 1'-0"

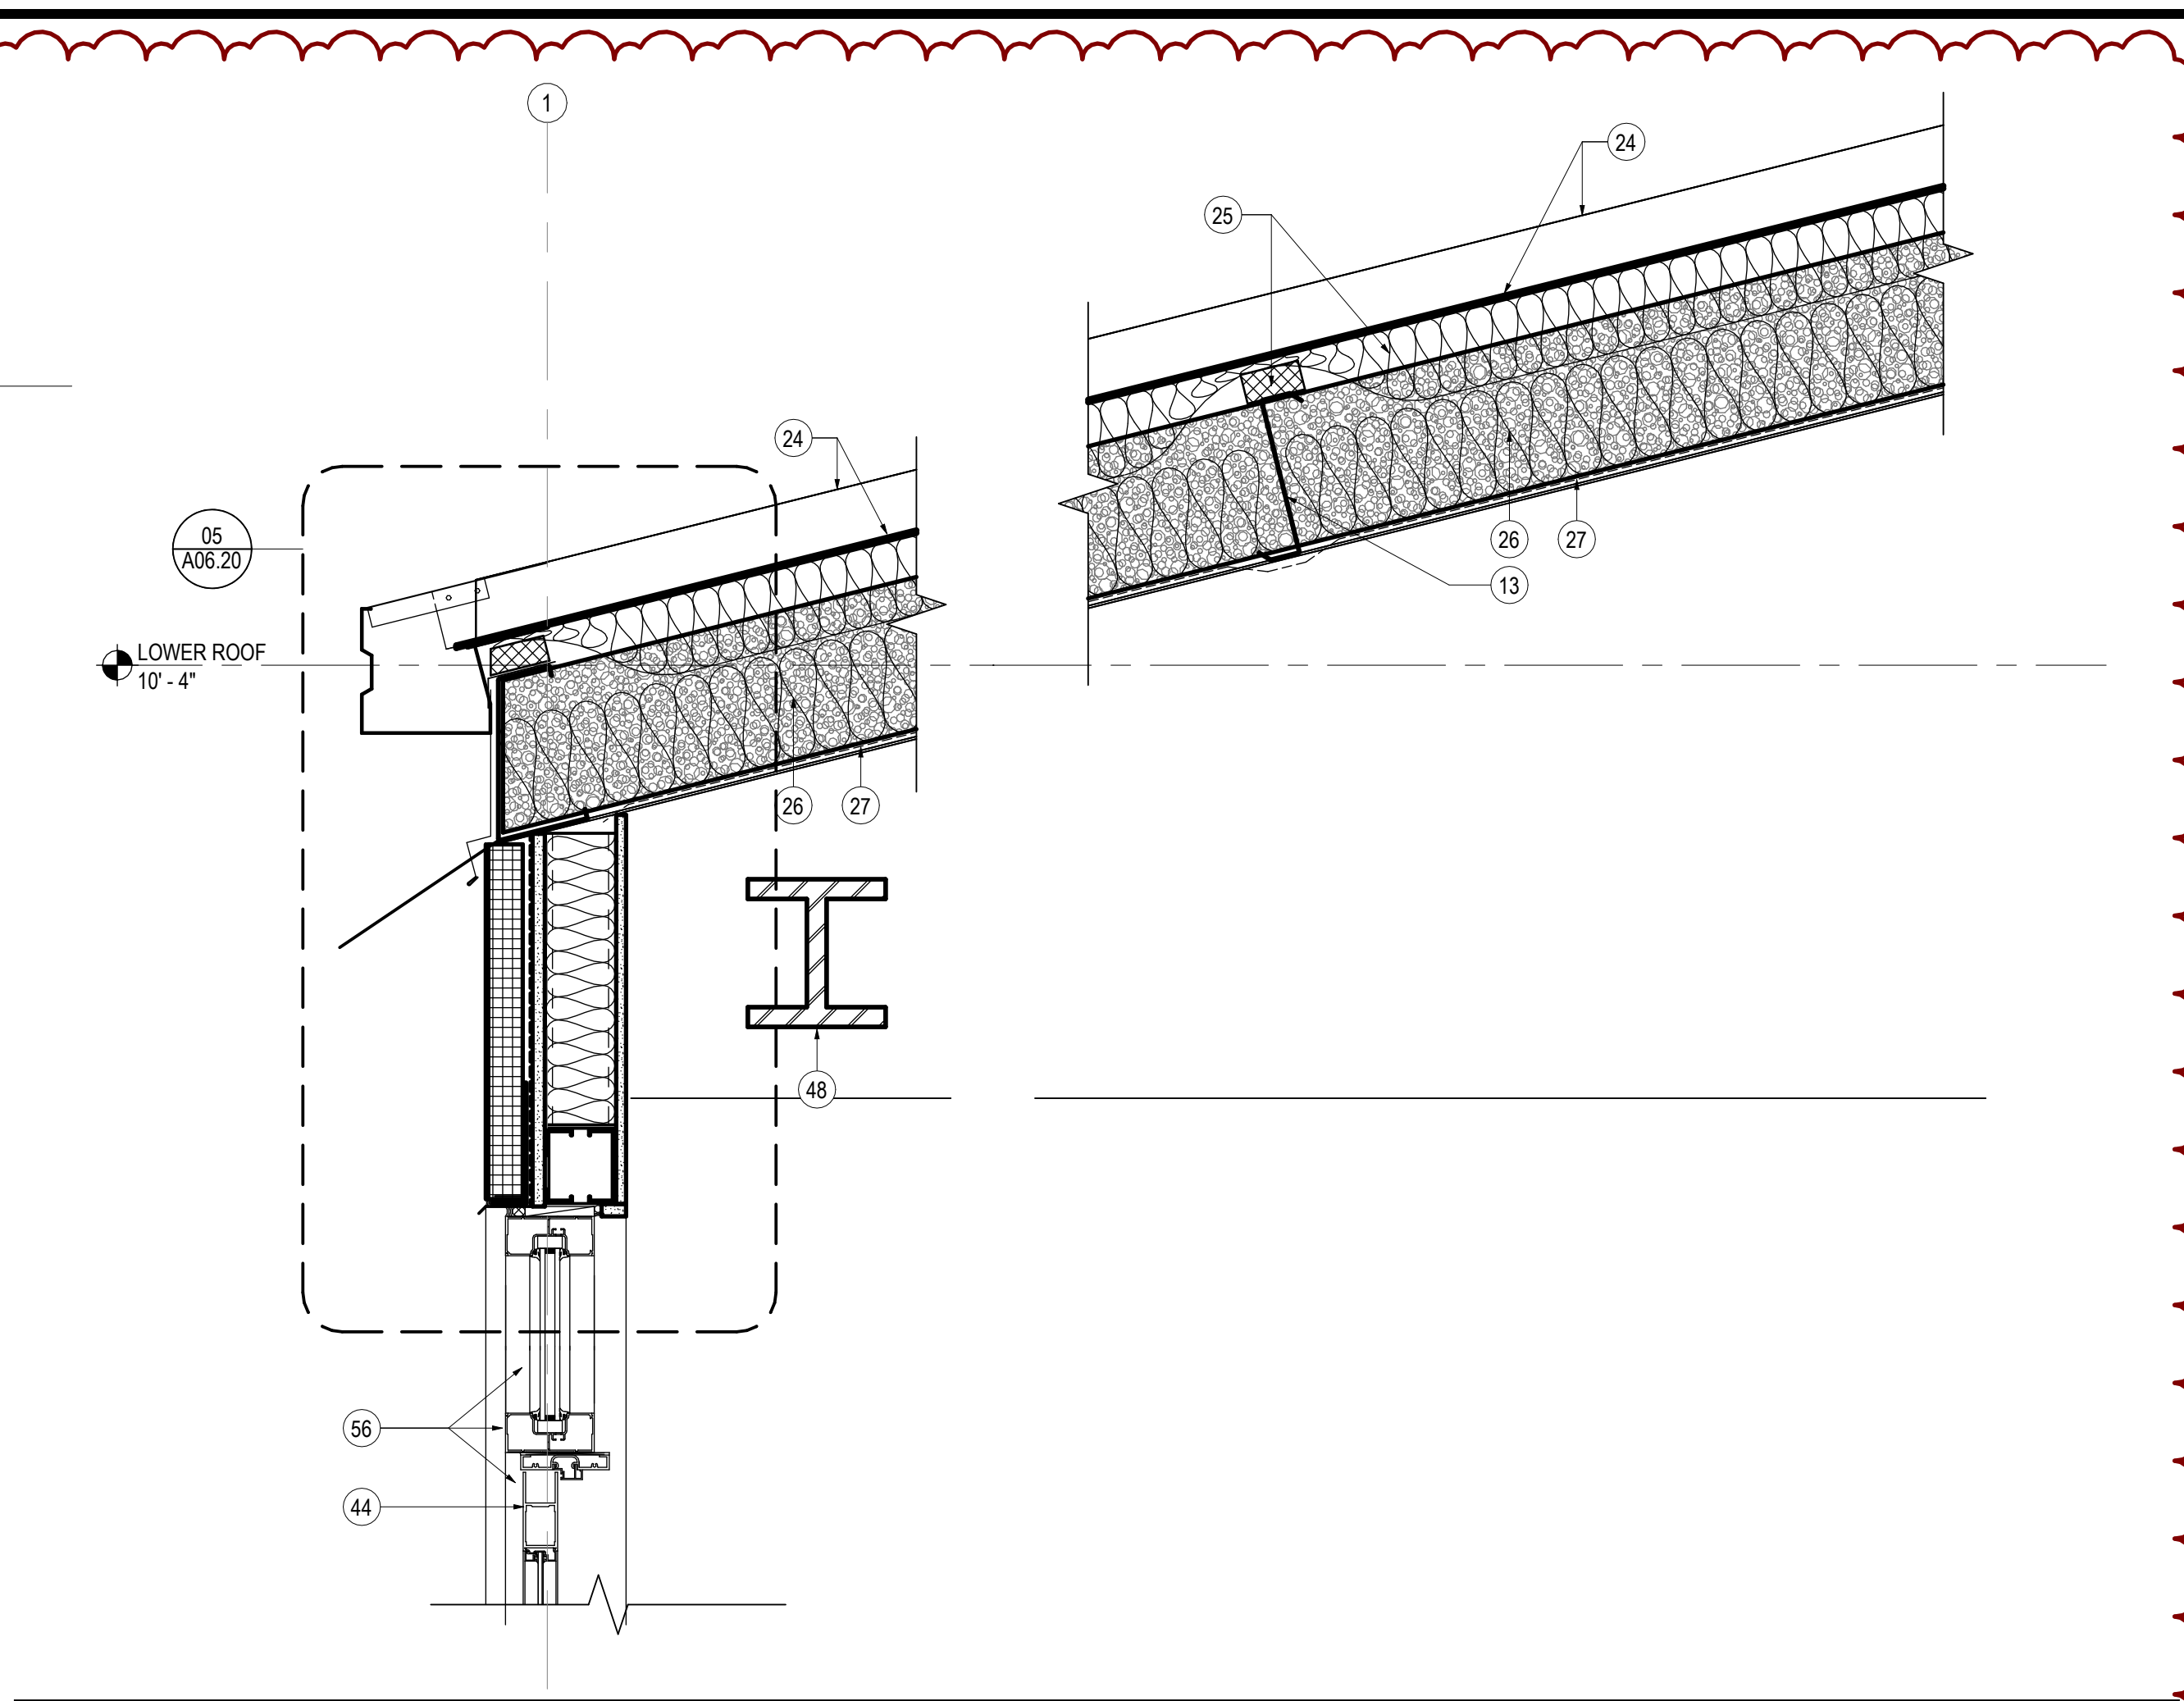


01 WALL AT LOBBY ENTRY - Callout 1
SCALE: 1 1/2" = 1'-0"

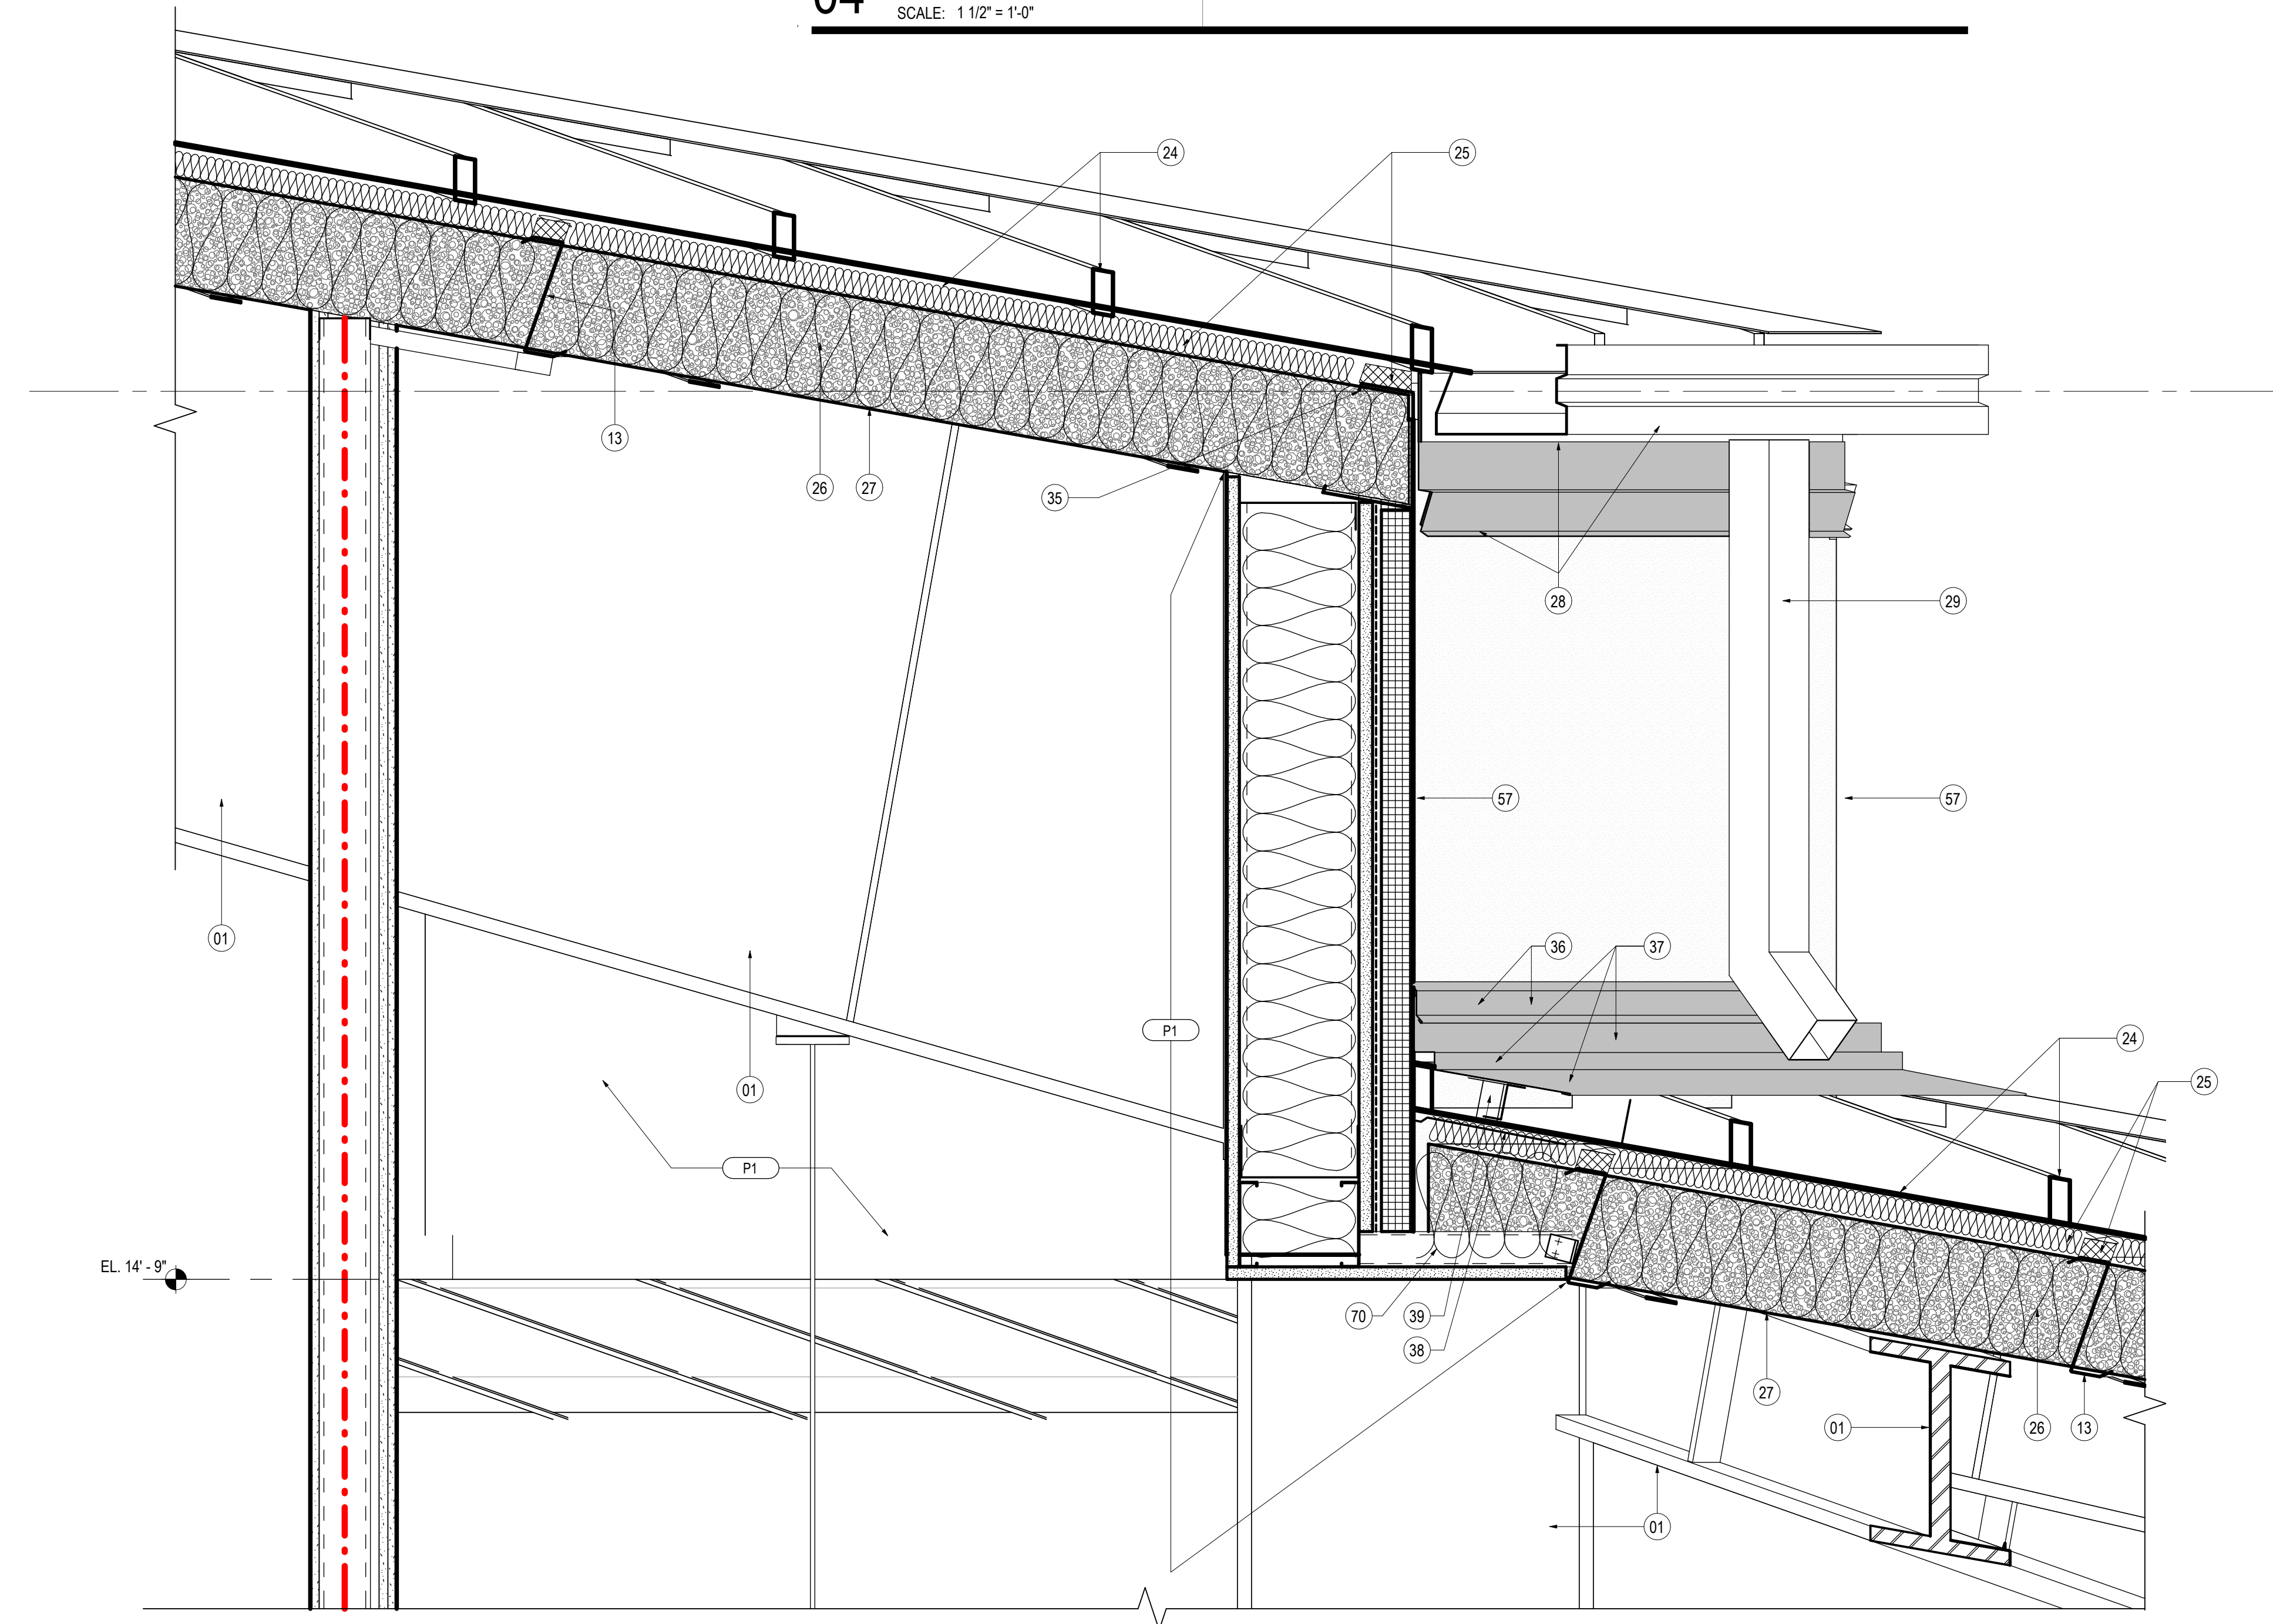

05 SANCTUARY WALL AT CHAMFERED CORNER
SCALE: 1 1/2" = 1'-0"

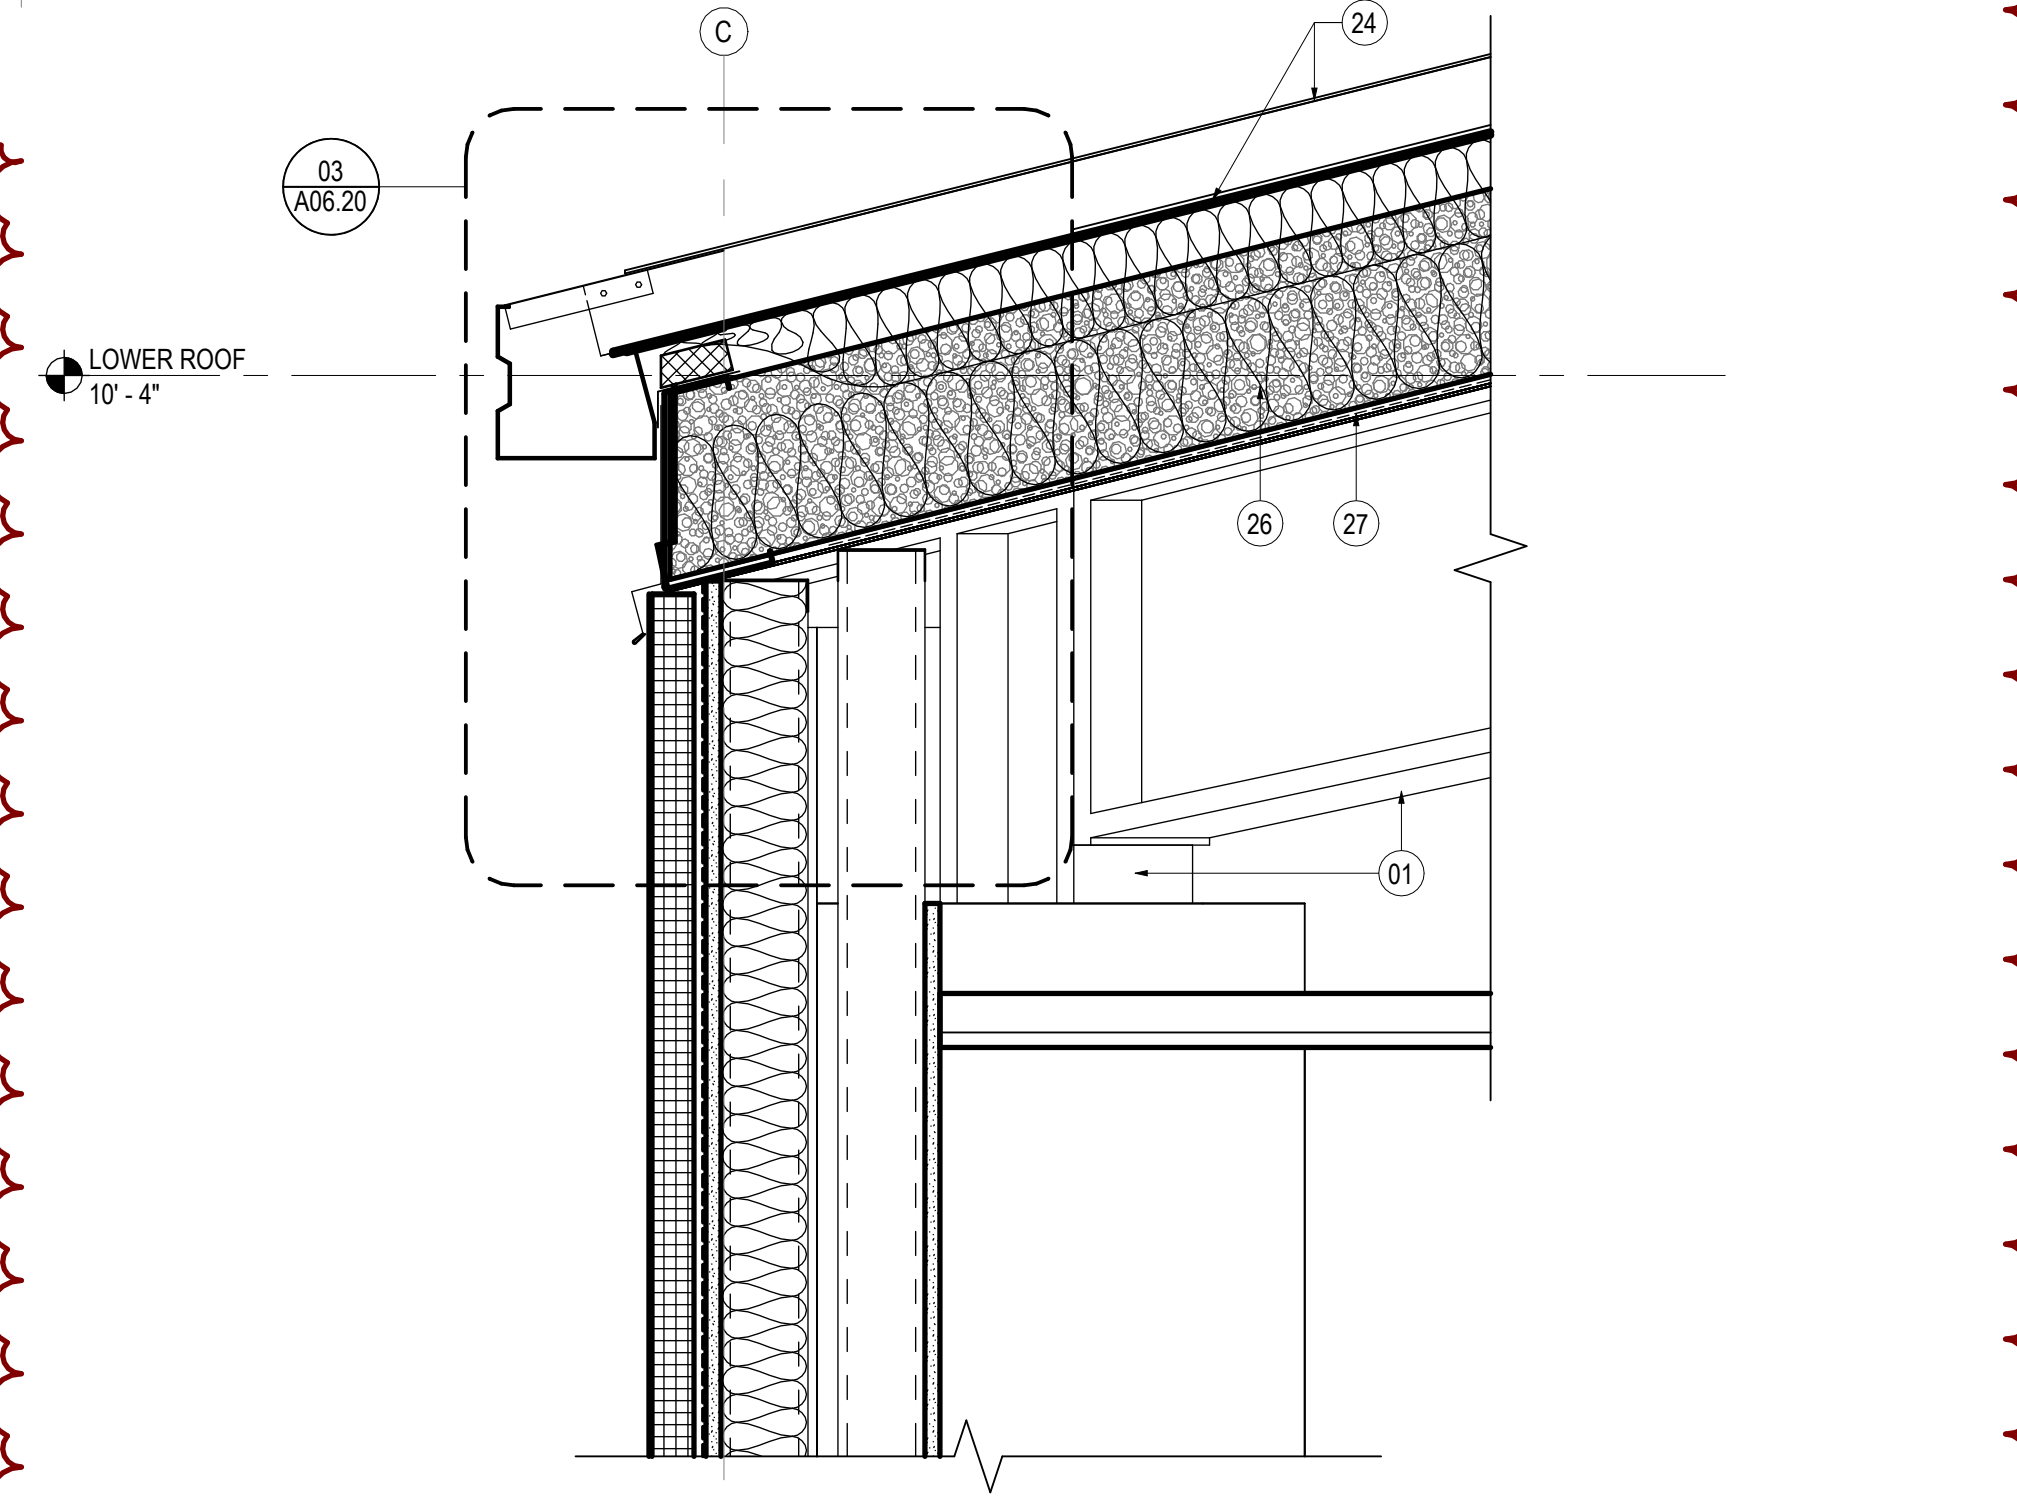

02 SOUTH WALL AT RESTROOMS - Callout 1
SCALE: 1 1/2" = 1'-0"

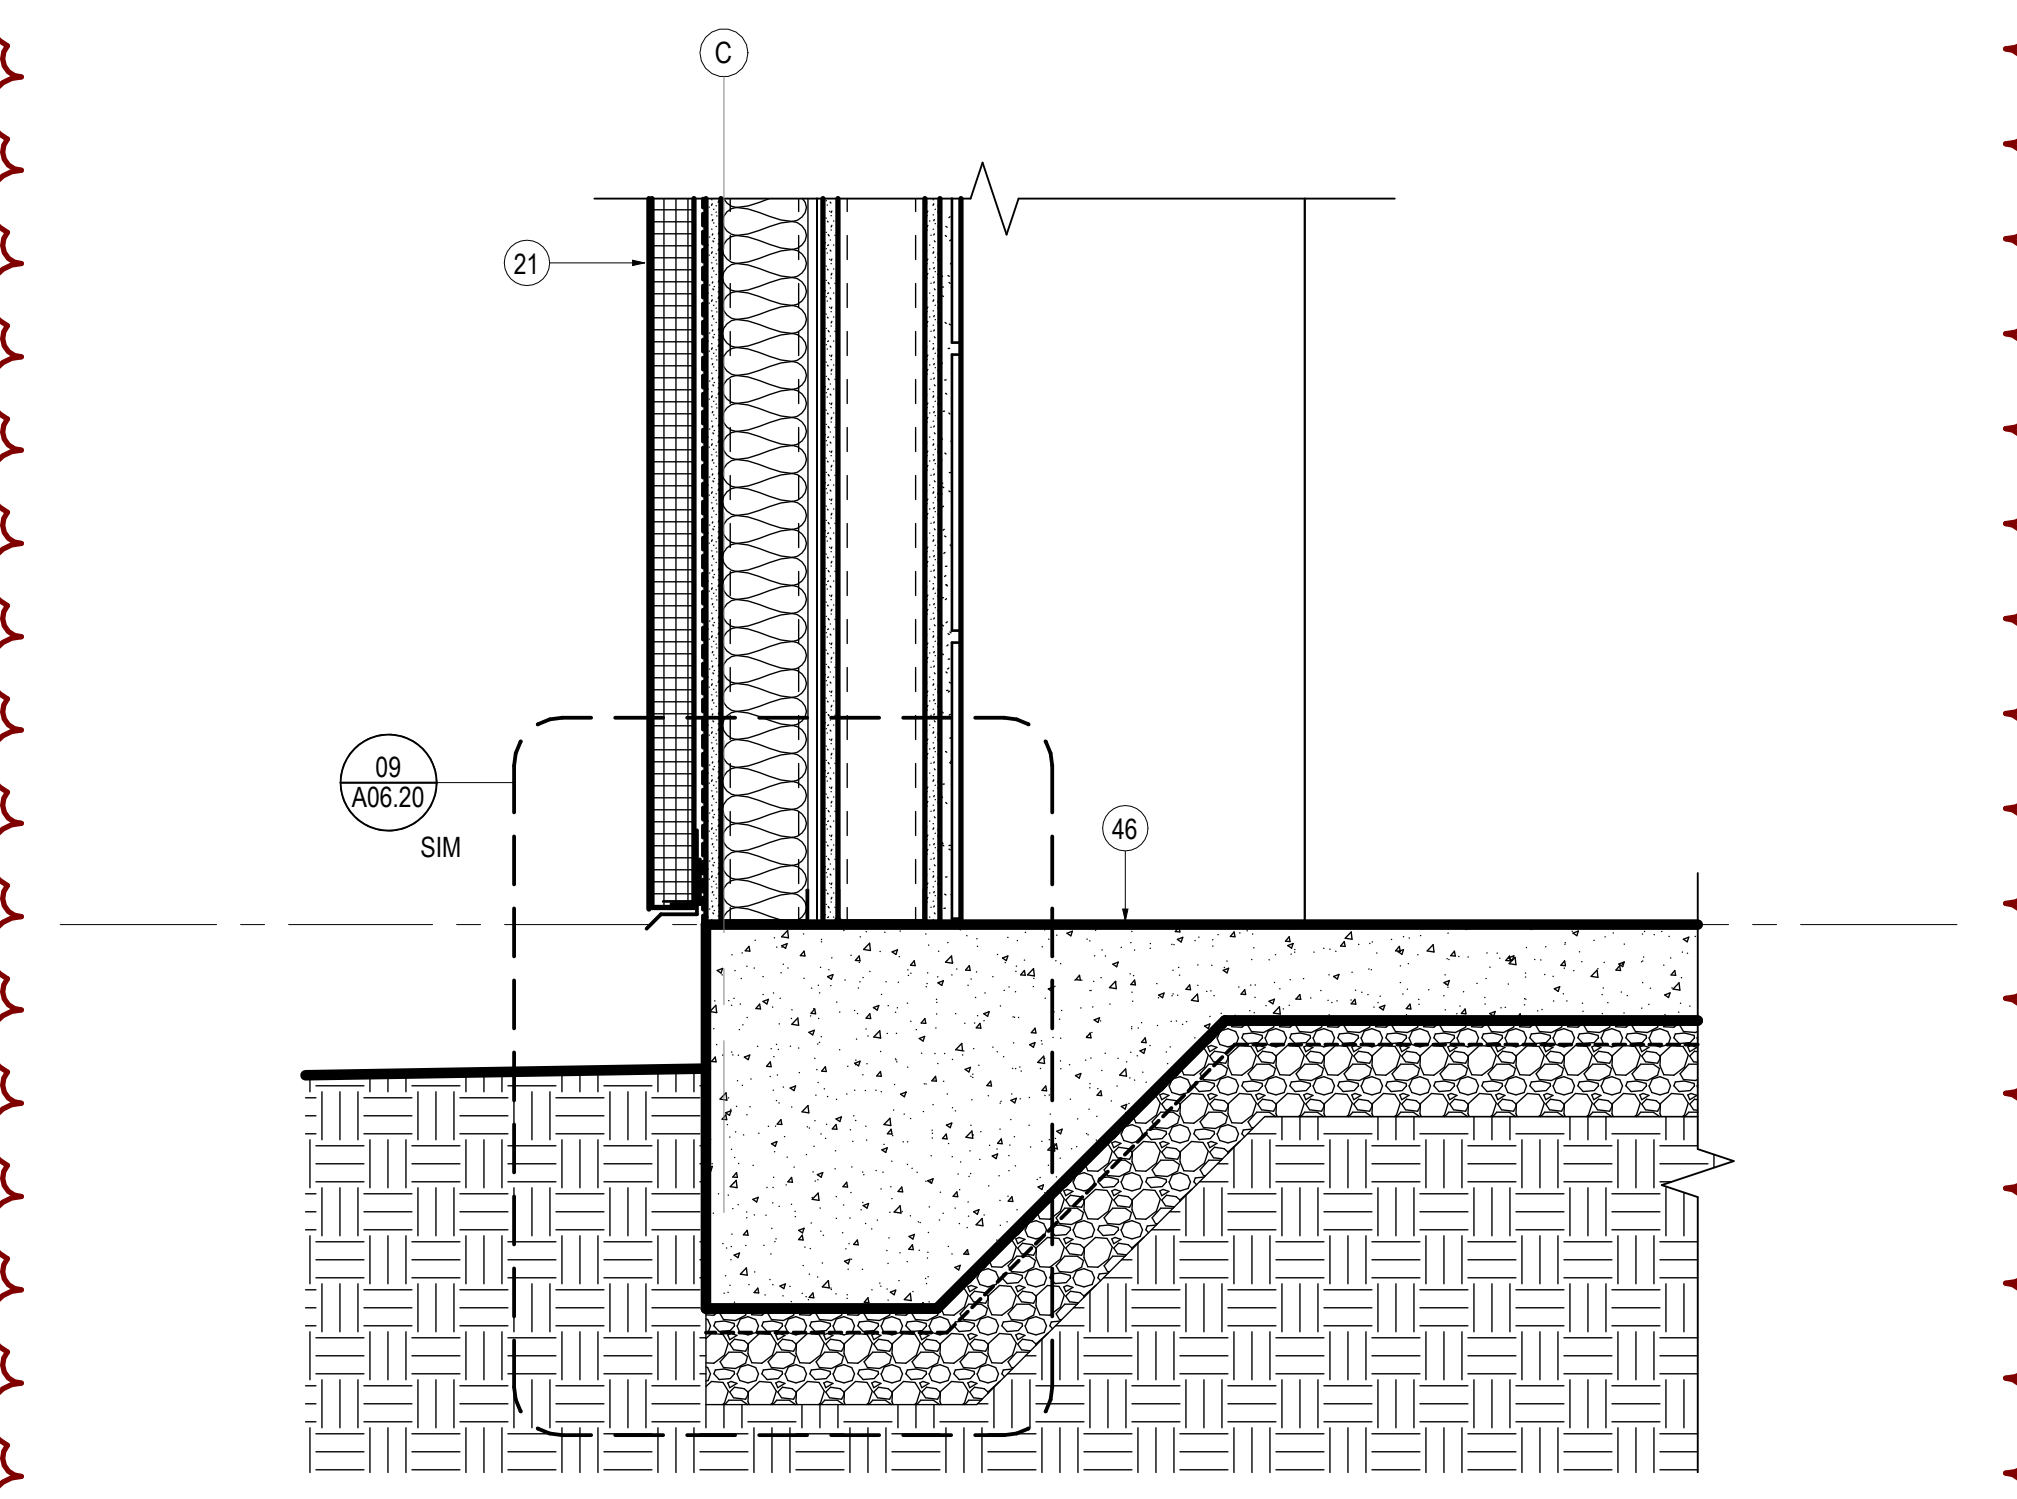

03 SOUTH WALL AT RESTROOMS - Callout 2
SCALE: 1 1/2" = 1'-0"

SHEET NOTES

- 01 STRUCT. STL. - PAINT BLACK WHERE EXPOSED
- 02 GWB AND MDF STAGE APRON - PAINT BLACK
- 03 ELEVATED FLOOR w/ LVT FINISH ON 1/4" T. TEMPERED MASONITE, 1/2" HOMASOTE, AND 3/4" FRP PLYWOOD ON MTL. STUD FRAMING (SEE STRUCT.)
- 04 SLOPED GWB "CLOUD" AT UNDERSIDE OF STL. STRUCT.
- 07 MTL. PANEL CEILING SYSTEM MTL. BLDG. MANUF. LIGHTING TRUSS (SEE STRUCT.)
- 08 RAMP w/ LVT FINISH ON (2) LAYERS 3/4" FRP PLYWOOD ON MTL. STUD FRAMING (SEE STRUCT.)
- 09 STAIR w/ LVT FINISH ON (2) LAYERS 3/4" FRP PLYWOOD ON MTL. STUD FRAMING (SEE STRUCT.)
- 11 GWB CONTROL JOINT
- 12 EXPOSED ROOF INSULATION
- 13 MTL. Z PURLIN (TYP.)
- 14 SUSPENDED PROJECTION SCREEN
- 15 LED CYLINDER PENDANT LIGHT FIXTURE (TYP.) (SEE ELEC.)
- 16 LED WALL SCONCE LIGHT FIXTURE (TYP.) (SEE ELEC.)
- 17 RECTANGULAR BEAM LED LIGHT FIXTURE (TYP.) (SEE ELEC.)
- 18 RECESSED LED LIGHT FIXTURE (TYP.) (SEE ELEC.)
- 20 8"x16"x4" CMU (PROVIDE TIES PER MANUF. REQS.) ON MTL. STUD FURRING AT STL. COLUMN
- 21 E.F.S. - 1-1/2" R-5 RIGID INSUL. AND 5/8" SHEATHING ON 3-5/8" MTL. STUD FRAMING W/ R-13 BLANKET INSUL.
- 22 REVEAL (TYP.)
- 23 8"x16"x4" CMU (PROVIDE TIES PER MANUF. REQS.) W/ 1-1/2" AIR SPACE, 2" RIGID INSUL., AND 5/8" SHEATHING ON 3-5/8" MTL. STUD FRAMING
- 24 STANDING SEAM MTL. ROOF (OWNER FURNISHED)
- 25 CONT. R-11 VINYL-FACED BLANKET INSUL. ON R-3 THERMAL SPACER BLOCKS (THERMAL SPACER BLOCKS AT EA. PURLIN)
- 26 R-19 FIBERGLASS BLANKET INSUL. BET. PURLINS (PROVIDE LONGITUDINAL AND TRANSVERSE MTL. SUPPORT BANDING)
- 27 CONT. BLACK FIBER-REINFORCED VAPOR BARRIER MEMBRANE AT BOTTOM OF PURLINS
- 28 CUTTER AND FLASHING BY MTL. BLDG. MANUF.
- 29 DOWNSPOUTS BY MTL. BLDG. MANUF. (TYP.)
- 31 3/8" T. x 24" D. CLEAR TEMPERED GLASS SHELVES (TYP.)
- 32 ADJUSTABLE SHELF BRACKETS & FLUSH-MOUNTED SHELF TRACKS (TYP.)
- 33 RAKES INSIDE WALL MOUNT EH COUNTER SUPPORT BRACKETS
- 34 OPEN TO UPPER ROOF ABOVE
- 35 MTL. C PURLIN BY MTL. BLDG. MANUF.
- 36 PRE-FIN. COUNTER FLASHING
- 37 TIE-IN TRIM BY MTL. BLDG. MANUF.
- 38 BACK-UP PLATE BY MTL. BLDG. MANUF.
- 39 OUTSIDE MTL. CLOSURE BY MTL. BLDG. MANUF.
- 41 STL. SPANDREL ANGLE AT BOTTOM OF MTL. Z PURLINS BY MTL. BLDG. MANUFACTURER
- 42 COMPRESSIBLE FILLER
- 43 NEW CONC. SIDEWALK
- 44 ALUM. DOOR AS SCHEDULED
- 45 DOOR THRESHOLD AS SCHEDULED - SET ON FULL BED OF MASTIC
- 46 TURNED-DOWN CONC. SLAB (SEE STRUCT.)
- 47 STRUCT. STL. COLUMN
- 48 STRUCT. STL. MOMENT FRAME - PAINT BLACK WHERE EXPOSED
- 49 SOUND ATTENUATION BLANKET (TYP.)
- 51 LINEAR SLOT RETURN (SEE MECH.)
- 52 MTL. SUPPORT BANDING - SPACE AS DIMENSIONED ON ENLARGED RCP (TYP.)
- 53 UNHINGED / RECESSED KNOXBOX (ALUM. FIN.)
- 54 FLUID-APPLIED AIR BARRIER MEMBRANE
- 55 JOINT SEALANT AND BACKER ROD
- 56 ALUM. STOREFRONT SYSTEM
- 57 E.F.S. - 1-1/2" R-5 RIGID INSUL. AND 5/8" SHEATHING ON 6" MTL. STUD FRAMING W/ R-13 BLANKET INSUL.
- 59 E.F.S. DRAINABLE TRACK
- 60 THRU-WALL STAINLESS STL. FLASHING W/ DRIP EDGE - FLASHED INTO AIR AND WATER BARRIER MEMBRANE
- 61 R-19 FIBERGLASS BLANKET INSUL. BET. MTL. STUD FRAMING (PROVIDE LONGITUDINAL AND TRANSVERSE MTL. SUPPORT BANDING)
- 62 STANDING SEAM MTL. ROOF (OWNER FURNISHED) ON 3/4" FRP PLYWOOD ON 6" MTL. STUD FRAMING
- 68 ROLLERSHADE AT EA. EXT. WINDOW (TYP.)
- 69 EAVE TRIM, PANEL, CAP TRIM, AND FLASHING BY MTL. BLDG. MANUF.
- 70 MTL. STUD BRACE (SEE STRUCT.)

Ossa
STUDIO

4539 HEDGEMORE DRIVE, SUITE 101
CHARLOTTE NC 28209
704.890.2653
WWW.OSSASTUDIO.COM

Professional Engineer Seal for Jack Ossa, License No. 11709, State of North Carolina, Charlotte, NC.

Professional Engineer Seal for Ossa Studio, License No. 53194, State of North Carolina, Charlotte, NC.

10/30/24

PROJECT TEAM

General Contractor
ECCLESIA CONSTRUCTION
www.ecclesiainc.com
803.327.5670

Civil Engineering
HILLIARD ENGINEERING, PLLC
www.heaecorp.com
919.352.2834

Structural Engineering
PROVIDENCE PARTNERS
www.providencepartnersinc.com
704.266.6621

Mechanical, Electrical, Plumbing & Fire Protection
ENGINEERING
www.egr.com
704.287.2193

Date	Description
10/30/24	FOR CONSTRUCTION
2 10/14/24	RTAP NO. 1

Project Name

community church
making church come alive

658 GRAHAM ROAD
SANFORD NC 27311

Client

3D COMMUNITY CHURCH

Project Number
23024.00

Description
SECTION DETAILS

Scale
1 1/2" = 1'-0"

A06.11

© 2024 Ossa Studio


10/14/2024 5:08:09 PM L:\Projects\Drawings\Local\23024.00_3D_Community Church_andrew.mcdellan\FHC.rvt

SHEET NOTES

- 01 STRUCT. STL. - PAINT BLACK WHERE EXPOSED
- 02 GWB AND MDF STAGE APRON - PAINT BLACK
- 03 ELEVATED FLOOR w/ LVT FINISH ON 1/4" T. TEMPERED MASONITE, 1/2" HOMASOTE, AND 3/4" FRT PLYWOOD ON MTL. STUD FRAMING (SEE STRUCT.)
- 04 SLOPED GWB "CLOUD" AT UNDERSIDE OF STL. STRUCT.
- 07 MTL. PANEL CEILING SYSTEM MTL. BLDG. MANUF. LIGHTING TRUSS (SEE STRUCT.)
- 08 RAMP w/ LVT FINISH ON (2) LAYERS 3/4" FRT PLYWOOD ON MTL. STUD FRAMING (SEE STRUCT.)
- 10 STAIR w/ LVT FINISH ON (2) LAYERS 3/4" FRT PLYWOOD ON MTL. STUD FRAMING (SEE STRUCT.)
- 11 GWB CONTROL JOINT
- 12 EXPOSED ROOF INSULATION
- 13 MTL. Z PURLIN (TYP.)
- 14 SUSPENDED PROJECTION SCREEN
- 15 LED CYLINDER PENDANT LIGHT FIXTURE (TYP.) (SEE ELEC.)
- 16 LED WALL SCONCE LIGHT FIXTURE (TYP.) (SEE ELEC.)
- 17 RECTANGULAR BEAM LED LIGHT FIXTURE (TYP.) (SEE ELEC.)
- 18 RECESSED LED LIGHT FIXTURE (TYP.) (SEE ELEC.)
- 20 8"x16"x4" CMU (PROVIDE TIES PER MANUF. REQS.) ON MTL. STUD FURRING AT STL. COLUMN
- 21 E.I.F.S. - 1-1/2" R-7.5 RIGID INSUL. AND 5/8" SHEATHING ON 3-5/8" MTL. STUD FRAMING W/ R-13 BLANKET INSUL.
- 22 REVEAL (TYP.)
- 23 8"x16"x4" CMU (PROVIDE TIES PER MANUF. REQS.) W/ 1-1/2" AIR SPACE, 2" RIGID INSUL., AND 5/8" SHEATHING ON 3-5/8" MTL. STUD FRAMING
- 24 STANDING SEAM MTL. ROOF (OWNER FURNISHED)
- 25 CONT. R-11 VINYL-FACED BLANKET INSUL. ON R-3 THERMAL SPACER BLOCKS (THERMAL SPACER BLOCKS TYP. AT EA. PURLIN)
- 26 R-19 FIBERGLASS BLANKET INSUL. BET. PURLINS (PROVIDE LONGITUDINAL AND TRANSVERSE MTL. SUPPORT BANDING)
- 27 CONT. BLACK FIBER-REINFORCED VAPOR BARRIER MEMBRANE AT BOTTOM OF PURLINS
- 28 CUTTER AND FLASHING BY MTL. BLDG. MANUF.
- 29 DOWNSPOUTS BY MTL. BLDG. MANUF. (TYP.)
- 31 3/8" T. x 24" D. CLEAR TEMPERED GLASS SHELVES (TYP.)
- 32 ADJUSTABLE SHELF BRACKETS & FLUSH-MOUNTED SHELF TRACKS (TYP.)
- 33 RAKES INSIDE WALL MOUNT EH COUNTER SUPPORT BRACKETS
- 34 OPEN TO UPPER ROOF ABOVE
- 35 MTL. C PURLIN BY MTL. BLDG. MANUF.
- 36 PRE-FIN. COUNTER FLASHING
- 37 TIE-IN TRIM BY MTL. BLDG. MANUF.
- 38 BACK-UP PLATE BY MTL. BLDG. MANUF.
- 39 OUTSIDE MTL. CLOSURE BY MTL. BLDG. MANUF.
- 41 STL. SPANDREL ANGLE AT BOTTOM OF MTL. Z PURLINS BY MTL. BLDG. MANUFACTURER
- 42 COMPRESSIBLE FILLER
- 43 NEW CONC. SIDEWALK
- 44 ALUM. DOOR AS SCHEDULED
- 45 DOOR THRESHOLD AS SCHEDULED - SET ON FULL BED OF MASTIC
- 46 TURNED-DOWN CONC. SLAB (SEE STRUCT.)
- 47 STRUCT. STL. COLUMN
- 48 STRUCT. STL. MOMENT FRAME - PAINT BLACK WHERE EXPOSED
- 49 SOUND ATTENUATION BLANKET (TYP.)
- 51 LINEAR SLOT RETURN (SEE MECH.)
- 52 MTL. SUPPORT BANDING - SPACE AS DIMENSIONED ON ENLARGED RCP (TYP.)
- 53 UNHINGED / RECESSED KNOXBOX (ALUM. FIN.)
- 54 FLUID-APPLIED AIR BARRIER MEMBRANE
- 55 JOINT SEALANT AND BACKER ROD
- 56 ALUM. STOREFRONT SYSTEM
- 57 E.I.F.S. - 1-1/2" R-7.5 RIGID INSUL. AND 5/8" SHEATHING ON 6" MTL. STUD FRAMING W/ R-13 BLANKET INSUL.
- 59 E.I.F.S. DRAINABLE TRACK
- 60 THRU-WALL STAINLESS STL. FLASHING W/ DRIP EDGE - FLASHED INTO AIR AND WATER BARRIER MEMBRANE
- 61 R-19 FIBERGLASS BLANKET INSUL. BET. MTL. STUD FRAMING (PROVIDE LONGITUDINAL AND TRANSVERSE MTL. SUPPORT BANDING)
- 62 STANDING SEAM MTL. ROOF (OWNER FURNISHED) ON 3/4" FRT PLYWOOD ON 6" MTL. STUD FRAMING
- 68 ROLLERSHADE AT EA. EXT. WINDOW (TYP.)
- 69 EAVE TRIM, PANEL, CAP TRIM, AND FLASHING BY MTL. BLDG. MANUF.
- 70 MTL. STUD BRACE (SEE STRUCT.)



4539 HEDGEMORE DRIVE, SUITE 101
CHARLOTTE NC 28209
704.890.2853
WWW.OSSASTUDIO.COM

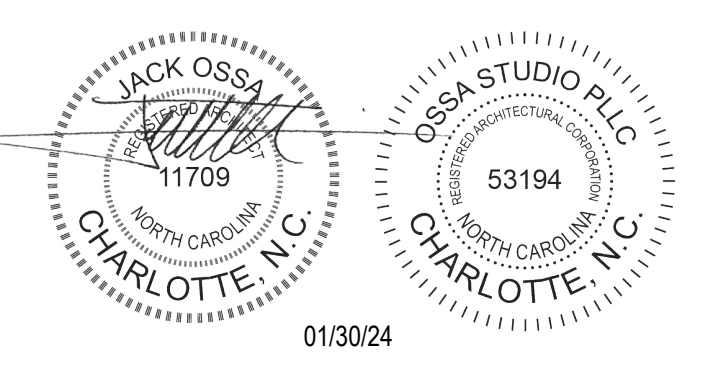

PROJECT TEAM

General Contractor
ECCLESIA CONSTRUCTION
www.ecclesiainc.com
803.327.5670


Civil Engineering
HILLIARD ENGINEERING, PLLC
www.hilliardepp.com
919.352.2834

Structural Engineering
PROVIDENCE PARTNERS
www.providencepartnersinc.com
704.266.6621

Mechanical, Electrical, Plumbing & Fire Protection
ENGINEERING
www.egntecture.com
704.287.2193

Date	Description
01/30/24	FOR CONSTRUCTION
2 10/14/24	RTAP NO. 1

Project Name

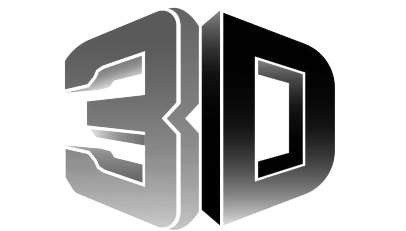

community church
making church come alive
658 GRAHAM ROAD
SANFORD NC 27311

Client

3D COMMUNITY CHURCH

Project Number

23024.00


Description

SECTION DETAILS


Scale

3" = 1'-0"


A06.20

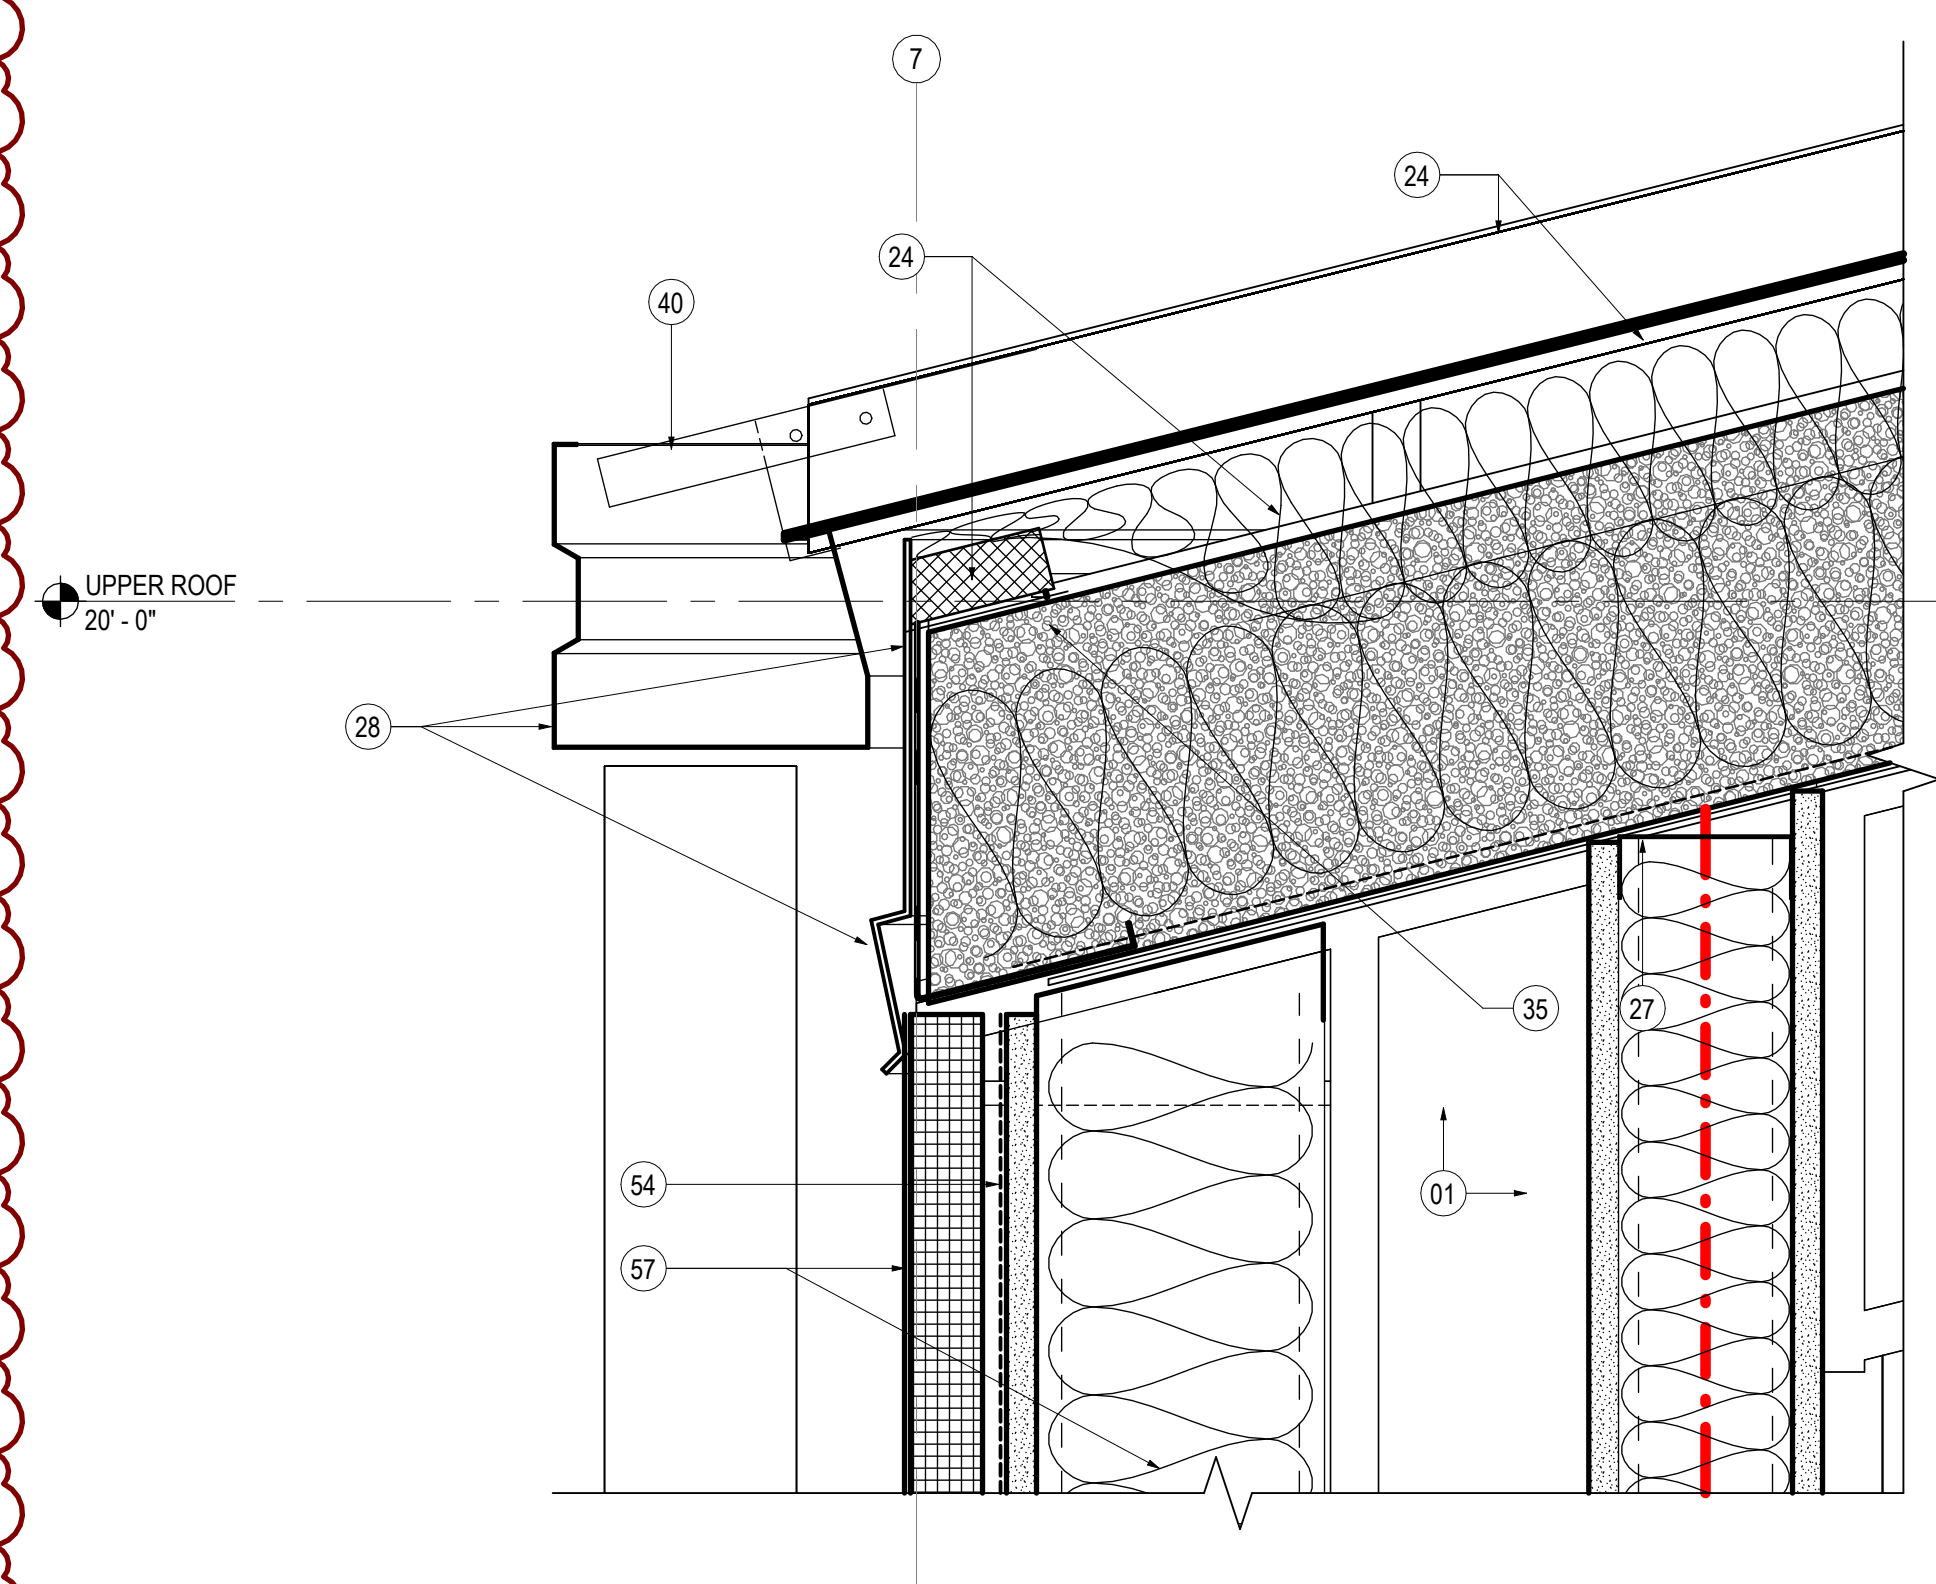


01 UPPER ROOF AT EIFS WALL
SCALE: 3" = 1'-0"

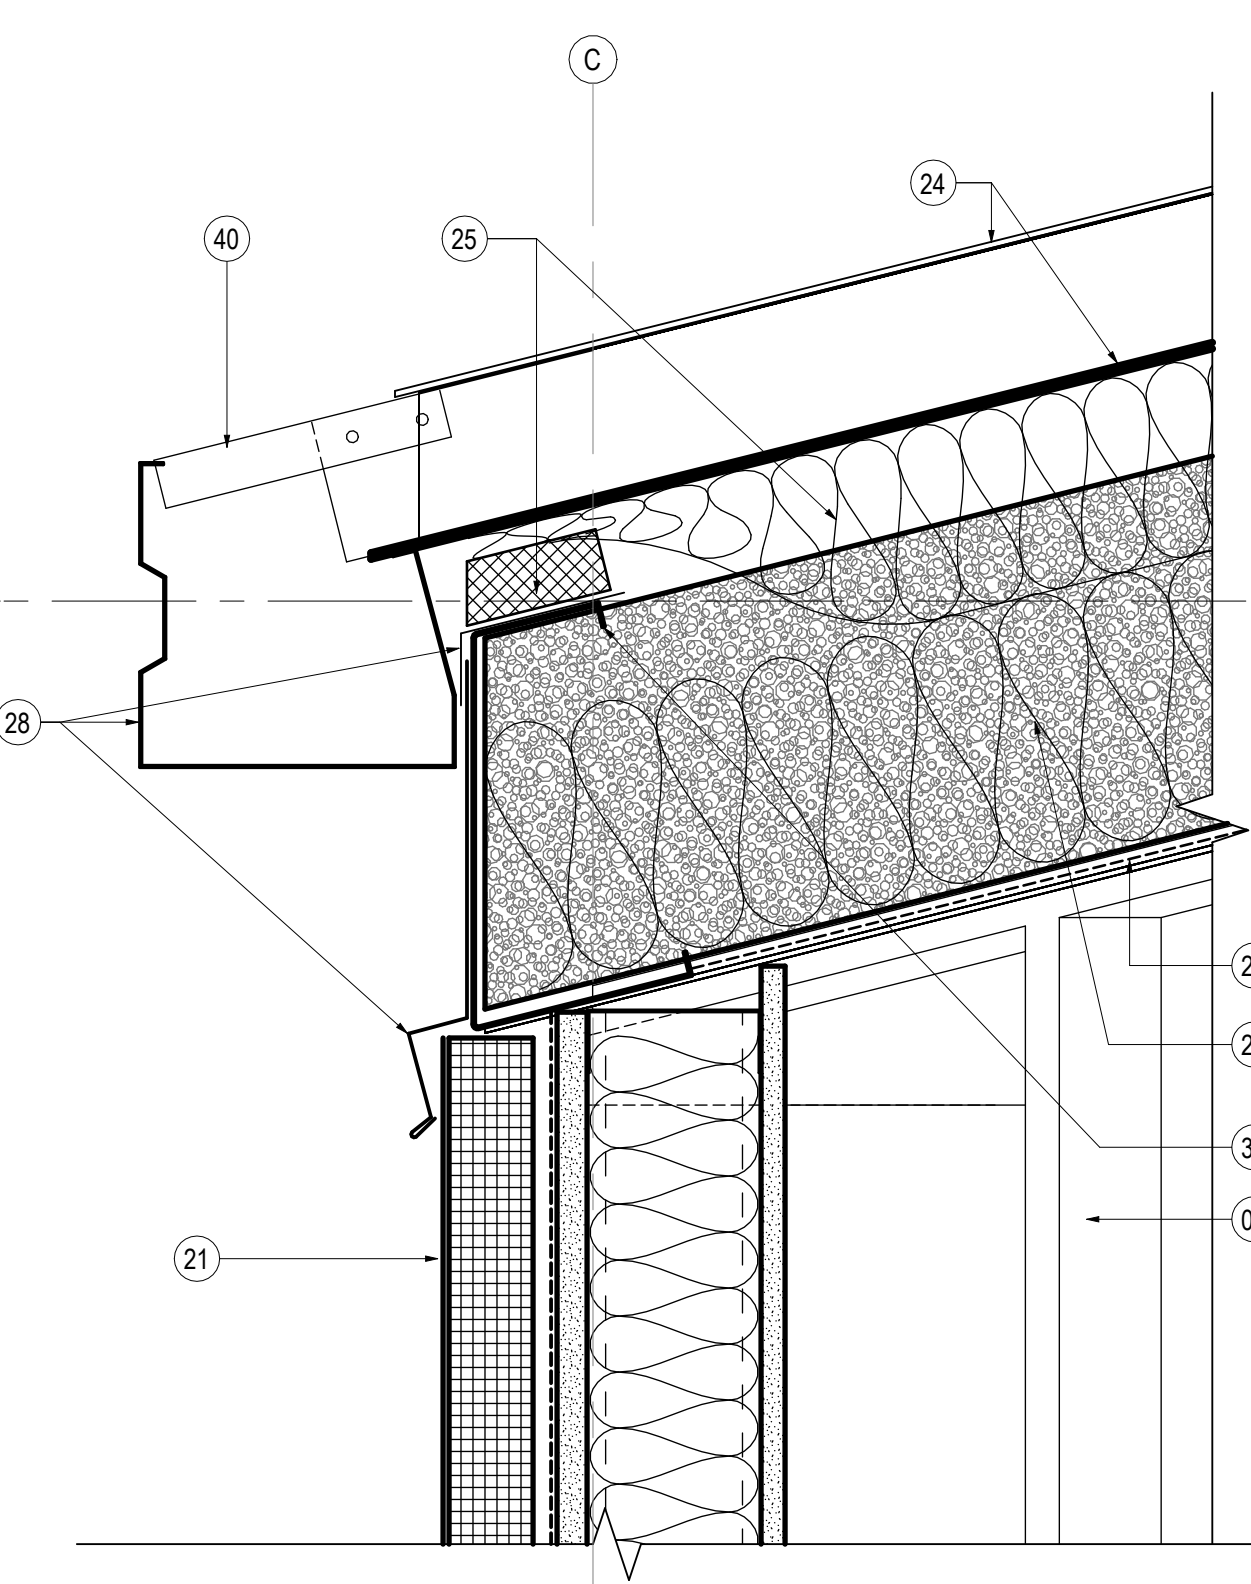


03 LOW ROOF AT CMU WALL
SCALE: 3" = 1'-0"

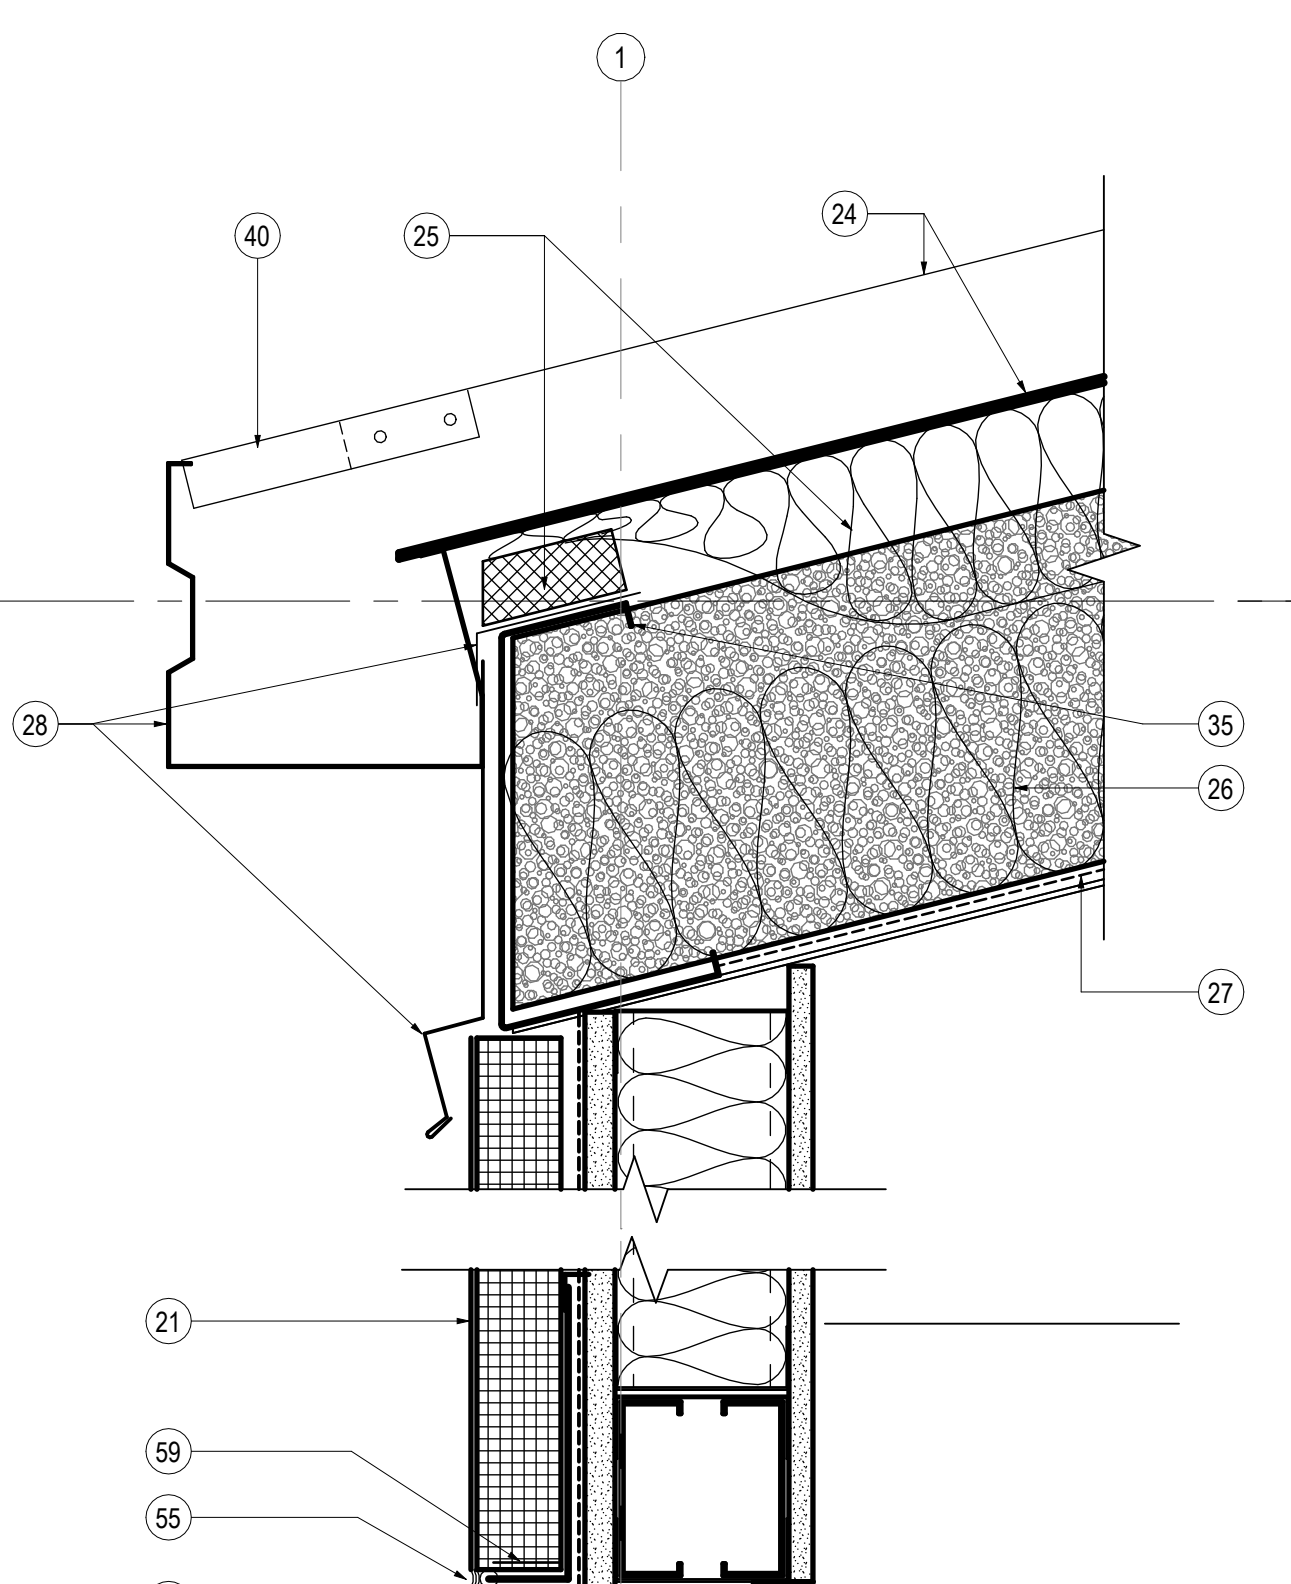


05 LOBBY ENTRY AT CMU WALL
SCALE: 3" = 1'-0"

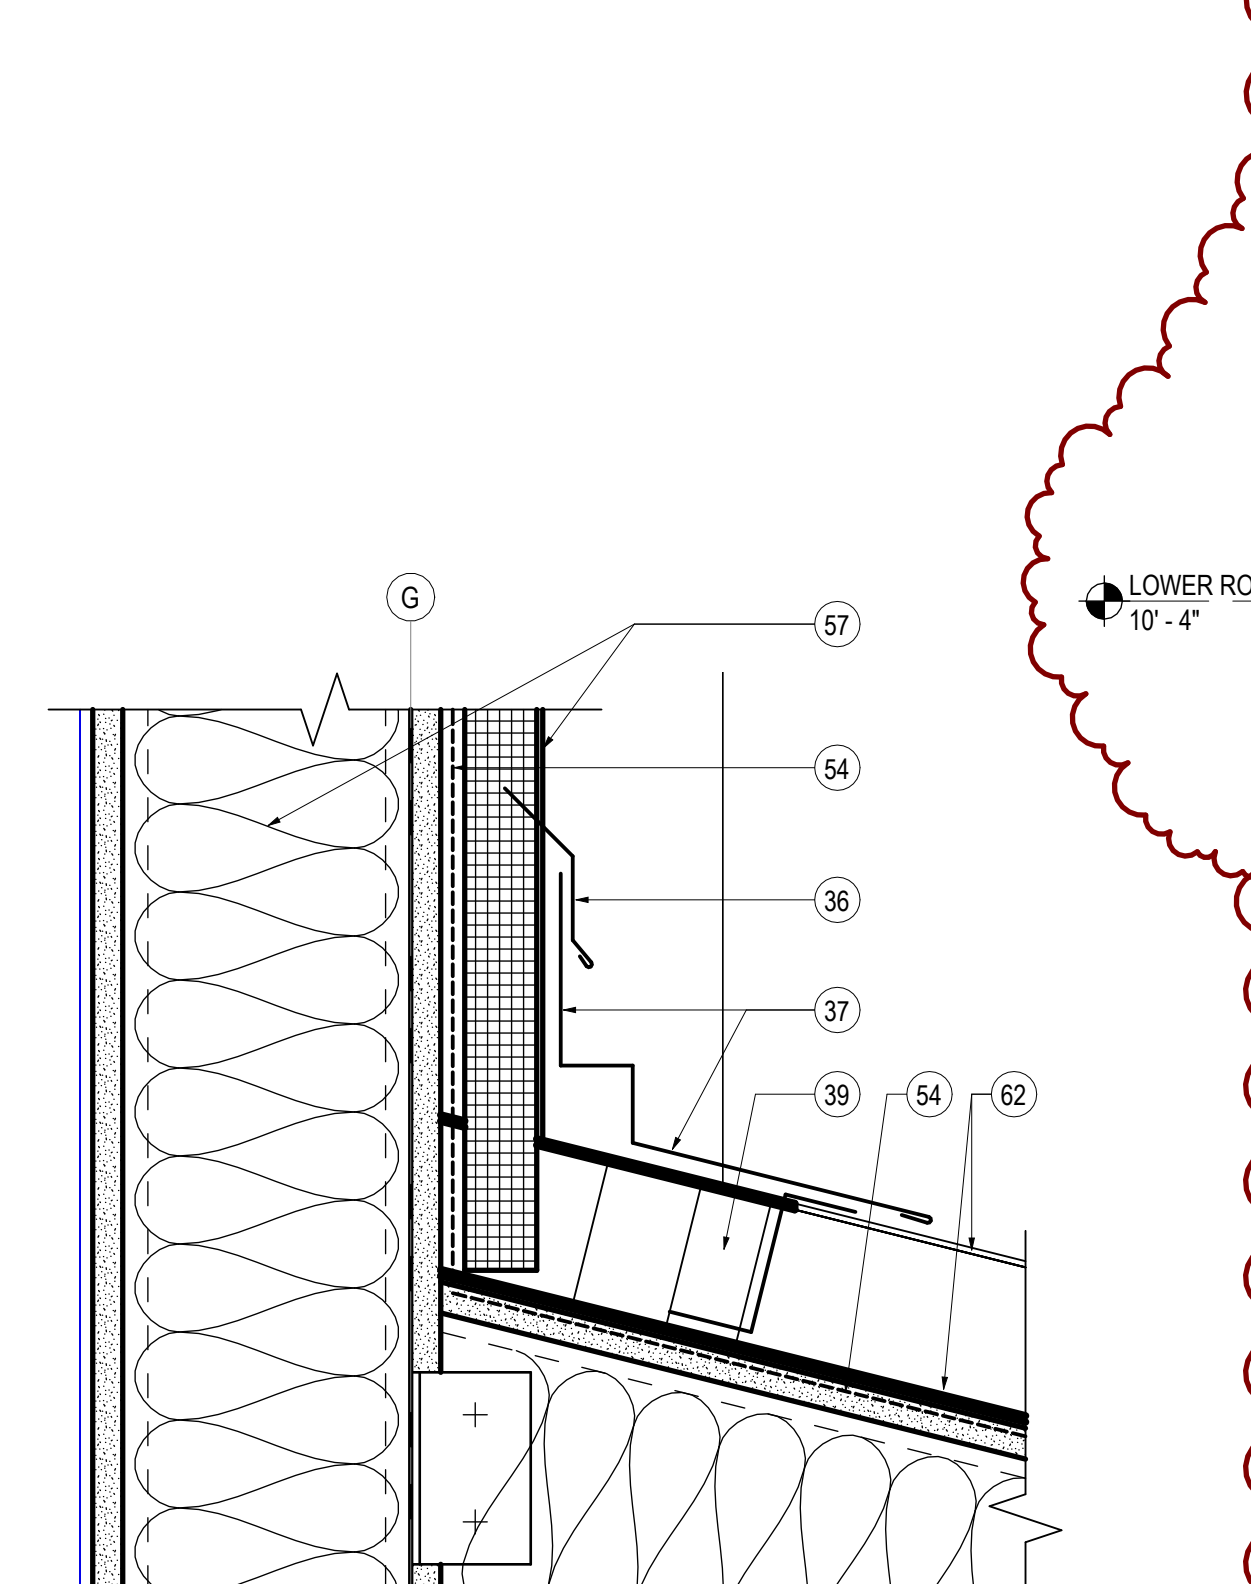


07 HVAC CHASE ROOF AT NORTH WALL
SCALE: 3" = 1'-0"

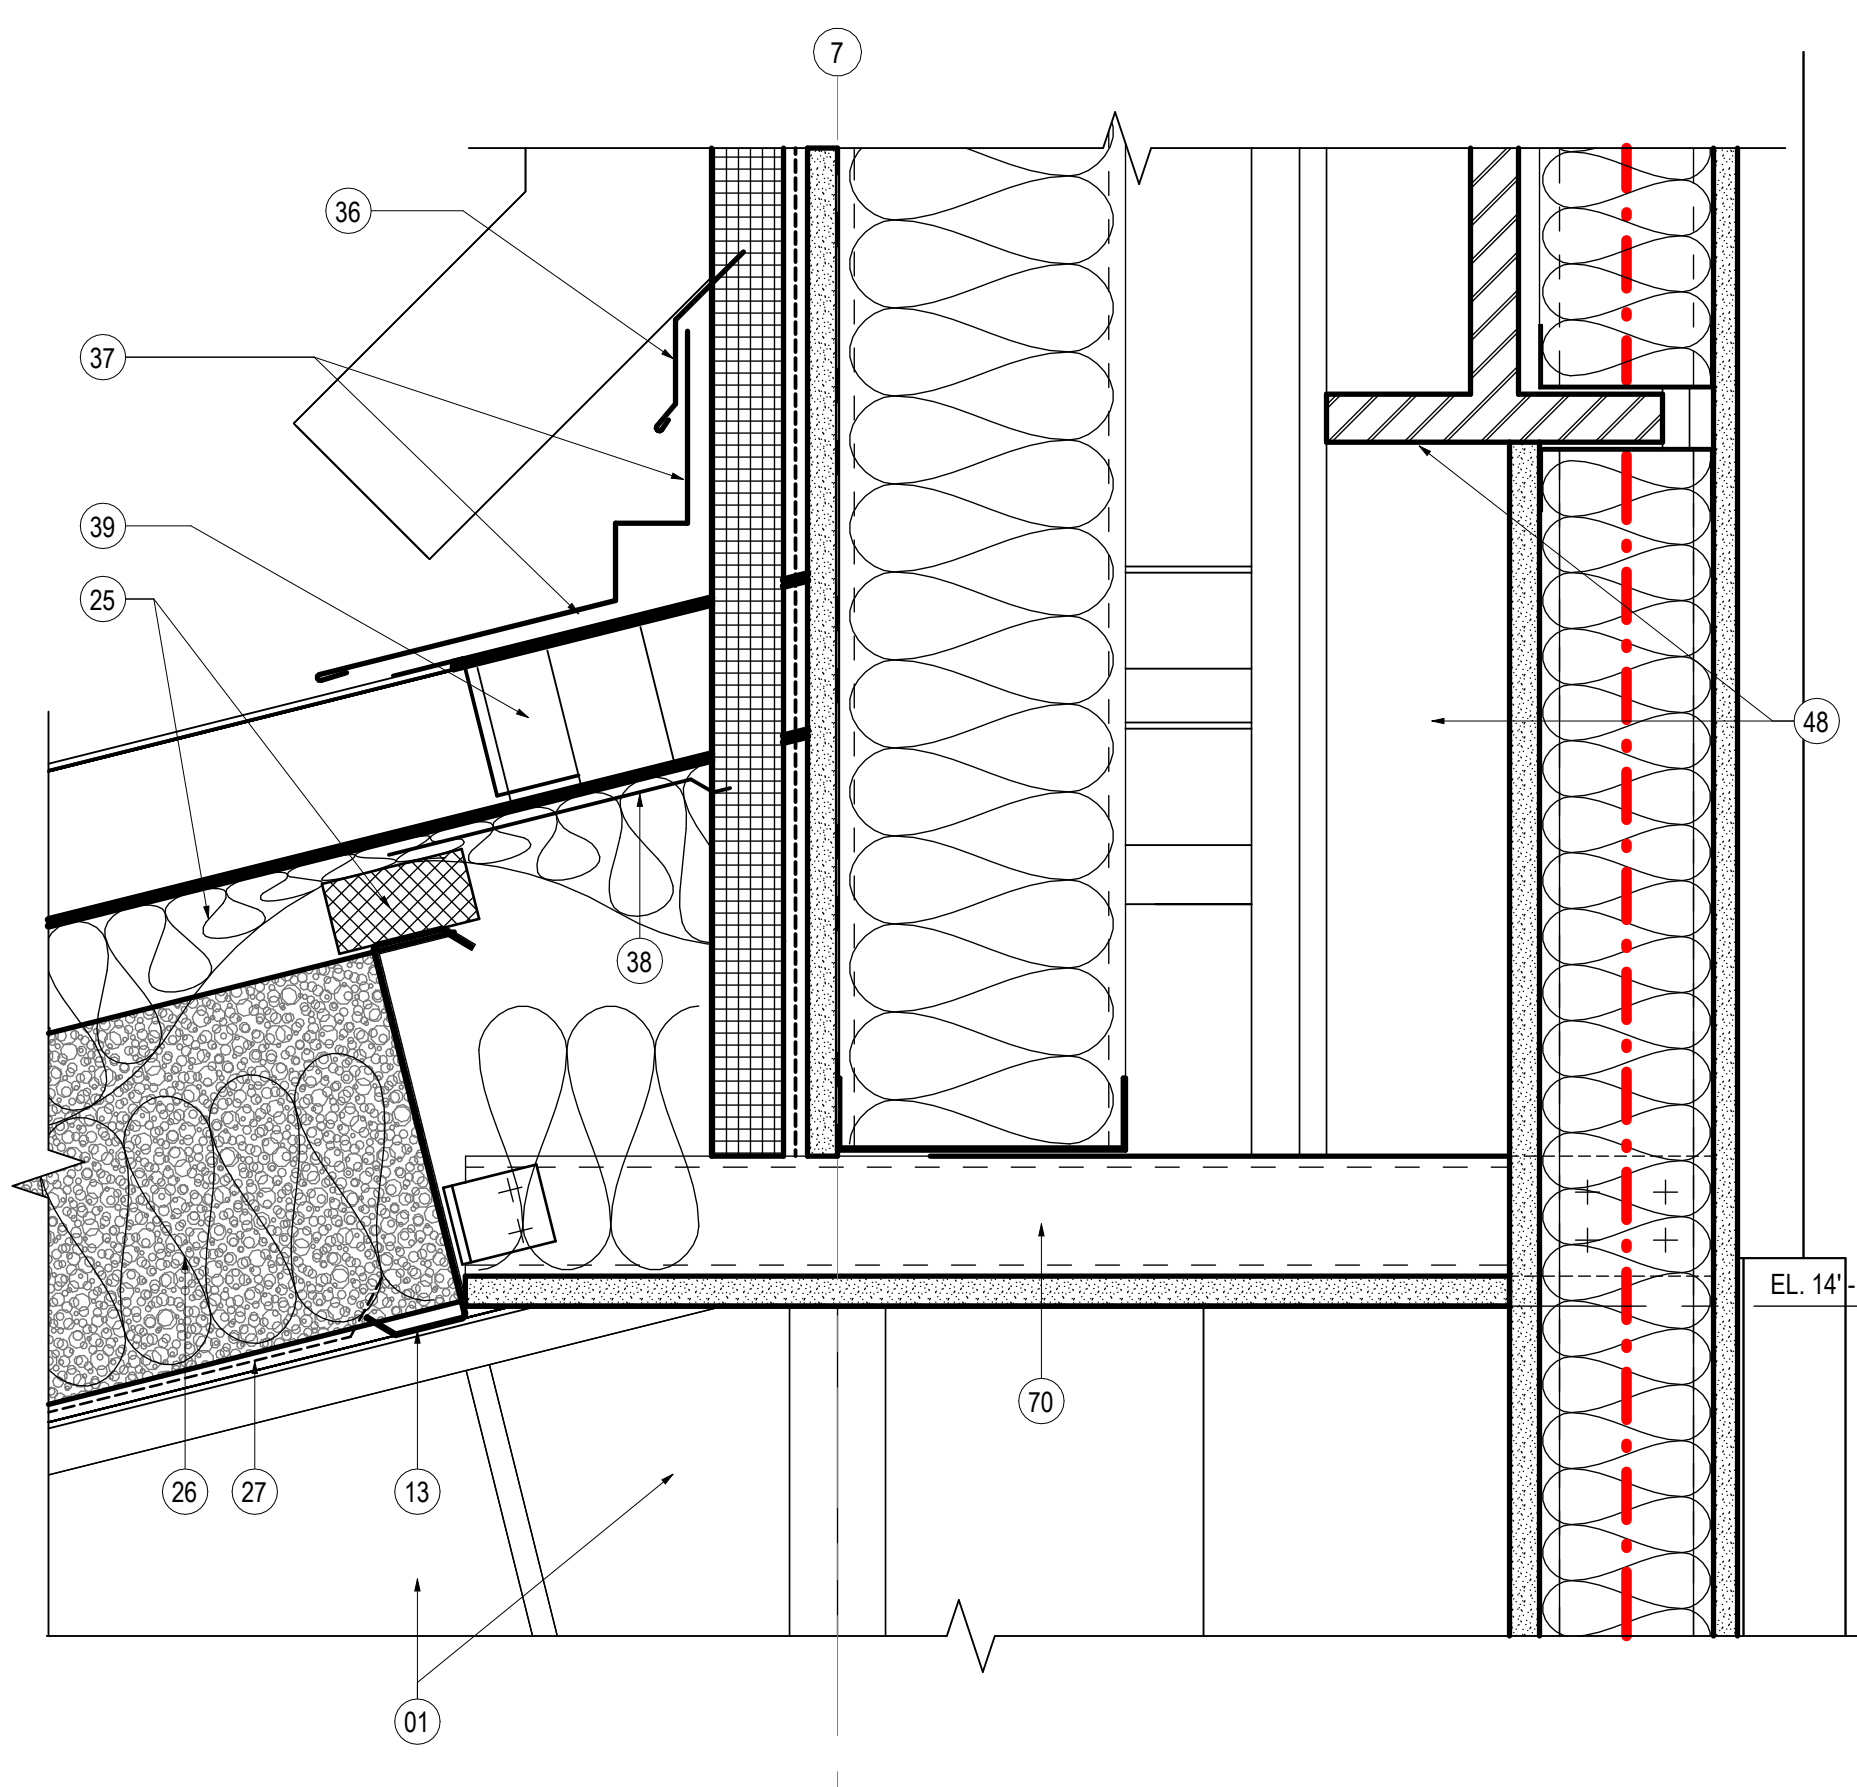


02 LOW ROOF AT UPPER EIFS WALL
SCALE: 3" = 1'-0"

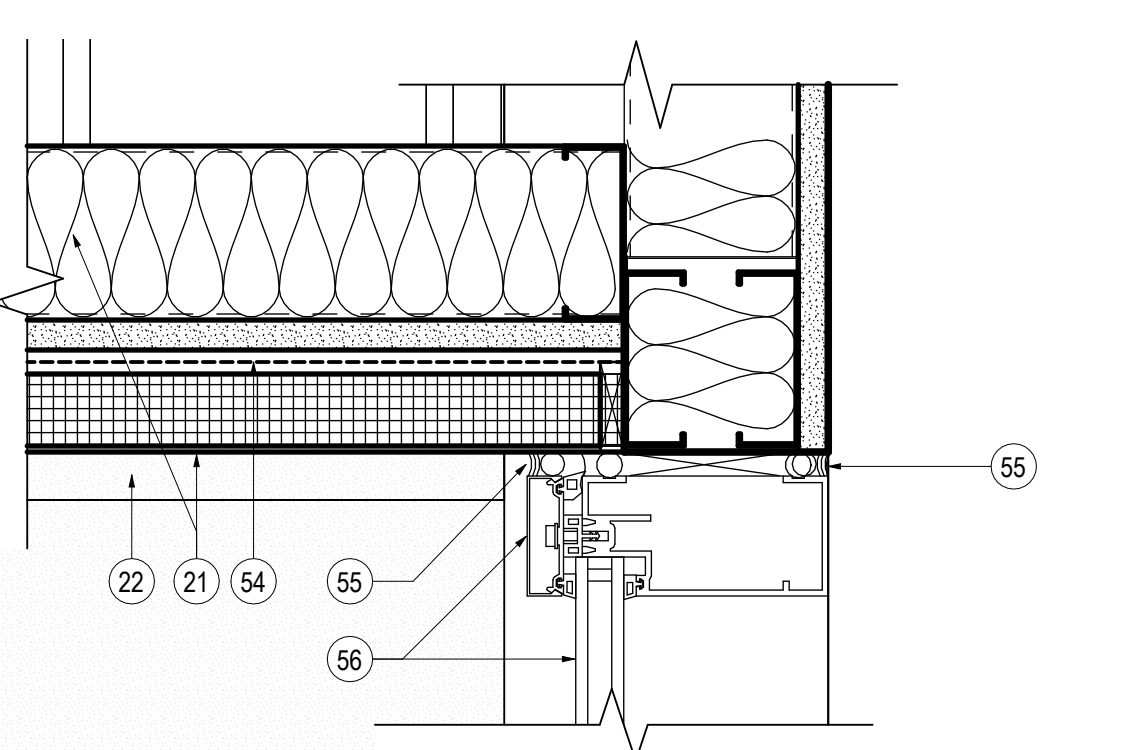

06 WALL AT MAIN ENTRY AT EIFS SOFFIT
SCALE: 3" = 1'-0"

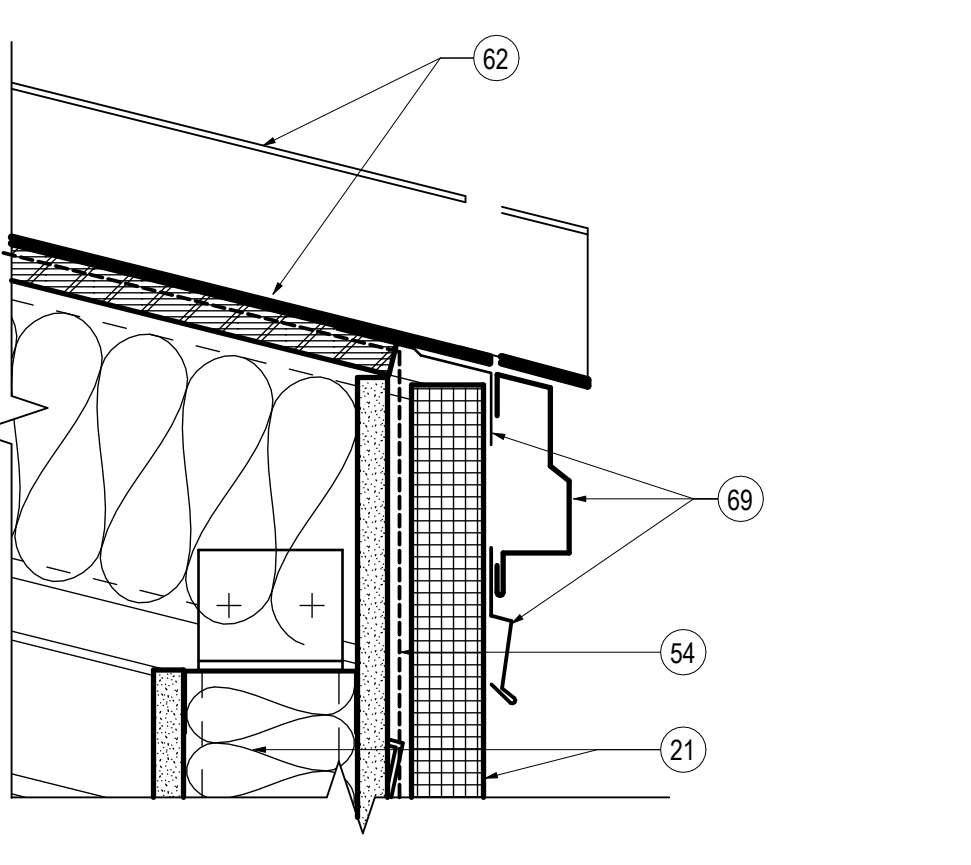

08 HVAC CHASE WALL / ROOF
SCALE: 3" = 1'-0"

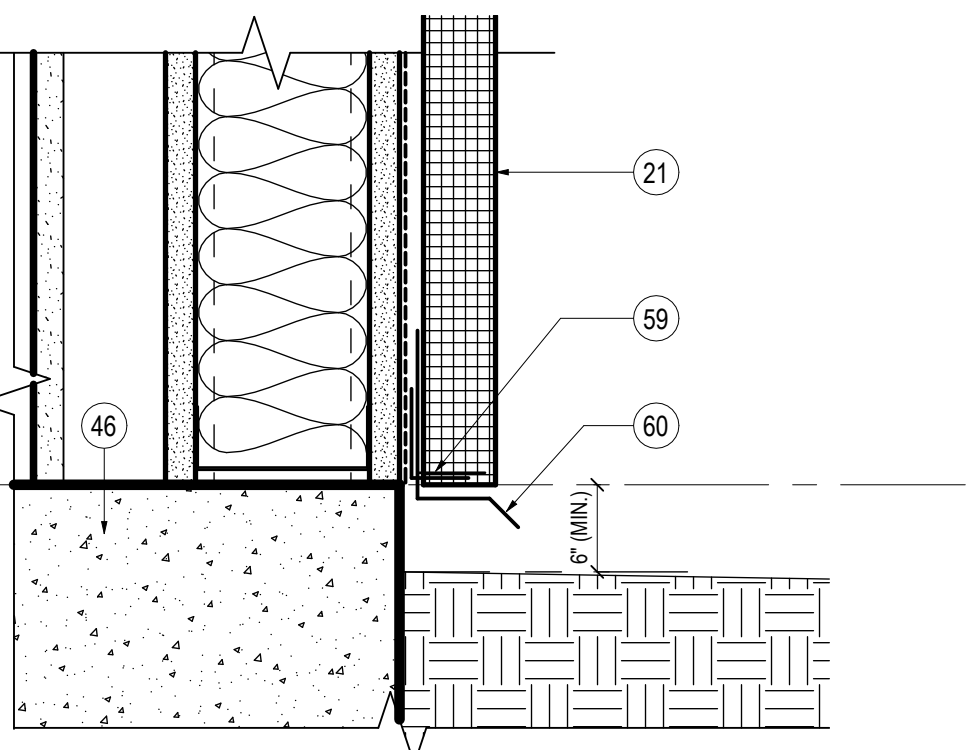

09 HVAC CHASE WALL AT FOUNDATION
SCALE: 3" = 1'-0"