


Scott

 05 May 2023

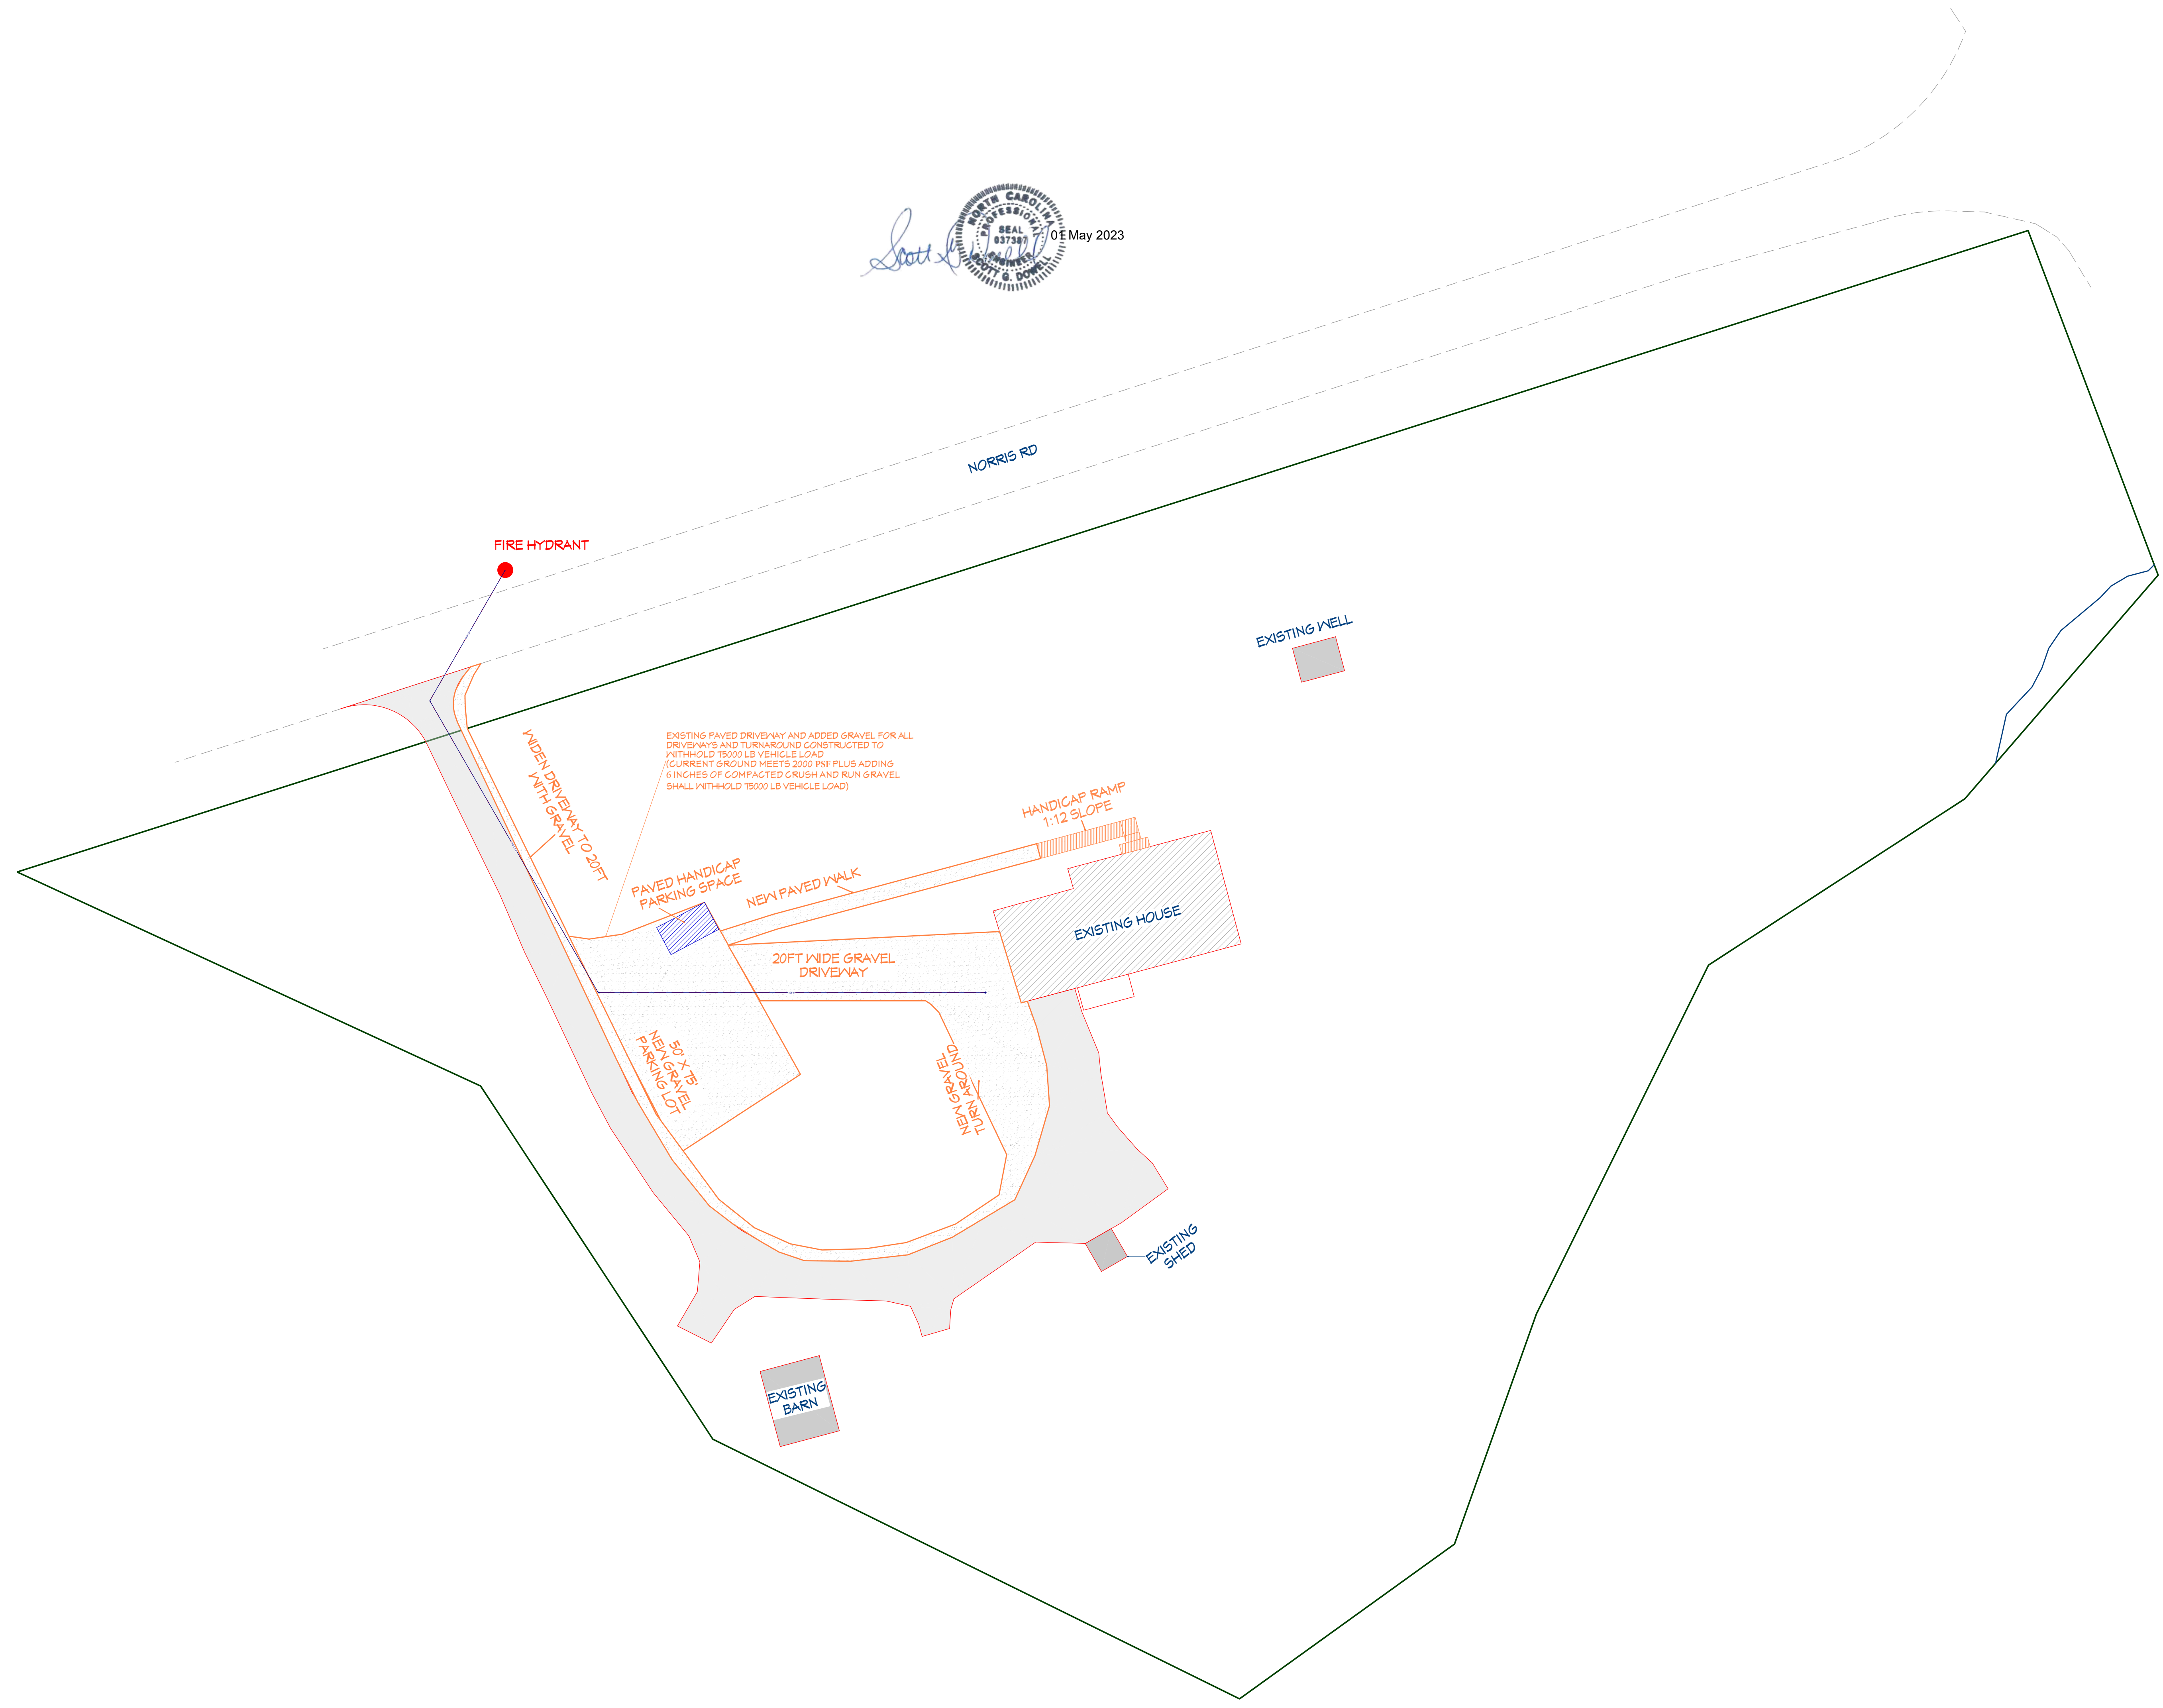

SITE PLAN

67 NORRIS RD CONVERSION

DRAWINGS PROVIDED BY:
TONY R WIMBERLY
 PO BOX 1793
 ANGLIER, NC 27501
 (919) 669-7066

DATE:


4/24/2023

SCALE:


1" = 25'

SHEET:

1

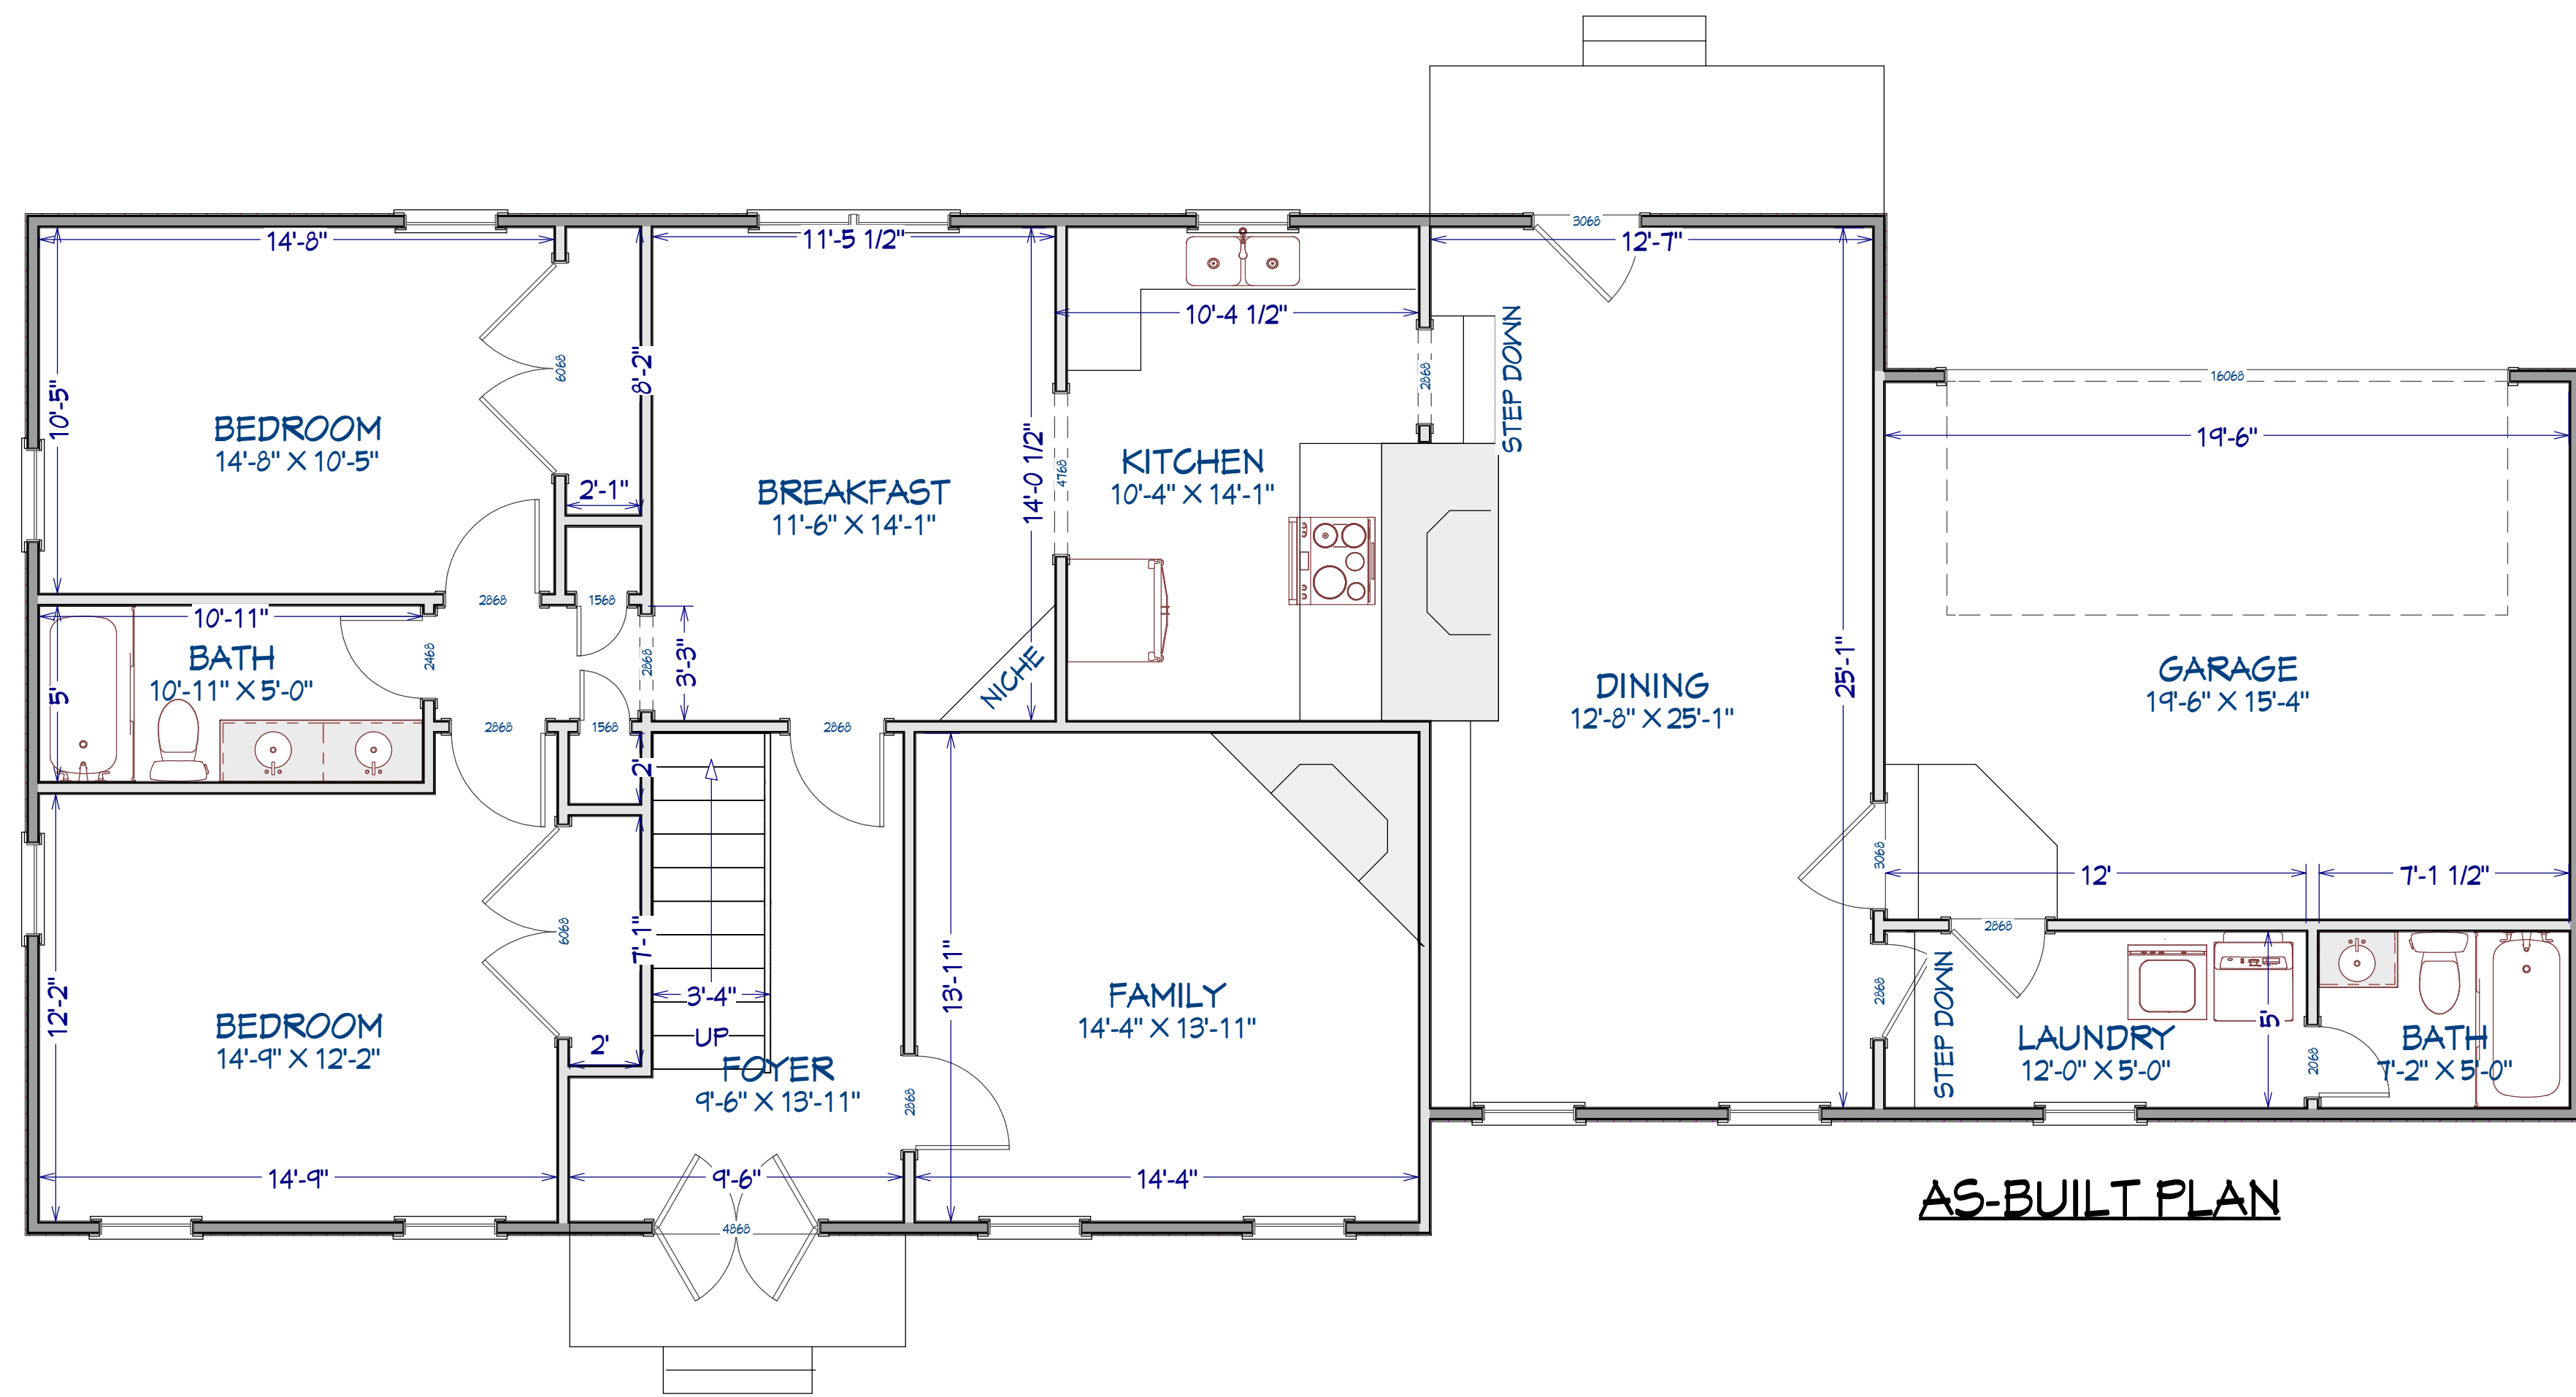



AS-BUILT PLAN

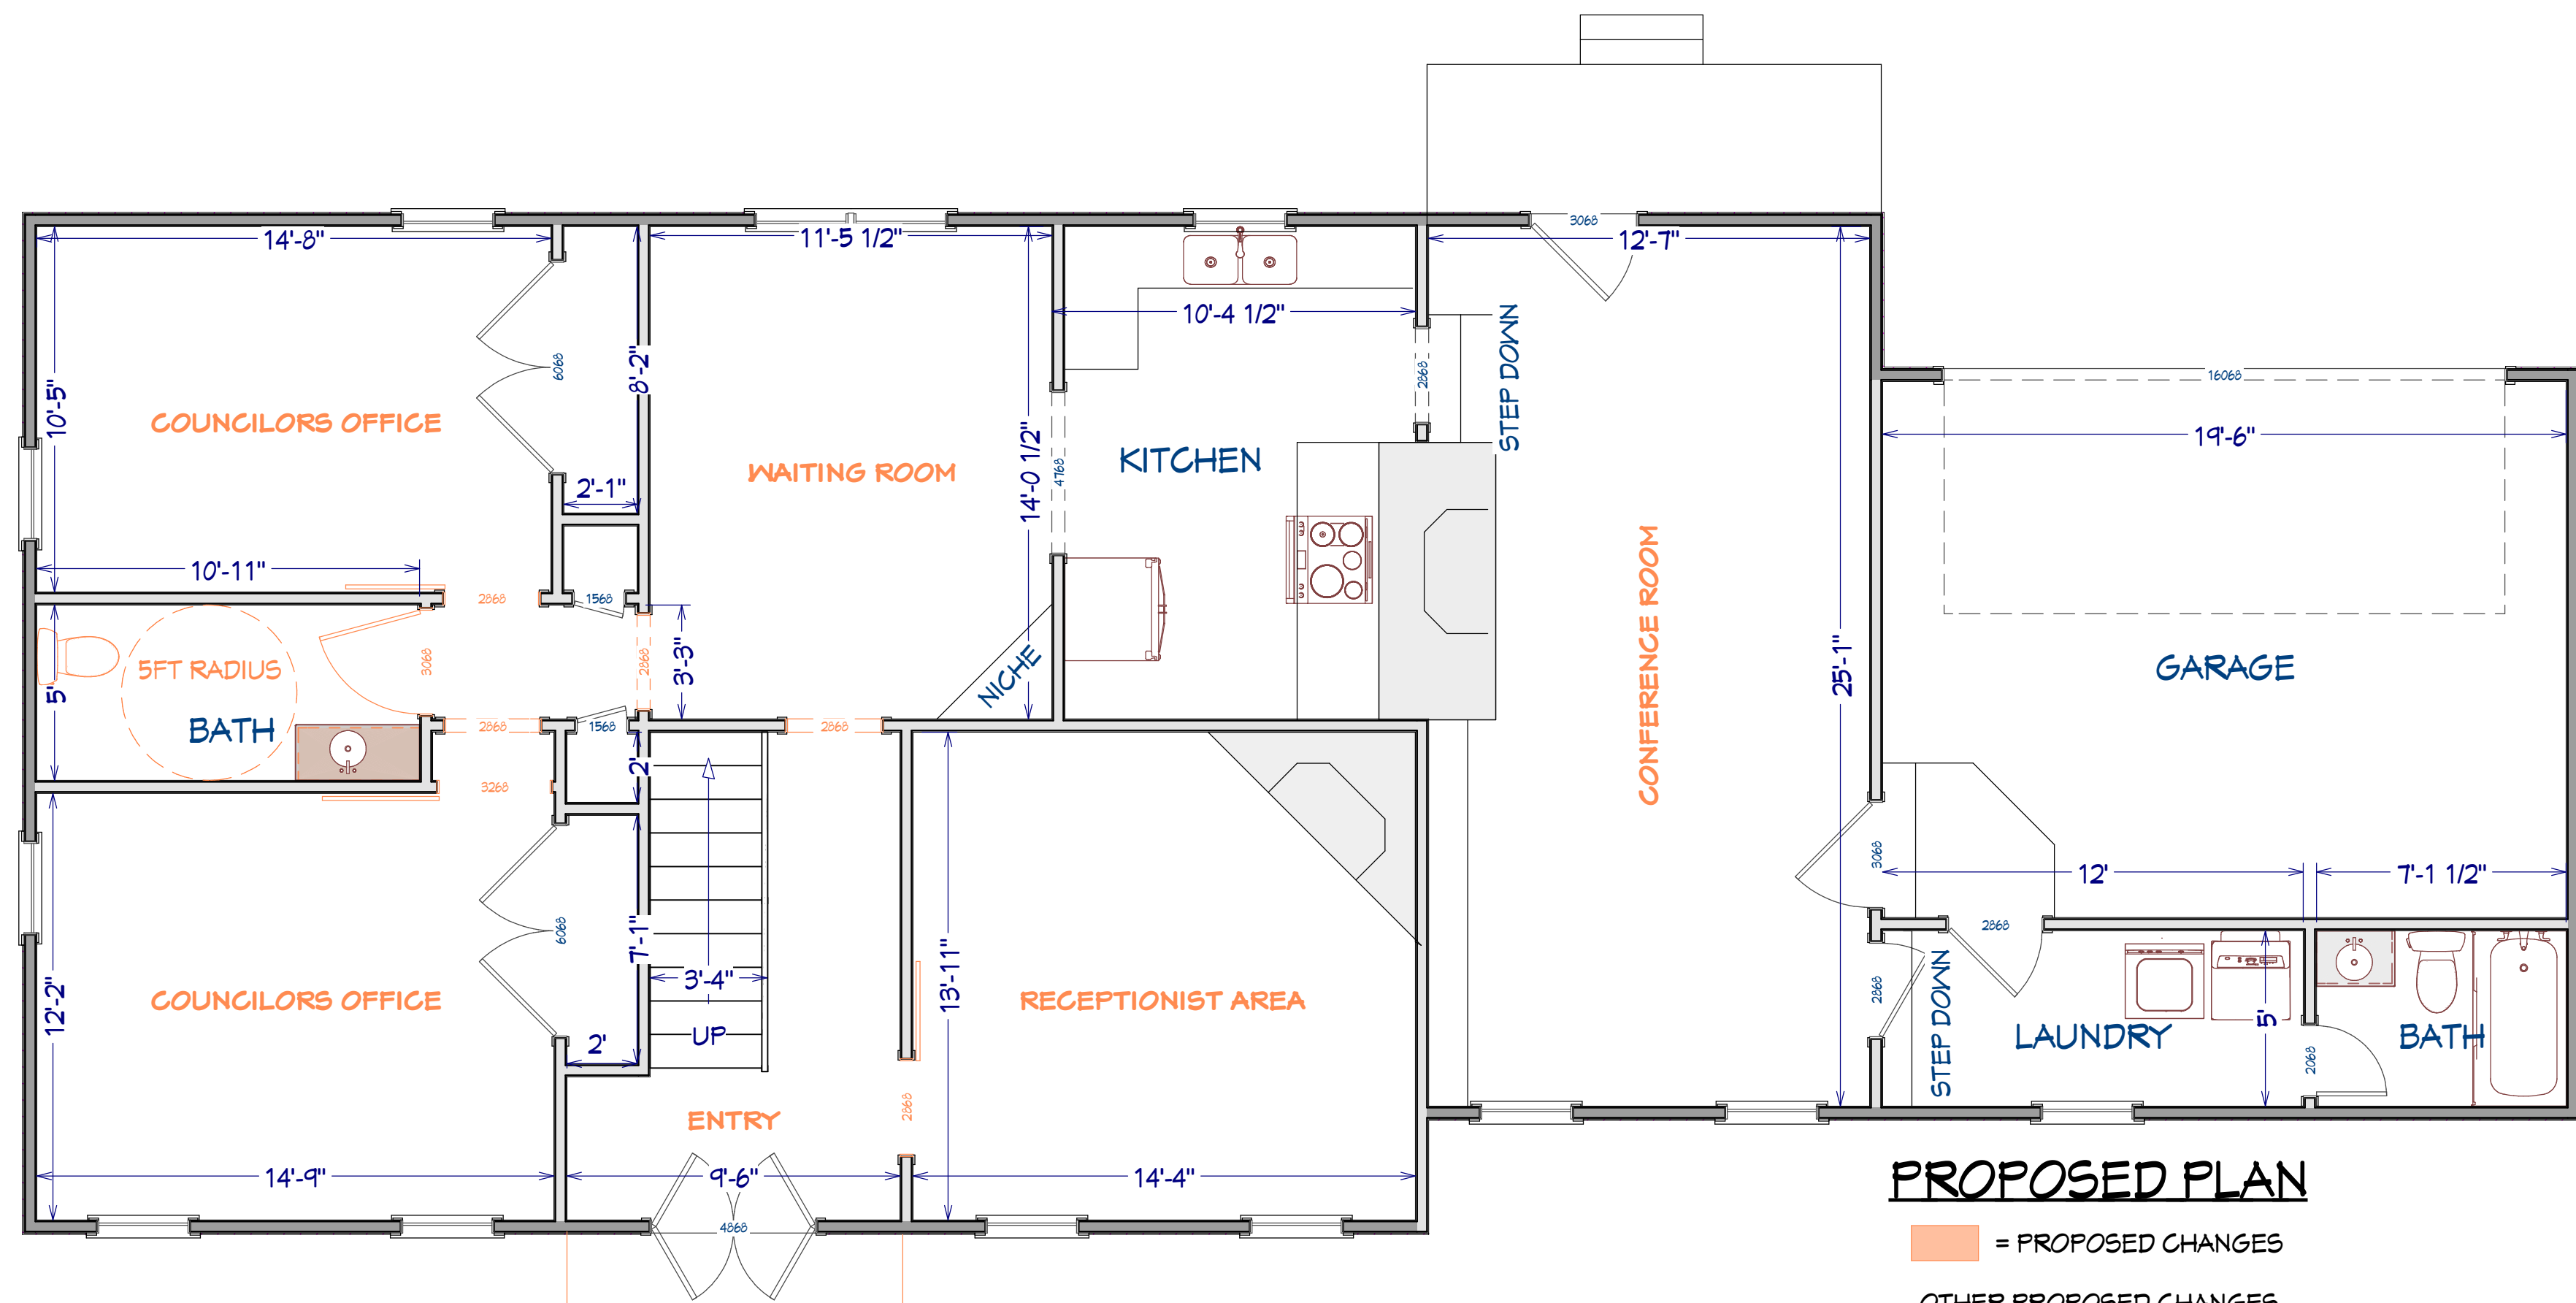


PROPOSED PLAN

- = PROPOSED CHANGES
- OTHER PROPOSED CHANGES
- * CHANGE ALL DOOR HARDWARE TO LEVER STYLE

HANDICAP RAMP
1:12 SLOPE

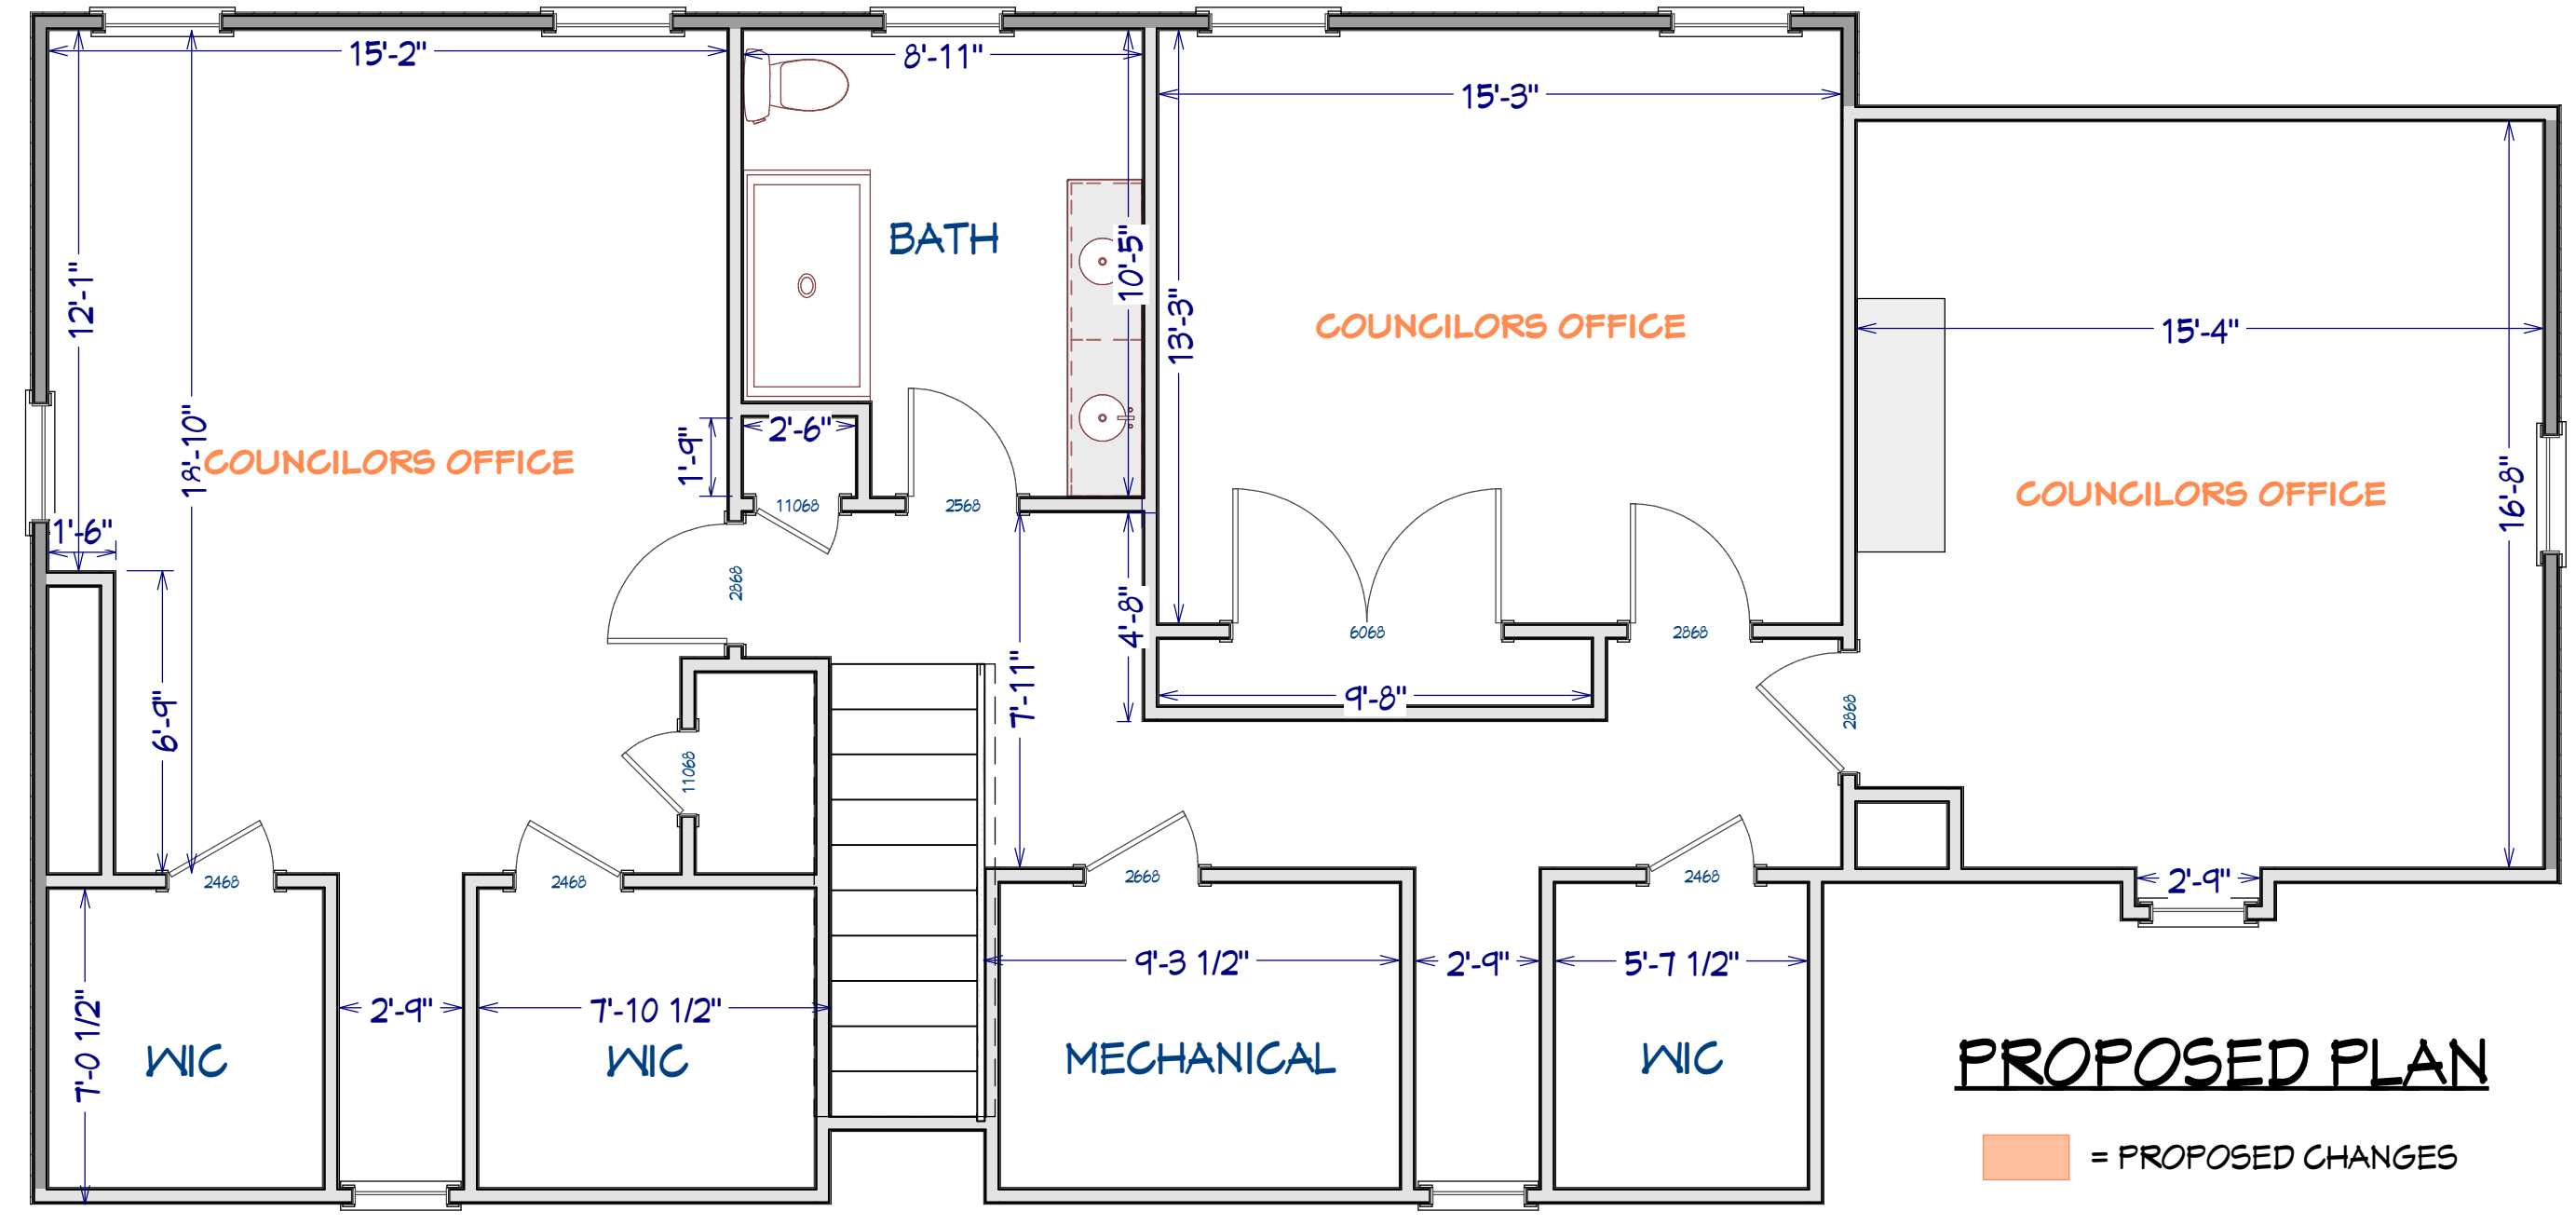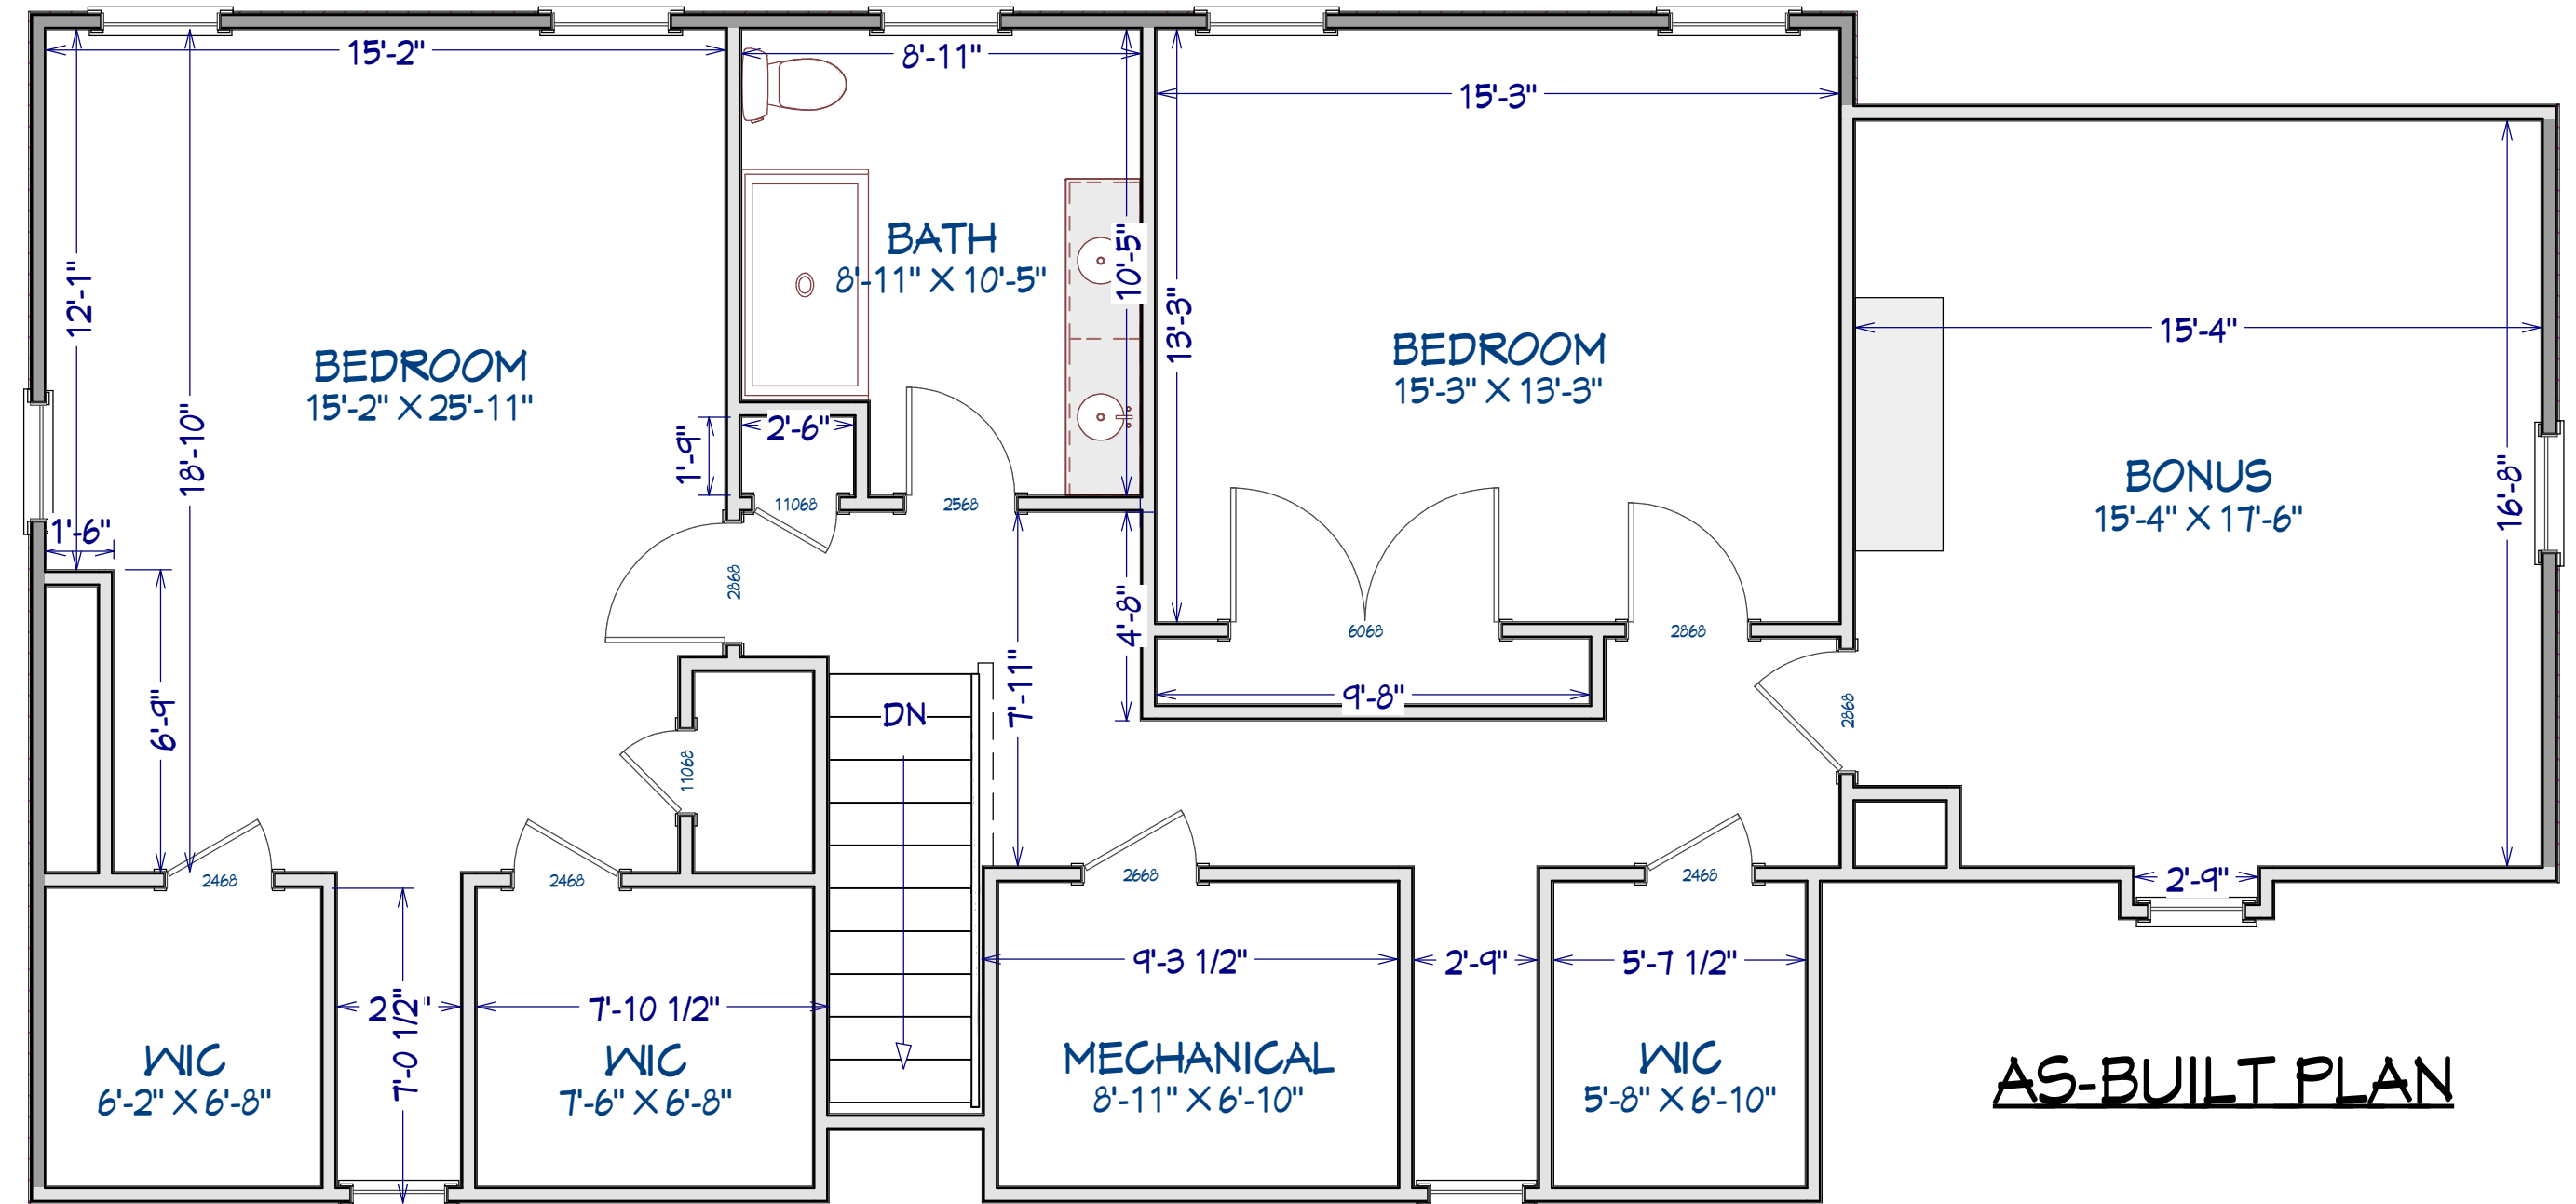


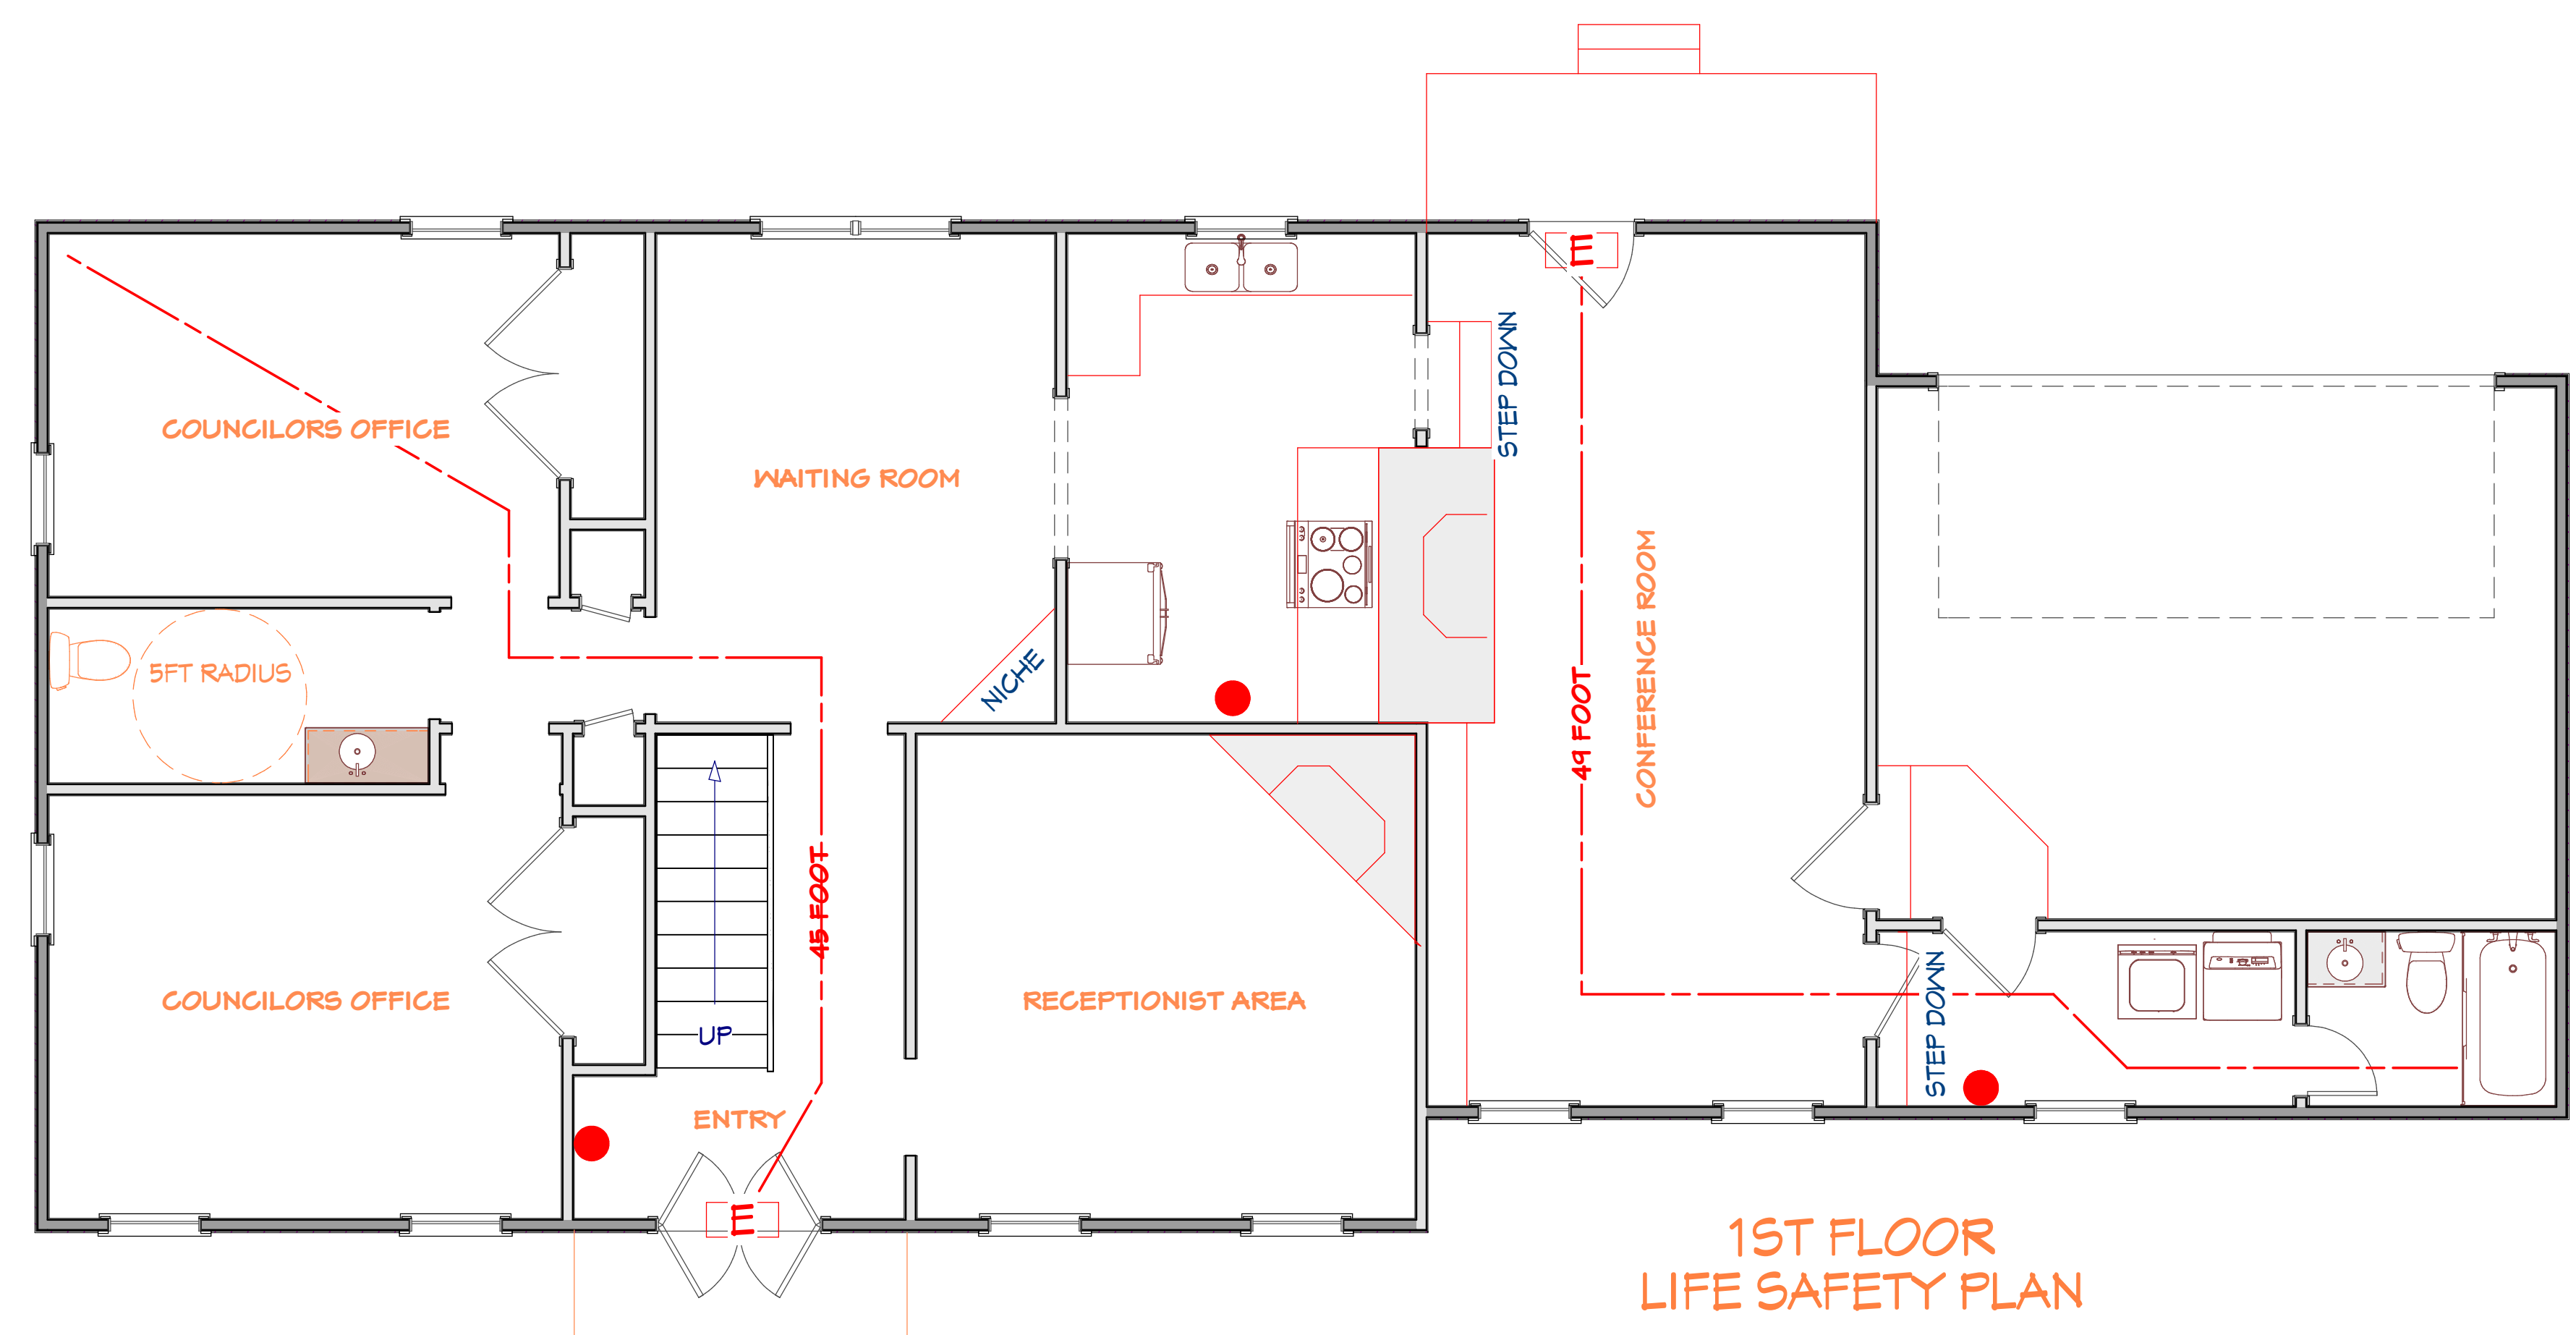

= FIRE EXTINGUISHER
= EXIT SIGN WITH

HANDICAP RAMP
1:12 SLOPE

1ST FLOOR
LIFE SAFETY PLAN

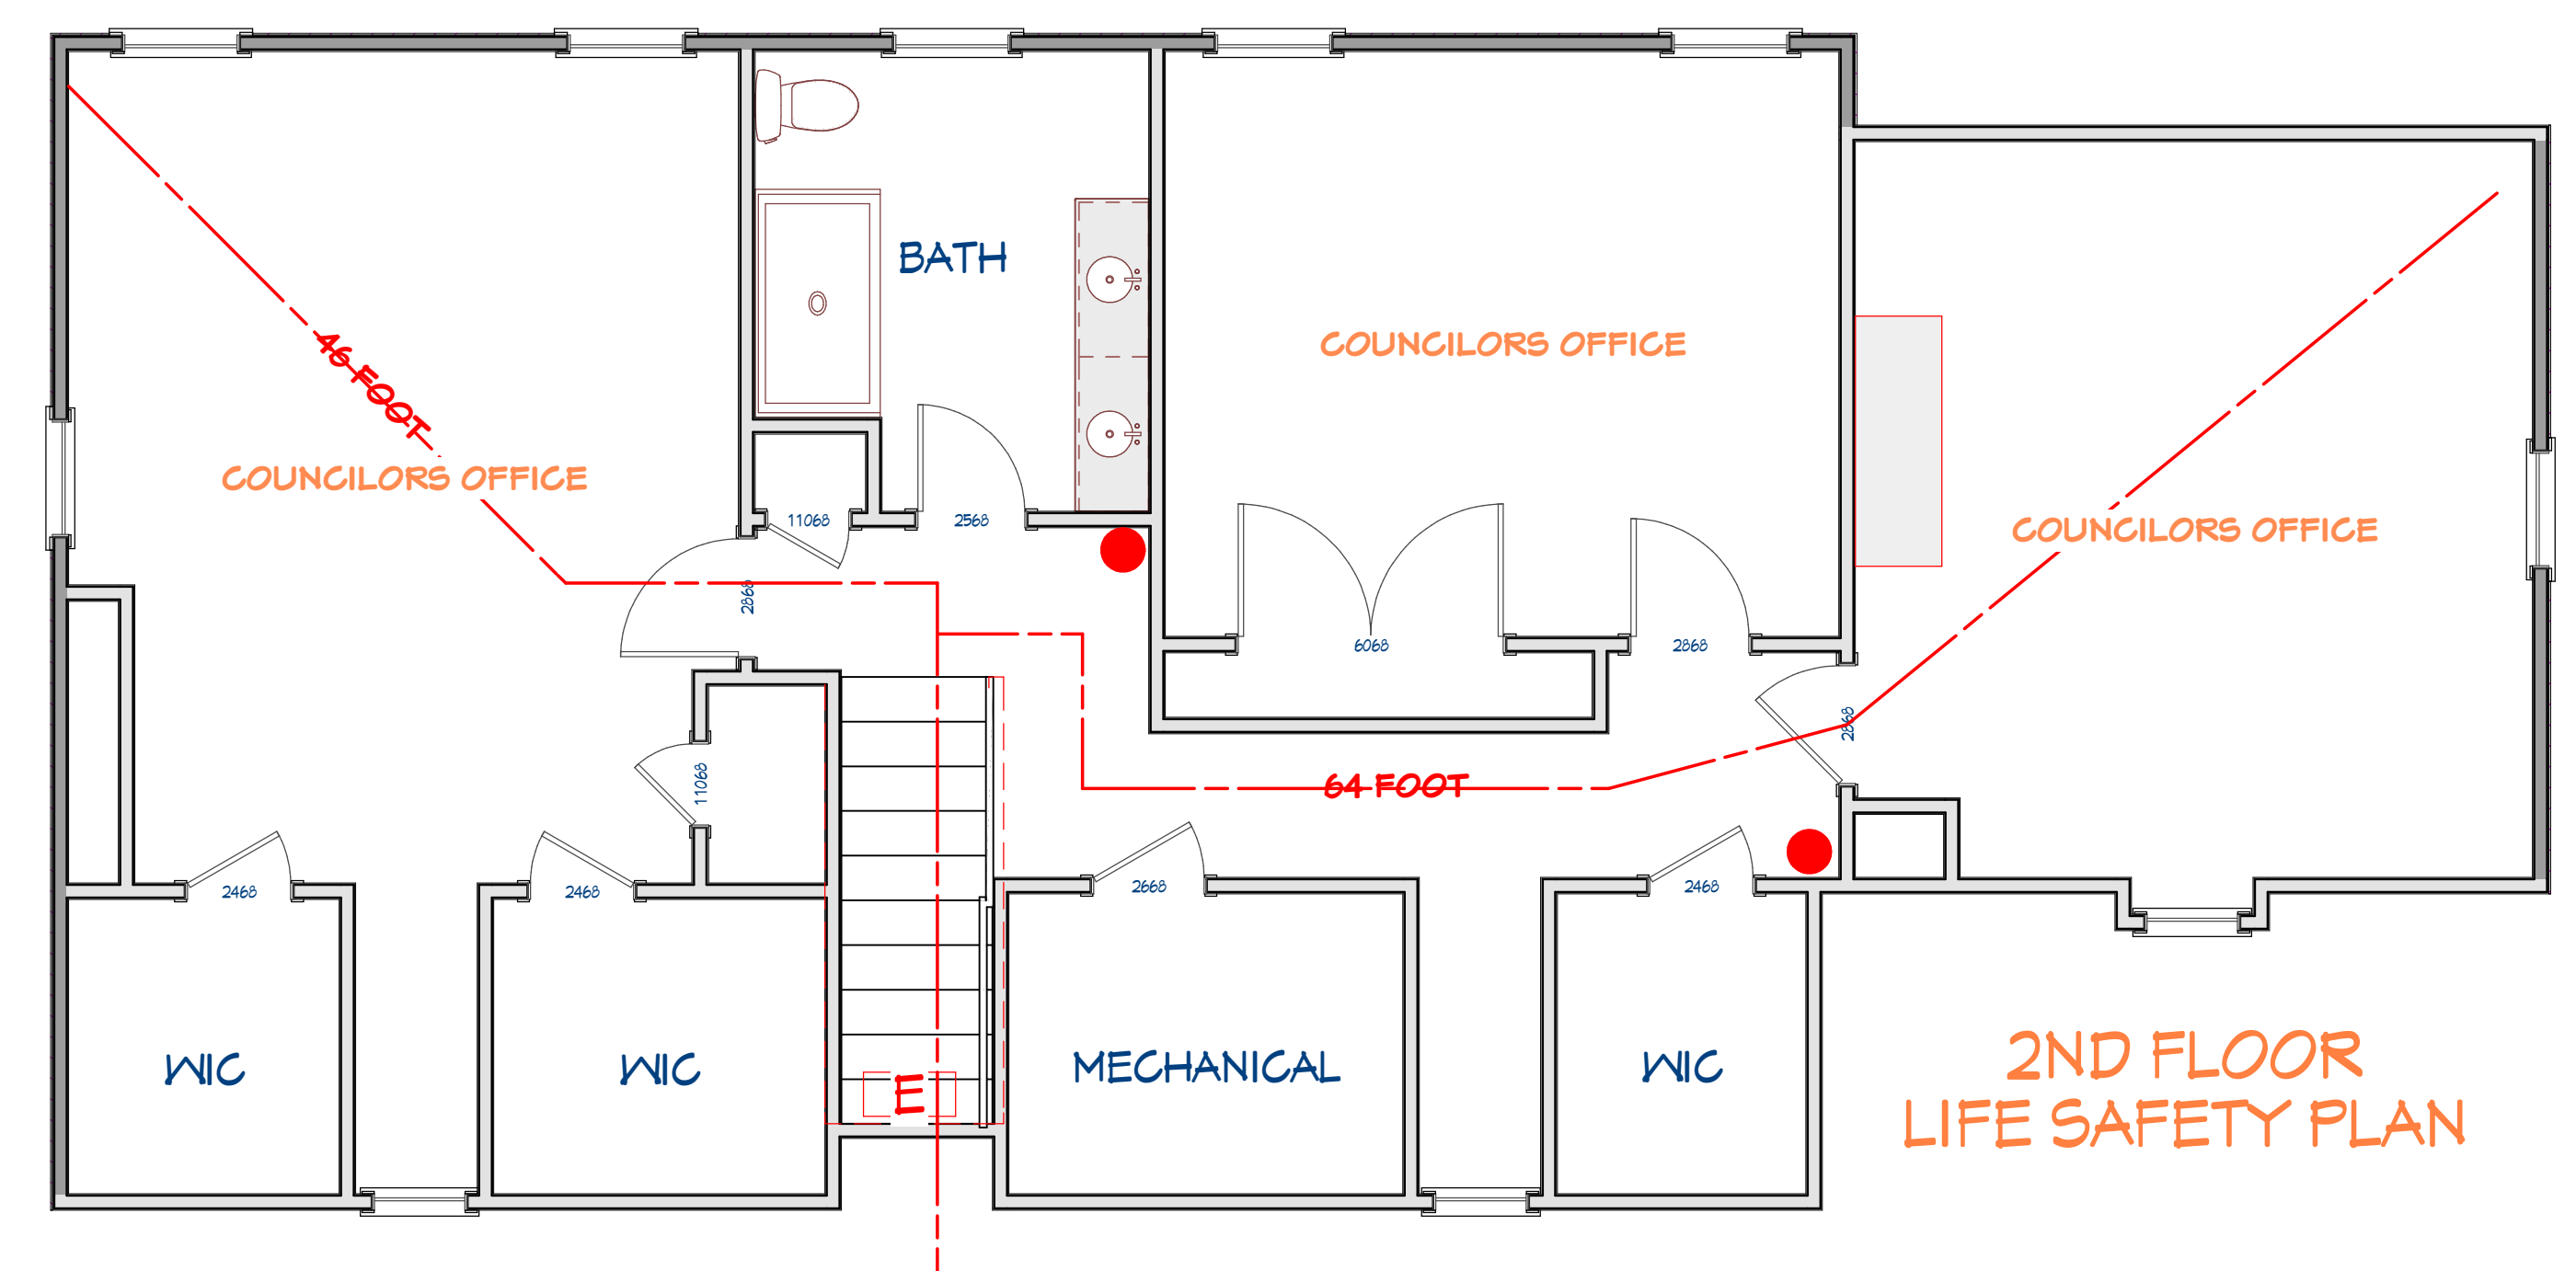

● = FIRE EXTINGUISHER
[E] = EXIT SIGN WITH
EMERGENCY LIGHTING

2ND FLOOR
LIFE SAFETY PLAN