



Reviewed for Fire Code Compliance



Leslie Jackson

09/25/2023 10:21:04 AM


Application for Plan Review

Application # .KCM.2309.0005
Date Received: 9.18.23 Received By: dyckusm
Name of Project: Emmanuel Baptist Church
Physical Address of Project: 1460 Hwy 24
Cameron, NC 28326
Plans Submitted By: Jonathan Newton
Project Phone: (919) - 356-6588
Contact Person/Address: Jonathan Newton
254 Blanchard Rd
Sanford NC 27332
Contact Email: pastor.jonathannewton@gmail.com
Contact Phone: (919) - 356-6588 () - -
Contractor's Name/Info: _____


Contractor's Phone: () - -

- Plans that are submitted will be reviewed as quickly as possible with an average time of review between 7-10 working days.
- Status checks may be conducted on plan reviews by visiting the website <http://htweb.harnett.org/Click2GovBP/Index.jsp> or by calling the Harnett County Central Permitting Office (910-893-7525, Option #2), or the Harnett County Fire Marshal's Office (910-893-7580).
- Approved plans must be picked up from the Central Permitting Office and all fees paid before any required inspections can be conducted.

DESIGNED BY
 CHECKED BY
 DATE
 SCALE

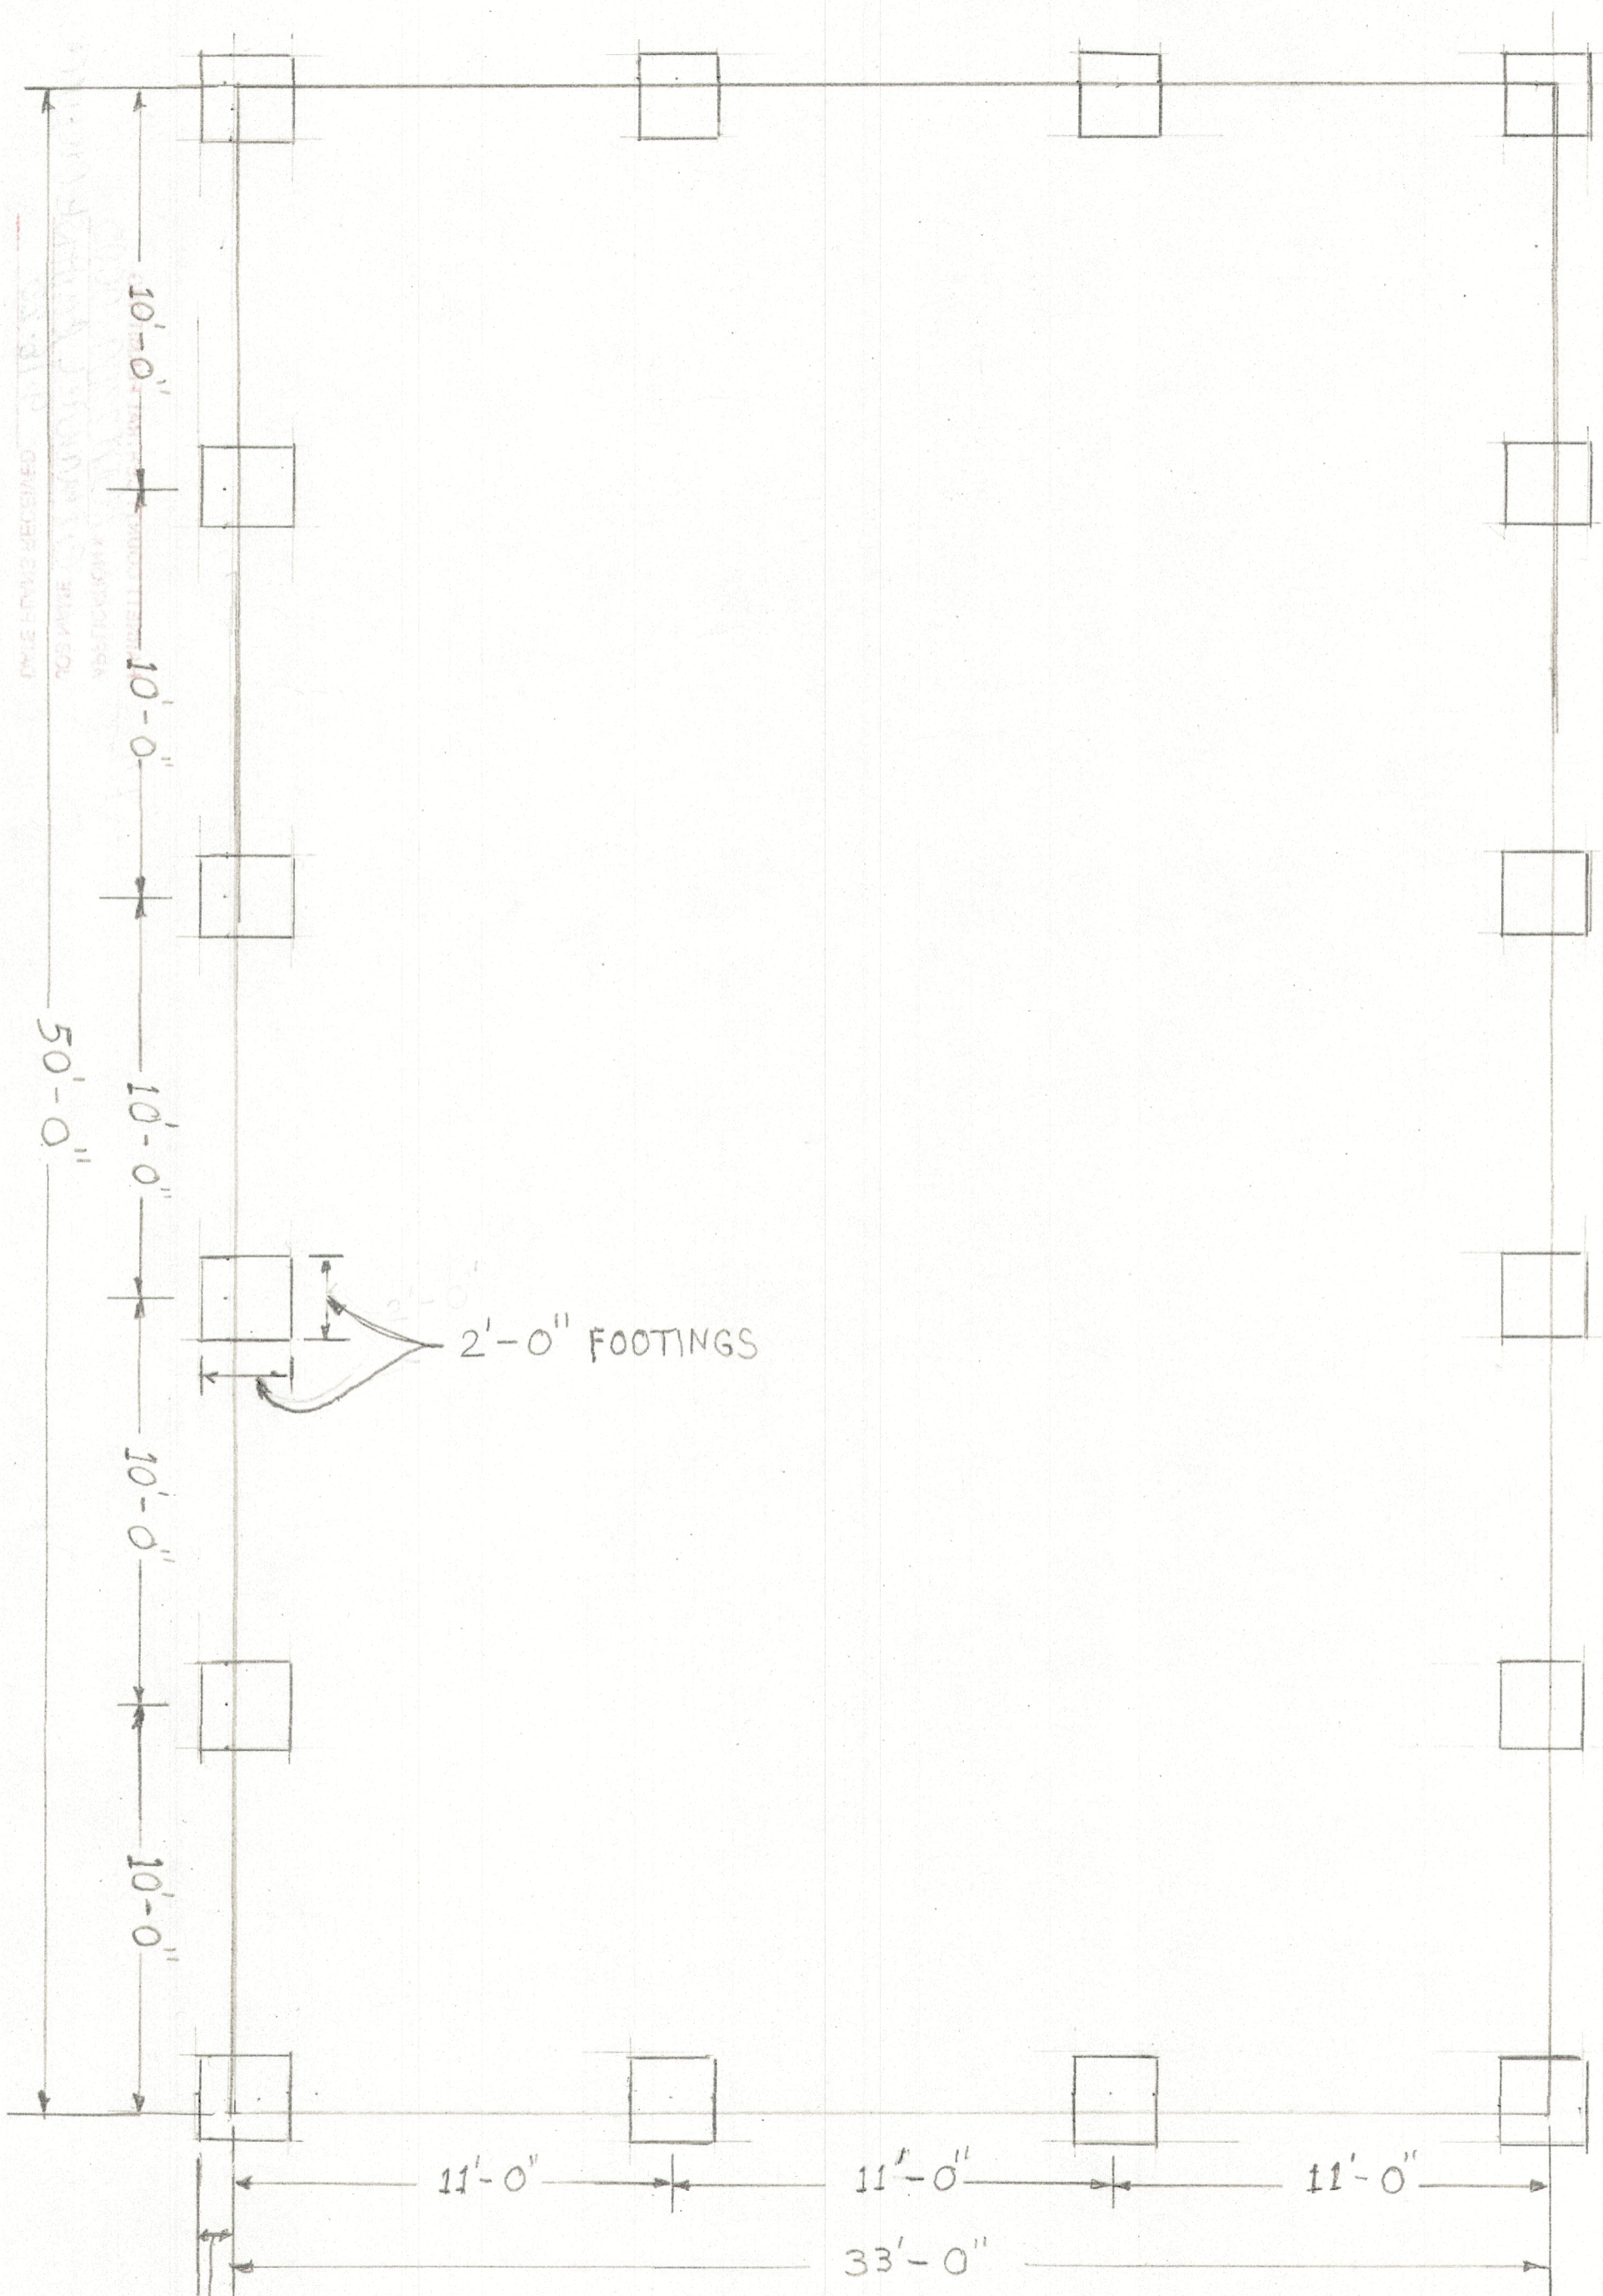

FOUNDATION PLAN SCALE 1/4" = 1 FOOT

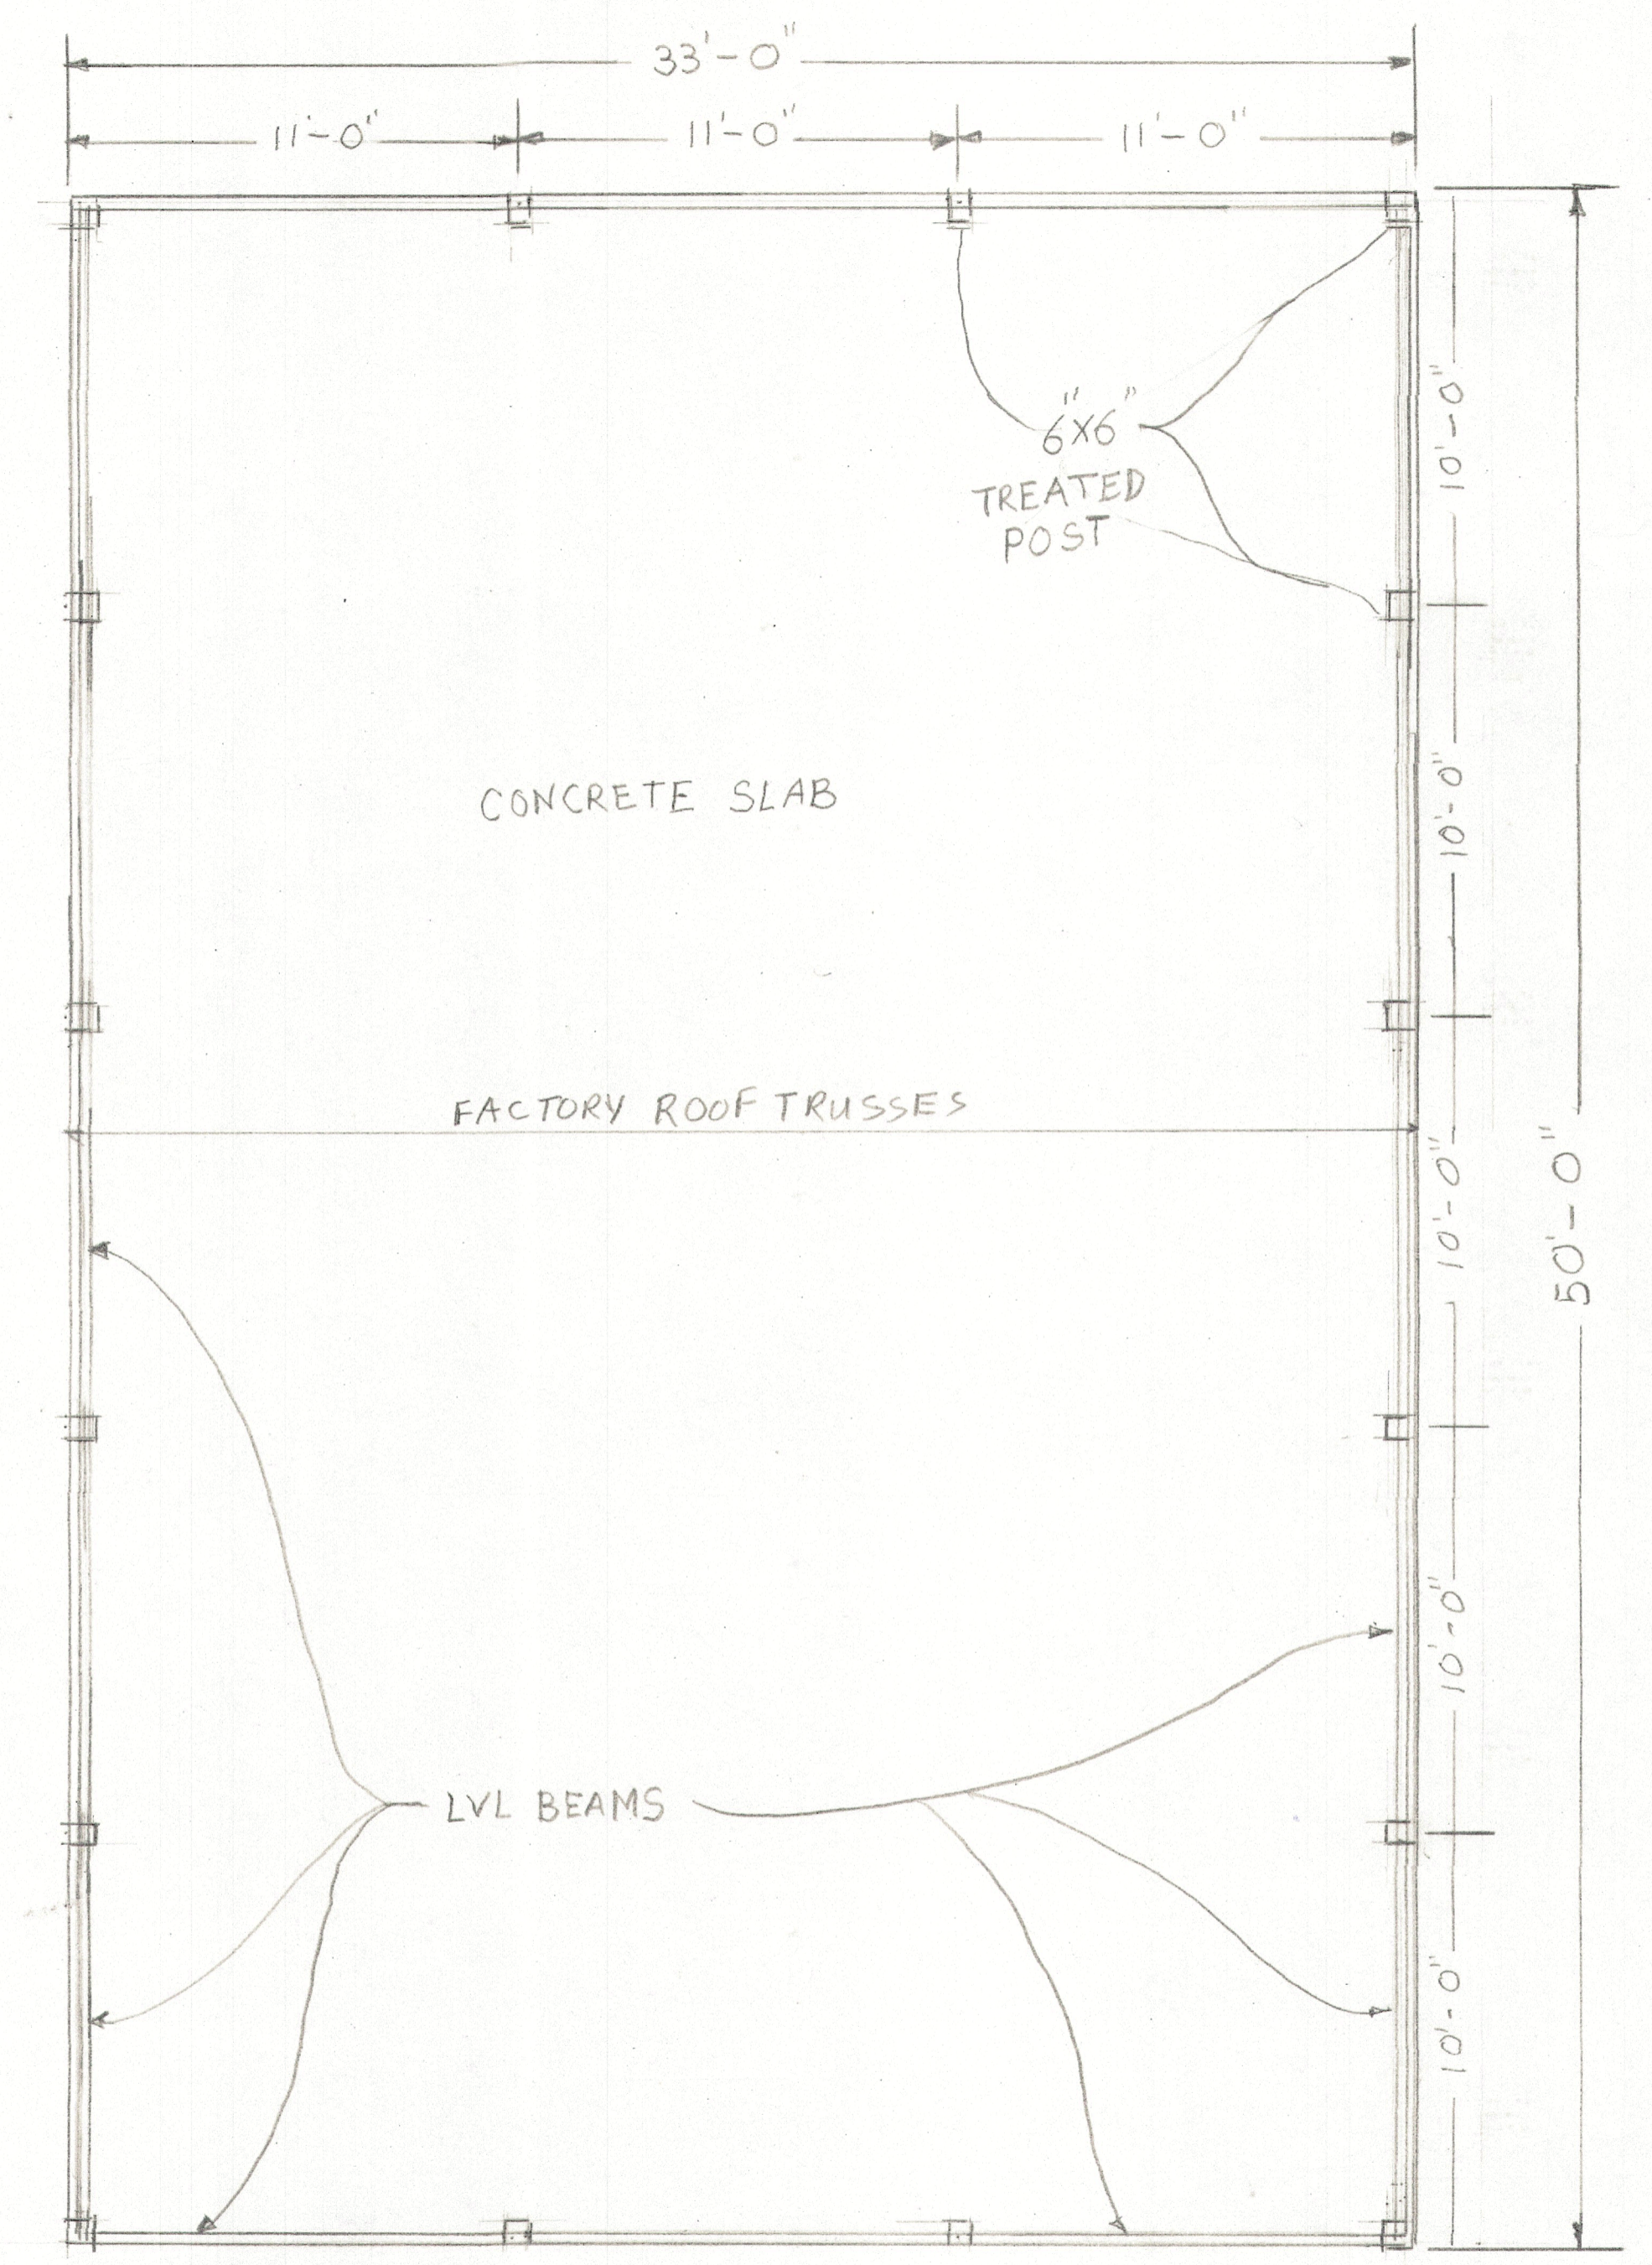

FLOOR PLAN SCALE 1/4" = 1 FOOT

SCALE: 1/4" = 1'	APPROVED BY:	DRAWN BY:
DATE:		REVISED:
		DRAWING NUMBER: