


REVISIONS	
NO.	DATE

A NEW CHAMPS CONVENIENCE STORE
 U.S. HWY 401 NORTH
 Fuquay-Varina, North Carolina 27526

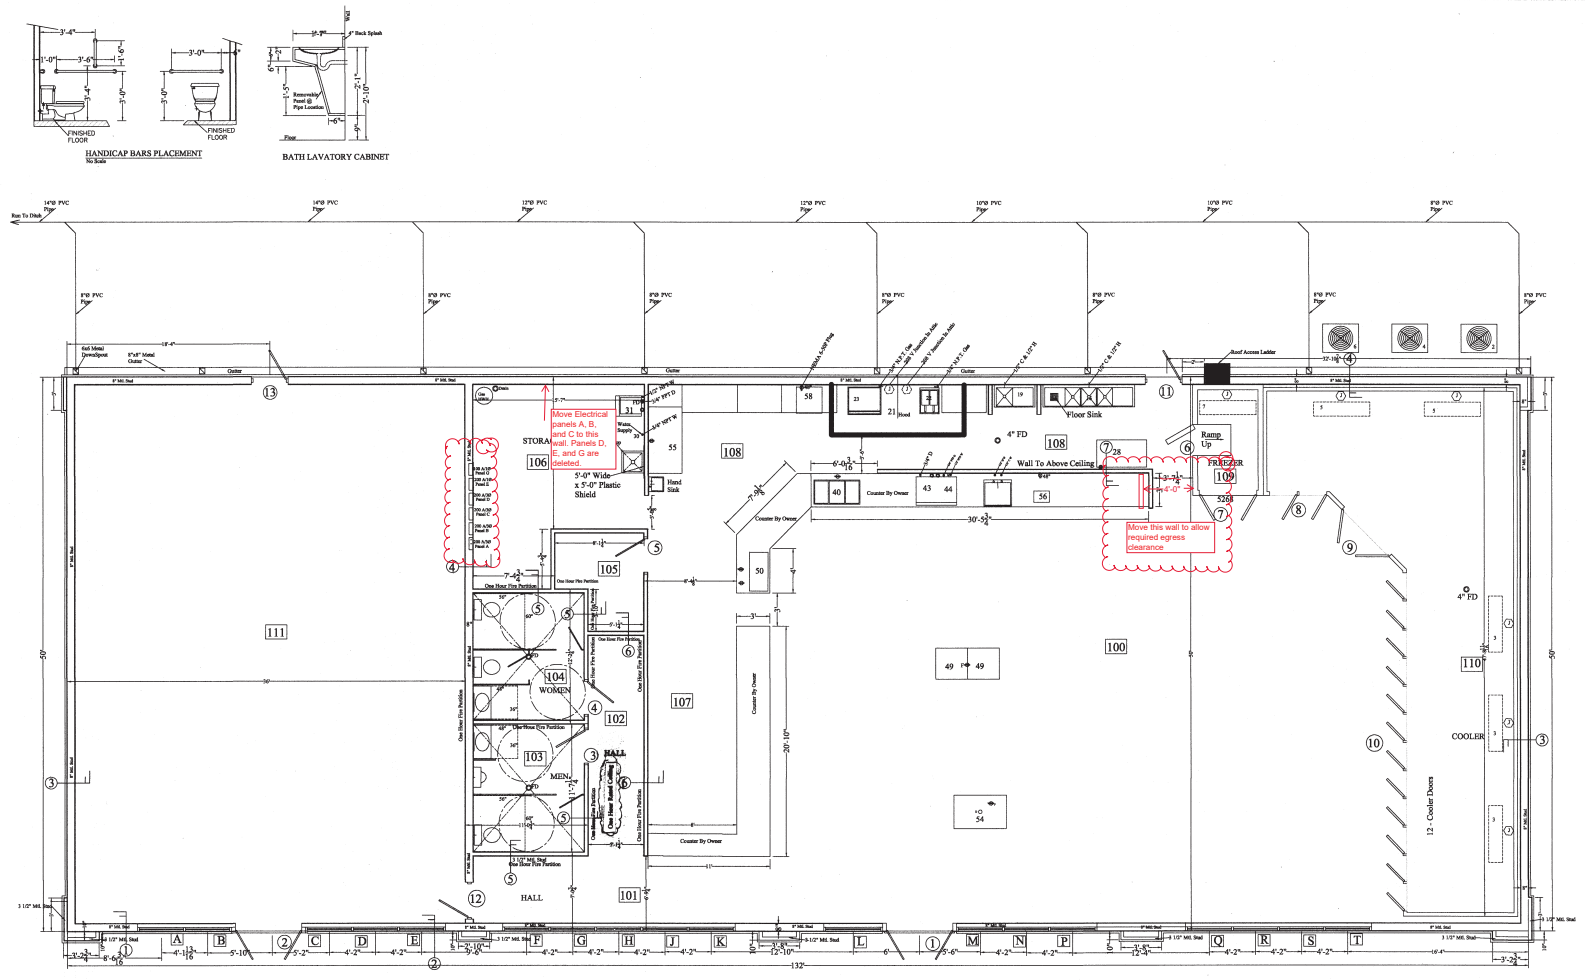
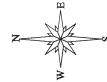
RJB, PE, PA
 C-0289
 Robert J. Bracken
 ENGINEERING • SURVEYING
 3768 Caribonion Road • Sanford, NC 27330

SCALE: 1/4" = 1'-0"
 DRAWN BY: WJL
 DATE:
 CHECKED BY: RJB
 DWG. NUMBER:
 JOB NUMBER:

SHEET NO:
G - 2

SEAL

 12/14/22

RECEIVED
 By Regency Construction at 2:42 pm, Feb 20, 2024



FLOOR PLAN
 Scale: 3/16" = 1'-0"