



TYPICAL WALL SECTION - "3"
No Scale x 2


Note: R-21 Insulation Typical In All Exterior Wall Cavities and R-3.6 Continuous Exterior Insulation On All Exterior Walls per Com-Check Details

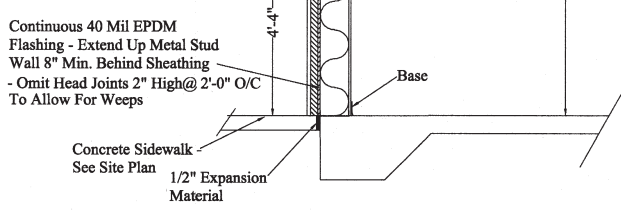

TYPICAL WALL SECTION - "1"
No Scale x 2

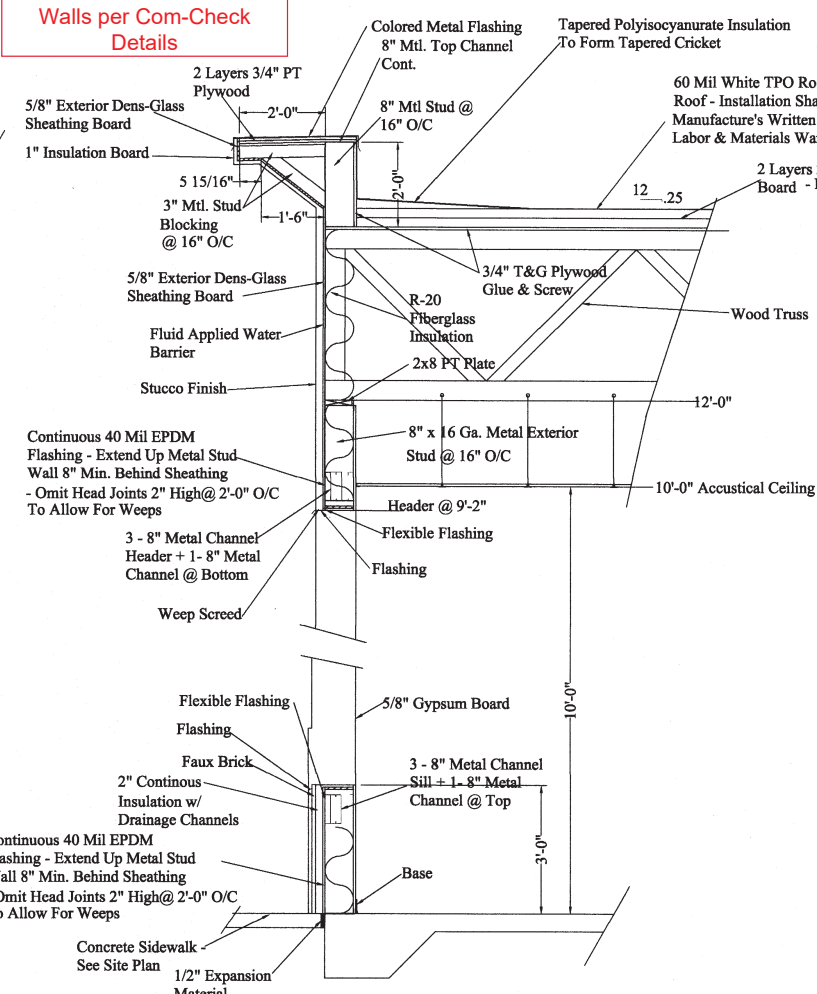


TYPICAL WALL SECTION - "2"
No Scale x 2

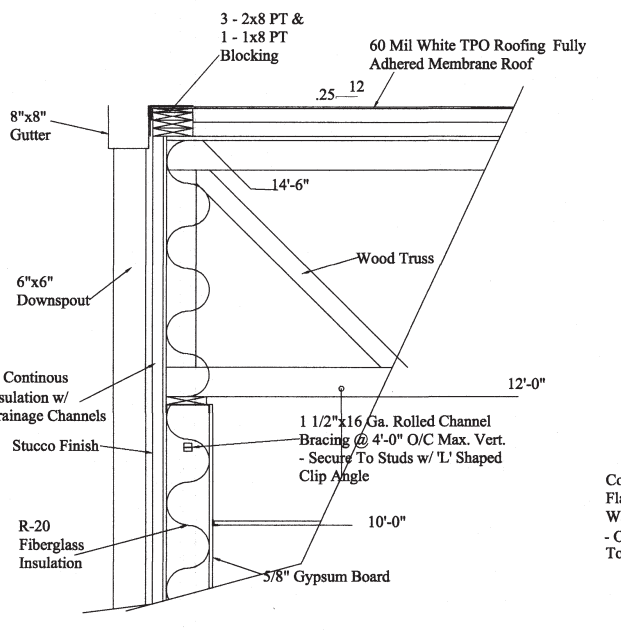


TYPICAL WALL SECTION - "4"
No Scale x 2

Roof Line - Field Verify

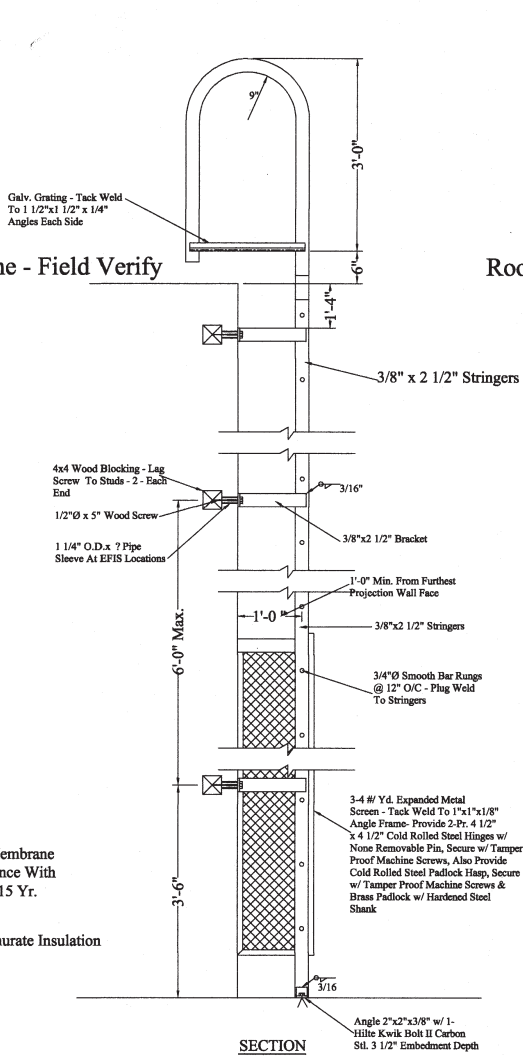


ROOF LADDER DETAIL
3/4" = 1'-0"

Roof Line - Field Verify

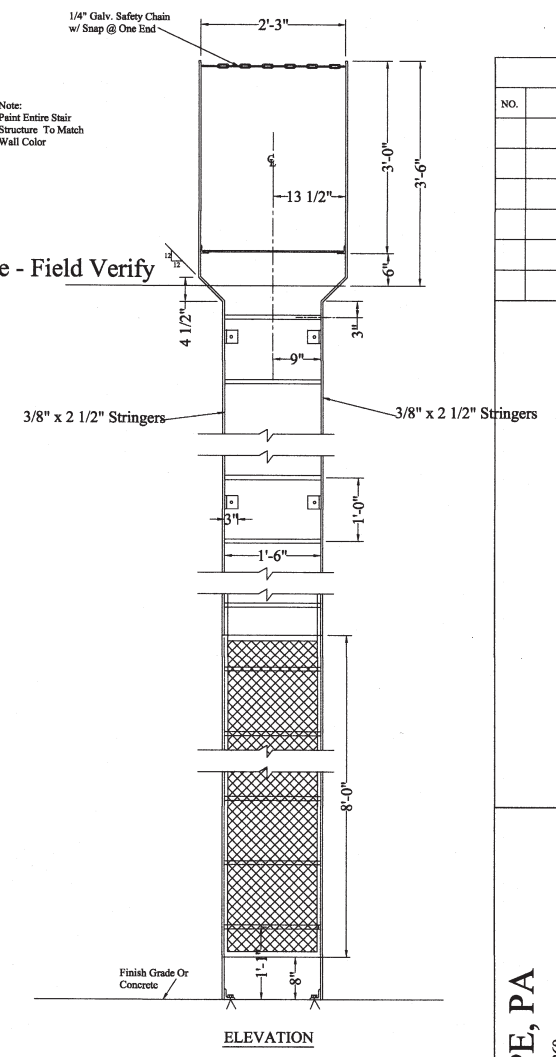

ELEVATION

CORNICE DETAIL

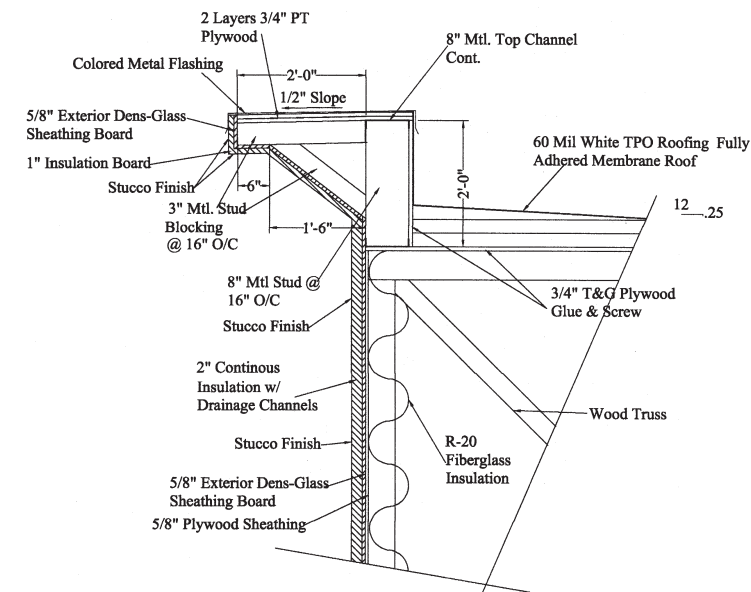

No Scale x3

REVISIONS	
NO.	DATE

A NEW CHAMPS CONVENIENCE STORE
U.S. HWAY 401 NORTH
Fuquay-Varina, North Carolina 27526

RJB, PE, PA
C-0269

Robert J. Bracken
ENGINEERING • SURVEYING

3768 Caribton Road • Sanford, NC 27330

SCALE: 1/4" = 1'-0"

DRAWN BY: WRJ

DATE:


CHECKED BY: RJB

DWG. NUMBER:

JOB NUMBER:

SHEET NO:

G - 3

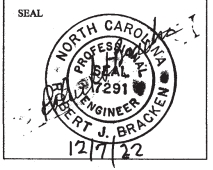

RECEIVED
By Regency Construction at 2:42 pm, Feb 20, 2024