

HARBOR FREIGHT TOOLS

'SHELL BUILDING'

ERWIN, NC

HELT
DESIGN
ARCHITECTURE INTERIORS

6405 W. WILKINSON
BLVD, STE. 100
BELMONT, NC 28012

704.342.1686
HELTDESIGN.COM
INFO@HELTDESIGN.COM
PROJECT NAME:

HARBOR
FREIGHT TOOLS
FOR
STOCKS & TAYLOR
CONSTRUCTION

PROJECT NO: 23174

PROJECT ADDRESS:

46 SHRIJI LANE
ERWIN, NC 28339

SEAL: 04/19/22



CORPORATE ENTITY:
C.L. HELT, ARCHITECT, INC. A NORTH
CAROLINA PROFESSIONAL CORPORATION
DBA HELT DESIGN.

COPYRIGHT:
THIS DRAWING AND ITS COPIES ARE THE
ARCHITECT'S INSTRUMENTS OF SERVICE.
THEY RETAIN ALL COMMON LAW AND
STATUTORY RIGHTS, INCLUDING COPYRIGHT.
THEY SHALL NOT BE USED OR COPIED FOR
ANY PROJECT OTHER THAN THE ONE TITLED
HERE IN.

DRAWING RELEASE:

NO.	DATE	DESCRIPTION

DRAWN BY: ME
CHECKED BY: JZ

DATE: 04/19/24

SHEET TITLE:
COVER SHEET


SHEET NUMBER:
T1.0

ARCHITECT: HELT DESIGN 6405 W. WILKINSON BLVD SUITE 100 BELMONT, NC 28012 ATTN: JAMES ZINK PH: 704-342-1686 EM: JAMESZ@HELTDESIGN.COM	STRUCTURAL ENGINEER: TODD M. BORN, P.E. 1522 MYRTLE OAKS TRAIL OVIEDO, FL 32765 ATTN: TODD BORN PH: 704.578.7213 EM: TBORN@BORN-ENGINEERS.COM	PME ENGINEER: M CONSULTANTS, PLLC 750 BROOKSEdge BLVD. WESTERVILLE, OHIO 43081 NC FIRM # P-1046 ATTN: CHRIS FETTER PH: 614.423.3976 EM: CFETTER@MENGINEERING.US.COM
---	--	---

HFT VENDORS:			
BI-PARTING DOOR VENDOR	OVERHEAD DOOR VENDOR	DOOR HARDWARE VENDOR	EXTERIOR / SITE LIGHTING
DORMAKABA DORMA DRIVE, DRAWER AC REAMSTOWN, PA 17567 CONTACT: ANTHONY RODRIGUEZ T: (847) 390-2213 EMAIL: anthony.rodriguez@dormakaba.com	CORNELL IRON 140 MAFFET STREET WILKES-BARRE, PA 18705 CONTACT: KRISTA BONAVINA T: (800) 862-8773 X 1620 EMAIL: kbonavina@cornellstorefronts.com	COOK AND BOARDMAN, LLC 345 MASON ROAD LaVERGNE, TN 37086 CONTACT: AMY BAKER T: (855) 447-8000 x4508 EM: harborfreightteam@cookandboardman.com	AMA LIGHTING 813 DOWNTOWNER BLVD., SUITE A MOBILE, AL 36609 CONTACT: ROBERT DEWEESE T: 850-500-4956 EM: RDEWEESE@AMALIGHTING.COM



ABBREVIATIONS:			
ABV	ABOVE	MECH	MECHANICAL
AFF	ABOVE FINISHED FLOOR	MISC	MISCELLANEOUS
A/C	AIR CONDITIONING	M.R.	MOISTURE RESISTANT
ARCH	ARCHITECT(URAL)	MULL	MULLION
@	AT	NIC	NOT IN CONTRACT
BLK	BLOCK(ING)	NTS	NOT TO SCALE
BOT	BOTTOM	NUM	NUMBER
BLDG	BUILDING	OFF	OFFICE
CLG	CEILING	OC	ON CENTER(S)
€	CENTER LINE	OPNG	OPENING
CIRC	CIRCUIT	OPH	OPPOSITE HAND
CLR	CLEAR	OD	OUTSIDE DIAMETER
COL	COLUMN	PEMB	PRE-ENGINEERED METAL
CONC	CONCRETE	PNT	BUILDING
C.M.U.	CONCRETE MASONRY UNIT	PLAM	PAINT(ED)
CONST	CONSTRUCTION	PLWD	PLYWOOD
CONT	CONTINUOUS	POL	POLISHED
CTR	COUNTER	PROJ	PROJECT
DTL	DETAIL	PLATE	PLATE
DIA	DIAMETER	RE	REFERENCE
DIM	DIMENSION	REF	REFRIGERATOR
DN	DOWN	REM	REMOVE(D)ABLE
DWG	DRAWING	REQD	REQUIRED
EA	EACH	REV	REVISION(S) REVISED
ELEV	ELEVATION	RM	ROOM
EQ	EQUAL	RO	ROUGH OPENING
EQPT	EQUIPMENT	RD	ROUND
EXIST	EXISTING	SCH	SCHEDULE
EXP	EXPOSED	SEC	SECTION
EXT	EXTERIOR	SHT	SHEET
EIFS	EXT. INSUL. FINISH SYSTEM	SIM	SIMILAR
FT (')	FEET, FOOT	SC	SOLID CORE
FIN	FINISHED	SPEC	SPECIFICATION(S)
FL	FLOOR(ING)	SS	STAINLESS STEEL
FD	FLOOR DRAIN	STO	STORAGE
FLUR	FLUORESCENT	STRUCT	STRUCTURAL
FUR	FURRED(ING)	SUSP	SUSPENDED
F.R.	FIRE RATED	TEL	TELEPHONE
F.E.	FIRE EXTINGUISHER	TYP	TYPICAL
GWB	GYPSON WALL BOARD	THRU	THROUGH
HDW	HARDWARE	VCT	VINYL COMPOSITION TILE
HDWD	HARDWOOD	VEST	VESTIBULE
HVAC	HEATING/VENTILATION/ AIR CONDITIONING	W/	WITH
HM	HOLLOW METAL	W/O	WITHOUT
IN (")	INCH	WD	WOOD
ID	INSIDE DIAMETER	WDB	WOOD BASE
INSUL	INSULATION		
INT	INTERIOR		
MANUF	MANUFACTURE(R)		
MFG	MANUFACTURE(R)		

SHEET INDEX	
PROJECT INFO	
T1.0	COVER SHEET / SHEET INDEX / PROJECT INFO.
T2.0	APPENDIX 'B' BUILDING CODE SUMMARY
T3.0	COMCHECK ENVELOPE COMPLIANCE REPORT
T4.0	LIFE SAFETY PLAN
CIVIL	(UNDER SEPARATE COVER)
ARCHITECTURAL	
A1.0	FLOOR PLAN
A1.1	ROOF PLAN
A2.0	ELEVATIONS
A2.1	EIFS DETAILS
A3.0	BUILDING SECTION
A4.0	WALL SECTIONS
A5.0	DETAILS
STRUCTURAL	
S001	STRUCTURAL NOTES SHEET
S002	STATEMENT OF SPECIAL INSPECTIONS
S100	FOUNDATION PLAN, SCHEDULE & NOTES
S200	FOUNDATION DETAILS
ELECTRICAL	
E-1	ELECTRICAL COVER SHEET
E-2	ELECTRICAL SHELL PLAN
E-3	ELECTRICAL SITE PLAN
E-4	ELECTRICAL SPECIFICATIONS
PLUMBING	
P-1	PLUMBING DETAILS AND SCHEDULES
P-2	PLUMBING SHELL PLAN

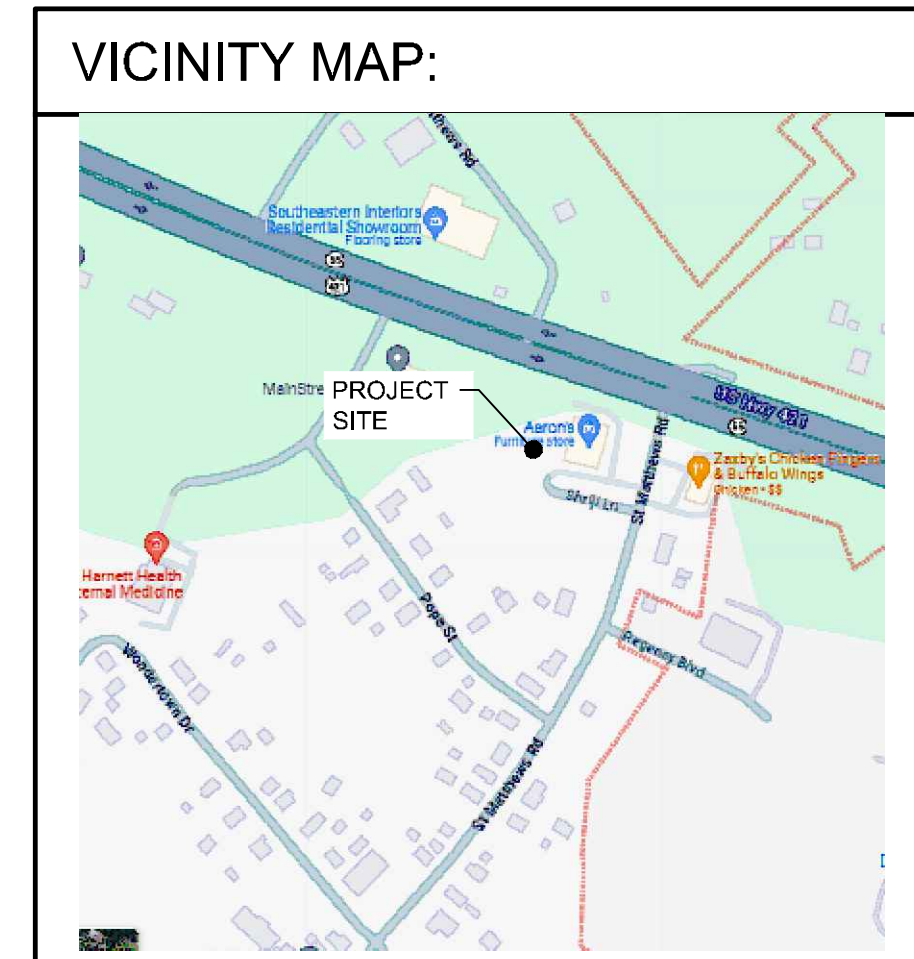

ULTIMATE WIND SPEED - 120 MPH Risk category II
WIND EXPOSURE CATEGORY - C
INFORMATION ABOVE ACQUIRED FROM 2018 NORTH
CAROLINA STATE BUILDING CODE - BASED ON ADDRESS
PROVIDED ON THIS SHEET.

ALL TRADES INCLUDING BUT NOT LIMITED TO METAL
BUILDING MANUFACTURERS AND STOREFRONT
MANUFACTURERS, ARE TO VERIFY WIND SPEED
PRIOR TO INDIVIDUAL DESIGN ASPECTS AND NOTIFY
ARCHITECT PRIOR TO DESIGN IF CONFLICTING
INFORMATION IS RECEIVED.

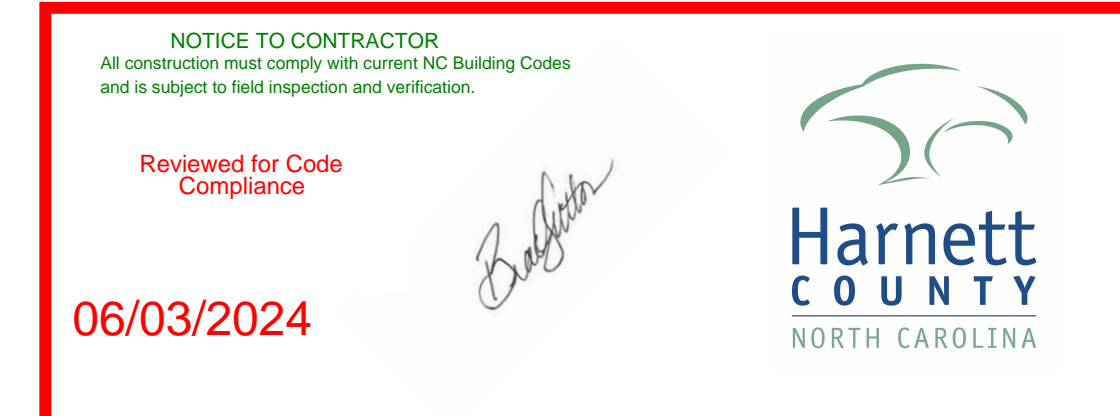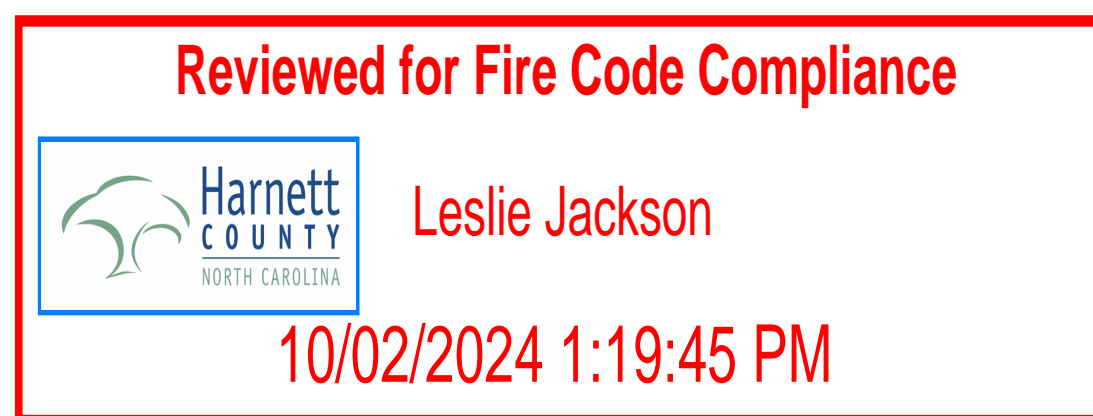


FIRE ALARM SERVICE:
 TENANT SHALL PROVIDE AND INSTALL A FIRE ALARM SYSTEM WITHIN THE LEASED SPACE AS PART OF TENANT BUILD-OUT. UNDER SEPARATE PERMIT.

FIRE EXTINGUISHER NOTE:
 GC TO PROVIDE 2A-10BC FIRE EXTINGUISHERS DURING CONSTRUCTION OF SHELL BUILDING PER THE LOCAL FIRE MARSHAL'S DIRECTION.
 TENANT IS RESPONSIBLE FOR PROVIDING FIRE EXTINGUISHERS AT TIME OF INTERIOR BUILD-OUT (SEPARATE PERMIT) AS REQUIRED FOR FINAL OCCUPANCY.

FIRE SEPARATION DISTANCES:
 ALL FIRE SEPARATION DISTANCES TO PROPERTY LINES EXCEED 20'-0". SEE CIVIL DRAWINGS FOR ADDITIONAL INFORMATION.
 NO EXTERIOR FIRE RATED WALLS REQUIRED OR PROVIDED.

KNOX BOX NOTE:
 IF A KNOX BOX ENTRY SYSTEM IS REQUIRED BY THE CODES GOVERNING THE CONSTRUCTION OF THE PROJECT, PROVIDE A RECESSED KNOX BOX BY THE CONTRACTOR PRIOR TO THE COMPLETION OF THE PROJECT. LOCATE PER LOCAL CODE REQUIREMENTS. KNOX BOX CONTACT - 866-625-4863

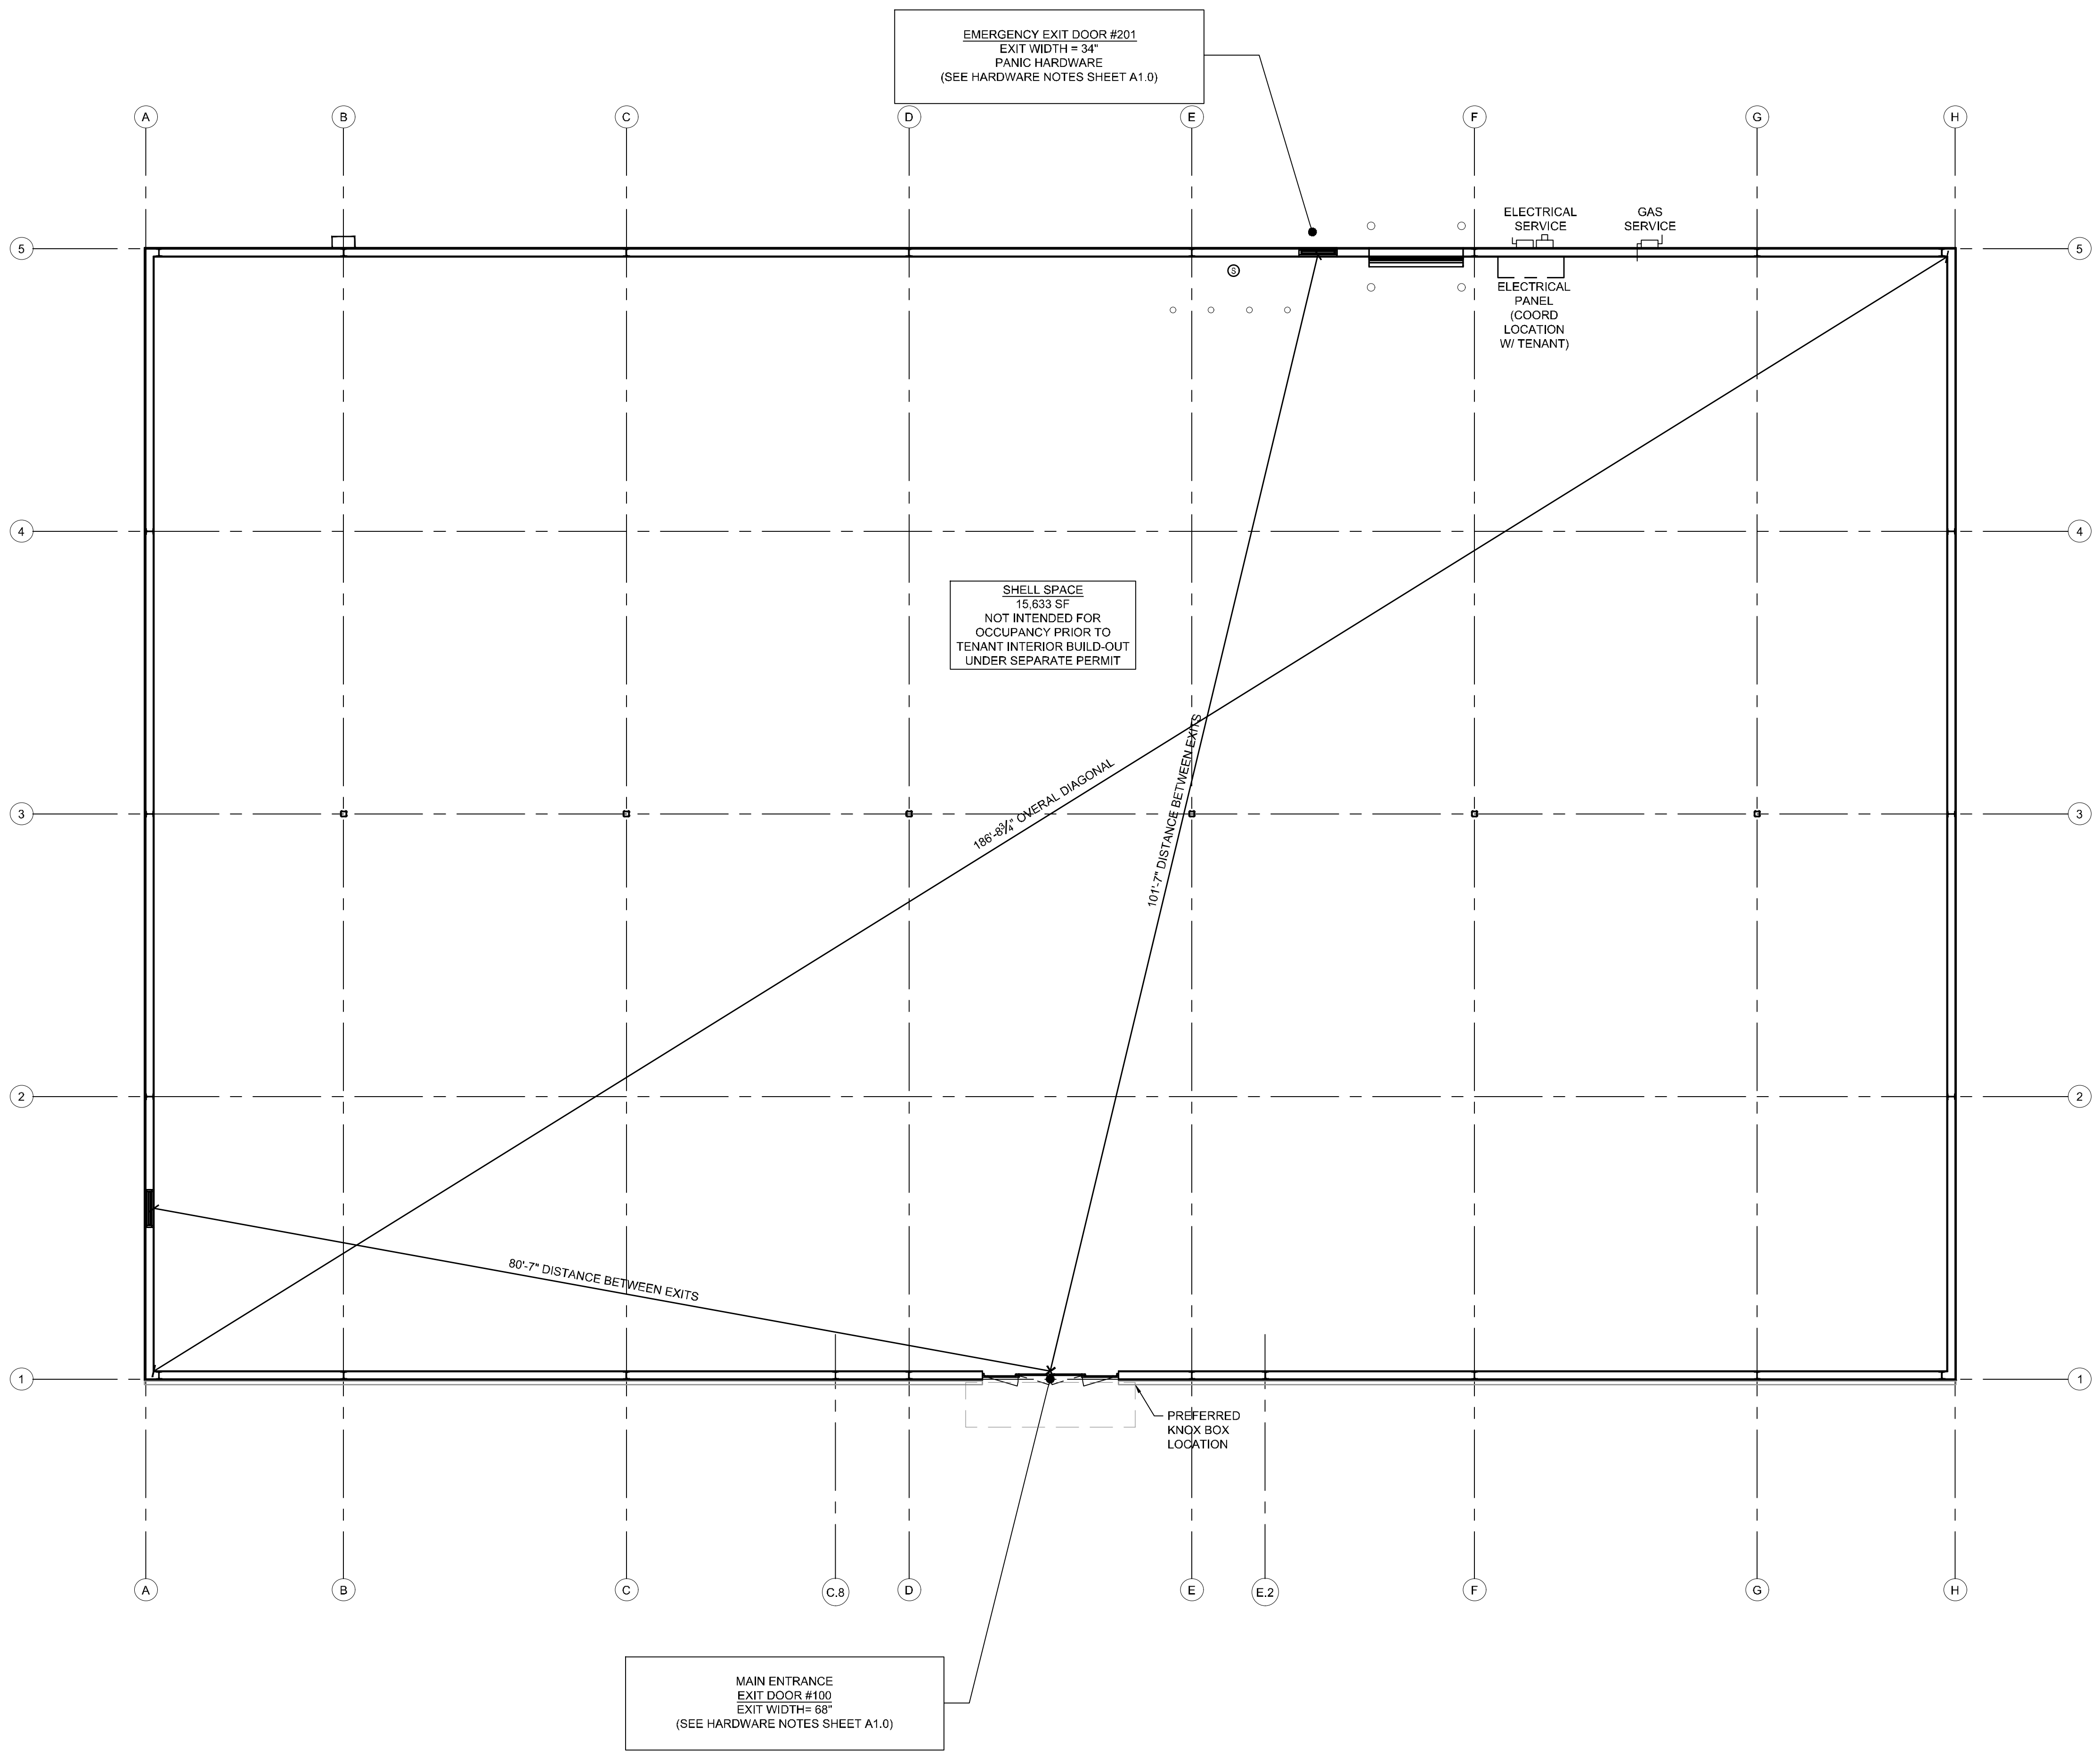

1 LIFE SAFETY PLAN
 SCALE: 1/4"=1'-0"

HELT DESIGN

ARCHITECTURE INTERIORS

6405 W. WILKINSON BLVD, STE. 100
 BELMONT, NC 28012
 704.342.1686
 HELTDESIGN.COM
 INFO@HELTDESIGN.COM
 PROJECT NAME:

HARBOR FREIGHT TOOLS

FOR STOCKS & TAYLOR CONSTRUCTION

PROJECT NO: 23174

PROJECT ADDRESS:

46 SHRIJI LANE
 ERWIN, NC 28339

SEAL: 04/19/22

CORPORATE ENTITY:
 C.L. HELT, ARCHITECT, INC. A NORTH CAROLINA PROFESSIONAL CORPORATION
 DBA HELT DESIGN.

COPYRIGHT:
 THIS DRAWING AND ITS COPIES ARE THE ARCHITECT'S INSTRUMENTS OF SERVICE. THEY RETAIN ALL COMMON LAW AND STATUTORY RIGHTS, INCLUDING COPYRIGHT. THEY SHALL NOT BE USED OR COPIED FOR ANY PROJECT OTHER THAN THE ONE TITLED HERE IN.

DRAWING RELEASE:

NO.	DATE	DESCRIPTION

DRAWN BY: ME CHECKED BY: JZ

DATE: 04/19/24

SHEET TITLE:
COVER SHEET

SHEET NUMBER:
T1.0

DOOR SCHEDULE

DOOR NO.	DOOR				FRAME		HDW NOTES	REMARKS
	W	H	T	TYPE	MATL	FINISH		
100	12'-0"	7'-8"		A	GLASS/ALUM.	ANOD. ALUM.	SUPPLIED BY DORMA	BI-PARTING ELECTRIC DOOR PACKAGE W/ INTEGRAL TRANSOM BY DORMA. SEE T1.0 FOR VENDOR INFORMATION. MINIMUM WINDOW FRAME HEIGHT OF 10' ABOVE FINISH FLOOR. ALL GLAZING TO BE 1" INSULATED TEMPERED GLASS. G.C. TO COORDINATE FINAL DOOR AND FRAME DIMENSIONS WITH DORMA.
200	3'-0"	7'-0"	1 3/4"	B	HOLLOW METAL	PAINTED	2	
300	3'-0"	7'-0"	1 3/4"	B	HOLLOW METAL	PAINTED	3	
400	8'-0"	10'-0"	1/2"	C	METAL	GALV.	4	CHAIN OPERATE INSULATED SERVICE DOOR FURNISHED AND INSTALLED BY O.H. DOOR VENDOR. VERIFY OPENING SIZE IN FIELD BEFORE ORDERING DOOR

HARDWARE NOTES


GROUP 2 - (SINGLE EXIT DOORS)
 -1 1/2" PAIR HINGES: MCKINNEY MP 79, 4 1/2" X 4 1/2", 26D
 -EXIT DEVICE - VON DUPRIN GUARD-X 2670-US28
 -CYLINDER CORE: FALCON C207-SC-C26D
 -CONST CORE: FALCON C607 CCA 7-PIN
 -HOUSING: FALCON C553 (CKVY -PN) 626
 -CLOSER: FALCON SCT1 RW / PA-689 (MTD, INSIDE)
 -KICKPLATE: ROCKWOOD K1050 - 10X34 US38D
 -DOOR STOP: ROCKWOOD 472-26D STOP W/ KEEPER
 -DOOR BOTTOM: PEMKO 315-CN MILL 36"
 GASKETING: PEMKO 303 AV (1) 36", (2) 84"
 THRESHOLD: PEMKO 171-A MILL 36"
 DOOR PULL: ROCKWOOD 131-26D (MTD, INSIDE)
 LATCH GUARD: DON-JO NLP-110 (EXTERIOR)
 DRIP EDGE: PEMKO 346C RAIN DRIP 40" (EXTERIOR)

GROUP 3 - (SINGLE EXIT DOORS)
 -1 1/2" PAIR HINGES: MCKINNEY MP 79, 4 1/2" X 4 1/2", 26D
 -EXIT DEVICE - VON DUPRIN GUARD-X 2670-US28
 -CYLINDER CORE: FALCON C207-SC-C26D
 -CONST CORE: FALCON C607 CCA 7-PIN
 -HOUSING: FALCON C553 (CKVY -PN) 626
 -CLOSER: FALCON SCT1 RW / PA-689 (MTD, INSIDE)
 -KICKPLATE: ROCKWOOD K1050 - 10X34 US38D
 -DOOR STOP: ROCKWOOD 472-26D STOP W/ KEEPER
 -DOOR BOTTOM: PEMKO 315-CN MILL 36"
 GASKETING: PEMKO 303 AV (1) 36", (2) 84"
 THRESHOLD: PEMKO 171-A MILL 36"
 DOOR PULL: ROCKWOOD 131-26D (MTD, INSIDE)
 LATCH GUARD: DON-JO NLP-110 (EXTERIOR)
 DRIP EDGE: PEMKO 346C RAIN DRIP 40" (EXTERIOR)
 DOOR VIEWER: DOORSCOPE DS2000 AL.S


GROUP 4 - (OVERHEAD DOOR)
 DOOR PANELS: 2 3/4" INSULATED STEEL INTERLOCKING FLAT SLAT CURTAIN W/ ENDLOCKS @ BOTH ENDS BY VENDOR SCHLAGE KS41F1200
 CYLINDER CORE: FALCON C649 (HCK, 1H4-626, SCHLAGE 80-035-GRN, 24 GA MIN. GALVANIZED STEEL BY VENDOR, HAND CHAIN BY VENDOR
 LOCKING: CHAIN KEEPER (BY VENDOR) WITH PADLOCK (SUPPLIED BY GC)
 BOTTOM BAR: EXTRUDED ALUMINUM BAR BY VENDOR
 WEATHER SEALS: BY VENDOR

DOOR SCHEDULE NOTES:

- ALL NEW DOORS AND HARDWARE SHALL COMPLY WITH CURRENT ADA REGULATIONS. ALL OPERABLE PARTS ON DOORS SHALL BE EASY TO GRASP WITH ONE HAND AND NOT REQUIRE GRASPING, PINCHING OR TWISTING OF THE WRIST TO OPERATE.
- ALL EXTERIOR DOORS TO BE 20 GA. MINIMUM. EXTERIOR DOOR FRAMES TO BE ALL WELDED 16 GA. MINIMUM.
- ALL DOOR HARDWARE SHALL BE LEVER TYPE OR PANIC HARDWARE.
- EXTERIOR DOORS SHALL BE OPERABLE FROM THE INSIDE WITHOUT THE USE OF A KEY, SPECIAL KNOWLEDGE OR EFFORT.
- OPENINGS SHALL BE A MINIMUM OF 32" WIDE WHEN DOOR IS AT A RIGHT ANGLE TO CLOSED POSITION.
- BOTTOM 10" OF ALL DOORS SHALL HAVE A SMOOTH, UNINTERRUPTED SURFACE FOR OPENING BY WHEELCHAIR FOOT REST.
- MAXIMUM EFFORT TO OPERATE DOORS SHALL NOT EXCEED 5 LBS. FOR EXTERIOR DOORS, AND 3 LBS FOR INTERIOR DOORS WITH A PUSH OR PULL EFFORT BEING APPLIED AT RIGHT ANGLES TO HINGED DOOR AND AT THE CENTER PLANE OF SLIDING OR FOLDING DOORS. COMPENSATING DEVICES OR AUTOMATIC DOOR OPERATIONS MAY BE UTILIZED TO MEET THE ABOVE STANDARDS, WHEN FIRE DOORS ARE REQUIRED. THE MAXIMUM EFFORT TO OPERATE THE DOORWAY MAY BE INCREASED NOT TO EXCEED 14 LBS. W/ CLOSURE.
- ALL HARDWARE LISTED TO BE SUPPLIED BY LISTED MANUFACTURER OR EQUAL.
- ALL DOOR HARDWARE TO BE BRUSHED CHROME FINISH.
- EXTERIOR DOORS & FRAMES, EXCLUDING OVERHEAD DOOR, TO BE PRIMED @ PAINTED TO MATCH THE ADJACENT FINISH ON THE EXTERIOR. 1 COAT PRIMER & 2 COATS PAINT. INTERIOR SHALL BE PRIMED AND PAINTED. 1 COAT PRIMER & 2 COATS PAINT, INDUSTRIAL ENAMEL SHERWIN WILLIAMS SW7667 CITYSCAPE (SEMI-GLOSS).
- BI-PARTING DOOR AND THRESHOLDS TO BE PROVIDED AND INSTALLED BY DOOR VENDOR.
- PROVIDE 8" HIGH WHITE VINYL NUMBERS STATING STREET ADDRESS IN HELVETICA FONT STYLE ON TRANSOM AT MAIN ENTRY DOOR.
- G.C. TO PROVIDE READILY VISIBLE SIGNAGE POSTED ON THE EGRESS SIDE OR ADJ. TO ALL EGRESS DOORS STATING: THIS DOOR TO REMAIN UNLOCKED WHEN BUILDING IS OCCUPIED.
- THRESHOLDS AT EGRESS DOORS SHALL BE NO MORE THAN 1/2" (MAX) HEIGHT AFF.

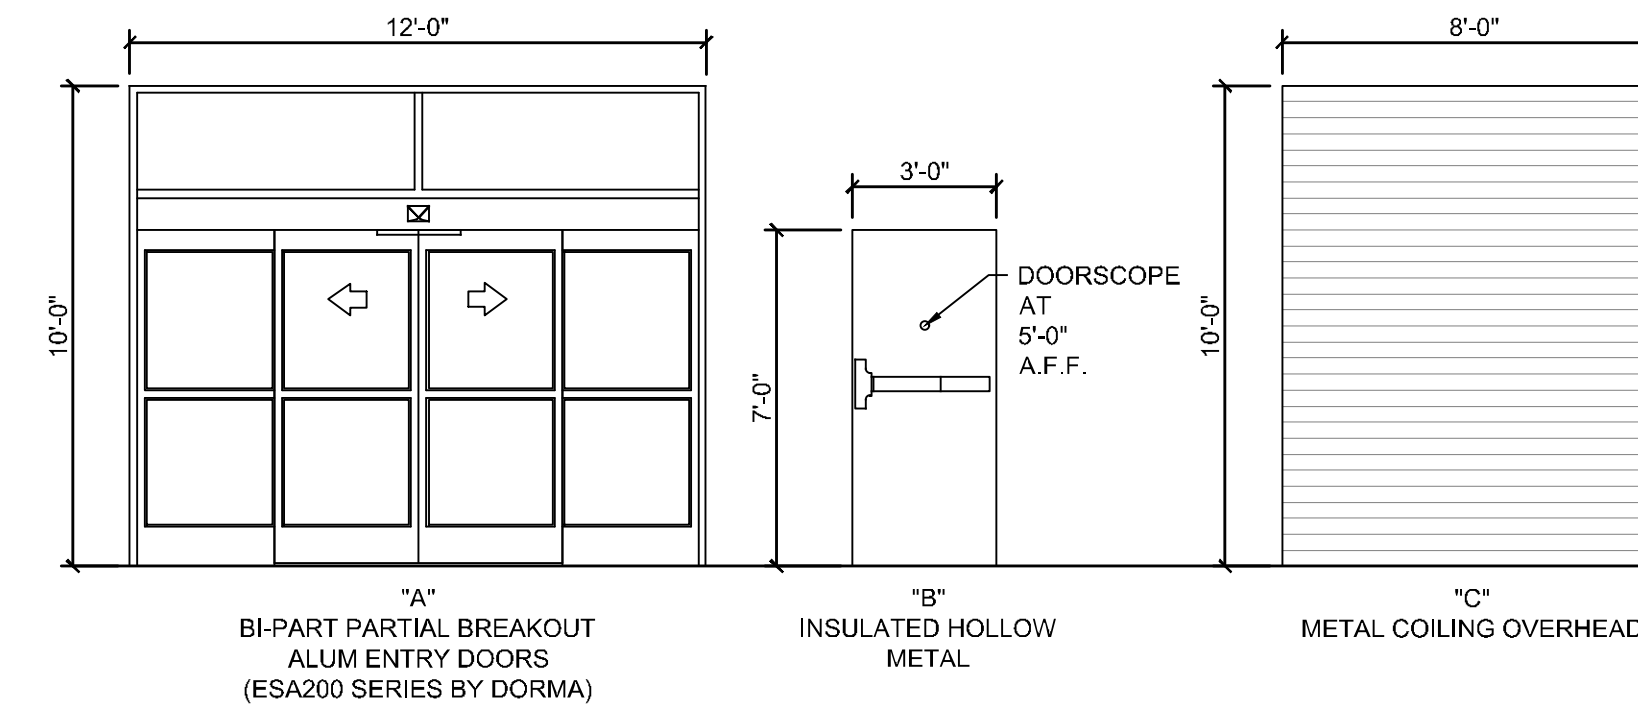

2 DOOR TYPES
SCALE: 1/4"=1'-0"

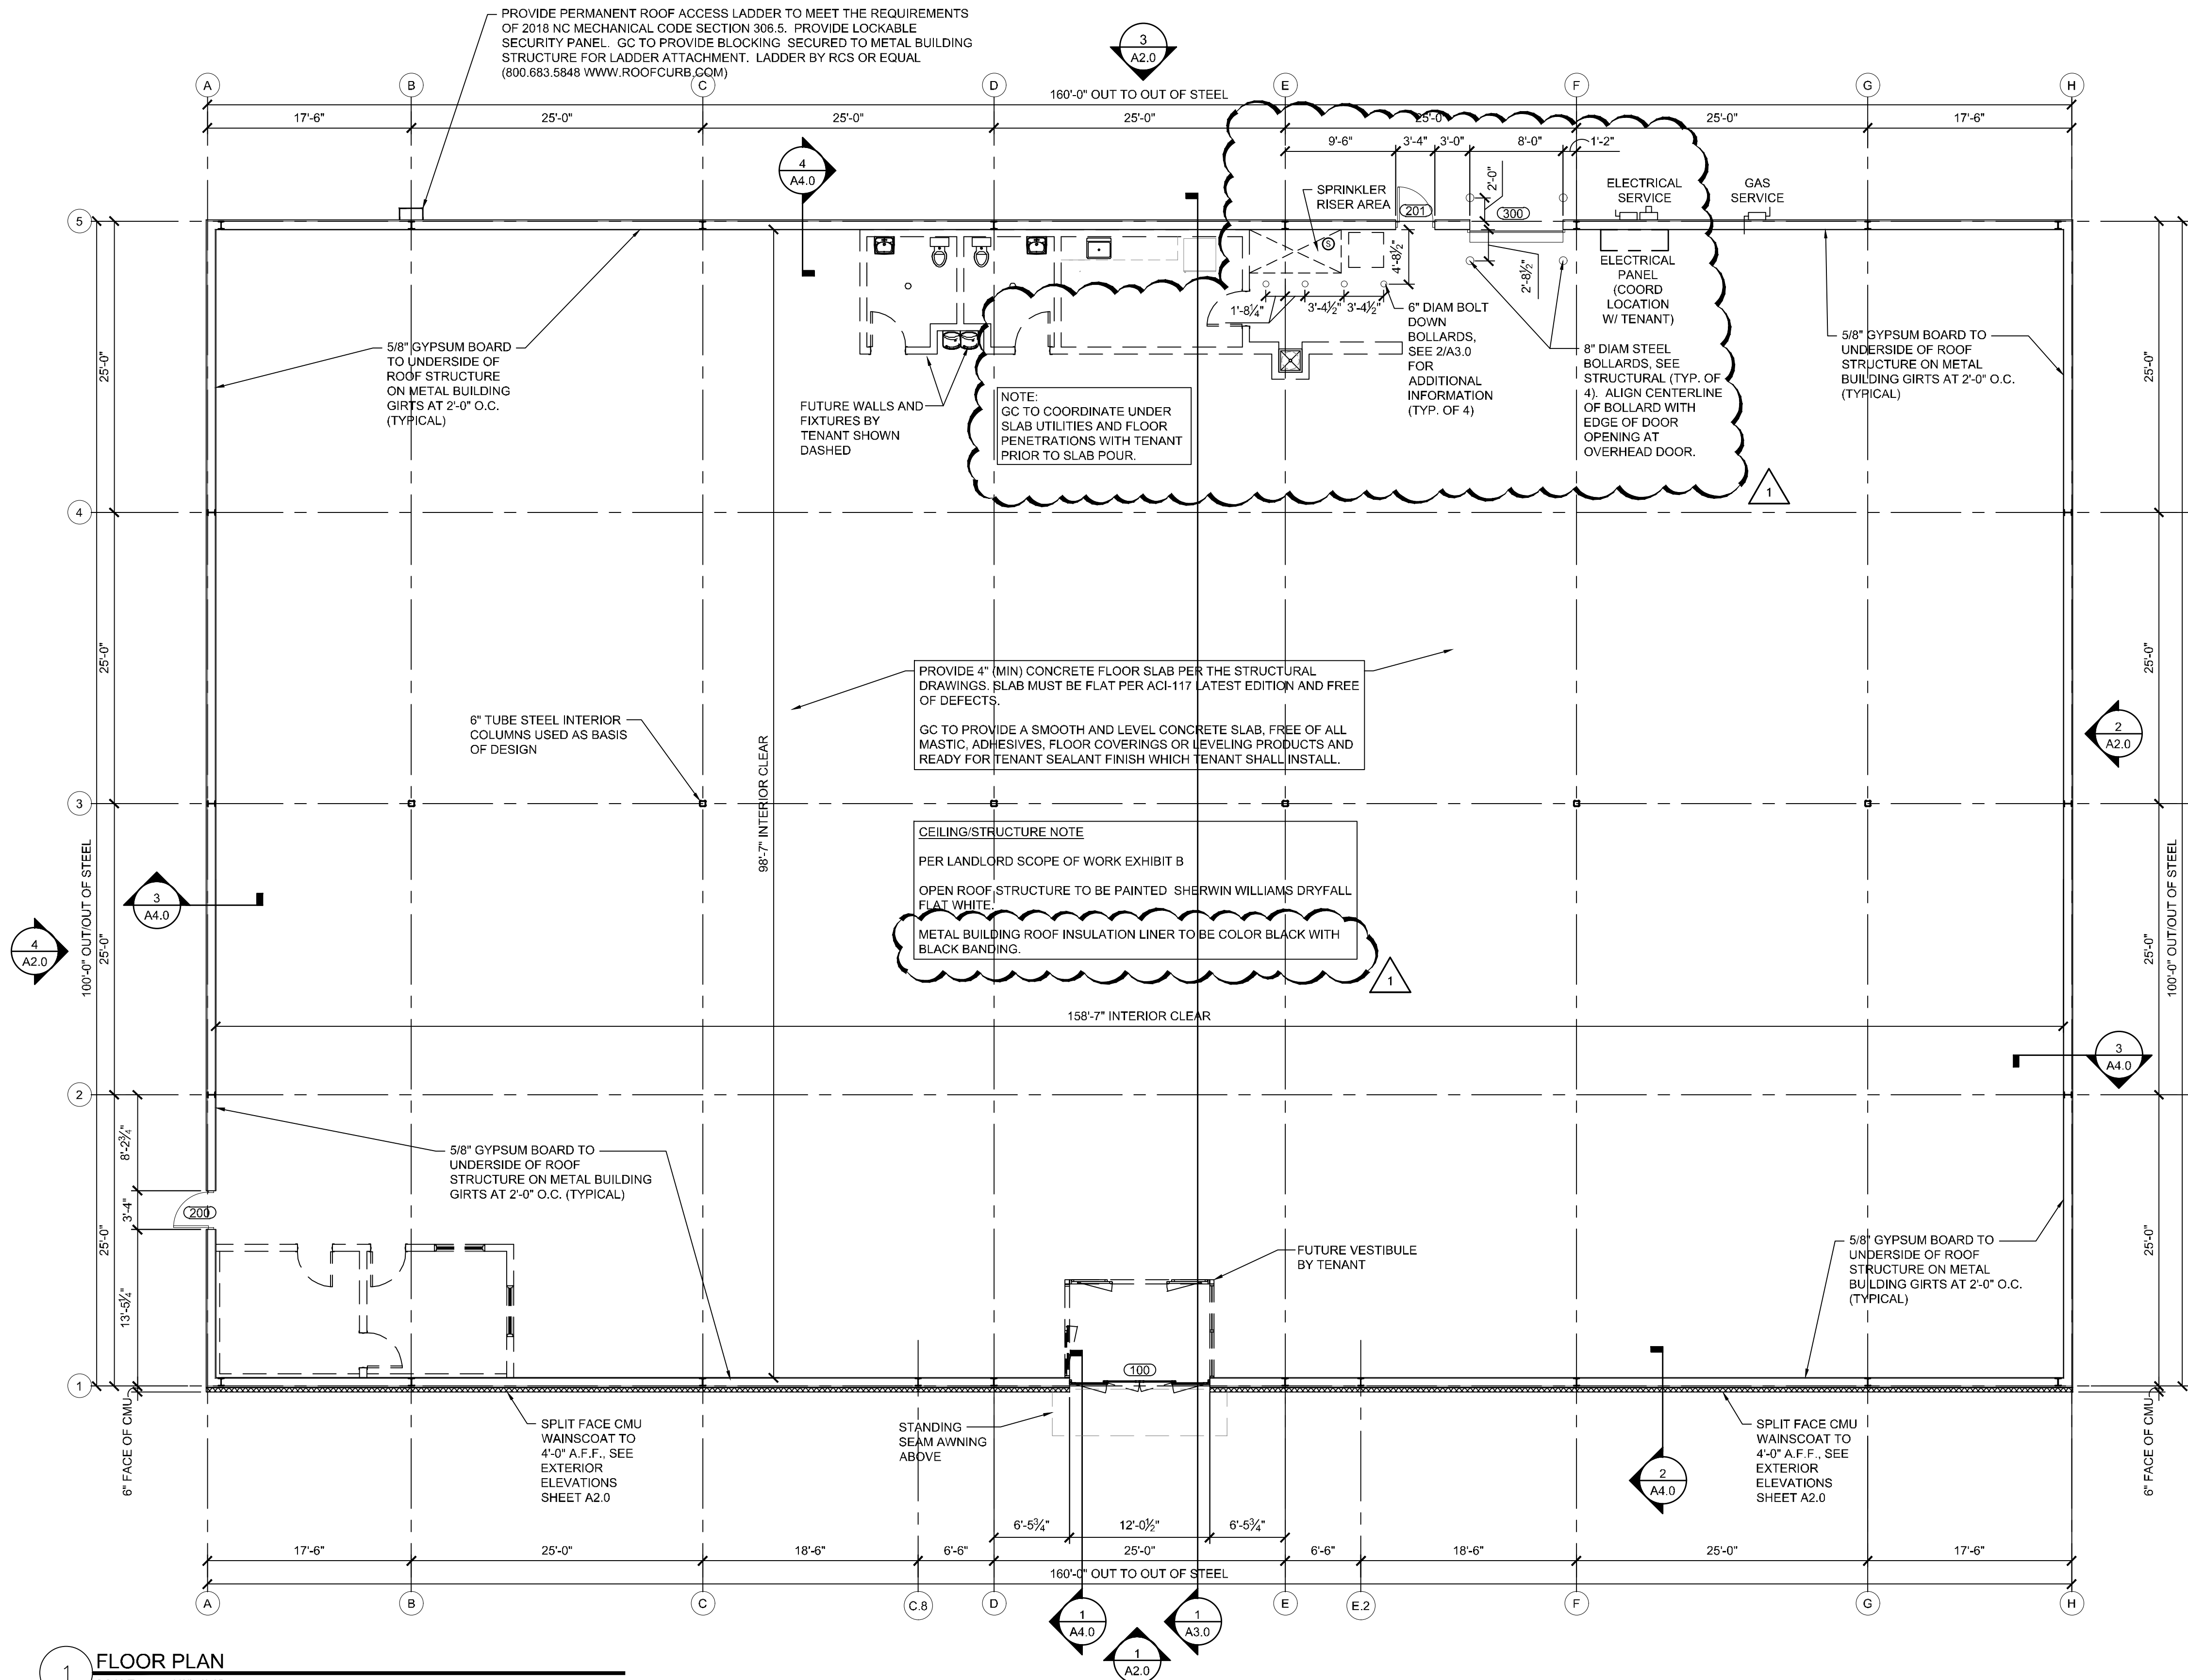

1 FLOOR PLAN
SCALE: 1/8"=1'-0"

HELT DESIGN

ARCHITECTURE INTERIORS

6405 W. WILKINSON BLVD, STE. 100
BELMONT, NC 28012

704.342.1686
HELTDDESIGN.COM
INFO@HELTDDESIGN.COM
PROJECT NAME:

HARBOR FREIGHT TOOLS
FOR STOCKS & TAYLOR CONSTRUCTION

PROJECT NO: 23174

PROJECT ADDRESS:

46 SHRIJI LANE
ERWIN, NC 28339

SEAL: 05/23/24



CORPORATE ENTITY:
C.L. HELT, ARCHITECT, INC. A NORTH CAROLINA PROFESSIONAL CORPORATION
DBA HELT DESIGN.

COPYRIGHT:
THIS DRAWING AND ITS COPIES ARE THE ARCHITECT'S INSTRUMENTS OF SERVICE. THEY RETAIN ALL COMMON LAW AND STATUTORY RIGHTS, INCLUDING COPYRIGHT. THEY SHALL NOT BE USED OR COPIED FOR ANY PROJECT OTHER THAN THE ONE TITLED HERE IN.

DRAWING RELEASE:

NO.	DATE	DESCRIPTION
△	05/23/24	HFT REVIEW COMMENTS

DRAWN BY: ME
CHECKED BY: JZ


DATE: 04/19/24

SHEET TITLE:
FLOOR PLAN

SHEET NUMBER:
A1.0

DOWNSPOUT & GUTTER CALCULATIONS:

DOWNSPOUTS SPACING TO BE DETERMINED BY METAL BUILDING ENGINEER, BASED ON LOCAL TYPICAL AND MAXIMUM RAINFALL AMOUNTS, WITH DOWNSPOUTS PLACED EQUALLY APART TYP. NO DOWNSPOUT MAY BE PLACED WITHIN 12" OF A DOOR FRAME.

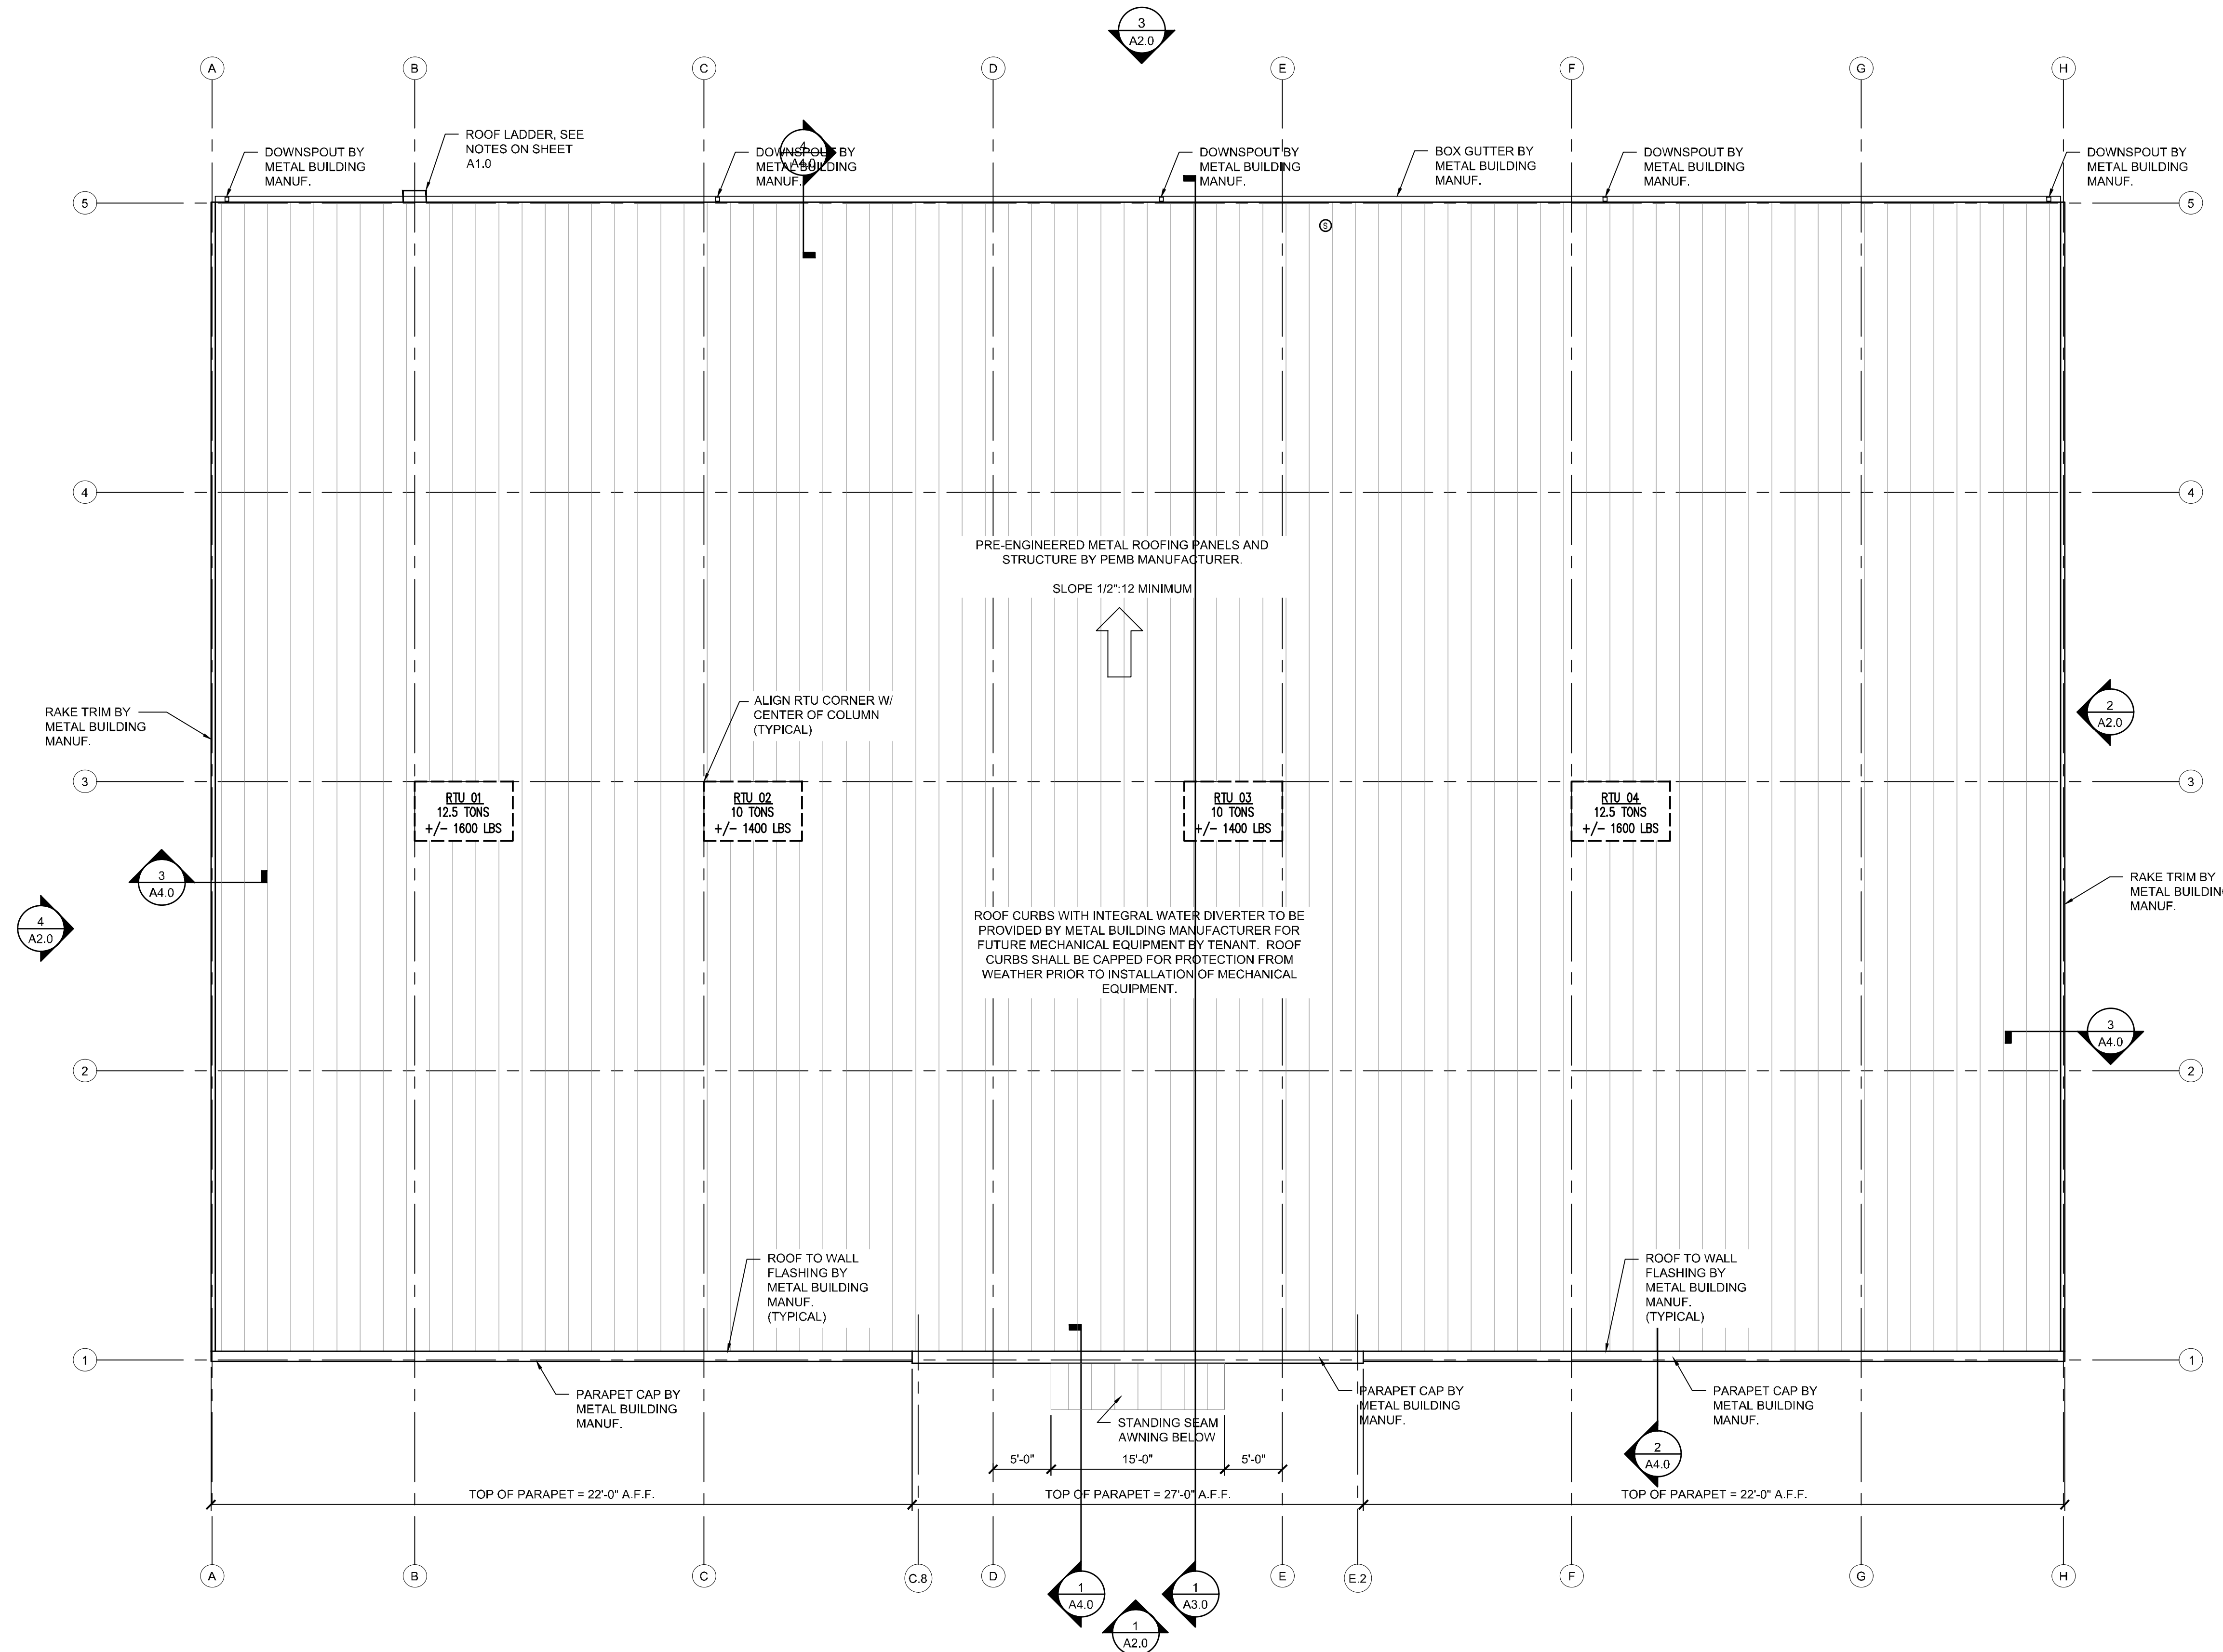

1
A1.1 ROOF PLAN
SCALE 1/8" = 1'-0"

HELT
DESIGN
ARCHITECTURE INTERIORS

6405 W. WILKINSON
BLVD, STE. 100
BELMONT, NC 28012

704.342.1686
HELTDDESIGN.COM
INFO@HELTDDESIGN.COM
PROJECT NAME:

HARBOR
FREIGHT TOOLS
FOR
STOCKS & TAYLOR
CONSTRUCTION

PROJECT NO: 23174

PROJECT ADDRESS:

46 SHRIJI LANE
ERWIN, NC 28339

SEAL: 04/19/22



CORPORATE ENTITY:
C.L. HELT, ARCHITECT, INC. A NORTH
CAROLINA PROFESSIONAL CORPORATION
DBA HELT DESIGN.

COPYRIGHT:
THIS DRAWING AND ITS COPIES ARE THE
ARCHITECT'S INSTRUMENTS OF SERVICE.
THEY RETAIN ALL COMMON LAW AND
STATUTORY RIGHTS, INCLUDING COPYRIGHT.
THEY SHALL NOT BE USED OR COPIED FOR
ANY PROJECT OTHER THAN THE ONE TITLED
HERE IN.

DRAWING RELEASE:





NO.	DATE	DESCRIPTION

DRAWN BY: ME
CHECKED BY: JZ

DATE: 04/19/24

SHEET TITLE:
ROOF PLAN

SHEET NUMBER:
A1.1

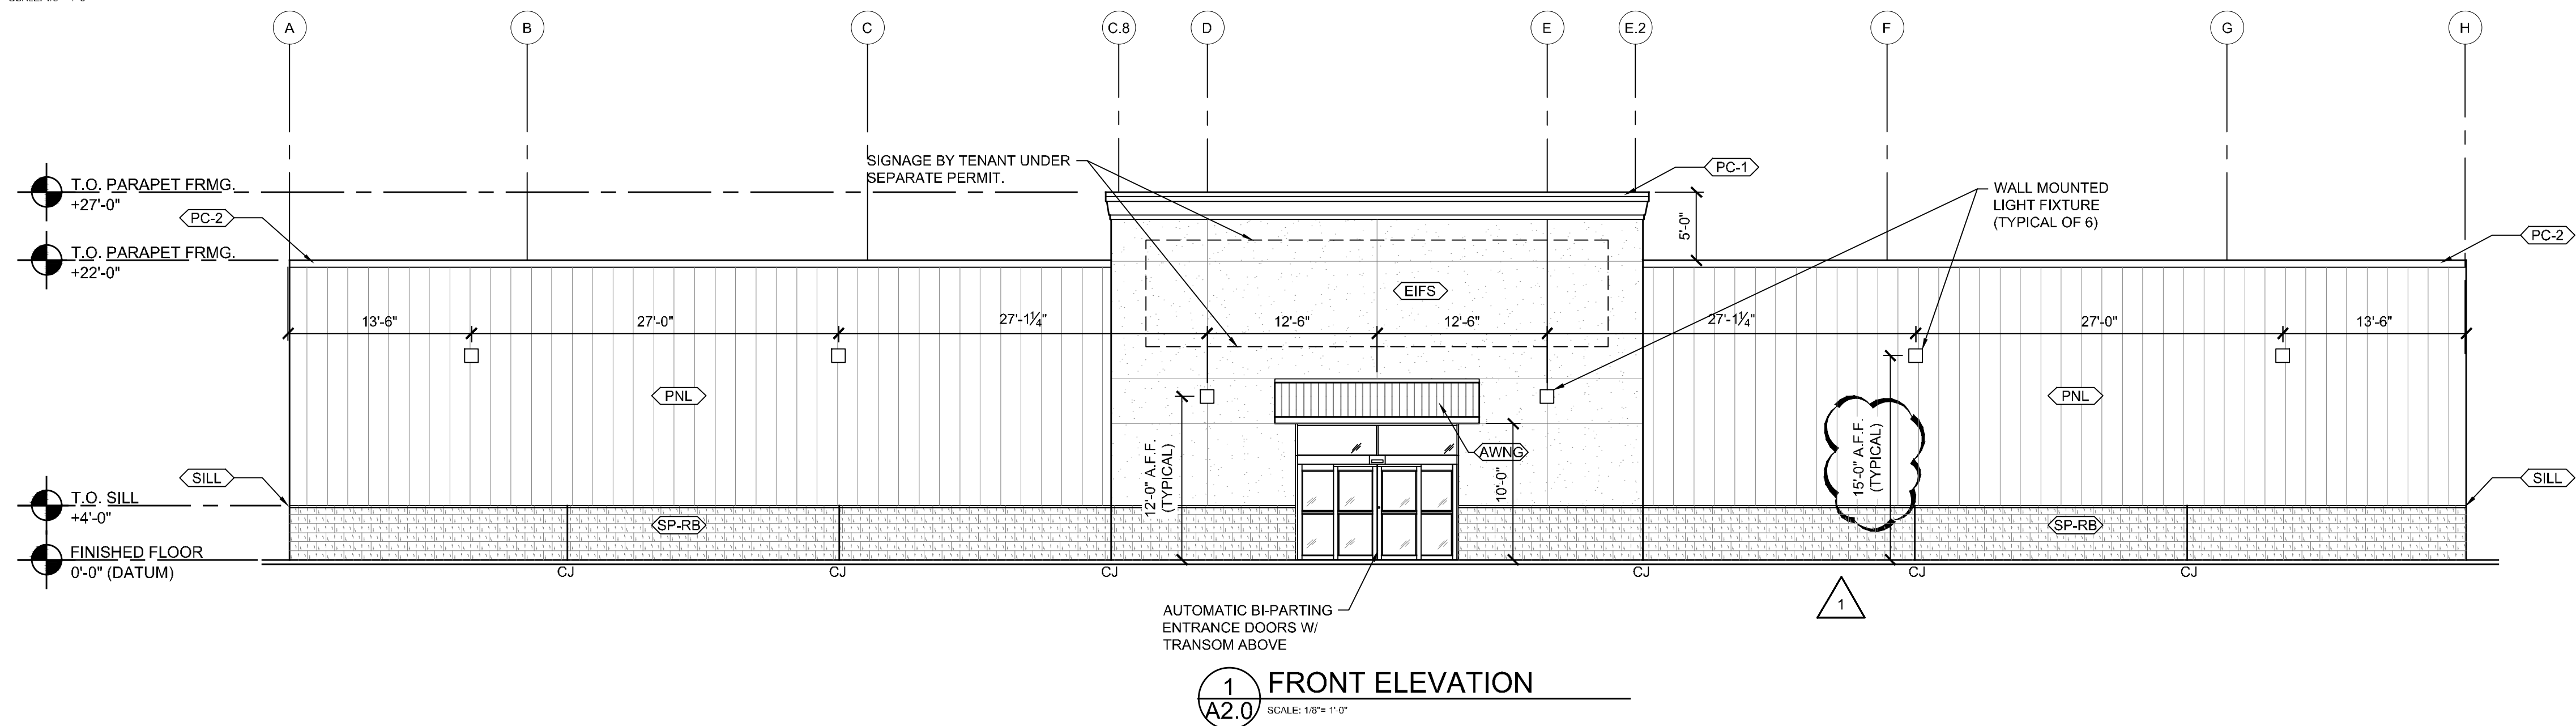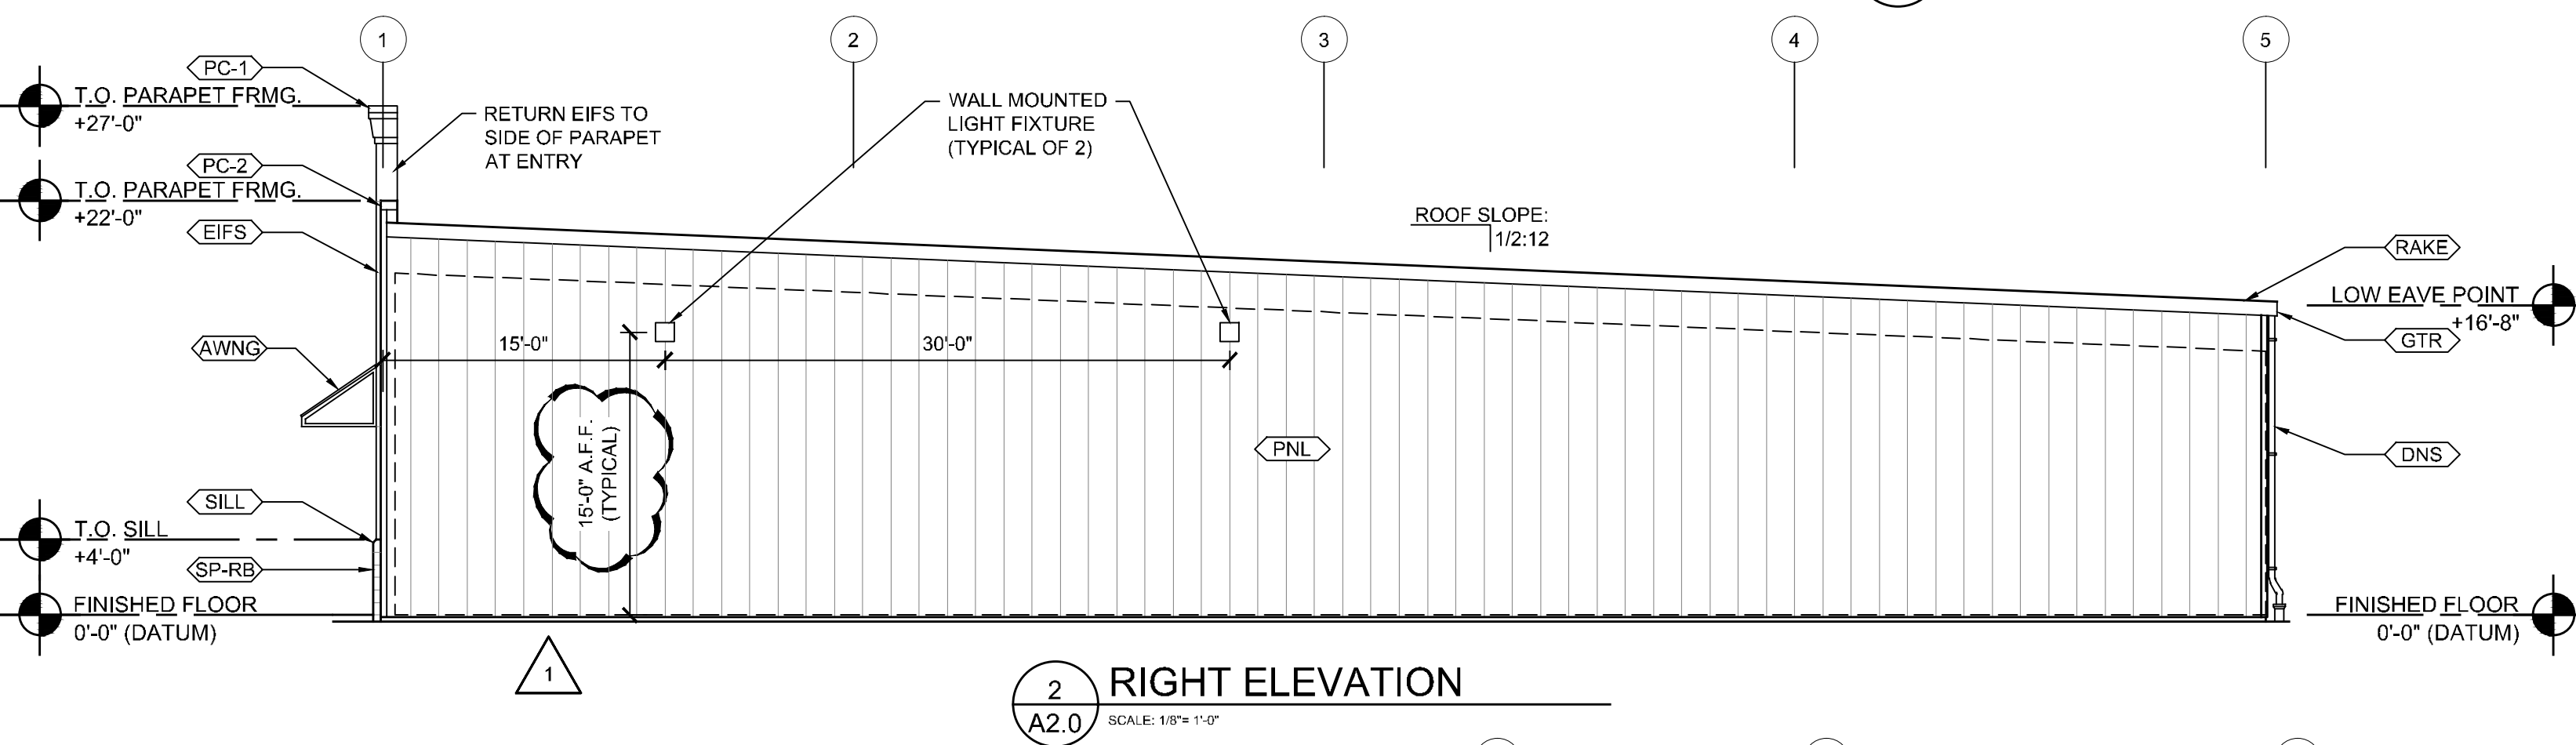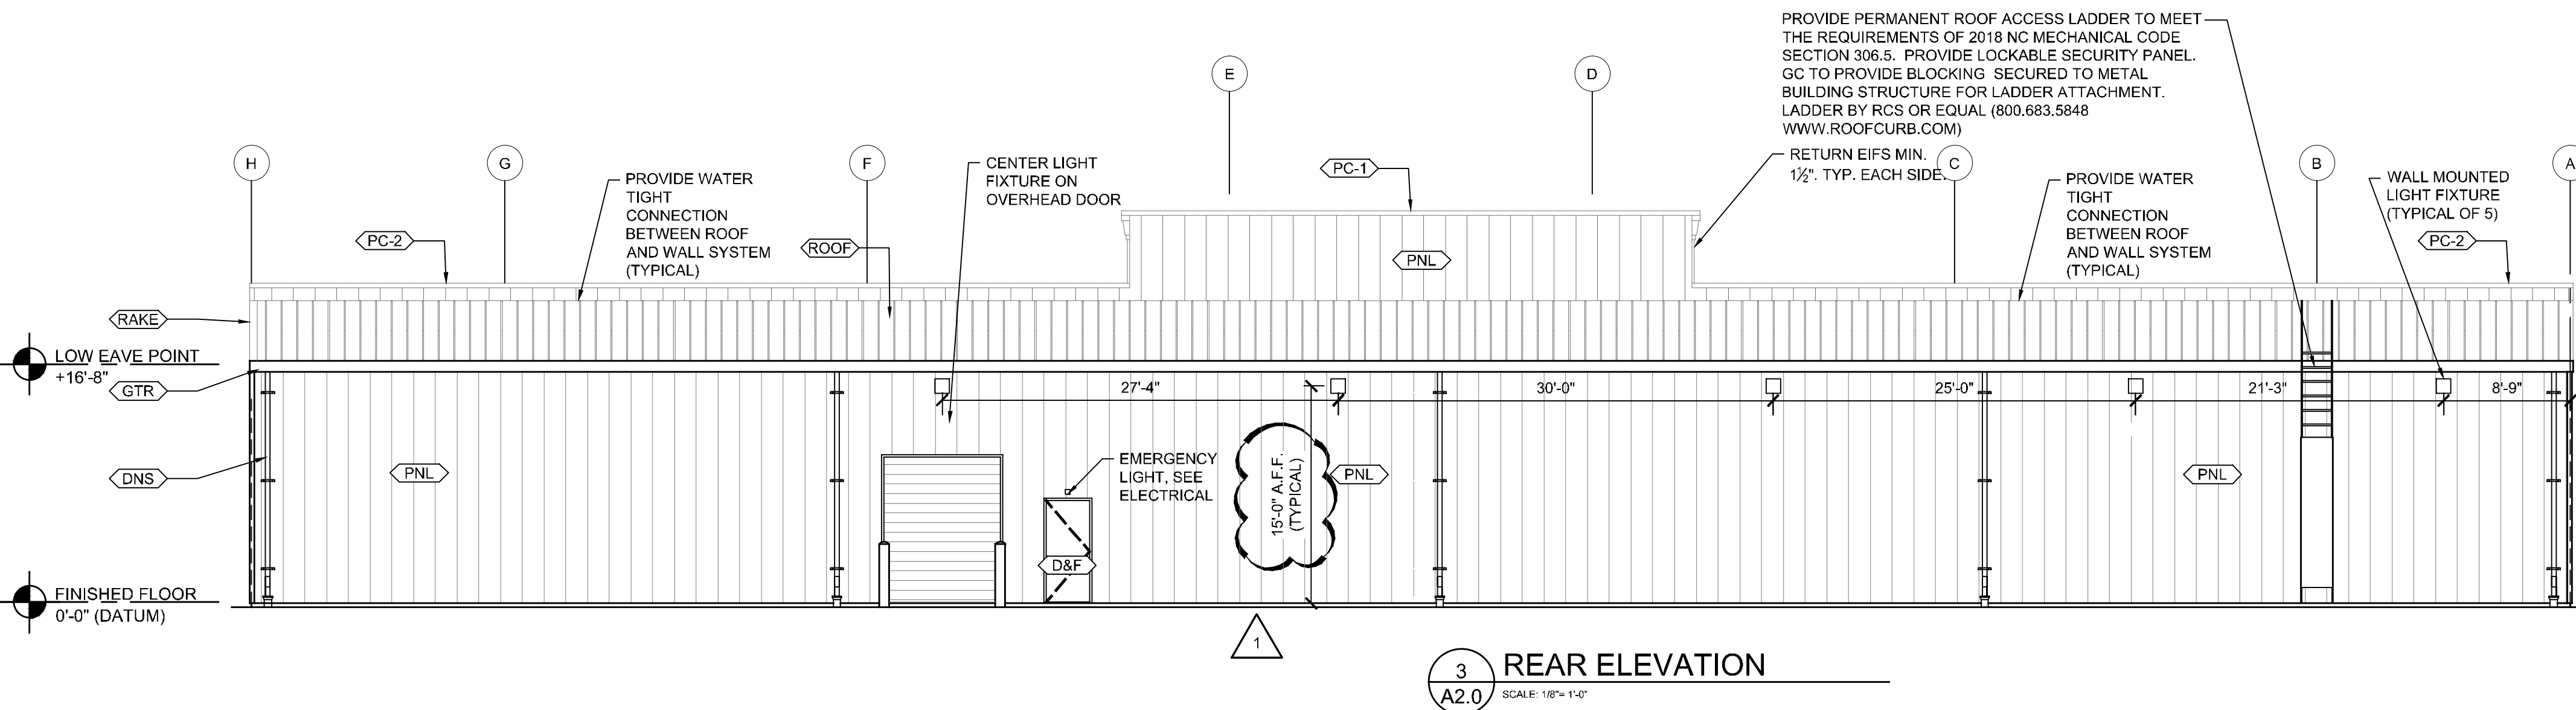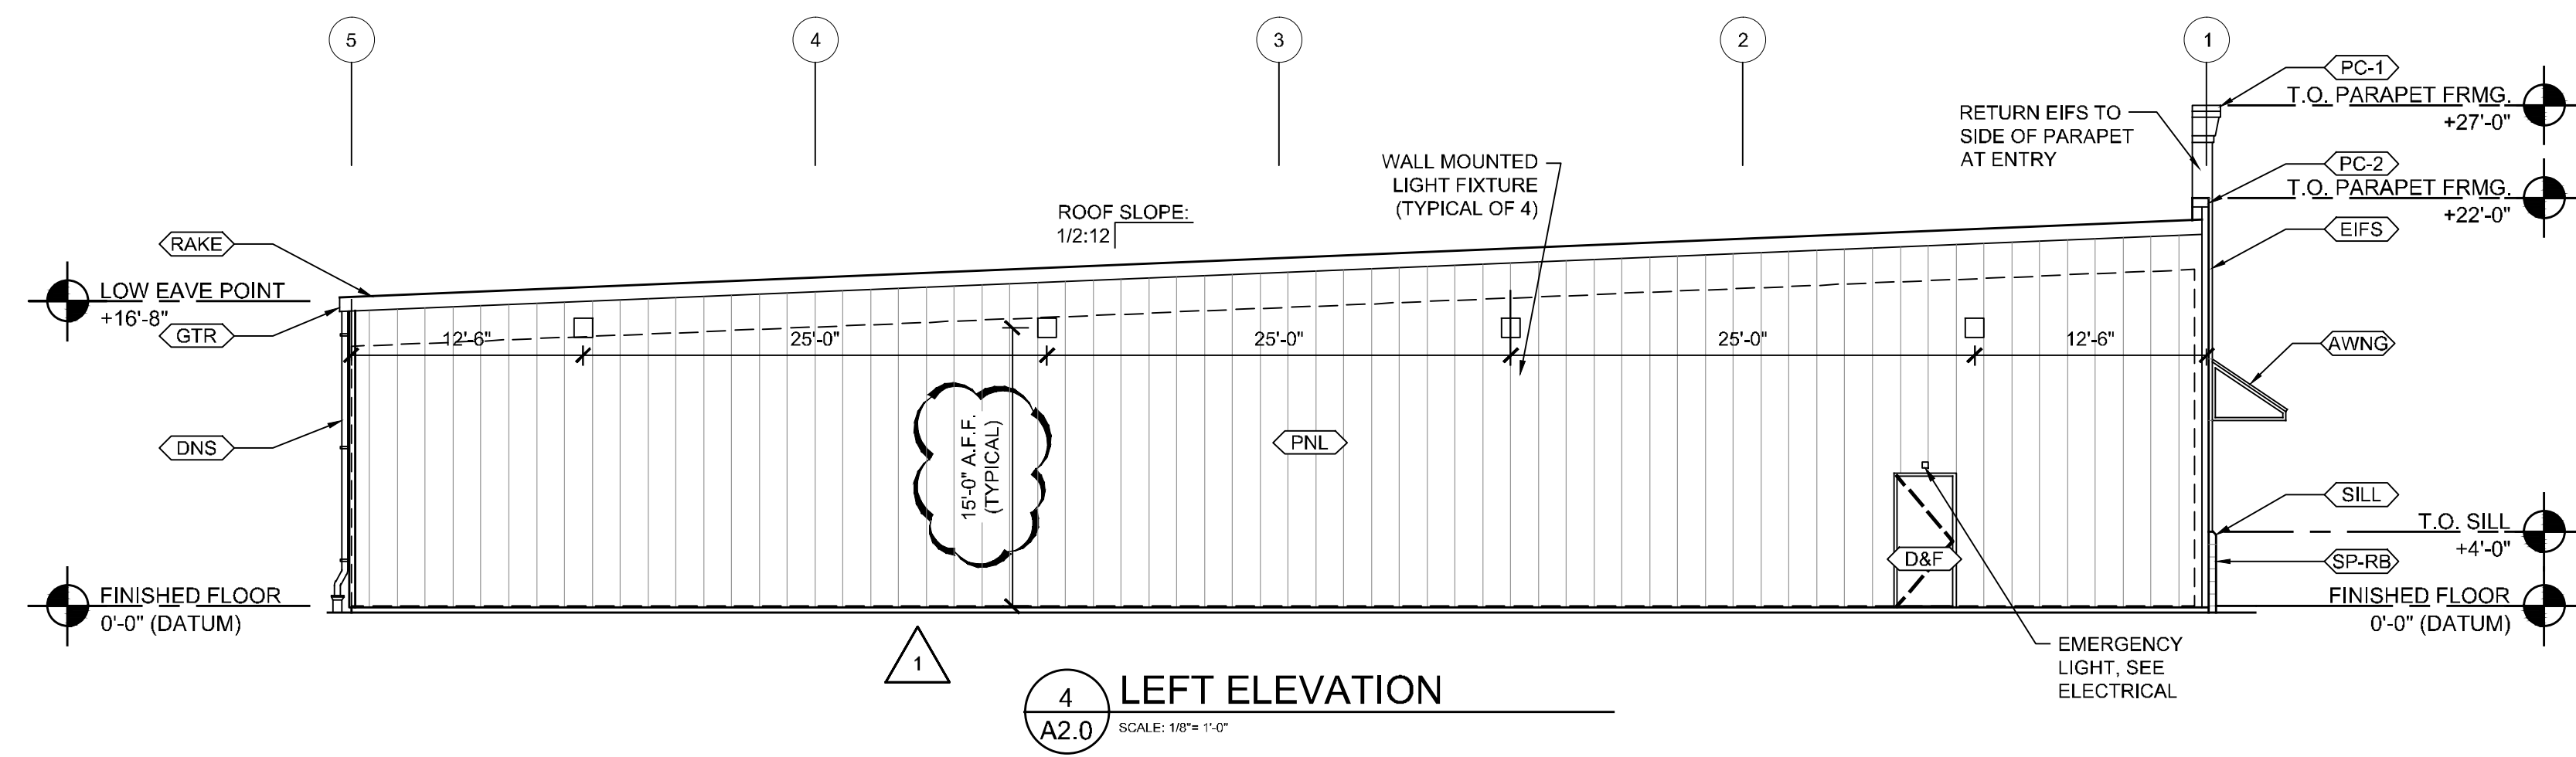

ELEVATION LEGEND		
KEYNOTE	DESCRIPTION	COLOR
<SP-RB>	SPLIT FACED CMU VENEER - RUNNING BOND	EQUAL TO SHERWIN WILLIAMS - SW7067 CITYSCAPE
<EIFS>	EIFS - COLOR 1 (FINISH - PRODUCT STO 310)	EQUAL TO SHERWIN WILLIAMS - SW4081 'SAFETY RED'
<PNL1>	26 GAUGE MBCI PBR METAL WALL PANEL (PROVIDED BY METAL BUILDING MANF.)	MBCI SIGNATURE 200 - 'ASH GRAY'
<RF-1>	24 GAUGE DOUBLE LOCK 3" METAL ROOF SYSTEM (PROVIDED BY METAL BUILDING MANF.)	MBCI SIGNATURE 200 - 'GALVALUME'
<SILL>	SPLIT FACED CMU SILL BLOCK	EQUAL TO SHERWIN WILLIAMS - SW7067 CITYSCAPE
<RAKE>	RAKE TRIM (PROVIDED BY METAL BUILDING MANF.)	MBCI SIGNATURE 200 - 'CHARCOAL GRAY'
<PC-1>	24 GAUGE KYNAR COATED METAL COPING (PROVIDED BY METAL BUILDING MANF.)	EQUAL TO SHERWIN WILLIAMS - SW4081 'SAFETY RED'
<PC-2>	24 GAUGE KYNAR COATED METAL COPING (PROVIDED BY METAL BUILDING MANF.)	MBCI SIGNATURE 200 - 'CHARCOAL GRAY'
<DNS>	PRE-FINISHED METAL DOWNSPOUT (SIZED & PROVIDED BY METAL BUILDING MANF.)	MBCI SIGNATURE 200 - 'ASH GRAY'
<GTR>	PRE-FINISHED METAL GUTTER (SIZED & PROVIDED BY METAL BUILDING MANF.)	MBCI SIGNATURE 200 - 'ASH GRAY'
<AWNG>	STANDING SEAM METAL AWNING	EQUAL TO MBCI SIGNATURE 200 - 'COBALT BLUE'
<D&F>	N/A	STEEL DOOR & HOLLOW METAL FRAME
PAINTING NOTES: CMU - (1) COAT OF S-W LOXON BLOCK SURFACER A24W200 (OR EQUAL), COATING, A5-400 SERIES (OR EQUAL) METAL - (2) COATS OF S-W METALTEX ACRYLIC SEMI-GLOSS (B42 SERIES)		
A	STOREFRONT TYPE (REFER TO SHEET A-3.0)	
500	DOOR NUMBER (REFER TO SHEET A-1.0)	
CJ	MASONRY CONTROL JOINT - RAKE & CAULK JOINT (MATCH BLOCK COLOR)	

HELT
DESIGN
ARCHITECTURE INTERIORS

6405 W. WILKINSON
BLVD, STE. 100
BELMONT, NC 28012

704.342.1686
HELTDDESIGN.COM
INFO@HELTDESIGN.COM
PROJECT NAME:

HARBOR
FREIGHT TOOLS
FOR
STOCKS & TAYLOR
CONSTRUCTION

PROJECT NO: 23174

PROJECT ADDRESS:

46 SHRIJI LANE
ERWIN, NC 28339

SEAL: 05/23/24



CORPORATE ENTITY:
C.L. HELT, ARCHITECT, INC. A NORTH CAROLINA PROFESSIONAL CORPORATION DBA HELT DESIGN.

COPYRIGHT:
THIS DRAWING AND ITS COPIES ARE THE ARCHITECT'S INSTRUMENTS OF SERVICE. THEY RETAIN ALL COMMON LAW AND STATUTORY RIGHTS, INCLUDING COPYRIGHT. THEY SHALL NOT BE USED OR COPIED FOR ANY PROJECT OTHER THAN THE ONE TITLED HERE IN.

DRAWING RELEASE:


NO.	DATE	DESCRIPTION
△	05/23/24	HFT REVIEW COMMENTS

DRAWN BY: ME
CHECKED BY: JZ


DATE: 04/19/24

SHEET TITLE:
ELEVATIONS


SHEET NUMBER:
A2.0

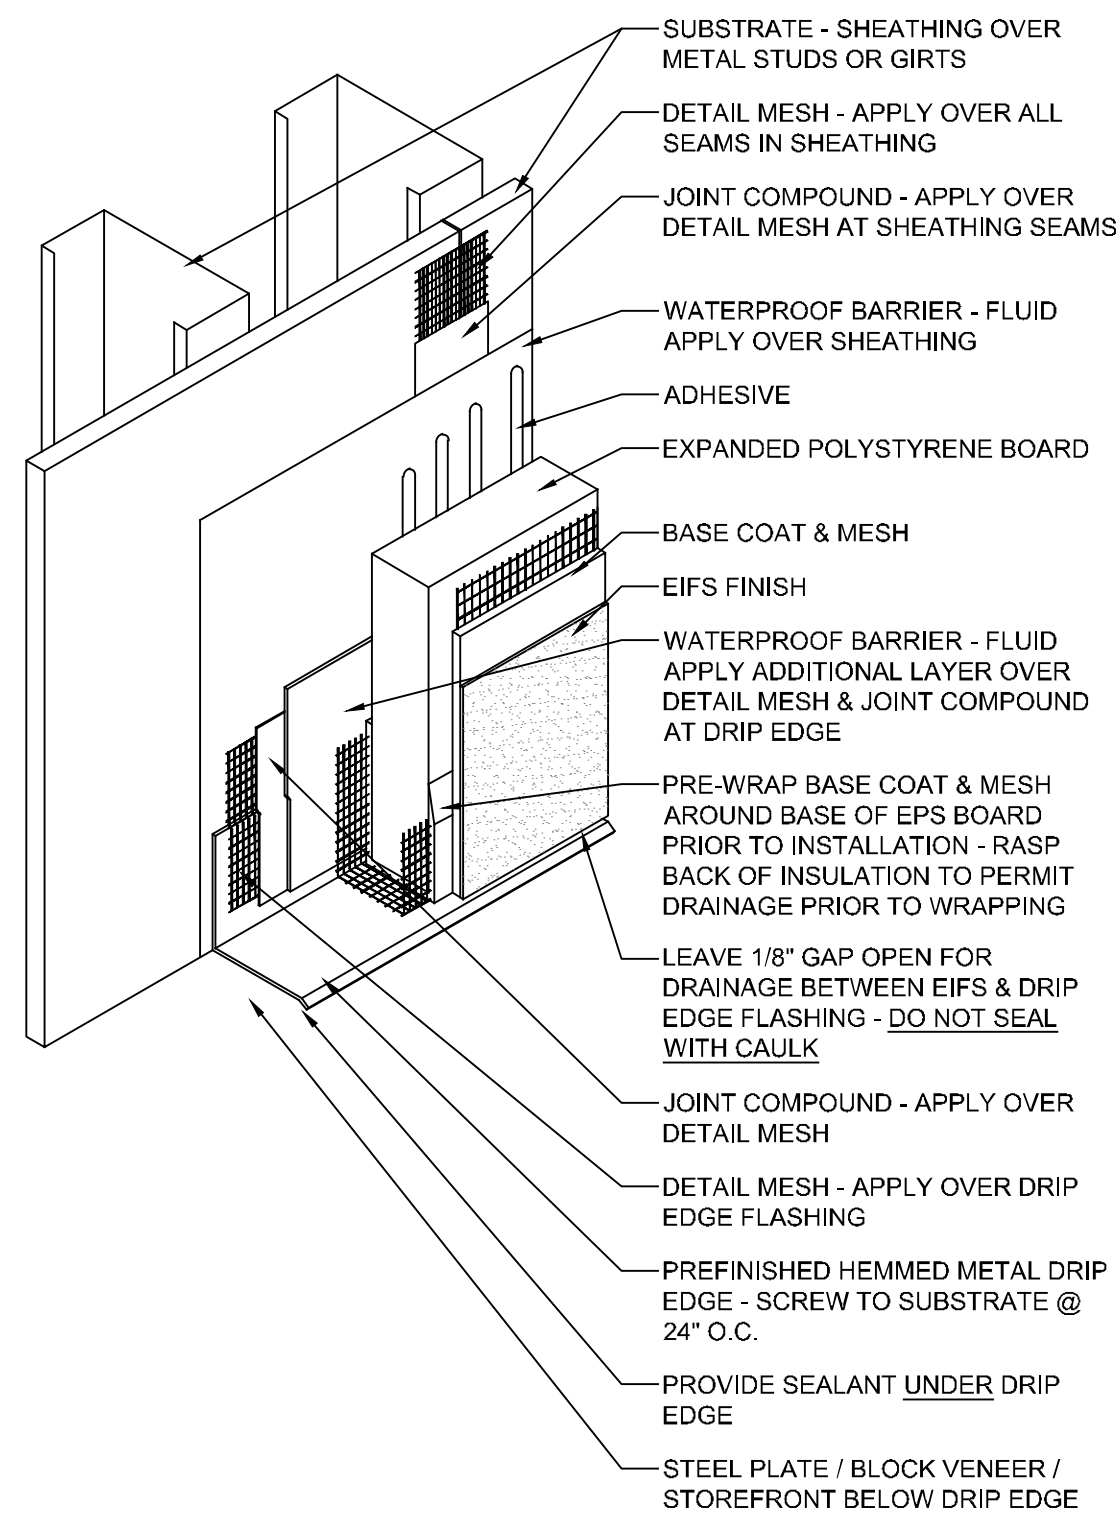


1 EIFS DRIP EDGE / ATTACHMENT
SCALE: NOT TO SCALE

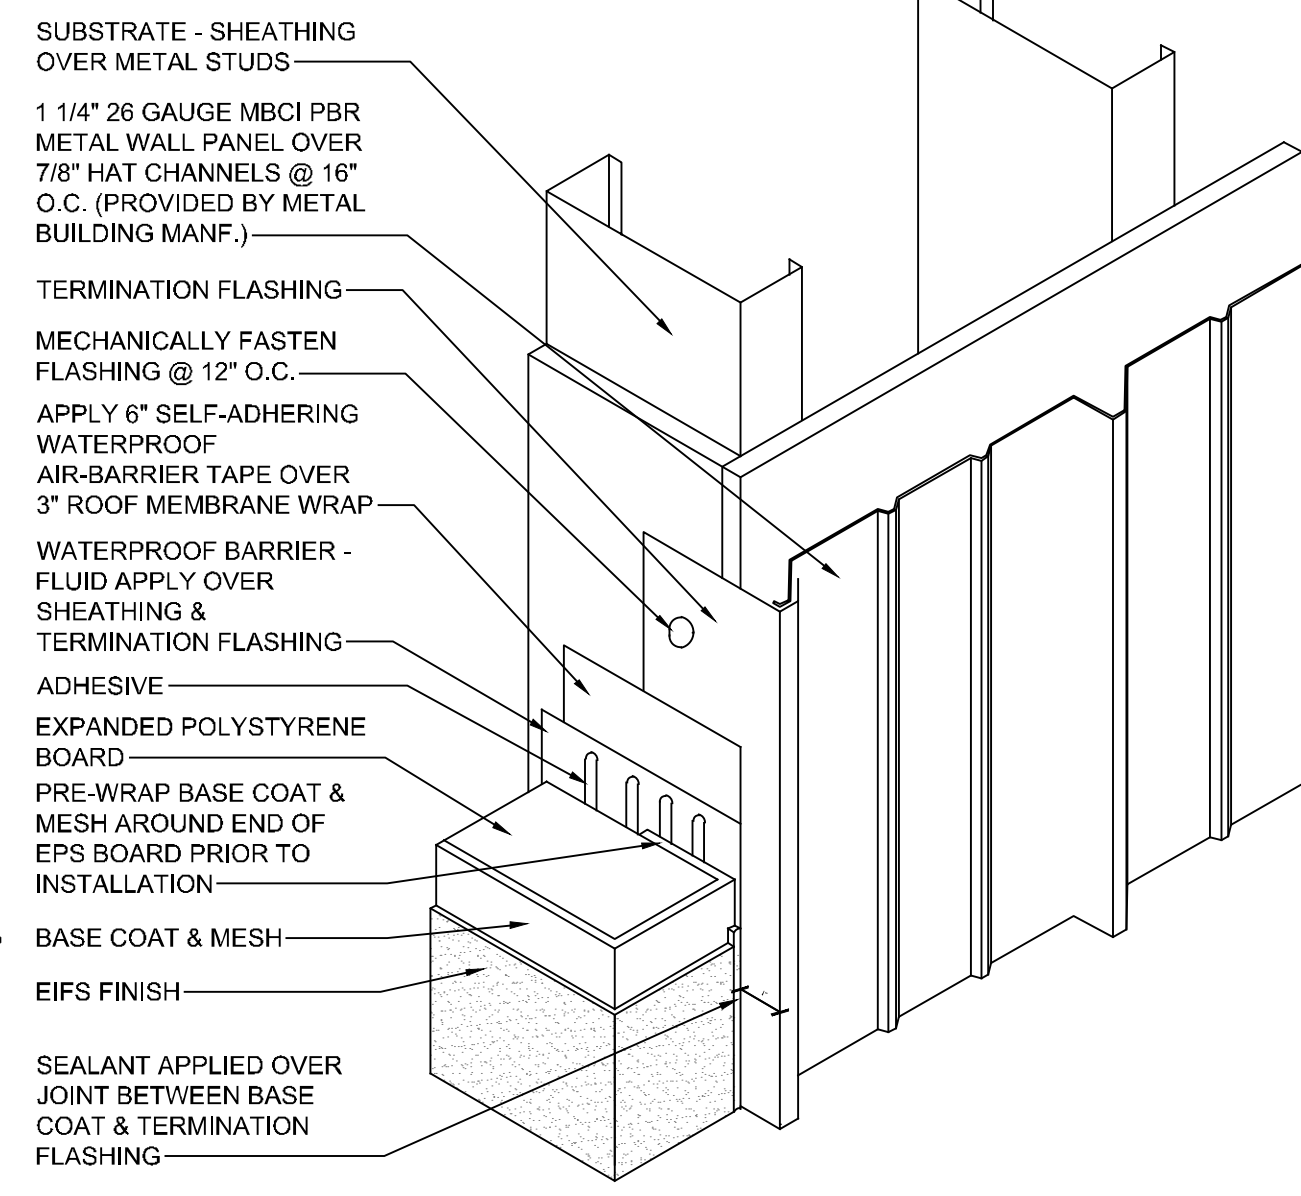

2 EIFS TERMINATION DETAIL
NOT TO SCALE

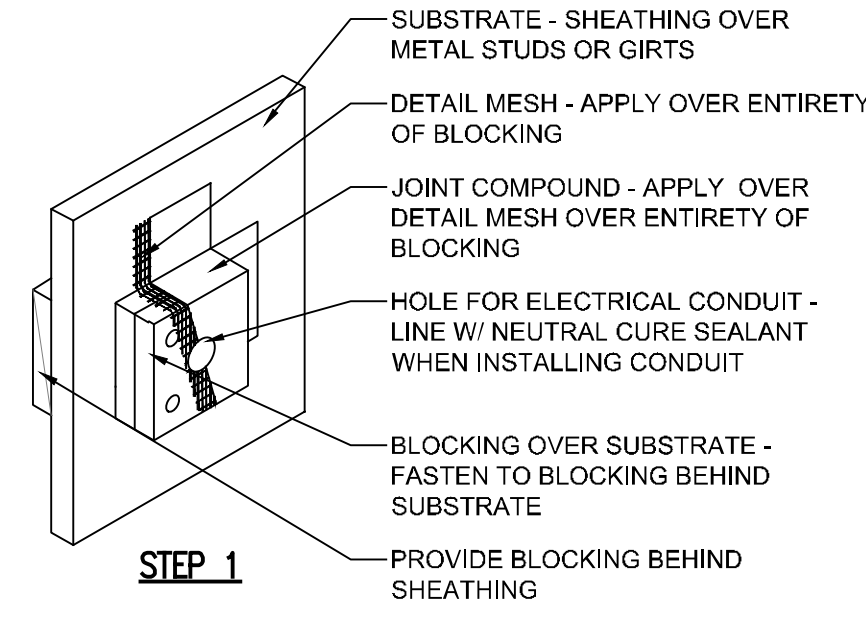


STEP 1

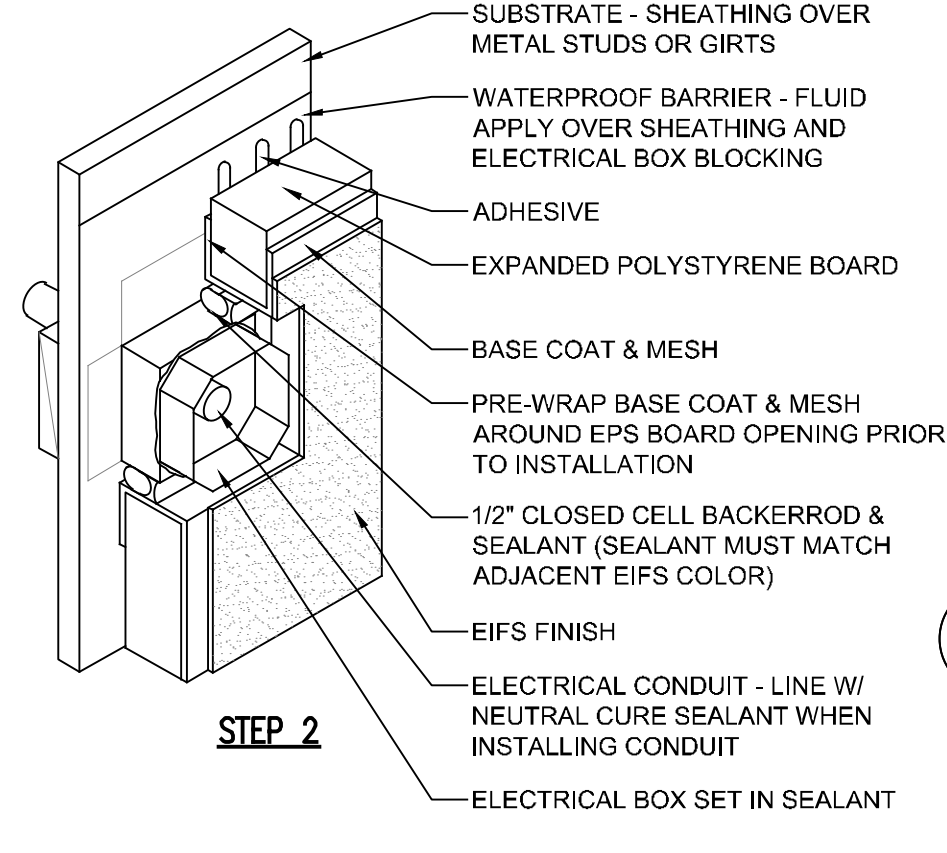


STEP 2


3 EIFS ELECTRICAL BOX DETAIL
SCALE: NOT TO SCALE

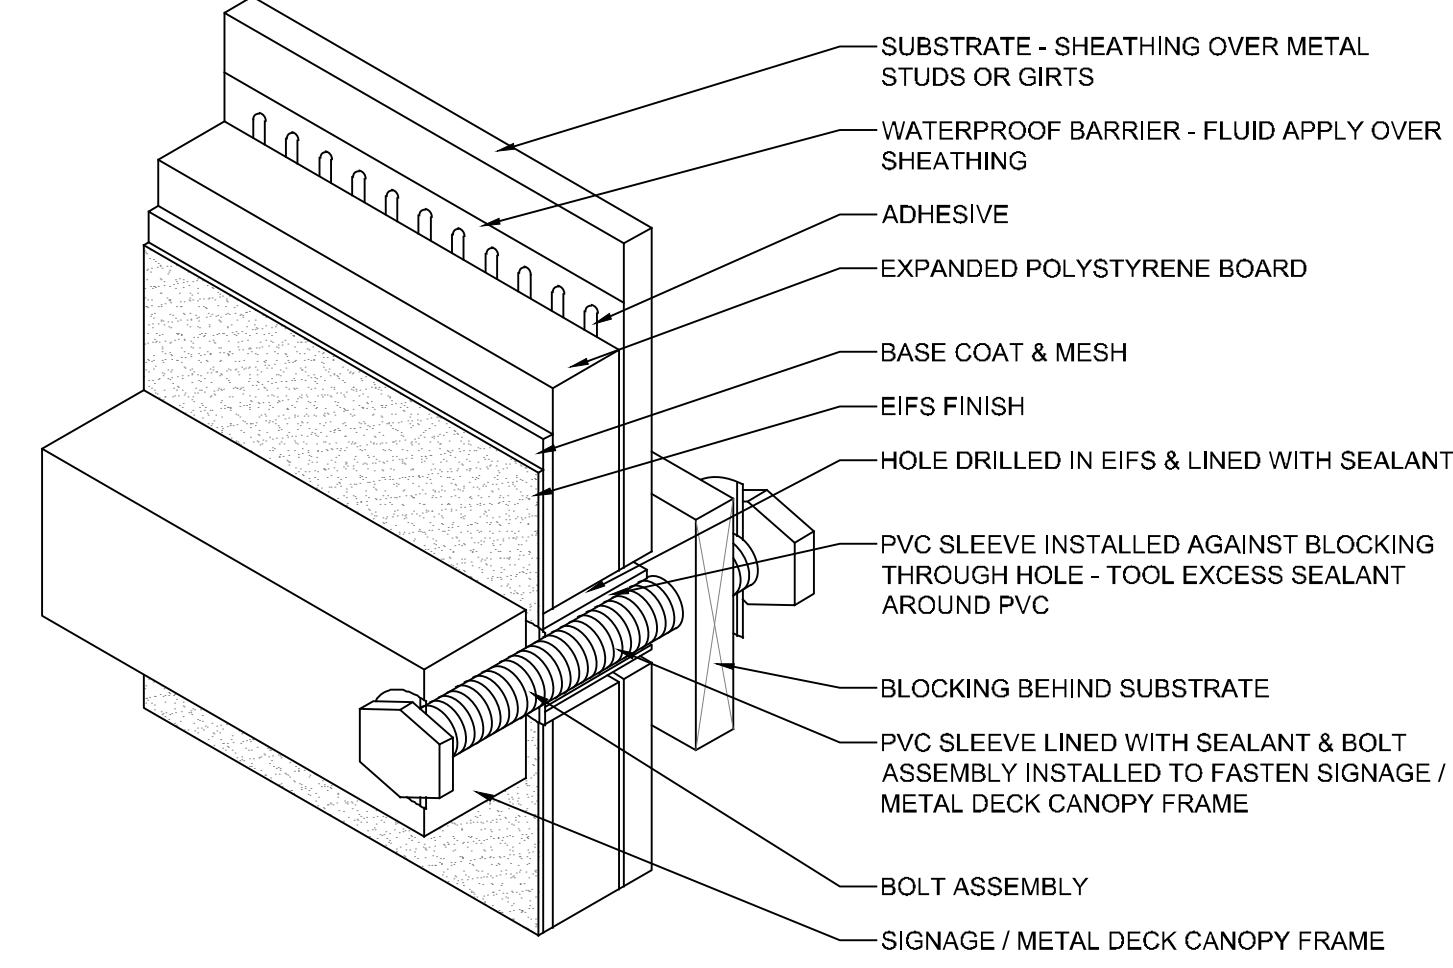

4 EIFS SIGN/METAL DECK CANOPY ANCHORAGE DETAIL
SCALE: NOT TO SCALE

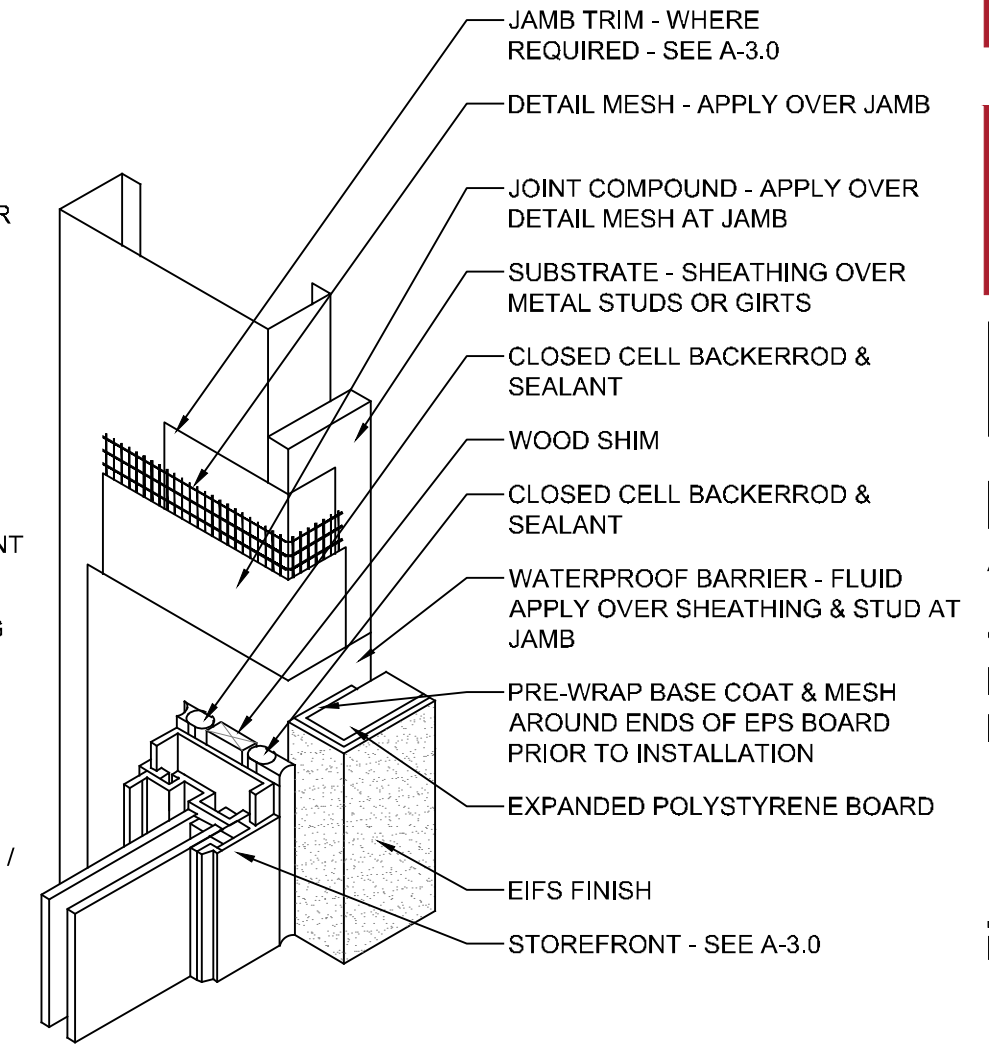

5 EIFS JAMB DETAIL
SCALE: NOT TO SCALE

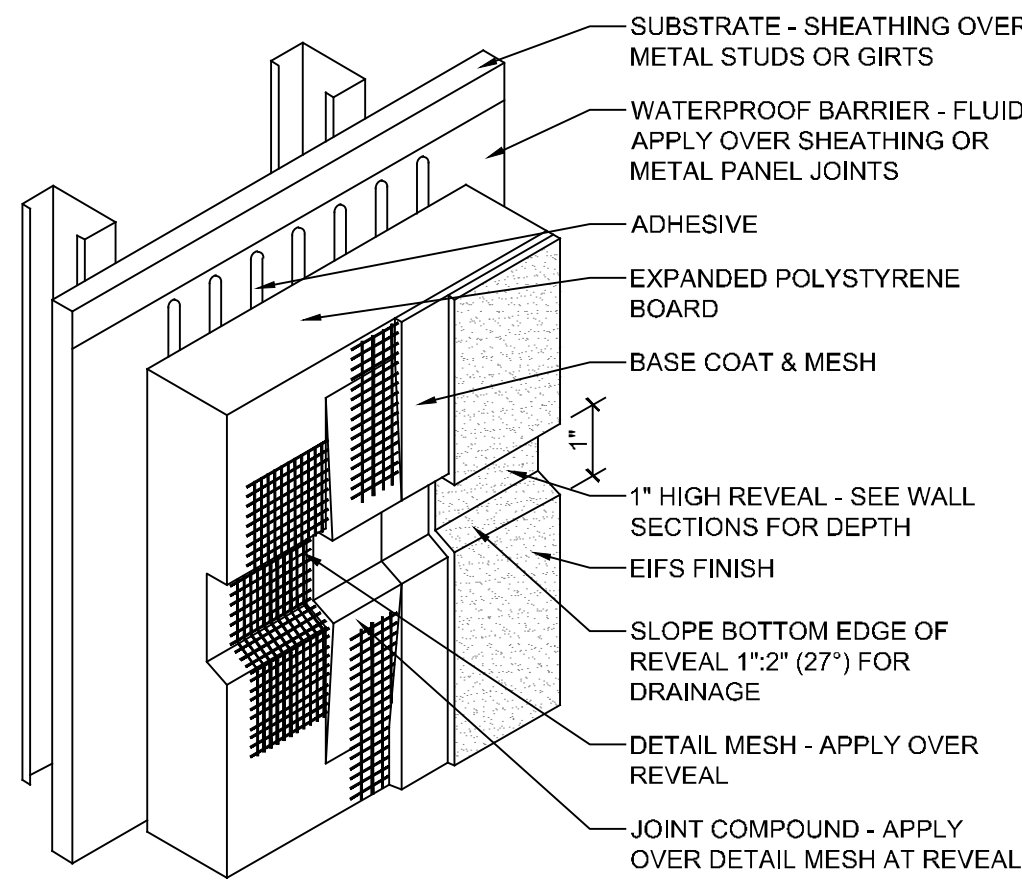

6 EIFS REVEAL DETAIL
SCALE: NOT TO SCALE

HELT DESIGN
ARCHITECTURE INTERIORS

6405 W. WILKINSON BLVD, STE. 100
BELMONT, NC 28012


704.342.1686
HELTDESIGN.COM
INFO@HELTDESIGN.COM
PROJECT NAME:

HARBOR FREIGHT TOOLS
FOR STOCKS & TAYLOR CONSTRUCTION

PROJECT NO: 23174

PROJECT ADDRESS:

46 SHRIJI LANE
ERWIN, NC 28339

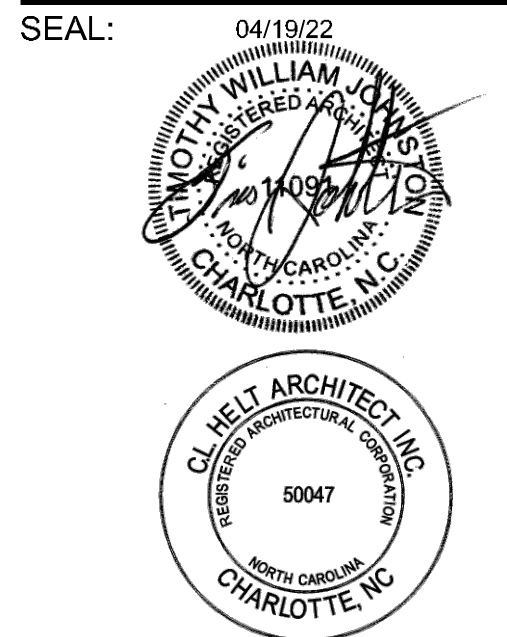

CORPORATE ENTITY:
C.L. HELT, ARCHITECT, INC. A NORTH CAROLINA PROFESSIONAL CORPORATION DBA HELT DESIGN.

COPYRIGHT:
THIS DRAWING AND ITS COPIES ARE THE ARCHITECT'S INSTRUMENTS OF SERVICE. THEY RETAIN ALL COMMON LAW AND STATUTORY RIGHTS, INCLUDING COPYRIGHT. THEY SHALL NOT BE USED OR COPIED FOR ANY PROJECT OTHER THAN THE ONE TITLED HERE IN.

DRAWING RELEASE:

NO.	DATE	DESCRIPTION

DRAWN BY: ME CHECKED BY: JZ

DATE: 04/19/24

SHEET TITLE:
EIFS DETAILS

SHEET NUMBER:

A2.1


**HARBOR
FREIGHT TOOLS**
FOR
STOCKS & TAYLOR
CONSTRUCTION

PROJECT NO: 23174

PROJECT ADDRESS:

46 SHRIJI LANE
ERWIN, NC 28339

SEAL: 05/23/24

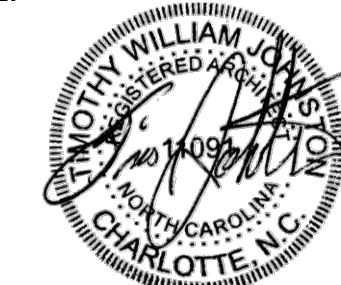

CORPORATE ENTITY:
C.L. HELT, ARCHITECT, INC. A NORTH
CAROLINA PROFESSIONAL CORPORATION
DBA HELT DESIGN.

COPYRIGHT:
THIS DRAWING AND ITS COPIES ARE THE
ARCHITECT'S INSTRUMENTS OF SERVICE.
THEY RETAIN ALL COMMON LAW AND
STATUTORY RIGHTS, INCLUDING COPYRIGHT.
THEY SHALL NOT BE USED OR COPIED FOR
ANY PROJECT OTHER THAN THE ONE TITLED
HERE IN.

DRAWING RELEASE:

NO.	DATE	DESCRIPTION
△	05/23/24	HFT REVIEW COMMENTS



DRAWN BY: ME
CHECKED BY: JZ


DATE: 04/19/24

SHEET TITLE:
BUILDING SECTIONS


SHEET NUMBER:

A3.0

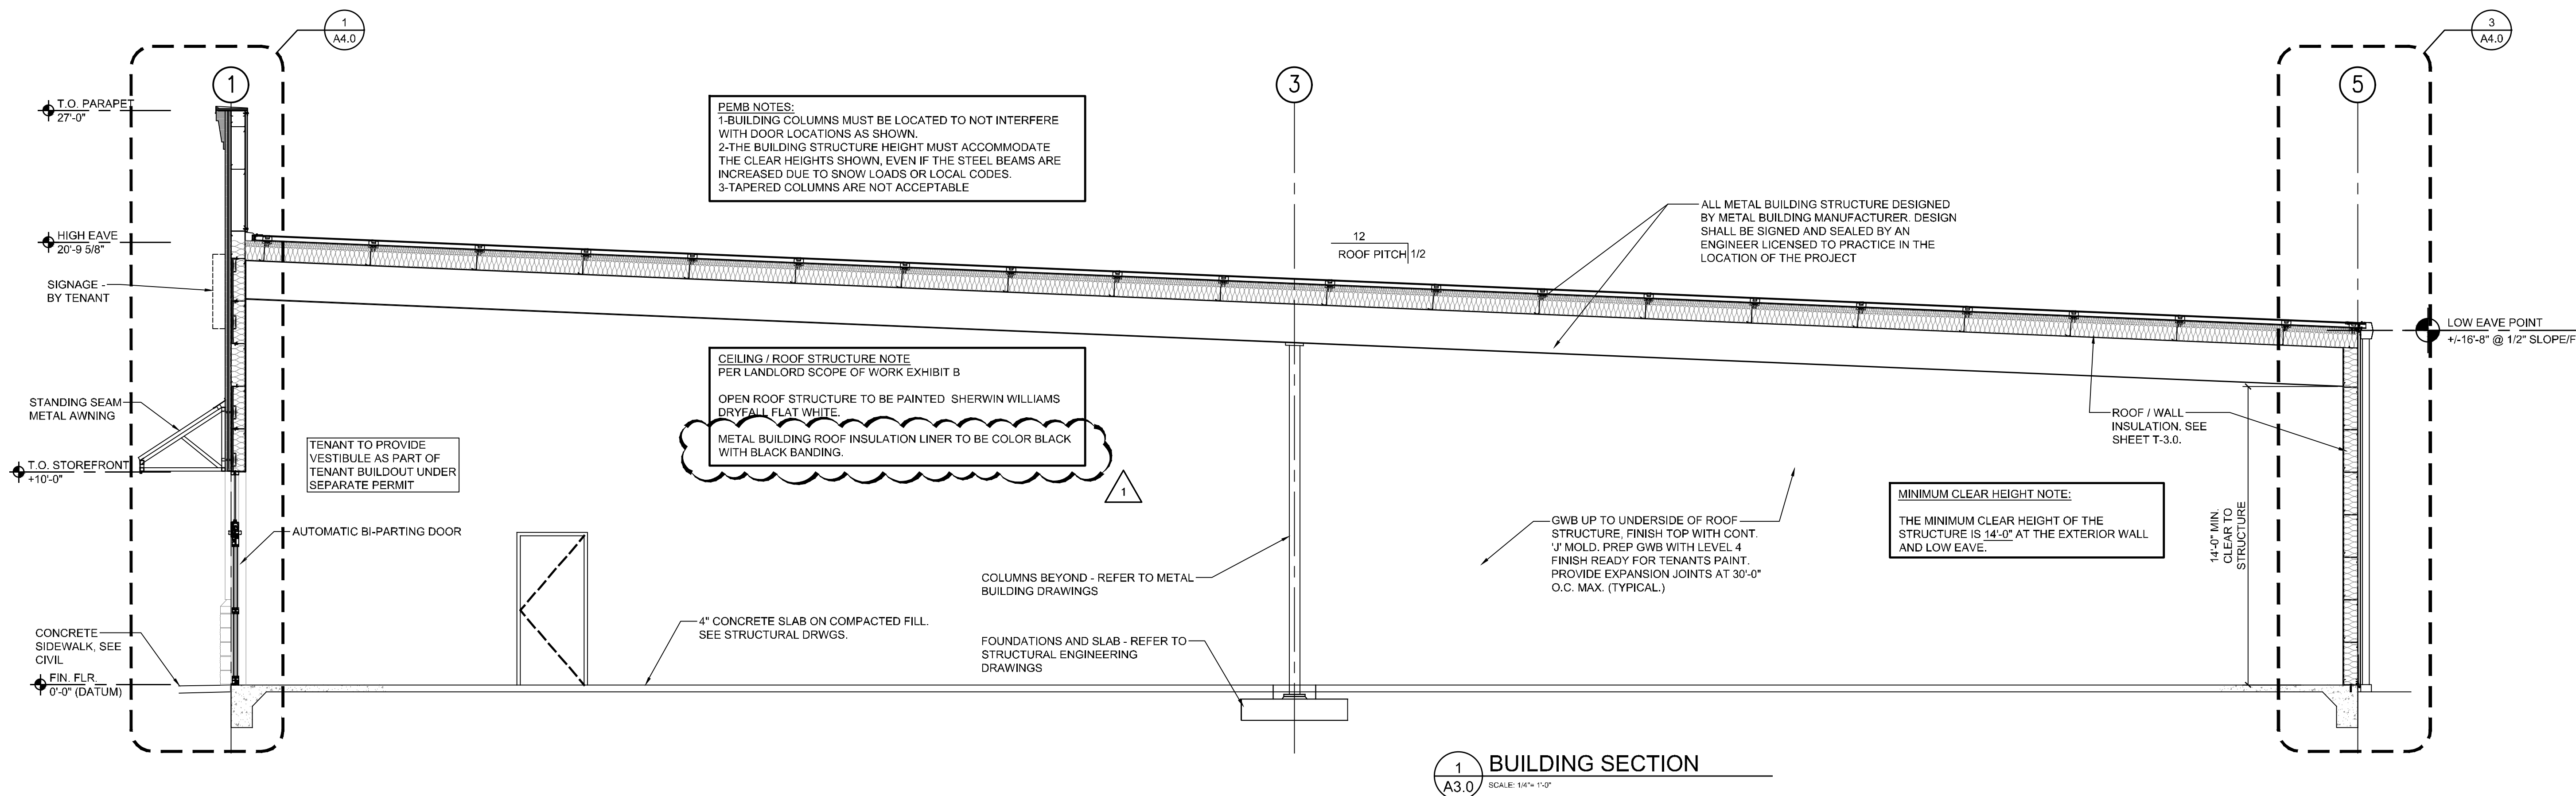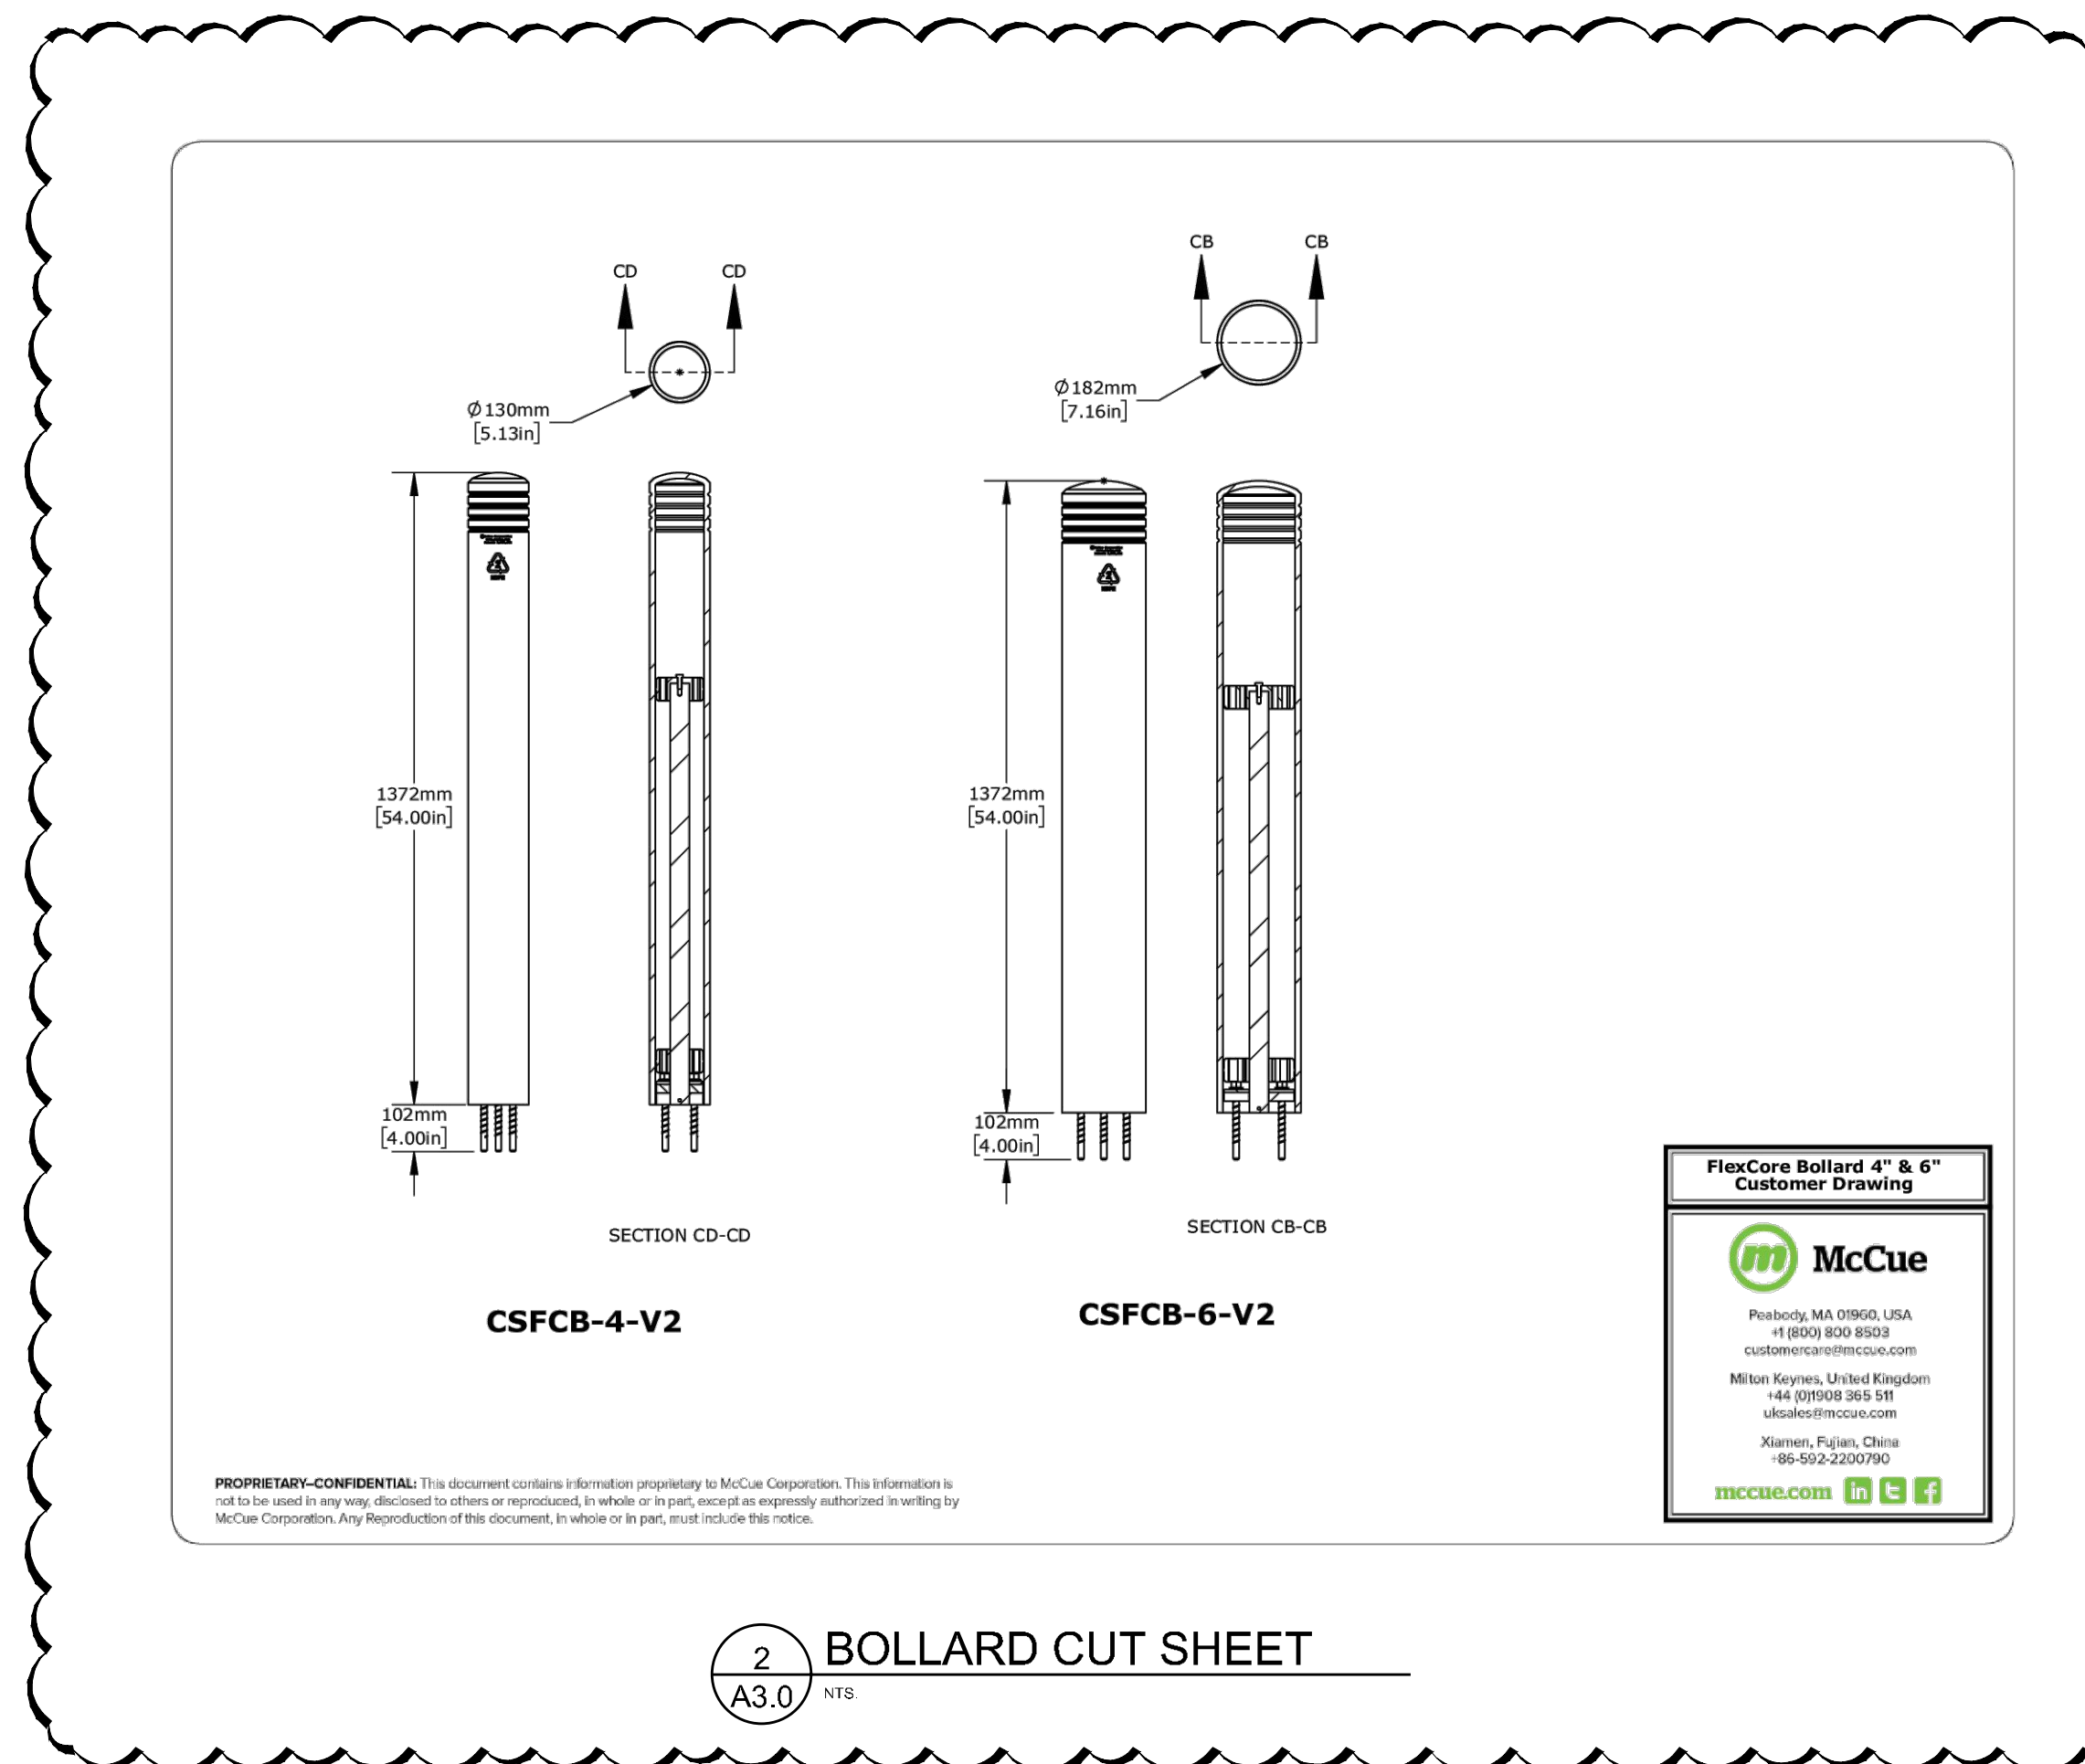


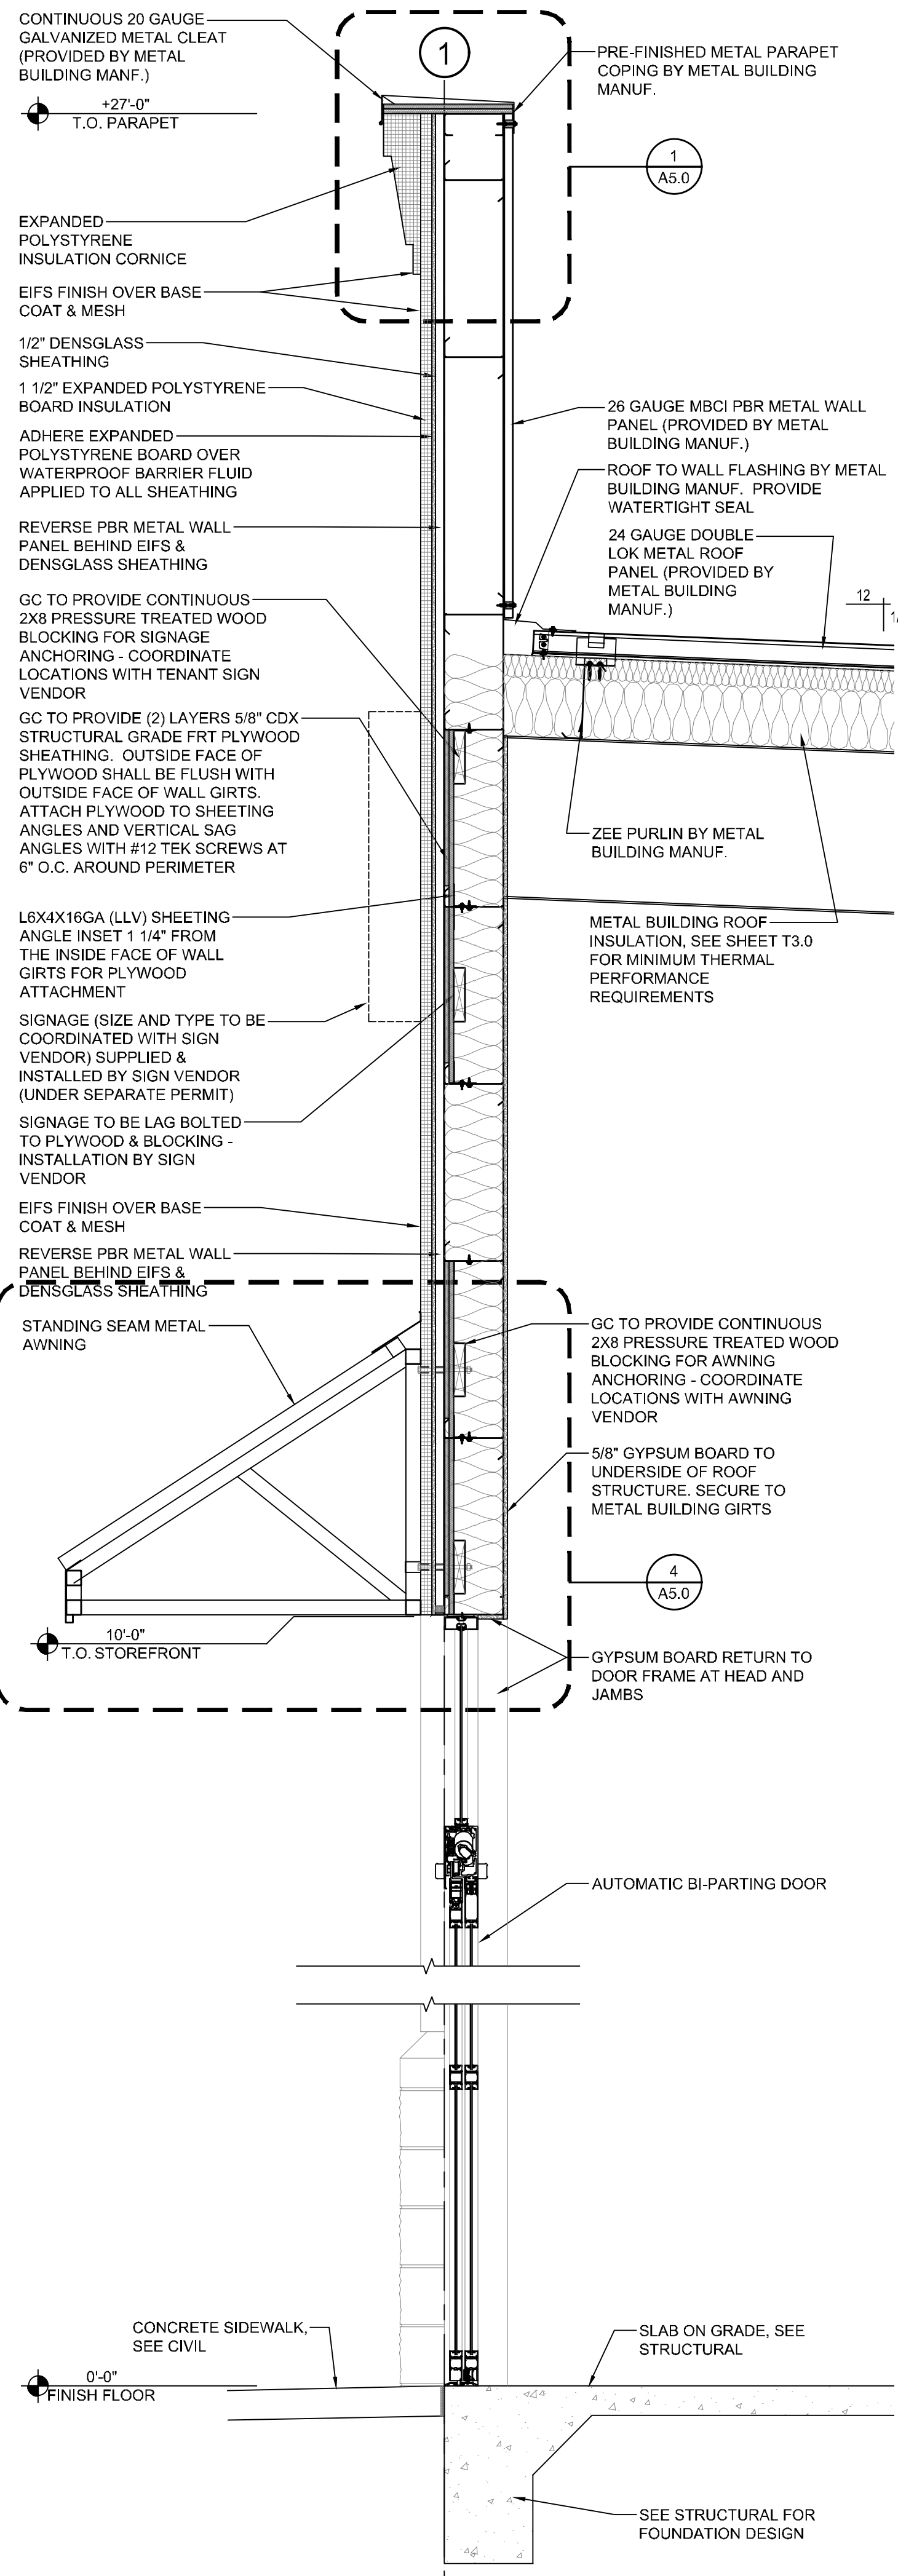


1 WALL SECTION
SCALE: 1/4" = 1'-0"

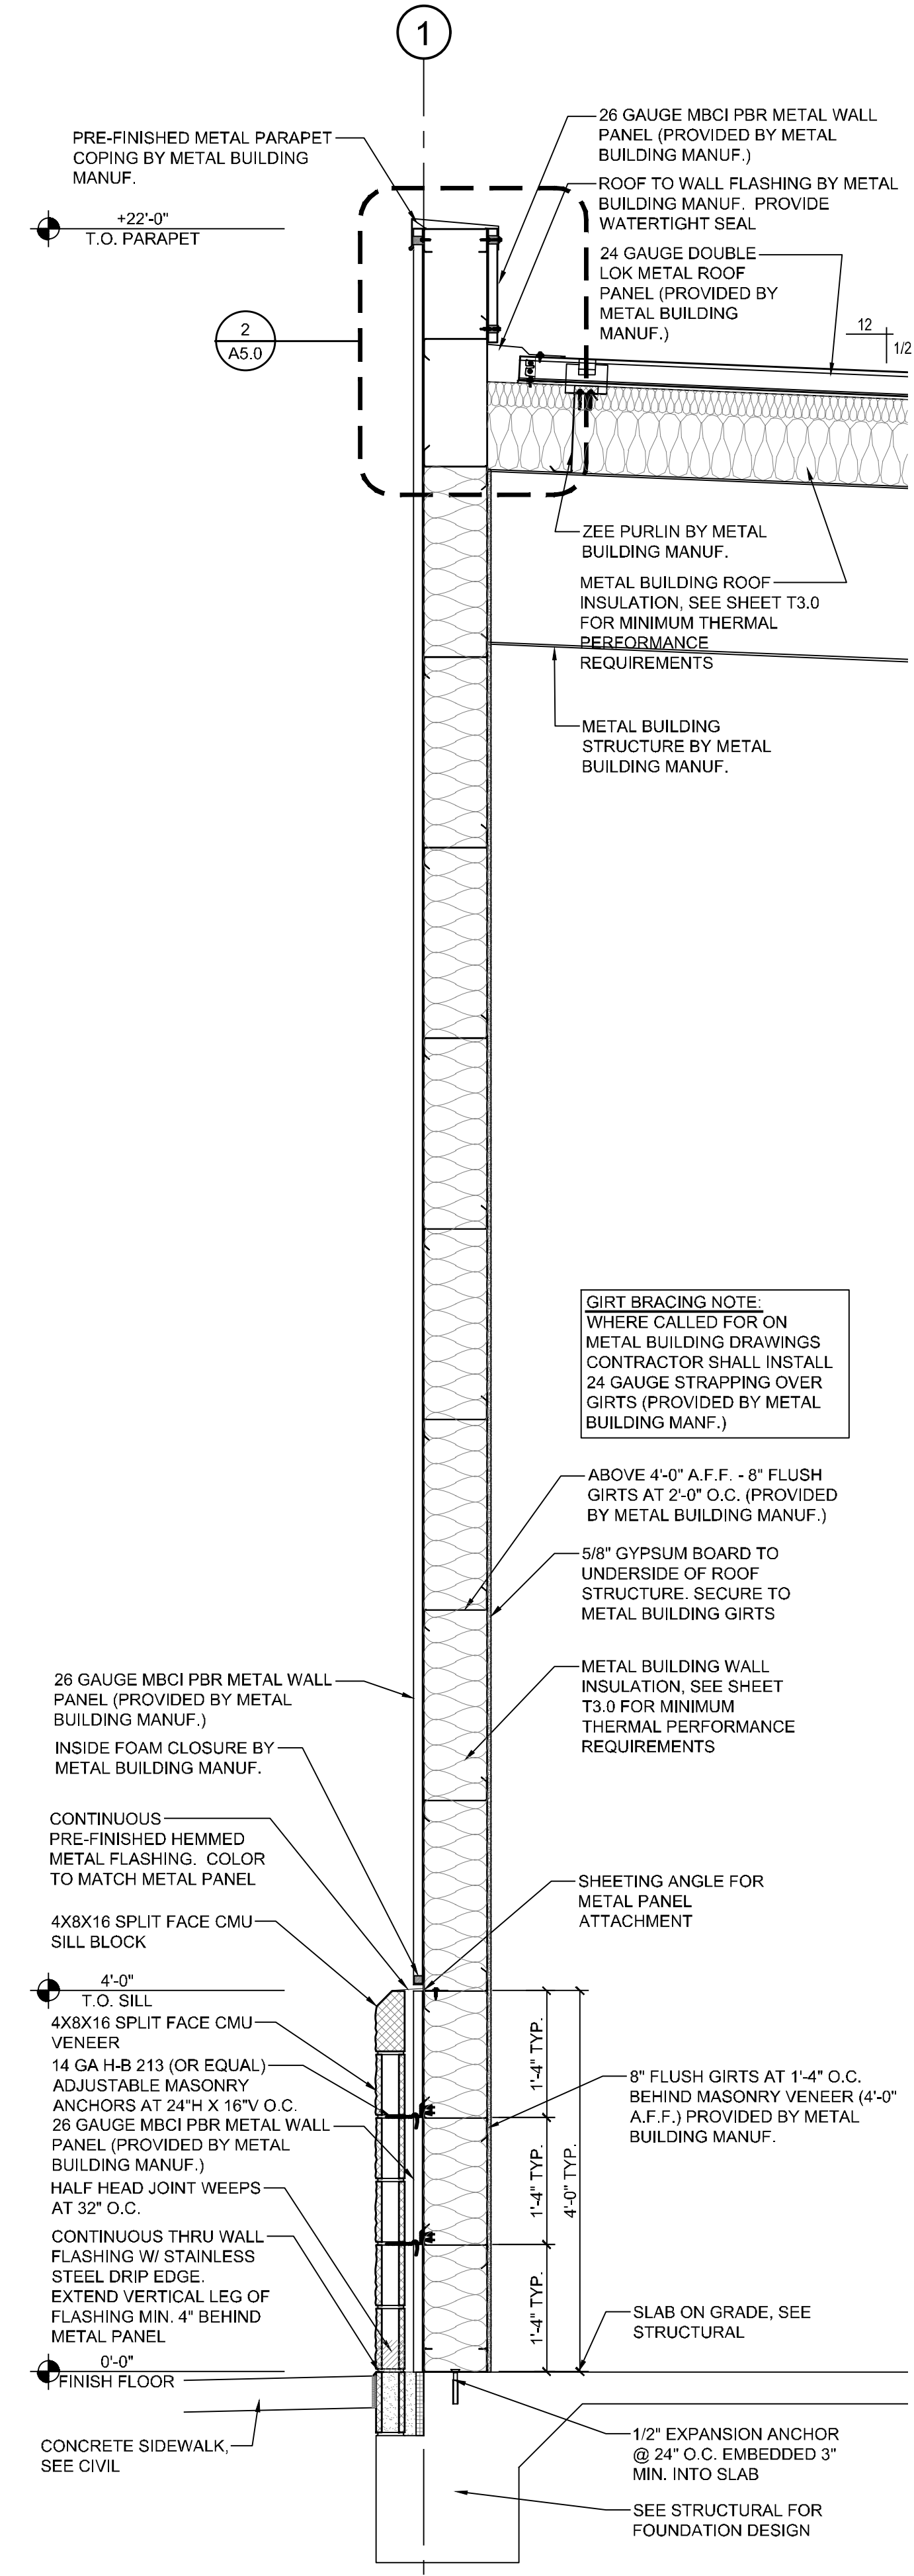

2 WALL SECTION
SCALE: 1/4" = 1'-0"

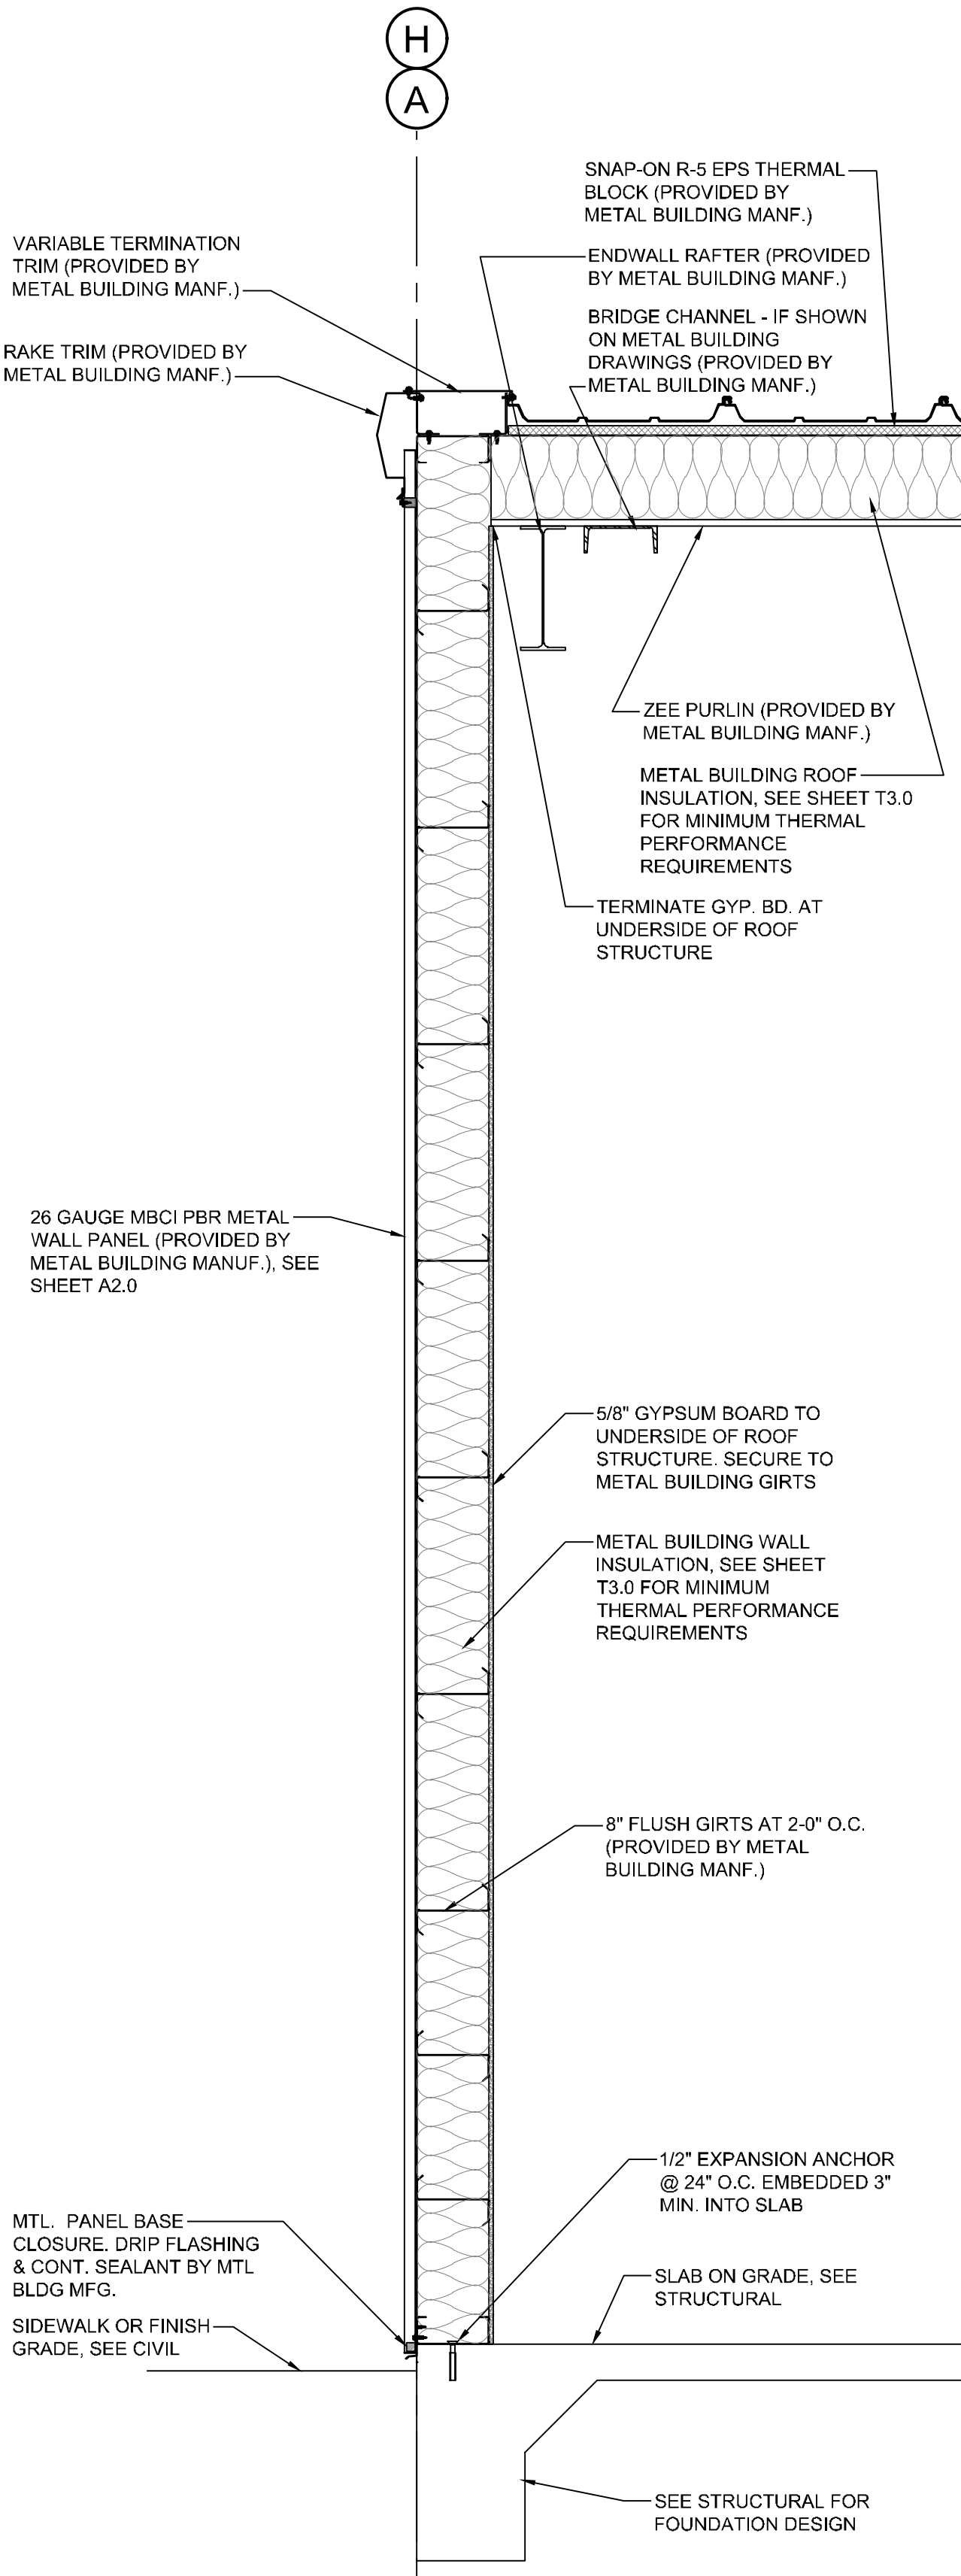

3 WALL SECTION
SCALE: 1/4" = 1'-0"

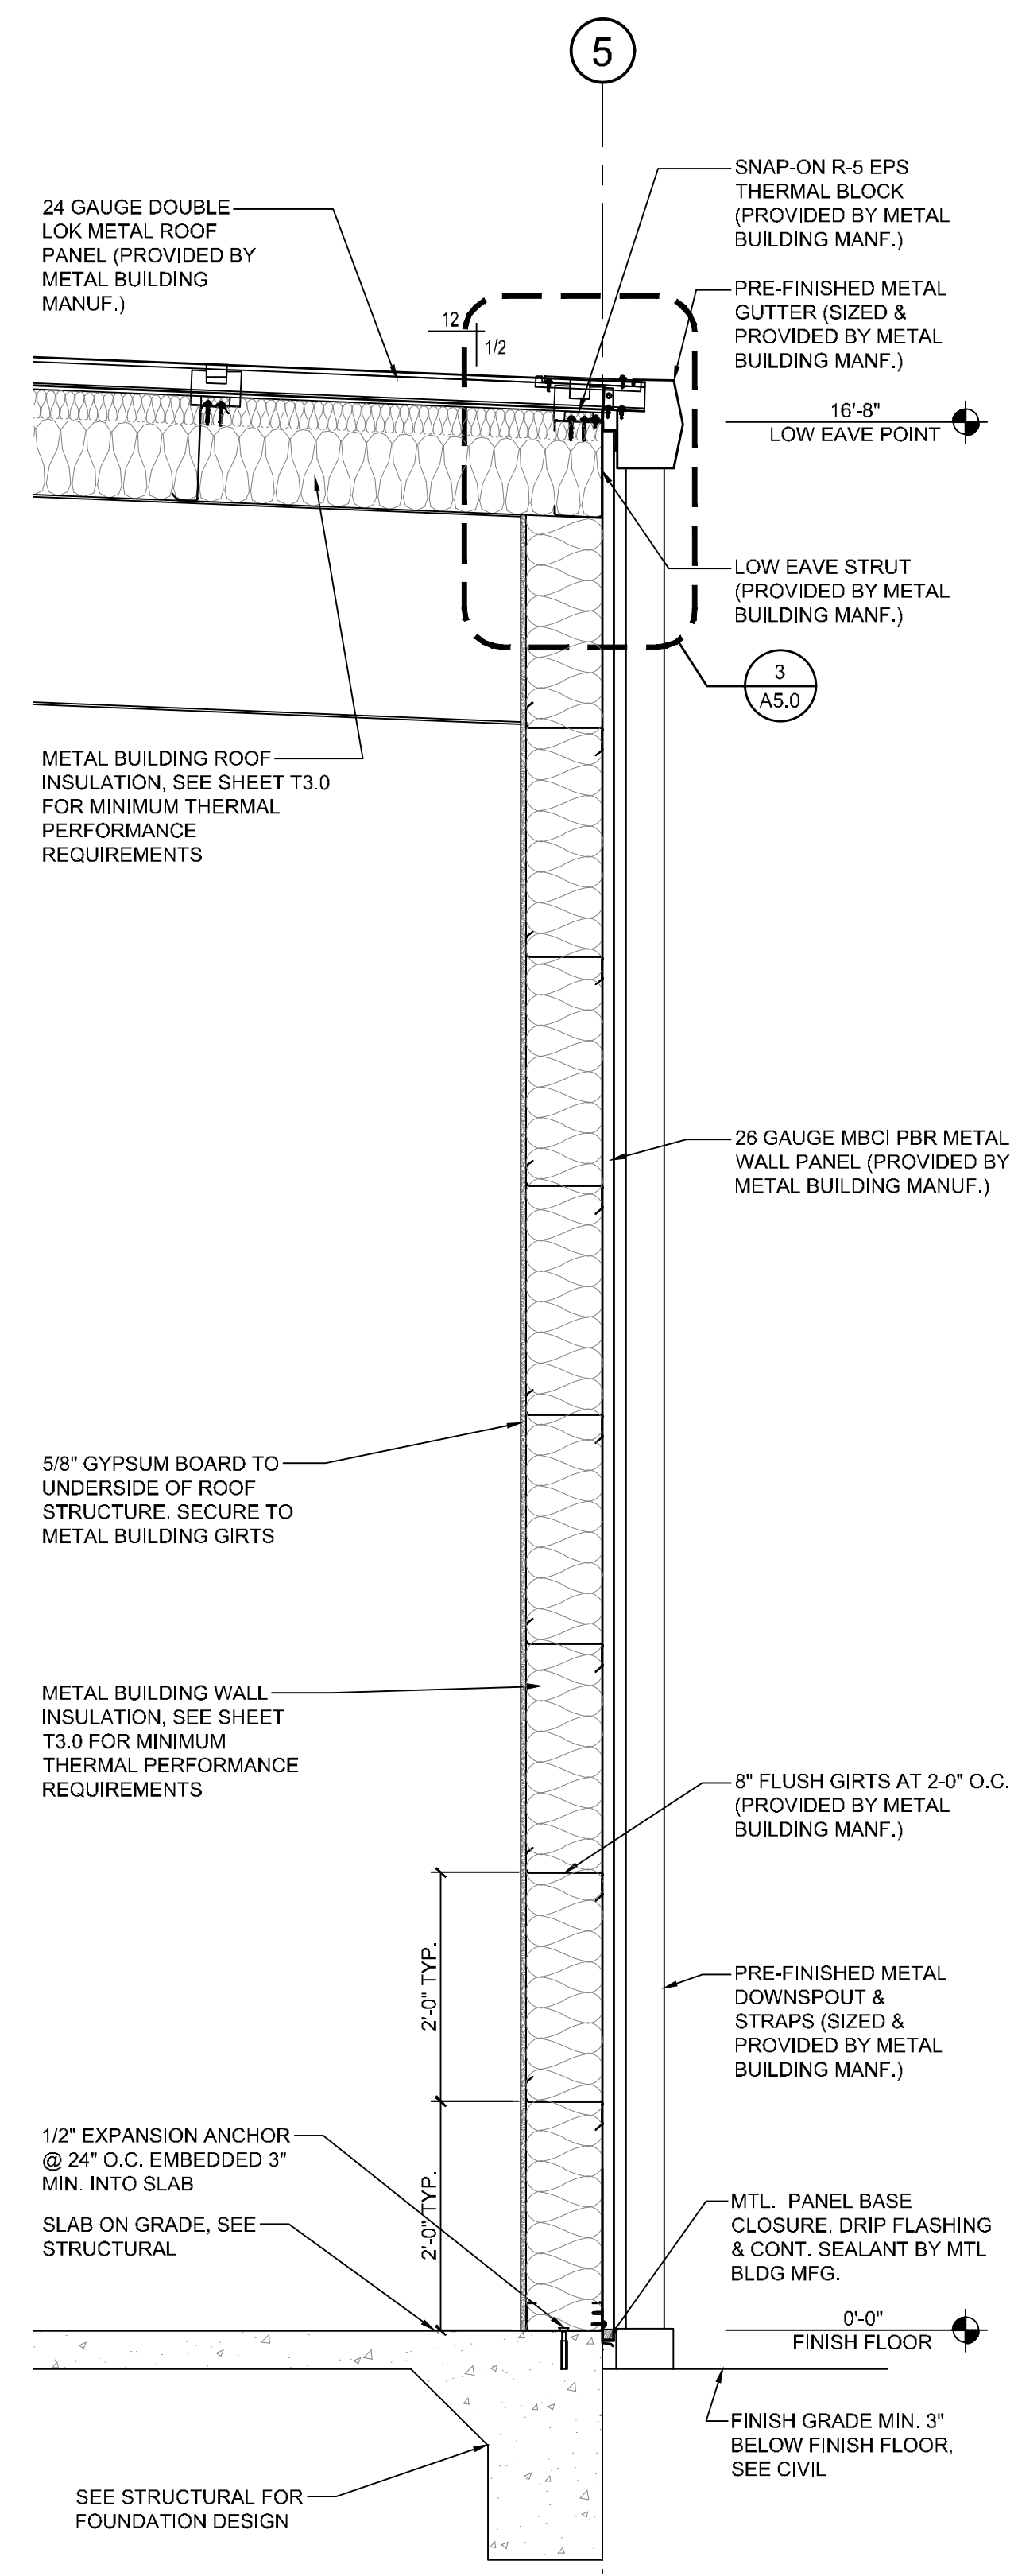

4 WALL SECTION
SCALE: 1/4" = 1'-0"

MASONRY VENEER FLASHING & WEEPS
LOCATE NEOPRENE THRU-WALL FLASHING AT FIRST BED JOINT BELOW FINISH FLOOR. PROVIDE HALF HEAD JOINT WEEPS @ 32" O.C. IN HEAD JOINTS AT THRU WALL FLASHING.
WHEN TOP OF SIDEWALK COVERS BED JOINTS BELOW FINISH FLOOR THEN THRU WALL FLASHING IS TO BE LOCATED AT FIRST BED JOINT ABOVE SIDEWALK. PROVIDE HALF HEAD JOINT WEEPS @ 32" O.C. IN HEAD JOINTS AT THRU WALL FLASHING. GROUT FILL VOIDS, AIR SPACE AND CMU BELOW FLASHING.

SIDEWALK TO BUILDING NOTE:
WHERE SIDEWALKS ABUTT THE BUILDING, PROVIDE A 1/4" ASPHALTIC EXPANSION JOINT WITH BACKERROD & GRAY SEALANT.

CEILING/ROOF STRUCTURE NOTE
PER LANDLORD SCOPE OF WORK EXHIBIT B
OPEN ROOF STRUCTURE TO BE PAINTED SHERWIN WILLIAMS DRYFALL FLAT WHITE. METAL BUILDING ROOF INSULATION LINER TO BE COLOR BLACK WITH BLACK BANDING.

PEMB INSULATION NOTE:
GC IS RESPONSIBLE FOR COORDINATING, PROVIDING AND INSTALLING PEMB WALL AND ROOF INSULATION UNLESS PREVIOUS COORDINATION HAS BEEN MADE WITH METAL BUILDING MANUFACTURER TO PROVIDE AND INSTALL. SEE SHEET T3.0 FOR INSULATION REQUIREMENTS.

FOUNDATION INSULATION:
PROVIDE CONTINUOUS PERIMETER FOUNDATION INSULATION WITH PROTECTION BOARD OR COATING. SEE INSULATION NOTE SHEET T3.0 FOR SPECIFICATIONS. INSULATION SHALL BE PLACED ON THE OUTSIDE OF THE SLAB / FOUNDATION WALL AND SHALL EXTEND FROM THE TOP OF THE SLAB FOR A MINIMUM OF 24" OR TO THE TOP OF THE FOOTING, WHICHEVER IS LESS.


GIRT BRACING NOTE:
WHERE CALLED FOR ON METAL BUILDING DRAWINGS CONTRACTOR SHALL INSTALL 24 GAUGE STRAPPING OVER GIRTS (PROVIDED BY METAL BUILDING MANUF.)



6405 W. WILKINSON BLVD, STE. 100
BELMONT, NC 28012
704.342.1686
HELTDDESIGN.COM
INFO@HELTDDESIGN.COM
PROJECT NAME:

HARBOR FREIGHT TOOLS
FOR STOCKS & TAYLOR CONSTRUCTION

PROJECT NO: 23174
PROJECT ADDRESS:
46 SHRIJI LANE
ERWIN, NC 28339

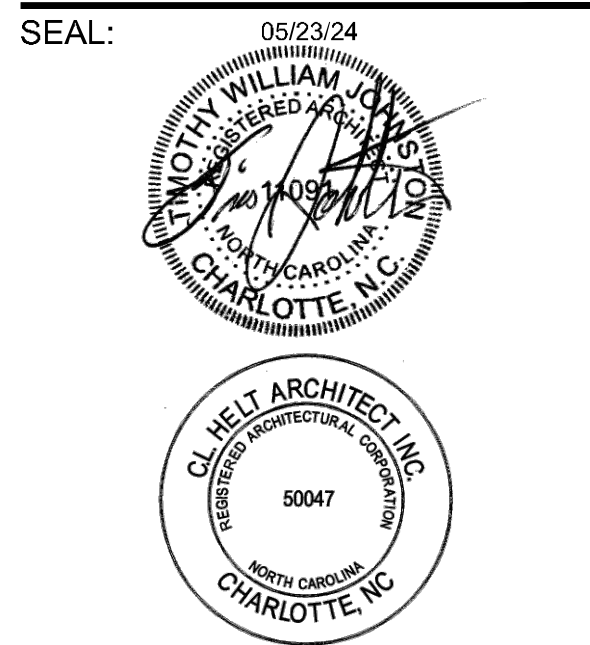

CORPORATE ENTITY:
C.L. HELT, ARCHITECT, INC. A NORTH CAROLINA PROFESSIONAL CORPORATION DBA HELT DESIGN.



COPYRIGHT:
THIS DRAWING AND ITS COPIES ARE THE ARCHITECT'S INSTRUMENTS OF SERVICE. THEY RETAIN ALL COMMON LAW AND STATUTORY RIGHTS, INCLUDING COPYRIGHT. THEY SHALL NOT BE USED OR COPIED FOR ANY PROJECT OTHER THAN THE ONE TITLED HERE IN.

DRAWING RELEASE:


NO.	DATE	DESCRIPTION
△	05/23/24	HFT REVIEW COMMENTS

DRAWN BY: ME
CHECKED BY: JZ
DATE: 04/19/24


SHEET TITLE:
WALL SECTIONS
SHEET NUMBER:
A4.0

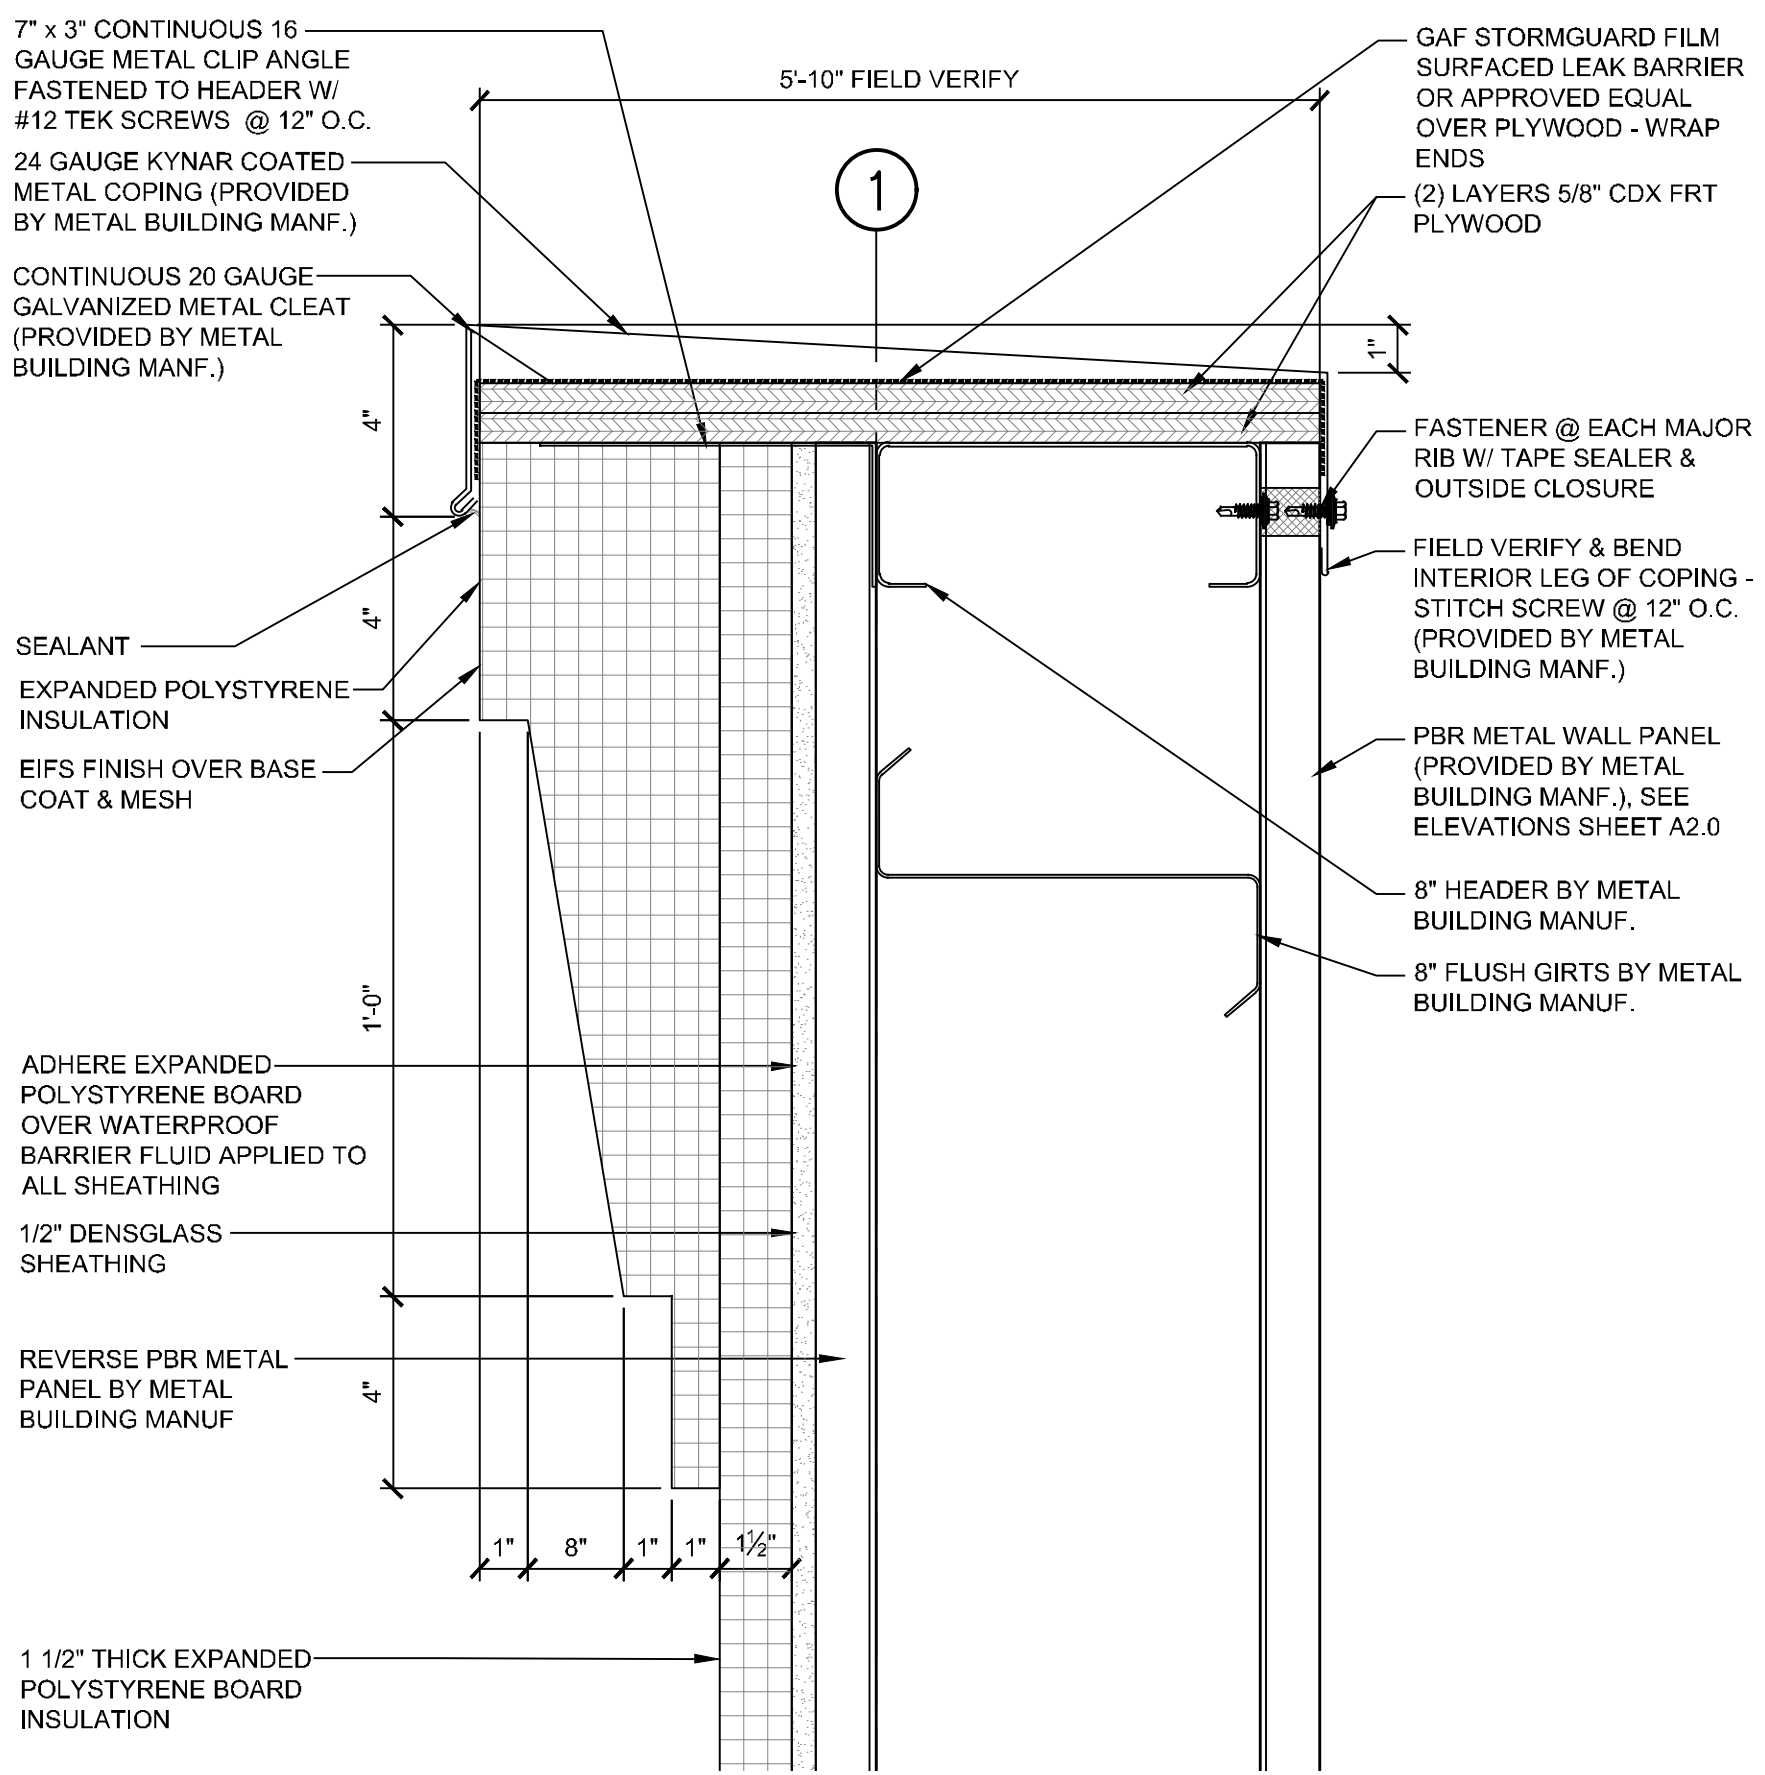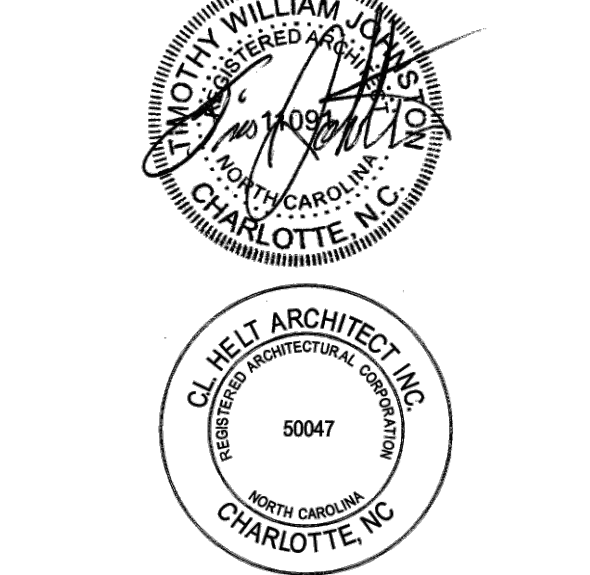


1 SECTION DETAIL
SCALE: 3/8"=1'-0"

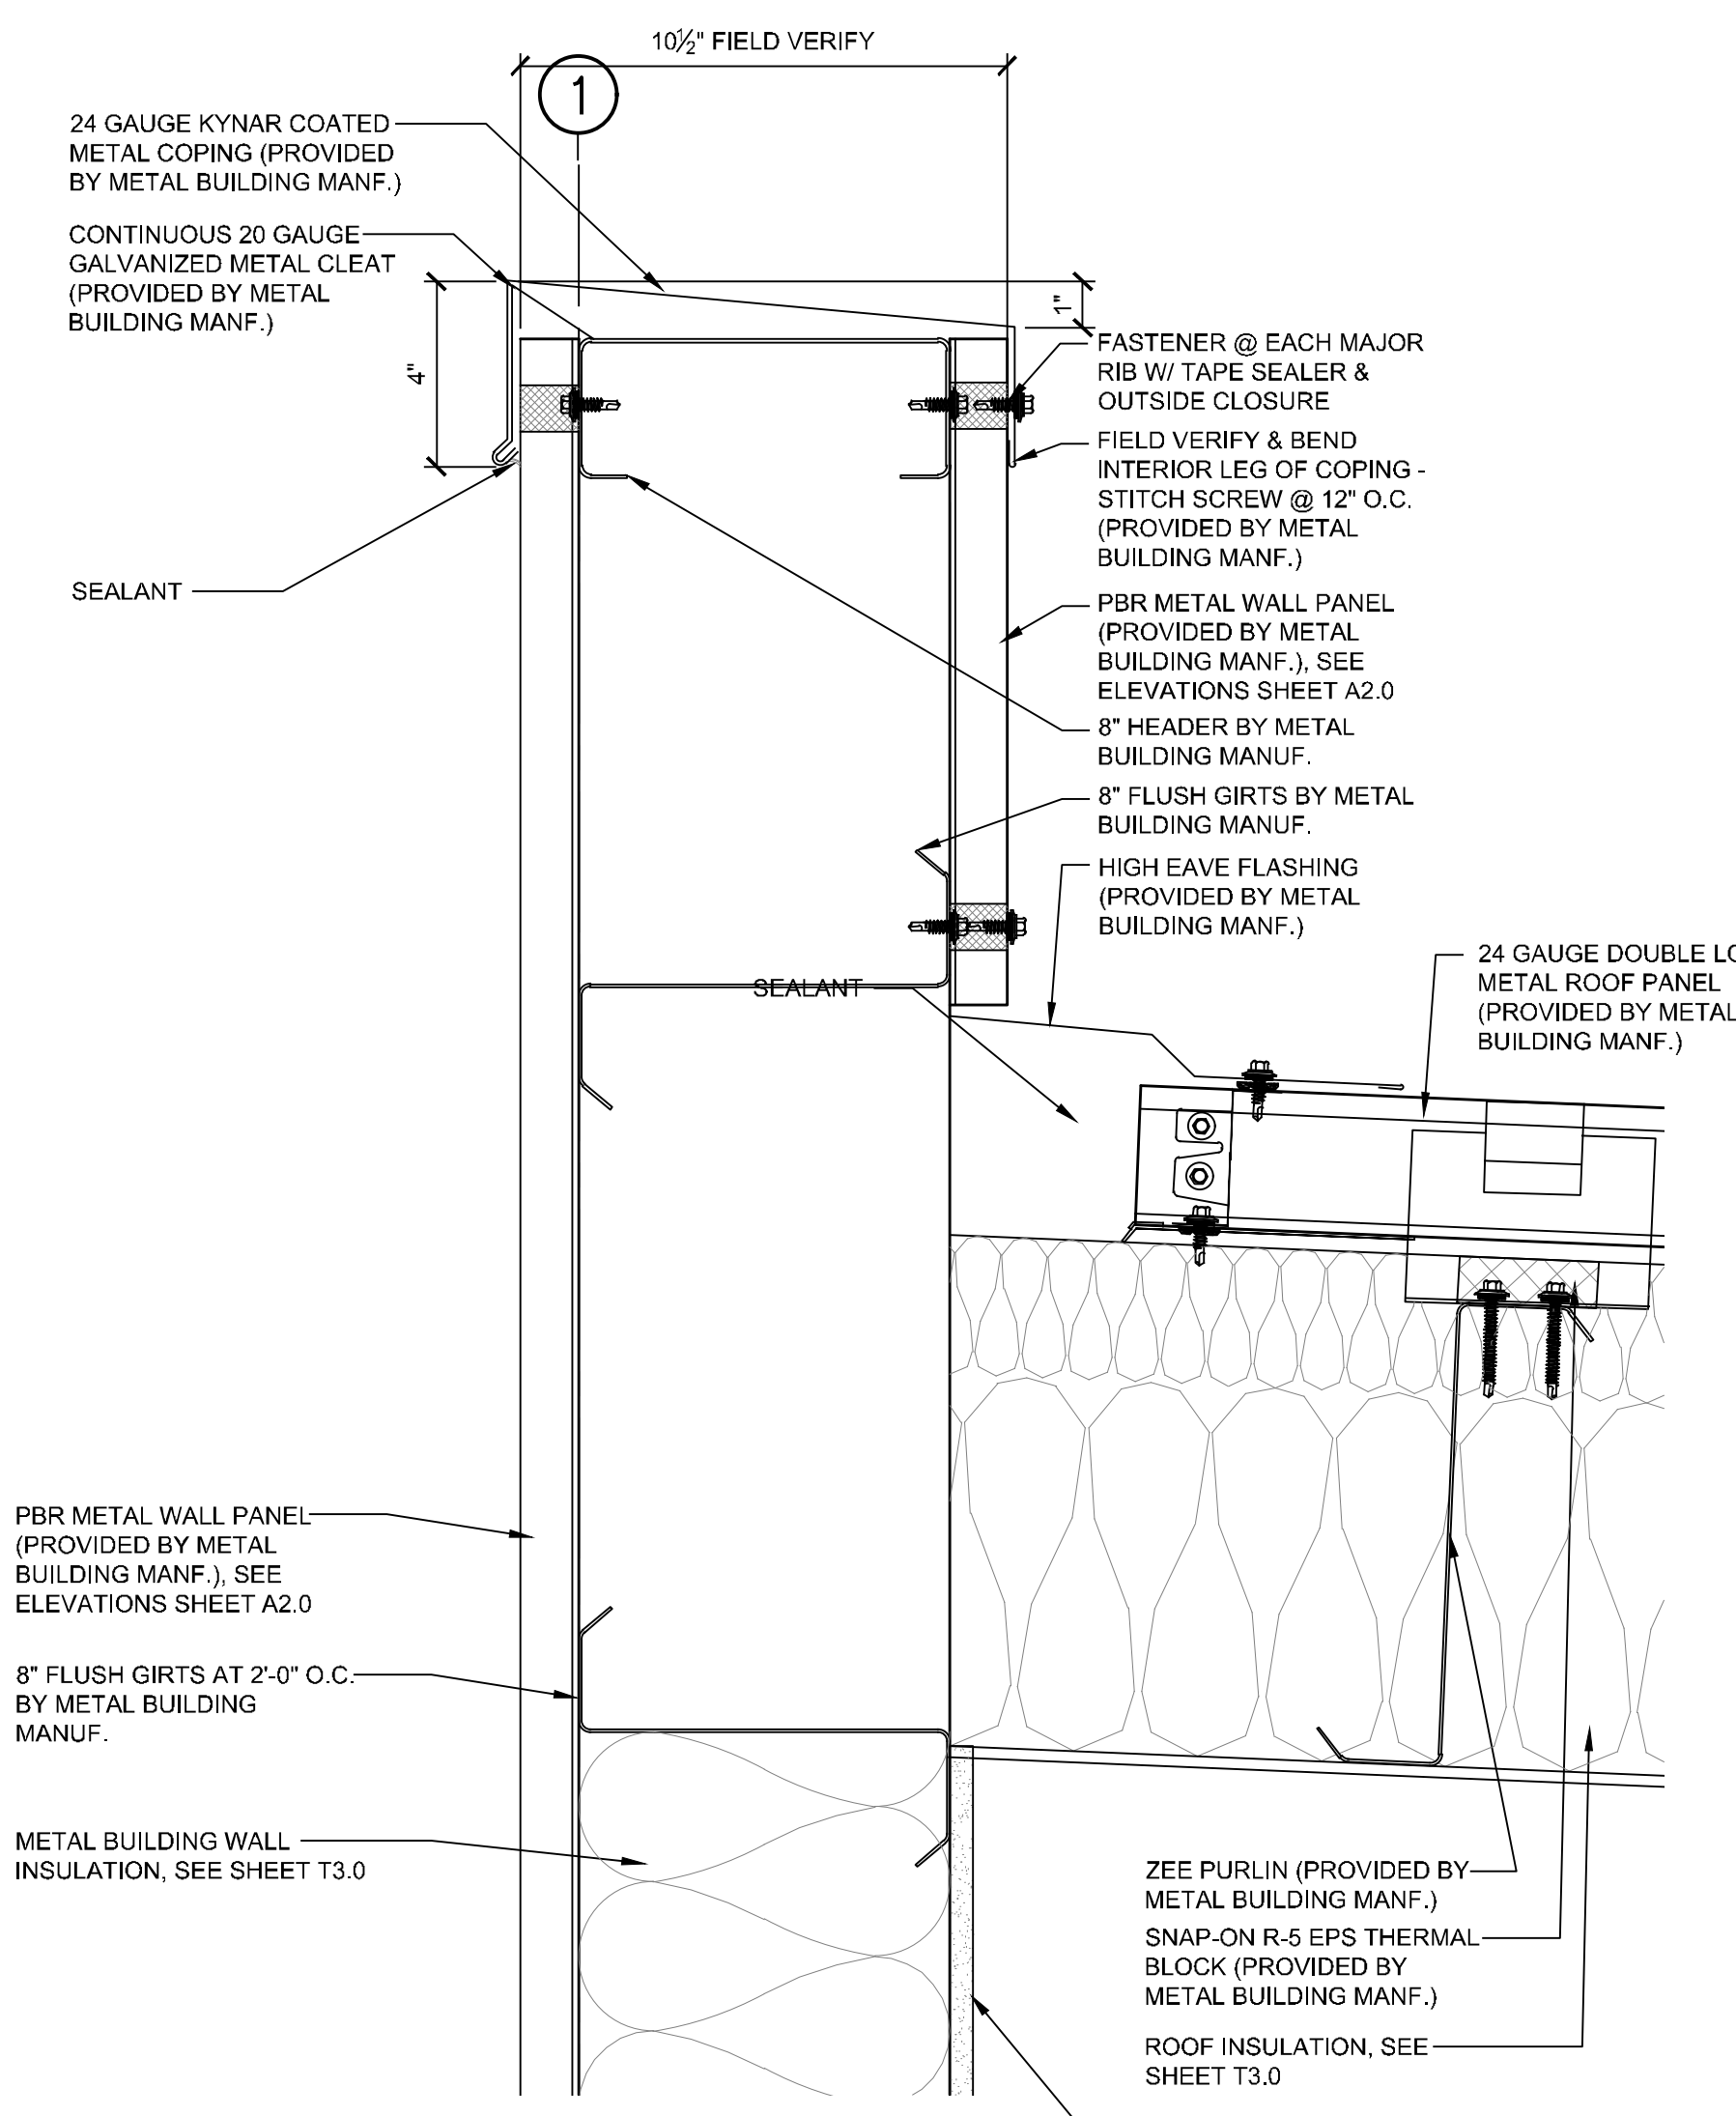

2 SECTION DETAIL
SCALE: 3/8"=1'-0"

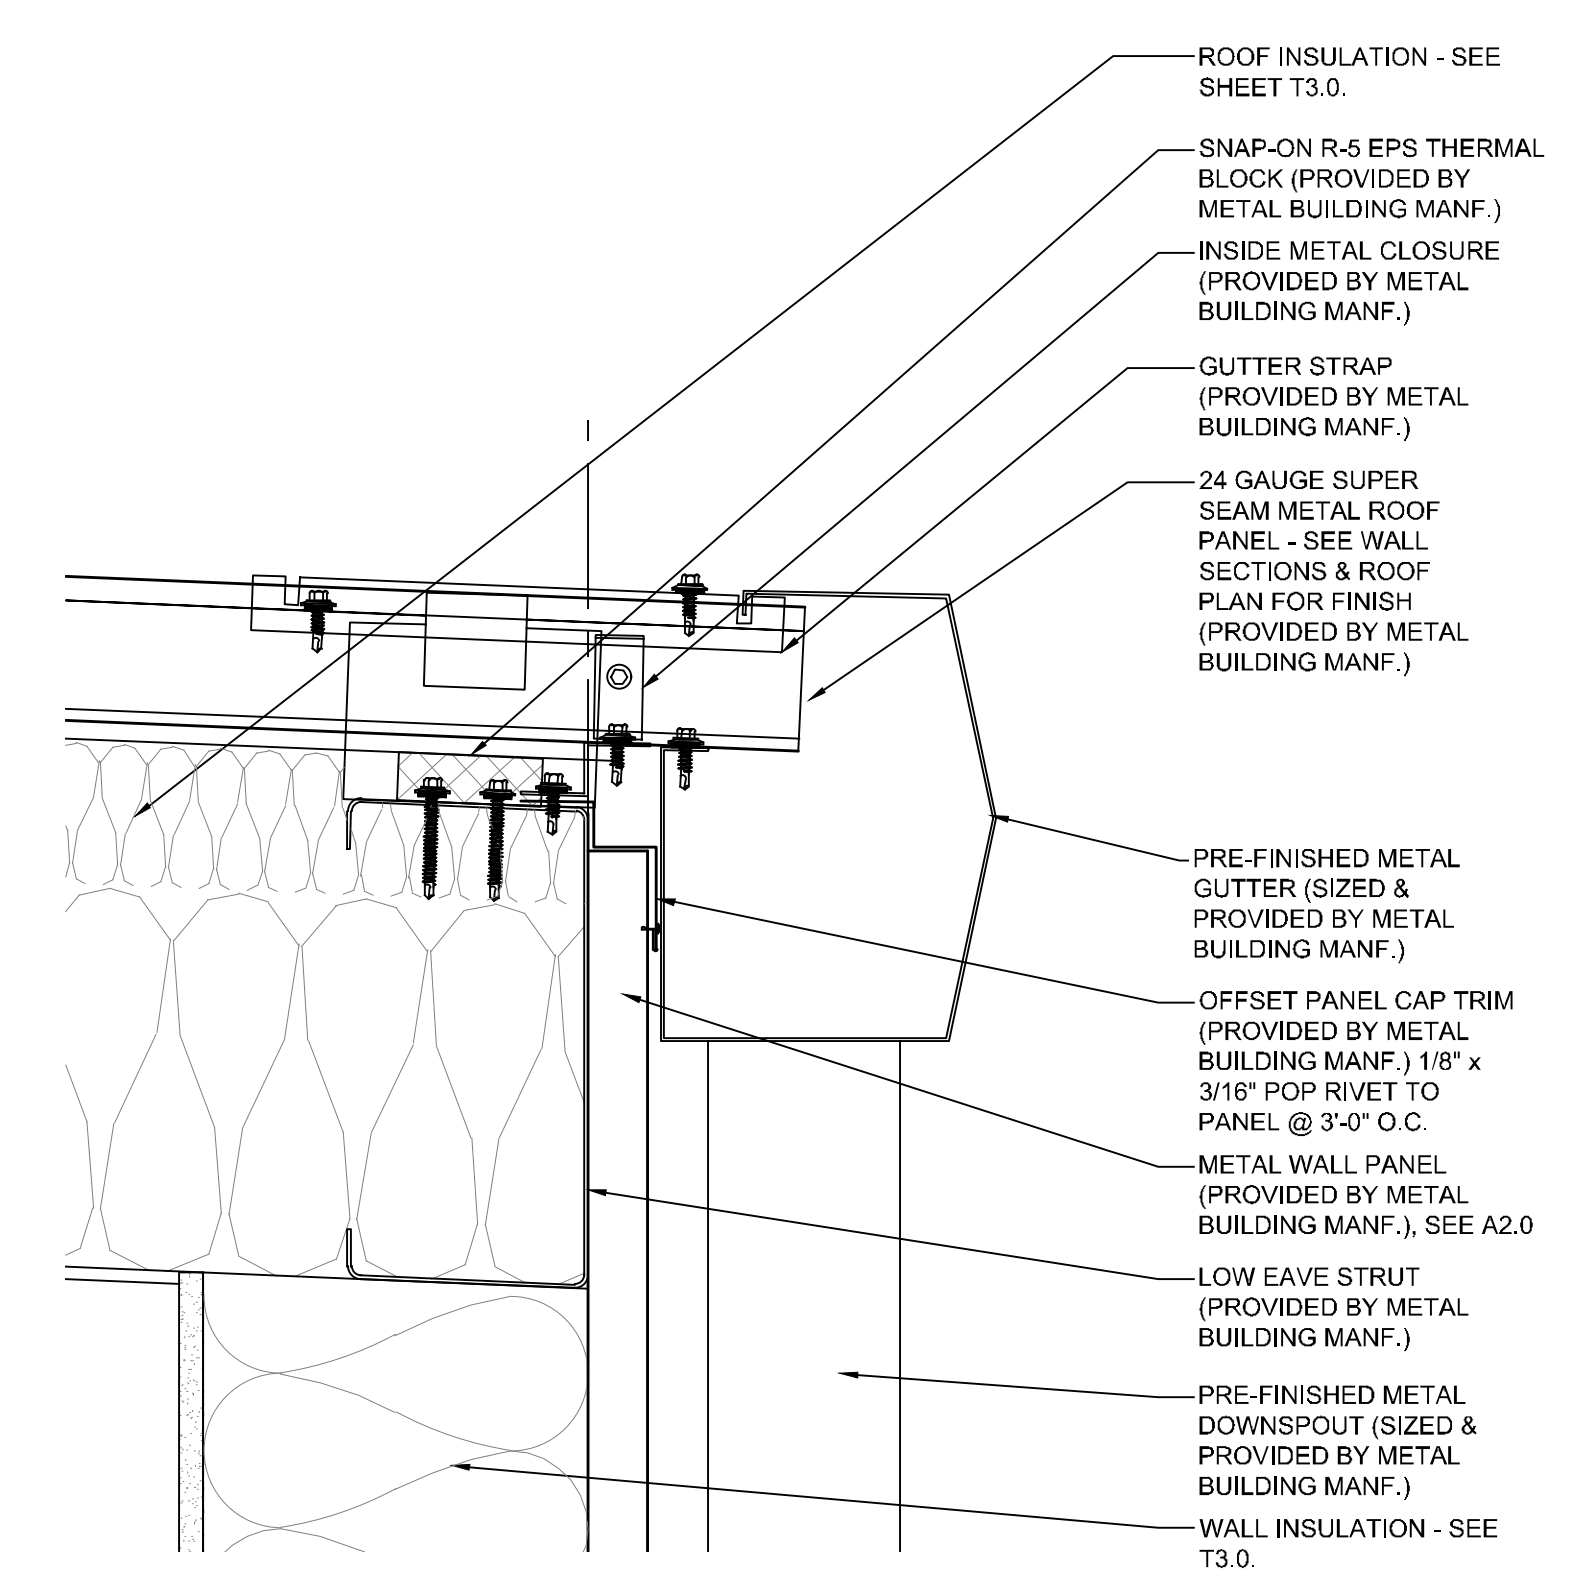

3 SECTION DETAIL
SCALE: 3/8"=1'-0"

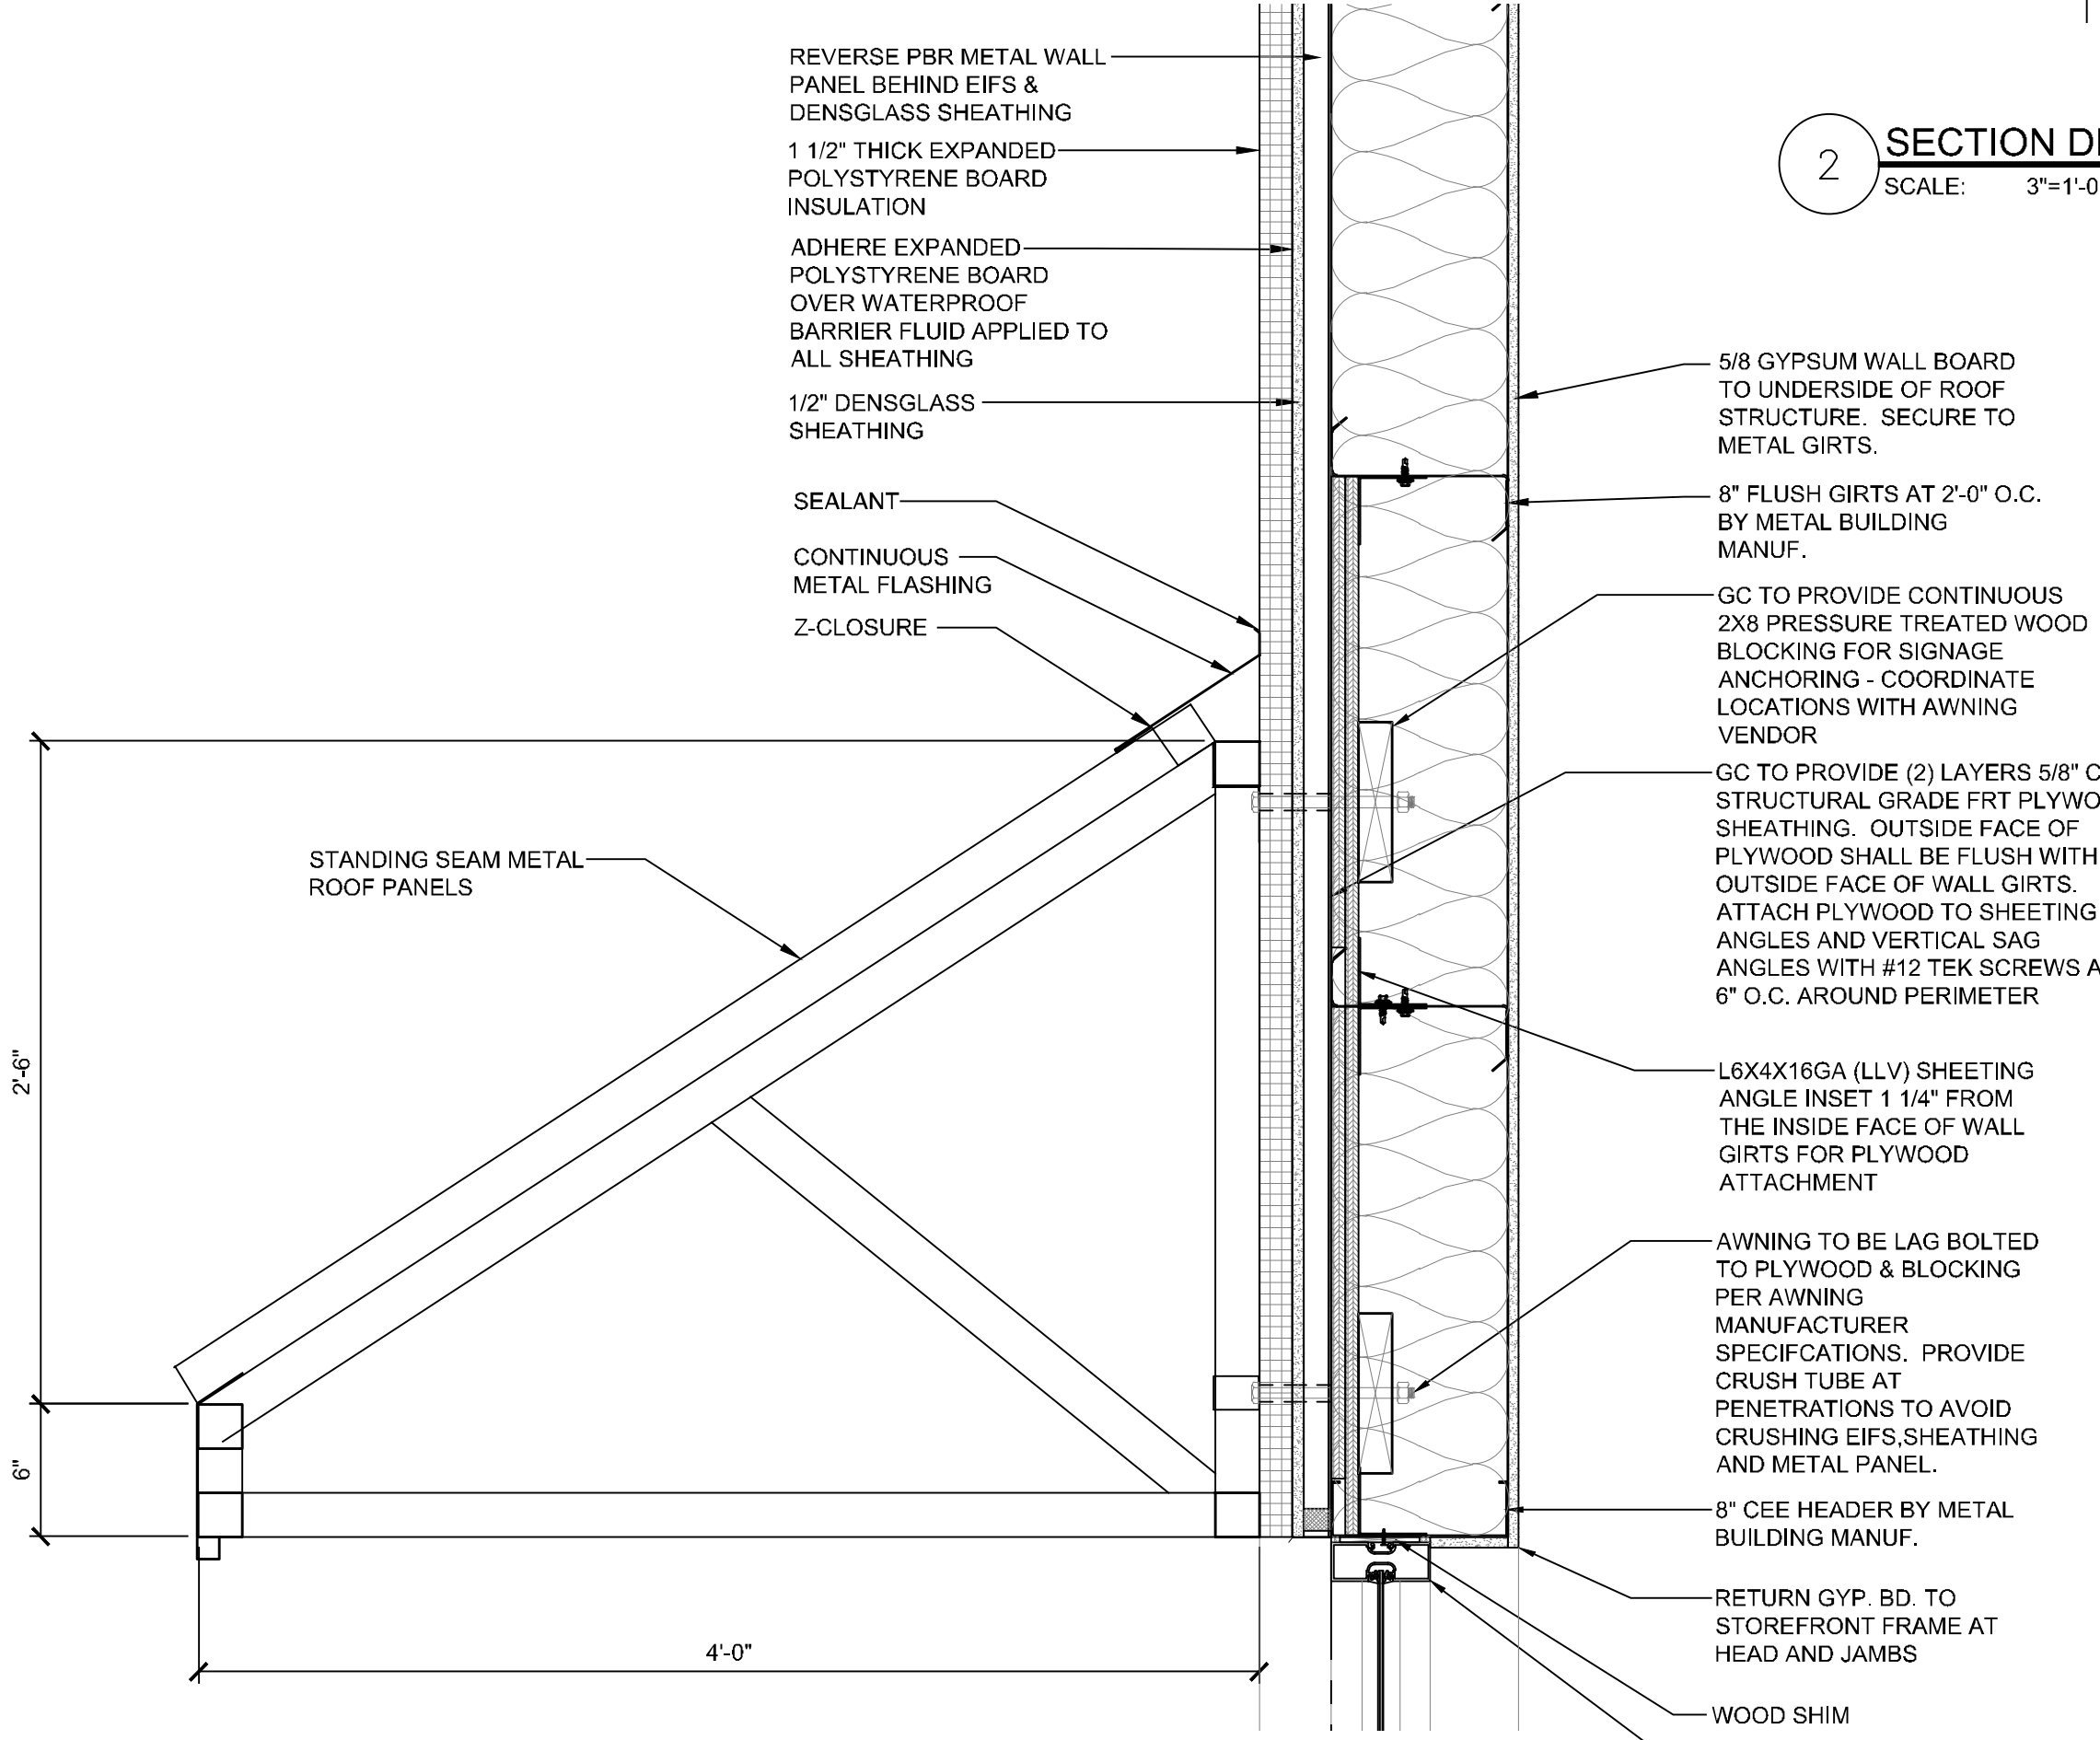


G.C. SHALL CONTRACT WITH AWNING VENDOR TO ENGINEER, FABRICATE AND INSTALL STANDING SEAM METAL CANOPY IN ACCORDANCE WITH THE 2018 NCSBC SECTION 3105.

4 SECTION DETAIL
SCALE: 3/8"=1'-0"

ULTIMATE WIND SPEED (MPH)	PIER DIAMETER (IN)	PIER DEPTH (FT)	VERTICAL REINFORCING BARS	HORIZONTAL TIES
-115	2'-0"	5'-6"	(6) #5	#3 @ 12" O.C.
120	2'-0"	5'-9"	(6) #5	#3 @ 12" O.C.
-130	2'-0"	6'-0"	(6) #5	#3 @ 12" O.C.
-140	2'-0"	7'-0"	(6) #5	#3 @ 12" O.C.
-150	2'-0"	7'-3"	(8) #5	#3 @ 12" O.C.
-160	2'-0"	7'-6"	(8) #5	#3 @ 12" O.C.

← THIS PROJECT

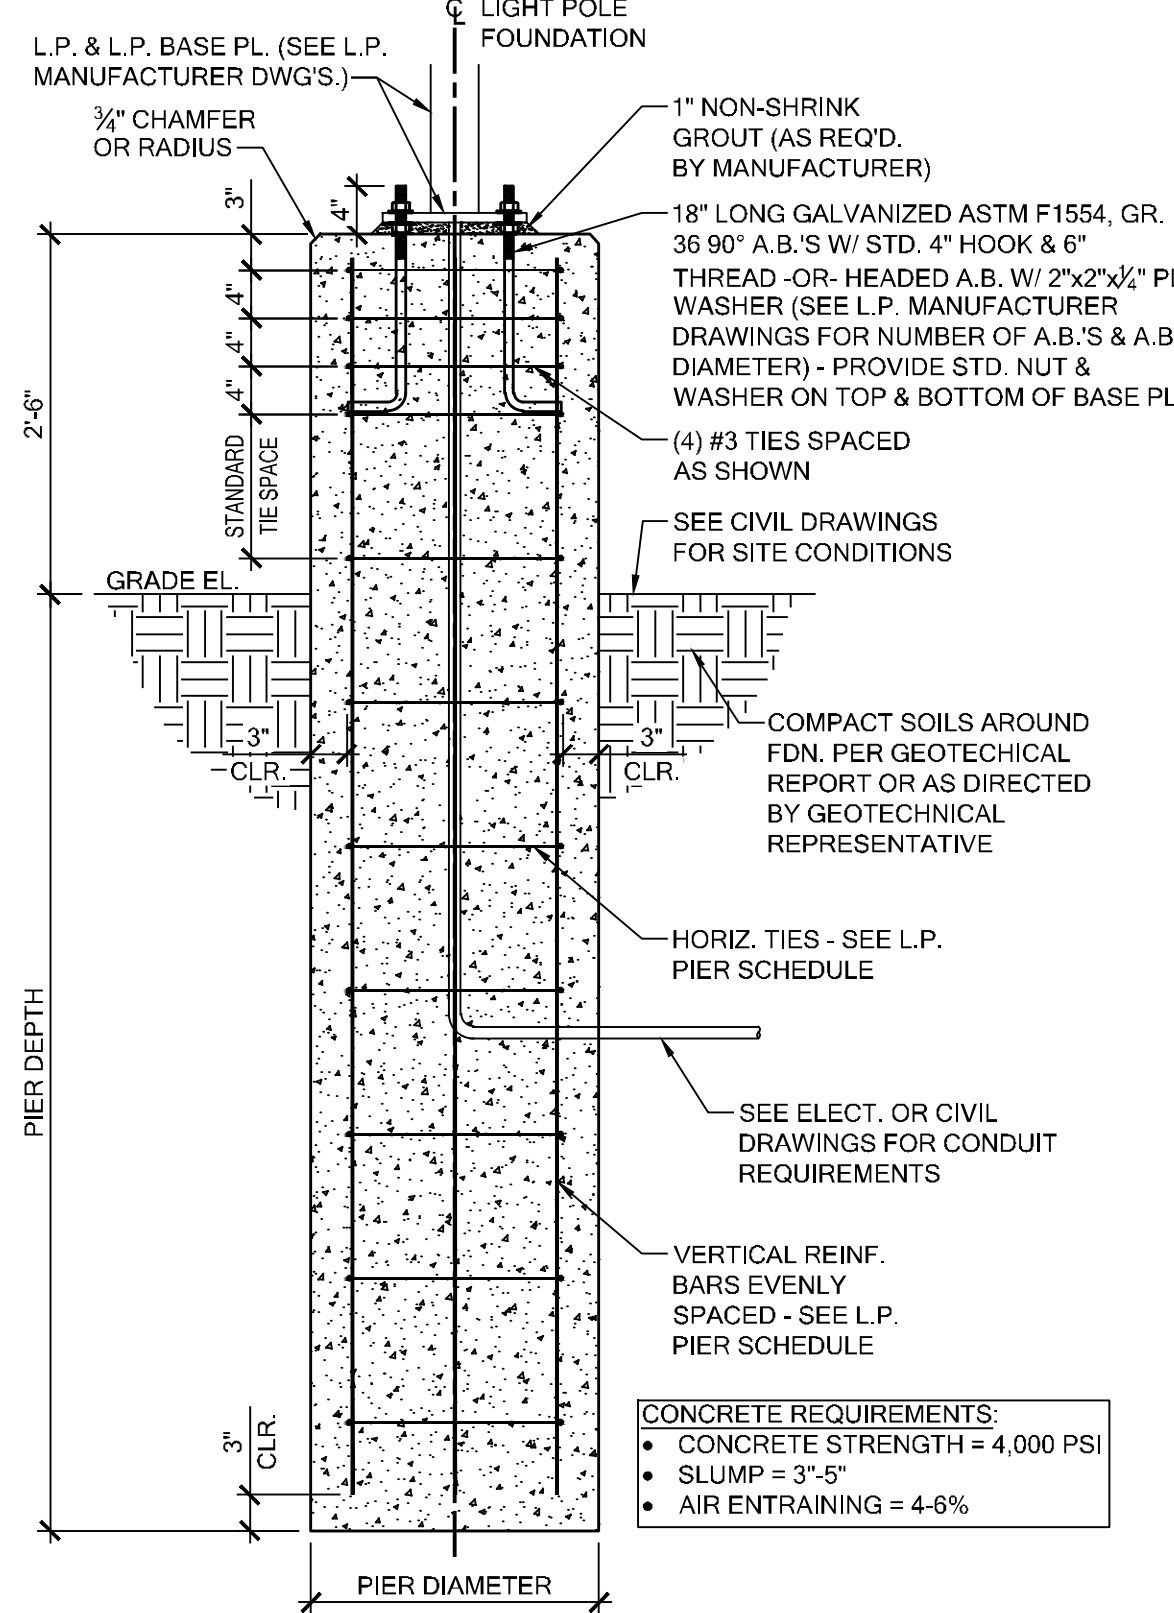

5 LIGHT POLE BASE DETAIL
SCALE: 3/4"=1'-0"

GENERAL STRUCTURAL NOTES:

- THE GENERAL STRUCTURAL NOTES ARE INTENDED TO AUGMENT THE DRAWINGS AND SPECIFICATIONS. SHOULD CONFLICTS EXIST BETWEEN THE DRAWINGS AND SPECIFICATIONS AND THE GENERAL STRUCTURAL NOTES, THE STRICTEST PROVISION SHALL GOVERN.
- GOVERNING CODE: 2018 NORTH CAROLINA BUILDING CODE
- DESIGN WIND SPEED: 120 MPH (ASCE7-16)
EXPOSURE CLASSIFICATION: C
RISK CATEGORY: II
ROOF LIVE LOAD: 20 PSF
ASSUMED COLLATERAL LOAD: 5 PSF
GROUND SNOW LOAD: 10 PSF
- SEISMIC DESIGN VALUES:
(SEE METAL BUILDING DRAWINGS)
- MECHANICAL FRAMING LOADS, OPENINGS, AND STRUCTURE IN ANY WAY RELATED TO MECHANICAL REQUIREMENTS ARE SHOWN FOR BIDDING PURPOSES ONLY. CONTRACTOR SHALL OBTAIN APPROVAL OF MECHANICAL AND OTHER TRADES BEFORE PROCEEDING WITH SUCH PORTION OF THE WORK. EXCESS COST RELATED TO VARIATION IN MECHANICAL REQUIREMENTS TO BE BORNE BY MECHANICAL CONTRACTOR.
- THE STRUCTURE IS DESIGNED TO BE SELF-SUPPORTING AND STABLE AFTER THE BUILDING IS FULLY COMPLETED. IT IS SOLELY THE CONTRACTOR'S RESPONSIBILITY TO DETERMINE ERECTION PROCEDURE AND SEQUENCE, AND TO INSURE THE SAFETY OF THE BUILDING AND ITS COMPONENT PARTS DURING ERECTION. THIS INCLUDES THE ADDITION OF WHATEVER TEMPORARY BRACING, GUYS, OR TIE-DOWNS WHICH MIGHT BE NECESSARY. SUCH MATERIAL SHALL REMAIN THE CONTRACTOR'S PROPERTY AFTER THE COMPLETION OF THE PROJECT.
- IT IS SOLELY THE CONTRACTOR'S RESPONSIBILITY TO FOLLOW ALL APPLICABLE SAFETY CODES AND REGULATIONS DURING ALL PHASES OF CONSTRUCTION.
- THE CONTRACTOR IS RESPONSIBLE FOR VERIFYING ALL DIMENSIONS AND CONDITIONS RELATING TO EXISTING CONSTRUCTION AND EXISTING SERVICE ON THE SITE.
- THE CONTRACTOR SHALL VERIFY ALL DIMENSIONS AND LOCATIONS OF COLUMNS, WALLS, OPENINGS, ETC. WITH THE ARCHITECTURAL DRAWINGS PRIOR TO PROCEEDING WITH THE WORK.
- ALL SITE PREPARATION FOR BUILDING FOUNDATIONS AND SLABS SHALL BE IN ACCORDANCE WITH THE DETAILS INDICATED ON THE CONTRACT DRAWINGS AND WITH THE RECOMMENDATIONS OF THE PROJECT REPORT OF GEOTECHNICAL INVESTIGATION.
- SHOP DRAWINGS SHALL BE SUBMITTED TO THE ARCHITECT FOR ALL STRUCTURAL COMPONENTS PRIOR TO FABRICATION. STRUCTURAL DRAWINGS SHALL NOT BE REPRODUCED FOR SHOP DRAWINGS OR ERECTION PLANS. SHOP DRAWINGS SHALL BE REVIEWED AND APPROVED BY THE CONTRACTOR FOR ALL DIMENSIONS, ELEVATIONS, AND ERECTION PROCEDURE PRIOR TO SUBMITTING TO ARCHITECT. PROVIDE AMPLE TIME FOR SHOP DRAWING REVIEW TO TAKE PLACE. REFER TO THE PROJECT SPECIFICATIONS FOR OTHER SUBMITTAL REQUIREMENTS.
- THE ENGINEER'S APPROVAL OF SHOP DRAWINGS SHALL NOT RELIEVE THE CONTRACTOR OF THE RESPONSIBILITY FOR DEVIATIONS, ERRORS, OR OMISSIONS FROM THE REQUIREMENTS OF THE CONTRACT DOCUMENTS.
- NO CONSTRUCTION LOADS THAT EXCEED THE SAFE LOAD CARRYING CAPACITY OF THE STRUCTURAL MEMBERS SHALL BE APPLIED TO THE STRUCTURE. NOTIFY STRUCTURAL ENGINEER AND ARCHITECT OF ANY UNUSUAL OR EXCESSIVE LOADS OCCURRING DURING CONSTRUCTION. DO NOT APPLY CONSTRUCTION LOADS UNTIL STRUCTURAL COMPONENTS ARE PROPERLY CONNECTED AND ALL NECESSARY TEMPORARY BRACING IS IN PLACE.
- WORK NOT INDICATED ON THE DRAWINGS BUT REASONABLY IMPLIED TO BE SIMILAR TO THAT AT SIMILAR LOCATIONS SHALL BE REPEATED. UNLESS OTHERWISE NOTED, ALL SECTIONS AND DETAILS SHOWN ON THESE DRAWINGS ARE TYPICAL AT SIMILAR LOCATIONS AND CONDITIONS.

FOUNDATION & GEOTECHNICAL NOTES:

- THE FOUNDATION HAS BEEN DESIGNED IN ACCORDANCE WITH THE RECOMMENDATIONS MADE IN "GEOTECHNICAL ENGINEERING REPORT" PREPARED BY TERRACON, DATED MARCH 7, 2024.
- PREPARE FOUNDATION SUBSTRATE IN ACCORDANCE WITH WRITTEN RECOMMENDATIONS OF "GEOTECHNICAL ENGINEERING REPORT".
- SPREAD FOOTINGS SHALL BEAR ON SOIL CAPABLE OF SUSTAINING A NET ALLOWABLE BEARING PRESSURE OF 1.5 KSF FOR INDIVIDUAL COLUMN FOOTING AND 1.5 KSF FOR CONTINUOUS WALL FOOTING UNDER FULL SERVICE LIVE AND DEAD LOAD.
- FOOTINGS SHALL BE POURED INTO AN EARTH-FORMED TRENCH IT SOIL CONDITIONS PERMIT.
- BOTTOM OF ALL EXTERIOR FOOTINGS SHALL BEAR A MINIMUM OF 12" BELOW FINAL GRADE OR TO A DEPTH BELOW THE LOCAL FROST DEPTH. CONTRACTOR SHALL VERIFY THE LOCAL FROST DEPTH AND NOTIFY THE E.O.R. OF ANY DISCREPANCIES.
- FOUNDATION WALLS THAT RETAIN EARTH SHALL BE BRACED AGAINST BACKFILLING PRESSURES UNTIL FLOOR SLABS AT TOP AND BOTTOM ARE IN PLACE.
- WHERE FOUNDATION WALLS ARE TO HAVE EARTH PLACED ON EACH SIDE, PLACE FILL SIMULTANEOUSLY SO AS TO MAINTAIN A COMMON ELEVATION ON EACH SIDE OF THE WALL.
- COMPACT BACKFILL IN ACCORDANCE WITH "GEOTECHNICAL ENGINEERING REPORT".
- PERFORM DENSITY AND MOISTURE CONTENT TESTS OF COMPACTED FILL MATERIALS IN ACCORDANCE WITH ASTM D2992 AND ASTM D3017, AS REQUIRED BY GEOTECHNICAL ENGINEER.
- FOOTINGS SHALL EXTEND DOWN TO A LOWER ELEVATION THAN INDICATED ON THE DRAWINGS IF NECESSARY TO REACH ADEQUATE BEARING MATERIAL.
- SLOPE SIDES OF EXCAVATIONS, OR SHORE, SHEET, AND BRACE SIDE SLOPES TO ENSURE SLOPE STABILITY AND SAFETY. ADEQUATELY PROTECT ALL EXCAVATION SLOPES.
- REMOVE ALL MATERIAL CONTAINING ROOTS, DEBRIS OR OTHER DELETERIOUS MATERIAL FROM THE SITE.
- PROVIDE ADEQUATE DRAINAGE OR DEWATERING TO ALLOW PROPER FINISHING OF EXCAVATIONS AND TO KEEP WATER FROM COLLECTING IN THE BOTTOM OF EXCAVATIONS. FOUNDATIONS SHALL BE PLACED IN THE DRY. DO NOT PLACE FOOTINGS IN WATER.
- PROVIDE NOTICE AND ALLOW SUFFICIENT TIME FOR FOOTING EXCAVATIONS TO BE INSPECTED BY THE GEOTECHNICAL ENGINEER PRIOR TO POURING CONCRETE.

CONCRETE NOTES:

- SPECIFICATIONS AND STANDARDS:
UNLESS SPECIFICALLY SHOWN OTHERWISE ALL CONCRETE WORK, DETAILS, FABRICATION, AND PLACEMENT OF BARS AND CONCRETE SHALL BE GOVERNED BY THE LATEST REVISIONS OF:
A. ACI 301, ACI 315, AND ACI 318
B. CRSI RECOMMENDED PRACTICE FOR PLACING REINFORCEMENT BARS
C. ACI 306 AND ACI 305 FOR WINTER AND HOT WEATHER CONCRETE RESPECTIVELY.
THE CONTRACTOR SHALL AT ALL TIMES HAVE A COPY OF THE RELEVANT SPECIFICATIONS QUOTED ABOVE ON THE SITE AND THE SUPERVISORY PERSONNEL SHALL BE THOROUGHLY FAMILIAR WITH THE CONTENTS THEREOF.
- CONCRETE REQUIREMENTS AND LOCATION IN JOB:
CEMENT SHALL BE TYPE I PORTLAND CEMENT, ASTM C-150.

CLASS	LOCATION	F _c	REQUIREMENTS
I	FOOTINGS	3000 PSI	3" TO 5" SLUMP
II	INTERIOR SLAB	4000 PSI	3" TO 5" SLUMP (SEE HFT SPECIFICATIONS FOR ADDITIONAL REQUIREMENTS)
III	EXTERIOR CONCRETE	3500 PSI	5% +/- 1% ENT. AIR (3" TO 5" SLUMP)
IV	MASONRY GROUT	3500 PSI	8" TO 10" SLUMP PEA GRAVEL MIX
- REINFORCING STEEL SHALL BE ASTM-615, GRADE 60. WELDED WIRE FABRIC SHALL CONFORM TO ASTM A-185.
- UNLESS OTHERWISE DETAILED, SPLICES SHALL BE IN ACCORDANCE WITH ACI 318 LATEST EDITION.
- WHERE CONCRETE IS CAST AGAINST EARTH, REINFORCING STEEL SHALL HAVE A MINIMUM CONCRETE COVER OF 3". WHEN FORMED BUT EXPOSED TO EARTH OR WEATHER, REINFORCING STEEL SHALL HAVE A MINIMUM CONCRETE COVER OF 1 1/2" FOR #5 BARS OR SMALLER AND 2" FIR BARS LARGER THAN #5. IN ALL OTHER CONDITIONS PROVIDE 1" COVER UNLESS NOTED OTHERWISE ON DRAWINGS.
- EMBEDS SHALL BE IN PLACE BEFORE PLACING CONCRETE.
- ALL EXTERIOR CORNERS ON EXPOSED CONCRETE, EXCEPT COLUMNS, SHALL HAVE 3/4" 45 DEG. CHAMFERS. CORNERS ON COLUMNS SHALL HAVE 1" 45" CHAMFERS, UNLESS NOTED.
- UNDER NO CIRCUMSTANCES SHALL FORMS BE LEFT IN PLACE PERMANENTLY.
- ALL EMBEDDED ITEMS (EXCEPT REINFORCING STEEL & ANCHOR BOLTS) SHALL BE GALVANIZED.
- SEE HFT STANDARDS FOR JOINT FILLER/SEALANT SPECIFICATIONS. FOLLOW ALL MANUFACTURER'S RECOMMENDATIONS FOR SURFACE PREPARATION AND INSTALLATION OF JOINT FILLER/SEALANT.
- EPOXY FOR SETTING DOWELS AND ANCHOR RODS INTO EXISTING CONCRETE SHALL BE A TWO COMPONENT STRUCTURAL EPOXY INJECTION GEL SUCH AS "POWER-FAST" AS MANUFACTURED BY POWERS RAWL. INSTALLATION SHALL BE ACCOMPLISHED IN ACCORDANCE WITH ALL MANUFACTURER'S SPECIFICATIONS.
- ROUGHEN CONCRETE AT FOOTINGS BEFORE POURING PIERS, PADS, OR WALLS, IN ACCORDANCE WITH ACI-318, CHAPTER 11.
- PROVIDE (2) #4 BARS x 4'-0" LONG IN CONCRETE SLABS AND MATS AT ALL RE-ENTRANT CORNERS.
- DO NOT INSTALL REENTRANT CORNER BARS OR HAIRPINS ACROSS CONTROL JOINTS. ROTATE BARS OR SHORTEN BARS AS REQUIRED TO AVOID CONTROL JOINT. NOTIFY ARCHITECT E.O.R. OF ANY MODIFICATION TO REENTRANT BARS AND HAIRPINS THAT IS NOT SHOWN ON THESE DRAWINGS.
- REINFORCEMENT SHALL BE ADEQUATELY SUPPORTED AND TIED IN PLACE PRIOR TO CONCRETE PLACEMENT. PROVIDE ANY STANDEES, BOLSTERS, CARRYING BARS, OR ADDITIONAL BARS AS MAY BE NECESSARY TO ADEQUATELY SUPPORT THE REINFORCEMENT IN ITS PROPER POSITION.
- UNLESS NOTED OTHERWISE ON THE DRAWINGS, DOWELS SHALL MATCH CORRESPONDING VERTICAL REINFORCEMENT.
- FILL ALL PLUMBING SLOTS WITH CONCRETE TO THE SAME DEPTH AS THE FLOOR SLAB AFTER PIPING IS INSTALLED.
- ALL SAW CUTTING OF CONTROL JOINTS SHALL BE ACCOMPLISHED WITH A "SOFF-CUT" SAW AND VACUUM SYSTEM EQUIPPED WITH A NEW BLADE AND PLATE, AS SOON AS THE SLAB WILL SUPPORT THE WEIGHT OF THE SAW AND OPERATOR.
- LAP WELDED WIRE FABRIC A MINIMUM OF 12".
- REFER TO ARCHITECTURAL AND HFT SPECIFICATIONS FOR FINISHING OF CONCRETE SLAB.
- CONFIRM THERE IS NO SLAG OR FLY ASH IN THE MIX - THESE MATERIALS WILL AFFECT THE POLISHING PROCESS.
- SEE HFT SPECIFICATIONS FOR PROPER CONCRETE CURING MATERIALS AND PROCEDURES.
- USE ONE SOURCE FOR CEMENT, AGGREGATES, AND POZZOLANS THROUGHOUT THE JOB. MONITOR AND CONTROL INCOMING MATERIAL CONSISTENCY. DO NOT USE CALCIUM CHLORIDE-BASED ADMIXTURES. NON-CHLORIDE ADMIXTURES MAY BE USED.
- WASH OUT ALL DRUMS BEFORE LOADING. KEEP SLUMPS CONSISTENT WITH A MAXIMUM OF 5. MINIMIZE DRIVER ADDED WATER MAINTAINING A MAXIMUM 0.53 WATER CONTENT RATIO.
- PLACE CONCRETE TO ACHIEVE AS TRUE AND SMOOTH A TOP SURFACE AS POSSIBLE. MOUNDS OR DIPS ARE NOT ACCEPTABLE. GO SHALL CONTROL OVERALL FLATNESS AND LEVELNESS, INCLUDING ON SLOPING AREAS TO WITHIN TOLERANCES PERMITTED BY SPECIFICATION - ASTM E1155.

FLATNESS / LEVELNESS REQUIREMENTS
 FLOOR FLATNESS (FF) = MIN. 35
 FLOOR LEVELNESS (FL) = MIN. 30

PRE-ENGINEERED METAL BUILDING

- THE CONTRACTOR IS RESPONSIBLE FOR THE DESIGN, COORDINATION, FABRICATION, AND ERECTION OF THE PRE-ENGINEERED METAL BUILDING SUPERSTRUCTURE INCLUDING COLUMN BASE PLATES AND ANCHORAGE. THE CONTRACTOR SHALL SUBMIT SHOP DRAWINGS DETAILING ASPECTS OF THE METAL BUILDING CONSTRUCTION AND DESIGN CALCULATIONS FOR REVIEW PRIOR TO FABRICATION. SHOP DRAWINGS AND CALCULATIONS SHALL BEAR THE SEAL AND SIGNATURE OF A PROFESSIONAL ENGINEER REGISTERED IN THE STATE OF THE PROJECT.
- SHOP DRAWING REVIEW IS FOR CONFORMANCE TO DESIGN INTENT ONLY. THE ARCHITECT AND STRUCTURAL ENGINEER ASSUME NO RESPONSIBILITY FOR THE DESIGN OF THE METAL BUILDING SUPERSTRUCTURE AS A RESULT OF SHOP DRAWING REVIEW.
- G.C. TO COORDINATE THE INTEGRATION OF THE METAL BUILDING COMPONENTS WITH THE ARCHITECTURAL FOUNDATION REQUIREMENTS. DEVIATIONS TO BE COORDINATED BEFORE ERECTION COMMENCES.
- MECHANICAL DUCTS, PIPES AND EQUIPMENT ARE SUPPORTED BY THE ROOF GIRDERS AND PURLINS. THE ROOF GIRDERS, PURLINS, AND ANY AUXILIARY COMPONENTS SHALL BE DESIGNED TO SUPPORT SUCH LOADS. ALL INFORMATION (WEIGHTS AND LOCATIONS) PERTAINING TO MECHANICAL EQUIPMENT SUSPENDED FROM THE BUILDING ROOF SHALL BE SUBMITTED TO THE PRE-ENGINEERED METAL BUILDING ENGINEER FOR APPROVAL.
- DESIGN LOADS FOR PRE-ENGINEERED METAL BUILDING SHALL BE IN ACCORDANCE WITH LOCAL CODES AND DESIGN CONDITIONS. G.C. TO VERIFY LOADS WITH LOCAL BUILDING OFFICIALS AND GEOTECHNICAL REPORTS.



HELT

DESIGN

ARCHITECTURE INTERIORS

6405 W. WILKINSON
BLVD, STE. 100
BELMONT, NC 28012

704.342.1686
HELTDESIGN.COM
INFO@HELTDESIGN.COM
PROJECT NAME:

HARBOR FREIGHT TOOLS

FOR
STOCKS & TAYLOR
CONSTRUCTION

PROJECT NO: 23174

PROJECT ADDRESS:

46 SHRIJI LANE
ERWIN, NC 28339

SEAL:



CORPORATE ENTITY:
C.L. HELT, ARCHITECT, INC. A NORTH CAROLINA PROFESSIONAL CORPORATION
DBA HELT DESIGN.

COPYRIGHT:
THIS DRAWING AND ITS COPIES ARE THE ARCHITECT'S INSTRUMENTS OF SERVICE. THEY RETAIN ALL COMMON LAW AND STATUTORY RIGHTS, INCLUDING COPYRIGHT. THEY SHALL NOT BE USED OR COPIED FOR ANY PROJECT OTHER THAN THE ONE TITLED HERE IN.

DRAWING RELEASE:

NO.	DATE	DESCRIPTION

DRAWN BY: TMB CHECKED BY: TMB

DATE: 05/21/24

SHEET TITLE:
STRUCTURAL NOTES
SHEET

SHEET NUMBER:
S001

STATEMENT OF SPECIAL INSPECTIONS

REQUIRED SPECIAL INSPECTIONS AND TESTS OF SOILS				
TYPE	APPLICABLE TO THIS PROJECT	CONTINUOUS	PERIODIC	REFERENCED STANDARD
1. VERIFY MATERIALS BELOW SHALLOW FOUNDATIONS ARE ADEQUATE TO ACHIEVE THE DESIGN BEARING CAPACITY.	X	---	X	
2. VERIFY EXCAVATIONS ARE EXTENDED TO PROPER DEPTH AND HAVE REACHED PROPER MATERIAL.	X	---	X	
3. PERFORM CLASSIFICATION AND TESTING OF COMPACTED FILL MATERIALS.	X	X		
4. VERIFY USE OF PROPER MATERIALS, DENSITIES AND LIFT THICKNESSES DURING PLACEMENT AND COMPACTION OF COMPACTED FILL.	X	X		
5. PRIOR TO PLACEMENT OF COMPACTED FILL, INSPECT SUBGRADE AND VERIFY THAT SITE HAS BEEN PREPARED PROPERLY.	X	---	X	

REQUIRED SPECIAL INSPECTIONS AND TESTS OF CONCRETE CONSTRUCTION				
TYPE	APPLICABLE TO THIS PROJECT	CONTINUOUS	PERIODIC	REFERENCED STANDARD
1. INSPECT REINFORCEMENT, INCLUDING PRESTRESSING TENDONS, AND VERIFY PLACEMENT.	X	---	X	ACI 318: CH. 20, 25.2, 25.3, 26.6.1 - 26.6.3
2. REINFORCING BAR WELDING:				
a. VERIFY WELDABILITY OF REINFORCING BARS OTHER THAN ASTM A706.				AWS D1.4 ACI 318: 26.6.4
b. INSPECT SINGLE-PASS FILLET WELDS, MAXIMUM 1/16".				
c. INSPECT ALL OTHER WELDS.				
3. INSPECT ANCHORS CAST IN CONCRETE.	X	---	X	ACI 318: 17.8.2
4. INSPECT ANCHORS POST-INSTALLED IN HARDENED CONCRETE MEMBERS:	X	X	---	
a. ADHESIVE ANCHORS INSTALLED IN HORIZONTALLY OR UPWARDLY INCLINED ORIENTATIONS TO RESIST SUSTAINED TENSION LOADS.				ACI 318: 17.8.2.4 ACI 318: 17.8.2
b. MECHANICAL ANCHORS AND ADHESIVE ANCHORS NOT DEFINED IN 4.a.				
5. VERIFY USE OF REQUIRED DESIGN MIX.	X	---	X	ACI 318: CH. 19, 26.4.3, 26.4.4
6. PRIOR TO CONCRETE PLACEMENT, FABRICATE SPECIMENS FOR STRENGTH TESTS, PERFORM SLUMP AND AIR CONTENT TESTS, AND DETERMINE THE TEMPERATURE OF THE CONCRETE.	X	---	X	ASTM C172 ASTM C31 ACI 318: 26.5, 26.12
7. INSPECT CONCRETE AND SHOTCRETE PLACEMENT FOR PROPER APPLICATION TECHNIQUES.	X	---	X	ACI 318: 26.5
8. VERIFY MAINTENANCE OF SPECIFIED CURING TEMPERATURE AND TECHNIQUES.	X	---	X	ACI 318: 26.5.3 - 26.5.5
9. INSPECT PRESTRESSED CONCRETE FOR:				
a. APPLICATION OF PRESTRESSING FORCES; AND				ACI 318: 26.10
b. GROUTING OF BONDED PRESTRESSING TENDONS.				
10. INSPECT ERECTION OF PRECAST CONCRETE MEMBERS.				ACI 318: 26.9
11. VERIFY IN-SITU CONCRETE STRENGTH, PRIOR TO STRESSING OF TENDONS IN POST-TENSIONED CONCRETE AND PRIOR TO REMOVAL OF SHORES AND FORMS FROM BEAMS AND STRUCTURAL SLABS.				ACI 318: 26.11.2
12. INSPECT FORMWORK FOR SHAPE, LOCATION AND DIMENSIONS OF THE CONCRETE MEMBER BEING FORMED.	X	---	X	ACI 318: 26.11.1.2(b)

REQUIRED SPECIAL INSPECTIONS AND TESTS OF STRUCTURAL STEEL				
TYPE	APPLICABLE TO THIS PROJECT	CONTINUOUS	PERIODIC	REFERENCED STANDARD
1. VERIFY CORRECT FRAMING SHAPES AND SIZES ARE INSTALLED IN PROPER LOCATIONS.				AISC360, N5
2. WELDING:				
a. VERIFY QUALIFIED WELDERS WITH APPROVE WELDING CERTIFICATES.				
b. VERIFY WELD FILLER MATERIAL.				
c. VERIFY PROPER WELDING TECHNIQUES.				
d. VERIFY PROPER MEMBER FIT-UP PRIOR TO WELDING.				
1. FILLET WELDS.				
2. PARTIAL JOINT PENETRATION (PJP) WELDS.				
3. COMPLETE JOINT PENETRATION (CJP) WELDS.				
e. POST-WELD INSPECTION:				
1. VERIFY WELDS CLEANED.				
2. VERIFY PROPER SIZE, LENGTH AND LOCATION OF WELDS.				
3. VERIFY WELDS ALL WELDS MEET VISUAL ACCEPTANCE CRITERIA.				
4. COMPLETE JOINT PENETRATION (CJP) WELDS TO BE ULTRASONIC TESTED PER AISC360, SECTION N5.5.				
5. VERIFY PROPER ARC STRIKES.				
6. VERIFY K-AREA.				
7. VERIFY BACKING REMOVED AND WELD TABS REMOVED (IF REQUIRED).				
8. VERIFY REPAIR ACTIVITIES.				
3. HIGH-STRENGTH BOLTING:	X	---	X	
a. VERIFY MANUFACTURER'S CERTIFICATIONS FOR FASTENER MATERIALS.	X	---	X	
b. VERIFY FASTENERS ARE MARKED IN ACCORDANCE WITH ASTM REQUIREMENTS.	X	---	X	
c. VERIFY PROPER BOLTED CONNECTIONS:	X	---	X	
1. SNUG-TIGHT BOLTED JOINTS.	X	---	X	
i. VERIFY PROPER BOLTING PROCEDURE USED AT BOLTED JOINTS.	X	---	X	
ii. VERIFY PROPER FASTENER ASSEMBLIES ARE USED AT BOLTED JOINTS.	X	---	X	
2. PRE-TENSIONED AND SLIP-CRITICAL BOLTED JOINTS.				
i. VERIFY PROPER BOLTING PROCEDURE USED AT BOLTED JOINTS.				
ii. VERIFY PROPER FASTENER ASSEMBLIES ARE USED AT BOLTED JOINTS.				
iii. VERIFY JOINT BROUGHT TO SNUG-TIGHT CONDITION PRIOR TO THE PRETENSIONING OPERATION.				
4. VERIFY FASTENER COMPONENT NOT TURNED BY THE WRENCH PREVENTED FROM ROTATING.				
v. VERIFY FASTENERS ARE PRETENSIONED IN ACCORDANCE WITH THE RCSC SPECIFICATION, PROGRESSING SYSTEMATICALLY FROM THE MOST RIGID POINT TOWARD THE FREE EDGES.				

HELT
DESIGN
ARCHITECTURE INTERIORS

6405 W. WILKINSON
BLVD, STE. 100
BELMONT, NC 28012

704.342.1686
HELTDESIGN.COM
INFO@HELTDESIGN.COM
PROJECT NAME:

HARBOR
FREIGHT TOOLS
FOR
STOCKS & TAYLOR
CONSTRUCTION

PROJECT NO: 23174

PROJECT ADDRESS:

46 SHRIJI LANE
ERWIN, NC 28339

SEAL:



CORPORATE ENTITY:
C.L. HELT, ARCHITECT, INC. A NORTH CAROLINA PROFESSIONAL CORPORATION
DBA HELT DESIGN.

COPYRIGHT:
THIS DRAWING AND ITS COPIES ARE THE ARCHITECT'S INSTRUMENTS OF SERVICE. THEY RETAIN ALL COMMON LAW AND STATUTORY RIGHTS, INCLUDING COPYRIGHT. THEY SHALL NOT BE USED OR COPIED FOR ANY PROJECT OTHER THAN THE ONE TITLED HERE IN.



DRAWING RELEASE:

NO.	DATE	DESCRIPTION

DRAWN BY: TMB CHECKED BY: TMB
DATE: 05/21/24

SHEET TITLE:
STATEMENT OF
SPECIAL INSPECTIONS

SHEET NUMBER:
S002

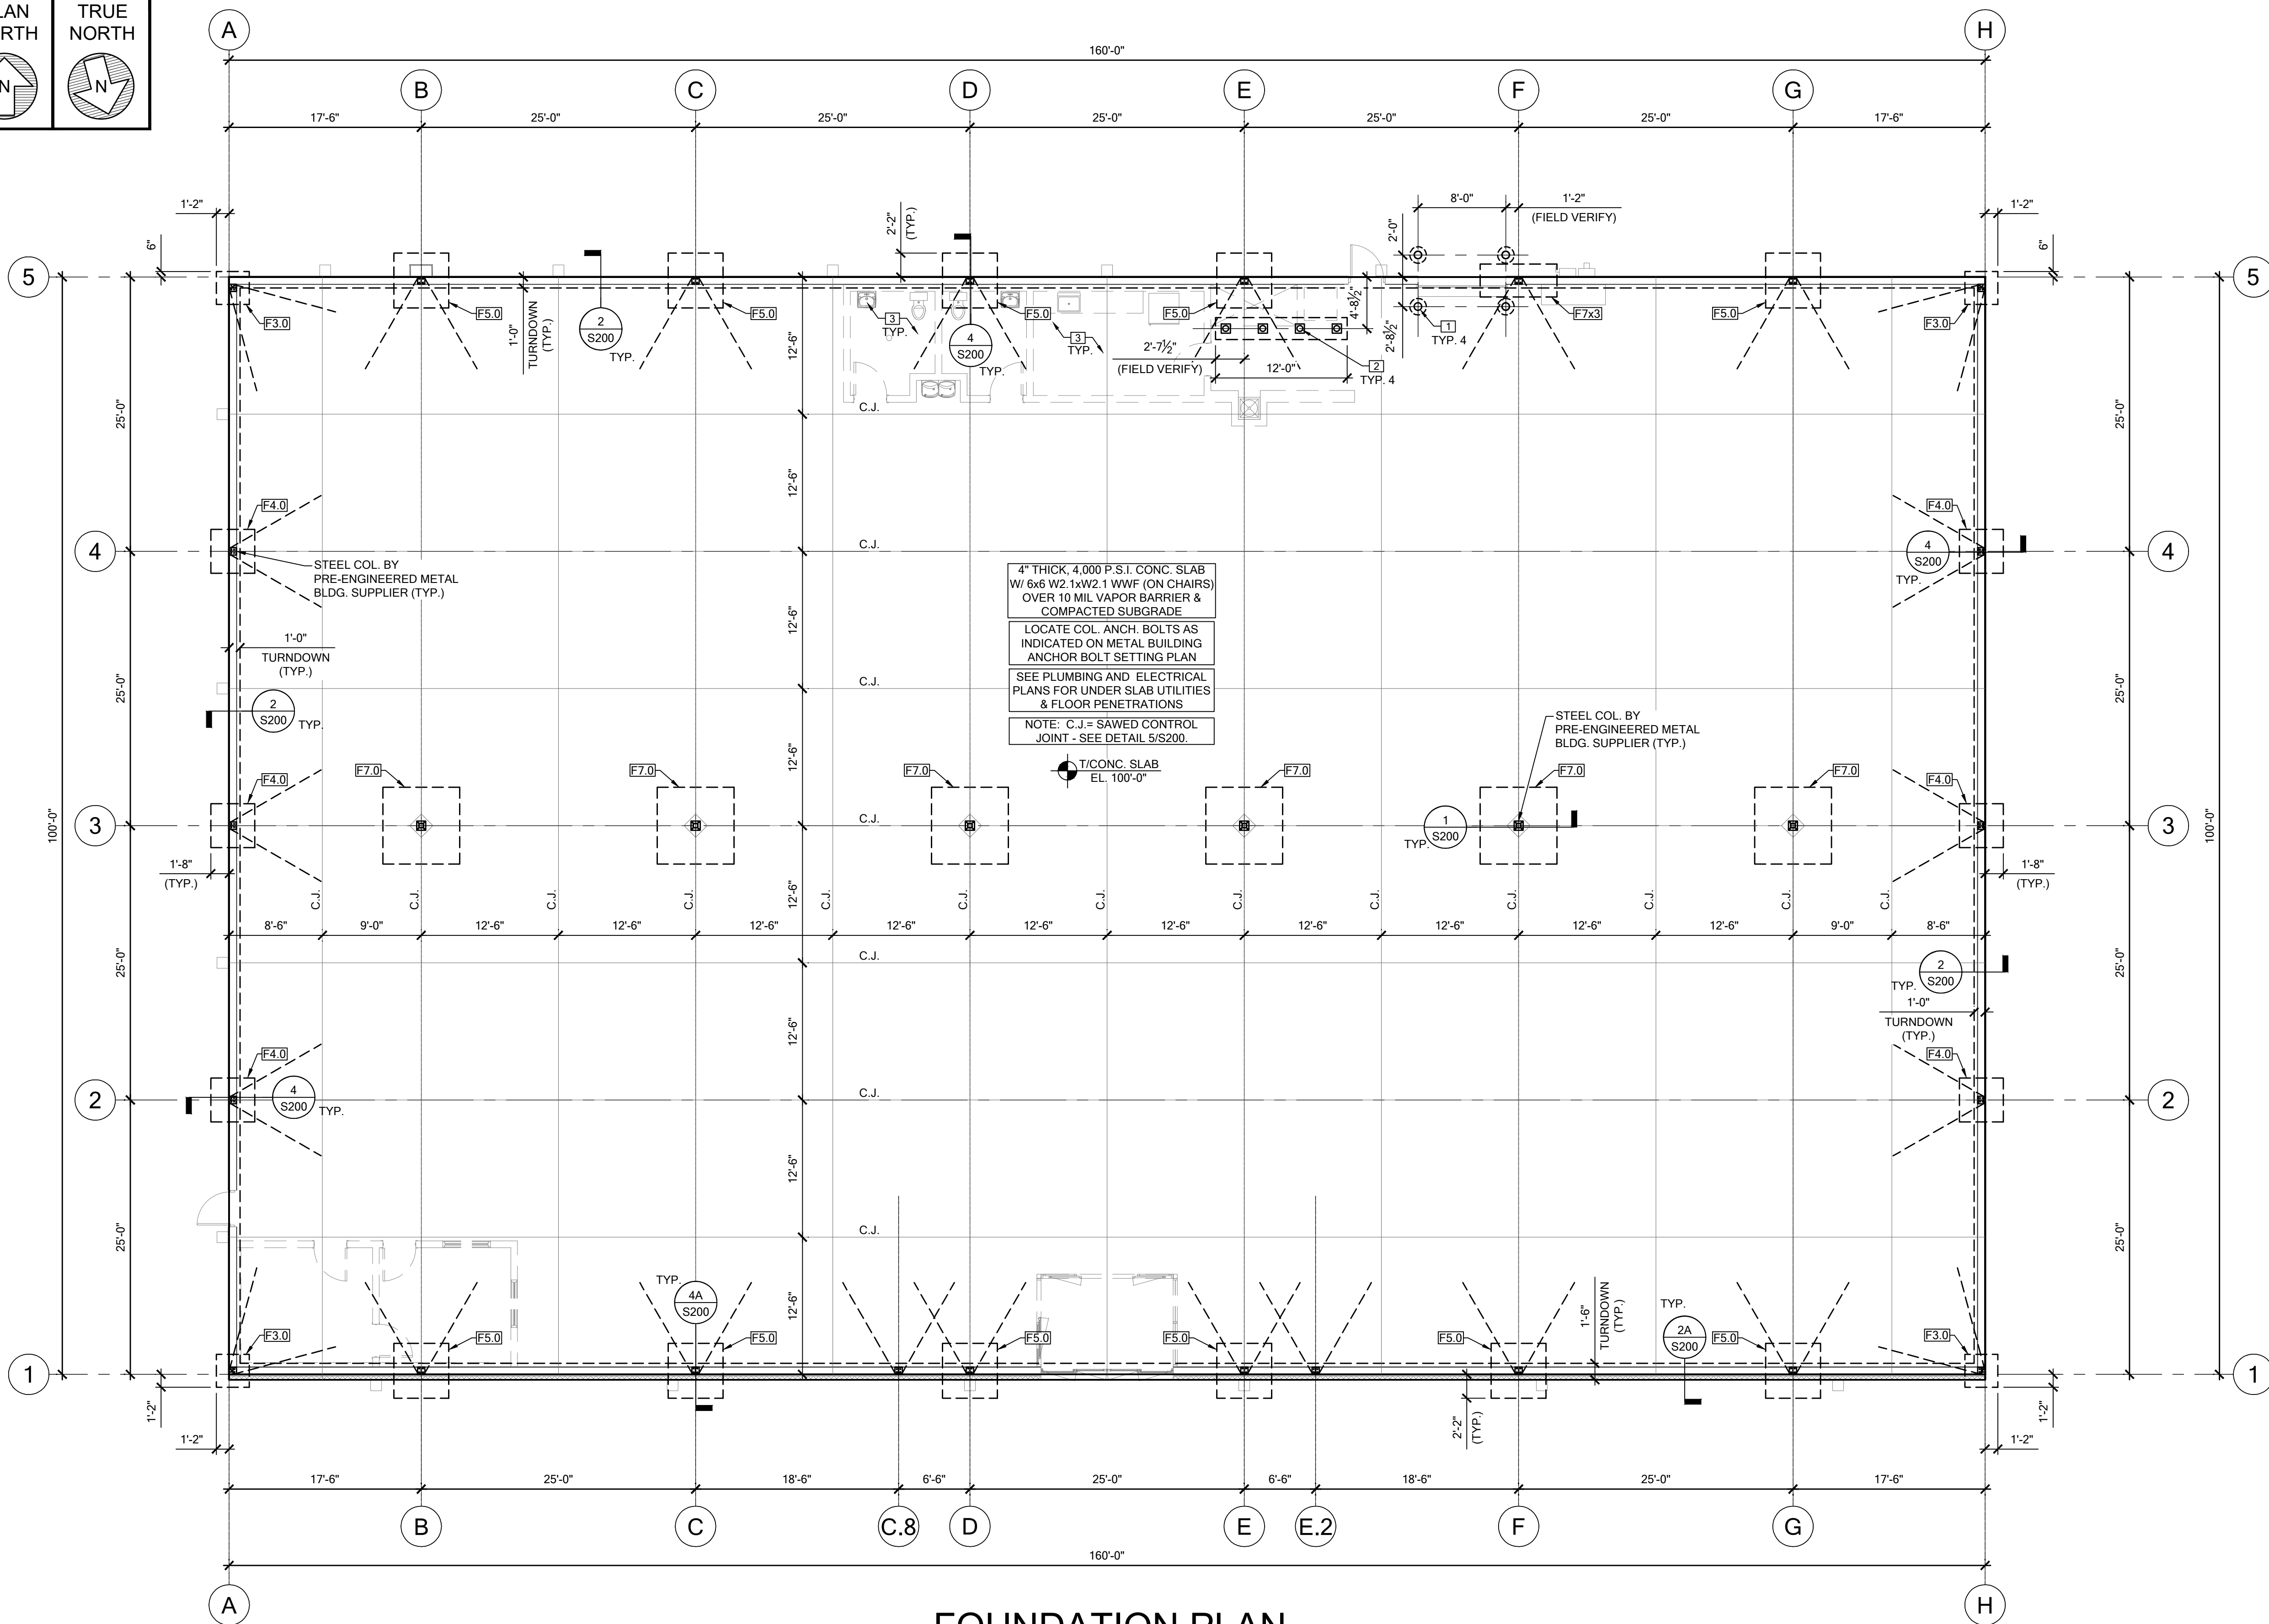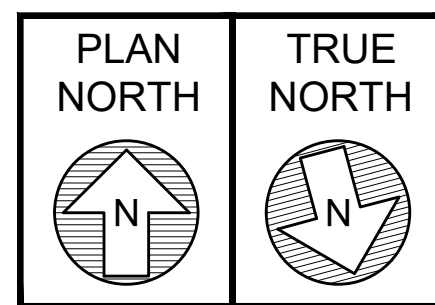

FOUNDATION PLAN

SCALE: 1/8" = 1'-0"

FOUNDATION SCHEDULE				
MARK	SIZE (L x W x D)	REINFORCING	T/FTG. EL.	REMARKS
F3.0	3'-0" x 3'-0" x 1'-0"	(4) #5 EA. WAY (BOTTOM ONLY)	98'-0"	
F4.0	4'-0" x 4'-0" x 1'-0"	(5) #5 EA. WAY (BOTTOM ONLY)	98'-0"	
F5.0	5'-0" x 5'-0" x 1'-0"	(6) #5 EA. WAY (BOTTOM ONLY)	98'-0"	
F7x3	7'-0" x 3'-0" x 1'-0"	(4) #5 EA. WAY LONG. (BOTTOM ONLY) (8) #5 EA. WAY TRAV. (BOTTOM ONLY)	98'-0"	
F7.0	7'-0" x 7'-0" x 2'-0"	(9) #5 EA. WAY (TOP & BOTTOM)	99'-4"	

NOTE:
G.C. RESPONSIBLE FOR BORINGS @ FINAL BLDG. LOCATION CHOSEN. VERIFY GRADING PER CIVIL DRAWINGS. G.C. TO CONTACT ARCHITECT/STRUCTURAL ENGINEER TO DETERMINE IF STEPPED FOOTINGS ARE TO BE PROVIDED FOR GRADE CHANGES AT PERIMETER OF BLDG.
GEOTECHNICAL INVESTIGATION RECOMMENDATIONS OF THE SOIL BELOW THE BUILDING AND PARKING LOT ARE TO BE FOLLOWED, AS WELL AS ANY ACCORDANCE WITH DOT STANDARDS FOR SITE WORK, AS REQUIRED.
PROVIDE A FOUNDATION DRAIN AT THE BUILDING PERIMETER THAT COMPLIES WITH IBC SECTION 1807.4.2 WHEN GRADE EXCEEDS THE FINISHED FLOOR. PERFORATED PLASTIC PIPE IS ACCEPTABLE.

FOUNDATION DESIGN INFORMATION
ALL FOUNDATION DESIGN IS BASED ON ALLOWABLE SOIL BEARING PRESSURE AS SPECIFIED IN FOUNDATION NOTES ON DWG. S001. ALL RECOMMENDATIONS FOR FILL, SITE PREPARATION, SUBGRADE COMPACTION, ETC. AS SPECIFIED IN THE GEOTECHNICAL REPORT SHALL BE FOLLOWED.

FOUNDATION LEGEND	
SYMBOL	DESIGN DESCRIPTION
FX.X	INDICATES CONCRETE FOOTING. SEE FOUNDATION SCHEDULE ON THIS DWG. FOR FOOTING SIZE & REINFORCING REQUIREMENTS.
###-##	INDICATES TOP OF SLAB, TOP OF FOOTING, OR TOP OF GRADE ELEVATION.
C.J.	INDICATES SAWED CONTROL JOINT - SEE DETAIL 5/S200. KEYED CONSTRUCTION JOINT CAN BE USED AT THE CONTRACTOR'S DISCRETION AT ALL SAWED CONTROL JOINTS UNLESS NOTED.

FOUNDATION NOTES	
1.	SEE SHEETS S001 FOR GENERAL STRUCTURAL NOTES. SEE SHEET S002 FOR CONCRETE SPECIFICATIONS.
2.	TOP OF CONCRETE SLAB ELEVATION AS NOTED IN PLAN FOR REFERENCE ONLY. SEE CIVIL DRAWINGS FOR ACTUAL ELEVATION ABOVE MEAN SEA LEVEL.
3.	SEE 7/S200 FOR TYPICAL FOUNDATION REINFORCING AT BUILDING CORNERS.
4.	G.C. SHALL COORDINATE AND NOTIFY E.O.R. OF ANY CONDITIONS THAT WILL REQUIRE FOOTING STEPS OR LOWER FOOTINGS THAN INDICATED ON FOUNDATION PLAN. THESE CONDITIONS INCLUDE, BUT ARE NOT LIMITED TO, CONFLICTS WITH FINAL GRADING AROUND BUILDING PERIMETER, CONFLICTS WITH BELOW GRADE UTILITIES & PLUMBING, AND UNSUITABLE BEARING MATERIAL.
5.	ALL FOOTINGS ARE CENTERED UNDER BEARING WALLS, COLUMNS, GIRDER TRUSSES, ETC., UNLESS NOTED OTHERWISE.
6.	RECESSED SLABS, SLAB STEPS, AND SLOPED SLABS SHOWN ON THESE DRAWINGS SHALL BE VERIFIED WITH THE ARCHITECTURAL DRAWINGS BY THE G.C. THE G.C. SHALL ALSO BE RESPONSIBLE FOR COORDINATING ANY REQUIRED SLAB RECESSES, SLAB STEPS, AND SLOPED SLABS FOR FLOORING, EQUIPMENT, DRAINS, ETC. WITH THE ARCHITECTURAL AND M.E.P. DRAWINGS PRIOR TO CONSTRUCTION.
7.	MAINTAIN SLAB THICKNESS AT ALL FLOOR SLOPES AND DEPRESSIONS.

PLAN KEY NOTES	
1	8"Ø SCH. 40 PIPE BOLLARD FILLED W/ CONCRETE - SEE DETAIL 8, DWG. S200 FOR DETAILS - SAW CUT CONC. SLAB FOR INTERIOR BOLLARD INSTALLATION - G.C. SHALL VERIFY EXACT BOLLARD LOCATION
2	6"Ø BOLT-DOWN SCH. 40 PIPE BOLLARD FILLED W/ CONCRETE - FOLLOW MANUFACTURER'S RECOMMENDATIONS FOR ANCHORING TO SLAB - PROVIDE 24-IN WIDE x 12-FT LONG x 12-IN THICK, THICKENED SLAB W/ #4 BARS @ 12" O.C. (EA. WAY) AS SHOWN IN PLAN FOR ANCHORING BOLLARDS - G.C. SHALL VERIFY EXACT BOLLARD LOCATION AND THICKENED SLAB LOCATION
2	G.C. SHALL COORDINATE PLUMBING ROUGH-INS FOR BATHROOM AND BREAK AREA PRIOR TO INSTALLATION OF CONCRETE SLAB - ANY SLAB LEAVE-OUTS MUST BE REVIEWED AND APPROVED BY E.O.R. PRIOR TO CONSTRUCTING

CONTRACTOR/ SUB-CONTRACTOR NOTE:
ANY DISCREPANCY OR ERROR IN DIMENSIONS OR NOTES SHALL BE BROUGHT TO THE ATTENTION OF THE DESIGN PROFESSIONAL FOR CLARIFICATION PRIOR TO COMMENCEMENT OF CONSTRUCTION.



6405 W. WILKINSON BLVD, STE. 100
BELMONT, NC 28012
704.342.1686
HELTDDESIGN.COM
INFO@HELTDDESIGN.COM
PROJECT NAME:

HARBOR FREIGHT TOOLS FOR STOCKS & TAYLOR CONSTRUCTION

PROJECT NO: 23174

PROJECT ADDRESS:

46 SHRIJI LANE
ERWIN, NC 28339

SEAL:



CORPORATE ENTITY:
C.L. HELT, ARCHITECT, INC. A NORTH CAROLINA PROFESSIONAL CORPORATION
DBA HELT DESIGN.

COPYRIGHT:
THIS DRAWING AND ITS COPIES ARE THE ARCHITECT'S INSTRUMENTS OF SERVICE. THEY RETAIN ALL COMMON LAW AND STATUTORY RIGHTS, INCLUDING COPYRIGHT. THEY SHALL NOT BE USED OR COPIED FOR ANY PROJECT OTHER THAN THE ONE TITLED HERE IN.

DRAWING RELEASE:


NO.	DATE	DESCRIPTION

DRAWN BY: TMB
CHECKED BY: TMB


DATE: 05/21/24

SHEET TITLE:
FOUNDATION PLAN,
SCHEDULE & NOTES


SHEET NUMBER:
S100

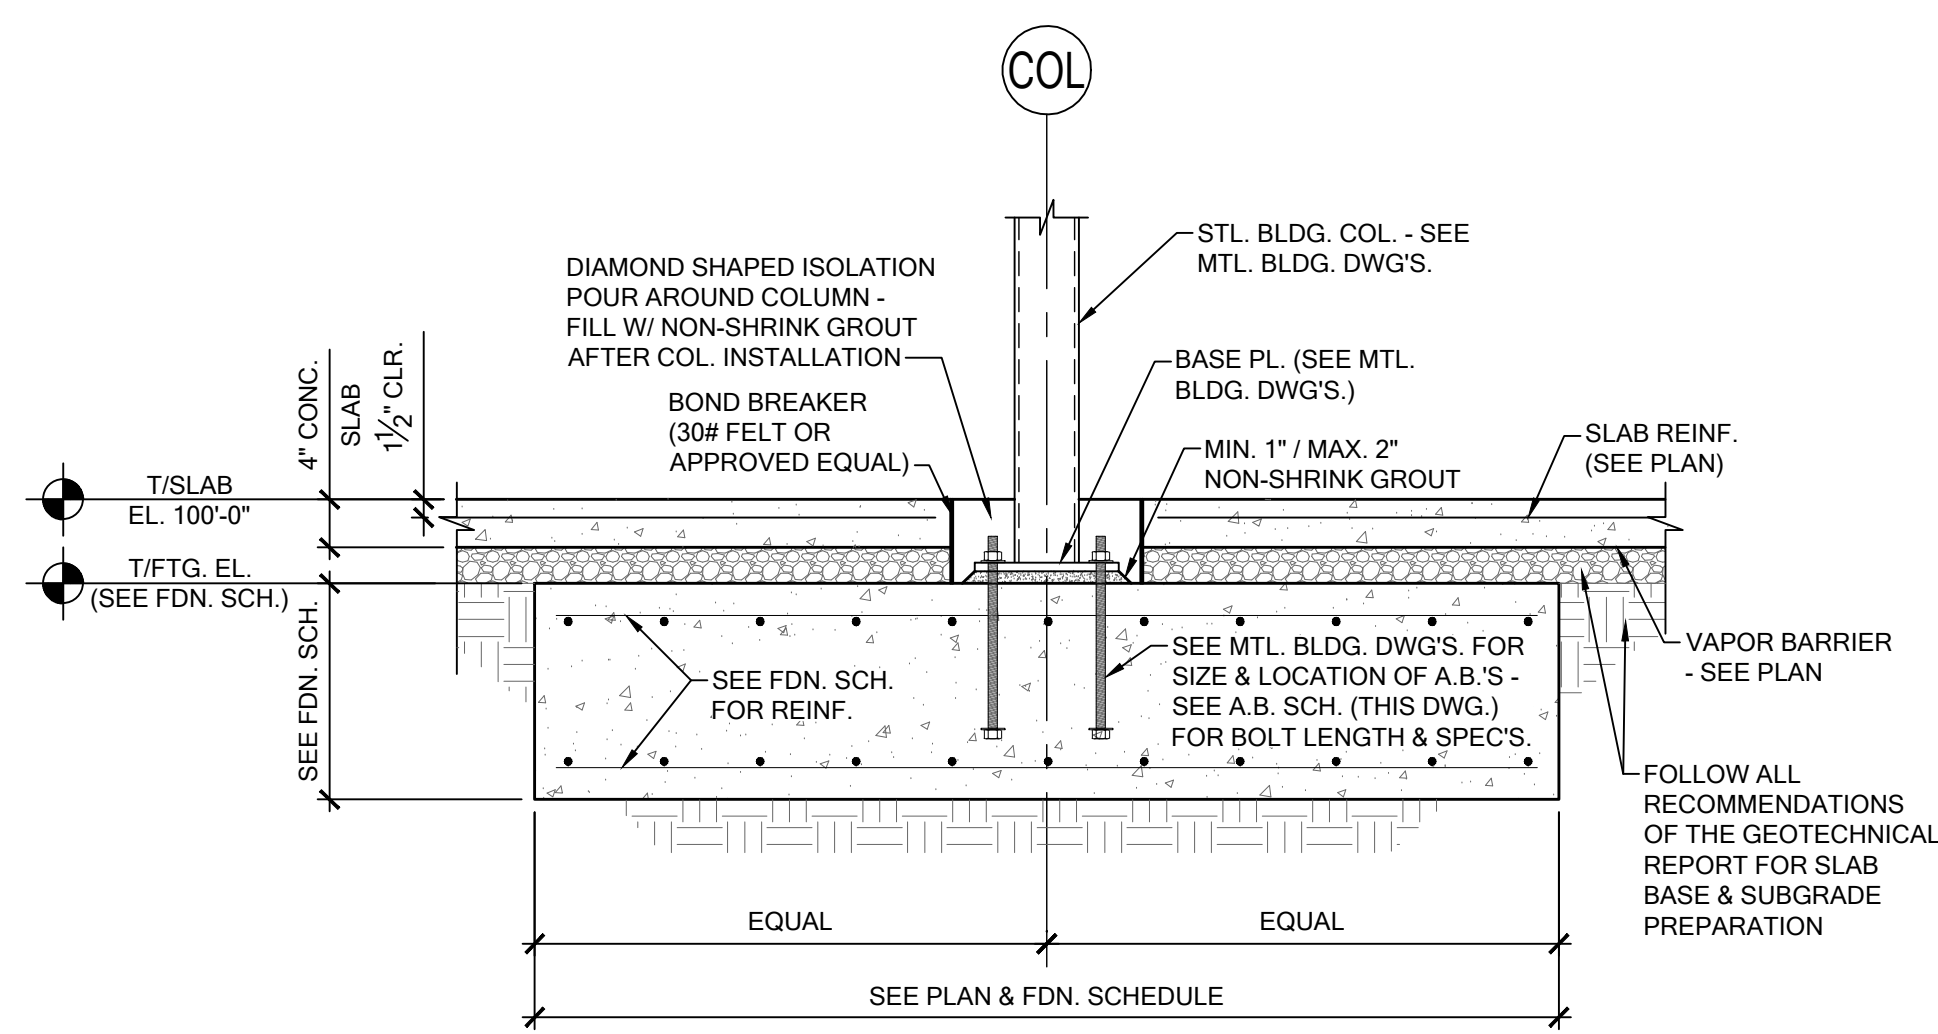


1 TYPICAL FDN. SECTION @ INTERIOR COLUMN
SCALE: 3/4" = 1'-0"

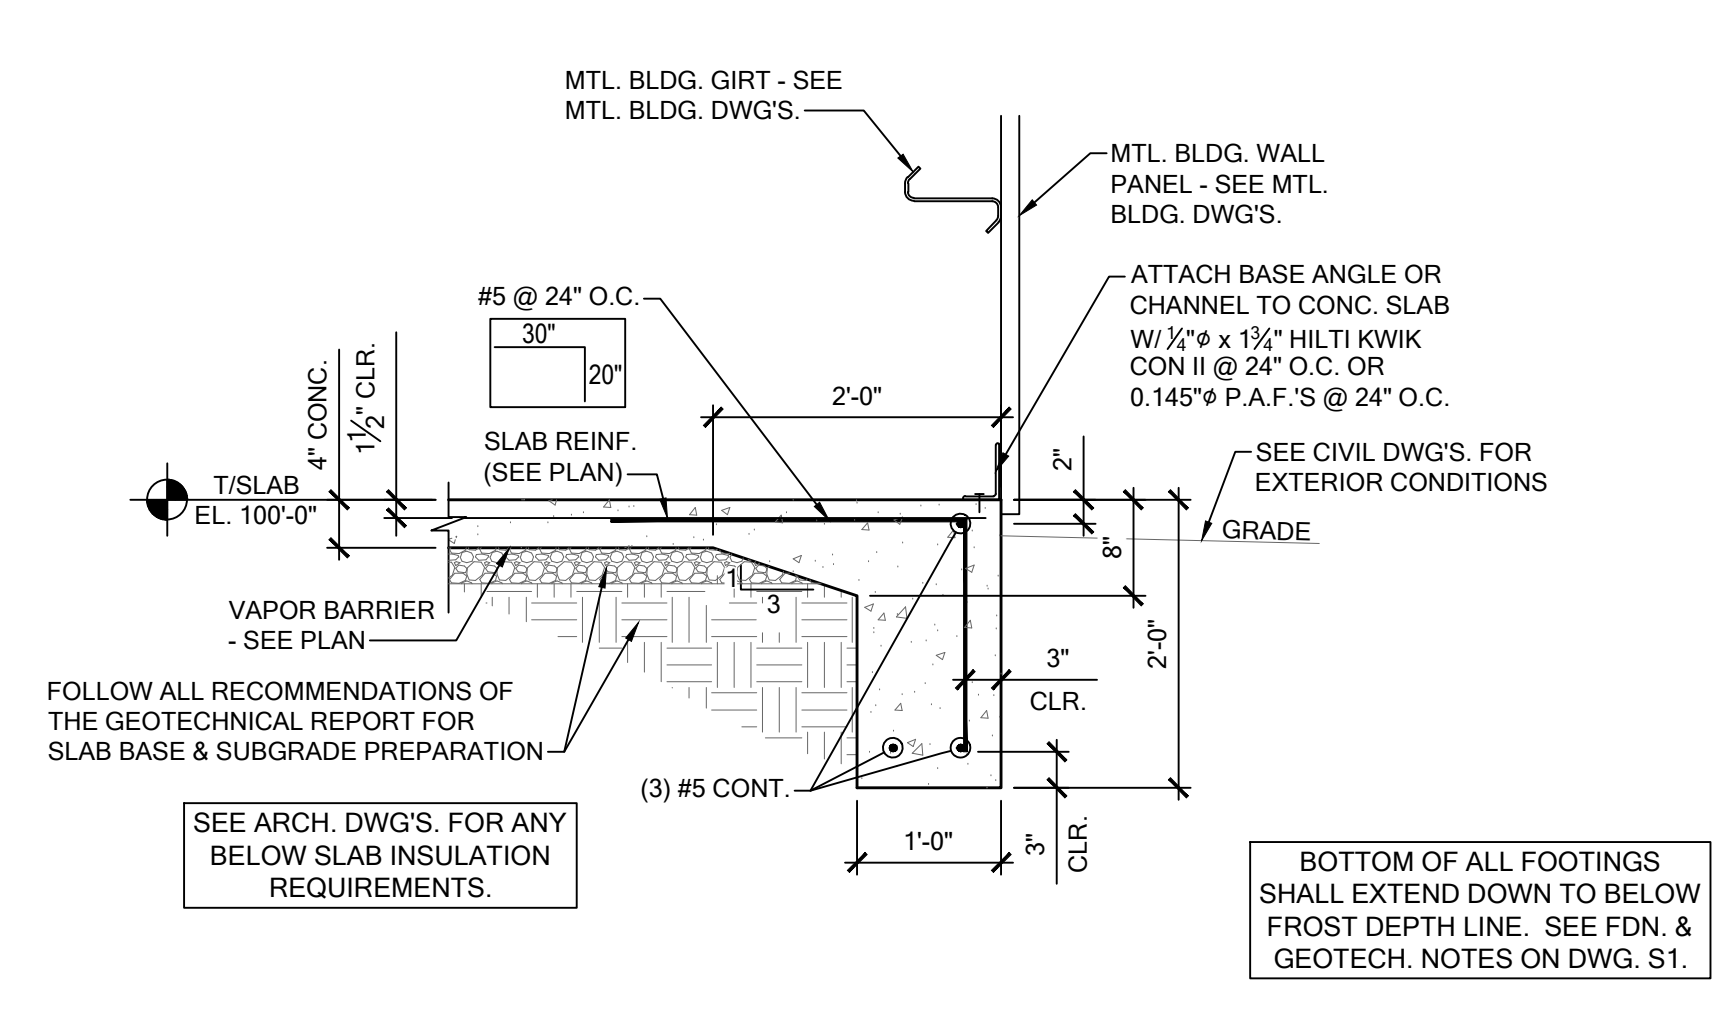


2 TYPICAL FDN. SECTION @ TURN DOWN
SCALE: 3/4" = 1'-0"

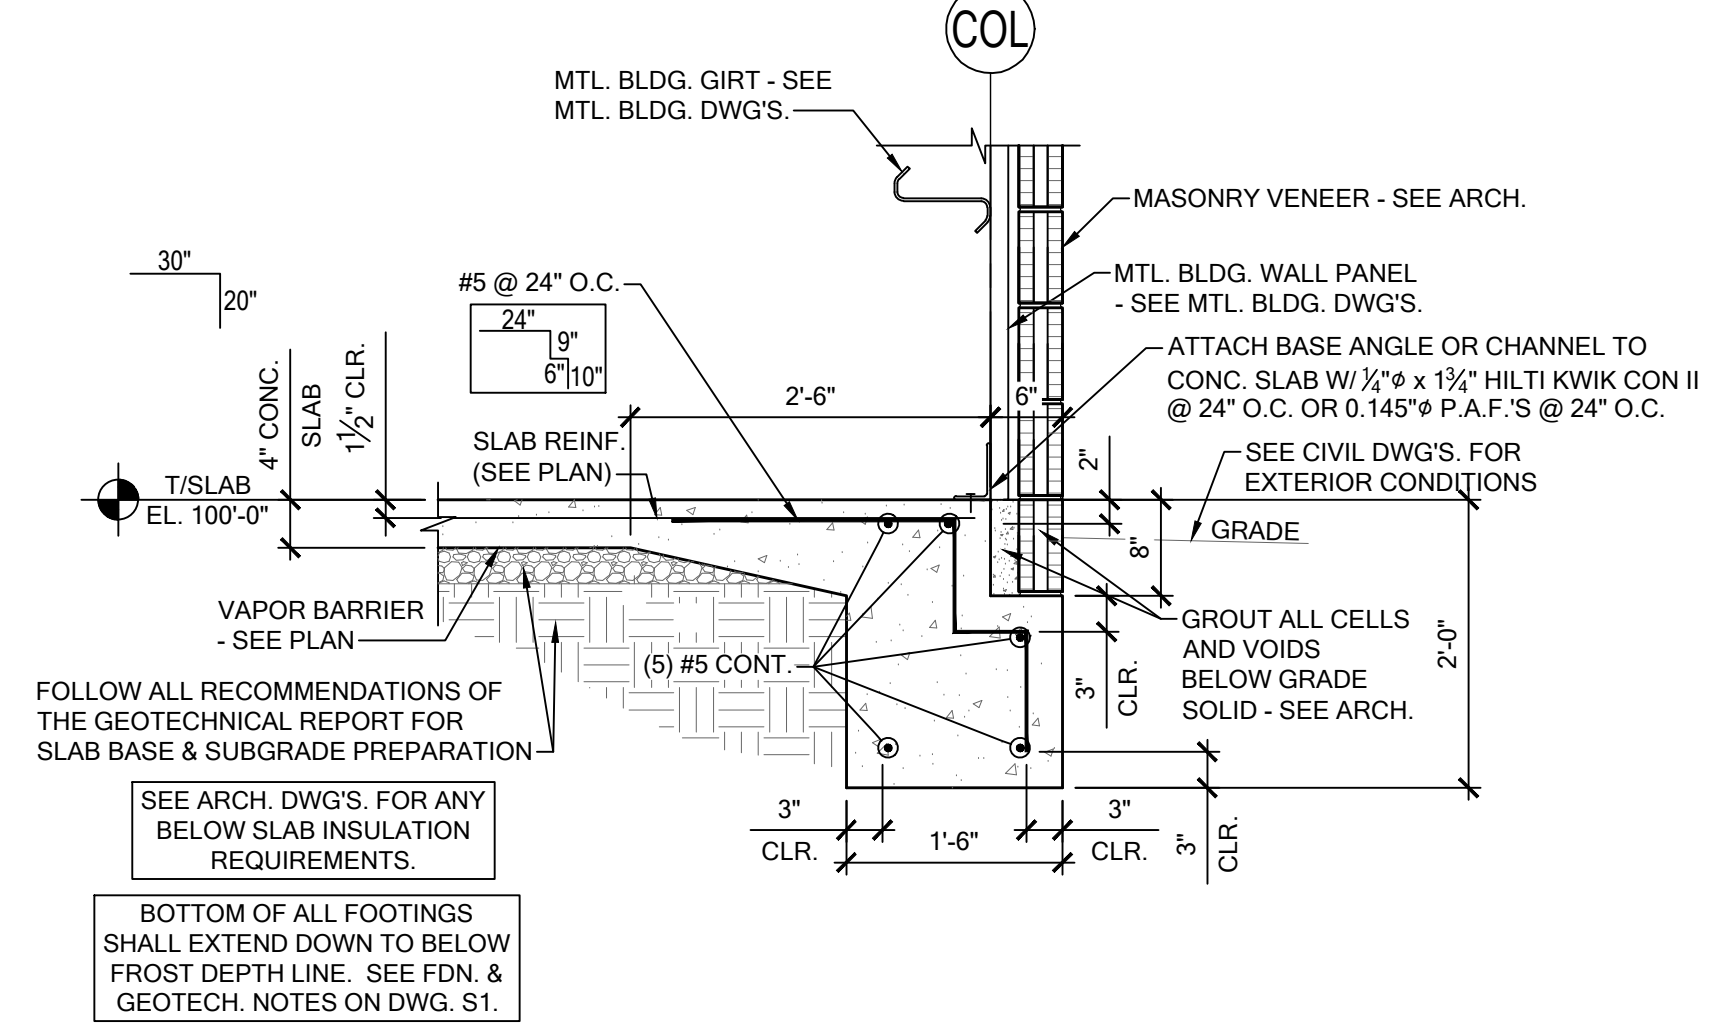


2A TYPICAL FDN. SECTION @ TURN DOWN W/ BRICK LEDGE
SCALE: 3/4" = 1'-0"

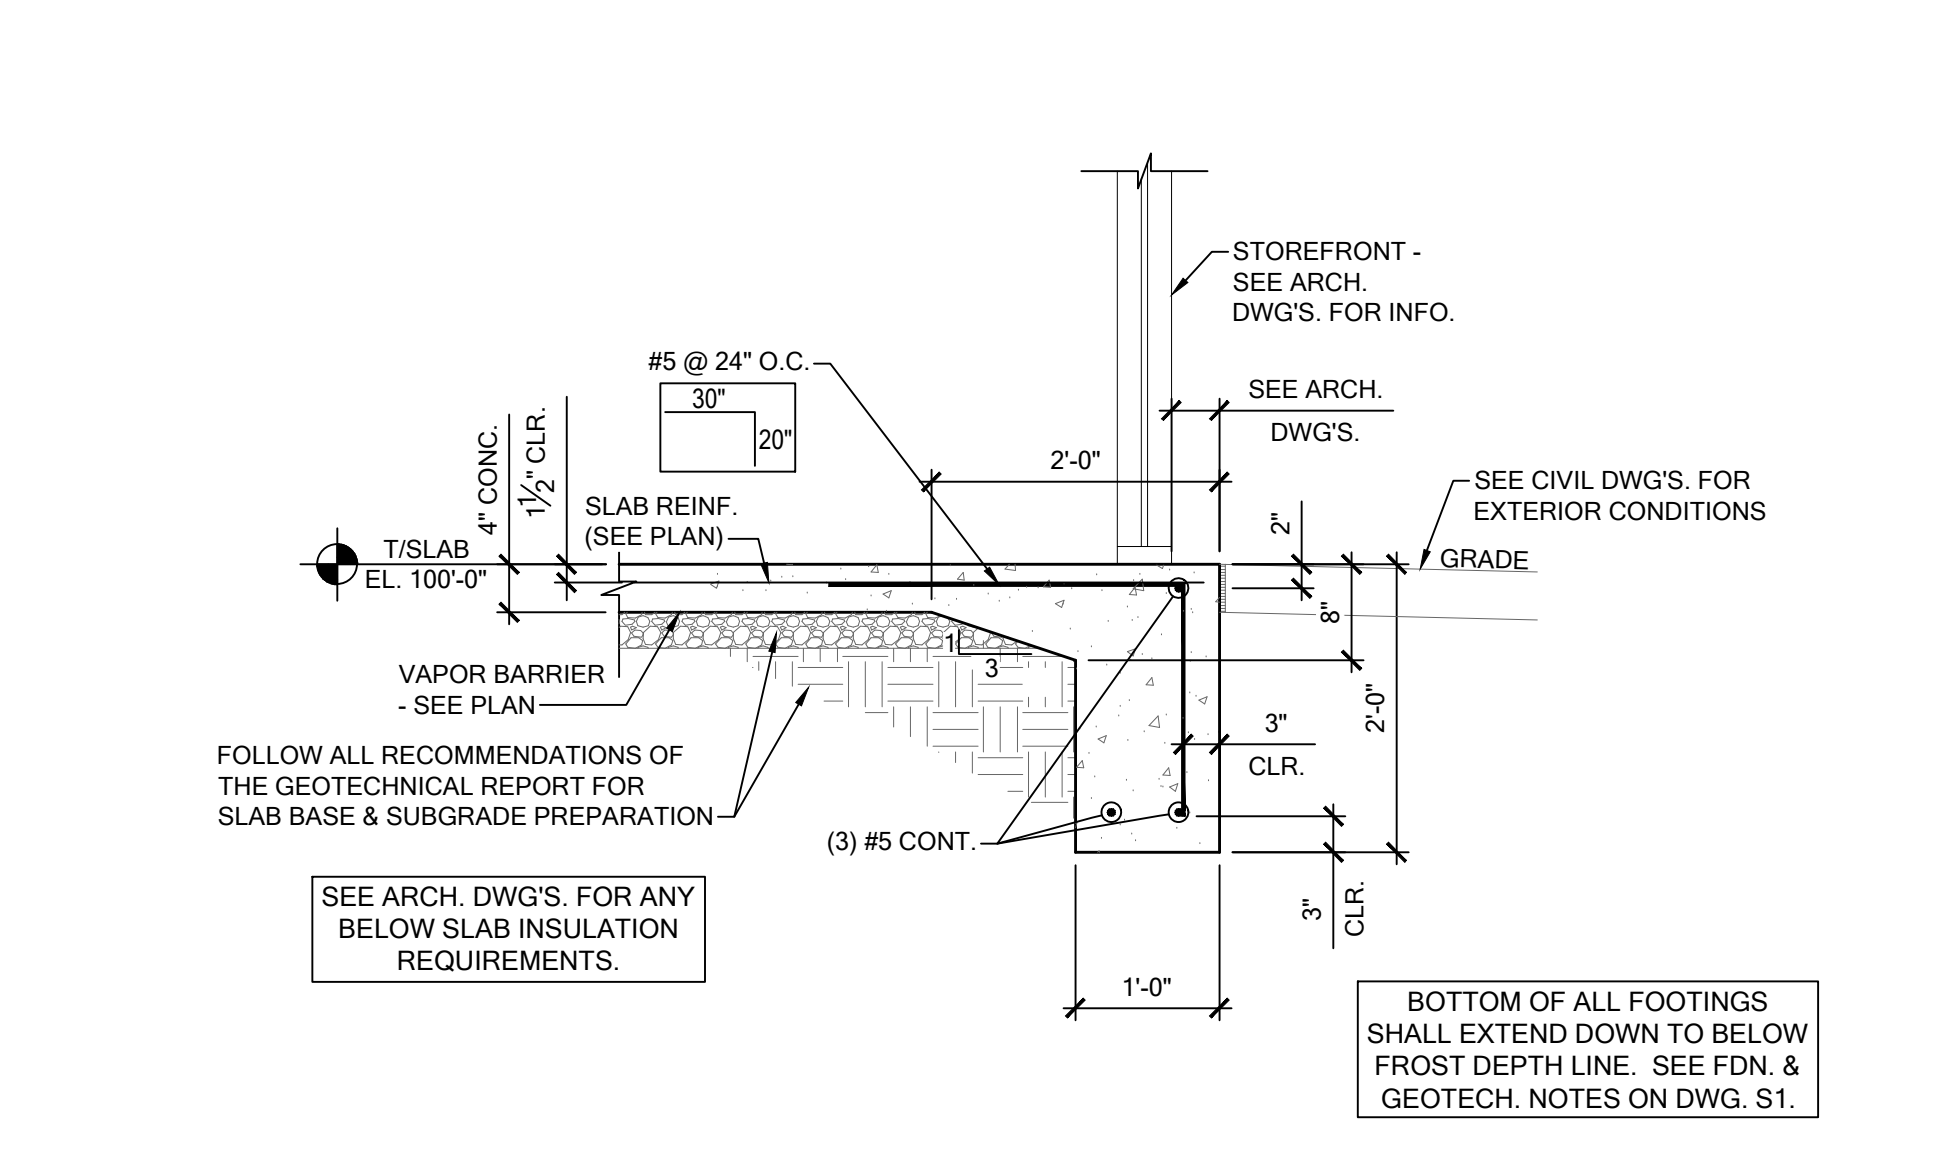


3 TYPICAL FDN. SECTION @ STOREFRONT
SCALE: 3/4" = 1'-0"

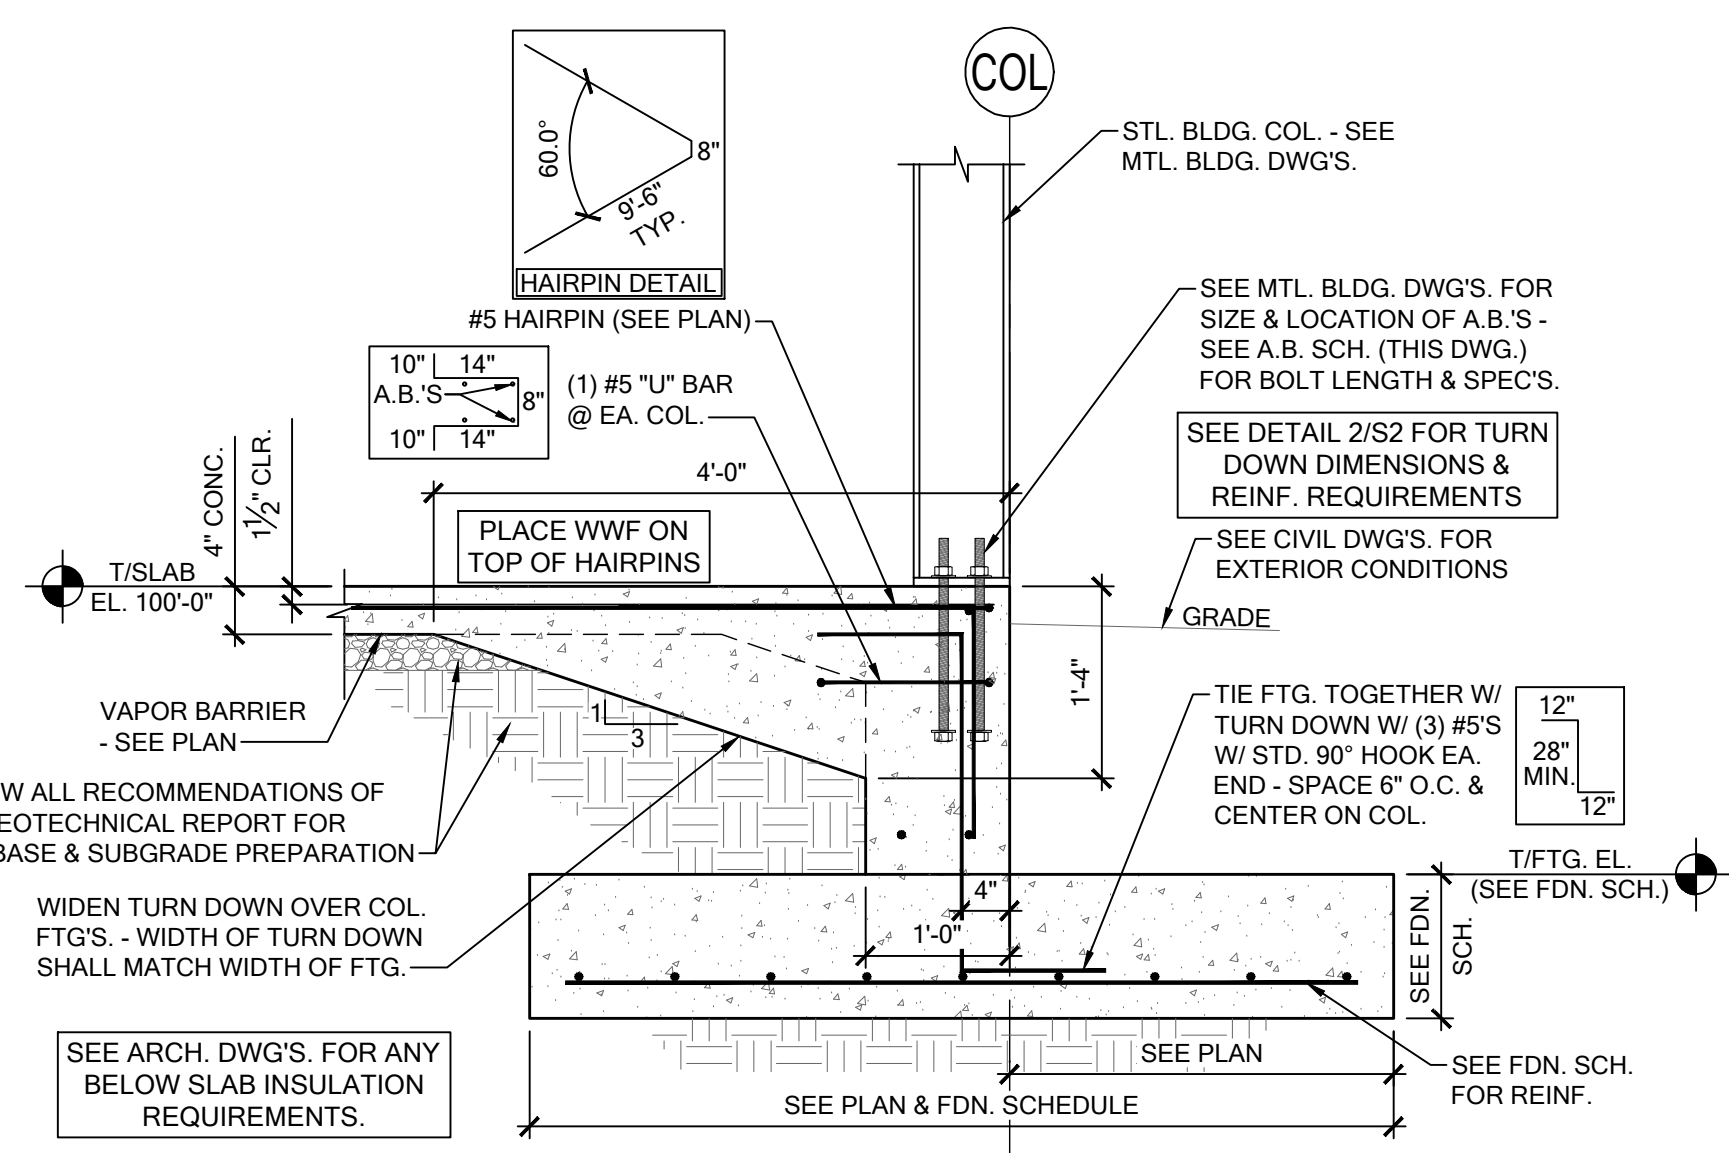

4 TYPICAL FDN. SECTION @ PERIMETER COLUMN
SCALE: 3/4" = 1'-0"

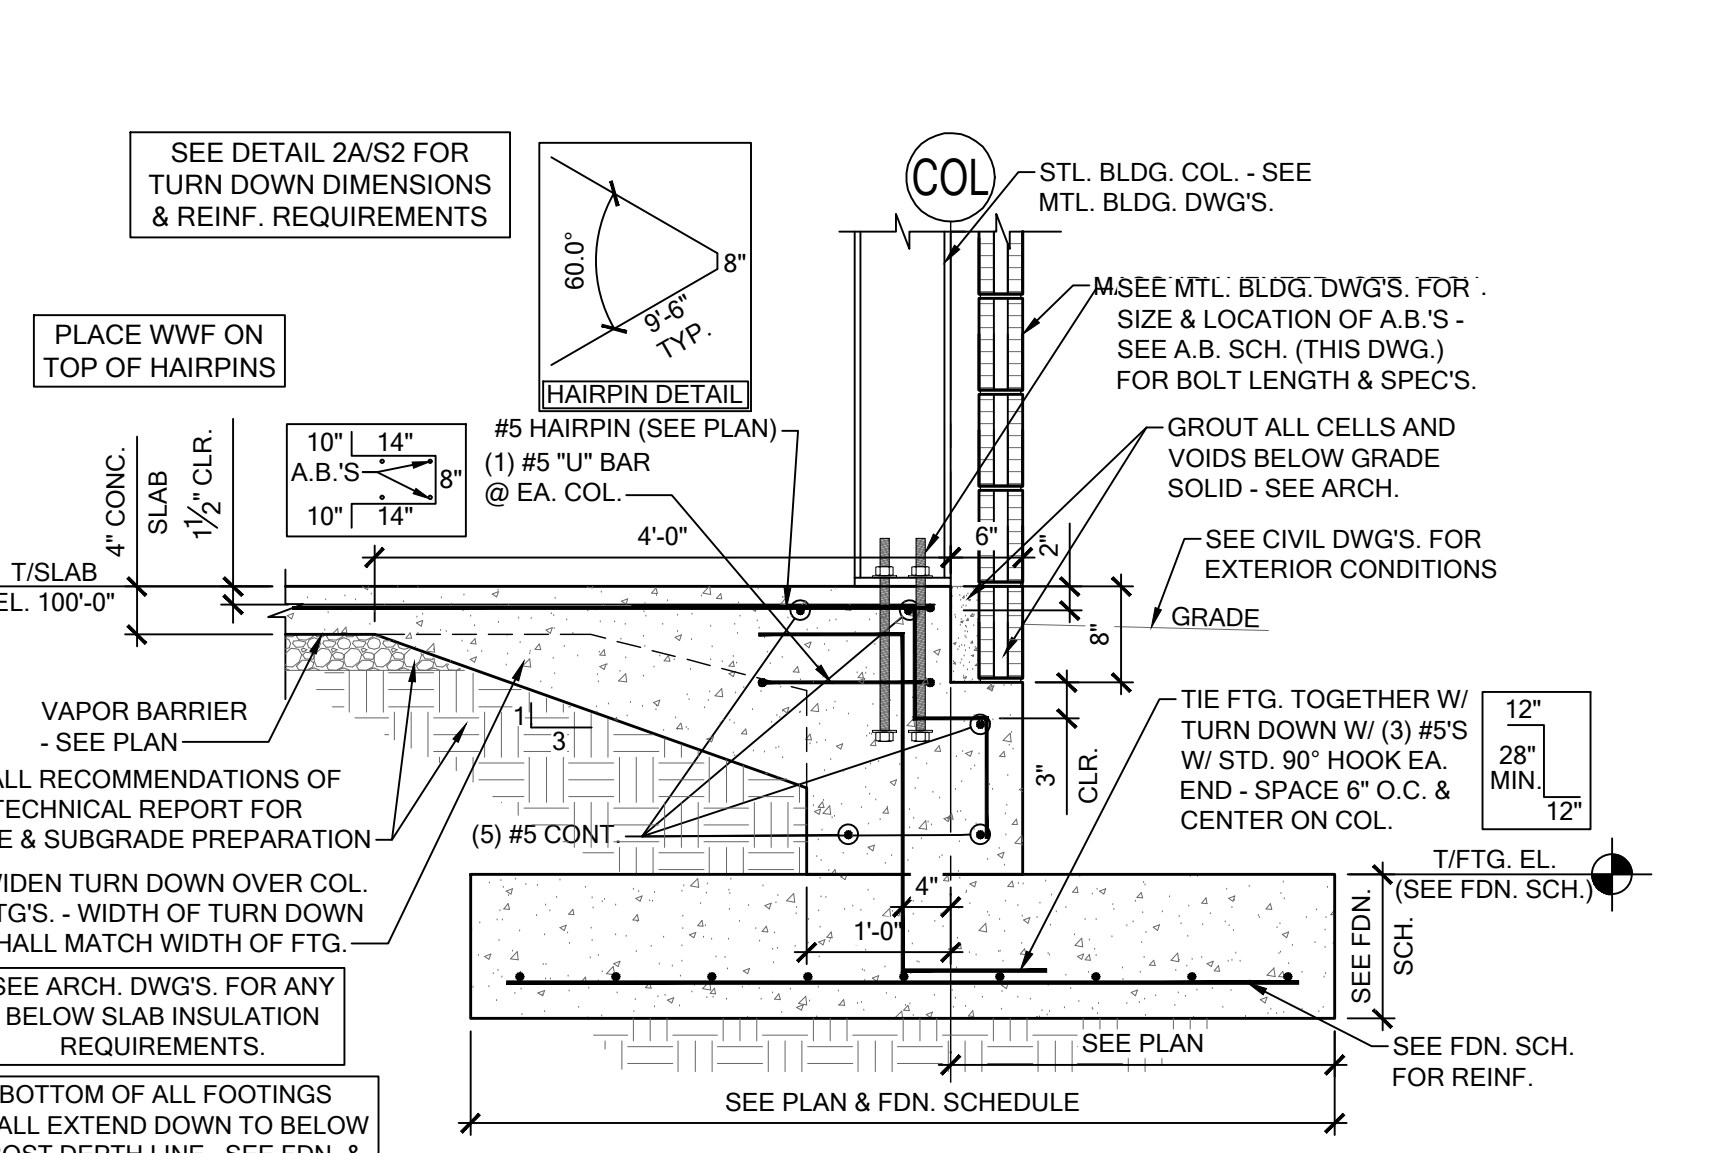

4A TYPICAL FDN. SECTION @ PERIMETER COLUMN W/ BRICK LEDGE
SCALE: 3/4" = 1'-0"

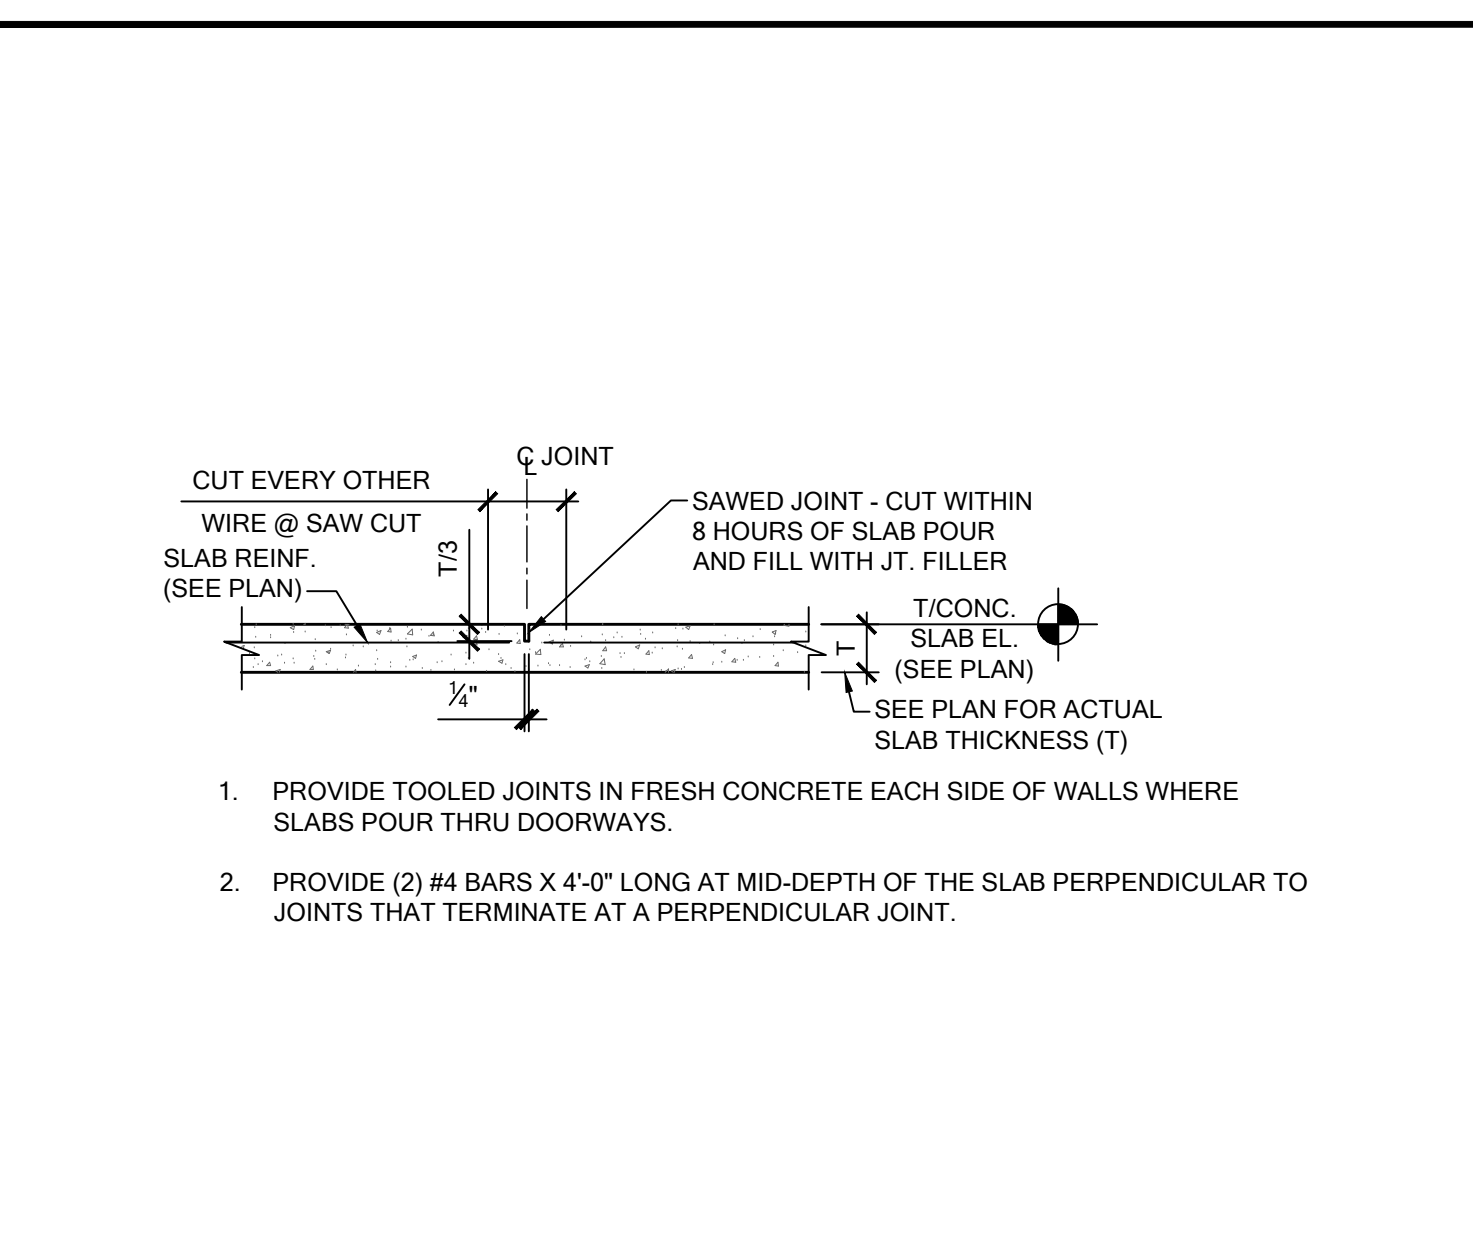


5 SAWED CONTROL JOINT DETAIL
SCALE: N.T.S.

BOLT DIA. (Ø) (IN)	BOLT LENGTH (L) (IN)	THREAD LENGTH (T) & MAX PROJ. (IN)
3/8"	8"	3"
1/2"	9"	3"
5/8"	11-4"	4"
3/4"	11-4"	4"
7/8"	11-5"	4"
1"	11-6"	4"
1 1/8"	11-7"	5"
1 1/4"	11-9"	6"
1 3/8"	11-11"	6"
1 1/2"	11-11"	7"
1 3/4"	11-11"	7"
2"	11-11"	8"
2 1/4"	11-11"	9"
2 1/2"	11-11"	10"

6 ANCHOR BOLT SCHEDULE
SCALE: N.T.S.

BAR SIZE	MASONRY			CONCRETE	
	BEND	LENGTH	LAP SPLICE	TENSION SPLICE	COMPRESSION SPLICE
#3	2 1/4"	4 1/4"	9 1/4"	1'-6"	1'-10"
#4	3"	5 5/8"	12 1/2"	2'-0"	2'-5"
#5	3 3/4"	7"	15 1/2"	2'-6"	3'-0"
#6	4 1/2"	8 1/16"	18 1/2"	3'-0"	3'-7"
#7	5 1/4"	9 13/16"	21 3/4"	3'-6"	4'-3"

7 REBAR BEND & SPLICE DETAIL
SCALE: N.T.S.

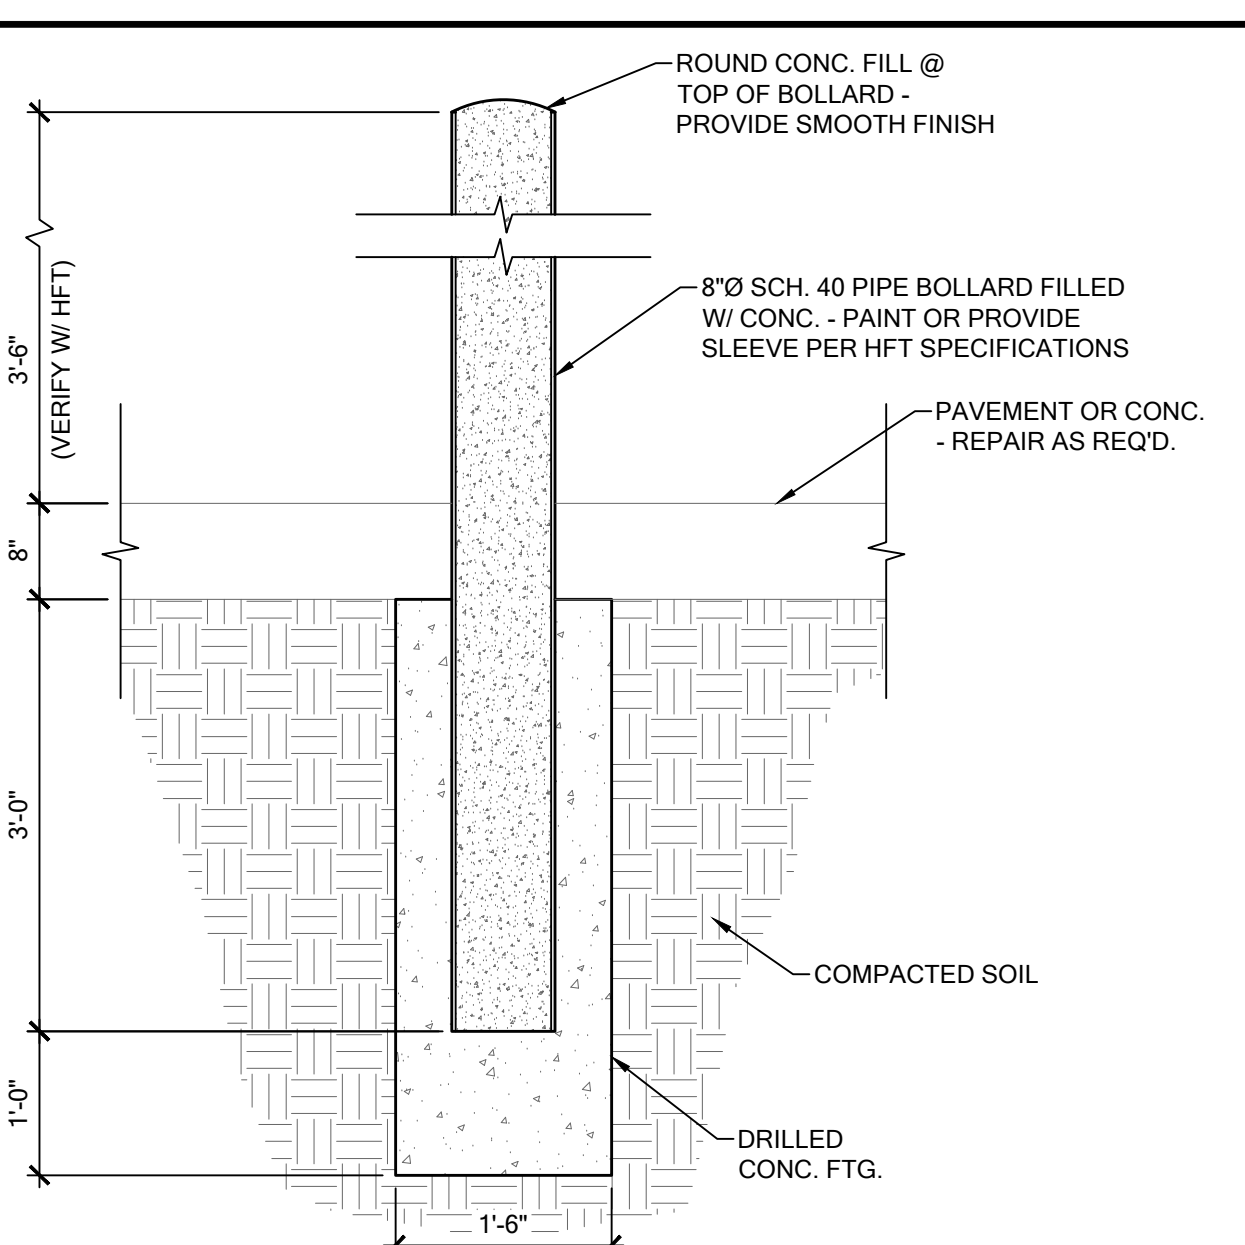


8 TYPICAL BOLLARD DETAIL
SCALE: 3/4" = 1'-0"




NO.	DATE	DESCRIPTION

ELECTRICAL DEVICE LEGEND	
SYMBOL	DESCRIPTION
⊕	WIRED JUNCTION BOX
⊕	WALL MOUNTED JUNCTION BOX
⊕	DUPLEX RECEPTACLE, 3 WIRE GRD. TYPE, 20A
⊕	DUPLEX RECEPTACLE, WEATHERPROOF, 20A
⊕	GROUND FAULT PROTECTED DUPLEX RECEPTACLE, 20A
⊕	DUPLEX RECEPTACLE WITH ISOLATED GROUND
⊕	CONTROLLED QUADRAPLEX RECEPTACLE
⊕	QUADRAPLEX WALL RECEPTACLE, 20A
⊕	DUPLEX RECEPTACLE, MOUNTED ABOVE COUNTER
⊕	WALL MOUNTED NEMA L5-20R 20 AMP TWIST LOCK RECEPTACLE
⊕	FLOOR MOUNTED DUPLEX RECEPTACLE, 20A
⊕	FLOOR MOUNTED (RECESSED) TWIST LOCK RECEPTACLE
⊕	CEILING MOUNTED DUPLEX RECEPTACLE, 20A
⊕	PUSHBUTTON STATION
⊕	LOW VOLTAGE BUZZER TRANSFORMER
⊕	DOOR BUZZER
⊕	TOGGLE SWITCH - SINGLE, 3-WAY & 4-WAY
⊕	OCCUPANCY SENSOR (TWO POLE WHERE NOTED)
⊕	VACANCY SENSOR
⊕	SWITCHED CIRCUIT
⊕	UNSWITCHED CIRCUIT
⊕	MANUAL MOTOR STARTING SWITCH W/ PILOT LIGHT
⊕	DATA OUTLET - CATEGORY 6
⊕	PEOPLE COUNTER DEVICE
⊕	SAFETY SWITCH
⊕	MAGNETIC MOTOR STARTER
⊕	COMBINATION STARTER/SAFETY SWITCH
⊕	MOTOR OUTLET - 1 PHASE
⊕	MOTOR OUTLET - 3 PHASE
⊕	FIRE ALARM HORN/STROBE SIGNAL DEVICE
⊕	CEILING MOUNTED FIRE ALARM HORN/STROBE SIGNAL DEVICE
⊕	POLE MOUNTED (HUNG FROM STRUCTURE) FIRE ALARM HORN/STROBE SIGNAL DEVICE
⊕	FIRE ALARM STROBE SIGNAL DEVICE
⊕	DUCT MTD. SYSTEM SMOKE DETECTOR W/ REMOTE INDICATORS
⊕	FIRE ALARM PULL STATION
⊕	SYSTEM SMOKE DETECTOR
⊕	FIRE ALARM BOOSTER BOX
⊕	KEY PAD
⊕	HOLD UP BUTTON
⊕	POWER PACK
⊕	CEILING MOUNTED VACANCY SENSOR.
⊕	WALL MOUNTED, LOW VOLTAGE, MANUAL-ON SWITCH
⊕	THERMOSTAT
⊕	TEMPERATURE SENSOR

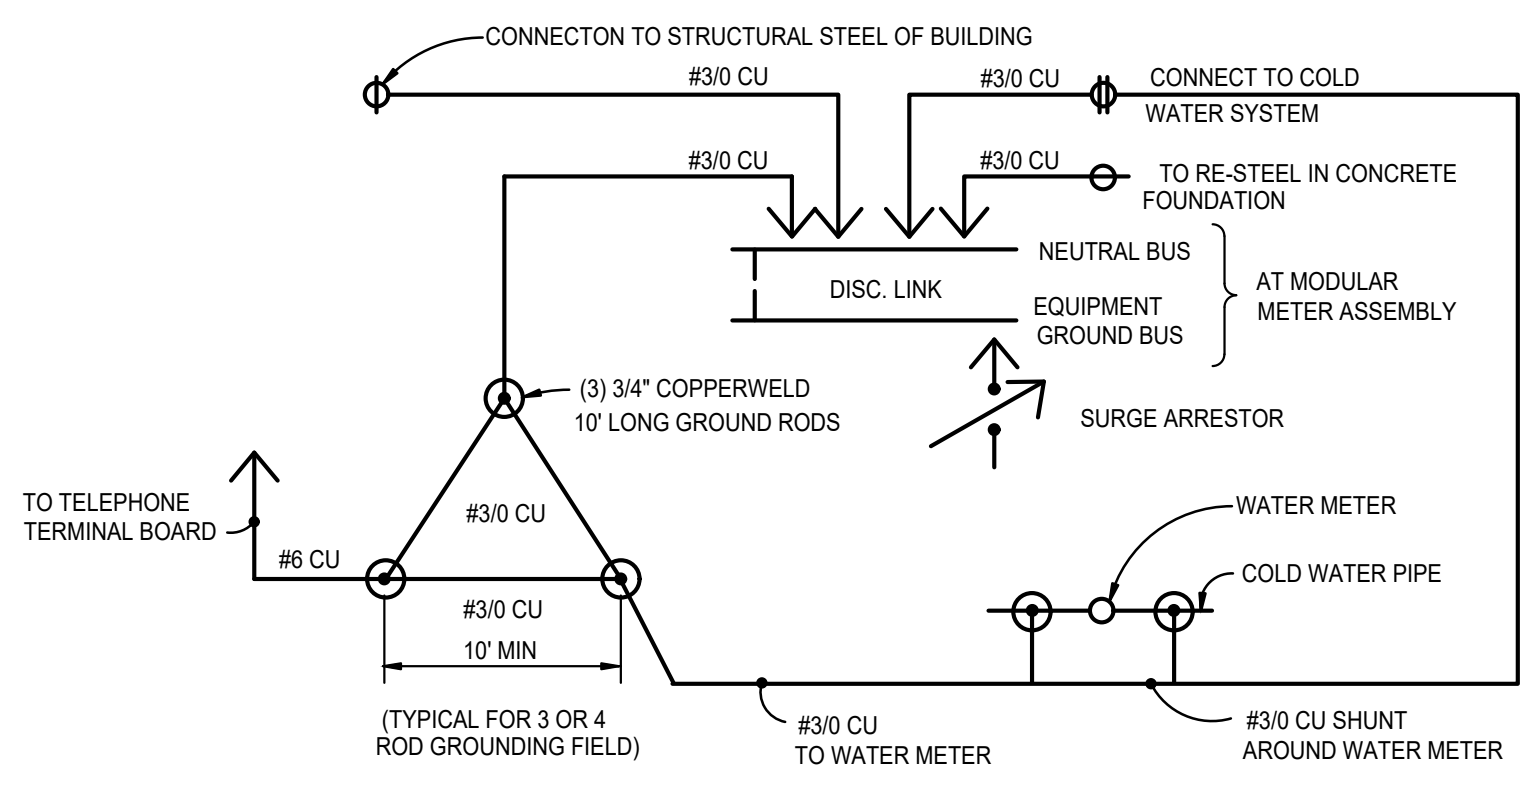

1 GROUNDING DETAIL
N.T.S.

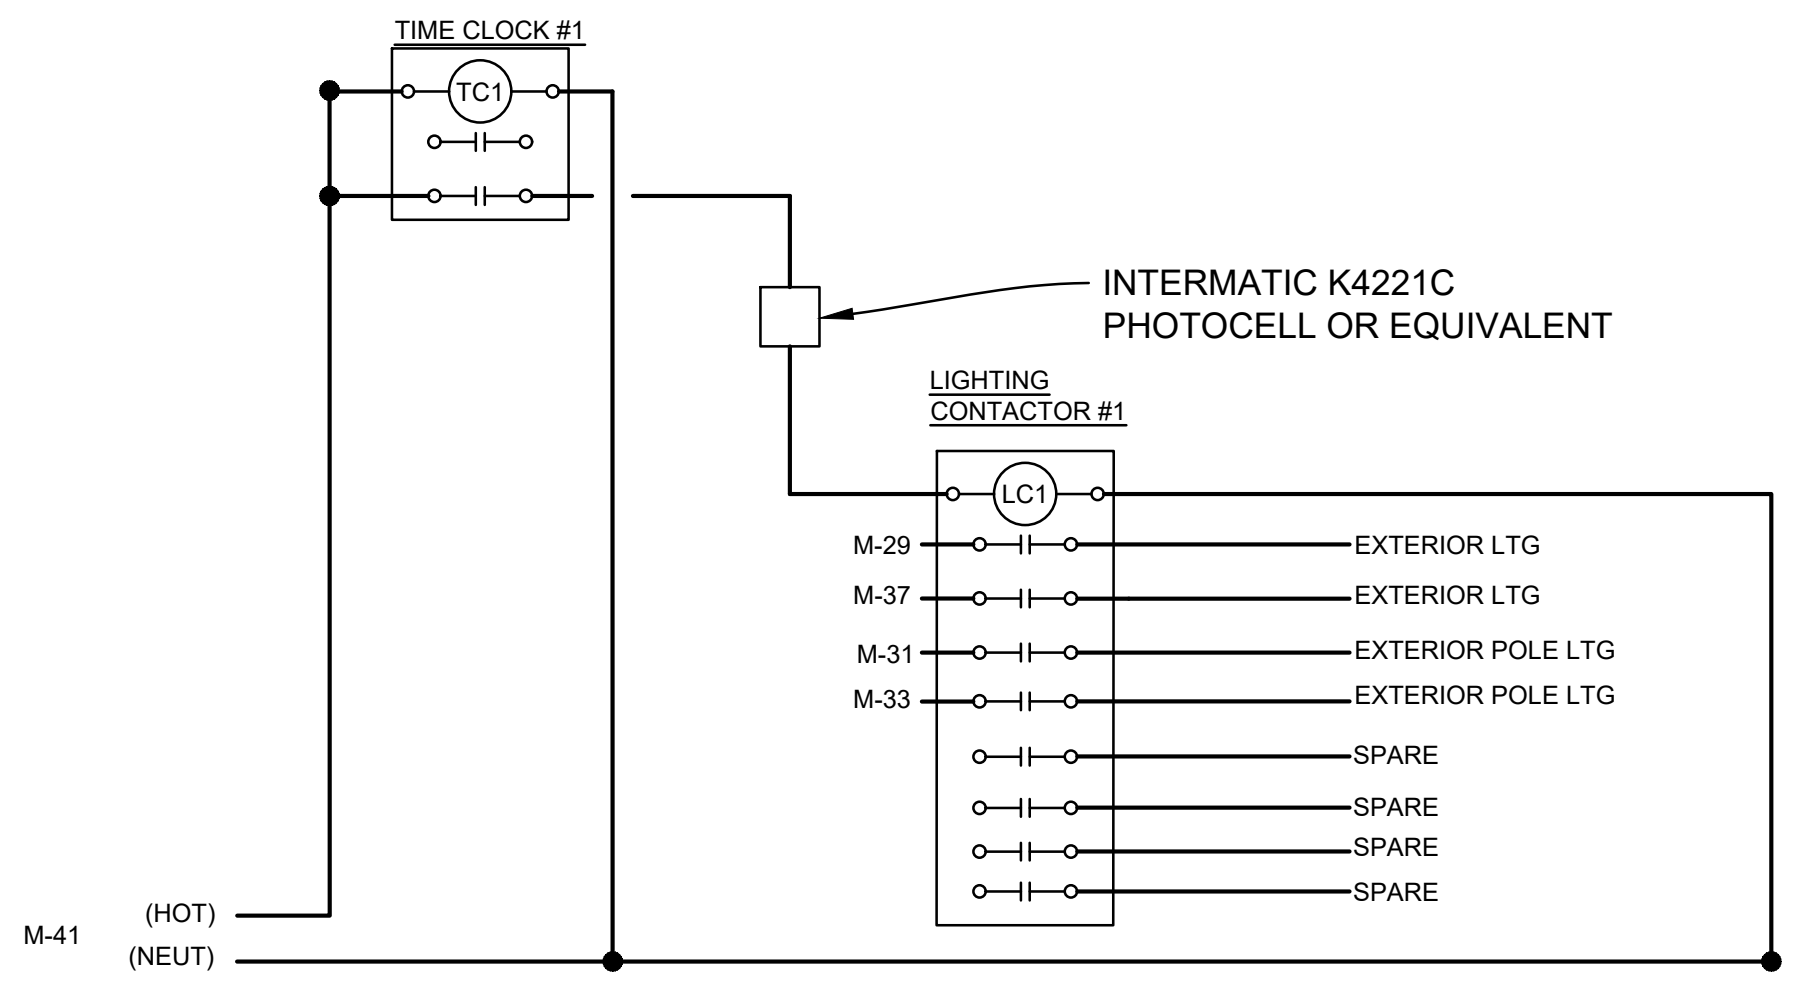

Panel Wiring Schedule (3-Phase)

Ckt. No.	Zone	Load Description	Brkr. Size	Brkr. Opts.	N.E.C. kVA	Phase	N.E.C. kVA	Brkr. Opts.	Brkr. Size	Load Description	Zone	Ckt. No.
1					0.000	A	0.000					2
3		FUTURE HVAC UNIT	80/3	HACR	0.000	B	0.000	HACR	80/3	FUTURE HVAC UNIT		4
5					0.000	C	0.000					6
7					0.000	A	0.000					8
9		FUTURE HVAC UNIT	50/3	HACR	0.000	B	0.000	HACR	50/3	FUTURE HVAC UNIT		10
11					0.000	C	0.000					12
13					0.000	A	0.000					14
15		SPARE	150/3		0.000	B	0.000		150/3	SPARE		16
17					0.000	C	0.000					18
19					0.000	A	0.000					20
21		SPARE	100/3		0.000	B	0.000		100/3	SPARE		22
23					0.000	C	0.000					24
25		RECEPT - INTERIOR			0.180	A	0.000			SPARE		26
27		RECEPT - EXT. GFI			0.180	B	0.000			SPARE		28
29		LTS - WALL PACK			0.984	C	0.000			SPARE		30
31		SITE LIGHT POLES			0.436	A	0.000			SPARE		32
33		SITE LIGHT POLES			0.436	B	0.000			SPARE		34
35		SPARE			0.000	C	0.000			SPARE		36
37		LTS - WALL PACK			0.861	A	0.000			SPARE		38
39		PYLON SIGN			0.000	B	0.000			SPARE		40
41		PHOTOCELL/CONTACTOR			0.000	C	0.000			SPARE		42

Notes:
 * All circuit breakers to be 20-Amp, 1-Pole unless otherwise noted.
 ** All Phases to be balanced to within 10% using Actual Load Totals.

Breaker Options:
 AS Powerlink AS Breaker
 LO Handle lock-on device
 ST Shunt Trip Type
 AUX Auxiliary Contacts
 PA Handle Padlock Attachment
 GFCI Ground Fault Circuit Interrupter
 HACR Heating, A/C & Refrigeration
 SF Subfeed
 AFCI Arc Fault Circuit Interrupter


Existing Circuit to remain
 Isolated Ground Circuit

Connected Load: 8.5 amps
 NEC Demand Feeder Load: 10.4 amps


ELECTRIC LOAD SUMMARY
208Y/120V SERVICE

DESCRIPTION	N.E.C. CONNECTED KVA	NEC DEMAND NOTES	N.E.C. DEMAND FACTOR	N.E.C. DEMAND KVA
LIGHTING (CONTINUOUS)	2.717	[1]	1.25	3.396
TRACK LIGHT DEMAND ALLOWANCE	-	[2]	-	0.000
SHOW WINDOW DEMAND ALLOWANCE	-	[3]	-	0.000
KIT APPLIANCE	0.000	[4]	1.00	0.000
RECEPTACLES	0.360	[5]	-	0.360
MOTORS	0.000	[6]	-	0.000
HVAC SYSTEM	0.000	[6]	-	0.000
HVAC SYSTEM - NON COINCIDENT	0.000	[7]	0.00	0.000
ELECTRIC WATER HEATER	0.000	-	1.00	0.000
EV CHARGING	0.000	-	1.25	0.000
MISCELLANEOUS	0.000	-	1.00	0.000
	3.077			3.756
N.E.C. DEM. KVA X 1000 SYS. VOLTAGE X 1.732 = MINIMUM FEEDER AMPERAGE				
3.756 X 1000 208 X 1.732 = 10.4 AMPS				

LOAD SUMMARY NOTES:
 [1] POWER FACTOR IS ALREADY INCLUDED IN LIGHTING LOAD.
 [2] 150VA/2FT OF LINE VOLTAGE TRACK + SUM LOW VOLTAGE XFRRMS - CONNECTED LOAD
 [3] 200VA/1F - ACTUAL CONNECTED LOAD
 [4] KIT APPLIANCE DEMAND FACTOR PER NEC 220-56
 [5] 0.0 < 10KW = 100%, REMAINING = 50%
 [6] 125% OF THE LARGEST MOTOR OR COMPRESSOR IN SYSTEM APPLIED ON ONE UNIT.
 [7] EQUIPMENT WILL NOT BE OPERATING WHILE SYSTEM IS AT MAXIMUM DEMAND.

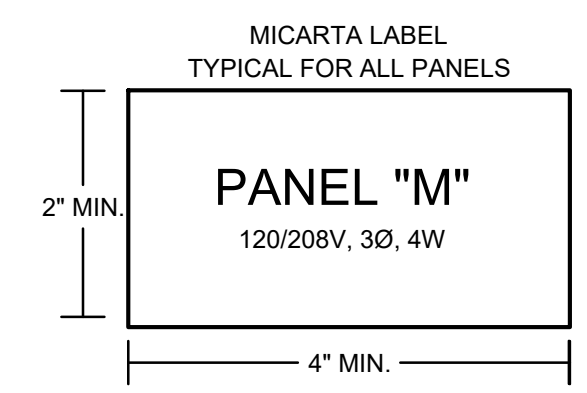

- RISER DIAGRAM CODED NOTES
- E.C. SHALL COORDINATE WITH THE LOCAL POWER COMPANY, SOUTH RIVER ELECTRIC MEMBERSHIP, TO OBTAIN NEW 600A 120/208V WYE SERVICE.
 - PROVIDE A CU GROUNDING ELECTRODE CONDUCTOR TO BUILDING STEEL, UNDERGROUND METAL WATERPIPE AND CONCRETE ENCASED ELECTRODE PER NEC 250-50. SEE DETAIL 1 ON THIS SHEET FOR MORE INFORMATION.
 - PROVIDE DUAL CHANNEL DIGITAL TIMECLOCK WITH PHOTOCELL TO CONTROL EXTERIOR LIGHTING. TORK MODEL DW200B.
 - VERIFY SHORT CIRCUIT REQUIREMENTS WITH LOCAL UTILITY COMPANY, SOUTH RIVER ELECTRIC MEMBERSHIP.

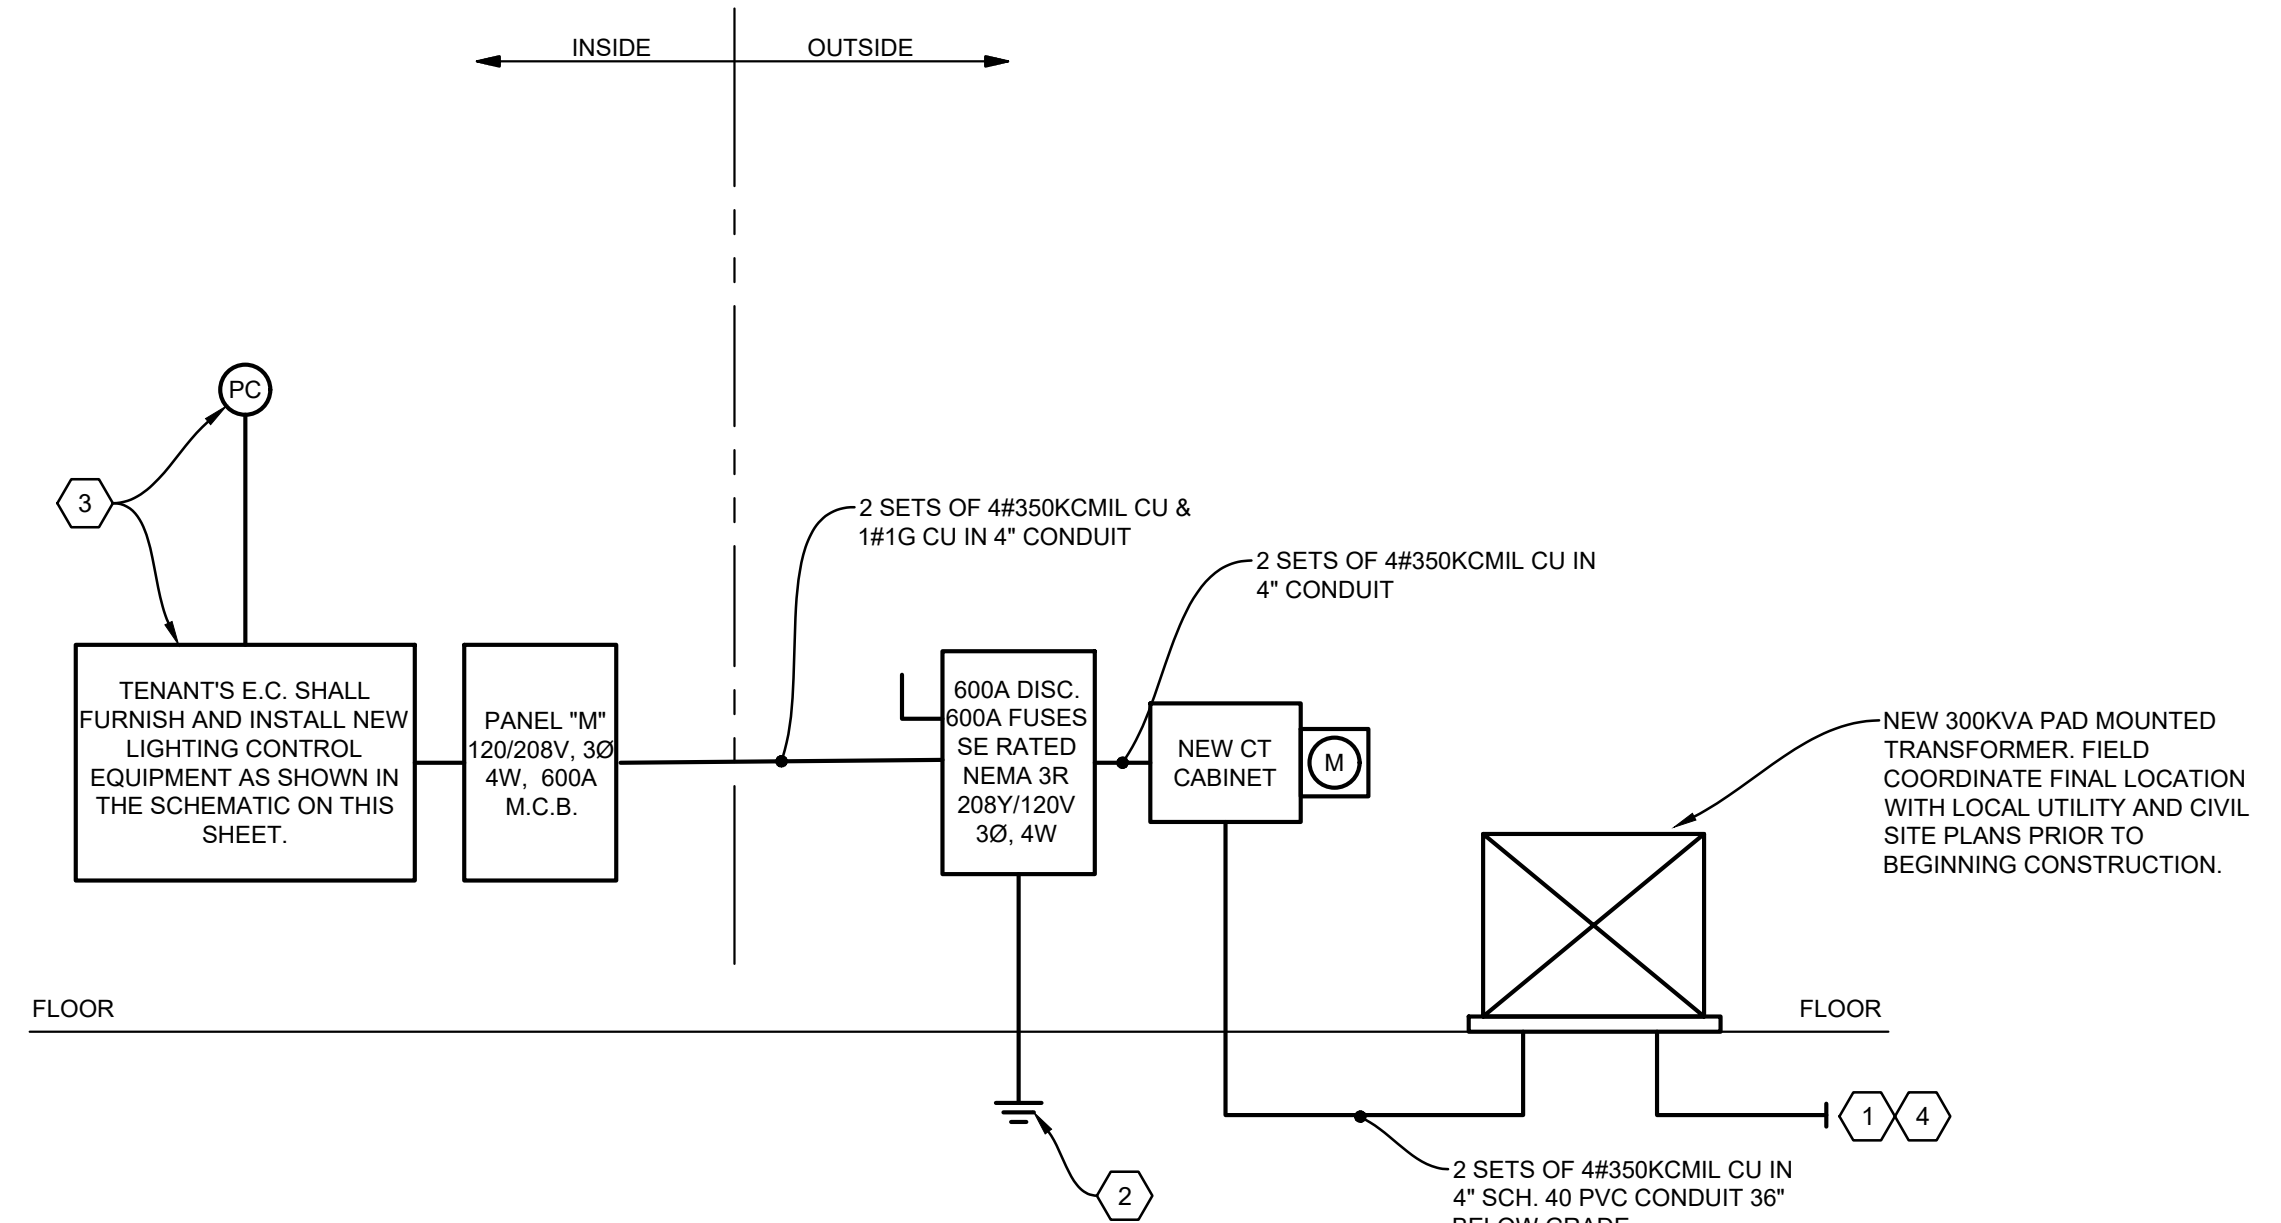

3 ELECTRICAL RISER DIAGRAM
N.T.S.

FIELD VERIFY ALL CONDITIONS

DESIGN DRAWINGS ARE SCHEMATIC. THIS CONTRACTOR SHALL VISIT THE SITE PRIOR TO BIDDING OR AWARD OF CONTRACT TO INSPECT EXISTING FIELD CONDITIONS. THIS CONTRACT SHALL INCLUDE ALL LABOR AND MATERIALS NECESSARY FOR FIELD MODIFICATIONS DUE TO EXISTING CONDITIONS.

THE CONTRACTOR SHALL CONTACT THE ARCHITECT, ENGINEER OR OWNER PRIOR TO BIDDING FOR INTERPRETATIONS AND CLARIFICATIONS OF THE DESIGN AND INCLUDE IN HIS BID ALL COSTS TO MEET THE DESIGN INTENT. CLARIFICATIONS MADE BY THE ARCHITECT, ENGINEER OR OWNER AFTER BIDDING WILL BE FINAL AND SHALL BE IMPLEMENTED AT CONTRACTORS COST.

BIDDING CONTRACTORS SHALL HAVE A WORKING KNOWLEDGE OF LOCAL CODES AND ORDINANCES AND SHALL INCLUDE IN THEIR BIDS THE COSTS FOR ALL WORK INSTALLED IN STRICT ACCORDANCE WITH GOVERNING CODES. THE PLANS AND SPECIFICATIONS NOT WITHSTANDING, THE CONTRACTOR SHALL ALERT ARCHITECT, ENGINEER OR OWNER OF ANY APPARENT DISCREPANCIES BETWEEN GOVERNING CODES AND DESIGN INTENT.

PROJECT NAME:

HARBOR
FREIGHT TOOLS
FOR
STOCKS & TAYLOR
CONSTRUCTION

PROJECT NO: 23174

PROJECT ADDRESS:

46 SHRIJI LANE
ERWIN, NC 28339

SEAL:



COPYRIGHT:

THIS DRAWING AND IT'S COPIES ARE THE ARCHITECT'S INSTRUMENTS OF SERVICE. THEY RETAIN ALL COMMON LAW AND STATUTORY RIGHTS, INCLUDING COPYRIGHT. THEY SHALL NOT BE USED OR COPIED FOR ANY PROJECT OTHER THAN THE ONE TITLED HERE IN.

DRAWING RELEASE:


NO.	DATE	DESCRIPTION

DRAWN BY: CF CHECKED BY: SH

DATE: 04/19/24

SHEET TITLE:
ELECTRICAL COVERSHEET

SHEET NUMBER:
E-1

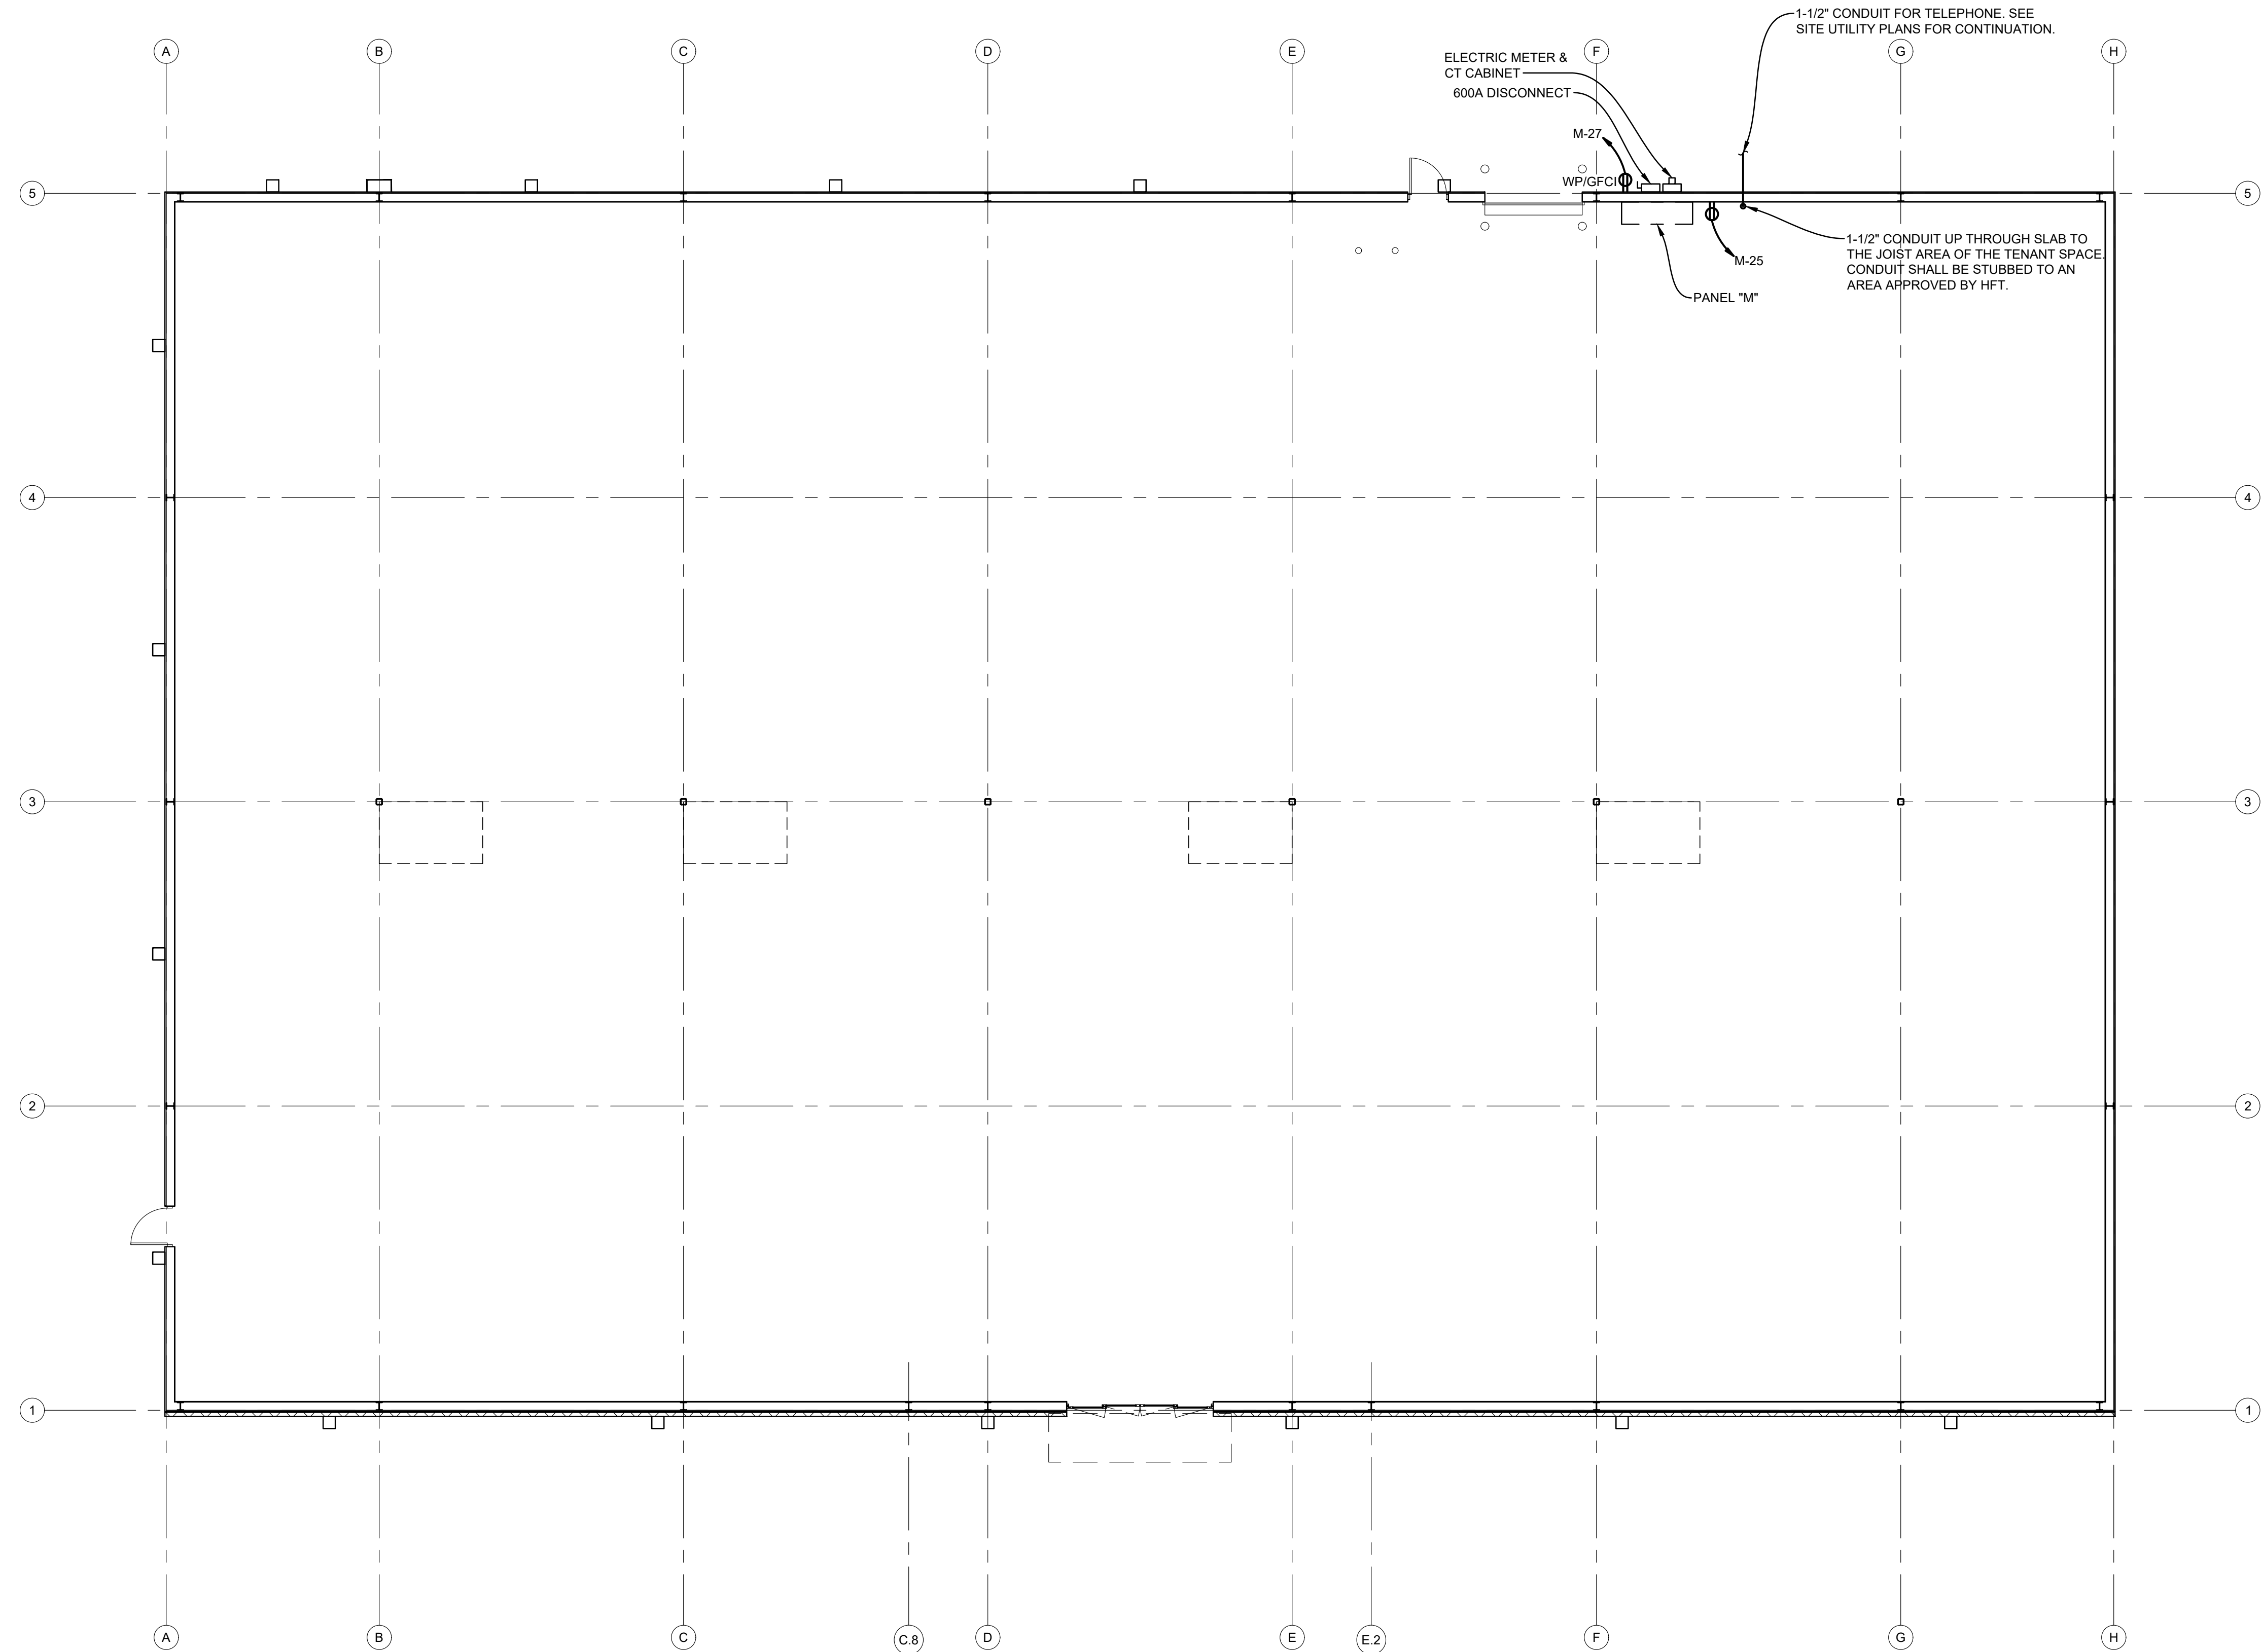

PROJECT NAME:

**HARBOR
 FREIGHT TOOLS**
 FOR
 STOCKS & TAYLOR
 CONSTRUCTION

PROJECT NO: 23174

PROJECT ADDRESS:

46 SHRIJI LANE
 ERWIN, NC 28339

SEAL:



COPYRIGHT:

THIS DRAWING AND ITS COPIES ARE THE ARCHITECT'S INSTRUMENTS OF SERVICE. THEY RETAIN ALL COMMON LAW AND STATUTORY RIGHTS, INCLUDING COPYRIGHT. THEY SHALL NOT BE USED OR COPIED FOR ANY PROJECT OTHER THAN THE ONE TITLED HERE IN.

DRAWING RELEASE:

NO.	DATE	DESCRIPTION

DRAWN BY: CF CHECKED BY: SH

DATE: 04/19/24

SHEET TITLE:
 ELECTRICAL SHELL PLAN


SHEET NUMBER:

E-2


Luminaire Schedule									
Symbol	Qty	Label	Arrangement	LLF	Description	Lum. Watts	Total Watts	Lum. Lumens	[MANUFAC]
PL-A	6	PL-A	SINGLE	0.890	LITH # RZR-PLED-IV-FT-80LED-350mA-40K-HS-RTA-16'-6E-DM19-F-B-C-COLOR	85.4	512.4	9255	U.S. ARCHITECTURAL LIGHTING
PL-B	2	PL-B	SINGLE	0.890	LITH # RZR-PLED-IV-40LED-875mA-40K-RTA-16'-6E-DM19-F-B-C-COLOR	108	216	14189	U.S. ARCHITECTURAL LIGHTING
WP-B	1	WP-B	SINGLE	0.890	LITH # WDGE4 LED P2 70CRI R3 40K	109.02	109.02	15911	Lithonia Lighting
WP-A	1	WP-A	SINGLE	0.890	LITH # WDGE2 LED P5 40K 80CRI VF	48.44	48.44	5998	Lithonia Lighting
WP-D	13	WP-D	SINGLE	0.890	LITH # WDGE4 LED P3 70CRI R4 40K	124.86	1623.18	18524	Lithonia Lighting
WP-C	2	WP-C	SINGLE	0.890	LITH # WDGE1 LED P1 40K 80CRI VF	10.0002	20.0004	1227	Lithonia Lighting



- SITE PLAN CODED NOTES**
- COORDINATE TELEPHONE/DATA REQUIREMENTS WITH LOCAL TELE/COMM PROVIDER. VERIFY EXACT LOCATIONS AND REQUIREMENTS IN FIELD PRIOR TO WORK COMMENCEMENT.
 - (2) #6 & (1) #8G IN 3/4" CONDUIT.
 - (2) #6 & (1) #8G IN 3/4" CONDUIT.
 - SEE DETAIL 1 ON THIS SHEET FOR MORE INFORMATION.
 - E.C. TO PROVIDE EXTERIOR EMERGENCY EGRESS LIGHTING. PROVIDE SPEC 'LED-WPS-29-TRI-BZ-EMB' OR EQUAL. CONNECT TO LOCAL EXTERIOR LIGHTING CIRCUIT AHEAD OF ALL SWITCHING AND CONTROLS.
 - E.C. TO PROVIDE CONDUIT AND PULL STRING FOR ROAD SIGN POWER ON NORTH SIDE OF PROPERTY. VERIFY EXACT LOCATION PRIOR TO WORK COMMENCEMENT.

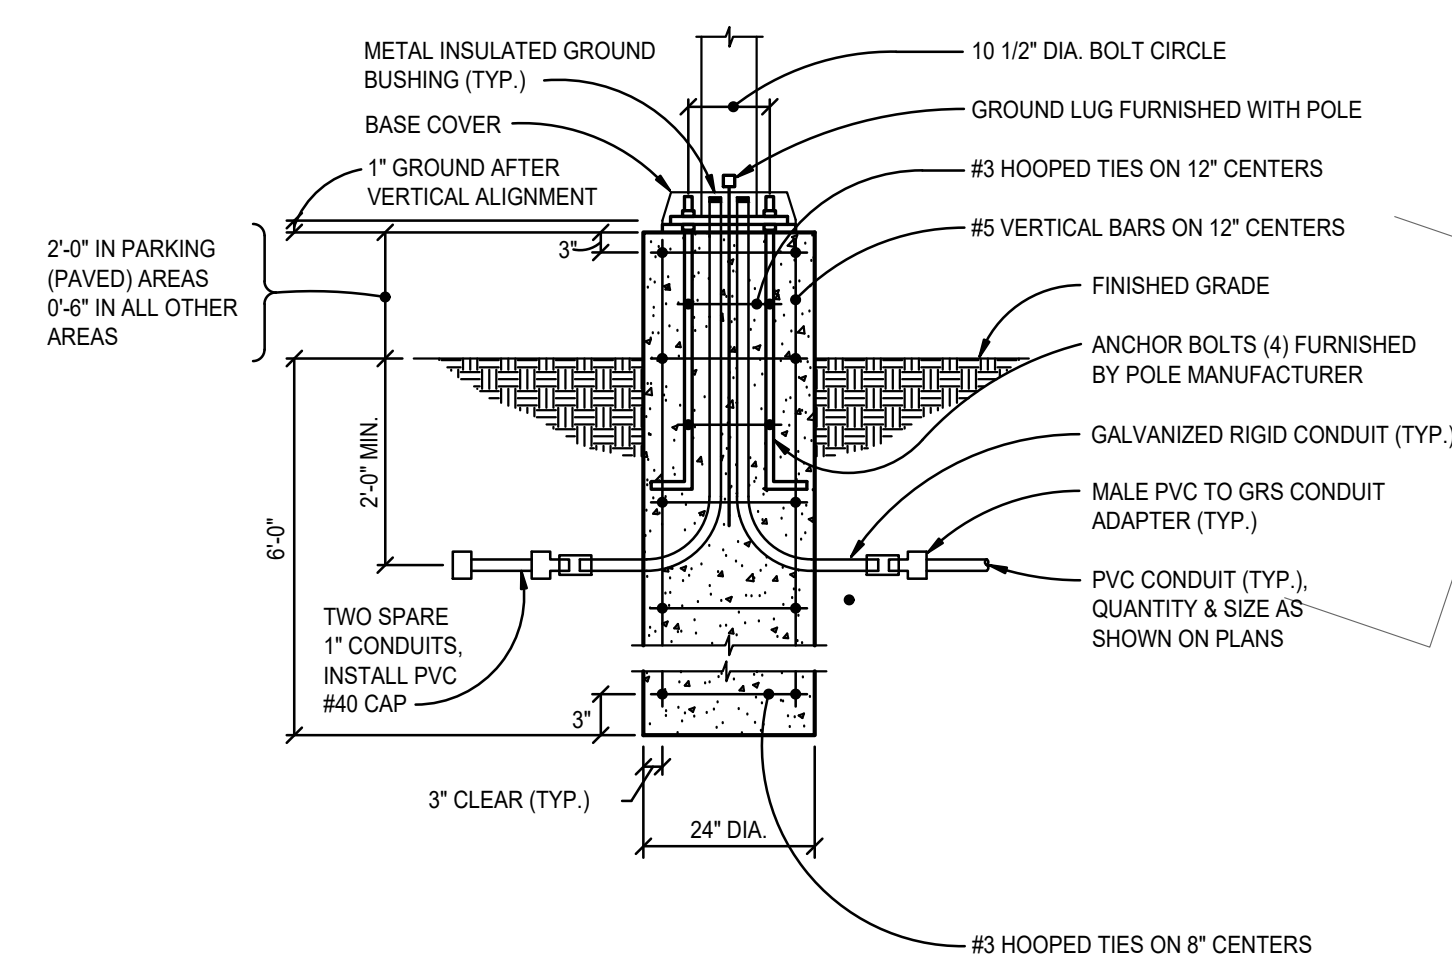

1 SITE LIGHTING POLE BASE DETAIL
N.T.S.

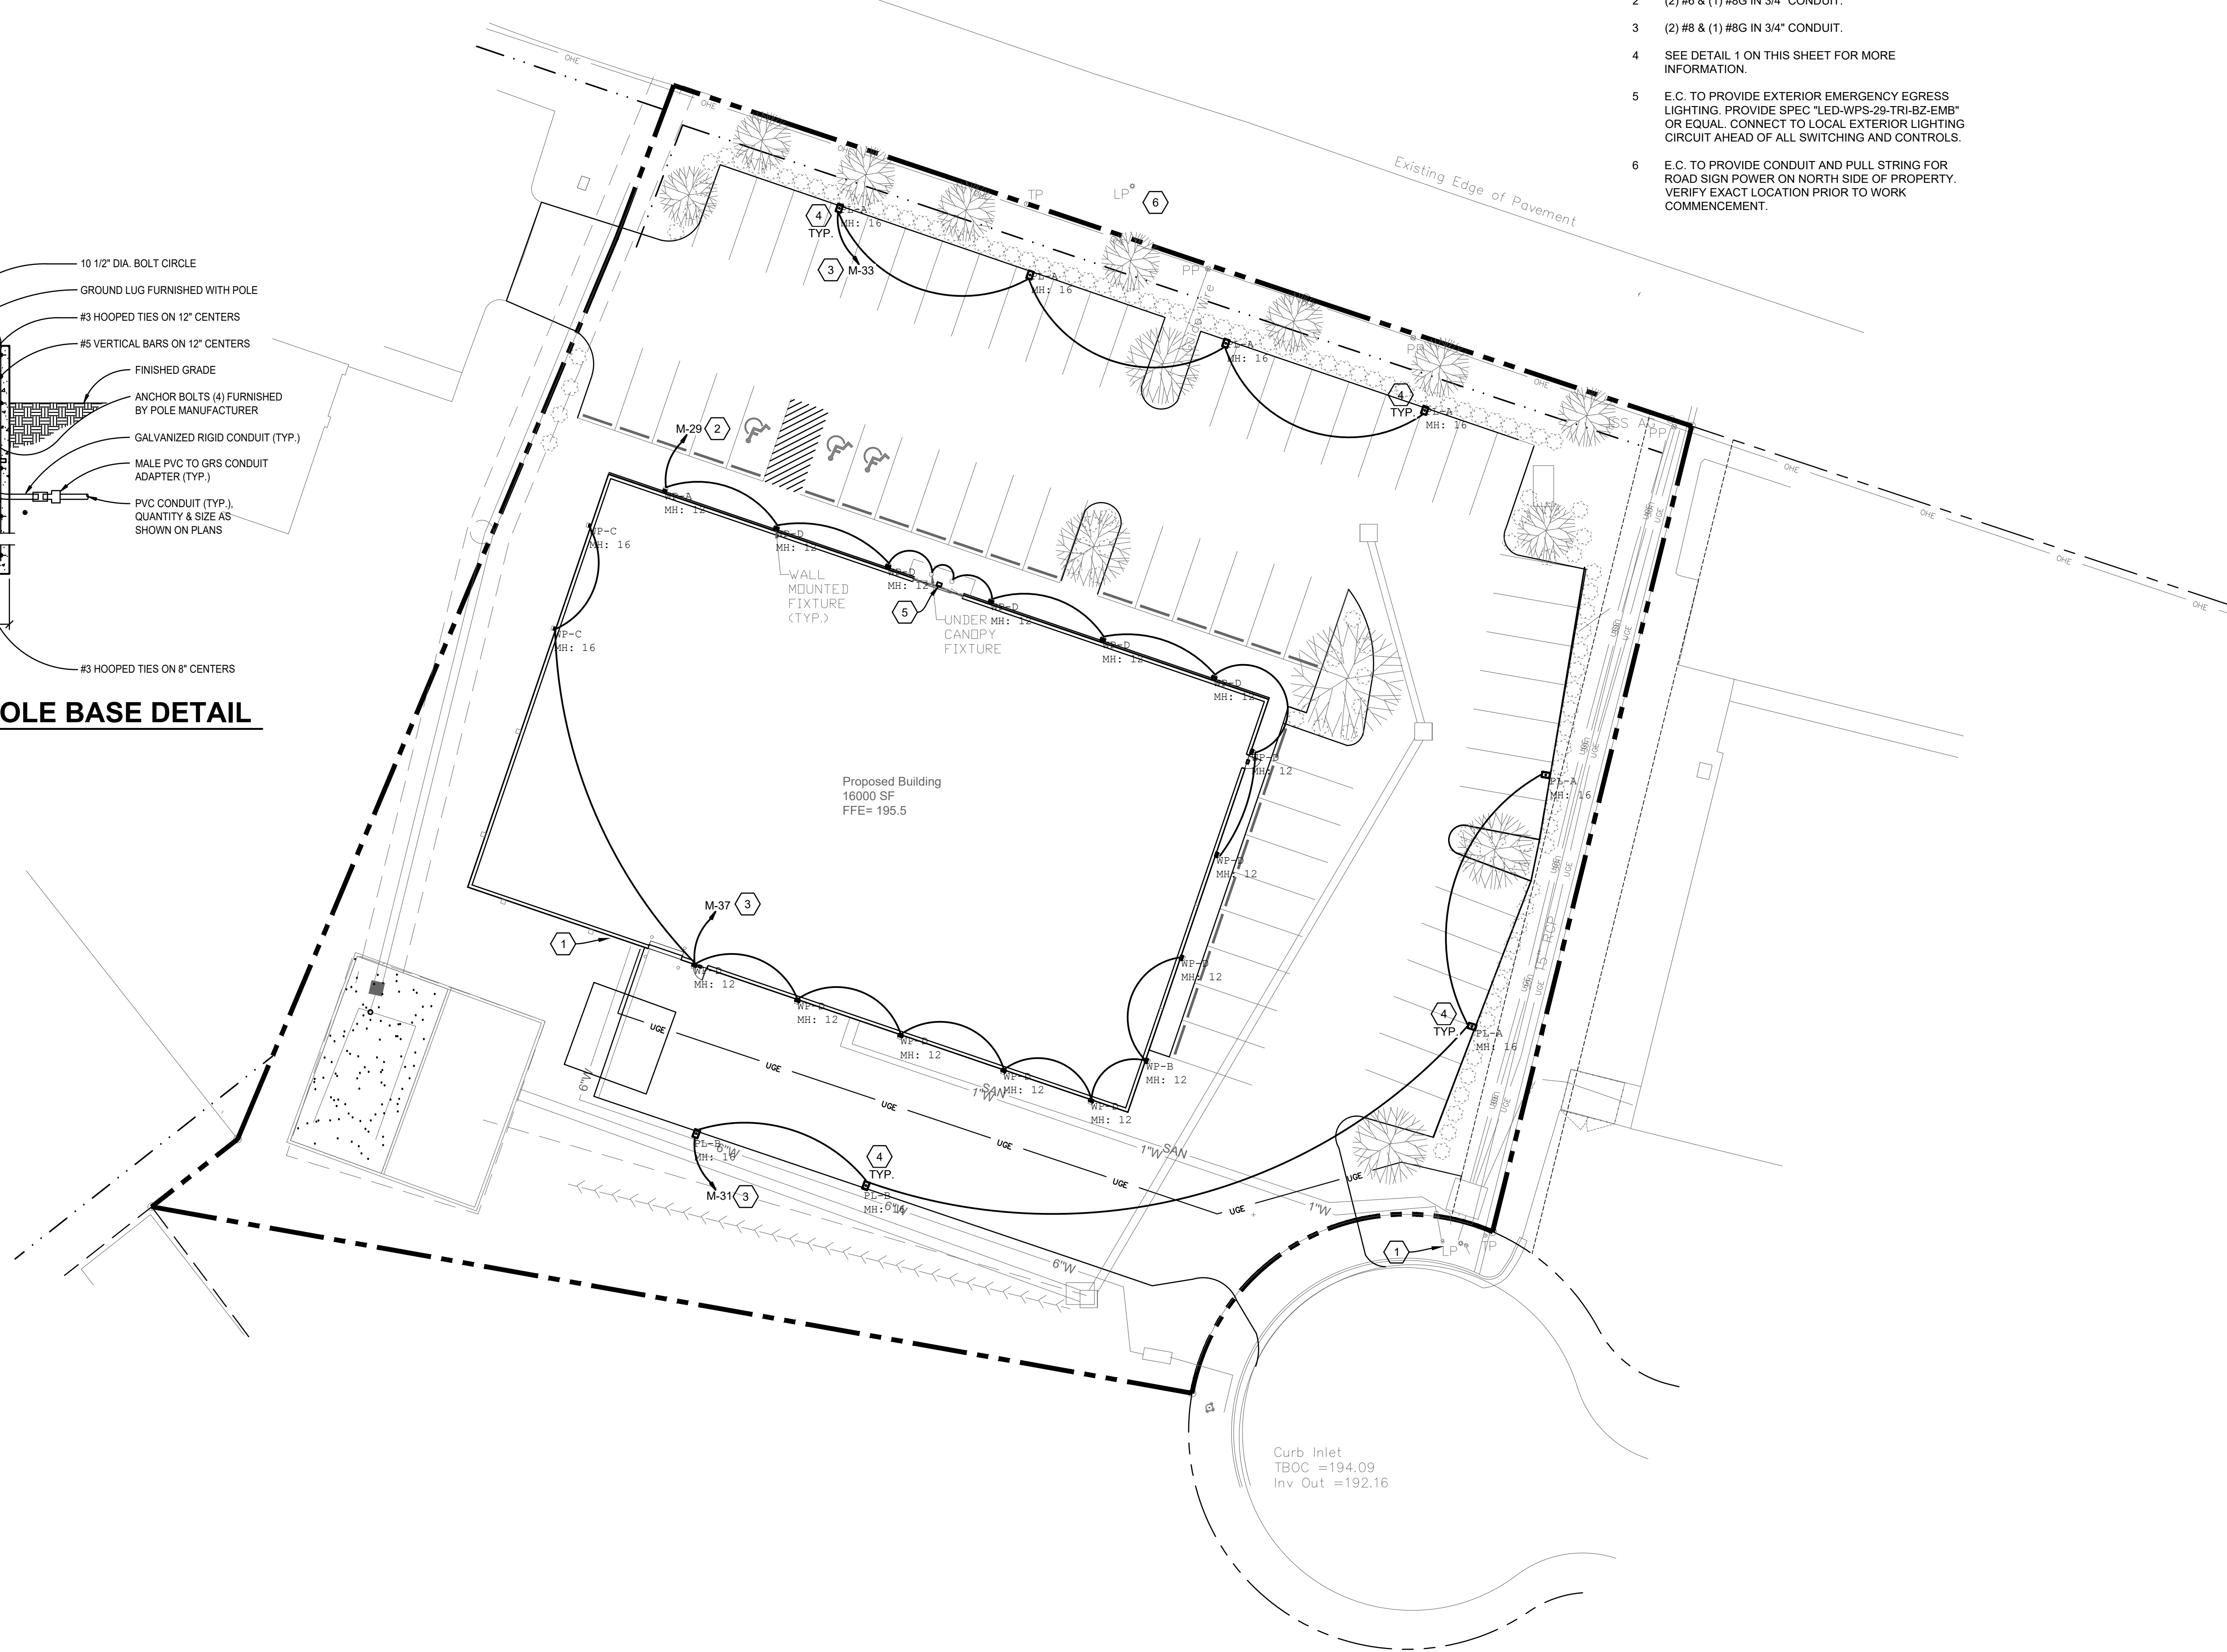

PROJECT NAME:

**HARBOR
FREIGHT TOOLS**
FOR
STOCKS & TAYLOR
CONSTRUCTION

PROJECT NO: 23174

PROJECT ADDRESS:

46 SHRIJI LANE
ERWIN, NC 28339

SEAL:



COPYRIGHT:

THIS DRAWING AND ITS COPIES ARE THE ARCHITECT'S INSTRUMENTS OF SERVICE. THEY RETAIN ALL COMMON LAW AND STATUTORY RIGHTS, INCLUDING COPYRIGHT. THEY SHALL NOT BE USED OR COPIED FOR ANY PROJECT OTHER THAN THE ONE TITLED HERE IN.

DRAWING RELEASE:

NO.	DATE	DESCRIPTION

DRAWN BY: CF
CHECKED BY: SH

DATE: 04/24/24

SHEET TITLE:
ELECTRICAL SITE PLAN

SHEET NUMBER:
E-3

ELECTRICAL SPECIFICATIONS

GENERAL CONDITIONS:

- A. THE REQUIREMENTS AS SET FORTH UNDER GENERAL CONDITIONS, INSTRUCTIONS TO BIDDERS AND GENERAL REQUIREMENTS ARE A PART OF THIS CONTRACT.
- B. BIDS SHALL BE BASED ON A COMPLETE/FULL SET OF DRAWINGS.
- C. CONTRACTOR MUST READ THE ENTIRE SPECIFICATIONS COVERING OTHER BRANCHES OF WORK AND IS RESPONSIBLE FOR COORDINATION OF THE WORK WITH WORK PERFORMED BY OTHER TRADES.

SCOPE OF WORK:

- A. CONTRACTOR SHALL VISIT SITE PRIOR TO BIDDING. BIDS SHALL SERVE AS EVIDENCE OF KNOWLEDGE OF EXISTING CONDITIONS. ALL REQUIREMENTS INCLUDING MODIFICATIONS WHICH ARE REQUIRED TO MEET THE INTENT OF THE DRAWINGS AND SPECIFICATIONS ARE TO BE OBTAINED BY ELECTRICAL CONTRACTOR PRIOR TO AND INCLUDED IN BID PRICE. FIELD VERIFY ALL EXISTING ELECTRICAL AND TELEPHONE EQUIPMENT, LOCATIONS, CONDITIONS ETC. FAILURE TO VISIT THE SITE SHALL NOT RELIEVE THE CONTRACTOR FROM ANY RESPONSIBILITY IN THE PERFORMANCE OF THE ELECTRICAL WORK.
- B. FURNISH ALL LABOR, MATERIALS, TESTING, EQUIPMENT, INCIDENTALS AND TOOLS TO PERFORM ELECTRICAL WORK SHOWN, NOTED OR SCHEDULED FOR A COMPLETE AND FINISHED INSTALLATION.
 - 1. MATERIALS, PRODUCTS AND EQUIPMENT, INCLUDING ALL COMPONENTS THEREOF, SHALL BE NEW AND AS SUCH APPEAR ON THE UNDERWRITERS LABORATORIES LIST OF APPROVED ITEMS AND SHALL BE SIZED IN CONFORMANCE WITH REQUIREMENTS OF THE LATEST EDITION OF THE NATIONAL ELECTRICAL CODE AND OTHER APPLICABLE CODES, WHICHEVER ARE MORE STRINGENT.
- C. THE WORK IS TO BE IN ACCORDANCE WITH THE LATEST EDITION OF THE NEC AND ALL APPLICABLE FEDERAL, STATE AND LOCAL CODES.
- D. INCLUDE ANY LABOR AND MATERIALS NOT SPECIFICALLY MENTIONED, BUT NECESSARY TO PROVIDE A COMPLETE AND FULLY OPERATIVE ELECTRICAL SYSTEMS.

PERMITS:

- A. SECURE AND PAY FOR ALL REQUIRED PERMITS, FEES, ASSESSMENTS AND INSPECTION CERTIFICATES THAT RELATE TO THE ELECTRICAL CONTRACT.
- B. FURNISH APPROVED CERTIFICATE OF FINAL INSPECTION, AND TURN OVER TO OWNER AT COMPLETION OF PROJECT.

DRAWINGS AND SPECIFICATIONS:

- A. THIS ELECTRICAL PLANS ARE DIAGRAMMATIC, NOT SHOWING EVERY ITEM IN EXACT LOCATION OR DETAIL. MEASUREMENTS AND LOCATIONS MUST BE FIELD VERIFIED AND COORDINATED WITH ARCHITECTURAL, PLUMBING, HVAC, FIRE PROTECTION, FIRE ALARM, STRUCTURAL, AND OTHER BUILDING DRAWINGS.

SHOP DRAWINGS:

- A. SUBMIT FIVE COPIES OF MATERIAL LISTS AND SHOP DRAWINGS FOR MAJOR EQUIPMENT TO THE OWNER'S CONSTRUCTION MANAGER FOR APPROVAL PRIOR TO ORDERING EQUIPMENT. CONTRACTOR SHALL SUBMIT SHOP DRAWINGS EARLY ENOUGH IN PROJECT TO ALLOW AMPLE TIME FOR OWNERS REVIEW WITHOUT CAUSING TIME DELAYS OR CONFLICTS IN THE JOB PROGRESS. SUBMITTALS SHALL BE IN ACCORDANCE WITH GENERAL CONDITIONS AND THE MANUFACTURERS LISTED ON THE DRAWINGS AND SHALL BEAR THE STAMP OF THE CONTRACTOR SHOWING THAT HE HAS REVIEWED AND APPROVED THEM AND THAT THEY ARE IN CONFORMANCE WITH THE CONTRACT DRAWINGS. LACK OF SUCH CONTRACTOR'S APPROVAL WILL BE CAUSE FOR REJECTION WITHOUT REVIEW BY THE OWNER.
- B. WHERE TRADE NAMES, BRANDS OF MANUFACTURERS OF EQUIPMENT OR MATERIALS ARE SHOWN ON THE DRAWINGS OR SPECIFICATIONS THE EXACT EQUIPMENT SHALL BE USED ON THE PROJECT. THE USE OF ANY UNAUTHORIZED EQUIPMENT SHALL BE SUBJECT TO REMOVAL/REPLACEMENT AT THE REQUEST OF THE OWNER'S CONSTRUCTION MANAGER (AT THE ELECTRICAL CONTRACTORS EXPENSE).

CONDUITS:

- A. CONDUIT SHALL BE STANDARD STEEL RIGID, IMC OR EMT (THIN WALL) ACCORDING TO LOCAL CODE AND LANDLORD REQUIREMENTS. CONDUIT SHALL BE CONCEALED IN FINISHED AREAS, EXCEPT AS OTHERWISE APPROVED BY ARCHITECT. EMT CONNECTIONS SHALL BE COMPRESSION OR SET SCREW TYPE.
- B. FLEXIBLE CONDUIT OR TYPE MC CABLE SHALL BE USED FOR FINAL CONNECTIONS TO LIGHT FIXTURES, MOTORS AND VIBRATING EQUIPMENT ONLY; AND WHERE SO USED TO BE GROUNDED WITH A SEPARATE FULL SIZED GREEN GROUNDING CONDUCTOR. FINAL TYPE MC/FLEX CONNECTIONS SHALL BE LIMITED TO 6'-0" IN LENGTH. (ARRANGE CIRCUITS SO AS TO AVOID THE USE OF JUNCTION BOXES ABOVE DRYWALL CEILING AREAS, JUNCTION BOXES LOCATED ABOVE LAY-IN CEILINGS ARE ACCEPTABLE.)

- 1. MINIMUM SIZES OF CONDUITS SHALL BE 3/4" FOR STANDARD CONDUIT, AND 1/2" FOR FLEX CONDUIT (1/2" STANDARD CONDUIT AND 3/8" MC CABLE MAY BE USED AS SPECIFIED ABOVE, IF ACCEPTABLE WITH LANDLORD AND LOCAL CODES, ELECTRICAL CONTRACTOR SHALL FIELD COORDINATE WITH LANDLORD & INSPECTION AGENCIES PRIOR TO INSTALLATION). ELECTRIC METALLIC TUBING (EMT) SHALL BE GALVANIZED OR ELECTRO-GALVANIZED. FITTINGS SHALL BE SET SCREW OR COMPRESSION TYPE, FITTING SHALL BE AS MANUFACTURED BY REGEL, STEEL CITY, RACO, T & B, EFCOR OR EQUAL. EMT SHALL BE USED FOR FEEDERS AND BRANCH CIRCUITS RUN ABOVE SUSPENDED CEILING OR CONCEALED IN INTERIOR PARTITIONS.
- 2. PAINTING OF ELECTRICAL CONDUITS, ETC., IF REQUIRED, WILL BE BY GENERAL CONTRACTOR.
- C. THE USE OF ROMEX OR BX IS NOT PERMITTED.
- D. MAXIMUM CONDUIT HANGER SPACING SHALL BE 8'-0" FOR 3/4" THRU 1 1/4" AND 10'-0" FOR 1 1/2" THRU 4" CONDUITS. DO NOT SUPPORT CONDUIT FROM THE CEILING SYSTEM.

- E. LEAVE A #10 AWG PULL WIRE OR NYLON PULL STRING IN ALL EMPTY CONDUITS.
- F. SECURE ALL RACEWAYS TO THE BUILDING STRUCTURE IN A RIGID AND SECURE MANNER, USING FASTENERS SUCH AS "CADDY CLIPS" OR EQUAL.
- G. FLASH AND COUNTERFLASH ALL RACEWAYS WHICH PENETRATE THE ROOF OR USE PITCH POCKETS. INSURE THAT PENETRATIONS ARE COMPLETELY WEATHERPROOF. ALL RACEWAY SYSTEMS EXPOSED TO THE WEATHER SHALL BE WEATHERPROOF. PRIOR APPROVAL BY LANDLORD IS REQUIRED TO ADD ADDITIONAL EQUIPMENT LOADS TO STRUCTURE OR TO MAKE HOLES IN EXISTING ROOF. NOTIFY LANDLORD'S ROOFING CONTRACTOR AT LEAST 72 HOURS PRIOR TO ANY REQUIRED ROOF WORK.

WIRE:

- A. WIRE SHALL BE SINGLE CONDUCTOR COPPER WITH 600 VOLT INSULATION. MINIMUM WIRE SIZE SHALL BE #12 AWG, ALL WIRE AND CABLE SHALL BE NEW AND SHALL BE BROUGHT TO THE SITE IN UNBROKEN PACKAGES. ALL WIRING OF ANY TYPE SHALL BE IN CONDUIT. NO STRANDED WIRE ALLOWED FOR #10 AND #12 AWG SIZES. (INCREASE CONDUCTOR BY ONE SIZE FOR EVERY 150' INCREMENT OF DISTANCE FROM THE PANEL BOARD FOR 120 VOLT CIRCUITS.)

- 1. GENERAL WIRING SHALL BE THW OR THHN. (ALUMINUM CONDUCTORS ARE NOT PERMITTED.)
- B. WIRE CONNECTORS SHALL BE EQUAL TO SCOTCHLOCK FOR #8 AND SMALLER, AND EQUAL TO T & B 'LOCK-TITE' FOR #6 AND LARGER.
- C. THE USE OF SHARED NEUTRALS IS ACCEPTABLE FOR LIGHTING AND RECEPTACLE CIRCUITS IF INSTALLED IN ACCORDANCE WITH N.E.C. #310, AND LOCAL CODES.
- D. ALL WIRING TO BE COLOR CODED AS FOLLOWS:

120/208 VOLT SYSTEM	277/480 VOLT SYSTEM
NEUTRAL - WHITE PHASE A OR L1-BLACK PHASE B OR L2-RED PHASE C OR L3-BLUE GROUND-GREEN	NEUTRAL - WHITE WITH TRACER OR GRAY PHASE A OR L1 - BROWN PHASE B OR L2-ORANGE PHASE C OR L3-YELLOW GROUND-GREEN WITH TRACER

LIGHTING:

- A. LIGHTING FIXTURES AND LAMPS SHALL BE FURNISHED AS SCHEDULED ON THE LIGHTING FIXTURE SCHEDULE. FLUORESCENT FIXTURES SHALL HAVE HPF BALLASTS WITH EFFICIENCY FACTORS IN ACCORDANCE WITH LOCALLY ADOPTED ENERGY CODE.
 - B. LIGHT FIXTURES SHALL BE SUPPORTED FROM THE BUILDING STRUCTURAL VIA ALL THREAD AND UNI-STRUT, AND NOT SUPPORTED BY CEILING SYSTEM.
- WIRED GROUND SYSTEM:
- A. FURNISH AND INSTALL A COMPLETE WIRED GROUNDING SYSTEM FOR ELECTRICAL EQUIPMENT AND CIRCUITS AS SHOWN ON THE DRAWINGS AND DESCRIBED GENERALLY BELOW.
 - B. ALL GROUNDING CONDUCTORS SHALL BE GREEN, WHERE EXPOSED IN PANEL, SWITCHBOARD, OUTLET, BOXES, ETC.
 - C. ALL ENCLOSURES AND NON-CURRENT CARRYING METALS TO BE GROUNDED. CONDUIT SYSTEM TO BE ELECTRICALLY CONTINUOUS. ALL LOCK NUTS MUST CUT THROUGH ENAMELED OR PAINTED SURFACES ON ENCLOSURES. WHERE ENCLOSURES AND NON-CURRENT CARRYING METALS ARE ISOLATED FROM THE CONDUIT SYSTEM, USE BONDING JUMPERS WITH APPROVED CLAMPS.
 - D. RUN A SEPARATE GROUNDING CONDUCTOR IN EACH CONDUIT, #12 MINIMUM, OR AS SHOWN ON DRAWINGS. FOR PANEL FEEDERS BOND THE GROUNDING CONDUCTOR TO THE CONDUIT, WHERE ENTERING AND LEAVING THE CONDUIT. ALL GROUND CLAMPS SHALL BE PENN-UNION OR EQUAL, SIMILAR TO "GPL" TYPE. CONDUIT GROUND BUSHINGS SHALL BE THOMAS & BETTS OR EQUAL, SIMILAR TO #3800 SERIES WITH NYLON INSULATED THROAT.
 - E. ALL DEVICES SHALL BE BONDED TO THE CONDUIT SYSTEM. USE A BONDING JUMPER BETWEEN THE OUTLET BOX AND THE DEVICE GROUNDING TERMINAL. METAL-TO-METAL CONTACT BETWEEN THE DEVICE YOKE AND THE OUTLET BOX IS NOT ACCEPTABLE AS A BOND FOR EITHER SURFACE MOUNTED BOXES OR FLUSH TYPE BOXES. ALL JUNCTION BOXES, OUTLET BOXES AND PULL BOXES SHALL BE BONDED TO THE CONDUIT SYSTEM. ALL FLEXIBLE CONDUIT SHALL BE JUMPERED WITH A GROUND CONDUCTOR.

WIRE DEVICES:

- A. COLOR OF WIRING DEVICES AND COVERPLATES SHALL BE SELECTED BY ARCHITECT. (SEE PLAN NOTES FOR ADDITIONAL INFORMATION).
- 1. RECEPTACLES SHALL BE 20 AMP, 3-WIRE GROUNDING TYPE EQUAL TO HUBBELL 5362.
- 2. SWITCHES SHALL BE 20 AMP SPECIFICATION GRADE, RATED AT 120 OR 277 VOLT, AS REQUIRED.
- 3. SPECIAL DEVICES SHALL BE A SPECIFICATION GRADE.
- 4. FLOOR BOXES TO BE HUBBELL #5627/29 WITH ALUMINUM COVER (OR EQUAL BY 'STEEL CITY') AND HUBBELL 5362 RECEPTACLE (UNLESS OTHERWISE NOTED)
- 5. EQUAL BY ARROW-HART, GENERAL ELECTRIC, BRYANT, PASS & SEYMOUR, OR SIERRA.

PANELBOARDS AND SAFETY SWITCHES:

- A. PROVIDE BRANCH CIRCUIT PANELS WHICH SHALL BE OF THE BOLTED CIRCUIT BREAKER TYPE WITH SOLID COPPER BUSSING FULL SIZED NEUTRAL, 25% GROUND BUSSING, OVERALL HINGED/LOCKABLE DOOR, AND TYPEWRITTEN DIRECTORY INSIDE DOOR. ALL SERVICE ENTRANCE EQUIPMENT SHALL BEAR THE MANUFACTURER'S LABEL WHICH SHALL STATE THAT THE EQUIPMENT IS RATED FOR SERVICE ENTRANCE APPLICATION IN ACCORDANCE WITH N.E.C. #230-70. LOAD BALANCE ALL ELECTRICAL PHASES AT PANELS AND SWITCHBOARDS. TWO AND THREE POLE BREAKERS SHALL BE COMMON TRIP TYPE. WHEN USED AS SWITCHES IN 120V. AND 277V. LIGHTING CIRCUITS, FURNISH TYPE "SMD" BREAKERS IN ACCORDANCE WITH N.E.C. #240-63B. SQUARE D OR EQUAL BY SIEMENS ITE, CUTLER-HAMMER, OR GENERAL ELECTRIC (OR APPROVED EQUAL).
- B. PROVIDE SAFETY AND DISCONNECT SWITCHES, FUSED OR NONFUSED, AS CALLED FOR ON DRAWINGS AND AS REQUIRED BY CODE. (FUSES AS MANUFACTURED BY BUSSMAN, CHASE SHAWMUT, ECONOMY FUSE CO., OR LITTLE FUSE CO. ARE ACCEPTABLE). DISCONNECT SWITCHES THAT ARE INSTALLED AT AIR CONDITIONING EQUIPMENT, HEAT PUMPS, ETC SHALL BE FUSED IN ACCORDANCE WITH THE EQUIPMENT'S NAME PLATE REQUIREMENTS PER N.E.C. 440-21 & 110-3B. SWITCHES SHALL BE HEAVY DUTY, QUICK MAKE/QUICK BREAK TYPE, FUSIBLE OR NON-FUSIBLE, WEATHERPROOF AS INDICATED ON THE DRAWINGS, OR AS REQUIRED BY LOCAL CODES. LOAD AND HORSEPOWER RATED AS MANUFACTURED BY SQUARE D, SIEMENS ITE, CUTLER HAMMER, OR GENERAL ELECTRIC (OR APPROVED EQUAL).
- C. MANUAL MOTOR STARTERS WITH OVERLOAD PROTECTION MAY BE USED FOR FRACTIONAL HORSEPOWER MOTORS THAT DO NOT REQUIRE AUXILIARY CONTROL. SINGLE PHASE STARTERS SHALL BE SQUARE D OR EQUAL. THREE PHASE STARTERS SHALL BE PROVIDED WITH OVERLOAD DEVICE IN EACH PHASE MATCHED TO MOTOR NAMEPLATE RATING. MAGNETIC MOTOR STARTERS (MINIMUM SIZE #1) SHALL BE USED FOR ALL SINGLE PHASE AND THREE PHASE MOTORS RATED ABOVE 1/2 HP OR THAT REQUIRE AUXILIARY CONTROL. PROVIDE CONTROL DEVICES (CONTACTS, TRANSFORMERS, ETC.) IN STARTERS AS REQUIRED FOR INTERLOCKS, COORDINATION WITH MECHANICAL AND/OR TEMPERATURE CONTROL CONTRACTORS. COMBINATION STARTERS, WHEN USED, SHALL CONTAIN FUSIBLE SWITCHES.

BOXES:

- A. OUTLET BOXES AND COVERS SHALL BE GALVANIZED, ONE-PIECE PRESSED STEEL KNOCKOUT.
- B. JUNCTION, PULL BOXES AND COVERS SHALL BE GALVANIZED STEEL, CODE GAUGE SIZE.
- C. INSTALL BOXES RIGIDLY ON BUILDING STRUCTURE AND SUPPORT INDEPENDENTLY OF THE CONDUIT SYSTEM. ALSO PROVIDE SUITABLE/PROPER BOX EXTENSIONS TO EXTEND BOXES TO FINISHED FACES OF WALLS ETC. ALL OUTLET BOXES TO HAVE SUITABLE BLOCKING BEHIND THEM TO MINIMIZE THE DEFLECTION THAT OCCURS WHEN PLUGGING/UNPLUGGING INTO THESE DEVICES.
- D. WHERE A 277 VOLT LIGHT SWITCH IS GANGED WITH A 120 VOLT RECEPTACLE PROVIDE A SUITABLE DIVIDER OR SEPARATE JUNCTION BOXES IN ACCORDANCE WITH NEC AND LOCAL CODES.
- E. ELECTRICAL CONTRACTOR SHALL LABEL ALL JUNCTION BOXES, NOT LOCATED IN WALLS, WITH TYPE OF CABLING WITHIN BOX (IE: "FIRE ALARM SIGNAL CIRCUIT" OR "LIGHTING CIRCUIT X-XX"). LABELING SHALL BE LOCATED ON BOX COVER AND APPLIED WITH PERMANENT BLACK MARKER.

SERVICES:

- A. ELECTRICAL CONTRACTOR SHALL PROVIDE TEMPORARY SERVICE FROM LANDLORD'S DESIGNATED LOCATION AND PROVIDE LIGHTING, POWER AND WIRING AS REQUIRED TO FACILITATE APPLICABLE TEMPORARY NEEDS, AND FURNISH EXTENSION CORDS. ANY TEMPORARY WIRING, FUSES, ETC., SHALL BE REMOVED UPON COMPLETION OF THE PROJECT. PROVIDE GROUND FAULT PROTECTION AS REQUIRED BY N.E.C. AND LOCAL CODES.
- B. PROVIDE ELECTRICAL SERVICE AS SHOWN ON THE DRAWINGS, FIELD VERIFY EXACT REQUIREMENTS PRIOR TO BIDS. ALL WORK NOT SPECIFICALLY NOTED AS BEING BY THE LANDLORD OR POWER COMPANY SHALL BE PROVIDED BY THE ELECTRICAL CONTRACTOR. CLOSELY COORDINATE ENTIRE INSTALLATION WITH LANDLORD AND POWER COMPANY AS REQUIRED. (PROVIDE EQUIPMENT THAT IS COMPATIBLE WITH AVAILABLE FAULT CURRENT LEVELS, PROVIDE "CABLE LIMITERS" IF NECESSARY FOR SYSTEM COORDINATION). FIELD VERIFY EXACT TYPE, SIZE, LOCATION, REQUIREMENTS, ETC. OF EXISTING POWER AND TELEPHONE FACILITIES PRIOR TO BIDDING PROJECT.
- C. MAKE PROVISIONS FOR NEW TELEPHONE SERVICE AS REQUIRED, AND AS INDICATED ON THE DRAWINGS.
- D. CONDUIT SYSTEM FOR TELEPHONE DISTRIBUTION WITHIN TENANT'S PREMISES SHALL BE PROVIDED AS REQUIRED FOR A COMPLETE TELEPHONE SYSTEM. OUTLET BOXES SHALL BE 4" SQUARE TELEPHONE SYSTEM. MINIMUM WITH SINGLE DEVICE COVER AND TELEPHONE PLATE CLOSELY FIELD COORDINATE WITH TENANTS CONSTRUCTION MANAGER TO AVOID CONFLICTS.

STEP-DOWN TRANSFORMER: (IF APPLICABLE)

- A. PROVIDE DRY-TYPE TRANSFORMER AS MANUFACTURED BY SQUARE "D", HEAVY DUTY, ACME, GENERAL ELECTRIC, SIEMENS ITE OR OTHER EQUIVALENT MANUFACTURERS, OF THE ENCLOSED VENTILATED TYPE WITH KVA AND VOLTAGE RATINGS AS CALLED FOR ON THE DRAWINGS WITH COILS DESIGNED FOR 150 DEGREE C RISE ABOVE A 40 DEGREE C AMBIENT WITH 100% OF RATED LOAD CONNECTED TO THE SECONDARY, CLASS 220 DEGREE C INSULATION AND A MINIMUM OF SIX STANDARD FULL CAPACITY TAPS (TWO ABOVE AND FOUR BELOW NORMAL). TRANSFORMER SHALL BE IN ACCORDANCE WITH THE U.S. DEPARTMENT OF ENERGY (DOE) 2016 EFFICIENCY STANDARDS. SOUND LEVEL/DECIBELS SHALL BE IN ACCORDANCE WITH "NEMA" STANDARDS, AND INSTALLATION SHALL INCLUDE "KORFOUNED" OR EQUAL VIBRATION-DAMPENING MOUNTS AND FLEXIBLE STEEL CONDUIT FOR PRIMARY AND SECONDARY CONNECTIONS TO MINIMIZE SOUND TRANSMISSION. MOUNT TRANSFORMER ON SEPARATE VIBRATION ISOLATORS. THESE ARE ADDITIONAL VIBRATION ISOLATORS AND ARE USED IN CONJUNCTION WITH ANY INTEGRAL FACTORY INSTALLED VIBRATION ISOLATORS.

LIGHTING CONTACTOR AND TIMER SWITCHES:

- A. CONTACTORS FOR CONTROL OF LIGHTING AND SIGNS SHALL BE SQUARE "D", CLASS 8903, TYPE "L", ELECTRICALLY HELD. EQUIVALENT PRODUCTS BY OTHER MANUFACTURERS ARE PERMITTED.
- B. ELECTRONIC DIGITAL TIME SWITCHES SHALL BE USED FOR CONTROL OF SHOW WINDOW LIGHTING, SIGNS, AND IF REQUIRED/DESIRED OTHER LIGHTING. THE ELECTRONIC DIGITAL TIMER SHALL BE A TORK MODEL DWZ100A OR EQUIVALENT WITH A 7-DAY FORMAT, 365 DAY ADVANCED HOLIDAY SCHEDULE, CAPABLE OF DIFFERENT SETTINGS EACH DAY OF THE WEEK, AND HAVE AN ASTRONOMIC FEATURE.

INSTALLATION:

- A. ALL ELECTRIC WORK SHALL BE INSTALLED SO AS TO BE READILY ACCESSIBLE FOR OPERATING, SERVICING, MAINTAINING AND REPAIRING. HANGERS SHALL INCLUDE ALL MISCELLANEOUS STEEL SUCH AS CHANNELS, RODS, ETC., NECESSARY FOR THE INSTALLATION OF WORK AND SHALL BE FASTENED TO BUILDING STEEL, CONCRETE OR MASONRY, BUT NOT PIPING OR DUCTWORK. ALL CONDUIT SHALL BE CONCEALED WHEREVER POSSIBLE. EXPOSED CONDUITS SHALL BE IN STRAIGHT LINES PARALLEL WITH OR AT RIGHT ANGLES TO COLUMN LINES OR BEAMS AND SEPARATED AT LEAST 3 INCHES FROM WATER LINES WHEREVER THEY RUN ALONGSIDE OR ACROSS SUCH LINES. ALL CONDUCTORS SHALL BE IN CONDUIT, DUCTS OR OTHER CODE APPROVED RACEWAYS.

- B. ALL LINE AND LOW VOLTAGE POWER AND CONTROL WIRING (EXCEPT HVAC LOW VOLTAGE WIRING) INCLUDING CONNECTIONS TO MOTORS, DAMPERS, INTERLOCKING, ETC., SHALL BE PROVIDED BY THE ELECTRICAL CONTRACTOR. (ALL LINE VOLTAGE WIRING, CONDUIT, AND FINAL CONNECTIONS FROM THE POWER SOURCE THRU THE STARTER/DISCONNECT ETC. TO THE MOTOR OR EQUIPMENT IS THE RESPONSIBILITY OF THE ELECTRICAL CONTRACTOR. ALL HVAC RELATED LOW VOLTAGE CONTROL WIRING, CONDUIT AND FINAL CONNECTIONS IS THE RESPONSIBILITY OF THE MECHANICAL/TEMPERATURE CONTROL CONTRACTOR, UNLESS OTHERWISE NOTED ON THE PLANS).

- C. THE ELECTRICAL CONTRACTOR SHALL DO ALL CUTTING, CHASING OR CHANNELING AND PATCHING REQUIRED FOR ANY WORK UNDER THE ELECTRICAL DIVISION, ANY CUTTING SHALL HAVE PRIOR APPROVAL OF THE LANDLORD. FINISHES SHALL EXTEND AT LEAST TWO (2") INCHES ABOVE SLEEVED FLOOR AND ALL SLEEVES, OPENINGS, ETC., THROUGH FIRE RATED WALLS AND FLOORS SHALL BE FIRE SEALED WITH CALCIUM SILICATE, SILICONE "RTV" FOAM, "3M" FIRE RATED SEALANTS OR EQUAL BY HILTI AFTER CONDUIT/CABLES INSTALLATION SO AS TO RETAIN THE FIRE RATING.

- D. THE ELECTRICAL CONTRACTORS, INSOFAR AS THE WORK IS CONCERNED, SHALL AT ALL TIMES KEEP THE PREMISES IN A NEAT AND ORDERLY CONDITION AND, AT THE COMPLETION OF THE WORK, SHALL PROPERLY CLEAN UP AND CART AWAY ANY DEBRIS AND EXCESS MATERIAL.

- E. THE FOLLOWING EQUIPMENT SHALL BE IDENTIFIED WITH ENGRAVED BAKELITE NAMEPLATES AS TO NAME AND/OR FUNCTION; DISTRIBUTION PANELS, LIGHTING PANELS, MOTOR STARTERS AND DISCONNECT SWITCHES. NAMEPLATES TO BE APPROXIMATELY 1" X 2" IN SIZE AND BE FASTENED WITH POP RIVETS OR SCREWS.

- F. THE LOCATION OF OUTLETS AND EQUIPMENT SHOWN ON THE DRAWINGS ARE APPROXIMATE AND THE ARCHITECT/TENANT CONSTRUCTION MANAGER SHALL HAVE THE RIGHT TO RELOCATE ANY OUTLETS OR FIXTURES BEFORE THEY ARE INSTALLED WITHOUT ADDITIONAL COST.

- G. ELECTRICAL CONTRACTOR SHALL RECORD ALL FIELD CHANGES IN THE WORK AS THE JOB PROGRESSES, AND TURN THIS AS BUI INFORMATION OVER TO THE OWNER AT THE COMPLETION OF THE PROJECT.

- H. ELECTRICAL CONTRACTOR SHALL PROTECT ALL FIXTURES/EQUIPMENT AGAINST DAMAGE FROM LEAKS, ABUSE, ETC., AND PAY COST OF REPAIR OR REPLACEMENT OF FIXTURES OR EQUIPMENT MADE NECESSARY BY FAILURE TO PROVIDE SUITABLE SAFEGUARDS OR PROTECTION.

- I. ELECTRICAL CONTRACTOR SHALL MAKE ALL FINAL ELECTRICAL CONNECTIONS AS REQUIRED FOR A COMPLETE AND OPERATING SYSTEM. AFTER ALL EQUIPMENT HAS BEEN INSPECTED AND APPROVED, THOROUGHLY CLEAN ALL EQUIPMENT PROVIDED UNDER THIS WORK JUST PRIOR TO COMPLETION OF PROJECT.

- J. THE ELECTRICAL CONTRACTOR IS RESPONSIBLE FOR ANY/ALL NECESSARY ELECTRICAL DEMOLITION WORK THAT IS REQUIRED TO FACILITATE THE NEW INSTALLATION, FIELD COORDINATE PRIOR TO BIDS. REMOVE AND/OR MODIFY EQUIPMENT, ETC. AS REQUIRED FOR A COMPLETE INSTALLATION. ANY EQUIPMENT OR DEVICE REMAINING IN USE AFTER PART OF THE EQUIPMENT OR DEVICES HAVE BEEN REMOVED ARE TO BE RECONNECTED TO EXISTING OR NEW CIRCUITS AND LEFT IN WORKING ORDER. FEEDERS TO PANELS AND WIRING TO OTHER EQUIPMENT TO BE ROUTED CONCEALED IN FINISHED AREAS. COORDINATE ANY DISRUPTION OF ELECTRICAL OR TELEPHONE SERVICES WITH LANDLORD AND TENANT CONSTRUCTION MANAGER TO AVOID CONFLICTS.

GUARANTEE:

- A. MATERIALS, EQUIPMENT AND INSTALLATION SHALL BE GUARANTEED FOR A PERIOD OF ONE (1) YEAR FROM DATE OF ACCEPTANCE. DEFECTS WHICH APPEAR DURING THAT PERIOD SHALL BE CORRECTED AT THE ELECTRICAL CONTRACTOR'S EXPENSE.

- B. FOR THE SAME PERIOD, ELECTRICAL CONTRACTOR SHALL BE RESPONSIBLE FOR ANY DAMAGE TO PREMISES CAUSED BY DEFECTS IN WORKMANSHIP OR IN THE WORK OR EQUIPMENT FURNISHED AND/OR INSTALLED BY THE ELECTRICAL CONTRACTOR.

FINALLY:

- A. IT IS THE INTENT THAT THE FOREGOING WORK SHALL BE COMPLETE IN EVERY RESPECT AND THAT ANY MATERIAL OR WORK NOT SPECIFICALLY MENTIONED OR SHOWN ON THE DRAWINGS, BUT NECESSARY TO FULLY COMPLETE THE WORK SHALL BE FURNISHED.



PROJECT NAME:

HARBOR FREIGHT TOOLS
FOR
STOCKS & TAYLOR
CONSTRUCTION

PROJECT NO: 23174

PROJECT ADDRESS:

46 SHRIJI LANE
ERWIN, NC 28339

SEAL:



COPYRIGHT:

THIS DRAWING AND IT'S COPIES ARE THE ARCHITECT'S INSTRUMENTS OF SERVICE. THEY RETAIN ALL COMMON LAW AND STATUTORY RIGHTS, INCLUDING COPYRIGHT. THEY SHALL NOT BE USED OR COPIED FOR ANY PROJECT OTHER THAN THE ONE TITLED HERE IN.

DRAWING RELEASE:

NO.	DATE	DESCRIPTION

DRAWN BY: CF CHECKED BY: SH

DATE: 04/19/24

SHEET TITLE:
ELECTRICAL SPECIFICATIONS

SHEET NUMBER:

E-4

FIELD VERIFY ALL CONDITIONS

DESIGN DRAWINGS ARE SCHEMATIC. THIS CONTRACTOR SHALL VISIT THE SITE PRIOR TO BIDDING OR AWARD OF CONTRACT TO INSPECT EXISTING FIELD CONDITIONS. THIS CONTRACT SHALL INCLUDE ALL LABOR AND MATERIALS NECESSARY FOR FIELD MODIFICATIONS DUE TO EXISTING CONDITIONS.

THE CONTRACTOR SHALL CONTACT THE ARCHITECT, ENGINEER OR OWNER PRIOR TO BIDDING FOR INTERPRETATIONS AND CLARIFICATIONS OF THE DESIGN AND INCLUDE IN HIS BID ALL COSTS TO MEET THE DESIGN INTENT. CLARIFICATIONS MADE BY THE ARCHITECT, ENGINEER OR OWNER AFTER BIDDING WILL BE FINAL AND SHALL BE IMPLEMENTED AT CONTRACTORS COST.

BIDDING CONTRACTORS SHALL HAVE A WORKING KNOWLEDGE OF LOCAL CODES AND ORDINANCES AND SHALL INCLUDE IN THEIR BIDS THE COSTS FOR ALL WORK INSTALLED IN STRICT ACCORDANCE WITH GOVERNING CODES. THE PLANS AND SPECIFICATIONS NOT WITHSTANDING, THE CONTRACTOR SHALL ALERT ARCHITECT, ENGINEER OR OWNER OF ANY APPARENT DISCREPANCIES BETWEEN GOVERNING CODES AND DESIGN INTENT.

PLUMBING EQUIPMENT SCHEDULE				
TAG	MFGR.	MODEL	DESCRIPTION	REMARKS
BFP	WATTS	LF909	BACKFLOW PREVENTER	1-1/2" SIZE, REDUCED PRESSURE ZONE WITH AIR GAP PIPED TO FLOOR DRAIN.
HB	WATTS	HY-420	HOSE BIBB	NON-FREEZE KEY OPERATED WALL HYDRANT WITH CHROME PLATED FACE, INTEGRAL VACUUM BREAKER, PROVIDE WITH LOCKABLE COVER.

SECTION 15200
PLUMBING

A. SCOPE OF WORK

- THIS CONTRACTOR SHALL FURNISH ALL LABOR, MATERIALS, EQUIPMENT, SERVICES, TOOLS, TRANSPORTATION AND FACILITIES NECESSARY FOR, REASONABLY IMPLIED AND INCIDENTAL TO, THE FURNISHING, INSTALLATION, COMPLETION AND TESTING OF ALL THE WORK FOR THE PLUMBING SYSTEMS AS SHOWN ON THE DRAWINGS, CALLED FOR IN THE SPECIFICATIONS, AND AS REQUIRED BY JOB CONDITIONS, TO INCLUDE, BUT NOT BE LIMITED TO THE FOLLOWING. (REFER TO RESPONSIBILITY SCHEDULE FOR EXACT RESPONSIBILITIES)
 - COMPLETE SANITARY PIPING SYSTEMS OF WASTE, DRAINS, AND VENTS.
 - COMPLETE COLD AND HOT WATER PIPING SYSTEMS, APPURTENANCES AND INSULATION.
 - PLUMBING FIXTURES AND EQUIPMENT AS SCHEDULED.
 - COMPLETE NATURAL GAS PIPING SYSTEMS (AS APPLICABLE, REFER TO PLANS).
 - TESTS AND ADJUSTMENTS.

- BEFORE STARTING WORK, THIS CONTRACTOR SHALL EXAMINE THE ARCHITECTURAL, STRUCTURAL, MECHANICAL AND ELECTRICAL PLANS AND SPECIFICATIONS TO SEQUENCE, COORDINATE, AND INTEGRATE THE VARIOUS ELEMENTS OF THE PLUMBING SYSTEM, MATERIALS, AND EQUIPMENT WITH OTHER CONTRACTORS TO AVOID INTERFERENCES AND CONFLICTATIONS.
- RELOCATION OF EXISTING WATER, GAS, WASTE, VENT, OR DRAINAGE LINES TO FACILITATE STORE DESIGN CRITERIA MUST BE INCLUDED IN BID PROPOSAL.

B. GENERAL PIPING REQUIREMENTS

- GENERALLY, SANITARY AND POTABLE WATER TAPS WILL BE PROVIDED BY THE LANDLORD. FIELD VERIFY EXACT CONNECTION POINTS PRIOR TO SUBMITTING BID AND NOTIFY THE TENANT'S CONSTRUCTION MANAGER IF CONDITIONS ARE NOT AS SHOWN ON THE PLANS OR AS STATED IN THE SPECIFICATIONS. CONTRACTOR MUST VERIFY THE OPERABILITY OF ENTIRE SYSTEM PRIOR TO TIE IN AS FOLLOWS:
 - Snake sanitary for a distance of 100 feet and report any blockage.
 - Test water pressure to insure minimum of 50 PSI.
- INSTALL ALL NECESSARY PIPE HANGERS, SADDLES, AND CARRIERS TO PROPERLY SUPPORT ALL PIPING AND FIXTURES. HANGERS SHALL SUIT TYPE OF PIPING PROVIDED AND BE SPACED AT A MAXIMUM SPAN OF 5 FEET. PROVIDE SWAY AND SEISMIC BRACING WHERE REQUIRED BY CODES.
- ESCUTCHEONS SHALL BE CHROME PLATED, SIZE AS REQUIRED AND PLACED AT ALL PIPE PENETRATIONS AT WALLS, FLOORS, AND CEILINGS IN FINISHED AREAS.
- FLASHING SHALL BE SEALED WATERTIGHT AND PERFORMED IN ACCORDANCE TO THE LANDLORD'S CRITERIA. USE A LANDLORD APPROVED ROOFING CONTRACTOR WHERE APPLICABLE.

C. PIPING

- SANITARY PIPING - NO PVC ALLOWED (STORM PIPING AS REQUIRED)
 - WASTE, DRAIN AND VENT PIPING SHALL BE SERVICE WEIGHT, CAST IRON SOIL PIPE. VENT PIPING ABOVE FLOOR 2" OR SMALLER MAY BE GALVANIZED STEEL.
 - JOINTS: BELOW FLOOR SLAB - COMPRESSION TYPE PLASTIC SEAL (HUB AND SPIGOT), ABOVE FLOOR SLAB - NEOPRENE SEALING SLEEVE WITH STAINLESS STEEL SHIELD AND CLAMP WITH APPROVED NEOPRENE - BASED LUBRICANT, (HUBLESS). GALVANIZED VENT - SCREWED JOINTS WITH TEFLOW TAPE ON MALE THREADS.
 - PITCH WASTE LINES 2" AND SMALLER NOT LESS THAN 1/4" PER FOOT. PITCH LARGER MAINS NOT LESS THAN 1/8" PER FOOT.
 - INSTALL A CLEANOUT AT BASE OF EACH SOIL STACK, AT EACH CHANGE IN DIRECTION, AT INTERVALS NOT OVER 50 FEET, AND ELSEWHERE AS SHOWN ON DRAWINGS OR REQUIRED BY LOCAL CODE. CLEANOUTS SHALL NOT BE INSTALLED IN PUBLIC AREAS WITHOUT SPECIFIC PERMISSION BY TENANT'S CONSTRUCTION MANAGER; BUT WHERE NECESSARY, THE WALL COVERS ARE TO BE STAINLESS STEEL AND THE FLOOR COVERS ARE TO BE BRASS (FLUSH WITH FINISHED FLOOR). PROVIDE COVERS WITH INSET AREA FOR CARPETED FLOOR LOCATIONS. ALL CLEAN-OUT LOCATIONS SHALL BE APPROVED BY THE TENANT'S CONSTRUCTION MANAGER.
 - INSULATE ALL HORIZONTAL RUNS OF PIPING LOCATED IN CEILING SPACES WHEN APPLICABLE. INSULATION TO BE AS SPECIFIED FOR WATER PIPING.
 - INSULATE THE TRAP, SANITARY AND SUPPLY PIPES UNDER LAVATORY WITH 1/2" ARMSTRONG "ARMAFLEX" PIPING INSULATION OR TRUEBRO MODEL 102W "HANDI LAV GUARD" INSULATION KIT.

- CONDENSATE PIPING SHALL BE TYPE "L" DRAWN COPPER TUBE WITH 95-5 TIN-ANTIMONY SOLDERED JOINTS AND WROUGHT COPPER FITTINGS WITH DIELECTRIC SEPARATION BETWEEN DISSIMILAR METALS.

3. POTABLE WATER PIPING:

- BELOW GRADE: TYPE "K", ANNEALED TEMPERED COPPER TUBE FOR PIPE SIZES 2 INCHES AND SMALLER. BRAZE ALL JOINTS.
- ABOVE GRADE: TYPE "L" DRAWN COPPER TUBE WITH WROUGHT COPPER FITTINGS AND 95-5 TIN-ANTIMONY SOLDER.
- INSTALL AIR CHAMBER SHOCK ABSORBERS IN PIPING SYSTEM TO PREVENT NOISE AND DAMAGE DUE TO WATER HAMMER.
- ALL BRANCH PIPING SYSTEM SHALL HAVE ACCESSIBLE SERVICE VALVE. PROVIDE SHUT OFF VALVES IN THE SUPPLY PIPING TO EVERY FIXTURE. PROVIDE ACCESS DOORS WHERE NECESSARY.
- PROVIDE WATER METER AND REMOTE READER PER LANDLORD'S CRITERIA OR LOCAL UTILITIES REQUIREMENTS IF APPLICABLE. REFER TO PLANS TO DETERMINED IF WATER METER IS REQUIRED.
- SECURE PIPE AT ANGLE STOPS.
- PROVIDE FLEXIBLE INSERTS AT ALL PIPE PENETRATIONS THROUGH FRAMING TO KEEP PIPES FROM HITTING FRAME WHEN IN OPERATION.


D. INSULATION

- INSULATE ALL WATER AND INTERIOR CONDENSATE PIPING WITH 1" THICK (K=0.23 @ 75 F) SNAP-ON FIBERGLASS PIPE INSULATION WITH AN ALL SERVICE JACKET TO MEET LOCAL CODES AND UL FLAME SPREAD RATING OF 25 AND SMOKE DEVELOPED RATINGS OF 50. APPROVED MANUFACTURER: MANVILLE MICRO-LOK.


E. TEST & STERILIZATION

- LEAKAGE TESTS SHALL BE PER NYC ECCC C402.5, MINIMUM AS FOLLOWS:
 - TEST POTABLE WATER PIPING AND CONDENSATE PIPING AT 125 PSIG FOR SIX HOURS. PER NYC 2014 PC 312.5
 - TEST DRAIN, WASTE, VENT PIPING BY A 10" WATER COLUMN FOR TWO HOURS. ALL JOINTS SHALL BE GAS AND WATER TIGHT. PER NYC 2014 PC 312
 - TEST GAS PIPING PER NYC 2014 FGC SECTIONS 107.3.1 - 107.3.3
 - STERILIZE POTABLE HOT & COLD WATER LINES UPON COMPLETION OF SYSTEM. STERILIZE WATER SYSTEM IN ACCORDANCE WITH NYC 2014 PC 610.

PLUMBING SYMBOLS (NOT ALL SYMBOLS USED)			
SYMBOL	DESCRIPTION	SYMBOL	DESCRIPTION
—DCW—	DOMESTIC COLD WATER	⊗	SHUT-OFF VALVE
—(E)DCW—	EXISTING DOMESTIC COLD WATER	⊗	PIPE FLEX CONNECTION
—DHW—	DOMESTIC HOT WATER	⊗	BALL VALVE
—(E)DHW—	EXISTING DOMESTIC HOT WATER	⊗	Y-TYPE STRAINER
—110" DHW—	110" DOMESTIC HOT WATER	⊗	GAS COCK (PLUG VALVE)
—110" DHWR—	110" DOMESTIC HOT WATER RETURN	⊗	CHECK VALVE
—SAN—	SANITARY LINE	⊗	BACKFLOW PREVENTER
—(E)SAN—	EXISTING SANITARY LINE	⊗	BALANCE VALVE
—GRE—	GREASE SANITARY LINE	⊗	COMB. BALANCE & SHUT-OFF VALVE
—D—	CONDENSATE LINE	⊗	DRAIN VALVE
—V—	VENT LINE	⊗	PRESSURE RELIEF VALVE
—(E)V—	EXISTING VENT LINE	⊗	PRESSURE REDUCING VALVE
—G—	GAS LINE	⊗	PRESSURE REDUCING VALVE
—W—	WATER SERVICE LINE	⊗	VALVE WITH TAMPER SWITCH
—140"—	140" F. WATER	⊗	SOLENOID VALVE
—TW—	TEMPERED WATER	⊗	SHOCK ABSORBER
⊗	REDUCER	⊗	HOSE BIBB
⊗	FLOOR OR AREA DRAIN	⊗	PIPE ANCHOR
⊗	CURB BOX AND VALVE	⊗	PIPE GUIDE OR SLEEVE
⊗	CAPPED LINE	⊗	FLOW DETECTOR SWITCH
⊗	PIPE UNION	⊗	PRESSURE GAUGE WITH GAGE COCK
⊗	P-TRAP (PLAN VIEW)	⊗	TEMPERATURE GAUGE
⊗	PIPE TEE DROP	⊗	REDUCE BACKFLOW PREVENTER
⊗	PIPE TEE RISE	⊗	CONNECT TO EXISTING
⊗	PIPE DROP		
⊗	PIPE RISE		
⊗	TRAP PRIMER		
⊗	STACK LETTER		
⊗	RISER NUMBER		

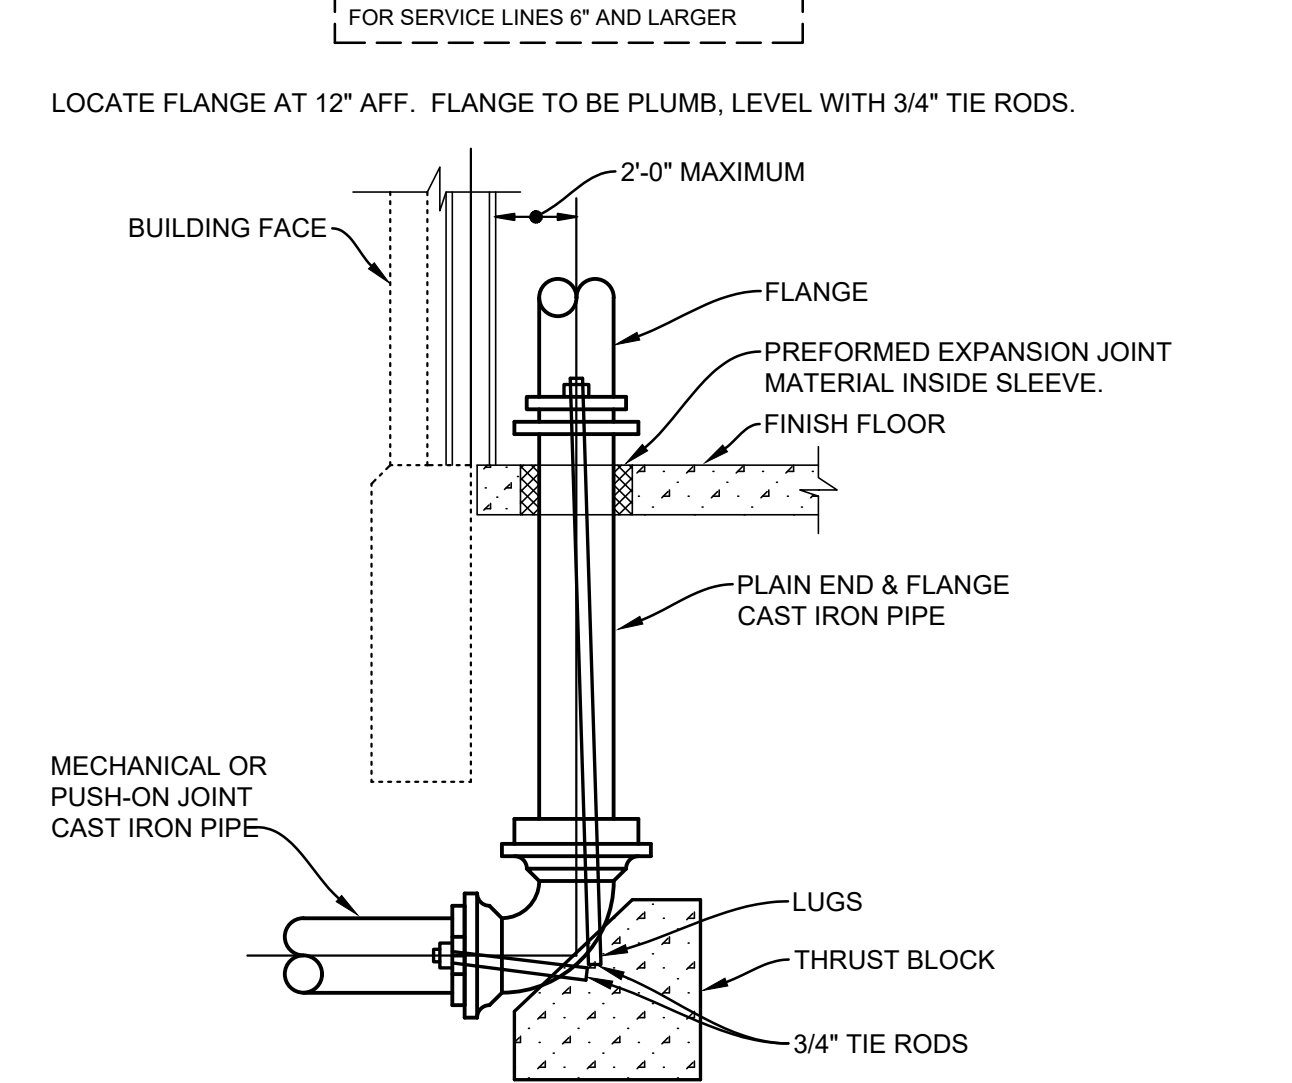

A WATER SERVICE LINE SCHEMATIC
N.T.S.

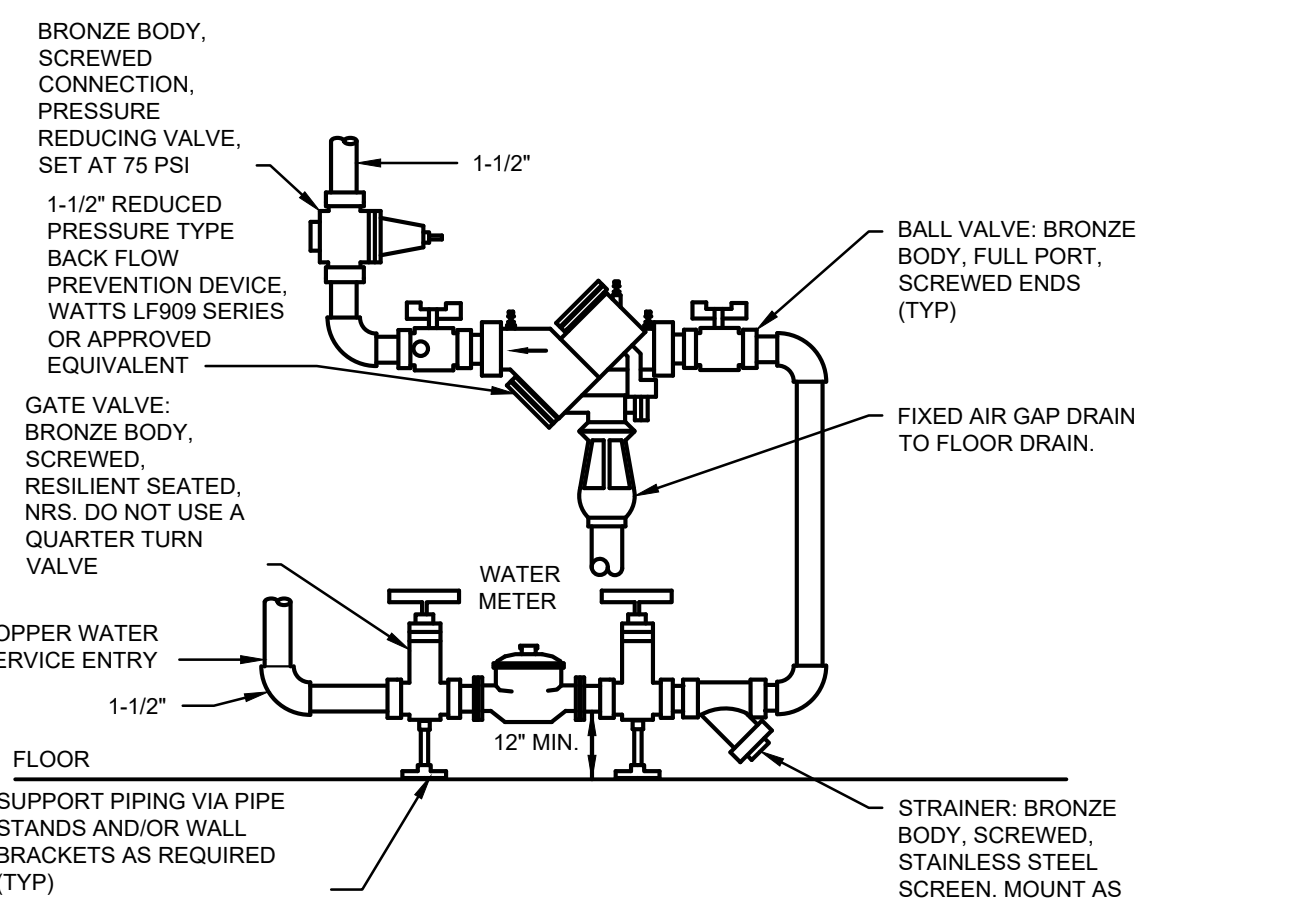

DETAIL SHOWS GENERAL SCHEMATIC REQUIREMENTS. INSTALL ITEMS FURNISHED BY WATER COMPANY. PAY ANY FEES REQUIRED BY WATER COMPANY. FURNISH AND INSTALL ITEMS NOT PROVIDED BY THE WATER COMPANY. PROVIDE BACKFLOW PREVENTER OF TYPE AND MANUFACTURER APPROVED BY LOCAL AUTHORITIES. PROVIDE PRESSURE REDUCING VALVE ONLY IF PRESSURE EXCEEDS 80 PSI - VERIFY. STRAINER AND REDUCING VALVE MAY BE INSTALLED IN VERTICAL PIPE IF SPACE LIMITATIONS REQUIRE IT. CLEAN STRAINER BEFORE TURNING BUILDING OVER TO OWNER. PROVIDE ANY REQUIRED CERTIFICATION OF TESTING OF THE BACKFLOW PREVENTER TO LOCAL AUTHORITIES.

B BACKFLOW PREVENTER SCHEMATIC
N.T.S.



PROJECT NAME:


**HARBOR
FREIGHT TOOLS**
FOR
**STOCKS & TAYLOR
CONSTRUCTION**

PROJECT NO: 23174

PROJECT ADDRESS:

46 SHRIJI LANE
ERWIN, NC 28339

SEAL:

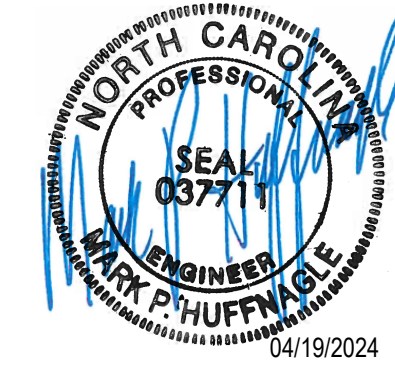

COPYRIGHT:

THIS DRAWING AND ITS COPIES ARE THE ARCHITECT'S INSTRUMENTS OF SERVICE. THEY RETAIN ALL COMMON LAW AND STATUTORY RIGHTS, INCLUDING COPYRIGHT. THEY SHALL NOT BE USED OR COPIED FOR ANY PROJECT OTHER THAN THE ONE TITLED HERE IN.

DRAWING RELEASE:

NO.	DATE	DESCRIPTION


DRAWN BY: EC
CHECKED BY: BM

DATE: 04/19/24

SHEET TITLE:
PLUMBING DETAILS AND SCHEDULES

SHEET NUMBER:

P-1

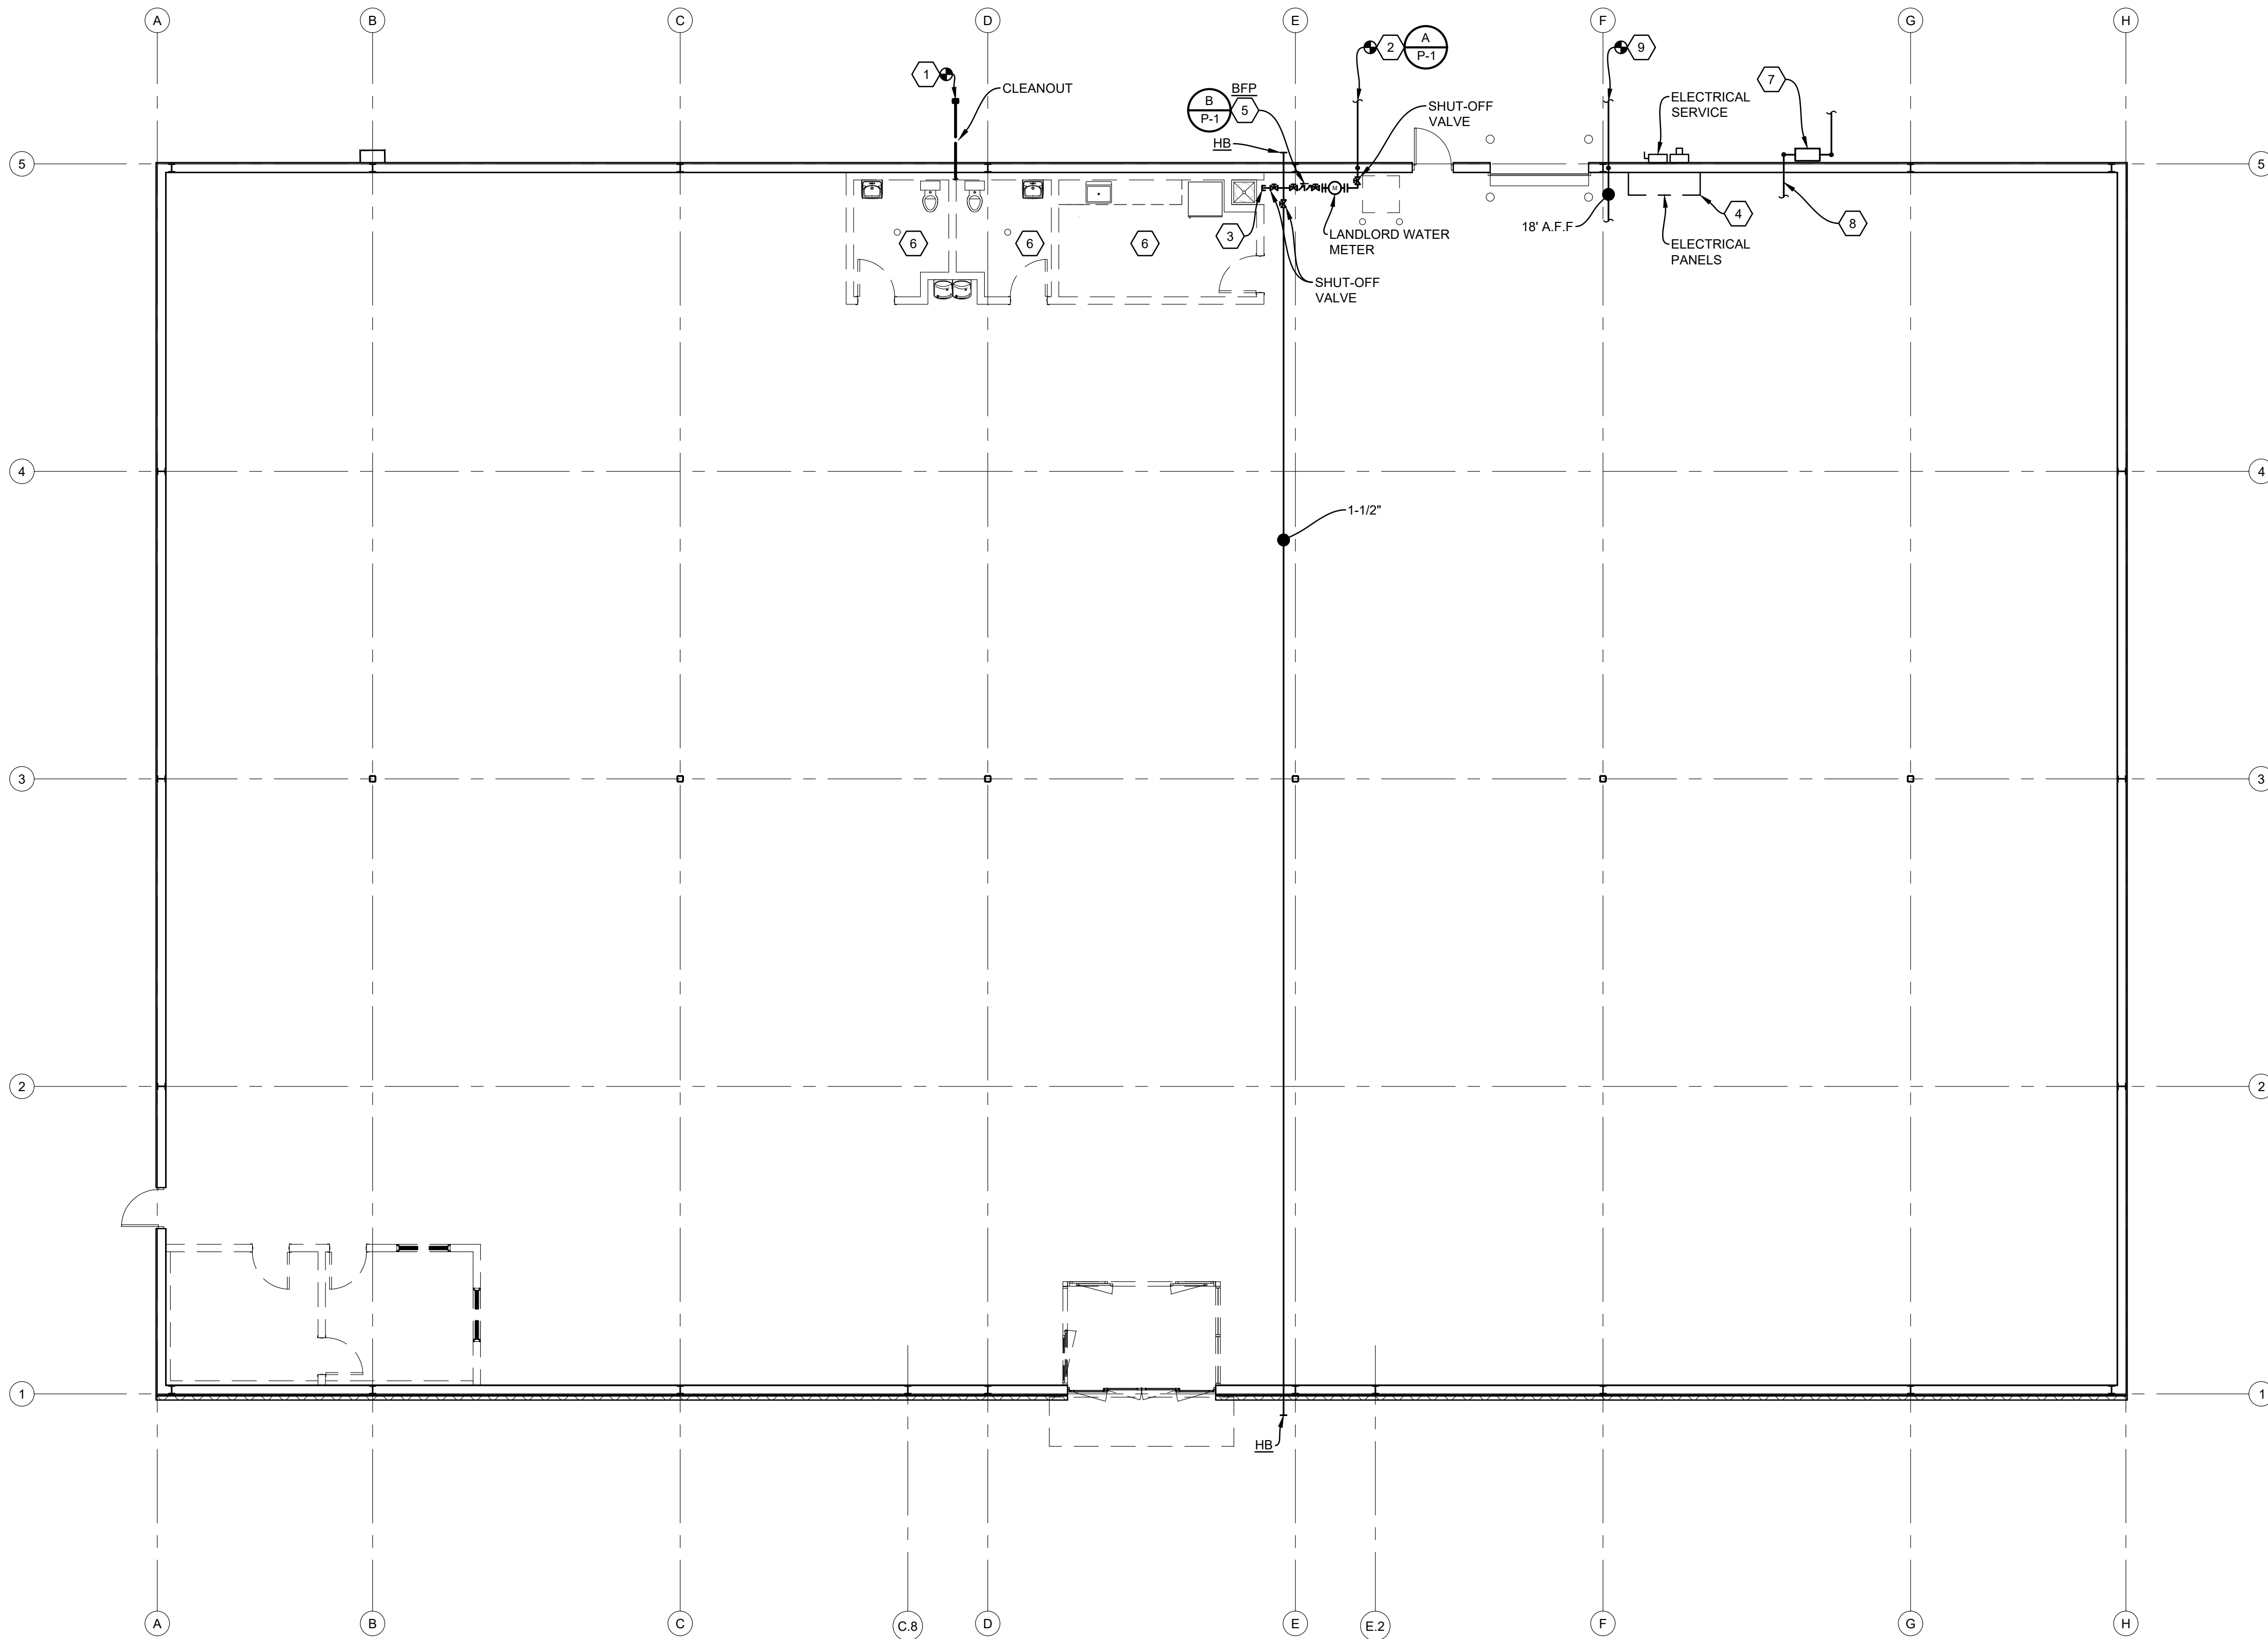

CODED NOTES:

- 1 NEW SANITARY STUB FOR FUTURE TENANT. FIELD VERIFY EXACT STUB IN LOCATION AND INVERT ELEVATION. REFER TO CIVIL SITE PLANS FOR SEWER LINE CONTINUATION.
- 2 CONNECT TO 1-1/2" LANDLORD PROVIDED WATER SERVICE LINE. NEW WATER SERVICE LINE SHALL BE TRENCHED INTO THE BUILDING BELOW THE FREEZING DEPTH PRIOR TO ENTERING THE BUILDING.
- 3 CAPPED 1-1/2" WATER SERVICE LINE. FUTURE EXTENSION TO PLUMBING FIXTURES BY TENANT. FIELD VERIFY EXACT LOCATION.
- 4 NO PLUMBING WORK SHALL BE ROUTED OVER ELECTRICAL EQUIPMENT.
- 5 NEW LANDLORD REDUCED PRESSURE ZONE BACK FLOW PREVENTER. BACK FLOW PREVENTER TO FOLLOW ALL LOCAL PLUMBING CODES AND JURISDICTION REQUIREMENTS. FIELD VERIFY EXACT LOCATION IN ACCORDANCE WITH MANUFACTURER REQUIRED CLEARANCES.
- 6 FUTURE RESTROOM AND ASSOCIATED PLUMBING FIXTURES AS PART OF TENANT FIT-OUT SCOPE.
- 7 PROVIDE NEW NATURAL GAS SERVICE AND GAS METER. COORDINATE GAS LOAD WITH TENANT ENGINEER, P.C. TO FIELD VERIFY DELIVERY PRESSURE AND EXACT METER LOCATION PRIOR TO CONSTRUCTION. P.C SHALL COORDINATE WITH ENGINEER FOR GAS PIPING.
- 8 GAS PIPING ROUTE DETERMINED BY FUTURE TENANT AND FUTURE TENANT EQUIPMENT.
- 9 NEW FIRE PROTECTION MAIN STUB FOR FUTURE TENANT. FIELD VERIFY EXACT STUB IN LOCATION. REFER TO CIVIL SITE PLANS FOR FIRE LINE CONTINUATION.

PLUMBING GENERAL NOTES:

- A PLUMBING WORK SHALL BE DONE IN ACCORDANCE WITH LOCAL PLUMBING CODE, LOCAL AND AUTHORITY HAVING JURISDICTION.
- B PIPING LAYOUTS ON DRAWINGS ARE SCHEMATIC. EXACT LOCATIONS ARE TO BE COORDINATED WITH FIELD CONDITIONS AND THE WORK OF OTHER TRADES.
- C PLUMBING FIXTURES, ACCESSORIES, AND MATERIALS PROVIDED FOR WATER SERVICE LINES SHALL BE LEAD FREE.
- D PIPING EXTERIOR WALLS SHALL BE INSTALLED BETWEEN THE INSULATION AND THE INTERIOR WALL FINISHING MATERIAL.
- E INSULATE HOT AND COLD WATER LINES, AND CONDENSATE DRAINAGE PIPING WHERE APPLICABLE PER CORRESPONDING SPECIFICATIONS.
- F CORRESPONDING BACK FLOW DEVICES TO COMPLY WITH ASME112.14.1, CSA B181.1, OR CSA B181.2.

PROJECT NAME:

**HARBOR
FREIGHT TOOLS**
FOR
STOCKS & TAYLOR
CONSTRUCTION

PROJECT NO: 23174

PROJECT ADDRESS:

46 SHRIJI LANE
ERWIN, NC 28339

SEAL:



COPYRIGHT:

THIS DRAWING AND IT'S COPIES ARE THE ARCHITECT'S INSTRUMENTS OF SERVICE. THEY RETAIN ALL COMMON LAW AND STATUTORY RIGHTS, INCLUDING COPYRIGHT. THEY SHALL NOT BE USED OR COPIED FOR ANY PROJECT OTHER THAN THE ONE TITLED HERE IN.

DRAWING RELEASE:

NO.	DATE	DESCRIPTION

DRAWN BY: EC CHECKED BY: BM

DATE: 04/19/24

SHEET TITLE:
PLUMBING SHELL PLAN

SHEET NUMBER:


P-2

HARBOR FREIGHT TOOLS

46 SHRIJI LN. ERWIN, NC 28339



05/17/24

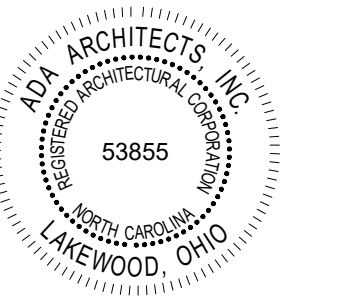

REVISIONS

#	DATE	TYPE
1		
2		
3		
4		
5		
6		
7		
8		
9		
10		

COVER SHEET

DATE 05/17/24

JOB NO. 23475

SHEET NO. **A0.0**

SIGN VENDOR LIST

Harbor Freight Tools Sign Vendor Territories

Vendors

- Northern US Urban Neon
- Southern US Atlas Sign Industries

SIGN VENDOR (NORTHERN)

URBAN SIGN GROUP
500 PINE STREET SUITE 3A
HOLMES, PA 19043
CONTACT: SEBASTIAN CARPENTER
T: (610) 522-5555
EMAIL: scarpenter@urbansigngroup.com

SIGN VENDOR (SOUTHERN)

ATLAS SIGN INDUSTRIES
1077 W. BLUE HERON BLVD.
WEST PALM BEACH, FL 33404
CONTACT: JODY KLUTZ
T: (860) 781-3097
EMAIL: jody.k@atlasbw.com

NOTE:
ALL SIGNAGE AND PERMITS FOR SIGNAGE ARE BY OTHERS AND NOT PART OF THE BUILDING PERMIT PACKAGE. NO BUILDING SIGNAGE WORK TO BE PERFORMED AS PART OF THIS PROJECT PERMIT.

CODE AND BUILDING DATA

- PROJECT SCOPE:**
INTERIOR BUILD OUT OF NEWLY CONSTRUCTED COLD DARK SHELL. INTERIOR ALTERATIONS INCLUDE NEW OFFICES, RESTROOMS, BREAK ROOM WITH CABINETS, AND VESTIBULE. NEW EXTERIOR SIGNAGE (UNDER SEPARATE PERMIT). THE BUILDING IS 2024 CONSTRUCTION.
- DEFERRED SUBMITTALS:**
 - EXTERIOR SIGNAGE (INCLUDING TEMPORARY SIGN BANNER)
 - AUTOMATIC SPRINKLER SYSTEM MODIFICATIONS
 - FIRE ALARM SYSTEM MODIFICATIONS
 - MERCHANDISE RACKING
- APPLICABLE CODES:**
 - BUILDING CODE: 2018 NORTH CAROLINA STATE BUILDING CODE
 - ENERGY CODE: 2018 NORTH CAROLINA STATE ENERGY CODE
 - MECHANICAL CODE: 2018 NORTH CAROLINA STATE MECHANICAL CODE
 - ELECTRICAL CODE: 2020 ELECTRICAL CODE
 - PLUMBING CODE: 2018 NORTH CAROLINA STATE PLUMBING CODE
 - FIRE CODE: 2018 NORTH CAROLINA STATE FIRE CODE
 - ACCESSIBILITY: 2018 NORTH CAROLINA STATE ADA STANDARDS WITHIN NORTH CAROLINA STATE BUILDING CODE / 2009 ANSI A117.1
- USE AND OCCUPANCY CLASSIFICATION:**
M - MERCANTILE
- CONSTRUCTION CLASSIFICATION (TYPE):**
IIB - FULLY SPRINKLERED
- FIRE-RESISTANCE RATING REQUIREMENTS FOR BUILDING ELEMENTS (HOURS):**

STRUCTURAL FRAME:	0 HOURS	INTERIOR BEARING WALLS:	0 HOURS
EXTERIOR BEARING WALLS:	0 HOURS	FLOOR CONSTRUCTION:	0 HOURS
INTERIOR BEARING WALLS/COLUMNS:	0 HOURS	ROOF CONSTRUCTION:	0 HOURS
- ALLOWABLE HEIGHT and BUILDING AREAS:**

ALLOWABLE AREA:	50,000 SQ. FT.
SALES AREA:	9,381 SQ. FT.
NON-SALES AREA:	6,619 SQ. FT.
GROSS LEASED AREA:	16,000 SQ. FT.
ALLOWABLE HEIGHT:	75'-0"
ACTUAL HEIGHT:	27'-8"
- OCCUPANT LOAD:**
ACTUAL INTERIOR AREA BUILDING: 16,000 SQ. FT.

FUNCTION OF SPACE	FLR. AREA	OCC.	CALCULATION	ALLOWABLE
M - SALES	60 GROSS	9,381 SQ. FT.	164 OCCUPANTS	
B - CORE AREA	100 GROSS	660 SQ. FT.	20 OCCUPANTS	
S-1 - STOCK	300 GROSS	5,999 SQ. FT.	191 OCCUPANTS	

ANTICIPATED OCCUPANT LOAD FOR HARBOR FREIGHT TOOLS: 150 MAX FROM HISTORICAL DATA

- EGRESS REQUIREMENTS:**
 - REQUIRED EGRESS WIDTH: 191 OCC. x 0.20 = 38.2" (44" MIN)
 - PROVIDED EGRESS WIDTH: (1) BREAK-AWAY SINGLE SLIDING DOOR @ 45", (2) H.M. DOOR @ 34" = 113"
 - REQUIRED EXIT ACCESS TRAVEL DISTANCE: 25'
 - PROVIDED EXIT ACCESS TRAVEL DISTANCE: LESS THAN 25'
 - MIN. NUMBER OF EXITS REQUIRED / PROVIDED: 2 EXITS REQUIRED / 3 EXITS PROVIDED
- PLUMBING FIXTURE REQUIREMENTS:**

PLUMBING FIXTURE	CALCULATION	REQUIRED	PROVIDED
WATER CLOSETS, MEN:	1 PER 500 OCC.	1	1
WATER CLOSETS, WOMEN:	1 PER 500 OCC.	1	1
LAVATORIES, MEN:	1 PER 750 OCC.	1	1
LAVATORIES, WOMEN:	1 PER 750 OCC.	1	1
DRINKING FOUNTAINS:	1 PER 1,000 OCC.	1	1 (H/LOW)
MOP SINK:	1 SERVICE SINK/USE GROUP	1	1

VENDOR LIST

IT VENDOR	IT CHECKLIST	FLOORING VENDORS	LVT VENDOR
RETAIL TECH INC. MAIN CONTACT: CRISTIN BELSITO T: (952) 356-1775 X 2007 C: (440) 263-2270 EMAIL: cbelisto@retailtechinc.com	MUST HAVE CHECK LIST: <input type="checkbox"/> PROJECT MANAGERS CONTACT INFORMATION INCLUDING EMAIL ADDRESS <input type="checkbox"/> CONTRACTOR INFORMATION 1 WEEK BEFORE CONSTRUCTION STARTS (PROTRACK TRIGGER VIA EMAIL) <input type="checkbox"/> GENERAL CONTRACT INFO INCLUDING EMAIL ADDRESSES <input type="checkbox"/> SITE FOREMAN INFO INCLUDING EMAIL ADDRESS <input type="checkbox"/> CONFIRMED ADDRESS WITH MPOE LOCATION (CLOSET, DIMARK, ETC.) <input type="checkbox"/> STANDARD STORE SET UP IS 2 LINES IN A HUNT GROUP, 1 LINE FOR BACK UP COMMUNICATION, AND 1 ALARM LINE. IF WE NEED MORE DEDICATED ALARM LINES TO PASS CITY CODE, NEED TO KNOW THAT UPFRONT	DIAMA-SHIELD, LLC 32401 INDUSTRIAL DRIVE MADISON HEIGHTS, MI 48071 CONTACT: TRAVIS SIBLEY T: (313) 510-8149 EMAIL: tsibley@damashield.com	MATTER SURFACES CONTACT: DAVE BOLINGER T: (260) 341-4949 EMAIL: dbolinger@selected-service.com CONTACT: COREY HALL T: (404) 735-0799
RETAIL TECH INC. MAIN CONTACT: CRISTIN BELSITO T: (952) 356-1775 X 2007 C: (440) 263-2270 EMAIL: cbelisto@retailtechinc.com		RACKING VENDOR MADIX, INC. 500 AIRPORT ROAD TERRELL, TX 75160 CONTACT: SCOTT NELSON T: (855) 529-6457 C: (855) 755-9386 EMAIL: snelson@madixinc.com	OVERHEAD DOOR VENDOR CORNELL IRON 140 MAFFET STREET WILKES-BARRE, PA 18705 CONTACT: KRISTA BONAVINA T: (800) 882-6773 X 1620 EMAIL: kbonavina@cornellstorefronts.com
DOOR HARDWARE VENDORS / RESTROOM ACCESSORIES COOK AND BOARDMAN, LLC 345 MASON ROAD LAVERGNE, TN 37086 CONTACT: AMY BAKER T: (855) 447-8600 x4508 EMAIL: harborfreightteam@cookandboardman.com	FIRE AND SECURITY ALARM / MONITORING VENDOR ADT SECURITY 4221 N JOHN CARPENTER FWY IRVING, TX 75063 CONTACT: STEPHANIE NYSTROM T: (214) 277-7175 EMAIL: snystrom@adt.com CONTACT: DAN BITCON EMAIL: dbitcon@adt.com	ADDRESS VERIFICATION / METER SERVICES COST CONTROL ASSOCIATES 310 BAY ROAD QUEENSBURY, NY 12804 CONTACT: LENA GARCIA T: (714) 404-8212 EMAIL: lena.garcia@shenwin.com	PAINT VENDOR SHERWIN WILLIAMS 2100 WEST ORANGEWOOD, SUITE 100 ORANGE, CA 92668 CONTACT: LENA GARCIA T: (714) 404-8212 EMAIL: lena.garcia@shenwin.com
HVAC VENDOR LENNOX INDUSTRIES NATIONAL ACCOUNTS CONTACT: GARRY BAKER T: (972) 497-6665 EMAIL: LennoxNationalAccounts@Lennox.com	EMS VENDOR SIEMENS CONTACT: EMELY CORDON T: (512) 751-5942 EMAIL: emely.cordon@siemens.com PROJECT MANAGER: EMELY CORDON T: (512) 751-5942 EMAIL: emely.cordon@siemens.com ENGINEERING MANAGER: JUAN CABRERA T: (512) 567-7455 EMAIL: juancabrera@siemens.com	EMS SHIELDED CABLE VENDOR WINDY CITY WIRE CONTACT: KIMBERLY DEPAOLA T: (800) 378-1191 X 2811 C: (630) 633-4811 EMAIL: kdepaula@smartwire.com	RACKING ENGINEER GARY K. MUNKELT AND ASSOCIATES 1180 WELSH ROAD, SUITE 190 NORTH WALES, PA 19454 CONTACT: FRANK KOOSHYYAR T: (215) 855-8713 EMAIL: frank.kooshyyar@gkmassoc.com CONTACT: DENISE BAILEY T: (610) 449-4502 EMAIL: denise.bailey@gkmassoc.com CONTACT: BRENDA ROJHM T: (610) 449-4502 EMAIL: brenda.rojhm@gkmassoc.com

NOTE: SUBSTITUTE PRODUCTS -OR- ALTERNATES TO THOSE SPECIFIED ON PLANS WILL NOT BE ACCEPTED WITHOUT HFT'S EXPRESS CONSENT. ANY PROPOSED SUBSTITUTIONS MUST BE SUBMITTED TO ARCHITECT FOR REVIEW AND APPROVAL.

HFT VENDOR SCOPE OF WORK SUMMARY

- FIXTURES / FURNISHINGS:**
 - FURNISH AND INSTALL SALES AREA CASH WRAPS
 - FURNISH AND INSTALL FRONT OF HOUSE AND BACK OF HOUSE FIXTURES
 - FURNISH AND INSTALL EXTERIOR CART CORRAL (IF APPLICABLE)
 - DOORS AND STOREFRONT:**
 - FURNISH DOORS, FRAMES, AND HARDWARE. SEE SHEET A5.0 FOR FURTHER INFORMATION.
 - FURNISH AND INSTALL OVERHEAD DOOR AT RECEIVING AREA. SEE SHEET A5.0 FOR FURTHER INFORMATION.
 - FURNISH AND INSTALL HFT BI-PARTING AND SINGLE SLIDING DOOR PACKAGES. SEE SHEET A5.0 FOR FURTHER INFORMATION.
 - FURNISH AND INSTALL SECURITY GATES. SEE SHEET A1.1 FOR FURTHER INFORMATION.
 - FURNISH AND INSTALL COOLUV WINDOW TINT (IF APPLICABLE)
 - SIGNAGE:**
 - FURNISH AND INSTALL EXTERIOR SIGNAGE. POWER AND BLOCKING BY G.C.
 - FURNISH ALL INTERIOR SIGNAGE.
 - FLOOR FINISHES:**
 - FURNISH AND INSTALL GRINDING AND POLISHING OF CONCRETE FLOORS
 - ELECTRICAL:**
 - FURNISH AND INSTALL TELEPHONE / DATA WIRING. VERIFY IF WIRING IS TO BE PLENUM RATED
 - FURNISH AND INSTALL SOUND SYSTEM
 - FURNISH AND INSTALL CAMERAS
 - FURNISH LIGHT FIXTURES AND LAMPS
 - FURNISH LIGHTING DIMMING SYSTEM COMPONENTS (IF APPLICABLE, SEE E1.1A)
 - FURNISH AND INSTALL EMS COMPONENTS
 - MECHANICAL:**
 - FURNISH HVAC ROOFTOP UNITS. G.C. TO COORDINATE SCHEDULE AND DELIVERY
 - RESTROOM ACCESSORIES:**
 - FURNISH GRAB BARS, BLOCKING BY G.C.
 - FURNISH SANITARY NAPKIN DISPOSAL
 - FURNISH TOILET PARTITIONS (IF APPLICABLE)
- NOTE: G.C. SHALL MANAGE ALL WARRANTY ITEMS AND REMEDIES INCLUDING MANAGING SUB-CONTRACTORS, VENDORS AND HFT VENDORS FOR A PERIOD OF (1) YEAR FROM TURNOVER**

PROJECT DIRECTORY

BLDG. DEPT. CONTACT	FIRE DEPT. CONTACT	HARBOR FREIGHT TOOLS	HARBOR FREIGHT TOOLS
HARNETT COUNTY BUILDING DEPARTMENT 420 MCKINNEY PARKWAY LILLINGTON, NC 27546 CONTACT: DONNA JOHNSON T: (910) 814-6431 EMAIL: djohnson@harnett.org	HARNETT COUNTY FIRE MARSHAL 420 MCKINNEY PARKWAY LILLINGTON, NC 27546 CONTACT: DONNA JOHNSON T: (910) 893-7525 EMAIL: djohnson@harnett.org	HARBOR FREIGHT TOOLS 26677 AGOURA ROAD CALABASAS, CA 91302 CONTACT: DOUG STEECE Senior Director of Construction T: (818) 519-7503 EMAIL: dsteece@harborfreight.com	HARBOR FREIGHT TOOLS 26677 AGOURA ROAD CALABASAS, CA 91302 CONTACT: DOUG STEECE Senior Construction Manager T: (805) 407-1961 EMAIL: dsteece@harborfreight.com
HARBOR FREIGHT TOOLS 26677 AGOURA ROAD CALABASAS, CA 91302 CONTACT: JAKE MATTERN Construction Manager T: (818) 309-9137 EMAIL: jmattern@harborfreight.com	HARBOR FREIGHT TOOLS 26677 AGOURA ROAD CALABASAS, CA 91302 CONTACT: KYLE NIX Construction Manager T: (818) 309-9104 EMAIL: knix@harborfreight.com	HARBOR FREIGHT TOOLS 26677 AGOURA ROAD CALABASAS, CA 91302 CONTACT: KYLE NIX Construction Manager T: (213) 561-0921 EMAIL: knix@harborfreight.com	ARCHITECT CONTACT ADA ARCHITECTS, INC. 17710 DETROIT AVE. CLEVELAND, OH 44107 CLIENT MANAGER: BRYAN MATTHEWS PROJECT MANAGER: BRYAN MATTHEWS T: (216) 521-5134 F: (216) 521-4824 EMAIL: bmatthews@adaarchitects.com

LIFE SAFETY SUMMARY

LANDLORD TO PROVIDE A FULLY SUPPRESSED WARM DARK SHELL WITH 6" MINIMUM MAIN LOCATED ALONG THE SOUTH ELEVATION OF THE BUILDING, ADJACENT TO THE O.H. DOOR. LANDLORD WILL DELIVER THE SYSTEM WITH HEADS TURNED UP TOWARDS STRUCTURE. HFT TO MODIFY HEADS AS REQUIRED FOR NEW CONSTRUCTION.

PER 2018 NORTH CAROLINA BUILDING CODE, SECTION 907.2.7, A MANUAL FIRE ALARM SYSTEM IS NOT REQUIRED. G.C. TO COORDINATE WITH AUTHORITY HAVING JURISDICTION, LANDLORD AND BY PM FOR ANY LOCAL MONITORING REQUIREMENTS. G.C. TO SUPPLY AND INSTALL ANY REQUIRED FIRE ALARM COMPONENTS.

FIRE ALARM NOTES

(IF REQUIRED)

APPROVED PANELS:
FIRE-LITE MODEL #S MS-9600, ES-50, AND ES-200X

SILENT NIGHT MODEL #S SK6700, SK6808, SK6820, AND SK5208.

NOTE: FIRE ALARM VENDOR SHALL CLEARLY LABEL THE FIRE ALARM CONTROL PANEL IN THE FIELD. FIRE ALARM MONITORING IS VIA CELLULAR ANNUNCIATOR-NAPCO # SLE-LTEV-FIRE OR SLE-LTEA-FIRE. REFER TO SHEET E2.2 FOR ADDITIONAL INFORMATION. FA SUBCONTRACTOR TO PROVIDE & INSTALL CELLULAR ANNUNCIATOR & PANEL. G.C. TO VERIFY WEEK ONE OF CONSTRUCTION WITH FIRE INSPECTOR IF A CELLULAR COMMUNICATOR IS ACCEPTABLE AS THE PRIMARY POINT OF CONNECTION FOR THE FIRE ALARM SYSTEM.

HFT FURNISHED ITEMS, G.C. TO INSTALL

- FIXTURES / FURNISHINGS:**
 - MILKWORK KIT FOR OFFICES
 - FIRE EXTINGUISHERS
 - PLASTIC BOLLARD COVERS
 - EYE WASH STATION AND CARTRIDGE
 - CORNER GUARDS
 - POWER POLES
 - FORKLIFT BATTERY CHARGER STATION AND WATER TANK
 - MOP SINK SHELVES
 - UPRIGHT FRAME PROTECTORS
 - BOX BARS
 - BOLT DOWN BOLLARDS
 - INPRO WALL GUARD
 - DOCK FAN AND MOUNTING KIT (IF APPLICABLE)
 - GLASSBREAK DETECTOR
 - MICROWAVE DETECTOR
 - EXTERIOR DOOR CONTACTS
 - MECHANICAL:**
 - DIGITAL DIFFUSERS
 - 12" X 12" SQUARE PLIQUE DIFFUSERS
 - CABINET UNIT HEATER (IF APPLICABLE)
 - RECEIVING AREA UNIT HEATER (IF APPLICABLE)
 - PLUMBING FIXTURES:**
 - DRINKING FOUNTAIN AND STAINLESS STEEL WALL GUARDS
 - MOP SINK, FAUCET AND ACCESSORIES
 - BREAK ROOM SINK AND FAUCET
 - RESTROOM LAVATORIES, FAUCETS AND CARRIERS
 - WATER HEATER AND PAN EXPANSION TANK
 - ELECTRICAL:**
 - BURGLAR ALARM PANEL
 - WIRED ZONE EXPANDER
 - KEY PAD
 - SIREN
 - CEILING MOUNTED MOTION DETECTOR
 - GLASSBREAK DETECTOR
 - MOTION DETECTOR
 - MICROWAVE DETECTOR
 - EXTERIOR DOOR CONTACTS
 - OVERHEAD DOOR CONTACT**
 - EMPLOYEE TIME CLOCK**
 - DOOR BELL AND BUTTON**
 - FLOOR FINISHES:**
 - VESTIBULE CARPET TILE
 - LVT FLOORING
 - WALL BASE
 - RESTROOM ACCESSORIES:**
 - HAND DRYERS AND WALL GUARDS
 - TOILET PAPER HOLDERS
 - MIRRORS
 - TOILET SEAT COVER DISPENSERS
- NOTE: G.C. TO PROVIDE (2) 40'-0" CONEX CONTAINERS FOR TEMPORARY STORAGE OF HFT SUPPLIED ITEMS. COORDINATE DELIVERY / PLACEMENT WITH HFT PM.**

SITE VICINITY MAP




GENERAL NOTES

1. NO ADDITIONAL SITE CHANGES ARE REQUIRED, EXCEPT WHERE NOTED OTHERWISE ON ARCHITECTURAL FLOOR PLANS.

100 SERIES SITE PLAN KEY NOTES

- 100. MAIN TENANT ENTRANCE DOORS. SEE SHEET A1.1 AND A5.0 FOR ADDITIONAL INFORMATION.
- 101. ACCESSIBLE PATH OF TRAVEL.
- 102. EXISTING CONCRETE SIDEWALK BY LANDLORD UNDER A SEPARATE PERMIT.
- 103. EXISTING PARKING STRIPING.
- 104. EXISTING SITE LIGHTING BY LANDLORD UNDER A SEPARATE PERMIT.
- 105. EXISTING ACCESSIBLE PARKING SIGNAGE BY LANDLORD UNDER A SEPARATE PERMIT.
- 106. EXISTING ACCESSIBLE PARKING SYMBOL TO REMAIN.
- 107. EXISTING ACCESSIBLE AISLE STRIPING TO REMAIN.
- 108. AREA OF STRIPING TO DESIGNATE NO PARKING. STRIPING SHALL BE 4" WIDE, COLOR: P-7. DIAGONAL STRIPING @ 45°, 3'-0" O.C.
- 109. EXISTING CURB AT REAR OF DRIVE.
- 110. APPROXIMATE LOCATION OF CART CORRAL.
- 111. PAINT VERTICAL FACE OF CURB AND 6" HORIZONTAL EDGE OF CURB P-7.
- 112. PAINT 3'-0" HIGH WHITE LETTERING STATING "LOADING ZONE - NO PARKING," FONT: ARIAL NARROW.
- 113. APPROXIMATE LOCATION OF ELECTRIC METER AND DISCONNECT. SEE ELECTRICAL DRAWINGS FOR ADDITIONAL INFORMATION.
- 114. LOCATION OF EXISTING FROST SLAB BY LANDLORD UNDER A SEPARATE PERMIT.
- 115. EXISTING DUMPSTER LOCATION BY LANDLORD UNDER A SEPARATE PERMIT.
- 116. EXISTING FIRE HYDRANT.
- 117. EXISTING PAD MOUNTED TRANSFORMER.
- 118. APPROXIMATE LOCATION OF GAS METER. SEE PLUMBING DRAWINGS FOR ADDITIONAL INFORMATION.
- 119. 6" Ø BOLLARD. SEE SHEET A1.1 AND DETAIL 3AA.1 FOR ADDITIONAL INFORMATION.
- 120. 8" Ø BOLLARD. SEE SHEET A1.1 AND DETAIL 3AA.1 FOR ADDITIONAL INFORMATION.

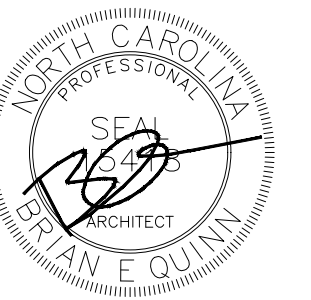


05/17/24

ADA ARCHITECTS
 17710 Detroit Avenue
 Lakewood, Ohio 44107
 Phone (216) 521-5134 Fax (216) 521-4824
 www.adaarchitects.com

HARBOR FREIGHT
 46 SHRUI LANE
 ERWIN, NC 28639


THESE DOCUMENTS CONTAIN INFORMATION PROPRIETARY TO ADA ARCHITECTS, INC.
 UNAUTHORIZED USE OF THESE DOCUMENTS IS EXPRESSLY PROHIBITED UNLESS AGREED UPON IN WRITING.

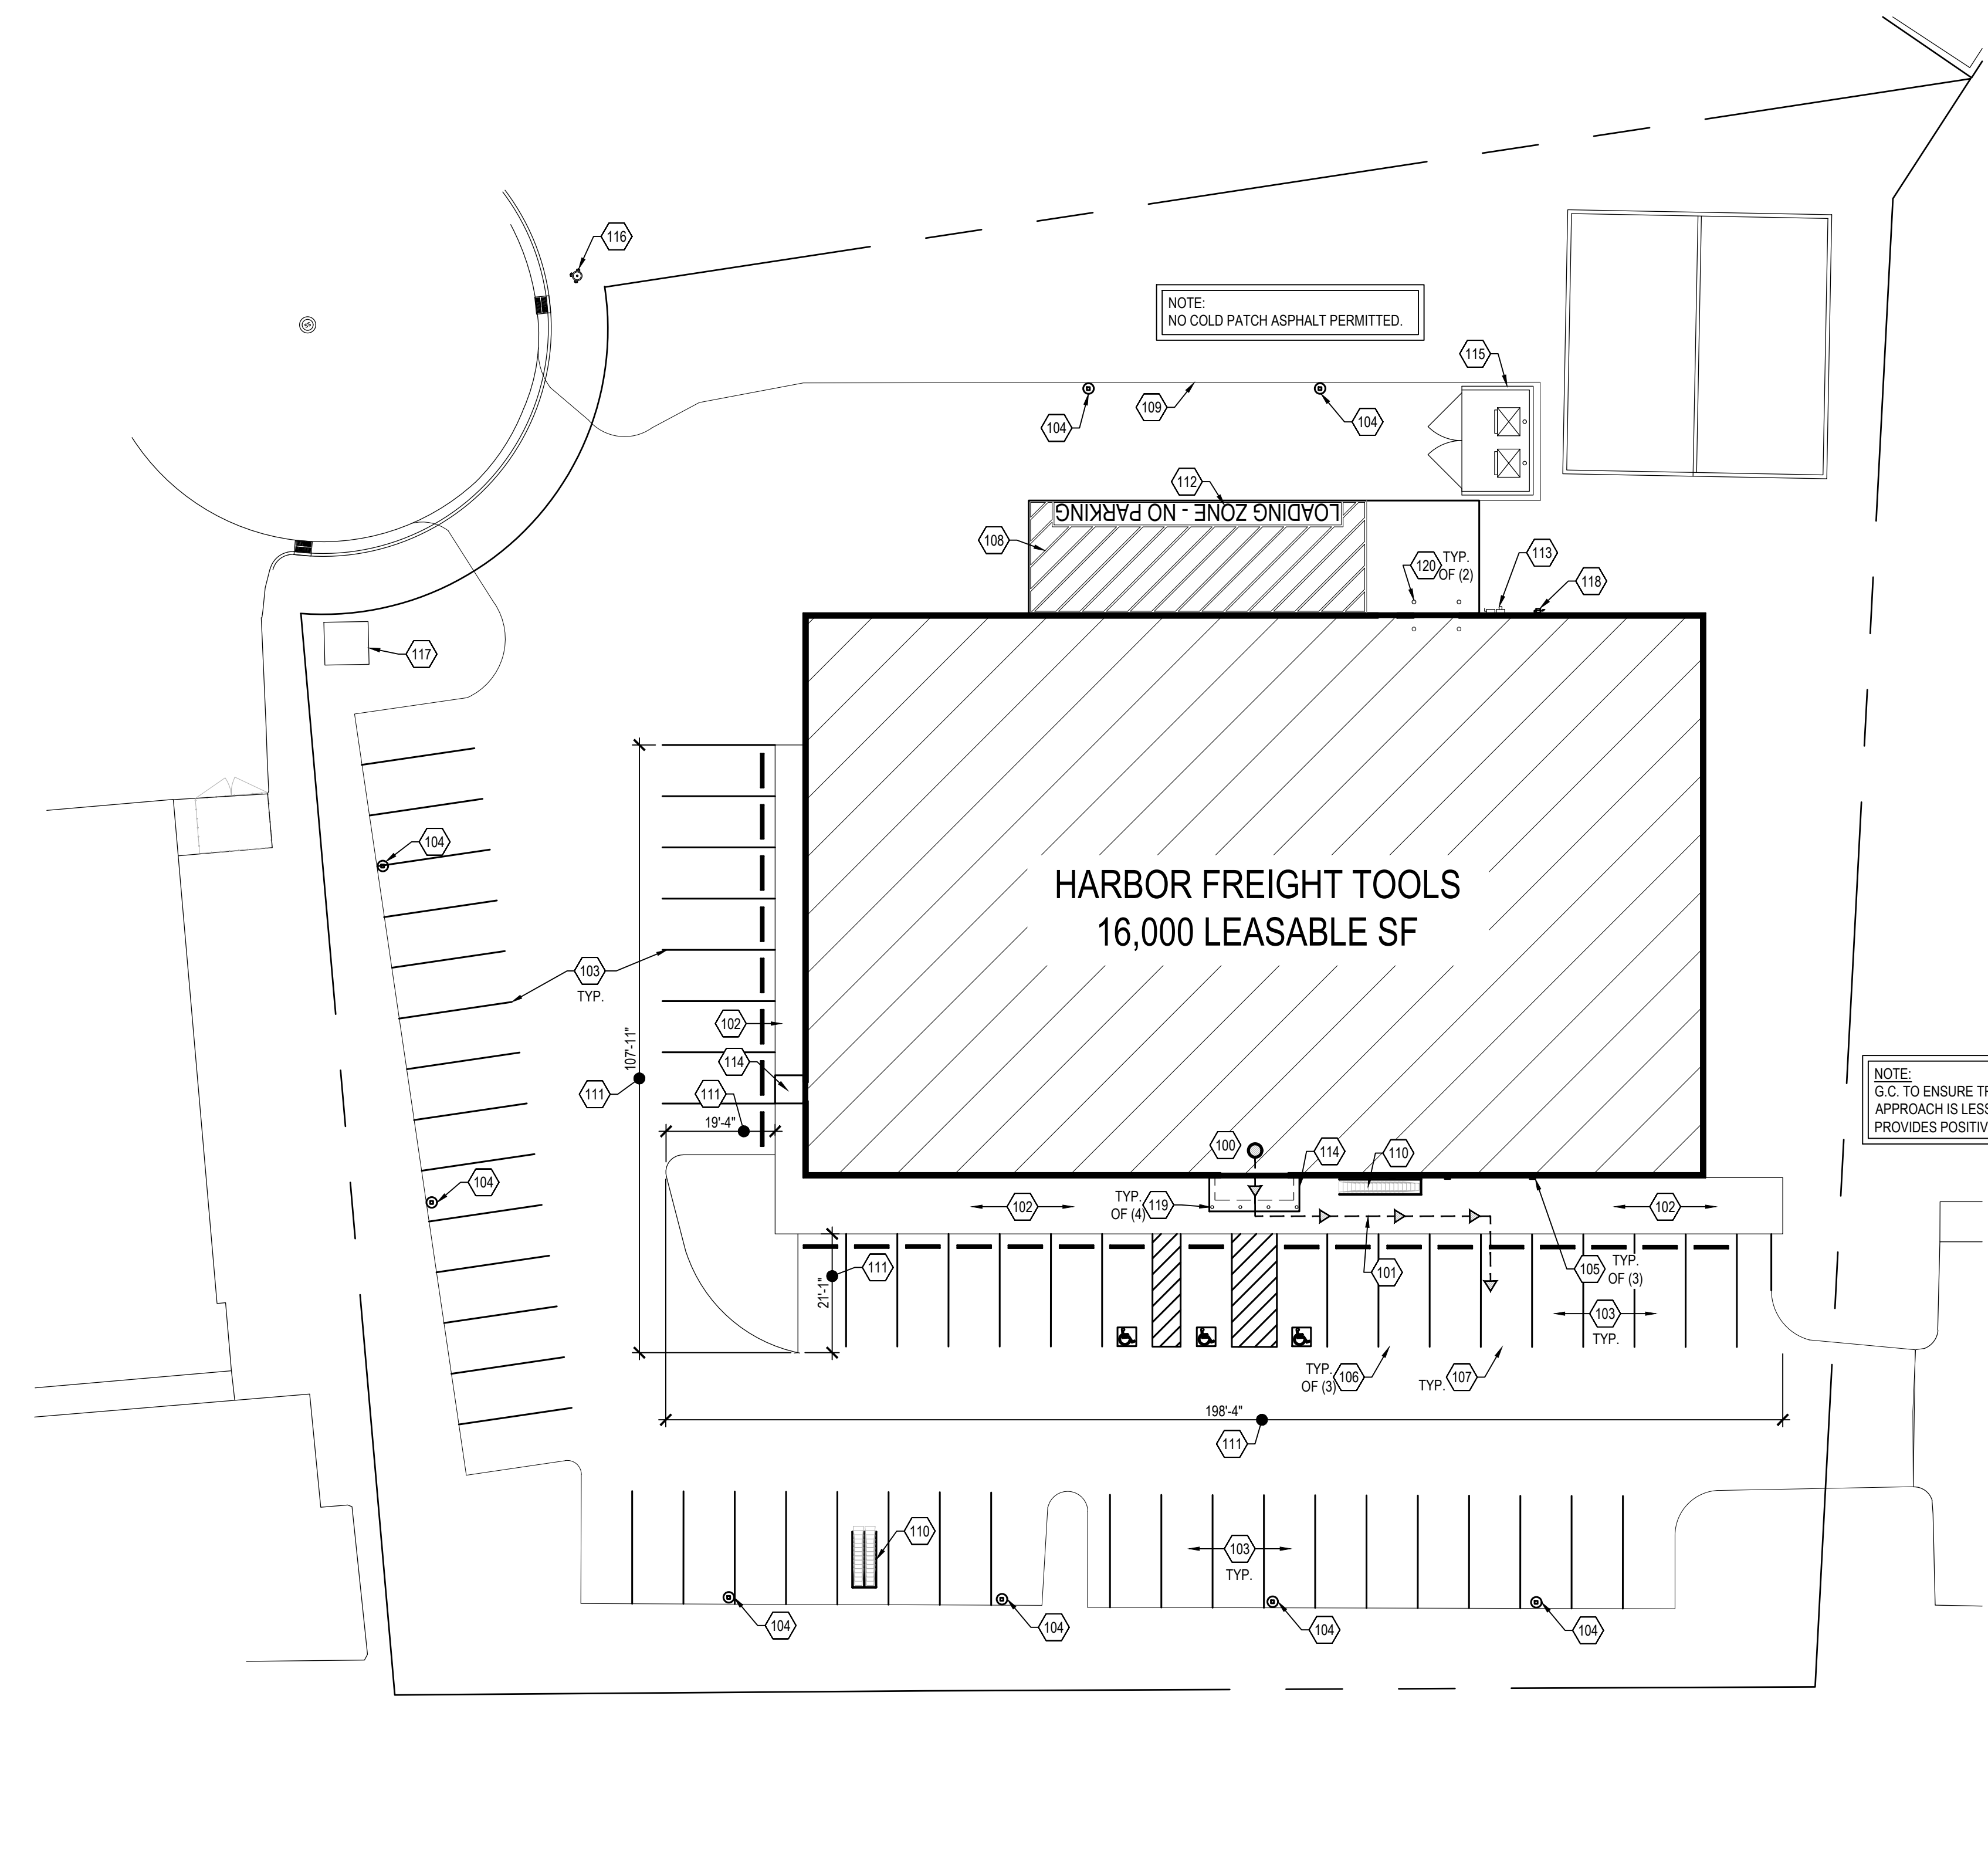

NOTE:
NO COLD PATCH ASPHALT PERMITTED.

NOTE:
G.C. TO ENSURE TRANSITION AT ENTRY APPROACH IS LESS THAN 1/8\"/>

NOTE:
LANDLORD IS RESPONSIBLE FOR THE ACCESSIBLE COMPLIANCE OF THE SITE, INCLUDING BUT NOT LIMITED TO APPROACH TO BUILDING AND ROUTE TO THE PUBLIC WAY, REQUIRED PARKING STALLS, AISLES AND SIGNAGE, SLOPES, CROSS SLOPE AND REQUIRED ELEMENTS.

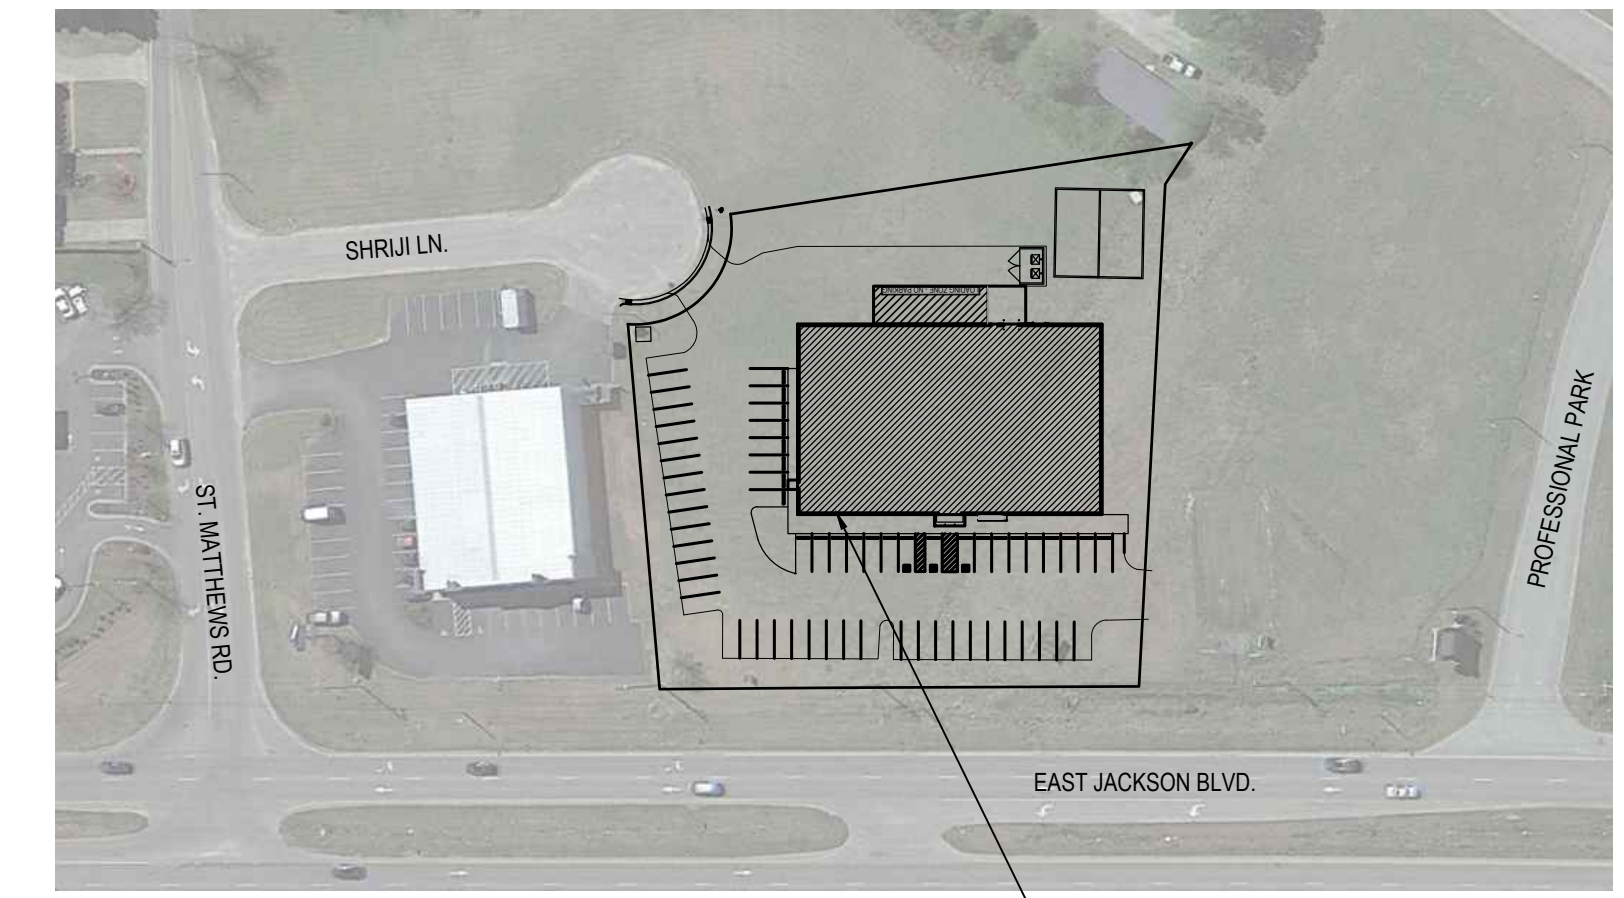

EAST JACKSON BOULEVARD (US 421 S)
ARCHITECTURAL SITE PLAN
 SCALE: 1" = 20'

OVERALL SITE PLAN
 NOT TO SCALE

DO NOT SCALE THESE DRAWINGS

REVISIONS	
#	DATE
1	
2	
3	
4	
5	
6	
7	
8	
9	
10	

ARCHITECTURAL SITE PLAN

DATE 05/17/24

JOB NO. 23475

AS1.0
SHEET NO.



05/17/24

ADA ARCHITECTS

17710 Detroit Avenue
Phone (716) 521-5134
Fax (216) 521-4824
www.adaarchitects.com

HARBOR FREIGHT

ERWIN, NC 28839
46 SHRIJI LANE

REVISIONS

#	DATE	TYPE
1		
2		
3		
4		
5		
6		
7		
8		
9		
10		

GENERAL NOTES

DATE 05/17/24

JOB NO. 23475

A0.2
SHEET NO.

- ALL WORK AND MATERIALS DESCRIBED HEREIN ARE THE RESPONSIBILITY OF EITHER THE LANDLORD OR THE TENANT'S GENERAL CONTRACTOR. THE TERMS "GENERAL CONTRACTOR", "CONTRACTOR", OR "SUBCONTRACTOR" REFER TO THOSE ENGAGED (SEE WORK RESPONSIBILITY CHART) TO PERFORM THE WORK.
- ALL RULES AND REGULATIONS, SCOPE OF WORK AND PROVISIONS INDICATED WILL BE PERFORMED BY THE SPECIFIC GENERAL CONTRACTOR, THEIR AGENTS, SUBCONTRACTORS, AND SUPPLIERS TO PROVIDE A TOTAL AND COMPLETE PROJECT FOR THE TENANT. WORK SHOWN IN THESE NOTES IS TO BE PERFORMED BY THE SPECIFIC GENERAL CONTRACTOR OR SUBCONTRACTORS, AGENTS AND/OR SUPPLIERS ONLY, WHETHER OR NOT THE WORK IS DELINEATED PROPERLY.
- BOTH THE LANDLORD AND THE TENANT'S GENERAL CONTRACTOR ARE REQUIRED TO HAVE ALL SUBCONTRACTORS REVIEW THESE NOTES PRIOR TO BIDDING AND TO FAMILIARIZE ALL PERSONS AND SUBCONTRACTORS WORKING ON THIS PROJECT WITH THESE GENERAL NOTES AND THE CONTRACT DOCUMENTS NOTED. LANDLORD'S DESIGN CRITERIA (IF APPLICABLE) AND THE EXECUTED LEASE AGREEMENT BETWEEN LANDLORD AND TENANT, ANY DISCREPANCY BETWEEN THESE AND THE LEASE OR DESIGN CRITERIA INFORMATION IS TO BE REMEDIATED BY THE TENANT OR ARCHITECT PRIOR TO THE START OF ANY WORK. BOTH GENERAL CONTRACTORS SHALL BE RESPONSIBLE FOR FULLY ACQUAINTING THEMSELVES WITH THE CONTENT AND SCOPE OF THESE DOCUMENTS. WORK DECLARED UNACCEPTABLE BY THE TENANT AND LANDLORD SHALL BE CORRECTED IN A MANNER AND TO A DEGREE OF QUALITY AS ACCEPTABLE BY THE TENANT AND LANDLORD.
- BOTH GENERAL CONTRACTORS, AS APPLICABLE, AND ALL SUBCONTRACTORS ARE REQUIRED TO CHECK AND VERIFY ALL DIMENSIONS AND FIELD CONDITIONS AT BUILDING SITE AND PREMISES AND NOTIFY THE LANDLORD, THE LANDLORD'S REPRESENTATIVE AND TENANT'S PROJECT ARCHITECT OR TENANT'S CONSTRUCTION REPRESENTATIVE OF ANY AND ALL DISCREPANCIES AND LIST ANY WORK NOT YET COMPLETED BEFORE STARTING WORK. IF A GENERAL CONTRACTOR IS REQUIRED TO INSTALL A BARRICADE DURING THE CONSTRUCTION PHASE OF THIS PROJECT, SUCH BARRICADE TO MEET THE LATEST BARRICADE DESIGN REQUIREMENTS OF THE TENANT, INCLUDING THE PAINTING OF SUCH BARRICADE AND ANY SIGNAGE. ADDITIONALLY, THIS BARRICADE MUST BE MOVED OUT AS REQUIRED FOR WORK AND/OR REMOVED AT THE END OF THE CONSTRUCTION TIME PERIOD. CHECK WITH THE LANDLORD TO VERIFY IF A BARRICADE HAS PREVIOUSLY BEEN INSTALLED ON THESE PREMISES IN ANTICIPATION OF CONSTRUCTION BY THE TENANT; IF THIS IS THE CASE, DO NOT INCLUDE ANY COST FOR THE ACTUAL BARRICADE BUT DO INCLUDE COSTS FOR MOVING SUCH BARRICADES IN AND OUT.
- ALL CONTRACTORS SHALL CHECK AND VERIFY ALL FIELD CONDITIONS AND SHALL HAVE SOLE RESPONSIBILITY FOR VERIFICATION OF CLEAR HEIGHTS WITHIN THE PREMISES, ANY DISCREPANCIES SHALL BE REPORTED TO THE ARCHITECT IMMEDIATELY. A GENERAL CONTRACTOR IS TOTALLY RESPONSIBLE FOR ALL "HOLD" DIMENSIONS AND IS TO CONTACT THE ARCHITECT, THE TENANT AND THE TENANT'S CONSTRUCTION REPRESENTATIVE OF ANY DISCREPANCIES VERBALLY AND ALSO IN WRITING PRIOR TO BUILDING WALLS, THEREAFTER, QUISIONS, TENANT'S FIXTURES FIT INTO PLACE WITH NO ROOM FOR ERROR. CONTRACTOR MUST REVIEW ENTIRE SET OF CONTRACT DOCUMENTS FOR CEILING HEIGHTS.
- WHEN BIDDING THIS PROJECT, EACH CONTRACTOR SHALL BE RESPONSIBLE FOR VISITING THE SITE PRIOR TO BIDDING AND VERIFYING EXISTING CONDITIONS AS REFLECTED IN THESE CONTRACT DOCUMENTS. ANY EXTRA WORK REQUIRED BUT NOT INCLUDED IN THE DOCUMENTS SHALL BE REPORTED TO THE TENANT OR TENANT'S ARCHITECT IMMEDIATELY.
- ALL WORK ON THIS PROJECT SHALL BE IN ACCORDANCE WITH ALL CODES, SUB-CODES, BUILDING DEPARTMENT REQUIREMENTS AND HEALTH DEPARTMENT REQUIREMENTS. GENERAL CONTRACTOR TO CONTACT LOCAL BUILDING OFFICIALS FOR SPECIFIC REQUIREMENTS FOR THIS USE.
- THE CONTRACTOR SHALL BE SOLELY RESPONSIBLE FOR AND HAVE CONTROL OVER CONSTRUCTION MEANS, METHODS, TECHNIQUES, SEQUENCES, AND PROCEDURES AND FOR COORDINATING ALL PORTIONS OF THE WORK UNDER THE CONTRACT, INCLUDING ANY AND ALL OSHA REQUIREMENTS, UNLESS CONTRACT DOCUMENTS GIVE OTHER SPECIFIC INSTRUCTIONS CONCERNING THESE MATTERS.
- THE GENERAL CONTRACTOR, WHETHER WORKING FOR THE LANDLORD OR THE TENANT, AND THE SUBCONTRACTORS FOR THE GENERAL CONTRACTOR SHALL PAY FOR AND OBTAIN ALL PERMITS REQUIRED FOR THE WORK NOTED ON THESE PLANS. THIS INCLUDES COSTS FOR ALL INSPECTIONS BY AUTHORITIES HAVING JURISDICTION, BUILDING DEPARTMENT AND HEALTH DEPARTMENT PERMIT COSTS, AND PERMIT COSTS FOR FIXTURES SUPPLIED BY TENANT (IF APPLICABLE).
- ALL CLEARANCES OF PIPES AND DUCTWORK INSTALLED BY THE GENERAL CONTRACTOR, WHETHER WORKING FOR THE LANDLORD OR THE TENANT, OR SUBCONTRACTORS MUST BE MAINTAINED FOR ADEQUATE HEIGHTS REQUIRED FOR CEILING SYSTEM AND LIGHT FIXTURES. CONTRACTOR MUST REVIEW ENTIRE SET OF CONTRACT DOCUMENTS FOR CEILING HEIGHTS. GENERAL CONTRACTOR (OR DESIGNATED AUTHORIZED CONTRACTOR AT GENERAL CONTRACTOR'S EXPENSE) TO REMOVE OR REPLACE AS REQUIRED ANY AND ALL EXISTING P.V.C. PIPING WITH LOCAL CODE ALLOWABLE MATERIALS THROUGHOUT LEASED PREMISES.
- ALL WORK TO BE COMPLETED FOLLOWING LANDLORD'S CONSTRUCTION "RULES AND REGULATIONS", IF APPLICABLE. THE GENERAL CONTRACTOR, WHETHER WORKING FOR THE LANDLORD OR THE TENANT, IS RESPONSIBLE DURING THE BIDDING PROCEDURES, FOR CONTACTING THE LANDLORD'S REPRESENTATIVE FOR A COPY OF THESE "RULES AND REGULATIONS" AND TO INCLUDE ANY COSTS IN THE WORK QUOTED TO THE LANDLORD.
- GENERAL CONTRACTOR, WHETHER WORKING FOR THE LANDLORD OR THE TENANT, AGREES THAT IN THE PERFORMANCE OF TENANT'S WORK AT THE PREMISES, ALL WORK SHALL BE PERFORMED IN A MANNER WHICH WILL NOT CREATE ANY WORK STOPPAGE, PICKETING, LABOR DISRUPTION OR DISPUTE OR VIOLATE LANDLORD'S LABOR CONTRACTS AFFECTING THE BUILDING OR INTERFERE WITH THE BUSINESS OF LANDLORD. IN THE EVENT OF THE OCCURRENCE OF ANY WORK STOPPAGE, PICKETING, LABOR DISRUPTION OR DISPUTE RESULTING FROM ACTIONS OR OMISSIONS OF GENERAL CONTRACTOR OR SUBCONTRACTORS OR ANY SUBTENANT OR CONCESSIONAIRE, OR THEIR RESPECTIVE EMPLOYEES, CONTRACTORS OR SUBCONTRACTORS, GENERAL CONTRACTOR SHALL, IMMEDIATELY UPON NOTICE FROM TENANT, CEASE THE CONDUCT GIVING RISE TO SUCH CONDITION. THIS CLAUSE MUST BE PART OF ALL GENERAL CONTRACTOR / SUBCONTRACTOR AGREEMENTS AND IF SUCH CLAUSE IS NOT INCLUDED, IT WILL NOT RELIEVE THE GENERAL CONTRACTOR OF THE REQUIREMENTS OR WORK STATED HEREIN.
- ALL CONTRACTORS, WHETHER WORKING FOR THE LANDLORD OR THE TENANT, SHALL BE BONDED, LICENSED CONTRACTORS POSSESSING GOOD LABOR RELATIONS AND MUST MAINTAIN A WORKMANSHIP. IN HARMONY WITH OTHER CONTRACTORS WORKING ON THE PROJECT, THE TENANT IS TO BE NOTIFIED IN WRITING OF THE NAMES, ADDRESSES, DAYTIME PHONE, FAX, AND EMERGENCY PHONE NUMBERS OF ALL SUBCONTRACTORS AND SUPPLIERS WORKING ON THIS PROJECT. GENERAL CONTRACTOR MUST ATTEST THAT NO PRODUCTS CONTAINING ASBESTOS OR HAZARDOUS MATERIAL WERE KNOWINGLY USED ON THIS PROJECT.
- PRIOR TO COMMENCEMENT OF ANY WORK, THE GENERAL CONTRACTOR, WHETHER WORKING FOR THE LANDLORD OR THE TENANT, SHALL CONTACT AND MEET WITH LANDLORD'S TENANT COORDINATOR AND TENANT'S PROJECT MANAGEMENT REPRESENTATIVE FOR A PRE CONSTRUCTION MEETING. AT WHICH TIME HE/she will PRESENT TO ALL PARTIES A LIST OF NAMES, ADDRESSES, BUSINESS PHONE, FAX AND EMERGENCY TELEPHONE NUMBERS OF THE SUBCONTRACTORS FOR THIS PROJECT. THE GENERAL CONTRACTOR WILL COMPLETE THE CHECKLIST FORM (CONTRACTOR INFORMATION FORM) REQUIRED FOR EACH TENANT'S SPACE THAT CONTRACTOR WILL BE WORKING ON AS REQUIRED UNDER LEASE OBLIGATION. THE CHECKLIST FORM INCLUDING SCHEDULE INFORMATION AS WELL AS GENERAL CONTRACTOR AND SUBCONTRACTORS INFORMATION IS TO BE SUBMITTED TO THE LANDLORD'S REPRESENTATIVE UPON ARRIVAL AT THE JOB SITE.
- GENERAL CONTRACTOR, WHETHER WORKING FOR THE LANDLORD OR THE TENANT, SHALL HAVE AT ALL TIMES, AT THE PREMISES, REPRESENTATIVE APPROVED CONTRACT DOCUMENTS, BUILDING DEPARTMENT AND HEALTH DEPARTMENT (IF APPLICABLE) APPROVED PERMIT DRAWINGS.
- GENERAL CONTRACTOR, WHETHER WORKING FOR THE LANDLORD OR THE TENANT, IS TO ARRANGE WITH THE LANDLORD FOR THE BUILDING, WHERE BUILDING EQUIPMENT AND MATERIALS ARE TO BE LOCATED AND HOW TRUCK TRAFFIC IS TO BE ROUTED TO AND FROM THE BUILDING.
- AN APPROVAL BY THE TENANT WILL ONLY BE VALID IF IN WRITING AND SIGNED BY THE TENANT OR BY THE TENANT'S DESIGNATED REPRESENTATIVE FOR SUCH PURPOSES. THE GENERAL CONTRACTOR, WHETHER WORKING FOR THE LANDLORD OR THE TENANT, WILL BE RESPONSIBLE FOR OBTAINING APPROVAL FROM TENANT'S ARCHITECT ON ALL STRUCTURAL CHANGES DURING THE COURSE OF THE CONSTRUCTION PHASE OF PROJECT, AS WELL AS VERIFICATION OF CORRECT INSTALLATION AND SPECIFICATION FOR MISCELLANEOUS STEEL, FOR MECHANICAL SYSTEMS, STEEL, FOR MEZZANINES (IF APPLICABLE), DUCTS, AND THE LANDLORD'S REQUIREMENTS FOR THE GENERAL CONTRACTOR TO MAINTAIN THE STRUCTURE OF TENANT'S STRUCTURE. ANY STRUCTURAL WORK ON PROJECT TO INCLUDE BUT NOT BE LIMITED TO MECHANICAL EQUIPMENT, SUPPORTS, HANGING SYSTEMS, CONCRETE SLABS, COSTS, ETC.
- ALL FINISH AND EXPOSED WOOD SHALL BE KILN DRIED, MILL QUALITY FINISH AND SHALL RECEIVE A FIRE RETARDANT COATING OR TREATMENT IF REQUIRED BY CODE OR THE LOCAL FIRE MARSHALL. NO WOOD OR COMBUSTIBLE MATERIAL SHALL BE USED ABOVE THE SUSPENDED CEILING UNLESS NONCOMBUSTIBLE LINING IS USED AND IS SPECIFICALLY ALLOWED BY APPLICABLE BUILDING CODES. THE FIRE MARSHALL AND ALL AGENCIES HAVING JURISDICTION, IF FIRE TREATED WOOD IS REQUIRED FOR FIXTURING ITEMS, THE GENERAL CONTRACTOR, WHETHER WORKING FOR THE LANDLORD OR THE TENANT, IS RESPONSIBLE FOR EXECUTING THIS WORK AS PER BUILDING OFFICIALS' REQUIREMENTS.
- GENERAL CONTRACTOR, WHETHER WORKING FOR THE LANDLORD OR THE TENANT, SHALL FURNISH AND INSTALL, AS REQUIRED, BEGINNING WITH THE CONSTRUCTION PHASE, HAND OPERATED FIRE EXTINGUISHERS, U.L. RATED, AS PER LOCAL CODE REQUIREMENTS; PLACEMENT AS APPROVED BY TENANT AND LOCAL BUILDING OFFICIAL.
- ALL CEILINGS SHALL BE UNDERWRITERS APPROVED AND OF THE NON COMBUSTIBLE TYPE. SEE CEILING SPECIFICATION WITHIN THE CONTRACT DOCUMENTS.
- GENERAL CONTRACTOR, WHETHER WORKING FOR THE LANDLORD OR THE TENANT, SHALL BE RESPONSIBLE FOR DAILY REMOVAL, OR AS REQUIRED BY LANDLORD, OF TRASH, RUBBISH AND SURPLUS MATERIALS RESULTING FROM CONSTRUCTION. THE CONTRACTORS AND SUBCONTRACTORS PARTICIPATING IN THE PERFORMANCE OF TENANT'S WORK SHALL REMOVE AND DISPOSE OF, AT LEAST ONCE A WEEK, AND MORE FREQUENTLY AS TENANT MAY DIRECT, ALL DEBRIS AND RUBBISH CAUSING INTERFERENCE WITH THE PERFORMANCE OF TENANT'S WORK. SUCH DEBRIS AND RUBBISH TO BE REMOVED, ALL TEMPORARY STRUCTURES, SURPLUS MATERIALS, DEBRIS AND RUBBISH OF WHATEVER KIND REMAINING IN THE BUILDING WHICH HAD BEEN BROUGHT IN OR CREATED BY THE CONTRACTOR AND SUBCONTRACTORS IN THE PERFORMANCE OF TENANT'S WORK. THIS CONTRACTOR MUST MAINTAIN A CLEAR PATH OF EGRESS FROM THE PREMISES FREE FROM TRASH AND RUBBISH AT ALL TIMES. ALL REMOVAL OF CONSTRUCTION DEBRIS TO AN APPROVED DUMPING SITE TO BE INCLUDED IN THE GENERAL CONTRACTOR'S WORK.
- ALL EXITS SHALL BE UNOBSTRUCTED AT ALL TIMES DURING CONSTRUCTION AND OCCUPANCY.
- GENERAL CONTRACTOR, WHETHER WORKING FOR THE LANDLORD OR THE TENANT, SHALL FURNISH AND PAY FOR ALL TEMPORARY UTILITY SERVICES DURING THE COURSE OF CONSTRUCTION.
- EACH CONTRACTOR, WHETHER WORKING FOR THE LANDLORD OR THE TENANT, AND SUBCONTRACTOR PARTICIPATING IN THE PERFORMANCE OF TENANT'S WORK SHALL (A) MAKE APPROPRIATE ARRANGEMENTS WITH LANDLORD FOR TEMPORARY UTILITY CONNECTIONS INCLUDING WATER AND ELECTRICITY, AS AVAILABLE WITHIN THE BUILDING, WHICH CONNECTIONS SHALL BE AT SUCH LOCATIONS AS SHALL BE DETERMINED BY LANDLORD; (B) PAY THE COST OF THE CONNECTIONS AND OF PROPER MAINTENANCE AND REMOVAL OF SAME, AND (C) PAY ALL UTILITY CHARGES INCURRED AT THE PREVAILING RATES OF THE UTILITY COMPANY PROVIDING SUCH SERVICE TO THE BUILDING, DURING THE COURSE OF CONSTRUCTION UP TO AND INCLUDING THE DATE OF "TURN OVER" TO THE TENANT.
- IT IS THE GENERAL CONTRACTOR'S REQUIREMENT, WHETHER WORKING FOR THE LANDLORD OR THE TENANT, THROUGH ITS SUBCONTRACTORS, TO RECONFIGURE AND BRING IN NEW UTILITY SERVICES AS REQUIRED, TO MEET THE NEEDS OF THESE SPECIFIC CONTRACT DOCUMENTS.
- GENERAL CONTRACTOR, WHETHER WORKING FOR THE LANDLORD OR THE TENANT, AND ALL SUBCONTRACTORS WORKING ON THIS PROJECT ARE RESPONSIBLE FOR CONTACTING THE PUBLIC UTILITY COMPANIES SUPPLYING UTILITIES TO THE AREA WHERE THE PROJECT IS LOCATED, IN ORDER TO VERIFY LOCATIONS OF UTILITIES, UNDERGROUND OR OVERHEAD, AND SECURE THE PROPER PROCEDURES WHILE WORKING ADJACENT TO, ABOVE OR NEAR SUCH UTILITIES TO AVOID ANY PROBLEMS WITH EXPLOSIONS, DISCONNECTION, REMOVALS, ETC.
- GENERAL CONTRACTOR, WHETHER WORKING FOR THE LANDLORD OR THE TENANT, SHALL APPLY FOR ALL UTILITY METERS AND NOTIFY THE UTILITY COMPANY OF THE NAME, ADDRESS AND PHONE NUMBERS OF THE TENANT FOR PERMANENT SERVICES. TENANT'S G.C. UNLESS OTHERWISE NOTED SHALL BRING IN ALL ADDITIONAL SERVICES, ADEQUATE FOR TENANT'S NEEDS AS REQUIRED, INCLUDING, BUT NOT LIMITED TO ELECTRIC, SPRINKLER, SOIL (WASTE), AND DOMESTIC WATER LINES (WHEN APPLICABLE).
- GENERAL CONTRACTOR, WHETHER WORKING FOR THE LANDLORD OR THE TENANT, AND / OR ITS ELECTRICAL SUBCONTRACTOR SHALL VERIFY ALL EQUIPMENT SPECIFICATIONS AND REQUIREMENTS WITH THE TENANT OR THE TENANT'S CONSTRUCTION REPRESENTATIVE PRIOR TO START OF CONSTRUCTION. THIS CONTRACTOR TO VERIFY AMPERAGE / VOLTAGE SPECIFICATIONS, WIRING SIZES AND REQUIREMENTS (SERVICE AND PANEL SPECIFICATION) WITH THE EQUIPMENT SUPPLIERS.
- ALL PLUMBING AND ELECTRICAL ROUGH-IN TO BE NEW AND ELECTRICAL SERVICE CONDUIT AND WIRE TO THE DEMISED PREMISES TO BE EXTENDED TO THE POINT OF NEW PANELS BY THE CONTRACTOR AS NECESSARY IS SHOWN ON CONTRACT DOCUMENTS. GENERAL CONTRACTOR, WHETHER WORKING FOR THE LANDLORD OR THE TENANT, TO FIELD VERIFY THAT THESE UTILITY LINES ARE AT OR ADJACENT TO TENANT'S SPACE AS NOTED AND AT THE SIZE SPECIFIED. BASED ON GENERAL CONTRACTORS OR SUBCONTRACTORS PRE-BID REVIEW OF PREMISES, IF THE UTILITIES ARE NOT IN LOCATIONS AS NOTED ON THE CONTRACT DOCUMENTS OR OF A SIZE LARGER OR SMALLER THAN NOTED, THIS CONTRACTOR IS TO MODIFY THE SERVICE ACCORDINGLY WITH EITHER NEW CONDUIT AND / OR NEW COPPER SERVICE WIRE EXTENDING BACK TO LANDLORD'S ELECTRICAL / METER ROOM SERVICE POINT, AND INCLUDE SUCH COSTS IN THE BID TO THE TENANT.
- THE ELECTRICAL SUBCONTRACTOR IS TO PROVIDE A CIRCUIT DIRECTORY WITH PROPER PHASING AND BALANCING, WHICH IS TO CONFORM TO THE LATEST EDITION OF THE NATIONAL ELECTRICAL CODE AND UNDERWRITERS CODE. THE SIGN'S JUNCTION BOX PERMIT IS TO BE INCLUDED IN THE WORK FOR THE ELECTRICAL SUBCONTRACTOR AND THE BOX IS TO BE SUPPLIED BY THIS CONTRACTOR AND PROPERLY LABELLED.
- GENERAL CONTRACTOR, WHETHER WORKING FOR THE LANDLORD OR THE TENANT, IS TO PROVIDE SHOP DRAWINGS OF ALL MILLWORK AND FIXTURES, PRIOR TO START OF CONSTRUCTION, FOR APPROVAL BY THE TENANT'S ARCHITECT.
- THE PROPER RECEIPT OF ALL NEW MATERIALS AND EQUIPMENT AT THE JOB SITE IS THE RESPONSIBILITY OF THE GENERAL CONTRACTOR, WHETHER WORKING FOR THE LANDLORD OR THE TENANT, AND / OR ITS SUBCONTRACTORS IF ANY. SECURE AND SAFE STORAGE OF ALL NEW AND EXISTING MATERIALS AND EQUIPMENT TO REMAIN (IF ANY) WILL BE PROVIDED BY THE GENERAL CONTRACTOR. GENERAL CONTRACTOR TO IMMEDIATELY ADVISE TENANT OR TENANT'S REPRESENTATIVE OF ALL DAMAGED OR DEFICIENT SHIPMENTS OF MATERIALS AND EQUIPMENT, WHETHER SUPPLIED BY TENANT OR DIRECTLY BY CONTRACTOR OR ITS SUPPLIERS. GENERAL CONTRACTOR TO COMPLETE AND SUBMIT ALL NECESSARY PAPERWORK AND ARRANGE INSPECTIONS OF DAMAGED GOODS AS PER TENANT CONSTRUCTION DEPT. REQUIREMENTS. NOTIFY TENANT, OR TENANT'S REPRESENTATIVE OF ANY POSSIBLE DELAYS. INCOMPLETE ORDERS AND DELAYS ARE TO BE IMMEDIATELY BROUGHT TO THE ATTENTION OF THE SUPPLIER AND THE ARCHITECT. SUBMIT CONFIRMATION OF ALL ORDERS, DELIVERY DATES, AND A FULL WRITTEN SCHEDULE TO TENANT'S ARCHITECT.

- ALL EXISTING MAIN AND NEW BUILDING ENTRY GLASS AND DOORS, STOREFRONT AND INTERIOR GLAZING, IF APPLICABLE, MUST COMPLY WITH ALL APPLICABLE CODES. LANDLORD'S CRITERIA, LANDLORD'S AND TENANT'S CONTRACT DOCUMENTS AND SAFETY GLAZING STANDARDS. GENERAL CONTRACTOR, WHETHER WORKING FOR THE LANDLORD OR THE TENANT, TO VERIFY IN FIELD ALL EXISTING GLAZING TO REMAIN MEETS OR EXCEEDS SUCH CODES STANDARDS, ETC. INCLUDING BUT NOT LIMITED TO TYPE, SUPPORT, FRAMING METHODS, ETC., AND UPGRADE IF OR AS REQUIRED. ALL STOREFRONTS TO BE INSTALLED BY GLAZING SUBCONTRACTORS CAREFULLY FOLLOWING REQUIREMENTS AND DETAILS FOR DESIGN AGAINST WIND LOAD CONSIDERATIONS, EVEN THOUGH SUCH INSTALLATION OF STOREFRONT GLAZING MAY BE IN AN ENCLOSED BUILDING. GENERAL CONTRACTOR TO VERIFY EXISTING STRUCTURAL SUPPORT HANGING JOINTS COVER REINFORCING AND IF STRUCTURAL SPANS ABOVE FOR SUCH HANGING EXCEED NORMAL HANGING SUPPORT DETAILS OR SPAN AND / OR WIND LOAD CALCULATIONS ARE REQUIRED DUE TO LOCAL BUILDING DEPARTMENT REQUIREMENTS, THIS CONTRACTOR IS TO HIRE A LOCAL STRUCTURAL CONSULTANT TO DESIGN SUCH SUPPORT SYSTEM HANGERS AND COMPLETE ALL STRUCTURAL CALCULATIONS / DRAWINGS IN THOSE AREAS WHERE SUCH INFORMATION IS REQUIRED AND TO INCLUDE SUCH COSTS IN THE BID TO THE TENANT.
- ANY SUBSTITUTIONS OF FINISH MATERIALS MUST BE APPROVED BY THE TENANT'S ARCHITECT IN WRITING. THE GENERAL CONTRACTOR, WHETHER WORKING FOR THE LANDLORD OR THE TENANT, IS RESPONSIBLE FOR SUBMITTING TWO (2) SAMPLES OF EACH SUBSTITUTION.
- ALL THE FLOOR FINISHES, WITHIN THE PREMISES, OR AT THE TRANSITION BETWEEN LANDLORD FLOOR FINISHES AND TENANT'S FLOOR FINISHES (AT ENTRY OR REAR DOOR, IF APPLICABLE) ARE TO BE SMOOTH AND LEVEL, TO AVOID TRIPPING HAZARDS AND BE WITHIN THE REQUIREMENTS OF BARRIER FREE DESIGN. IF AN EXPANSION JOINT COVER IS REQUIRED, SUCH COVER IS TO BE LEVEL AND SMOOTH WITH TENANT'S FLOOR FINISH ELEVATION AND WILL NOT PROTRUDE ABOVE SUCH FLOOR FINISH ELEVATION. IF THE EXISTING SLABS ARE NOT LEVEL, THE GENERAL CONTRACTOR, WHETHER WORKING FOR THE LANDLORD OR THE TENANT, IS REQUIRED TO COMPLETE FLASH PATCHING THROUGHOUT TO OBTAIN A SMOOTH AND LEVEL CONCRETE SLAB.
- SHOULD AN EXPANSION JOINT OCCUR IN THE LEASED PREMISES, GENERAL CONTRACTOR, WHETHER WORKING FOR THE LANDLORD OR THE TENANT, IS RESPONSIBLE FOR ALL CONSTRUCTION AFFECTED BY SUCH JOINT, INCLUDING FURNISHING AND INSTALLING A LEVEL, SLAB HEIGHT EXPANSION JOINT COVER, INCLUDING FLOOR, WALLS AND CEILING. GENERAL CONTRACTOR SHALL MAINTAIN INTEGRITY OF ALL SUCH EXPANSION JOINTS IN A MANNER CONSISTENT WITH ACCEPTABLE CONSTRUCTION DESIGN PRACTICES.
- ANY SCAFFOLDING, SAFETY RAILINGS, BARRICADES AND / OR PROTECTION DEVICES REQUIRED FOR THE PROJECT WILL BE FURNISHED AND PAID FOR BY THE GENERAL CONTRACTOR, WHETHER WORKING FOR THE LANDLORD OR THE TENANT. AS PART OF THE BASE BID, PROTECTION OF WORK IN PLACE - WORK IN PLACE THAT IS SUBJECT TO DAMAGE BECAUSE OF OPERATIONS BEING CARRIED ON ADJACENT THERETO SHALL BE COVERED, BOARDED UP, OR SUBSTANTIALLY ENCLOSED WITH ADEQUATE PROTECTION. ALL FORMS OF PROTECTION SHALL BE CONSTRUCTED IN A MANNER SUCH THAT, UPON COMPLETION, THE ENTIRE WORK AREA WILL BE DELIVERED TO THE OWNER IN PROPER, WHOLE, AND UNBLESHEMED CONDITION. ALL SUCH WORK SHALL BE COORDINATED WITH THE TENANT'S REPRESENTATIVE. THE TENANT'S ARCHITECT IS NOT RESPONSIBLE FOR JOB SITE SAFETY OR EXISTING CONDITIONS AT THE JOB SITE AND SINCE ALL WORK IS BY GENERAL CONTRACTOR FOR THE TENANT "FIT-OUT", THEIR REPRESENTATIVES WILL BE REQUIRED TO DO ALL SUPERVISION, OBSERVATIONS AND JOB SITE SAFETY.
- THE STRUCTURAL SYSTEM OF THE BUILDING HAS BEEN DESIGNED TO CARRY A MAXIMUM LIVE LOAD AS SPECIFIED IN THE LANDLORD'S CRITERIA, AND THE LANDLORDS OR TENANT'S CRITERIA, AS APPLICABLE. THE GENERAL CONTRACTOR AND / OR ANY AND ALL MATERIAL SUPPLY HANDLERS SHALL NOT IMPOSE ANY LOADING FOR ANY OF THE TENANT'S WORK ON A TEMPORARY OR PERMANENT BASIS WHICH CAN EXCEED SUCH SPECIFIED LOAD.
- ANY ALTERATIONS, ADDITIONS, DRILLING, WELDING OR OTHER ATTACHMENT OR REINFORCEMENTS TO LANDLORD'S STRUCTURE TO ACCOMMODATE TENANT'S WORK SHALL NOT BE PERFORMED WITHOUT, IN EACH INSTANCE, GENERAL CONTRACTOR, WHETHER WORKING FOR THE LANDLORD OR THE TENANT, OBTAINING LANDLORD'S PRIOR WRITTEN APPROVAL, AND THIS CONTRACTOR SHALL LEAVE LANDLORD'S STRUCTURE AS STRONG AS, OR STRONGER THAN, THE ORIGINAL DESIGN AND WITH FINISHES UNIMPAIRED. ONLY UTILIZE LANDLORD'S DESIGNATED ROOFING CONTRACTOR FOR ALL ROOF PENETRATIONS, FLASHING AND COUNTER FLASHING.
- SPRINKLER SYSTEM DESIGN AND / OR LAYOUT MODIFICATION, (IF APPLICABLE) TO BE PROVIDED BY THE DESIGNATED SPRINKLER SUBCONTRACTOR AND ALL SUBMISSIONS TO THE FIRE MARSHAL AND BUILDING INSPECTOR FOR THE NECESSARY APPROVAL ARE THE RESPONSIBILITY OF THE SPRINKLER SUBCONTRACTOR. GENERAL CONTRACTOR, WHETHER WORKING FOR THE LANDLORD OR THE TENANT, TO VERIFY WITH THE LANDLORD OR LANDLORD'S CRITERIA IF SPRINKLER CONTRACTOR IS TO BE LANDLORDS APPROVED OR DESIGNATED CONTRACTOR. APPROVALS BY LANDLORD, LANDLORD'S INSURANCE UNDERWRITER AND THE BUILDING INSPECTOR AND FIRE MARSHAL WILL BE REQUIRED.
- MECHANICAL SUBCONTRACTOR IS RESPONSIBLE FOR VISITING THE SITE PRIOR TO SUBMITTING A BID FOR THE WORK ON THIS PROJECT. THE CONTRACTOR MUST BECOME FAMILIARIZED WITH THE FIELD CONDITIONS, AND THE SCOPE OF WORK. CONTRACTOR TO ENGINEER, FURNISH AND INSTALL ANY / ALL REQUIRED FIRE ALARM, SMOKE EVACUATION, SMOKE DETECTION SYSTEMS, INCLUDING ANY / ALL PARTS AND LABOR (IF MOORE EXISTING SYSTEMS REQUIRED), TO MEET LOCAL CODES, LANDLORD REQUIREMENTS AND FIRE MARSHAL SPECIFICATION, WHETHER SUCH WORK IS OR IS NOT SHOWN IN THE CONSTRUCTION DOCUMENTS. IF A SMOKE EVACUATION AND / OR DETECTION SYSTEM OCCURS FOR THIS SPACE, IT SHALL BE LEFT INTACT DURING CONSTRUCTION. WHEN ANY MODIFICATION AND REWIRING TO BE COMPLETED DURING CONSTRUCTION PHASE TO POINT OF NEW PANELS, IF SMOKE DETECTORS ARE REQUIRED TO BE HARD WIRED TO LANDLORD FIRE ALARM SYSTEM, THEY ARE TO BE PER LANDLORD'S SYSTEM. CONTRACTOR TO CONTACT LANDLORD OR APPROVED AGENTS FOR PURCHASE AND INSTALLATION OF DETECTORS AT G.C. EXPENSE. G.C. AND / OR ITS FIRE ALARM SUBCONTRACTOR TO CONTACT LANDLORD FOR FINAL POINT OF CONNECTION TO LANDLORD'S FIRE ALARM JUNCTION BOX AND PERFORM WORK AT CONTRACTOR'S EXPENSE.
- GENERAL CONTRACTOR, WHETHER WORKING FOR THE LANDLORD OR THE TENANT, WILL FURNISH AND INSTALL A COMPLETE MECHANICAL SYSTEM TO INCLUDE BUT NOT BE LIMITED TO MECHANICAL EQUIPMENT, INSTALLED AND MOUNTED WITH DISCONNECT AND WIRING, HANGERS AND DUCTWAGE FOR SAME (INCLUDING THE THIRMS OF A LOCAL STRUCTURAL ENGINEER TO DESIGN SUCH DUNNAGE HANGERS), DUCTWORK, COLLARS, DIFFUSERS, REGISTERS, CONTROLS, TIME CLOCKS, ETC., WHETHER OR NOT SUCH WORK IS OR IS NOT SHOWN OR DELINEATED IN THE CONTRACT DOCUMENTS. GENERAL CONTRACTOR'S MECHANICAL CONTRACTOR(S) ARE REQUIRED TO COORDINATE WITH ALL OTHER CONTRACTORS ON JOB TO MAINTAIN TENANT'S CEILING HEIGHT, LIGHT FIXTURE LOCATION, SPRINKLER BRANCH LINES, ETC.
- ALL METAL FRAMING, GYPSUM BOARD, PARTITIONS, SOFFITS AND FACADES BY THE GENERAL CONTRACTOR, WHETHER WORKING FOR THE LANDLORD OR THE TENANT, UNLESS OTHERWISE NOTED.
- ALL GYPSUM BOARD TO BE FIRE TAPED AND SPOCKLED THREE (3) COATS, SANDED AND READY TO RECEIVE PAINT OR WALL COVERING. ALL EXISTING GYPSUM BOARD TO BE REPAIRED TO "LIKE NEW" CONDITION.
- ALL SWITCH, OUTLET PLATES, COVERS, GRILLES, DIFFUSERS, METAL TRIM (BUCKS, ETC.), ACCESSORIES TO BE FINISHED IN SAME COLOR / WALL COVERING AS ADJACENT WALL FINISHES, UNLESS NOTED OTHERWISE.
- ALL WORK THAT NEEDS TO BE COMPLETED BY THE GENERAL CONTRACTOR, WHETHER WORKING FOR THE LANDLORD OR THE TENANT, BELOW OR ABOVE THE PREMISES MAY HAVE TO BE DONE IN OTHER TENANT'S DEMISED PREMISES AND SUCH WORK NEEDS TO BE DONE IN COORDINATION WITH THE TENANT'S BELOW OR ABOVE THE PREMISES WORK OR PAYMENT FOR SECURITY THAT MAY BE NECESSARY. THE COST FOR THIS WORK, INCLUDING OVERTIME, MUST BE INCORPORATED IN THE BASE BID.
- THE CONSTRUCTION DRAWINGS LISTED IN THESE CONTRACT DOCUMENTS HAVE BEEN PREPARED BASED ON THE BEST INFORMATION AVAILABLE TO TENANT DURING PREPARATION OF THE CONTRACT DOCUMENTS. IN THE EVENT THAT PROBLEMS ARISE DURING THE COURSE OF THE PROJECT, DUE TO UNKNOWN SITE CONDITIONS OR CODE AND LANDLORD REQUIREMENTS (IF ANY) THAT CONFLICT WITH THE CONTRACT DOCUMENTS, THE GENERAL CONTRACTOR, WHETHER WORKING FOR THE LANDLORD OR THE TENANT, SHALL INFORM THE TENANT'S ARCHITECT IMMEDIATELY. ANY CHANGES THAT WILL BE REQUIRED, WILL BE DELINEATED BY TENANT ARCHITECT.
- QUALITY STANDARDS. ALL SUCH WORK SHALL BE PERFORMED IN A FIRST-CLASS WORKMANLIKE MANNER AND SHALL BE IN GOOD AND USABLE CONDITION AT THE DATE OF COMPLETION THEREOF. GENERAL CONTRACTOR, WHETHER WORKING FOR THE LANDLORD OR THE TENANT, SHALL REQUIRE ANY PERSON PERFORMING ANY SUCH WORK TO GUARANTEE THE SAME TO BE FREE FROM ANY AND ALL DEFECTS IN WORKMANSHIP AND MATERIALS FOR ONE (1) YEAR FROM THE DATE OF ISSUANCE OF THE CERTIFICATE OF OCCUPANCY. TENANT SHALL ALSO REQUIRE ANY SUCH PERSON TO BE RESPONSIBLE FOR THE DEFECTS. TENANT SHALL BE RESPONSIBLE FOR ANY AND ALL WORK DONE OR FURNISHED BY OR THROUGH SUCH PERSON, WHICH SHALL BECOME DEFECTIVE WITHIN ONE (1) YEAR AFTER COMPLETION OF THE WORK. THE CORRECTION OF SUCH WORK SHALL INCLUDE, WITHOUT ADDITIONAL CHARGE, ALL EXPENSES AND DAMAGES IN CONNECTION WITH SUCH REMOVAL, REPLACEMENT OR REPAIR OR ANY PART OF THE WORK WHICH MAY BE DAMAGED OR DISTURBED THEREBY. ALL WARRANTIES OR GUARANTEES AS TO MATERIALS OR WORKMANSHIP ON OR WITH RESPECT TO TENANT'S WORK SHALL BE CONTAINED IN THE CONTRACT OR SUBCONTRACT WHICH SHALL INSURE TO THE BENEFIT OF BOTH LANDLORD AND TENANT, AS THEIR RESPECTIVE INTERESTS APPEAR AND CAN BE DIRECTLY ENFORCED BY EITHER. GENERAL CONTRACTOR TO HAVE THIS CLAUSE IN EVERY SUBCONTRACTOR AGREEMENT FOR THE PROJECT AND IF SUCH CLAUSE IS NOT INCLUDED, IT WILL NOT RELIEVE THE GENERAL CONTRACTOR OF THE REQUIREMENTS OR WORK STATED HEREIN. **G.C. SHALL MAINTAIN A WRARRANT ITEMS AND REBATES INCLUDING MANAGING SUB-CONTRACTORS, VENDORS AND HFT VENDORS FOR A PERIOD OF ONE YEAR FROM TURNOVER.**
- TENANT'S WORK SHALL BE COORDINATED WITH THAT OF LANDLORD AND OTHER TENANTS IN THE BUILDING TO SUCH EXTENT THAT TENANT'S WORK WILL NOT INTERFERE WITH OR DELAY COMPLETION OF OTHER CONSTRUCTION WORK IN THE BUILDING.
- UPON COMPLETION OF ALL CONSTRUCTION AND PRIOR TO TURNOVER OF THE SPACE, THE GENERAL CONTRACTOR, WHETHER WORKING FOR THE LANDLORD OR THE TENANT, IS RESPONSIBLE FOR HAVING THE SPACE CLEANED; ANY CLEANING WHICH IS NOT DONE AT THE TIME OF TURNOVER AND NEEDS TO BE DONE BY THE TENANT, WILL BE BACK CHARGED TO THE GENERAL CONTRACTOR.
- ALL OF THE SUBCONTRACTORS QUOTING ON THEIR SPECIFIC SCOPE OF WORK/SERVICES TO CONTACT THE LOCAL BUILDING DEPARTMENT/AGENCY TO DISCUSS CODE ISSUES/DISCREPANCIES REGARDING THEIR SERVICES AND THE QUOTE ASSOCIATED WITH THE SERVICES TO THE GENERAL CONTRACTOR, WHETHER WORKING FOR THE LANDLORD OR THE TENANT, FOR THIS PROJECT. THIS CONTRACTOR TO BE FAMILIAR WITH THE SITE WHERE SUCH SERVICES ARE TO BE PERFORMED. THIS CONTRACTOR SHALL BE RESPONSIBLE FOR THE PERFORMANCE OF THE SERVICES AND HEALTH ASSOCIATED WITH THIS WORK AND TO INDICATE ON THE QUOTE ANY ITEMS REQUIRED THAT ARE NOT NECESSARILY SHOWN ON THE DRAWINGS/SPECIFICATIONS.
- CONSTRUCTION SHOWN TO REMAIN AS EXISTING SHALL BE REPAIRED, IF NECESSARY, IN A MANNER THAT WILL BE CONSISTENT WITH THE NEW CONSTRUCTION, AND PAINTED TO MATCH THE OVERALL COLOR SCHEME, UNLESS OTHERWISE NOTED.
- THE CONSTRUCTION SITE SHALL BE CLEANED AND TRASH REMOVED DAILY.
- ALL FINISHES TO BE AS NOTED AND SHALL NOT HAVE SMOKE DEVELOPED RATINGS GREATER THAN 450.
- INTERIOR FINISHES OF WALLS AND CEILINGS IN ALL ROOMS OR ENCLOSED SPACES SHALL HAVE A CLASS C FLAME SPREAD INDEX 76-200; SMOKE DEVELOPED INDEX 0-450. INTERIOR FINISHES OF EXIT ENCLOSURES AND EXIT PASSAGEWAYS SHALL HAVE A CLASS B FLAME SPREAD INDEX 26-75; SMOKE DEVELOPED INDEX 0-450. ASTM E 84. IFC TABLE 803.3.
- MATERIALS USED AS INTERIOR TRIM SHALL HAVE A MINIMUM CLASS C FLAME SPREAD AND SMOKE DEVELOPED INDEX AND SHALL COMPLY WITH ASTM E 84. COMBUSTIBLE TRIM SHALL NOT EXCEED 10% OF THE AGGREGATE WALL OR CLG. AREA IN WHICH IT IS LOCATED. IFC 804.
- INTERIOR WALL AND CEILING FINISHES SHALL COMPLY WITH NFPA 286 TESTING MEASURES. INTERIOR FLOOR FINISHES SHALL COMPLY WITH NFPA 253 WITH A CLASS 2 CRITICAL RADIANT FLUX > 0.22 WATTS / CM2. FLOOR FINISHES IN EXIT / ACCESS CORRIDORS SHALL BE CLASS 1 CRITICAL RADIANT FLUX > 0.45 WATTS / CM2.
- INTERIOR FINISH MATERIALS SHALL BE APPLIED SO THAT THEY WILL NOT BECOME READILY DETACHED WHERE SUBJECTED TO 200 DEGREES F. FOR NOT LESS THAN 30 MINUTES. IFC 803.2.
- THE REQUIRED FLAME SPREAD OR SMOKE DEVELOPED INDEX OF SURFACES IN EXISTING BUILDINGS MAY BE ACHIEVED BY APPLICATION OF APPROVED FIRE RETARDANT COATINGS AND SHALL COMPLY WITH NFPA 703. IFC 803.4.
- FIRE EXTINGUISHERS SHALL BE LOCATED AT THE DIRECTION OF THE FIRE DEPARTMENT, PROVIDED & INSTALLED BY HFT GENERAL CONTRACTOR.
- AT THE TIME OF SUBMITTING A BID, THE GENERAL CONTRACTOR IS TO HAVE CONFIRMED ALL FIELD MEASUREMENTS AND HAVE REVIEWED ALL FIELD CONDITIONS.
- G.C. SHALL VERIFY ALL RELEVANT DIMENSIONS, ELEVATIONS, ANGLES, AND EXISTING CONDITIONS BEFORE PROCEEDING WITH THE AFFECTED WORK AND NOTIFY THE ARCHITECT OF ANY DISCREPANCIES IMMEDIATELY. ALL DISCREPANCIES SHALL BE RESOLVED PRIOR TO CONTRACTOR PROCEEDING WITH AFFECTED WORK.
- THE CONTRACT WORK SHALL INCLUDE FURNISHING ALL MATERIALS, EQUIPMENT, TOOLS, LABOR AND SERVICES NECESSARY FOR COMPLETION OF THE PROJECT.
- GENERAL CONTRACTOR SHALL PERFORM ALL WORK IN CONFORMITY WITH THOSE LAWS HAVING JURISDICTION WHETHER OR NOT SUCH WORK IS SPECIFICALLY SHOWN ON THESE DRAWINGS, INCLUDING ALL SEISMIC REQUIREMENTS. GENERAL CONTRACTOR SHALL OBTAIN AND PAY FOR ALL NECESSARY BUILDING PERMITS AND SHALL BE REIMBURSED FOR GENERAL BUILDING PERMIT COSTS BY OWNER. BUSINESS LICENSE COSTS ARE NOT REIMBURSABLE.
- GENERAL CONTRACTOR SHALL BE RESPONSIBLE FOR THE QUALITY OF WORKMANSHIP AND FOR COMPLIANCE WITH THE DESIGN. THE GENERAL CONTRACTOR SHALL CORRECT ALL ERRORS AND DEVIATIONS AS REQUESTED BY THE OWNER.
- GENERAL CONTRACTOR SHALL CONTACT THE OWNER / HFT IMMEDIATELY IF THEY ENCOUNTER ANY HAZARDOUS MATERIALS.
- EXACT LOCATIONS OF PIPING, DUCTWORK, CONDUIT AND FIXTURES SHALL BE COORDINATED BETWEEN CONTRACTORS AND SUBCONTRACTORS TO AVOID INTERFERENCE.
- ALL SPRINKLER HEADS SHOWN ARE CONCEPTUAL ONLY. GENERAL CONTRACTOR TO HIRE A LICENSED SPRINKLER CONTRACTOR TO DESIGN AND INSTALL / MODIFY SPRINKLER SYSTEM. HEAD REPLACEMENT TO MEET ALL LOCAL AND NATIONAL CODES INCLUDING NFPA-13.
- AFTER COMPLETION OF THE WORK, PARTS OF THE BUILDING SHALL BE CLEANED WHERE EVER SUCH CLEANING IS REQUIRED, INCLUDING AREAS OF THE BUILDING MADE DIRTY BY CONSTRUCTION WORK. THE GENERAL CONTRACTOR SHALL REMOVE FROM THE PREMISES TRASH, RUBBISH, TOOLS, EQUIPMENT AND EXCESS MATERIALS. THE BUILDING IS TO BE LEFT IN PERFECTLY CLEAN CONDITION.

LVT INSTALLATION NOTES:

BEFORE STARTING THE JOB:

1. FLOOR PREPARATIONS SHOULD BE DONE WITH THE PERMANENT HVAC SET AT A MINIMUM OF 68° F (20° C).
2. IT IS RECOMMENDED THAT LVT FLOOR COVERING INSTALLATION SHALL NOT BEGUN UNTIL ALL OTHER TRADES ARE COMPLETED.

STORAGE AND HANDLING:

1. THE BUILDING MUST BE ENCLOSED AND THE HVAC IN CONTINUOUS OPERATION. THE LVT AND ADHESIVE MUST BE CONDITIONED TO ROOM TEMPERATURE FOR 7 DAYS PRIOR TO INSTALLATION. DURING THE INSTALLATION AND CONTINUOUS FOLLOWING COMPLETION OF THE INSTALLATION, THE AMBIENT AIR RELATIVE HUMIDITY MUST BE BETWEEN 10% - 65% WITH THE FLOOR AND ROOM TEMPERATURE BETWEEN 55 - 85 DEGREES FAHRENHEIT. THE INDOOR TEMPERATURE SHOULD NEVER FALL BELOW 55 DEGREES FAHRENHEIT OR ABOVE 85 DEGREES FAHRENHEIT REGARDLESS OF THE AGE OF THE INSTALLATION.
2. STORE CARTONS OF TILE OR PLANK PRODUCTS FLAT AND SQUARELY ON TOP OF ONE ANOTHER, PREFERABLY. LOCATE MATERIAL IN THE "CENTER" OF THE INSTALLATION AREA (I.E. AVOID FROM VENTS, DIRECT SUNLIGHT, ETC.) STORING CARTONS IN DIRECT SUNLIGHT MAY AFFECT PROPER ACCLIMATION BY INDUCING THERMAL EXPANSION / CONTRACTION.

JOB SITE CONDITIONS:

1. AREAS TO RECEIVE LVT FLOORING SHOULD BE ADEQUATELY ILLUMINATED DURING ALL PHASES OF THE INSTALLATION PROCESS.
2. CONTROLLED ENVIRONMENTS ARE CRITICAL. DO NOT INSTALL LVT FLOORING PRODUCTS UNTIL THE WORK AREA CAN BE TEMPERATURE CONTROLLED.
3. PORTABLE HEATERS ARE NOT ACCEPTABLE.
4. KEROSENE HEATERS SHOULD NEVER BE USED WHERE FLOOR COVERING PRODUCTS WILL BE INSTALLED. THEY HEAT THE AIR, NOT THE SUBSTRATE. THEY ALSO LEAVE A RESIDUE ON THE SUBSTRATE.
5. THE PERMANENT HVAC SYSTEM MUST BE OPERATIONAL AND FUNCTIONAL AND SET TO A MINIMUM OF 65° F OR A MAXIMUM OF 85° F FOR A MINIMUM OF 7 DAYS PRIOR TO DURING, AND CONTINUOUS AFTER INSTALLATION. THE INDOOR TEMPERATURE SHOULD NEVER FALL BELOW 55 DEGREES FAHRENHEIT OR ABOVE 85 DEGREES FAHRENHEIT REGARDLESS OF THE AGE OF THE INSTALLATION.

DO NOT SCALE THESE DRAWINGS

Harbor Freight Tools Retrofit Concrete Repair Specification

PART 1 GENERAL

1.01 SCOPE

This specification covers the furnishing of all labor, equipment and materials required to repair or replace spalled, deteriorated or structurally damaged concrete surfaces. Depth of repairs shall be adequate to restore concrete member or slab to original dimensions after proper preparation to sound concrete. Full depth slab replacements shall be anchored to adjacent slabs per ACI requirements. The General Contractor shall repair or replace all concrete surfaces as shown on contract drawings or as specified herein.

1.02 REFERENCES

- A. Applicable Standards and Codes:
1. ACI 302, "Guide for Concrete Floor and Slab Construction."
 2. ACI 304, "Guide for Measuring, Mixing, Transporting and Placing Concrete."
 3. ACI 305, "Hot Weather Concreting."
 4. ACI 306, "Cold Weather Concreting."
 5. ACI 318, "Standard Building Code Requirements for Reinforced Concrete."
 6. ACI 503, "Standard Specification for Repairing Concrete with Epoxy Mortars."
 7. ACI 504, "Guide to Sealing Joints in Concrete Structures."
 8. ACI 506, "Guide to Shotcrete."
 9. ACI 546, "Guide for Repair of Concrete Bridge Superstructures."
 10. ICRI Guideline 3732, "Selecting and Specifying Concrete Surface Preparation."
 11. ICRI Guideline 3733, "Guide for Selecting and Specifying Materials for Repair of Concrete Surfaces."

1.03 QUALITY ASSURANCE

- A. Material manufacturers shall be ISO 9001/9002 registered or provide proof of documented quality assurance system. Quality system must be independent auditing registrar. ISO 9001/9002 certification shall be included with material submittals. The material supplier shall provide job service as required to assure proper handling and installation of materials. The field representative shall instruct as needed to assure that handling, mixing, placing, finishing, and curing of materials are in accordance with specification.
- B. The General Contractor shall have experience and proficiency specific to the repair type and shall be approved by Harbor Freight.
- C. Prior to the start of concrete repairs or slab replacement, the General Contractor shall conduct a meeting to review the detailed requirements for scope of work. Surface preparation, proposed equipment, procedures, material mixing, placing and finishing procedures and site conditions shall be discussed and approved by the Harbor Freight project manager and architect, prior to beginning work.

The General Contractor shall require the attendance of all involved parties including but not limited to the General Contractor's superintendent, repair contractor, concrete contractor, ready mix producer, testing laboratory, material supplier representative and proposed equipment supplier representative. Minutes of the meeting shall be recorded, typed, and printed by the General Contractor and distributed to all parties concerned, including the Harbor Freight and Architect, within 5 days of the meeting.

1.04 PRE-BID INSPECTION

- A. The General Contractor shall visit the site prior to bid submittal to determine the extent of the required repairs or slab replacement. Final bid shall include all required repairs, including total quantities and unit costs for each repair, or a total cost for slab replacement.

1.05 MATERIAL STORAGE AND HANDLING

cemementitious base compound. Provide the following:
"Euco V-100" by Euclid Chemical

C. Accessory Products

1. Bonding Agents:

- a. Epoxy/Cement Bonding Agent (and Protective Coating for Reinforcing Steel): Product shall be a water-based epoxy resin designed for bonding repair materials to existing concrete or for adhesion and corrosion protection of reinforcing members (24 hour maximum open time). Provide the following:
"Duralprep AC" by Euclid Chemical
- b. Polyvinyl Acetate, Rewettable Type: Product shall be a resin adhesive for bonding repair materials to existing concrete when the repair is interior and dry conditions will exist after the repair is complete. Provide the following:
"Tammweld" by Euclid Chemical
- c. Latex, Non-Rewettable Type: Product shall be an acrylic latex bonding adhesive to bond the repair material to existing concrete. Provide the following:
"Akro-7T" by Euclid Chemical
- d. Latex, Non-Rewettable Type: Product shall be a styrene butadiene copolymer bonding adhesive to bond the repair material to existing concrete. Provide the following:
"SBR Latex" by Euclid Chemical
- e. Epoxy Adhesive: The compound shall be a two component, 100 percent solids, 100 percent reactive compound suitable for use on dry or damp surfaces and meet the requirements of ASTM C 881. Provide the following:
"Dural #452 Epoxy" by Euclid Chemical

2. Curing and Sealing Compound: The compound shall meet the moisture retention, solids content, and non-yellowing requirements of ASTM C-309 or C-1315 when applied at the manufacturer's recommended application rate per gallon. Provide the following:
 - a. Interior Cure: "Kurez DR VOX" by Euclid Chemical
 - b. Exterior Cure: "Super Aqua Cure VOX" or "Super Diamond Clear VOX" by Euclid Chemical

3. Joint / Crack Materials:
 - a. Single Component Polyurethane (Gun and Pourable Grade): Provide the following:
"Eucelastc 1 NS / SL" by Euclid Chemical
 - b. Polyurea Joint Filler: The product shall conform to the requirements of ACI 302, and be a UV resistant, fast setting, semi-rigid, polyurea. Provide the following:
"Euco QWIKjoint UVR" by Euclid Chemical
 - c. Crack Repair: Two-component, low viscosity hybrid urethane repair liquid used to mend cracks in concrete, repair spalled joints and repair damaged or uneven concrete surfaces.
"Euco QWIKstitch" by Euclid Chemical

PART 3 EXECUTION

Unless otherwise specified, the General Contractor shall apply all materials in strict accordance with the manufacturer's instructions which are made part of this specification.

3.01 ESTIMATING

- A. Refer to manufacturer's literature for material yields and coverage rate. Actual usage will vary depending on the profile and planeness of the repair surface and should be verified by the General Contractor. The General Contractor shall install the material at the thicknesses specified herein or on drawings and shall be familiar with site conditions to determine appropriate material quantities.

- A. Materials shall be delivered in the original, unopened containers. It shall be labeled with the manufacturer's name, product name and lot number. Store materials at the job site under dry conditions and at temperatures between 50°F (10°C) and 90°F (32°C).

1.06 SITE CONDITIONS

- A. Job conditions shall be maintained at standards that allow material placement within temperature and cleanliness requirements. Unusual conditions as uncovered during work shall be brought to the attention of Harbor Freight for analysis and disposition. These conditions include but are not limited to poor quality base concrete, severely corroded reinforcing steel, random cracks, and deep oil penetration.

1.07 ENVIRONMENTAL CONDITIONS

- A. Repair materials shall not be applied without protection in temperature below 45°F (7°C), or when the temperature is expected to fall below 45°F (7°C) during the curing period unless otherwise specified by the material manufacturer. Patching material shall not be applied to frozen surfaces.
- B. All materials used for the repair work must be VOC compliant. The manufacturer shall supply the appropriate material safety data sheets upon request.

1.08 SHORING AND SUPPORT

- A. When removal and patching of deteriorated structural concrete may cause temporary weakness, excessive deflections, or structural instability, shoring or other suitable supports shall be provided until completion and adequate curing of repairs.

PART 2 PRODUCTS

2.01 MATERIALS

- A. Horizontal Repairs and Overlays:
1. Thicknesses Less Than 1/2" (13mm): Product shall be a one component, trowel applied, latex and micro-silica modified cementitious base compound. Provide the following:
"Thin-Top Supreme" by Euclid Chemical
 2. Thicknesses Greater Than 1/2" (13mm): Product shall be a one component, trowel applied, latex and micro-silica modified cementitious base compound. Provide the following:
"Concrete Top Supreme" by Euclid Chemical
 3. Rapid Repairs: Product shall be a one component, cementitious material for patching and repairing concrete, meeting the requirements of ASTM C-928. Provide the following:
"Versa-Speed" by Euclid Chemical
 4. Repair of Existing Trench In-Fills over 1" Thick (25mm): Product shall be a one part, microsilica modified patching and repair material for concrete. Provide the following:
"Euocrete" by Euclid Chemical
 5. Underlayment for Soft Floor Coverings: Product shall be a one component, free-flowing, self-leveling, pumpable compound designed as an underlayment for subsequent placement of floor coverings. Provide the following:
"EucoFloor SL160" by Euclid Chemical
 6. Self-Leveling, Polishable Wearing Surface: Product shall be a one component, free flowing, self-leveling cementitious based compound designed as an underlayment for subsequent placement of floor coverings or as a wearing surface. Provide the following:
"LevelTop" by Increte Systems (Euclid Chemical)
- B. Vertical/Overhead Repairs
1. General Repairs: Product shall be a one component, trowel applied, and latex modified

3.02 PREPARATION

- A. Cleaning: The surface of the existing concrete should be clean and the pores free of any dirt or material that will be detrimental to the bond of the repair material.
- B. Surface Preparation: Concrete surfaces must be clean and rough. All oil, dirt, debris, paint, and unsound concrete must be removed. The surface must be prepared mechanically using a scabber, bush hammer, chipping hammer, shotblast or scarifier which will give a surface profile of a minimum 1/8" (3 mm) and expose the coarse aggregate of the concrete. For overlays, the concrete surface shall be roughened to the correct CSP profile (Concrete Surface Profile) and thickness recommended by the International Concrete Repair Institute (ICRI) Publication 03732, "Selecting and Specifying Concrete Surface Preparation for Sealers, Coatings, and Polymer Overlays." The final step in cleaning shall be the complete removal of all dust, dirt, and residue by pressure washing and/or vacuum.
- C. Cracks: All cracks greater than 1/8" in width shall be routed to a minimum 3/8" by 3/8". Thoroughly clean with oil free compressed air or vacuum and place bond breaker tape along the bottom of the joint. Crack must be dry before installation of the sealant. Do not rout cracks less than 1/8" width.
- D. Joints: Existing joints shall be maintained by forming at joint locations or saw cutting over joint locations. Edges shall be sawcut to 1/4" (6 mm) deeper than the overlay thickness and notched at the edge of the overlay to provide a locked in perimeter. Chip the edge with a handheld chipping hammer to provide the wedge-shaped notch.

3.03 BONDING/PRIMING


- A. After the concrete surface has been prepared, cleaned and dry, prime all areas with the bonding agent specified by the manufacturer. Apply bonding agent (or a product bond coat) by scrubbing the material into the concrete surface to penetrate the pores of the concrete. Follow the manufacturer's recommended coverage rate. Rougher surfaces may require a stiff broom to apply the bonding agent while a relatively smooth surface will allow use of roller or squeegee application.

3.04 MIXING OF REPAIR MATERIAL

- A. Follow the mixing instructions provided by the material manufacturer. Small quantities may be mixed with a drill and "jiffy" mixer. Use a paddle type mortar mixer for typical jobs. For large or pumped jobs, bulk bagged material mixed in a ready-mix truck or a mixer/pump combination may be used where material workability permits. All materials should be in the proper temperature range of 60°F (15°C) to 90°F (32°C). Add the appropriate amount of water for the batch size and then add the dry product. Mix for 3 to 5 minutes. If pea gravel is added, mix an additional 2-3 minutes after its addition. The mixed product should be transported by buggy or pumped to the repair area and placed immediately. For multiple component materials, be sure the proper ratios of Part A, Part B and Part C are thoroughly mixed.

3.05 PLACING OF REPAIR MATERIAL

- A. Trench In-fill:
1. In-fill trenches with "Euocrete" pre-packaged concrete by Euclid Chemical or 4000 psi ready mixed concrete. Trench shall exhibit straight, full-depth sawcuts at the interface of existing concrete to in-fill area. Install 15 mil vapor barrier by Stego at base of area to be in-filled. In-fill concrete shall be doweled into existing slab using #4 bars spaced 16" on center. Bars shall have minimum 4" embedment in existing concrete and come to within 3" of the opposite face of existing concrete. Place, consolidate, finish and cure in-fill concrete to match finish, color and elevation of adjacent concrete. Honor all control joints per ACI 302 recommendations. Use an evaporation retarder under hot or windy conditions to prevent surface drying.
- B. Self-Leveling Wear Surface:
1. Surface Prep: The concrete surface must be free of unbound cementitious by-products, loose dirt, oil, grease, or other contamination. Any animal or petroleum contamination should be removed with Increte Systems' Grease-A-Way. Exterior surfaces should be acid etched using a 5 to 1 solution of water to muriatic acid. Interior surfaces should be prepared by mechanical means

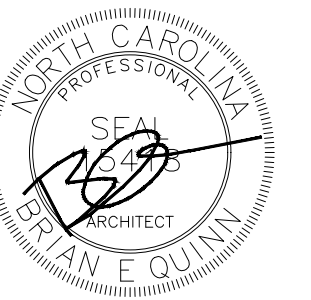

05/17/24



Lakewood, Ohio 44107
17710 Detroit Avenue
Phone (216) 521-5134
Fax (216) 521-4824
www.adaarchitects.com

HARBOR FREIGHT
46 SHRUI LANE
ERWIN, NC 28839

THESE DOCUMENTS CONTAIN INFORMATION PROPRIETARY TO ADA ARCHITECTS, INC.
UNAUTHORIZED USE OF THESE DOCUMENTS IS EXPRESSLY PROHIBITED UNLESS AGREED UPON IN WRITING.

DO NOT SCALE THESE DRAWINGS

REVISIONS

#	DATE	TYPE
1		
2		
3		
4		
5		
6		
7		
8		
9		
10		

CONCRETE SPECIFICATIONS

DATE 05/17/24

JOB NO. 23475


A0.3
SHEET NO.

WALL LEGEND	
	EXISTING WALL
	MASONRY WALL INFILL. SEE STRUCTURAL DRAWINGS FOR ADDITIONAL INFORMATION.
	NEW WALL. SEE WALL TYPES ON SHEET A4.1 FOR ADDITIONAL INFORMATION.
	WALL TYPE DESIGNATION. SEE SHEET A4.1 FOR ADDITIONAL INFORMATION.

NOTE:
 1. ALL WALLS BRACED TO STRUCTURE ABOVE @ 4'-0" O.C. MAX.
 2. ALL WALLS TO BE PAINTED TO 6" ABOVE CEILING, TO UNDERSIDE OF DECK (IF CEILING IS OPEN TO STRUCTURE), AND BEHIND ALL WALL FIXTURES BY CONTRACTOR.

- ### FLOOR PLAN NOTES
- REFER TO GENERAL NOTES ON SHEET A0.2 FOR ADDITIONAL INFORMATION.
 - HFT GENERAL CONTRACTOR TO VISIT SITE AND VERIFY EXISTING CONDITIONS PRIOR TO SUBMITTING PROPOSALS AND COMMENCING WORK.
 - HFT GENERAL CONTRACTOR IS TO PROVIDE FULL TIME SUPERVISION OF PROJECT. NOTIFY HFT PROJECT MANAGER OF TYPICAL WORK HOURS.
 - HFT GENERAL CONTRACTOR IS RESPONSIBLE FOR COORDINATION AND TIMING OF ALL HFT VENDOR INSTALLATIONS. COORDINATE WITH HFT PROJECT MANAGER FOR LIST AND MILESTONE TIMING.
 - HFT GENERAL CONTRACTOR IS RESPONSIBLE FOR UNLOADING AND HANDLING ALL OWNER SUPPLIED MATERIAL AND DISPOSAL OF ALL PACKING MATERIALS AT THE JOB SITE.
 - HFT GENERAL CONTRACTOR SHALL BE RESPONSIBLE FOR QUALITY AND FIT OF ALL MATERIALS, INCLUDING, BUT NOT LIMITED TO, ALL REFURBISHED MATERIALS. ALL REFURBISHED MATERIALS TO APPEAR NEW.
 - HFT GENERAL CONTRACTOR TO COORDINATE WITH HFTS FIXTURE MANUFACTURE TO ENSURE FINISHES TO MATCH.
 - IF THE CONTRACTOR CONSIDERS ANY SURFACE UNSUITABLE FOR A PROPER FINISH, HE SHALL NOTIFY HFT AND ARCHITECT OF THE CONDITION AND NOT COMMENCE WORK UNTIL DIRECTED BY HFT OR ARCHITECT.
 - HFT GENERAL CONTRACTOR TO NOTIFY OWNER OF ANY DAMAGES / SHORTAGES WITHIN 48 HOURS OF RECEIPT OR BEAR RESPONSIBILITY FOR REPLACEMENT OF SUCH.
 - ALL WORK SHALL BE PERFORMED IN STRICT ACCORDANCE WITH THE PUBLISHED INSTALLATION SPECIFICATIONS AND PROCEDURES OF THE MANUFACTURER OF THE MATERIAL USED.
 - PROTECT OTHER WORK AND MERCHANDISE AS REQUIRED TO PREVENT ANY DAMAGE.
 - PROVIDE A CLEAN SMOOTH CONCRETE SURFACE FOR PROPER INSTALLATION OF ALL FLOOR FINISHES.
 - APPLICATIONS OF PAINT SHALL BE ONE COAT PRIMER AND TWO COATS PAINT (U.N.O.). PRIMER SHALL BE SPECIFIED OR RECOMMENDED BY PAINT MANUFACTURER.
 - ALL ADHESIVES TO BE SUPPLIED BY HFT GENERAL CONTRACTOR. THE TYPE TO BE USED AS RECOMMENDED BY WALL COVERING MANUFACTURER SELECTED FOR THE TYPE OF INSTALLATION.
 - GENERAL CONTRACTOR SHALL BE RESPONSIBLE TO INSPECT ALL WALL COVERING FOR QUALITY AND DEFECTS PRIOR TO INSTALLATION.
 - ALL SURFACES TO RECEIVE FABRIC OR WALL COVERING AS SELECTED SHALL BE PROPERLY PREPARED AND SIZED AS RECOMMENDED BY WALL COVERING MANUFACTURER SELECTED FOR THE TYPE OF INSTALLATION. CONTRACTOR SHALL NOTIFY HFT OF ANY SURFACE NOT SUITABLE FOR PROPER APPLICATION OF WALL COVERING. DO NOT APPLY ANY MATERIAL UNTIL SITUATION IS RESOLVED.
 - HFT GENERAL CONTRACTOR IS RESPONSIBLE FOR INSTALLATION OF BLOCKING FOR ALL WALL AND CEILING SUPPORTED ITEMS IN STORE. REVIEW ITEMS THOROUGHLY. COORDINATE WITH VENDOR AS NECESSARY.
 - HFT GENERAL CONTRACTOR TO ENSURE TIGHT, SECURE, AND PROPER FASTENING OF ALL STANDARDS TO METAL STUDS.
 - ALL DIMENSIONS ARE FROM FACE OF GYP. BD. U.N.O.
 - ALL INTERIOR DOORS ARE 6" OFF WALL U.N.O.
 - ALL EXPOSED WALLS TO UNDERSIDE OF STRUCTURE SHALL BE BUILT TIGHTLY AROUND STRUCTURE, PIPING, ETC.

- ### 300 SERIES FLOOR PLAN KEY NOTES
- AUTOMATIC SINGLE SLIDING DOOR PACKAGE. SEE SHEETS A5.0 AND A5.1 FOR ADDITIONAL INFORMATION.
 - EXISTING STEEL COLUMNS. PREP AND PAINT (P-8). SEE SHEET A1.3 FOR FINISHES.
 - AUTOMATIC BI-PARTING DOOR PACKAGE. SEE SHEETS A5.0 AND A5.1 FOR ADDITIONAL INFORMATION.
 - EXISTING CONCRETE PAD BY LANDLORD UNDER A SEPARATE PERMIT.
 - LOCATION OF ELECTRICAL PANELS AND EQUIPMENT. MAINTAIN A 3'-0" CLEARANCE IN FRONT OF ELECTRICAL EQUIPMENT. REFER TO ELECTRICAL DRAWINGS FOR ADDITIONAL INFORMATION.
 - 4'-0" X 8'-0" FIRE RATED PLYWOOD TO HOUSE ALL ELECTRICAL AND OWNER'S EQUIPMENT. REFER TO ELECTRICAL DRAWINGS FOR ADDITIONAL INFORMATION.
 - 4'-0" WIDE X 3'-0" HIGH ONE WAY GLASS W/ 2" H.M. FRAME CENTERED IN WALL FACING CASH WRAP AREA, BTM. OF WINDOW TO BE @ 40" A.F.F. SEE A5.0 FOR ADDITIONAL INFORMATION.
 - SEE FIXTURE PLAN ON A1.2 FOR FIXTURE LAYOUT & ADDITIONAL NOTES.
 - SEE FINISH PLAN ON A1.3 FOR ALL FLOOR, WALL, AND CEILING FINISHES.
 - EXISTING CONCRETE SLAB PATCH AND REPAIR TO ENSURE A SMOOTH AND LEVEL SLAB. PREP. SLAB TO RECEIVE NEW FINISHES. SEE SHEET A0.3 & A0.4 FOR ADDITIONAL INFORMATION.
 - NOTIFY HFT PROJECT MANAGER AT START OF CONSTRUCTION IF A LEVEL FLOOR CANNOT BE OBTAINED.
 - 6" Ø STEEL PIPE BOLLARD BY LANDLORD UNDER A SEPARATE PERMIT.
 - 8" Ø STEEL PIPE BOLLARD BY LANDLORD UNDER A SEPARATE PERMIT.
 - 6" Ø BOLT DOWN BOLLARD PROVIDED BY HFT. SEE SHEET A1.12 FOR ADDITIONAL INFORMATION.
 - EXISTING CONCRETE PAVEMENT BY LANDLORD UNDER A SEPARATE PERMIT.
 - EXISTING CONCRETE SIDEWALK BY LANDLORD UNDER A SEPARATE PERMIT.
 - LINE OF EXISTING CANOPY ABOVE. SEE SHEET A3.0 FOR ADDITIONAL INFORMATION.
 - CONCRETE ACCESSIBLE ENTRY RAMP BY LANDLORD UNDER A SEPARATE PERMIT.
 - FROST SLAB @ CENTER LINE OF DOOR BY LANDLORD UNDER A SEPARATE PERMIT.
 - LOCATION OF EXISTING SPRINKLER MAIN BY LANDLORD UNDER A SEPARATE PERMIT. SEE FIRE PROTECTION DRAWINGS FOR ADDITIONAL INFORMATION.
 - EXISTING ELECTRIC METER AND DISCONNECT BY LANDLORD UNDER A SEPARATE PERMIT. SEE ELECTRICAL DRAWINGS FOR ADDITIONAL INFORMATION.
 - EXISTING GAS METER BY LANDLORD UNDER A SEPARATE PERMIT. SEE PLUMBING DRAWINGS FOR ADDITIONAL INFORMATION.
 - APPROXIMATE LOCATION OF WATER METER AND BACK FLOW PREVENTER. SEE PLUMBING DRAWINGS FOR ADDITIONAL INFORMATION.

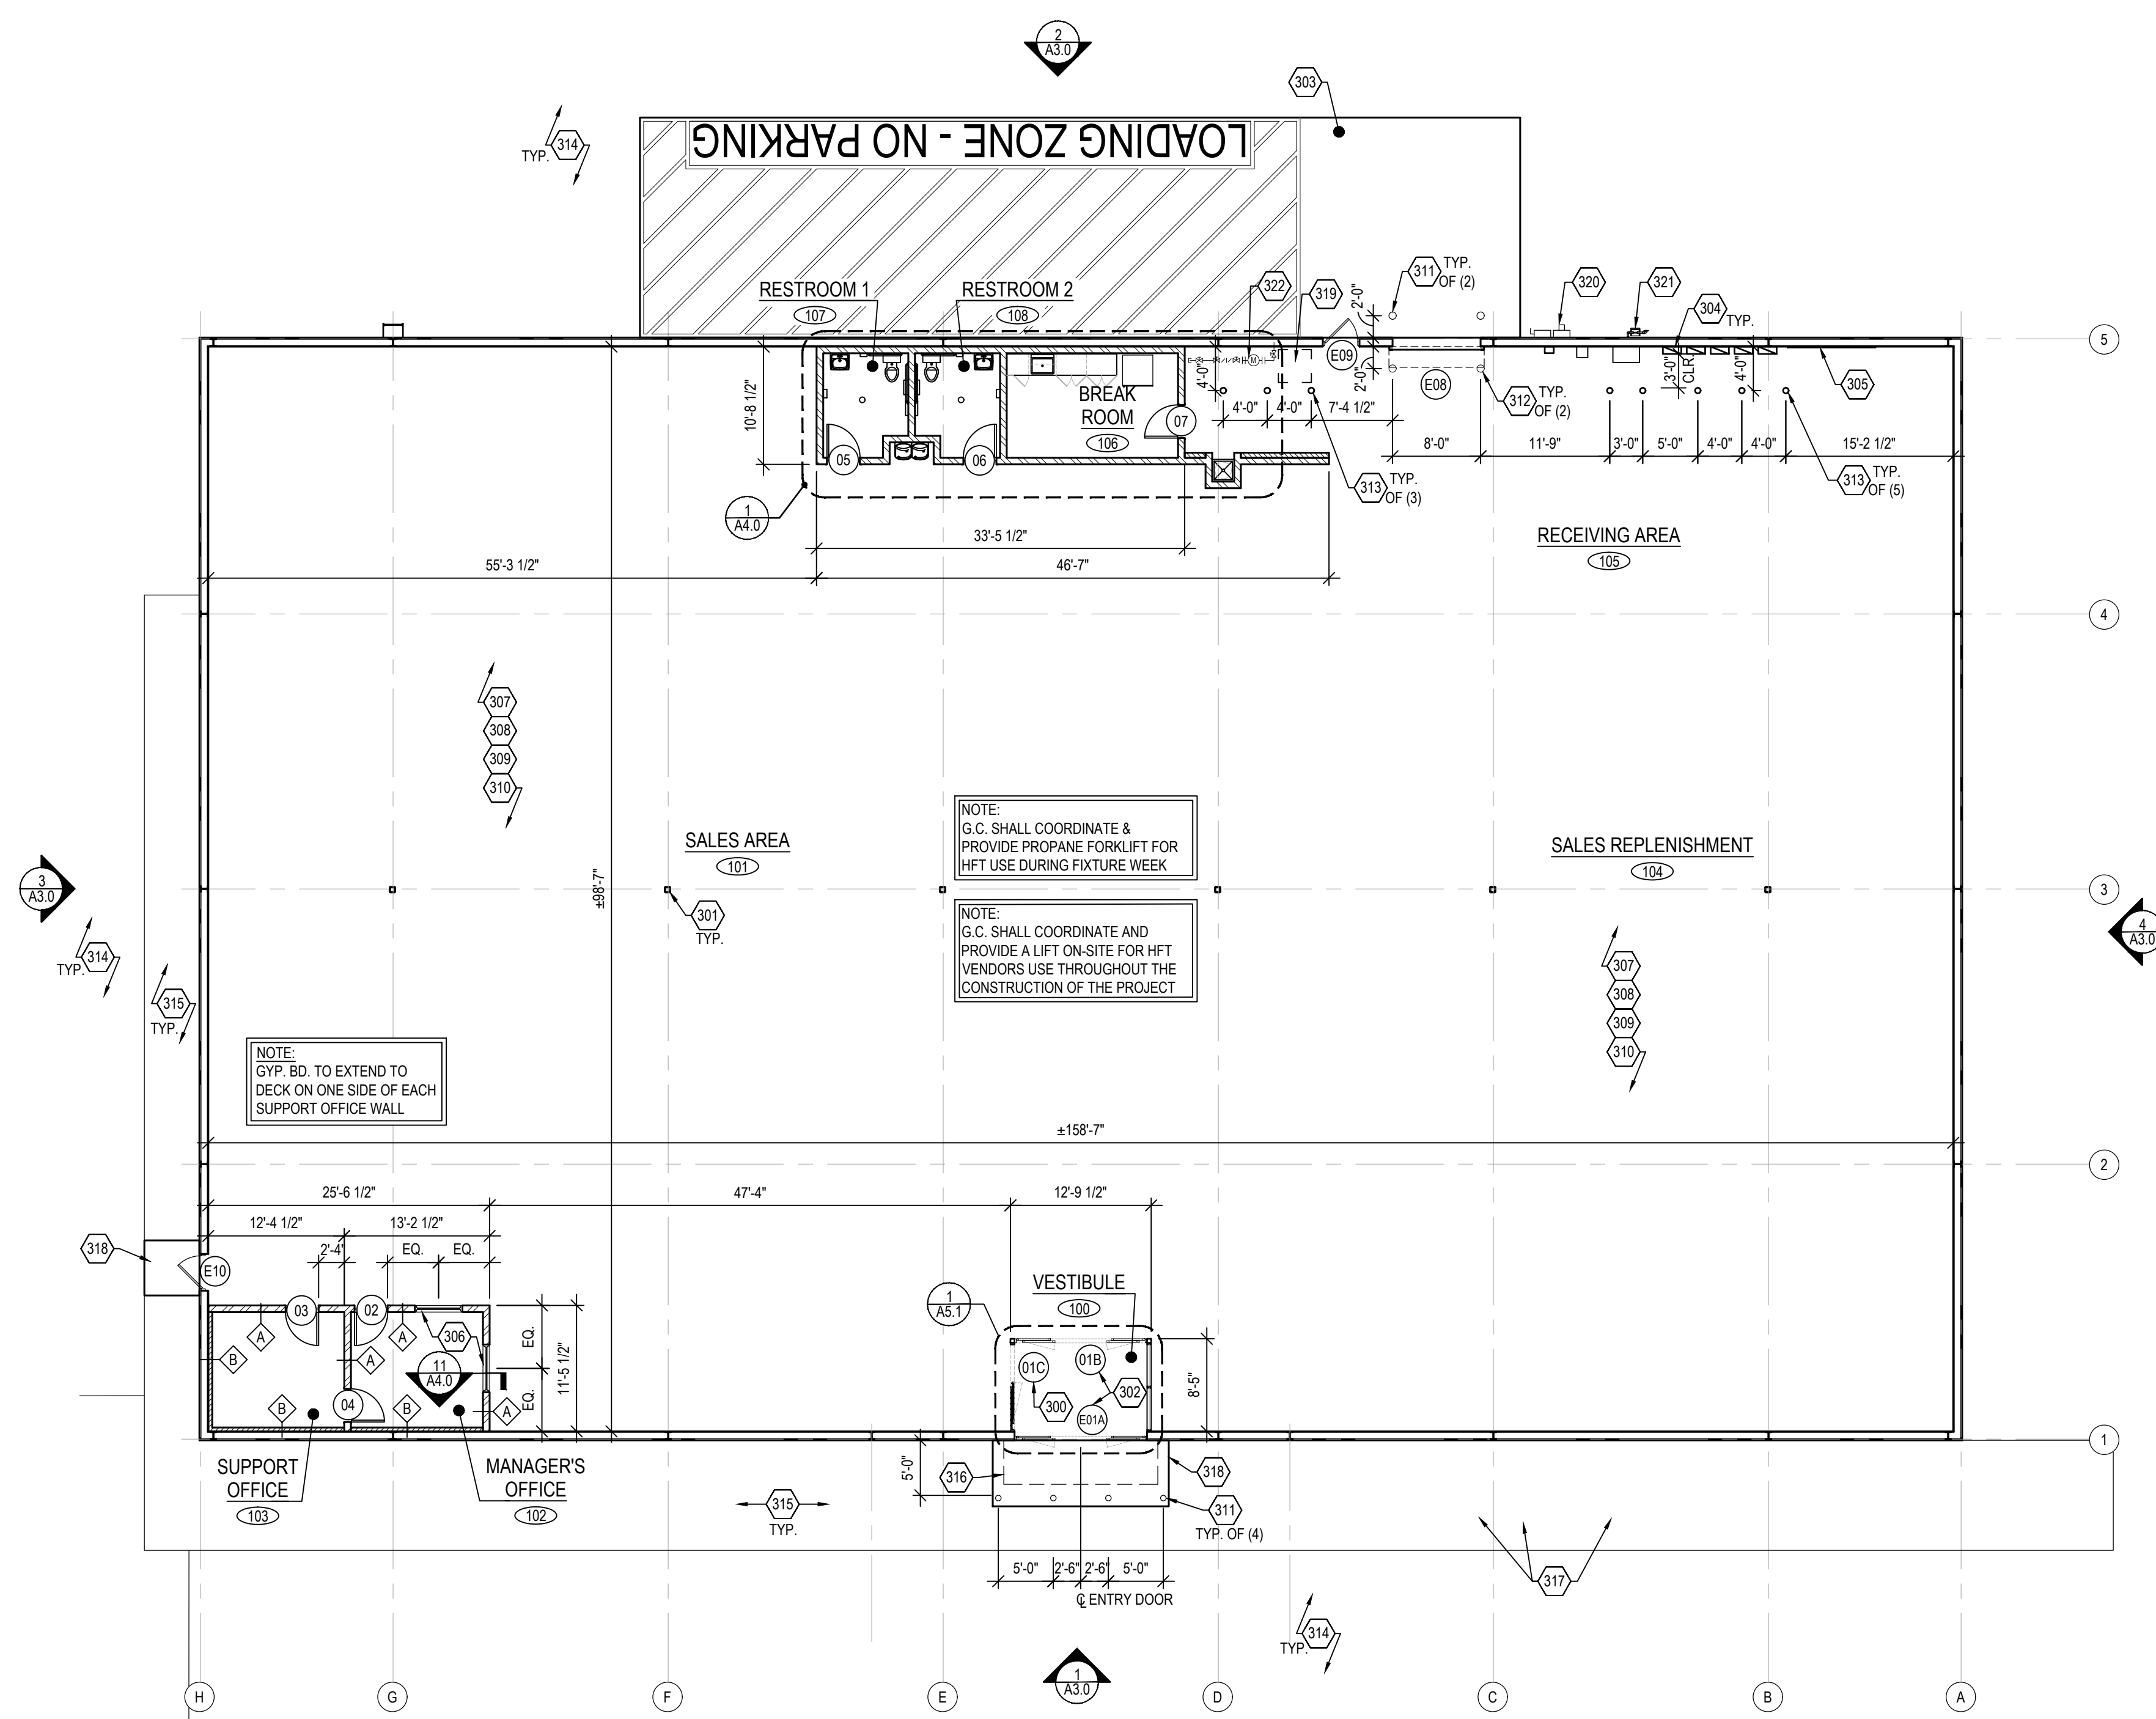

FLOOR PLAN
 SCALE 3/32" = 1'-0"



05/17/24

ADA ARCHITECTS
 Lakewood, Ohio 44107
 17710 Detroit Avenue
 Phone (216) 521-1534
 Fax (216) 521-4824
 www.adaarchitects.com

HARBOR FREIGHT
 ERWIN, NC 28839
 46 SHRUI LANE
 THESE DOCUMENTS CONTAIN INFORMATION PROPRIETARY TO ADA ARCHITECTS, INC.
 UNAUTHORIZED USE OF THESE DOCUMENTS IS EXPRESSLY PROHIBITED UNLESS AGREED UPON IN WRITING.

DO NOT SCALE THESE DRAWINGS

REVISIONS		
#	DATE	TYPE
1		
2		
3		
4		
5		
6		
7		
8		
9		
10		

FLOOR PLAN

DATE 05/17/24
 JOB NO. 23475

A1.1
 SHEET NO.

OCCUPANCY CALCULATIONS

USE and OCCUPANCY CLASSIFICATION:

USE: M - MERCANTILE
CLASS: IIB - FULLY SPRINKLERED

APPLICABLE CODES:

BUILDING CODE: 2018 NORTH CAROLINA STATE BUILDING CODE
ENERGY CODE: 2018 NORTH CAROLINA STATE ENERGY CODE
MECHANICAL CODE: 2018 NORTH CAROLINA STATE MECHANICAL CODE
ELECTRICAL CODE: 2020 ELECTRICAL CODE
PLUMBING CODE: 2018 NORTH CAROLINA STATE PLUMBING CODE
FIRE CODE: 2018 NORTH CAROLINA STATE FIRE CODE
ACCESSIBILITY: 2018 NORTH CAROLINA STATE ADA STANDARDS WITHIN NORTH CAROLINA STATE BUILDING CODE / 2009 ANSI A117.1

OCCUPANT LOAD:

ACTUAL INTERIOR AREA BUILDING: 16,000 SQ. FT.

FUNCTION OF SPACE	FLR. AREA/OCC.	CALCULATION	ALLOWABLE
M - SALES	60 GROSS	9,381 SQ. FT.	164 OCCUPANTS
B - CORE AREA	100 GROSS	680 SQ. FT.	7 OCCUPANTS
S-1 - STOCK	300 GROSS	5,959 SQ. FT.	20 OCCUPANTS
			191 OCCUPANTS

ANTICIPATED OCCUPANT LOAD FOR HARBOR FREIGHT TOOLS: 150 MAX FROM HISTORICAL DATA

EGRESS REQUIREMENTS:

REQUIRED EGRESS WIDTH: 191 OCC. x 0.20 = 38.2" (44" MIN)
PROVIDED EGRESS WIDTH: (1) BREAK-AWAY SINGLE SLIDING DOOR @ 45", (2) H.M. DOOR @ 34" = 113"
REQUIRED EXIT ACCESS TRAVEL DISTANCE: 250'
PROVIDED EXIT ACCESS TRAVEL DISTANCE: LESS THAN 250'
MIN. NUMBER OF EXITS REQUIRED / PROVIDED: 2 EXITS REQUIRED / 3 EXITS PROVIDED

AREA OCCUPANT LOAD ALLOWANCES AND EGRESS DOOR OCCUPANT LOAD CALCULATIONS:

SALES AREA OCCUPANCY:

SALES AREA 9,381 / 60 = 164 OCCUPANTS
RESTROOMS (ACCESSORY) (2) SINGLE OCCUPANCY = 2 OCCUPANTS
OFFICE (ACCESSORY) 308 S.F. / 100 = 3 OCCUPANTS

TOTAL = 169 OCCUPANTS
169 OCCUPANTS / 2 EXITS = 85 OCCUPANTS

SALES REPLENISHMENT AREA OCCUPANCY:

STOCK AREA 5,959 / 300 = 20 OCCUPANTS
BREAK ROOM (ACCESSORY) 176 S.F. / 100 = 2 OCCUPANTS

TOTAL = 22 OCCUPANTS
22 OCCUPANTS / 1 EXIT = 22 OCCUPANTS

EXIT SEPARATION

OVERALL DIAGONAL DIMENSION OF SALES AREA:	141'-3"
SEPARATION DISTANCE REQUIRED OF EXITS: 1/3 OF MAXIMUM OVERALL BUILDING DIMENSION (SPACE IS FULLY EQUIPPED WITH AUTOMATIC SPRINKLERS)	47'-1"
CALCULATED MINIMUM SEPARATION DISTANCE:	78'-8" (COMPLIES)
MINIMUM SEPARATION DISTANCE OF EXITS PROVIDED:	78'-8" (COMPLIES)

LEGEND

	EGRESS PATHWAY
	EXIT SIGN, SEE LIGHTING PLAN
	EMERGENCY LIGHT LOCATIONS, SEE LIGHTING PLAN
	EMERGENCY EXTERIOR LIGHT LOCATIONS, SEE LIGHTING PLAN
	FIRE EXTINGUISHER, ABC, CLASS 2A-20BC (MIN.) WALL MOUNTED FIRE EXTINGUISHER PER CODE. FIRE EXTINGUISHERS LOCATED TO PROVIDE MAXIMUM FLOOR AREA PER UNIT OF 3,000 S.F. AND A MAXIMUM TRAVEL DISTANCE OF 50' AS SHOWN. CONTRACTOR TO VERIFY FINAL LOCATIONS WITH FIRE MARSHAL.



05/17/24

ADA ARCHITECTS
Lakewood, Ohio 44107
17710 Detroit Avenue
Phone (216) 521-1534
Fax (216) 521-14824
www.adaarchitects.com

HARBOR FREIGHT
ERWIN, NC 28639
46 SHRUI LANE

THESE DOCUMENTS CONTAIN INFORMATION PROPRIETARY TO ADA ARCHITECTS, INC.
UNAUTHORIZED USE OF THESE DOCUMENTS IS EXPRESSLY PROHIBITED UNLESS AGREED UPON IN WRITING.

DO NOT SCALE THESE DRAWINGS

REVISIONS

#	DATE	TYPE
1		
2		
3		
4		
5		
6		
7		
8		
9		
10		


LIFE SAFETY PLAN

DATE 05/17/24

JOB NO. 23475

A1.1A


SHEET NO.

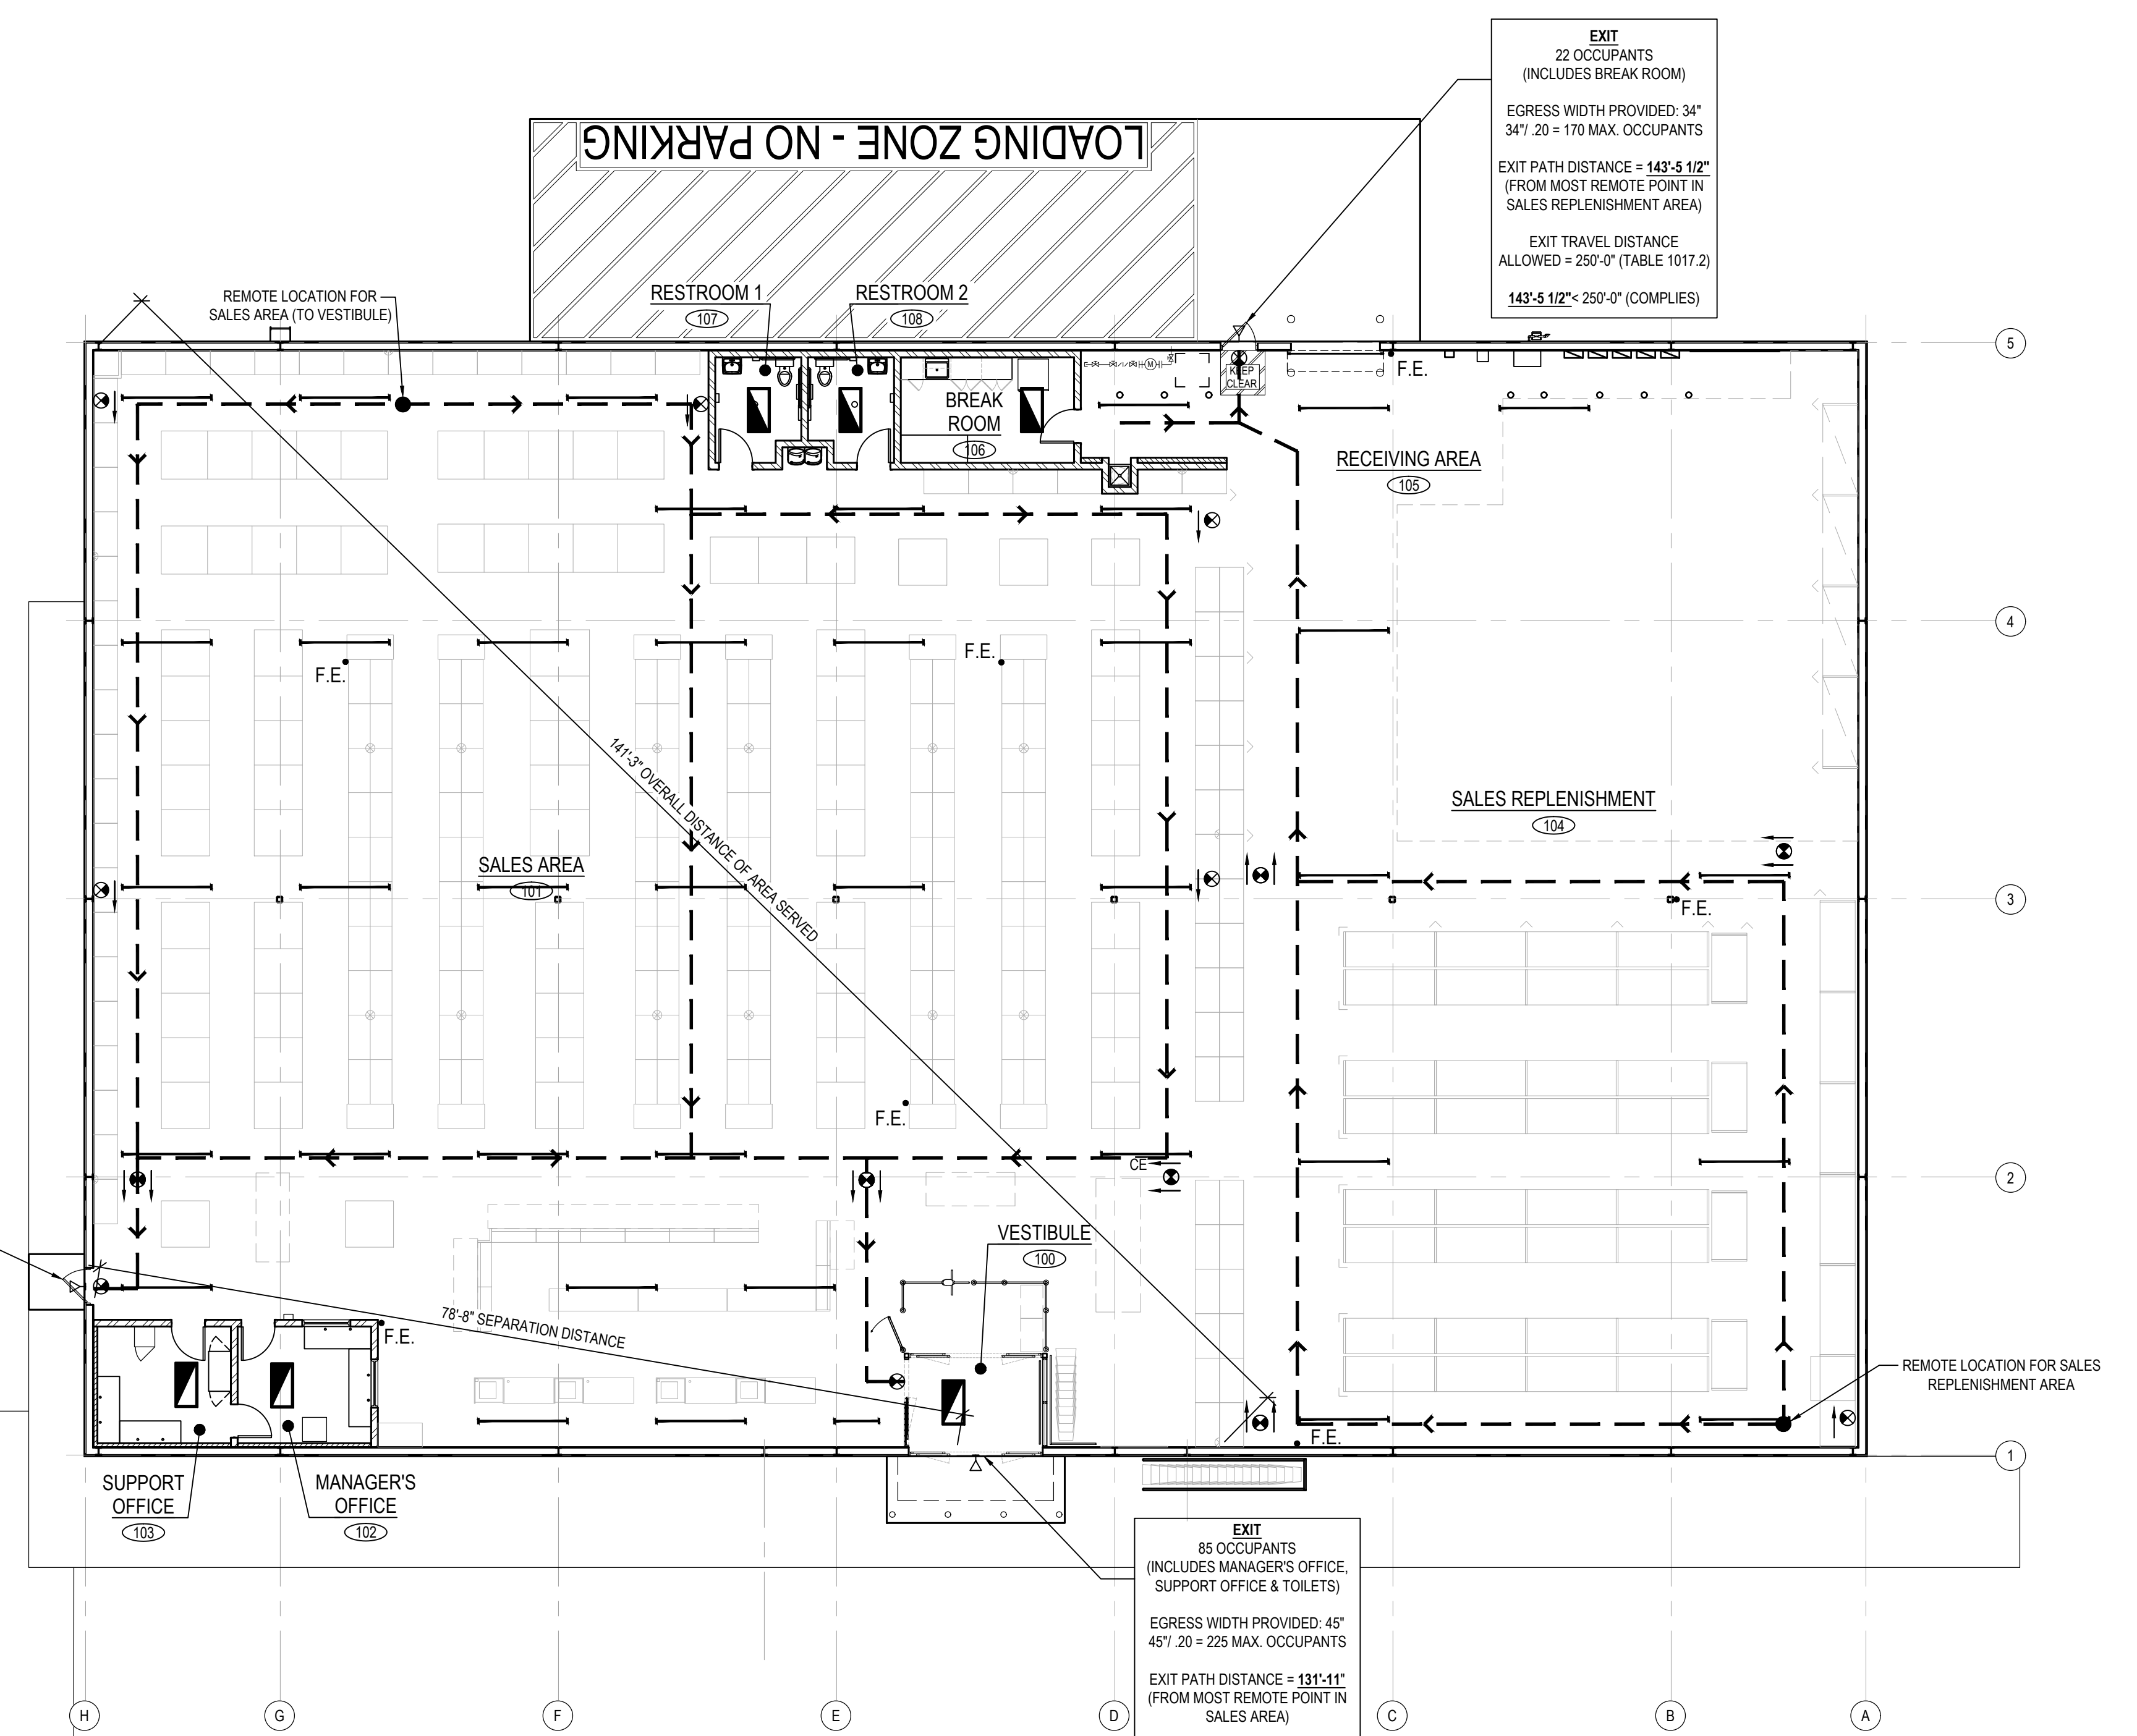


EXIT
22 OCCUPANTS
(INCLUDES BREAK ROOM)
EGRESS WIDTH PROVIDED: 34'
34' x 20 = 170 MAX. OCCUPANTS
EXIT PATH DISTANCE = 143'-5 1/2"
(FROM MOST REMOTE POINT IN
SALES REPLENISHMENT AREA)
EXIT TRAVEL DISTANCE
ALLOWED = 250'-0" (TABLE 1017.2)
143'-5 1/2" < 250'-0" (COMPLIES)

EXIT
85 OCCUPANTS
(INCLUDES MANAGER'S OFFICE,
SUPPORT OFFICE & TOILETS)
EGRESS WIDTH PROVIDED: 34'
34' x 20 = 170 MAX. OCCUPANTS
EXIT PATH DISTANCE = 108'-4 1/2"
(FROM MOST REMOTE POINT IN
SALES AREA)
EXIT TRAVEL DISTANCE
ALLOWED = 250'-0" (TABLE 1017.2)
108'-4 1/2" < 250'-0" (COMPLIES)


EXIT
85 OCCUPANTS
(INCLUDES MANAGER'S OFFICE,
SUPPORT OFFICE & TOILETS)
EGRESS WIDTH PROVIDED: 45'
45' x 20 = 225 MAX. OCCUPANTS
EXIT PATH DISTANCE = 131'-11"
(FROM MOST REMOTE POINT IN
SALES AREA)
EXIT TRAVEL DISTANCE
ALLOWED = 250'-0" (TABLE 1017.2)
131'-11" < 250'-0" (COMPLIES)

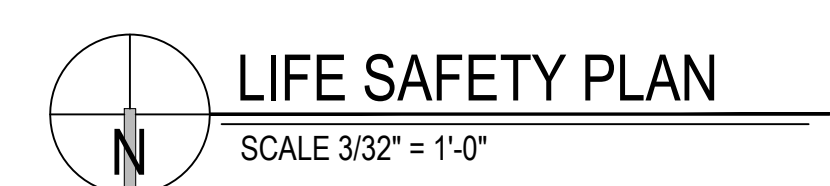

ITEM NO	PART NUMBER	DESCRIPTION	MATERIAL	QTY.
1	HBF 4 FT6-001-S1	CASH WRAP 4 FEET 6 INCH RIGHT HAND	3/4"THK.MDF	1
2	HBF 4 FT6-001-S4.1	DIAMOND PLATE, 47 9/16" X 27 15/16" (FRONT PANEL)	0.0625" ALUMINUM DIAMOND PLATE (TREADBRITE)	1
3	HBF-001-S4.2	DIAMOND PLATE, 23 13/16" X 27 15/16" (TALL END PANEL)	0.0625" ALUMINUM DIAMOND PLATE (TREADBRITE)	2
4	HBF-001-S4.3	RIGHT ANGLE, 28 9/16"	18 GA. GALVANIZED HRS	1
5	HBF-001-S4.4	ANGLE, 28 9/16" (EMPLOYEE SIDE)	18 GA. GALVANIZED HRS	2
6	HBF-001-S4.5	CORNER IRON FOR TOE KICK, 1" X 1" X 4-1/4"	16 GA. CRS	4
7	HBF 4 FT6-001-S4.6	TOP, 16 GA GALV. CASH WRAP, 48 3/16" X 24 1/8" (RH)	18 GA. GALV-X STEEL	1
8	HBF-001-S4.7	LEFT ANGLE, 28 9/16"	18 GA. GALVANIZED HRS	1
9		CLEAR RUBBER CORNER GUARDS		4

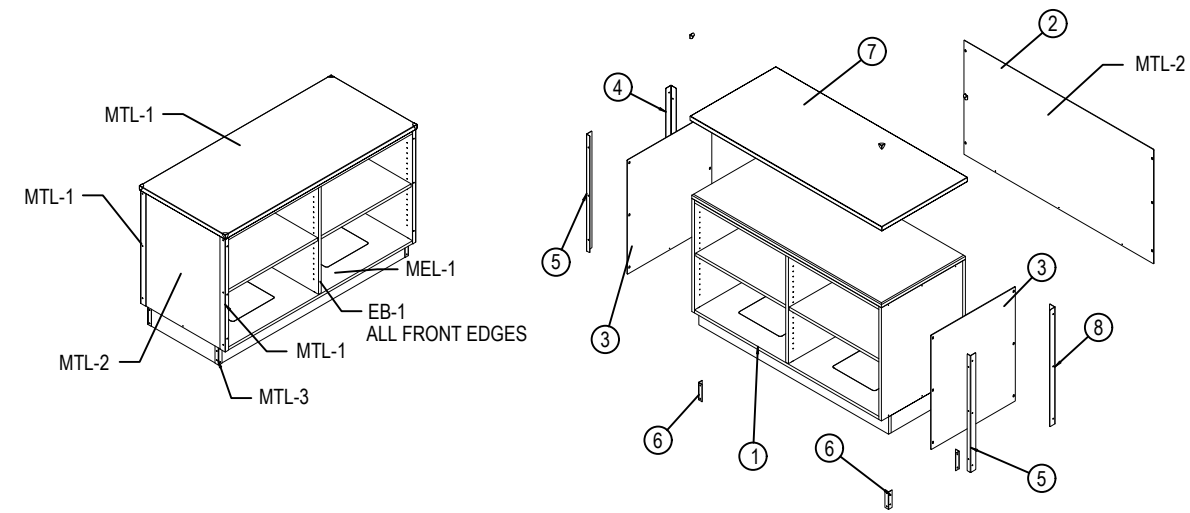


MATERIAL NOTES:
 3/4"THK.MDF
 0.0625" ALUMINUM DIAMOND PLATE (TREADBRITE)
 18 GA. GALVANIZED HRS
 16 GA. GALV-X STEEL

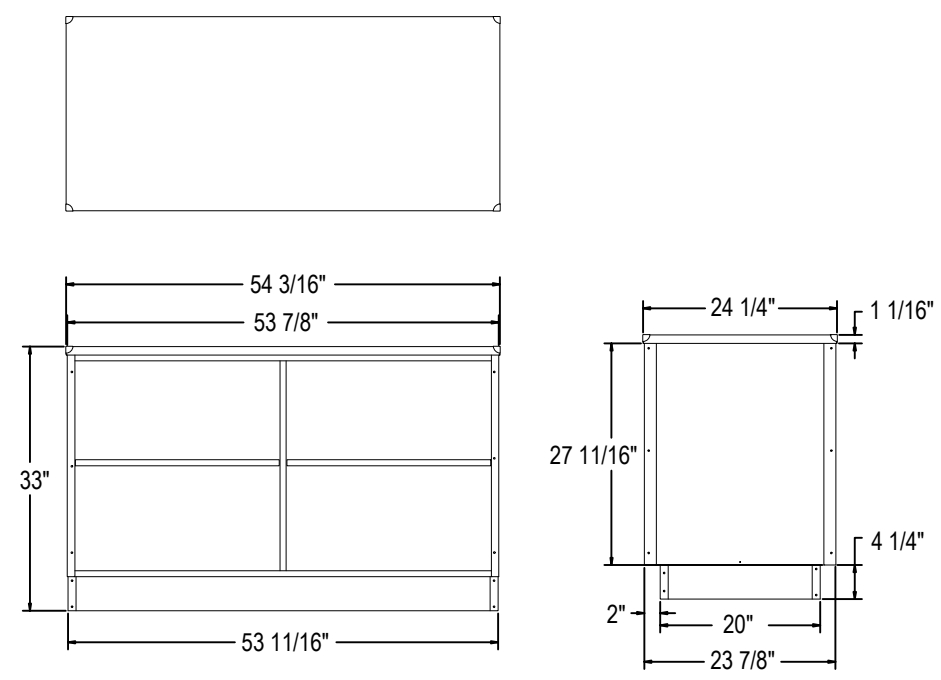

1 ACCESSIBLE TRANSACTION COUNTER

A1.2 SCALE: 1/2" = 1'-0"

NOTES:
 HFT TO PROVIDE AND GENERAL CONTRACTOR TO INSTALL CHARGER, WATER TANK AND EYEWASH STATION. CHARGER TO BE HARDWIRED. SEE ELECTRICAL DRAWINGS FOR ADDITIONAL INFORMATION.

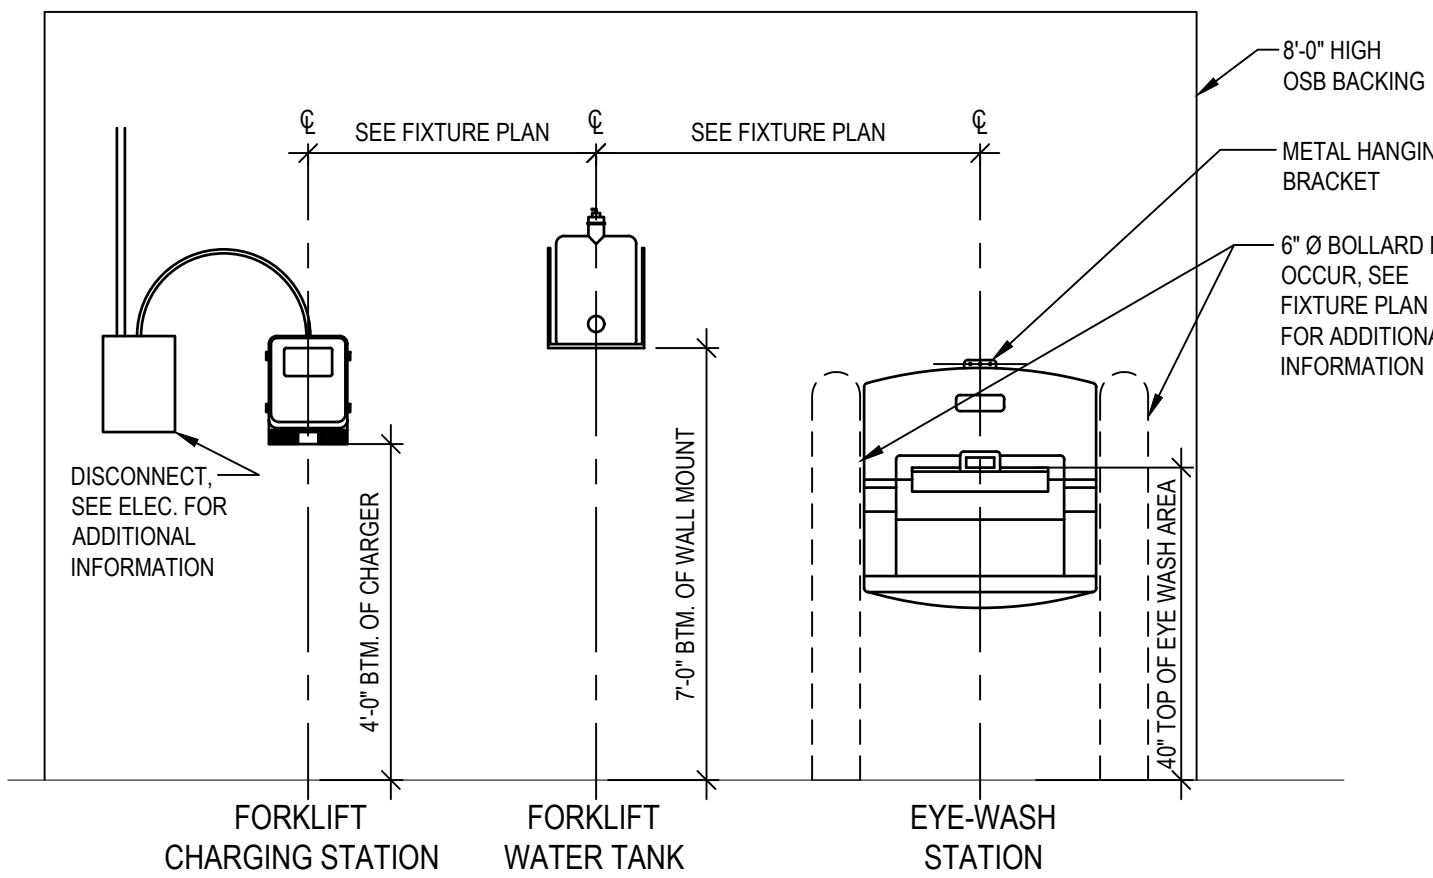

2 FORKLIFT CHARGER AND EYEWASH STATION ELEV.

A1.2 SCALE: 1/2" = 1'-0"

GENERAL NOTES

- REFER TO GENERAL NOTES ON SHEET A2.2 FOR ADDITIONAL INFORMATION.
- HFT GENERAL CONTRACTOR TO VISIT SITE AND VERIFY EXISTING CONDITIONS PRIOR TO SUBMITTING PROPOSALS AND COMMENCING WORK.
- HFT GENERAL CONTRACTOR TO PROVIDE NON-COMBUSTIBLE CEILING AND WALL BLOCKING AS NECESSARY.
- HFT GENERAL CONTRACTOR TO INSTALL POWER POLES FOR CASH WRAPS. LOCATIONS INDICATED ON PLAN. PRIOR TO INSTALLATION COORDINATE WITH FIXTURE FABRICATOR.
- HFT GENERAL CONTRACTOR TO FIELD SURVEY AND COORDINATE ACCESS OF ALL MILLWORK WITH HARBOR FREIGHT TOOLS OPERATIONS / STORE DESIGN.
- HFT GENERAL CONTRACTOR AND FIXTURE FABRICATOR TO COORDINATE WITH APPROVED FIXTURE DRAWINGS.
- HFT GENERAL CONTRACTOR TO COORDINATE WITH THE HARBOR FREIGHT TOOLS CONSTRUCTION MANAGER FOR NEW FIXTURE DROP LOCATIONS, TYPES, AND QUANTITIES.
- ONLY GRAPHIC REPRESENTATIONS OF FIXTURES ARE SHOWN. ALL DIMENSIONS ARE APPROXIMATE. COORDINATE WITH FIXTURE DESIGNER AND FOLLOW ALL GOVERNING CODES FOR FINAL LOCATIONS AND PLACEMENT.
- FIXTURE INSTALLER TO ADJUST FIXTURE LAYOUT AS REQUIRED TO PROVIDE 4" CLEAR PAST ANY COLUMN U.N.O.

400 SERIES FIXTURE PLAN KEY NOTES

- ABC, CLASS 2A; 20BC (MIN.) WALL MOUNTED FIRE EXTINGUISHER PER CODE. FIRE EXTINGUISHERS LOCATED TO PROVIDE MAXIMUM FLOOR AREA PER UNIT OF 3,000 S.F. AND A MAXIMUM TRAVEL DISTANCE OF 50' AS SHOWN. CONTRACTOR TO VERIFY FINAL LOCATIONS WITH FIRE MARSHAL.
- FRONT/BACK OF HOUSE FIXTURES ANCHORED TO SLAB PER MANF. INSTRUCTIONS. VERIFY ADDITIONAL REQUIREMENTS WITH THE HARBOR FREIGHT TOOLS CONSTRUCTION MANAGER. SEE A1.4, 1.5, 1.6, 1.7, 1.8, 1.9 AND 1.10 FOR ADDITIONAL INFORMATION.
- SHELVING AT SALES REPLENISHMENT RACKINGS TO BE OPEN WIRE SHELVES.
- CASH WRAP. HFT GENERAL CONTRACTOR TO VERIFY EXACT LOCATIONS WITH THE HARBOR FREIGHT TOOLS CONSTRUCTION MANAGER. REFER TO THE ELECTRICAL DRAWINGS FOR ELECTRICAL REQUIREMENTS. INSTALL ALL CASH WRAPS WITH A MAXIMUM COUNTER HEIGHT OF 34" A.F.F. FOR A MINIMUM COUNTER LENGTH OF 36" PER ACCESSIBILITY CODES. SEE DETAIL 11A1.2 FOR ADDITIONAL INFORMATION.
- APPROXIMATE POWER POLE LOCATION. APPROXIMATE DECK AT POWER POLE IS 19'-8" IN HEIGHT. HFT GENERAL CONTRACTOR TO CONFIRM CASH WRAP IS IN PROPER LOCATION PRIOR TO POWER POLE INSTALLATION AND FINAL HOOK UP. E.C. TO PROVIDE AND INSTALL UNI-STRUT ATTACHED TO STRUCTURE FOR SECURING POWER POLE IN PLACE. PAINT UNI-STRUT TO MATCH EXPOSED STRUCTURE.
- CASH REGISTER
- (1) 6'-0" AND (1) 7'-0" FACTORY GRAY COUNTER TOP FOR THE MANAGERS OFFICE DESK AND (2) 6'-0" FACTORY GRAY COUNTER TOP FOR THE SUPPORT OFFICE DESK. SEE DETAIL 11A4.0 FOR ADDITIONAL INFORMATION.
- GRAY GROMMET IN COUNTER BY HFT GENERAL CONTRACTOR. VERIFY EXACT LOCATION W/ HFT.
- APPROXIMATE LOCATION OF SAFE BY HFT.
- APPROXIMATE LOCATION OF IT CABINET BY HFT.
- PRINTER
- "KRONOS SERIES 4000" TIME CLOCK. MOUNT CENTERED BETWEEN MANAGER OFFICE DOOR & WINDOW @ 44" A.F.F.
- LOCATION OF HFT FORKLIFT BATTERY CHARGER. SEE ELECTRICAL DRAWINGS & DETAIL 2/A1.2 FOR ADDITIONAL INFORMATION.
- LOCATION OF HFT FORKLIFT WATER TANK. SEE DETAIL 2/A1.2.
- LOCATION OF HFT EYE WASH STATION. SEE DETAIL 2/A1.2.
- APPROXIMATE LOCATION OF CART CORRAL.
- 26" ULINE FULL DOME AND HALF DOME SAFETY MIRROR TO BE MOUNTED FOR VISIBILITY AROUND FIXTURES. SEE SHEET A2.0 FOR ADDITIONAL INFORMATION.
- SECURITY TURNSTILE AND RAILING. G.C. TO COORDINATE TURNSTILE AND RAILING INSTALLATION WITH HFT OPERATIONS. SEE SHEET A5.2 FOR ADDITIONAL INFORMATION.
- ENDCAPS TO BE 50.25" WIDE (TYP.) ALL GONDOLAS TO BE ANCHORED TO SLAB

CLEARANCE HEIGHTS CHART


AREA	CLEARANCE	HIGH POINT	LOW POINT
SALES	BOTTOM OF DECK	±20'-0" A.F.F.	±16'-0" A.F.F.
	BOTTOM OF STRUCTURE	±18'-0" A.F.F.	±14'-0" A.F.F.
SALES REPLENISHMENT	BOTTOM OF DECK	±20'-0" A.F.F.	±16'-0" A.F.F.
	BOTTOM OF STRUCTURE	±18'-0" A.F.F.	±14'-0" A.F.F.
RECEIVING AREA	CLEARANCE @ O.H. DOOR	±14'-0" A.F.F.	

SQUARE FOOTAGE BREAKDOWN

SALES AREA SQUARE FOOTAGE	9,381 S.F.
SALES REPLENISHMENT SQUARE FOOTAGE	5,969 S.F.
OFFICE AREA SQUARE FOOTAGE	689 S.F.
TOTAL OVERALL LEASE SQUARE FOOTAGE	16,000 S.F.

FIXTURE PLAN KEY

SYMBOL	DESCRIPTION	HEIGHT
AW	ADVERTISING 4 WAY	4'-0" A.F.F.
AF	ADVERTISING FLAT	0'-0" A.F.F.
G	GONDOLA	7'-0" A.F.F. (Consider all unmarked fixtures to be Gondola's)
D	DOUBLE TABLE	1'-9" A.F.F. - 3'-6" A.F.F.
S	SINGLE TABLE	3'-8" A.F.F.
F	FLAT DISPLAY MAT	0'-0" A.F.F.
XP	EXTENDED PEG PANEL	0'-0" A.F.F.
PT	POWER TOOL DISPLAY	7'-0" A.F.F.
AT	AIR TOOL DISPLAY	7'-0" A.F.F.
MPR	MOTOR/ PUMP RACK	7'-0" A.F.F.
B	BOX STOCK ON DISPLAY FLAT	----
UP	UPRIGHT PROTECTOR	----

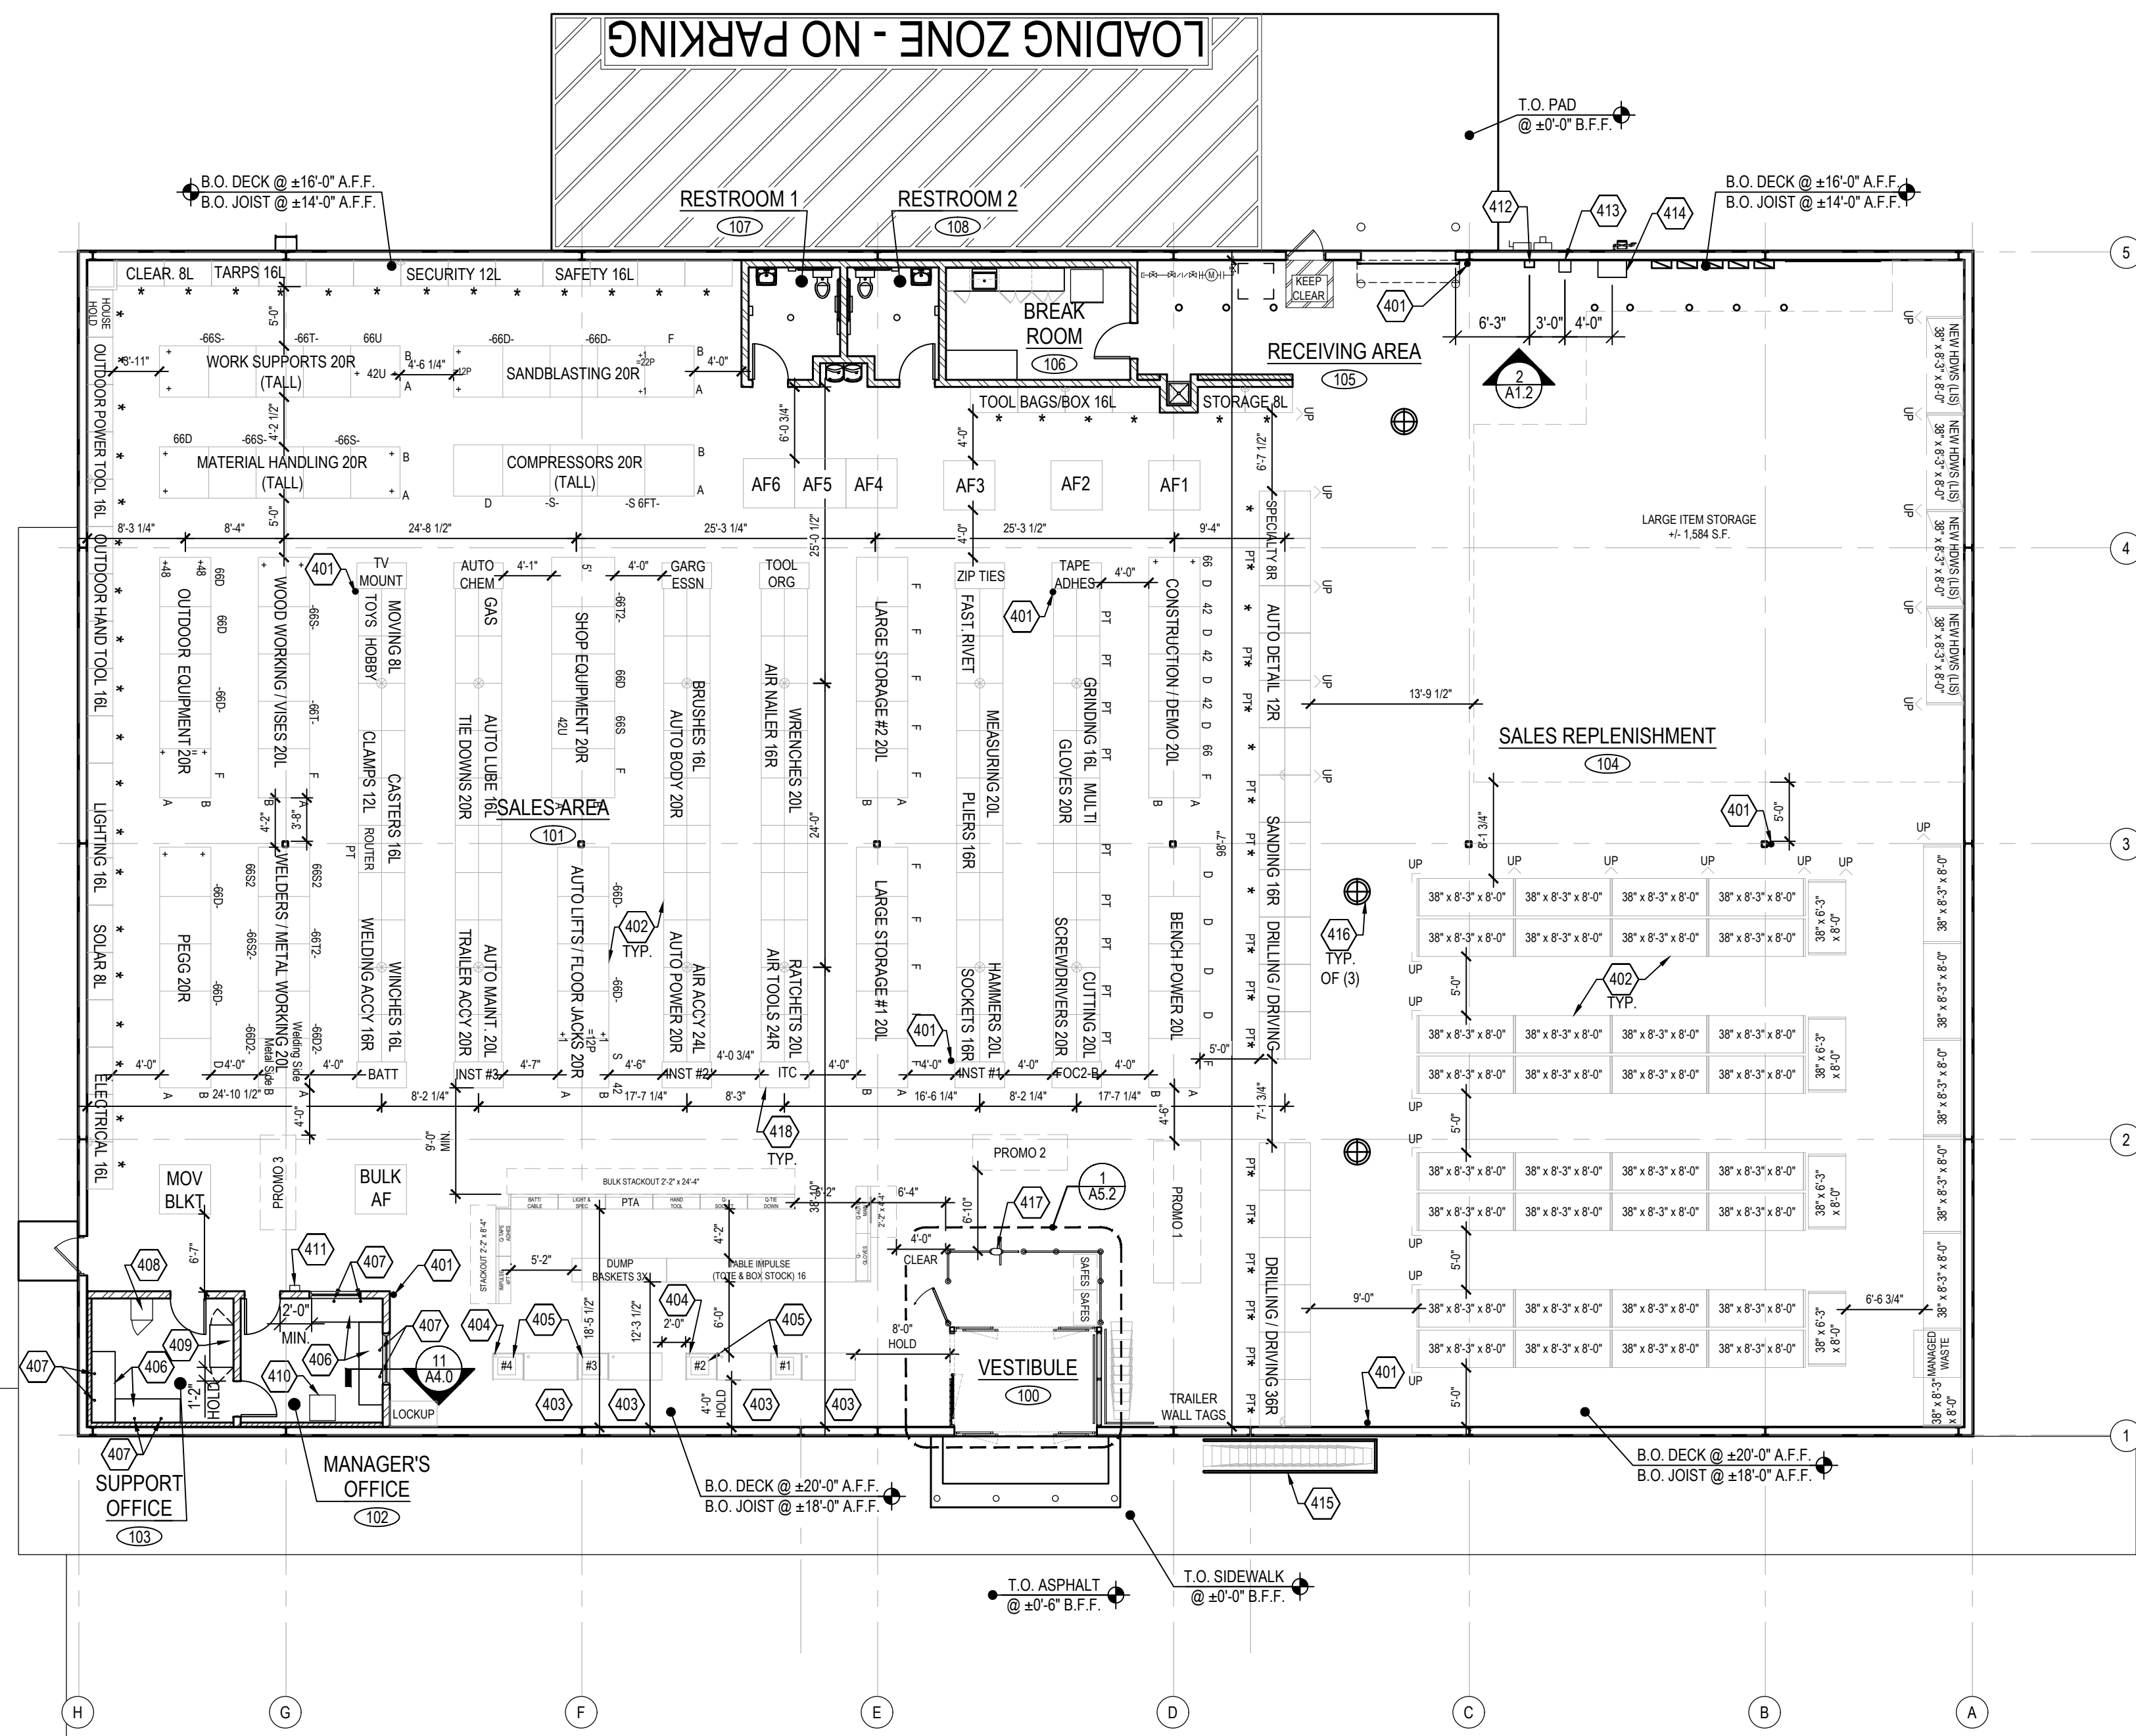

FIXTURE PLAN
 SCALE 3/32" = 1'-0"

DO NOT SCALE THESE DRAWINGS

REVISIONS	
#	DATE
1	
2	
3	
4	
5	
6	
7	
8	
9	
10	

FIXTURE PLAN

DATE 05/17/24
 JOB NO. 23475

A1.2
 SHEET NO.




05/17/24

ADA ARCHITECTS
 Lakewood, Ohio 44107
 17710 Detroit Avenue
 Phone (216) 521-1534
 Fax (216) 521-14824
 www.adaarchitects.com

HARBOR FREIGHT
 46 SHRUI LANE
 ERWIN, NC 28639

THESE DOCUMENTS CONTAIN INFORMATION PROPRIETARY TO ADA ARCHITECTS, INC. UNAUTHORIZED USE OF THESE DOCUMENTS IS EXPRESSLY PROHIBITED UNLESS AGREED UPON IN WRITING.

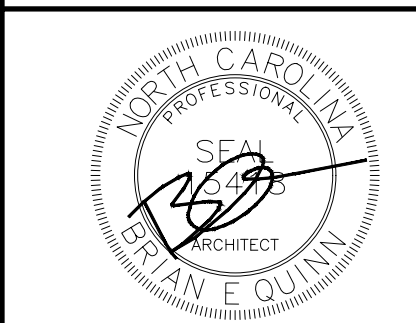

05/17/24

ADA ARCHITECTS
Lakewood, Ohio 44107
17710 Detroit Avenue
Phone (216) 521-1534 Fax (216) 521-4824
www.adaarchitects.com

HARBOR FREIGHT
ERWIN, NC 28839
46 SHRUI LANE

THESE DOCUMENTS CONTAIN INFORMATION PROPRIETARY TO ADA ARCHITECTS, INC. UNAUTHORIZED USE OF THESE DOCUMENTS IS EXPRESSLY PROHIBITED UNLESS AGREED UPON IN WRITING.

#	DATE	TYPE
1		
2		
3		
4		
5		
6		
7		
8		
9		
10		

FINISH PLAN


DATE 05/17/24
JOB NO. 23475

A1.3
SHEET NO.


KEY		MATERIAL	MFR.	COLOR	REMARKS
WALL FINISH	P-1	PAINT	SHERWIN - WILLIAMS	SW7067 CITYSCAPE (EGGSHELL)	UTILIZE PROMAR 200 (0 VOC) - NO SUBSTITUTIONS
	P-1A	PAINT	SHERWIN - WILLIAMS	SW7006 EXTRA WHITE (EGGSHELL)	UTILIZE PROMAR 200 (0 VOC) - NO SUBSTITUTIONS
	P-2	LATEX PAINT	SHERWIN - WILLIAMS	SW7067 CITYSCAPE (SEMI-GLOSS)	UTILIZE PROMAR 200 (0 VOC) - NO SUBSTITUTIONS
	P-6	PAINT - PRIMER	SHERWIN - WILLIAMS	WHITE	PREPRITE PROBLOCK PRIMER- NO SUBSTITUTIONS
	P-6A	PAINT - PRIMER	SHERWIN - WILLIAMS	WHITE	PROMAR BLOCK FILLER- NO SUBSTITUTIONS
	WC-1	FIBER REINFORCED PLASTIC (FRP) TO CEILING	MARLITE (NO SUBSTITUTIONS)	WHITE FACTORY FINISH	TRIM AND CUT AROUND ALL DISPENSERS & MIRRORS WHICH OVERLAP FRP AND CAULK EDGES. PROVIDE PVC TRIM MOLDING AT WALL BASE, DIVISION SEAMS, INSIDE AND OUTSIDE CORNERS AND EDGES. MITER TRIM AT ALL CORNERS AND CAULK ALL EXPOSED EDGES OF MOLDINGS.
FLOOR FINISH	CON-1	CONCRETE FLOOR SEALANT	HARBOR FREIGHT VENDOR	N/A	GRIND AND POLISH ALL CONCRETE FLOORS AS SPECIFIED ON SHEET A0.3 & A0.4
	LVT-1	FORMATIVE LVT PLANK 3.0mm 18" X 36"	MATTER SURFACES	BRIGHTON CONCRETE	JOINT WHERE VINYL TILE FLOOR MEETS 6" RUBBER BASE TO BE SEALED WITH SILICONE SEALANT. SEE LVT INSTALLATION NOTES ON SHEET A0.2 FOR ADDITIONAL INFORMATION.
BASE	C-1	CARPET TILE	MATWORKS - MONSTER TILE	CHARCOAL	
	C-2	CARPET TILE	MATWORKS - MATSHIELD	CHARCOAL	COLD WEATHER VESTIBULE TILE
CEILING	ACT-1	ACOUSTICAL CEILING TILE	ARMSTRONG	WHITE	2' x 4' CORTEGA SQUARE LAY-IN TILE #769 w/ PRELUDE 15/16" EXPOSED TEE GRID.
	ACT-2	ACOUSTICAL CEILING TILE	NATIONAL GYPSUM	WHITE	2' x 4' GOLD BOND BRAND, GRIDSTONE 1/2" FIRE-SHIELD GYPSUM CEILING PANELS w/ PRELUDE 15/16" EXPOSED TEE GRID.
MISC.	P-5	PAINT	SHERWIN - WILLIAMS	DRY FALL - SW7069 IRON ORE (FLAT)	PRO INDUSTRIAL WATERBORNE ACRYLIC DRYFALL - UTILIZE B42T0018-20 (LOW VOC) - NO SUBSTITUTIONS
	S-1	VINYL CAP SHEET	LAMTEC	WMP-10 BLACK	CAP SHEET FOR APPLICATIONS TO EXPOSED INSULATION AT UNDERSIDE OF DECK. INSTALL PER MFR. SPECIFICATIONS.
	P-3	INDUSTRIAL ACRYLIC GLOSS - MARINE GRADE	SHERWIN - WILLIAMS	SW4081 SAFETY RED (GLOSS)	PRO INDUSTRIAL MULTI SURFACE ACRYLIC. FOR PAINT APPLICATIONS TO EIFS AND MASONRY. USE (1) COAT SW CONFLX MASONRY PRIMER.
	P-3A	INDUSTRIAL HIGH PERFORMANCE ACRYLIC - MARINE GRADE	SHERWIN - WILLIAMS	SW4081 SAFETY RED (GLOSS)	PRO INDUSTRIAL ACRYLIC ACROLON 100 / PRO INDUSTRIAL ACROLON 218 HS. FOR PAINT APPLICATIONS TO PRE-FINISHED METAL. USE (1) COAT SW PROCRYL PRIMER.
	P-4	INDUSTRIAL HIGH PERFORMANCE ACRYLIC	SHERWIN - WILLIAMS	SW7067 CITYSCAPE (GLOSS)	PRO INDUSTRIAL ACRYLIC ACROLON 100 / PRO INDUSTRIAL ACROLON 218 HS. FOR PAINT APPLICATIONS TO STEEL HANDRAILS. USE (1) COAT SW MACROPOXY 646-100 EXPOY PRIMER.
	P-7	INDUSTRIAL ENAMEL	SHERWIN - WILLIAMS	SW4084 SAFETY YELLOW (SEMI-GLOSS)	PRO INDUSTRIAL WATERBASED ALKYD URETHANE. SEE PLAN FOR EXTENTS OF FLOOR STRIPING
	P-8	INDUSTRIAL ENAMEL	SHERWIN - WILLIAMS	SW7067 CITYSCAPE (SEMI-GLOSS)	PRO INDUSTRIAL WATERBASED ALKYD URETHANE. INTERIOR DOORS, DOOR FRAMES, COLUMNS AND OVERHEAD DOOR FRAME
	P-9	ACRYLIC-POLYURETHANE	SHERWIN - WILLIAMS	SW9176 DRESS BLUES (GLOSS)	PRO INDUSTRIAL ACRYLIC ACROLON 100 / PRO INDUSTRIAL ACROLON 218 HS. FOR EXTERIOR PAINT APPLICATIONS. USE (1) COAT SW MACROPOXY 646-100 EXPOY PRIMER FOR APPLICATIONS TO MASONRY. (1) COAT SW PROCRYL PRIMER FOR PRE-FINISHED METAL.
	P-10	INDUSTRIAL ACRYLIC GLOSS	SHERWIN - WILLIAMS	SW7066 GRAY MATTERS (GLOSS)	PRO INDUSTRIAL MULTI SURFACE ACRYLIC. FOR EXTERIOR PAINT APPLICATIONS. USE (1) COAT SW MACROPOXY 646-100 EXPOY PRIMER FOR APPLICATIONS TO MASONRY. (1) COAT SW PROCRYL PRIMER FOR PRE-FINISHED METAL.
	P-11	INDUSTRIAL ACRYLIC GLOSS	SHERWIN - WILLIAMS	SW7067 CITYSCAPE (GLOSS)	PRO INDUSTRIAL MULTI SURFACE ACRYLIC. FOR EXTERIOR PAINT APPLICATIONS. USE (1) COAT SW MACROPOXY 646-100 EXPOY PRIMER FOR APPLICATIONS TO MASONRY. (1) COAT SW PROCRYL PRIMER FOR PRE-FINISHED METAL.

NOTE: G.C. SHALL USE HARBOR FREIGHT TOOLS NATIONAL PARENT ACCOUNT #7757 WHEN ORDERING PAINT. SEE SHEET **A0.0** FOR VENDOR CONTACT INFORMATION.

NOTE: G.C./PAINTER TO UTILIZE SHERWIN WILLIAMS PAINT AS SPECIFIED. NO SUBSTITUTIONS. G.C./PAINTER TO UTILIZE HFT PARENT ACCOUNT FOR THE PROCUREMENT OF ALL PAINTS. COORDINATE SUPPORTING DOCUMENTATION WITH BY PM AND/OR HFT CM AS REQUIRED.

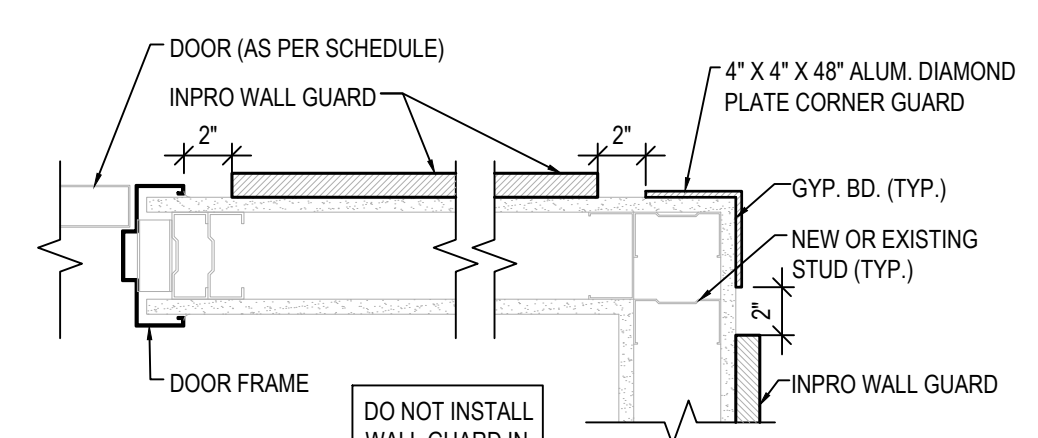


3 WALL GUARD SPACING DETAILS
SCALE: 1-1/2" = 1'-0"

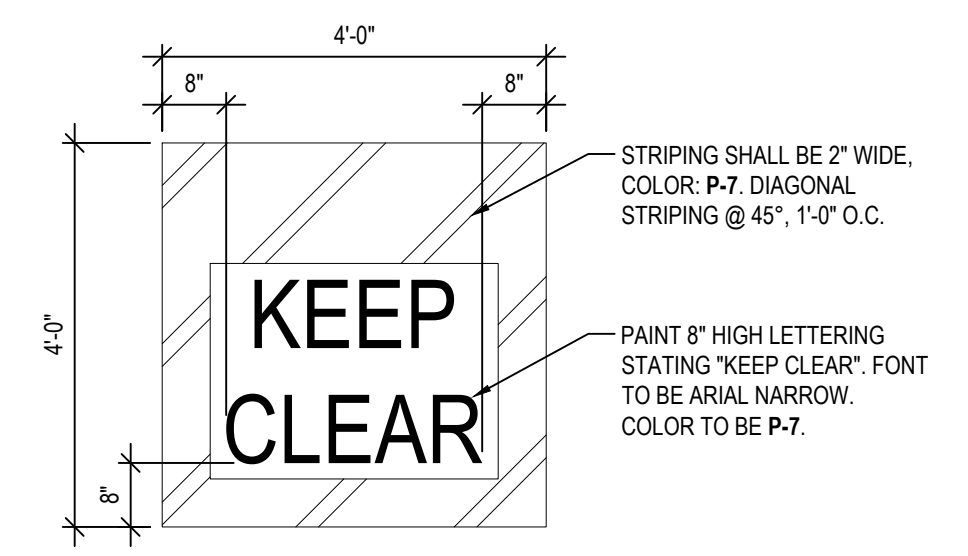


4 STOCK EGRESS STRIPING DETAIL
SCALE: 1/2" = 1'-0"

TAG SCHEDULE		ROOM SCHEDULE					
TAG	DESCRIPTION	NO.	ROOM NAME	WALL	BASE	FLOOR	CEILING
WG	DENOTES 700 WALL GUARD, AS MANUFACTURED BY INPRO, SHIPROCK, 0280" CENTERLINE OF RAIL MOUNTED @ 32" A.F.F. PER MANF. RECOMMENDATIONS. MIN. RUN 1'-6". HOLD WALL GUARD 2" FROM DOOR FRAMES AND CORNER GUARDS. SEE DETAIL 3A1.3 FOR ADDITIONAL INFORMATION. TERMINATE GUARDS WITH 701 END CAPS.	100	VESTIBULE	P-1	N/A	C-1	ACT-2
BR	MCCUE ZINC PLATED STEEL BOXRAIL HEAVY DUTY FLOOR BUMPER INSTALLED PER MANF. RECOMMENDATIONS.	101	SALES AREA	P-1A	VB-1	CON-1	OPEN TO STRUCTURE (PAINT P-5) TO 12" BELOW LOW POINT OF STRUCTURE
FB	LINE INDICATES FRT WOOD BLOCKING FOR WALL FIXTURES. SHADED AREA INDICATES LOCATION OF WALL FIXTURES. SEE DETAIL 1A1.3 FOR ADDITIONAL INFORMATION.	102	MANAGER OFFICE	P-1A	VB-1	LVT-1	ACT-1
OW	SHADED LINE DESIGNATES AREAS TO RECEIVE 1/2" OSB WAINSCOT TO 8'-0" A.F.F. OSB TO BE ORIENTED VERTICALLY. SEE PLAN FOR ADDITIONAL INFORMATION.	103	SUPPORT OFFICE	P-1A	VB-1	LVT-1	ACT-1
CA	CORNER GUARD. SEE DETAIL 2A1.3 FOR ADDITIONAL INFORMATION. TYPES: A, B, C, D, E	104	SALES REPLENISHMENT	P-1A	AS NOTED	CON-1	OPEN TO STRUCTURE (PAINT P-5) TO 12" BELOW LOW POINT OF STRUCTURE
VB	EXTEND BASE "VB-1" WITHIN SALES REPLENISHMENT AREA, DIMENSIONED LOCATION ONLY	105	RECEIVING AREA	P-1A	AS NOTED	CON-1	OPEN TO STRUCTURE (PAINT P-5) TO 12" BELOW LOW POINT OF STRUCTURE
TB	INSTALL 1x3 WOOD BLOCKING AT 6'-0", 5'-0" AND 3'-6" A.F.F. TO TOP OF BOARD, DIMENSIONED LOCATION ONLY. PAINT TO MATCH P-1.	106	BREAK ROOM	P-1A	VB-1	LVT-1	ACT-1
SP	DENOTES AREA OF FLOOR PAINTING AT STOCK EGRESS DOOR. SEE DETAIL 4A1.3 FOR ADDITIONAL INFORMATION.	107	RESTROOM 1	WC-1	VB-1	LVT-1	ACT-2
	DIMENSIONS SHOWN FOR ESTIMATION OF MATERIALS PURPOSES ONLY (TYP.)	108	RESTROOM 2	WC-1	VB-1	LVT-1	ACT-2


NOTES:
1. STRUCTURE ABOVE TO BE CLEANED AND CLEARED OF DEBRIS. ALL EXPOSED STEEL STRUCTURE AND DECK TO BE PAINTED P-5. COLUMNS TO BE PAINTED P-8.
2. ALL PREVIOUSLY PAINTED ITEMS TO BE PAINTED INCLUDING PIPING, DUCTWORK, CONDUIT, ETC.
3. ALL NEW WORK TO BE PAINTED. EXCLUDING NEW DUCTWORK / NEW HVAC DIFFUSERS. NEW CONDUIT TO BE PAINTED IF ADJACENT SURFACE IS TO BE PAINTED.
4. ALL DOORS AND FRAMES TO BE PAINTED P-8.
5. ALL GYPSUM BOARD SURFACES TO BE PAINTED P-1 OR P1-A.
6. ALL PREVIOUSLY PAINTED CMU (or CONCRETE) SURFACES TO BE PRIMED P-6A, PAINTED P-2.
7. ALL BARE CMU (or CONCRETE) SURFACES TO BE PRIMED P-6A, PAINTED P-2.
8. PROVIDE A CLEAN, SMOOTH CONCRETE SURFACE FOR PROPER INSTALLATION OF ALL FLOOR FINISHES.
9. APPLICATIONS OF PAINT SHALL BE ONE COAT PRIMER AND TWO COATS PAINT (U.N.O.) PRIMER SHALL BE SPECIFIED OR RECOMMENDED BY PAINT MANUFACTURER.
10. ALL MECHANICAL GRILLES / REGISTERS FACING INTO SALES AND STOCK AREAS TO BE PAINTED TO MATCH ADJACENT WALL SURFACE.

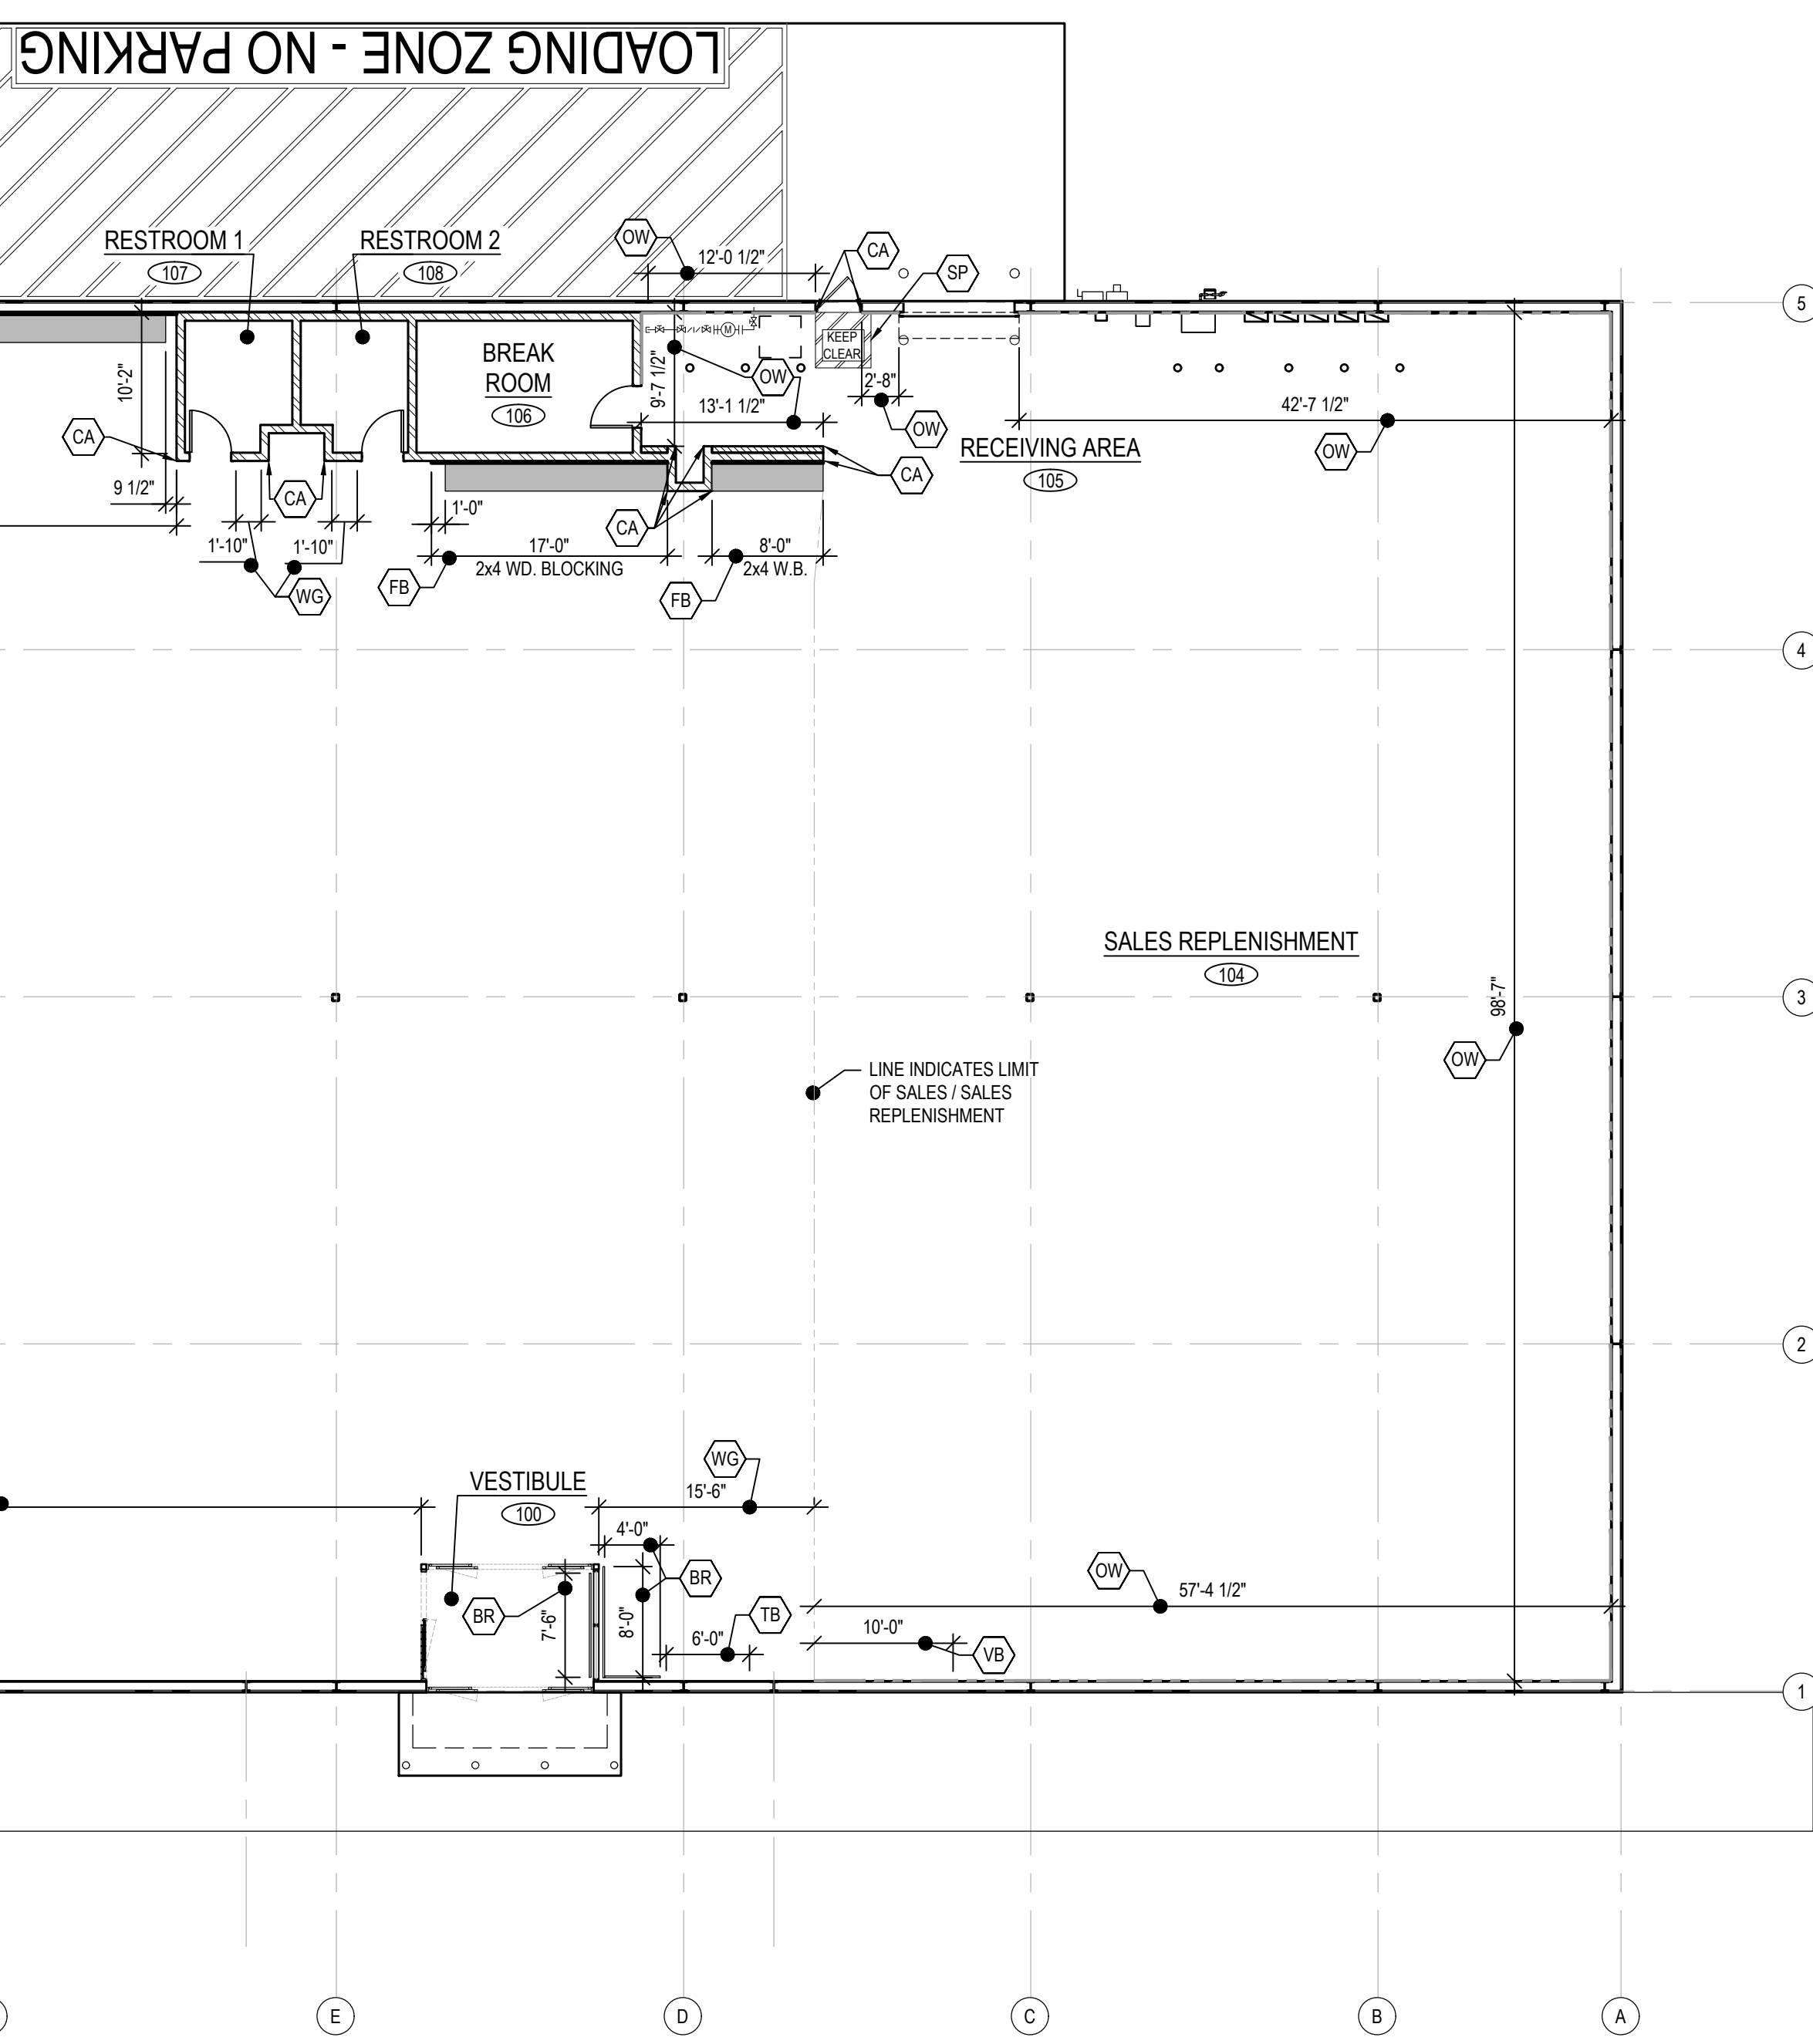

FINISH PLAN
SCALE 3/32" = 1'-0"

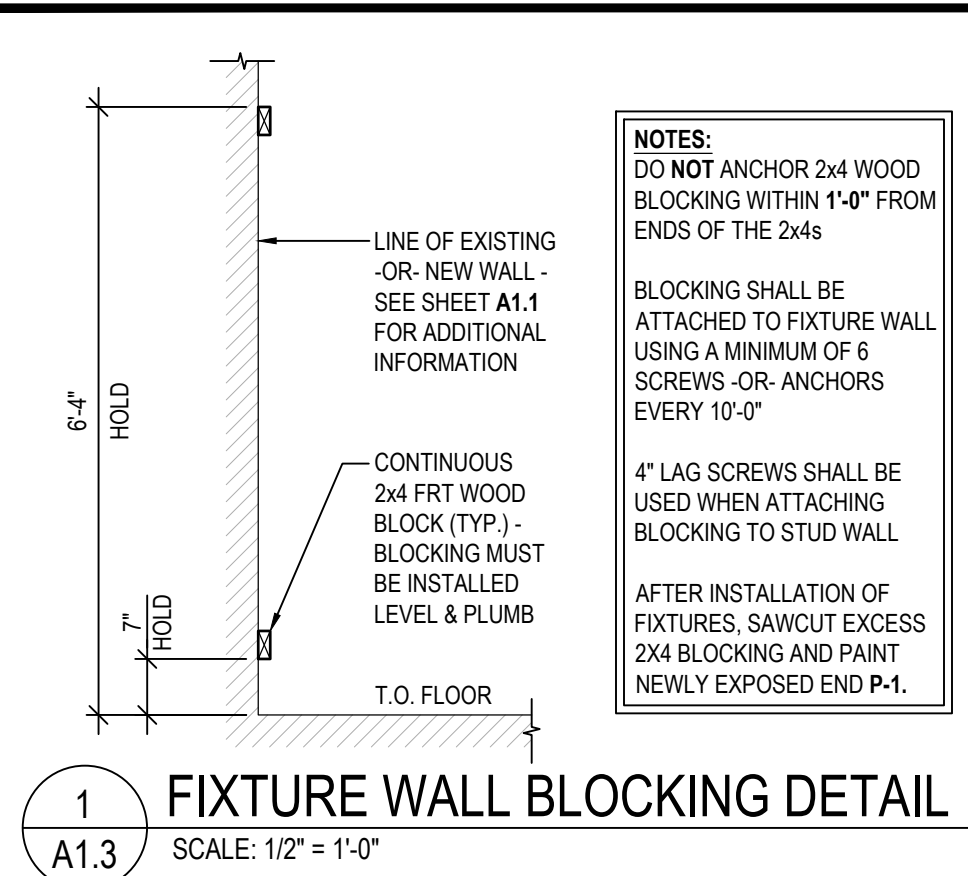

1 FIXTURE WALL BLOCKING DETAIL
SCALE: 1/2" = 1'-0"

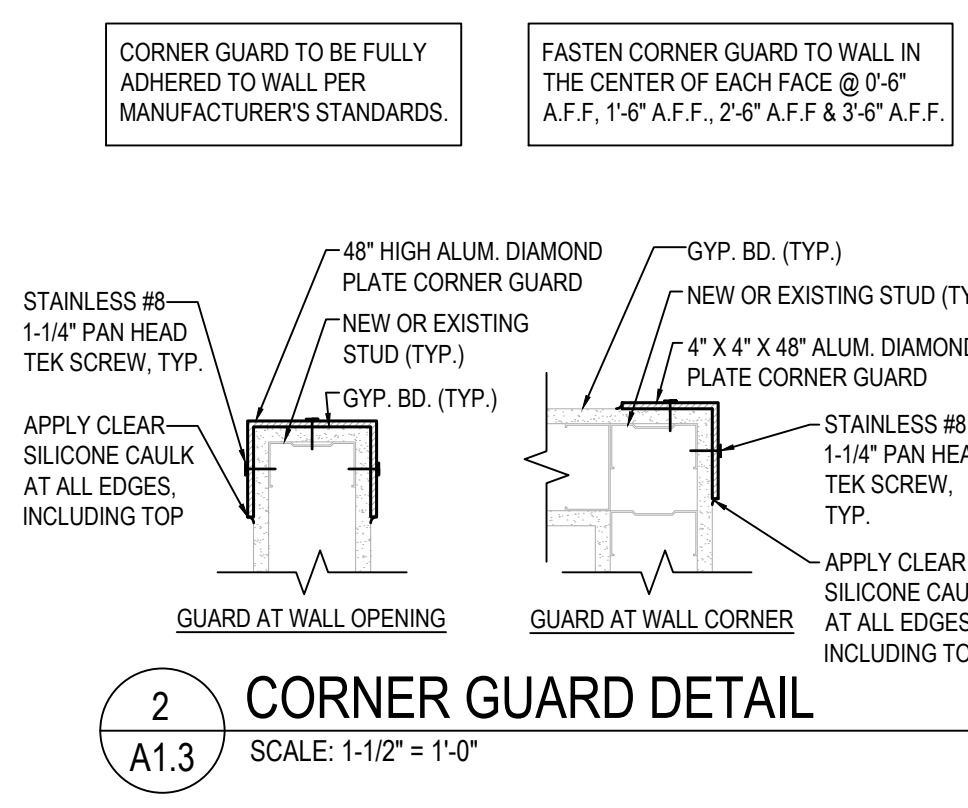


2 CORNER GUARD DETAIL
SCALE: 1-1/2" = 1'-0"


DO NOT SCALE THESE DRAWINGS

MAXILINE GONDOLA AND WALL GENERAL ASSEMBLY

NOTE! This publication is intended to be a generic installation instruction for Madix gondola and wall shelving, and may possibly be subject to change as required by the local building codes. Consult the building inspection department at the job site.

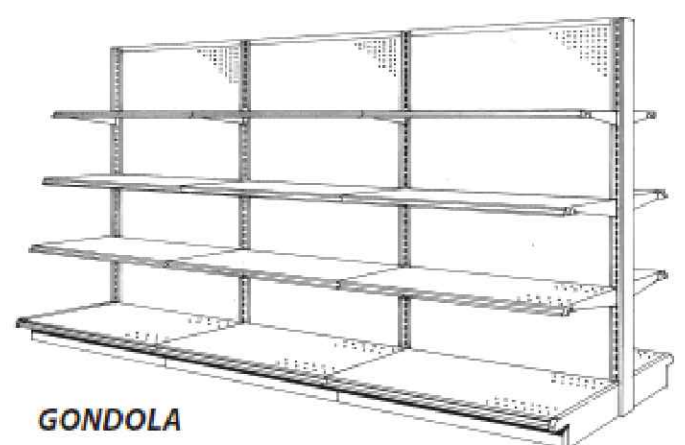

GONDOLA

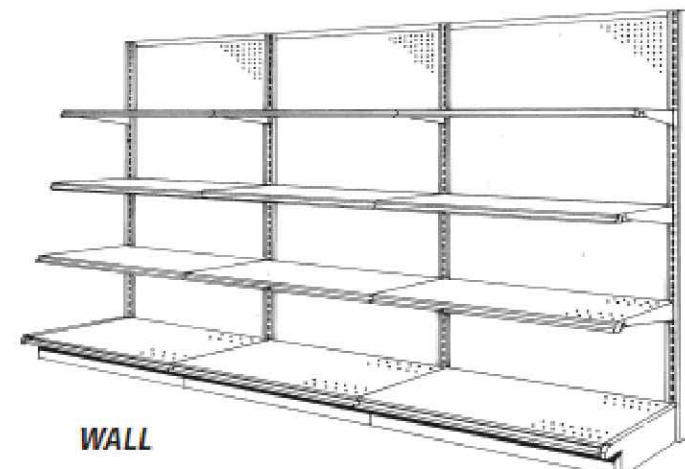

WALL

IMPORTANT! When unloading, stack all boxes...
 1. WITH THE LABELS VISIBLE.
 2. WITH THE SAME DESCRIPTION TOGETHER.
 3. WITH THE SAME PART NUMBER TOGETHER.

READ AND UNDERSTAND THIS DOCUMENT BEFORE PROCEEDING TO INSTALL SHELVING. SPECIAL ITEMS THROUGHOUT ARE DENOTED WITH:

CAUTION! **IMPORTANT!** **WARNING!**

NOTE!
 THE STANDARD PRODUCTS LISTED BELOW WILL ALTER THE INSTALLATION PROCEDURE SHOWN. Specific instructions covering any products listed below, if ordered, are included with this document package. Refer to them prior to beginning installation since your procedure will be altered.

- END MERCHANDISER.....ASY-652
- CANOPIES.....ASY-092
- TELESCOPING UPRIGHTS.....ASY-027
- BOX CORNER.....ASY-098
- METAL END FLAT.....ASY-269
- INSIDE CORNER.....ASY-062
- OPEN BACK STIFFENER.....ASY-042
- OUTSIDE CORNER.....ASY-059
- FLOOR ANCHORS.....ASY-357
- WIRE GRID BACKS.....ASY-328
- OUTSIDE MOUNT END MERCHANDISER.....ASY-064
- TRIPLE BACK SYSTEM.....ASY-325



PO BOX 729 TERRELL, TEXAS 75160
 214.515.5400 / 800.726.2387
 ASY-046 PAGE 1 OF 15 REV.06
 10/18/06 AJB ECN#500000010840

PALLET LABEL LAYOUT

SHIP DATE: 04/14/2008 CUSTOMER P.O.:
 PALLET #: 1002342380 CUST PO#: D029076 WT: 186.220 PALLET WEIGHT
 MFQ ORDER #: MADIX ORDER: FROM: Madix Store Fixtures TO: THE CUSTOMER
 MADIX ORDER #: 127394 1537 South Main Street
 CARRIER: 04/14/2008 CARRIER: AVONDALE TRUCKING AL 35072 SHIP TO ADDRESS
 123 FAKE STREET
 ROANOKE VA 24012 US
 MF: PALLET: Palletize PACK TYPE REQUEST
 TL = TRUCK LOAD
 LTL = LESS THAN TRUCK LOAD

QTY	UOM	ITEM# / DESCRIPTION	COLOR
10.0 EA	SUS-416	STD UPPER SHELF	SA-DGA11A-SP
4.0 EA	SUS-416	STD UPPER SHELF	SA-DGA11G-SP
3.0 EA	SUS-422	STD UPPER SHELF	SA-DGA11A-SP

QUANTITY ON PALLET MATERIAL # MATERIAL DESCRIPTION MATERIAL COLOR(S)

PO BOX 729 TERRELL, TEXAS 75160
 214.515.5400 / 800.726.2387
 ASY-046 PAGE 2 OF 15 REV.06
 10/18/06 AJB ECN#500000010840

POST THIS ENTIRE PAGE IN A CONSPICUOUS PLACE, CLEARLY VISIBLE TO ALL STORE PERSONNEL

WARNING!

READ BEFORE ASSEMBLY - FOR YOUR SAFETY!

- Install all shelving and/or fixtures as described in installation instruction.
- Shelving and components should ONLY be installed by trained personnel who have read and understand these instructions. Failure to do so may result in product damage or personal injury.
- Do not exceed the maximum load capacities as outlined under all headings related to Load Limits or Capacities in this document.
- Never use damaged parts.
- Install and use components only as directed.
- Do not combine Madix products with non-Madix products.
- Always install kickplates (KP-(nw)) to retain the structural integrity of the shelving. Kickplates must be installed correctly!
- Do not hang shelves, peg hooks or other accessories on the side of a fixture that does not have base shoes (BS) installed.
- Do not hang shelving, peg hooks or other accessories that exceed the depth of the base on a gondola or wall.
- All components that require trim, such as uprights (BU) and base shoes (BS) should have trim installed.
- Never expose any sharp or pointed edges to shoppers or employees.
- Do not climb or stand on shelving.
- Provide safe access to all levels of shelving according to OSHA regulations.
- Do not move assembled unit.
- Do not rearrange shelving while merchandised.
- Do not lean heavy items against shelving.
- All end panels (EP) and other panels for merchandising or aesthetics must have bases in order to direct traffic away from protrusions.

TERRELL, TX 800-726-2349



CLEANING SHELVING:

IMPORTANT INSTRUCTIONS FOR CLEANING MADIX METAL SHELVING:

When necessary to clean Madix shelving, use of a non-abrasive mild detergent and warm water, followed by thorough drying is ideal. The use of a cloth made of a soft, white cotton material is strongly recommended. The use of cleaning agents that contain abrasives, bleach, or strong solvents such as ketones, ethers etc. will result in damage to the finish. The damage is most severe when these harsh cleaning agents are used on colors which contain leafing aluminum pigment such as powder chrome, silver vein and other "vein" type finishes. The aluminum in these coatings resides at the surface of the finish and is therefore more susceptible to damage by the harsh cleaning agents. As an alternative to the mild detergent, cleaners with ingredients similar to those found in products such as 409, Fantastik, and Simple Green can be used. CAUTION! Cleaners having ingredients similar to those found in Ajax, Borax, Bleach, Comet, etc. should be avoided as finish damage could result.

WARNING! ALL GONDOLA AND WALL FIXTURES EXCEEDING 96" IN HEIGHT MUST BE SECURELY ANCHORED! SEE ASY-357 FOR PROPER ANCHORING PROCEDURES FOR GONDOLA AND WALL!

WARNING! NEVER STACK EXTENSION UPRIGHTS (EU). Do not exceed maximum load capacity on EU. Maximum load capacity for EU 6" to 12" is 250 lb per side, 13" to 18" is 215 lb per side, 19" to 24" is 160 lb per side, and 24" and up is 100 lb per side. SEE ASY-018 FOR EU INSTALLATION.

WARNING! LOAD CAPACITY FOR PEGBOARD BACKS: MAX 150 lbs for per side with SL lower spanner in place. MAX 300 lbs per side with HSL Heavy Duty Lower Spanner





PO BOX 729 TERRELL, TEXAS 75160
 214.515.5400 / 800.726.2387
 ASY-046 PAGE 3 OF 15 REV.06
 10/18/06 AJB ECN#500000010840

FIXTURE HEIGHT TO BASE WIDTH:

If the height of the upright exceeds six times the space between the upright and shoe leveler, the system must be secured in one of the following configurations:

- Secured at the top as per pg. 11 or...
- For Gondolas, Base Shoe Levelers must be anchored to the floor as shown in ASY-357
- For Walls, Base Shoe Levelers AND Upright Levelers must be anchored to the floor.

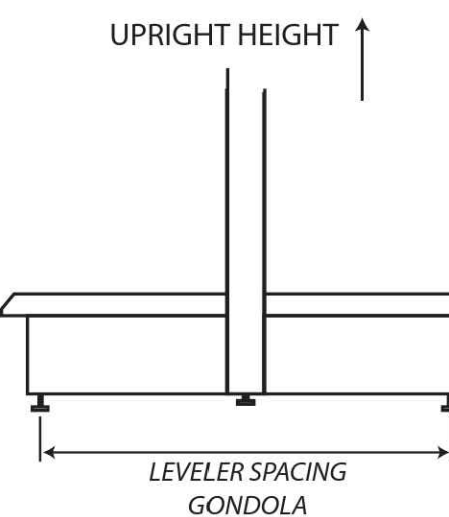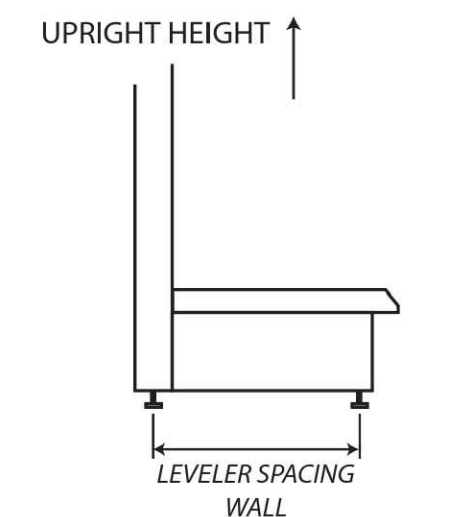

WALLS... USE CHART FOR EXAMPLE ONLY:

BASE SHELF DEPTH OF	EQUALS LEVELER SPACING OF	MAX HEIGHT OF UNANCHORED UPRIGHT
12"	9 1/2"	54"
14"	11 1/2"	66"
16"	13 1/2"	78"
18"	15 1/2"	90"
20"	17 1/2"	102"
22"	19 1/2"	114"
24"	21 1/2"	120"
26"	23 1/2"	138"
28"	25 1/2"	144"
30"	27 1/2"	162"

GONDOLAS... USE CHART FOR EXAMPLE ONLY:

BASE SHELF DEPTHS OF	EQUALS LEVELER SPACING OF	MAX HEIGHT OF UNANCHORED UPRIGHT
12" & 12"	19"	114"
12" & 14"	21"	126"
14" & 14"	23"	138"
14" & 16"	25"	144"
16" & 16"	27"	162"

WARNING! ALL UPRIGHTS 96" AND ABOVE WILL NEED TO BE ANCHORED.


WARNING! BOLTING UPPER SHELVES AT THE TOP OF FIXTURES TALLER THAN 96"...

ON ANY UPPER ROW OF SHELVES ON FIXTURES TALLER THAN 96"; THE SHELVES MUST BE BOLTED TOGETHER THROUGH THE FRONT MOST HOLES IN THE SIDES OF THE SHELVES!

VIEW FROM BELOW UPPER SHELVES



PO BOX 729 TERRELL, TEXAS 75160
 214.515.5400 / 800.726.2387
 ASY-046 PAGE 4 OF 15 REV.06
 10/18/06 AJB ECN#500000010840

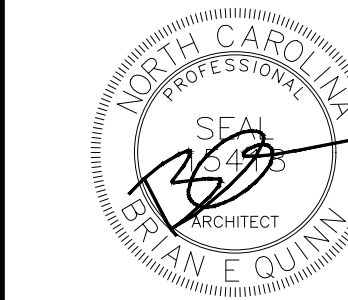

05/17/24

ADA ARCHITECTS

Lakewood, Ohio 44107
 17710 Detroit Avenue
 Phone (216) 521-5134 Fax (216) 521-14824
 www.adaarchitects.com

HARBOR FREIGHT

ERWIN, NC 28839

46 SHRUI LANE

THESE DOCUMENTS CONTAIN INFORMATION PROPRIETARY TO ADA ARCHITECTS, INC. UNAUTHORIZED USE OF THESE DOCUMENTS IS EXPRESSLY PROHIBITED UNLESS AGREED UPON IN WRITING.

REVISIONS

#	DATE	TYPE
1		
2		
3		
4		
5		
6		
7		
8		
9		
10		

FIXTURE SPECIFICATIONS AND DETAILS

DATE 05/17/24

JOB NO. 23475

A1.4

SHEET NO.

DO NOT SCALE THESE DRAWINGS



05/17/24

ADA ARCHITECTS

Lakewood, Ohio 44107
17710 Detroit Avenue
Phone (216) 521-1534
Fax (216) 521-14824
www.adaarchitects.com

HARBOR FREIGHT

ERWIN, NC 28639

46 SHRUI LANE

THESE DOCUMENTS CONTAIN INFORMATION PROPRIETARY TO ADA ARCHITECTS, INC.
UNAUTHORIZED USE OF THESE DOCUMENTS IS EXPRESSLY PROHIBITED UNLESS AGREED UPON IN WRITING.

GONDOLA / WALL PARTS IDENTIFICATION...



• THE PARTS SHOWN HERE REPRESENT A WALL, SINGLE SIDED, SECTION.

• BOTH GONDOLA AND WALL SECTIONS USE THE SAME PARTS.


• PAGES 7-10 SHOW INSTALLATION OF A GONDOLA, DOUBLE SIDED, FIXTURE.

WSRP MUST BE INSTALLED IN ALL WALL UPRIGHTS AND ALL UPRIGHTS ABOVE 96" FOR GONDOLA AND WALL!

NOTE: ONLY BS-(ND) SHOES WILL REQUIRE THE WSRP, BSSL-(ND) DO NOT REQUIRE THE WSRP.

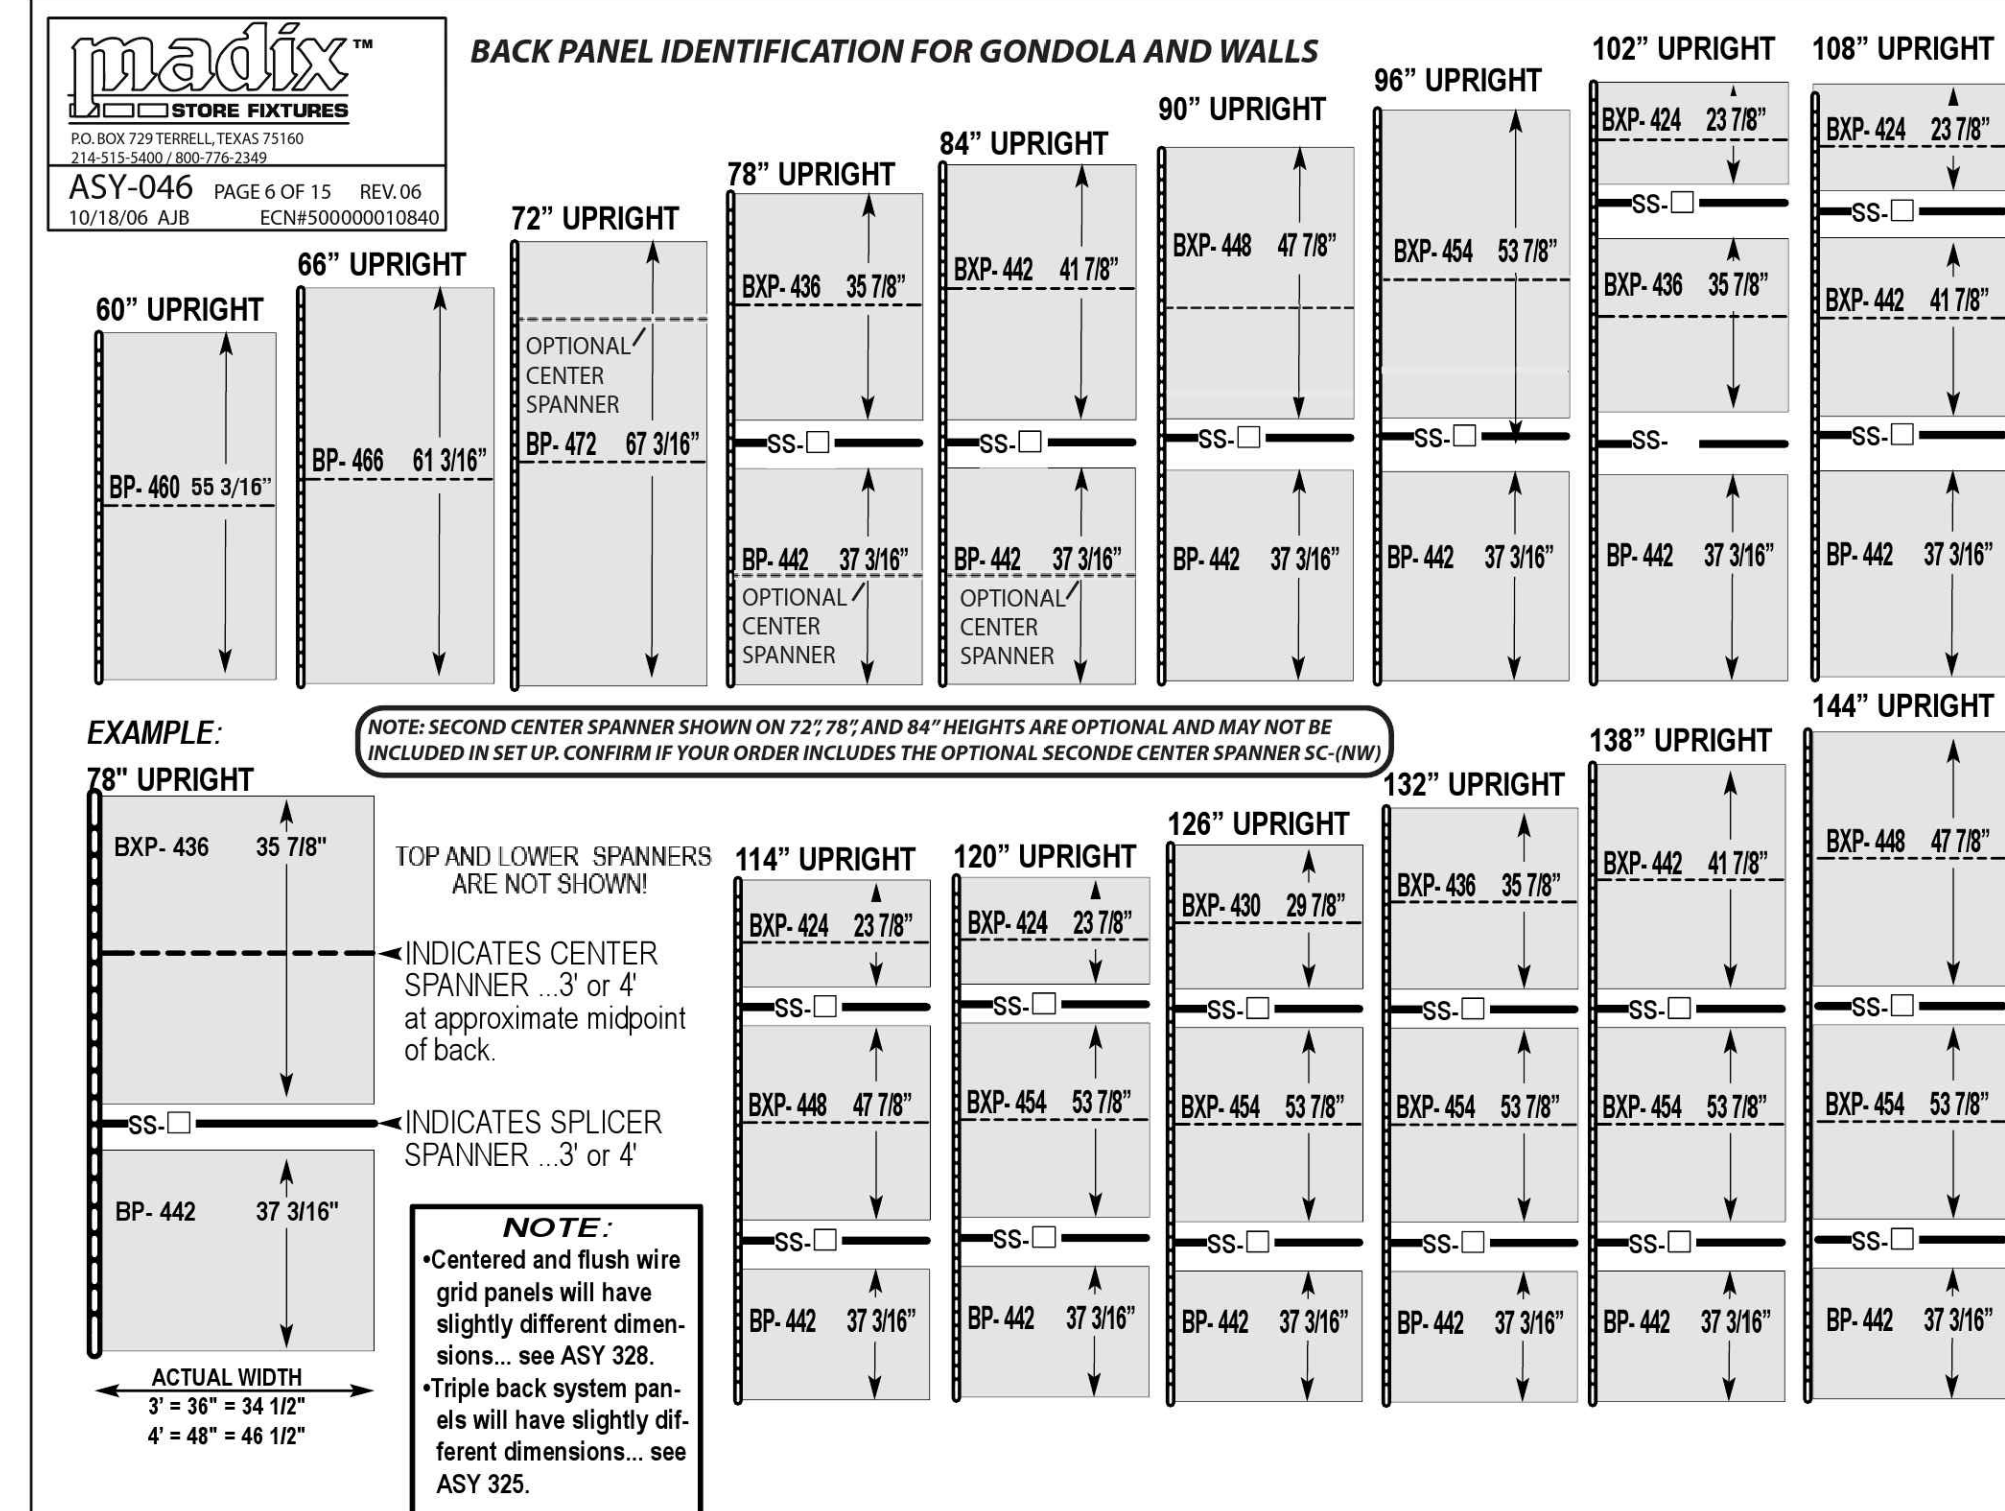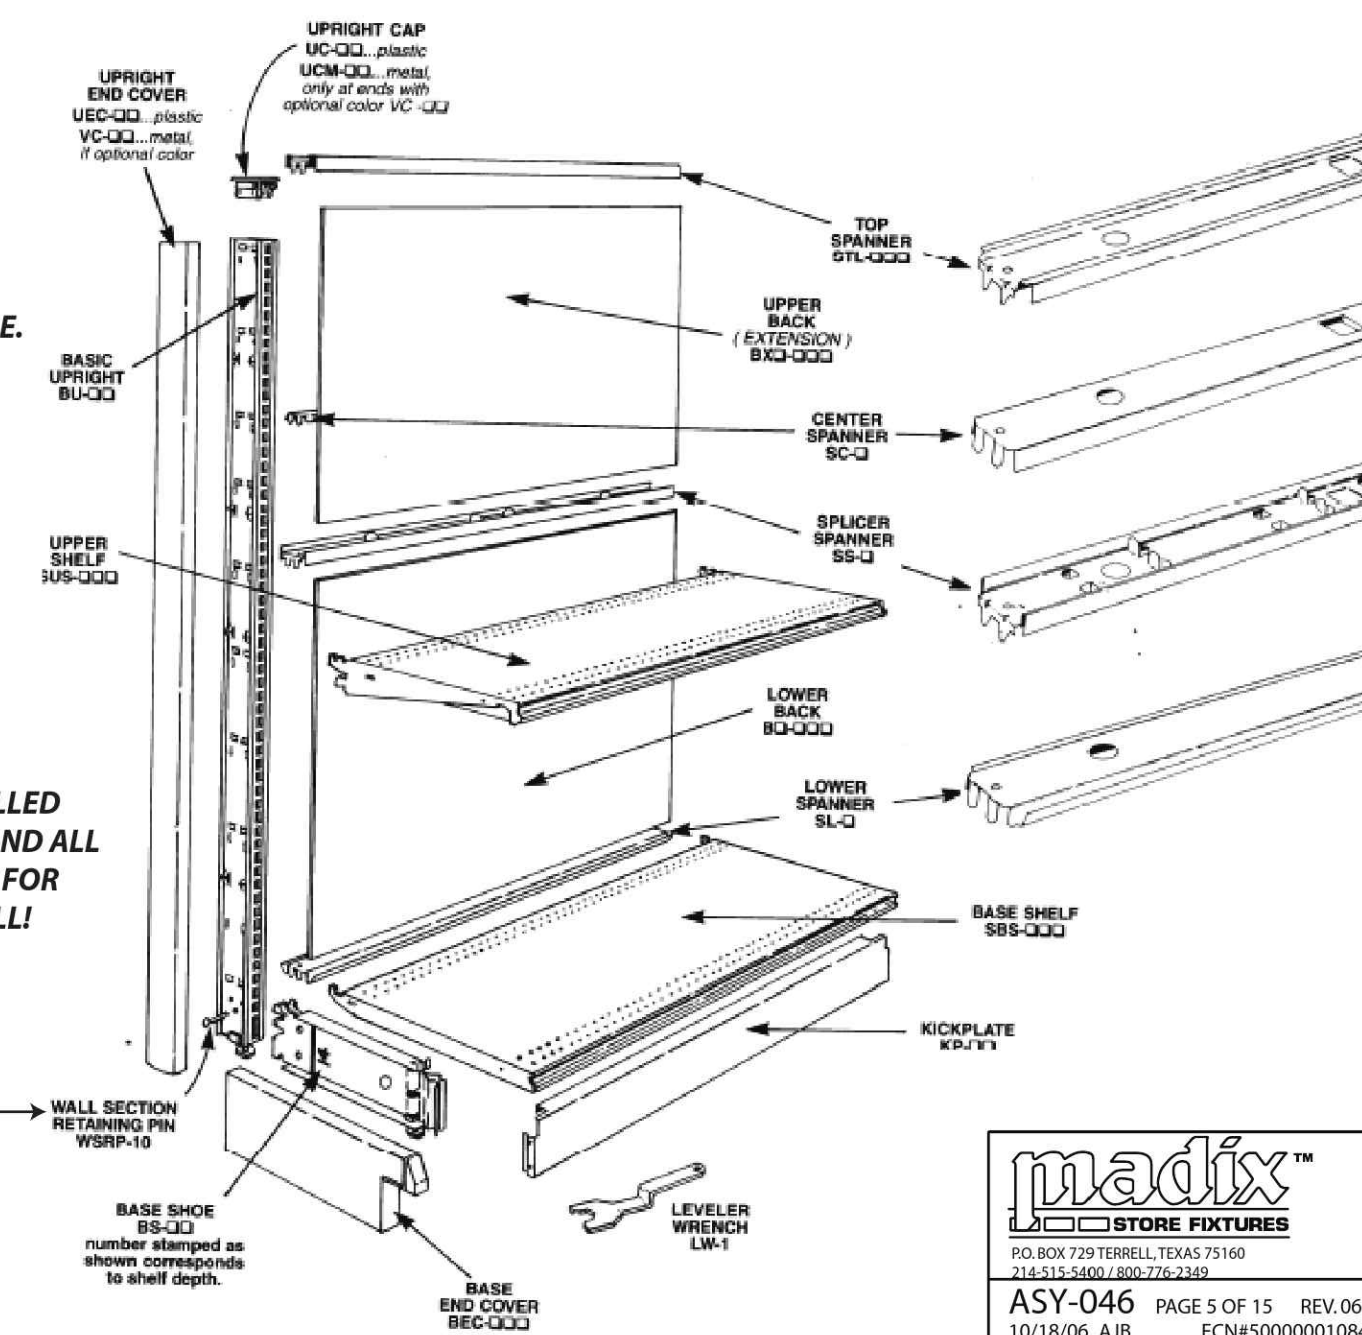

ASSEMBLY PROCEDURE...

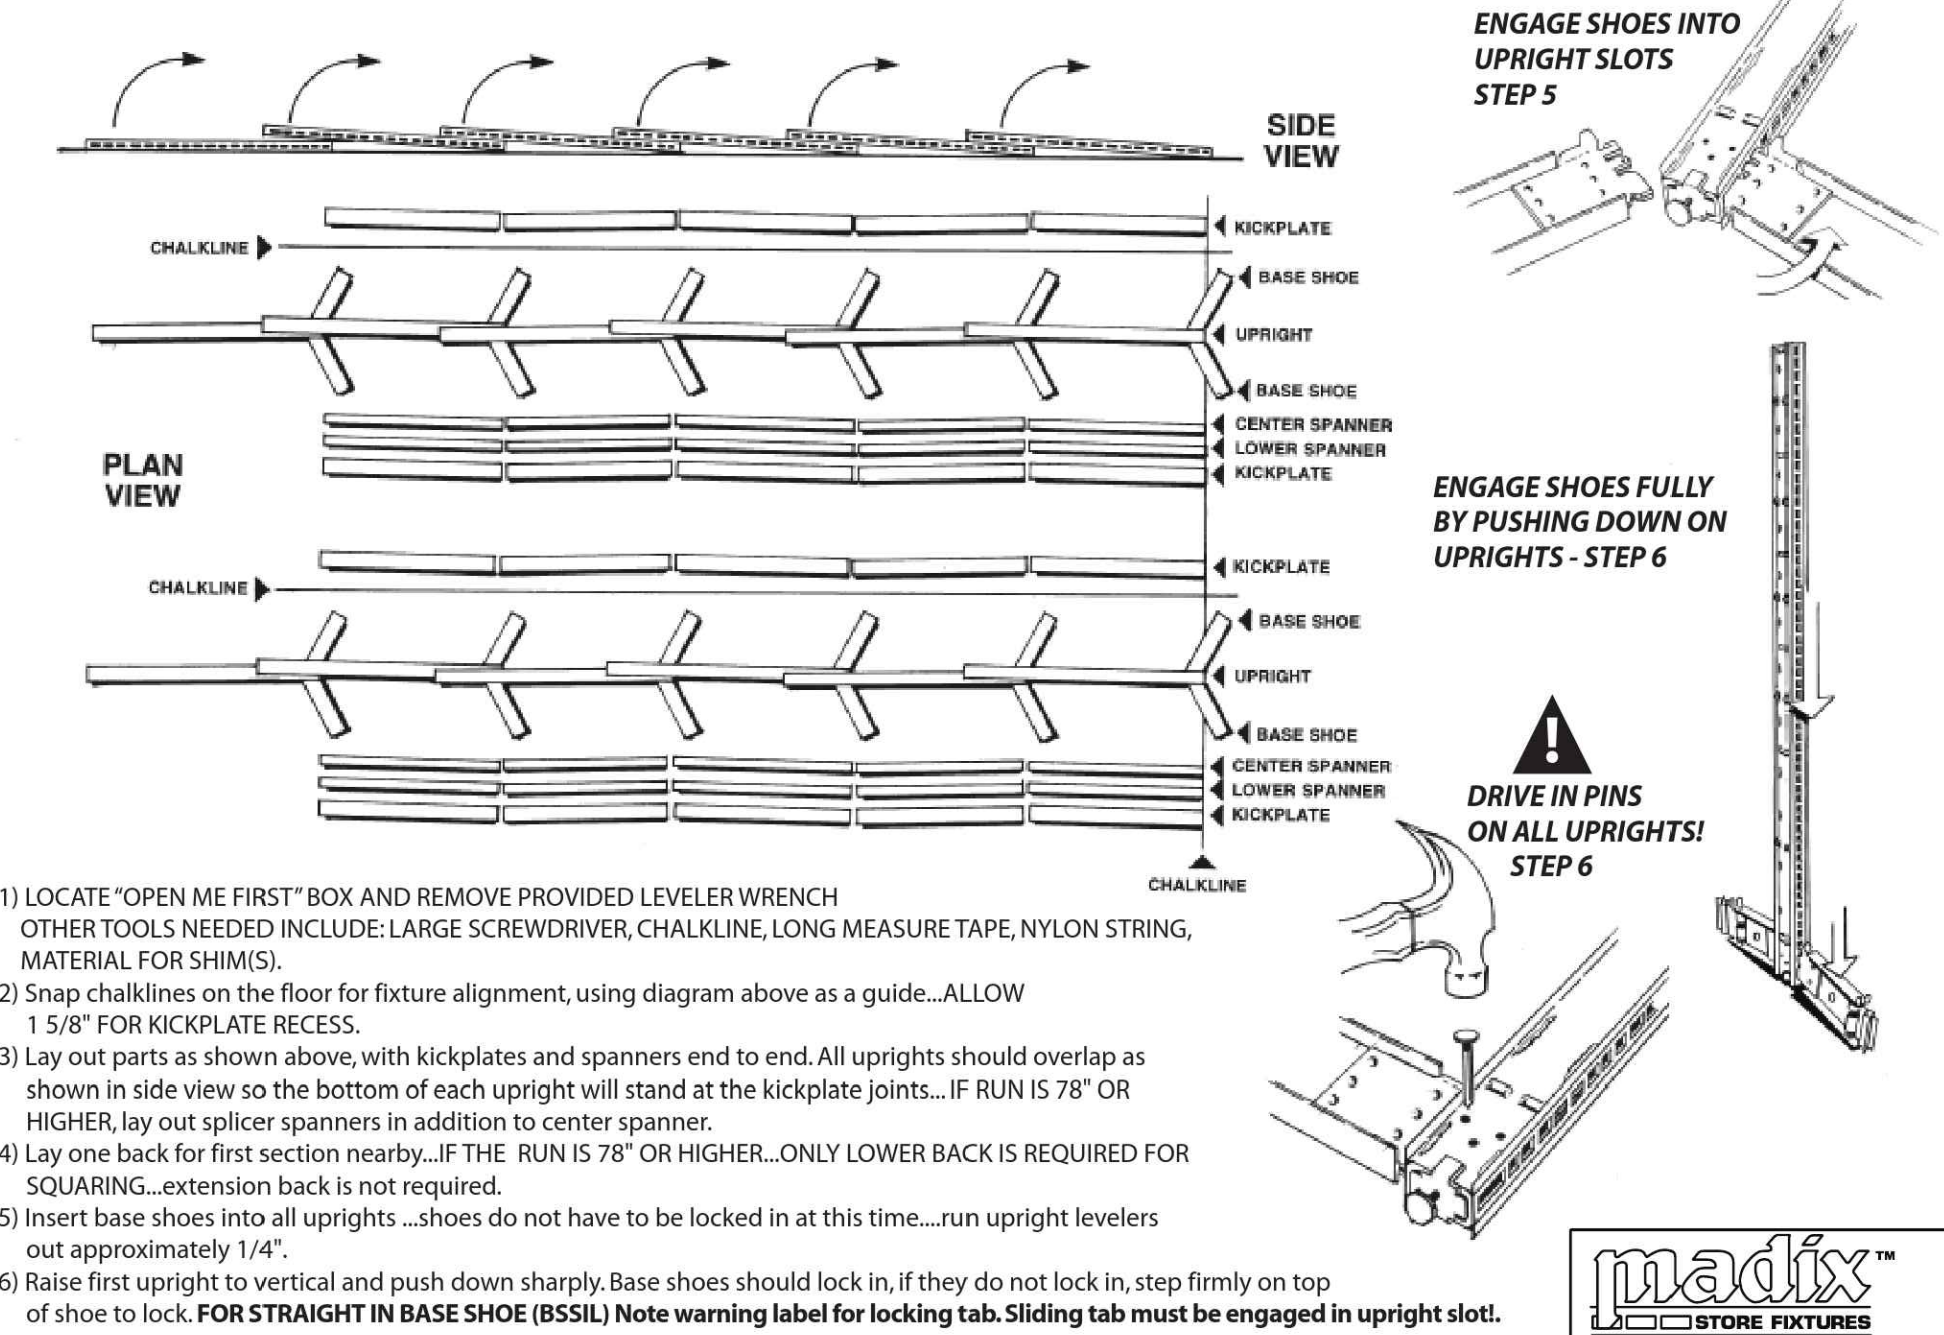


- LOCATE "OPEN ME FIRST" BOX AND REMOVE PROVIDED LEVELER WRENCH OTHER TOOLS NEEDED INCLUDE: LARGE SCREWDRIVER, CHALKLINE, LONG MEASURE TAPE, NYLON STRING, MATERIAL FOR SHIM(S).
- Snap chalklines on the floor for fixture alignment, using diagram above as a guide... ALLOW 1 5/8" FOR KICKPLATE RECESS.
- Lay out parts as shown above, with kickplates and spanners end to end. All uprights should overlap as shown in side view so the bottom of each upright will stand at the kickplate joints... IF RUN IS 78" OR HIGHER, lay out splicer spanners in addition to center spanner.
- Lay one back for first section nearby... IF THE RUN IS 78" OR HIGHER... ONLY LOWER BACK IS REQUIRED FOR SQUARING... extension back is not required.
- Insert base shoes into all uprights... shoes do not have to be locked in at this time... run upright levelers out approximately 1/4".
- Raise first upright to vertical and push down sharply. Base shoes should lock in, if they do not lock in, step firmly on top of shoe to lock. **FOR STRAIGHT IN BASE SHOE (BSSL) Note warning label for locking tab. Sliding tab must be engaged in upright slot.**

NOTE: ON ALL UPRIGHTS WITH BS-(ND) TYPE SHOE: lay upright on floor and drive WSRP pin through the upright and base shoe as shown... all uprights. Do not drive the WSRP pin until it is fully seated. Leave 1/8" to 1/4" gap between pin head and side panel of shoe!



ASSEMBLY PROCEDURE...

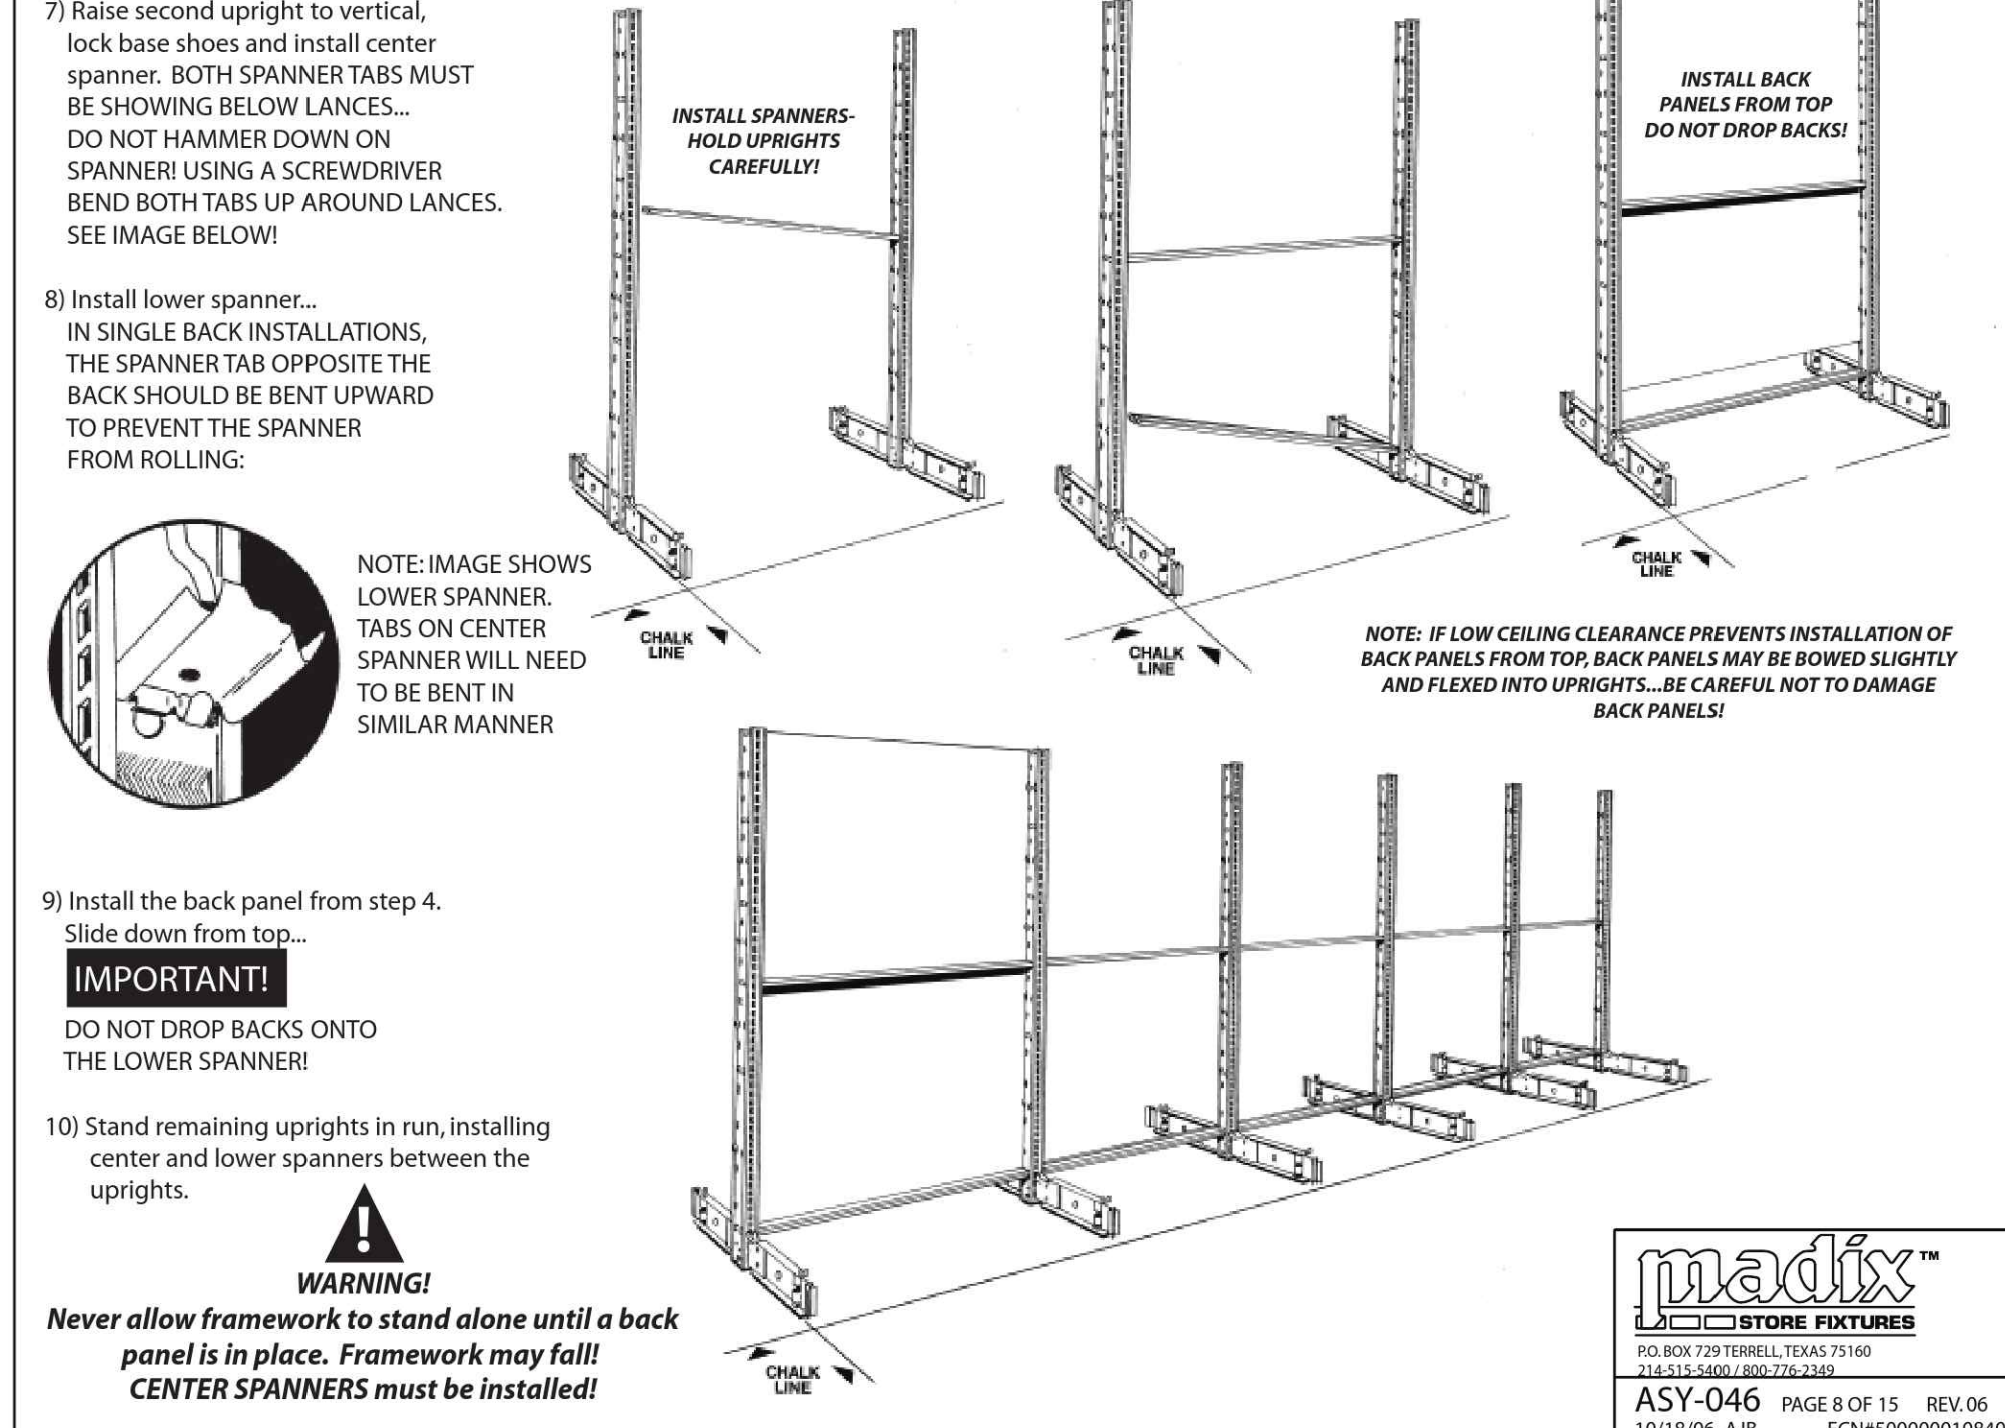

DO NOT SCALE THESE DRAWINGS

REVISIONS	
#	DATE
1	
2	
3	
4	
5	
6	
7	
8	
9	
10	

FIXTURE SPECIFICATIONS AND DETAILS

DATE 05/17/24

JOB NO. 23475

A1.5

SHEET NO.



05/17/24

ADA ARCHITECTS

Lakewood, Ohio 44107
17710 Detroit Avenue
Phone (216) 521-1534
Fax (216) 521-4824
www.adaarchitects.com

HARBOR FREIGHT

ERWIN, NC 28639
46 SHRUI LANE
THESE DOCUMENTS CONTAIN INFORMATION PROPRIETARY TO ADA ARCHITECTS, INC.
UNAUTHORIZED USE OF THESE DOCUMENTS IS EXPRESSLY PROHIBITED UNLESS AGREED UPON IN WRITING.

ASSEMBLY PROCEDURE...

- 11) Install all kickplates...kickplates snap directly in from front...
- 12) Pull both end uprights forward to bring the kickplates to the chalkline, then plumb using a level against face of upright and adjusting the base shoe levelers.
- 13) Attach the nylon line to end upright as shown. Attach line at corresponding slot on opposite end upright, draw taut and secure.
- 14) Examine all uprights at nylon line to determine the highest upright in run, excluding end uprights. Pull this highest upright forward until kickplate is on the chalkline. If run is a gondola, plumb at base shoe levelers...if run is a wall, plumb at upright and base shoe levelers.

IMPORTANT!
There must be enough clearance between the bottom of the upright and the head of the level leg to allow installation of anchors!

NOTE:
IF IT BECOMES NECESSARY TO EXTEND THE LEVELING LEGS BEYOND 1-1/2" SHIMS MUST BE USED TO RAISE THE FLOOR LEVEL.

STEP 11 KICKPLATES

SFA-RD REGULAR DUTY FLOOR ANCHOR, REQUIRES ONE (1) FASTNER TO FLOOR

SFA-HD REGULAR DUTY FLOOR ANCHOR, REQUIRES TWO (2) FASTNERS TO FLOOR

STEP 15 & 16

15) Working with the remaining uprights in succession, bring kickplates up to chalkline, then adjust for height at upright leveler and plumb at base shoes.

16) Raise or lower end uprights until slots on ends and highest upright correspond relative to the nylon line. THEN REPLUMB BOTH END UPRIGHTS!

WARNING! NEVER EXTEND LEVEL LEGS OVER 1 1/2"!

madix STORE FIXTURES
PO BOX 729 TERRELL TEXAS 75160
214-513-5460 / 800-776-2389
ASY-046 PAGE 9 OF 15 REV.06
10/18/06 AJB ECN#500000010840

ASSEMBLY PROCEDURE...

UC - STEP 20 STL-(NW) - STEP 19

UC UPRIGHT CAP UC - STEP 20

VC UPRIGHT COVER STEP 19

SBS BASE SHELF STEP 23

BS - STEP 21

UC UPRIGHT CAP

VC UPRIGHT COVER

TABS ON SPANNER WILL NEED TO HAVE TABS REST BEHIND TOP LANCE AS SHOWN

TABS ON CAP WILL GO INSIDE UPRIGHT AND SNAP TO INSIDE OF FIRST LANCE. ONCE IN PLACE CAP WILL NOT MOVE

...ONLY ON GONDOLA UPRIGHTS! NOT ON WALL UPRIGHT LEVELERS SEE STEP 17

WARNING!
DO NOT HANG SHELVING, PEG HOOKS OR OTHER ACCESSORIES THAT EXCEED THE DEPTH OF THE BASE ON A GONDOLA OR WALL.

IMPORTANT!
If trim or shelves do not fit or do not pass visual inspection, recheck plumb & level. If run is not plumb and level, return to steps 13 - 16.

IMPORTANT!
DO NOT DROP BACKS ONTO THE LOWER SPANNERS!

IMPORTANT!
On gondola uprights only: Run level legs up off the floor approximately 1/4". THIS APPLIES TO ALL GONDOLA UPRIGHTS REGARDLESS OF ANCHORING. ONLY BASE SHOE LEVELERS ARE ANCHORED ON GONDOLAS, NOT UPRIGHT LEVELERS.

17) On gondola uprights only: Run level legs up off the floor approximately 1/4". THIS APPLIES TO ALL GONDOLA UPRIGHTS REGARDLESS OF ANCHORING. ONLY BASE SHOE LEVELERS ARE ANCHORED ON GONDOLAS, NOT UPRIGHT LEVELERS.

18) Remove the nylon string used in leveling and install all remaining back panels in the run.

19) Install top spanners. Make sure tabs rest below first lance as shown. Install upright end covers. UEC is plastic and VC is metal. THESE MUST BE IN PLACE BEFORE UC (UPRIGHT CAPS) ARE INSTALLED.

20) If VCs (metal upright covers) are installed, install UC (upright caps) so that the short plastic extrusion is captured in the slot at top of the VC and tabs snap behind top lance See illustration top right.

21) To install the BECs (Base End Covers), simply slide them over the BS (Base Shoes). The BECs are held in place by the base shelves.

22) VERIFY ALIGNMENT AND LEVEL OF RUN. If floor anchors are required, install them now. SEE ASY-357 FOR PROPER ANCHORING PROCEDURES.

23) Install base shelves. Visually check base shelf alignment.

24) Install upper shelves and accessories.

madix STORE FIXTURES
PO BOX 729 TERRELL TEXAS 75160
214-513-5460 / 800-776-2389
ASY-046 PAGE 10 OF 15 REV.06
10/18/06 AJB ECN#500000010840

WALL RUN INSTALLATION AND WALL RUN ANCHORING...

Uprights will be anchored to a single run of 2 x 4 furring strips secured at approximately 8" below the top of the uprights, subject to leveling.

*Determine run length and location...then strike a chalkline on the wall at upright height, minus 8", to align the top edge of the furring strips.

*Start with a 10' long 2 x 4, finishing the rest of run with 8' long 2 x 4's, this insures that uprights will not be on a joint

IMPORTANT!
IF CANOPY IS TO BE USED, CONSULT INSTALLATION INSTRUCTION ASY 092 PRIOR TO PROCEEDING

WARNING!
FAILURE TO PROPERLY ANCHOR WALL FIXTURE SYSTEMS AND EXTENSIONS MAY RESULT IN SEVERE INJURY OR DEATH!
USE ANCHORING HARDWARE THAT RESISTS A MINIMUM OF 800 lbs PULL OUT FORCE.
MANY TYPES OF WALL CONSTRUCTION WILL BE ENCOUNTERED. USE FASTNERS APPROPRIATE FOR BOTH WALL TYPE AND LOAD SITUATION.
CONTACT A LOCAL STRUCTURAL ENGINEER FAMILIAR WITH CODES IN YOUR AREA. MADIX CAN PROVIDE THE CONTACT FOR A STRUCTURAL ENGINEER IF REQUIRED.

BUWMS

Installation of wall fixture follows same procedure as the gondola instructions, steps 1 through 11, EXCEPT:

*No chalkline is necessary...set back of uprights approximately 1" away from furring strips.

*If using basic upright wall mount support, BUWMS, install in rear side of upright in 10th slot from top.

Push fixture back against furring strips and proceed with plumb and level steps 12 through 16, visually sighting kickplate alignment.

*If using BUWMS wall mount support, secure to furring strips with appropriate hardware, shimming behind the BUWMS as necessary.

*If not using BUWMS, secure upright to furring strip with appropriate fasteners into 10th slot from top.

Complete steps 17 through 21.

*If base shelves have a wedge shaped gap, it will be necessary to push in at the gap and/or pull out at the adjacent joints...readjustment of the base shoe levelers may be necessary.

ALTERNATE METHOD... Follow instructions above, except, (1) Strike the chalkline on wall at upright height, minus 2"...this line is to mark anchor locations furring strips will be slightly lower. (2) Omit use of BUWMS or fasteners. (3) Cut 2 x 4's to section lengths...46 1/2" for 4', 34 1/2" for 3'. (4) Set 2 x 4 on second spanner lance from top of upright and secure to the wall using the appropriate fasteners for wall type and load situations.

madix STORE FIXTURES
PO BOX 729 TERRELL TEXAS 75160
214-513-5460 / 800-776-2389
ASY-046 PAGE 11 OF 15 REV.06
10/18/06 AJB ECN#500000010840

FIXTURE LOADING AND PRODUCT SAFETY...

GENERAL

- 1) Contact the local building department prior to starting installation to check on any restrictions.
- 2) Only parts and accessories produced or supplied by Madix are covered by Madix warranty.
- 3) Installation sequence must be followed exactly for assembly and leveling.
- 4) Under no circumstances should damaged parts be used.
- 5) Do not use shelving parts or accessories for any purpose other than originally intended.
- 6) Installation instructions with product load ratings are included with each order and must be followed carefully.
- 7) Employees must be made aware of possible overloading as specified in load ratings. If you do not receive these, please contact your sales or customer service representative.
- 8) Initial installation or relocation of Madix gondola or wall fixtures should be supervised exclusively by qualified personnel.

GONDOLA / WALL SHELVING

- 9) Never install shelves or accessories into the side of an upright that has no base shoes on that side.
- 10) Be sure all shelving parts or accessories are completely seated in slotting or perforations.
- 11) Do not permit climbing or standing on shelving at any time...including base shelves.
- 12) Do not attempt to relocate merchandised shelves or accessories.
- 13) Never try to move completed fixtures, especially if merchandised.
- 14) No shelves or accessories should project past the front of the base shelf.
- 15) Base end covers and upright end covers must always be installed at the end of a run.
- 16) To avoid collisions with upper shelves or accessories, all displays used on gondola ends should have a base shelf, metal end flat, or other base end treatment.

WARNING!
ALL CAPACITIES ARE FOR EVENLY DISTRIBUTED LOAD.

IMPORTANT!
CAPACITIES ARE REDUCED BY 30% WHEN ONLY THE FRONT HALF OF THE SHELF IS LOADED!

WARNING!
CAPACITIES LISTED ARE FOR SHELVES INSTALLED IN MADIX MAXI SHELVING SYSTEM ONLY!

madix STORE FIXTURES
PO BOX 729 TERRELL TEXAS 75160
214-513-5460 / 800-776-2389
ASY-046 PAGE 12 OF 15 REV.06
10/18/06 AJB ECN#500000010840

Shelf Type	Shelf Depth	MAXIMUM LOAD CAPACITY* IN POUNDS			
		Evenly Loaded	Front Loaded	15° Down	30° Down
SUS-□□□	6" - 8"	300#	300#	125#	100#
□	8" - 18"	500#	300#	125#	100#
□	20" - 24"	500#	300#	250#	100#
□	28" - 30"	400#	250#	200#	100#
SIP-□□□	6" - 8"	300#	300#	280#	100#
□	10" - 18"	500#	380#	280#	100#
□	20" - 24"	500#	350#	250#	100#
□	28" - 30"	400#	250#	200#	100#
HUS-□□□	6" - 18"	600#	n/a	n/a	n/a
□	20" - 24"	600#	n/a	n/a	n/a
SBS-□□□	12" - 20"	600#	n/a	n/a	n/a
□	12" - 30"	600#	n/a	n/a	n/a

* Based on evenly distributed static loading
* SIP type shelves are "straight fit", horizontal insertion into upright slotting

DO NOT SCALE THESE DRAWINGS

REVISIONS

#	DATE	TYPE
1		
2		
3		
4		
5		
6		
7		
8		
9		
10		

FIXTURE SPECIFICATIONS AND DETAILS

DATE 05/17/24
JOB NO. 23475
A1.6
SHEET NO.


FIXTURE LOADING - PRODUCT SAFETY

WARNING! DO NOT EXCEED ANY OF THE MAXIMUM LOAD LIMITS IN THE FOLLOWING SECTIONS!

FRONT LOADED SHELVES

IMPORTANT! Front loaded shelves create the most likely situation for exceeding the fixture loading capacities. Compare the increases in inch/lb. loadings of front loaded shelves over evenly loaded shelves, PARTICULARLY ON WALL SECTIONS!

A front loaded shelf has a void between the back panel and the merchandise. Take one half the loaded area dimension plus the gap dimension at back and multiply times the weight on the shelf in order to determine individual inch/lb. load.

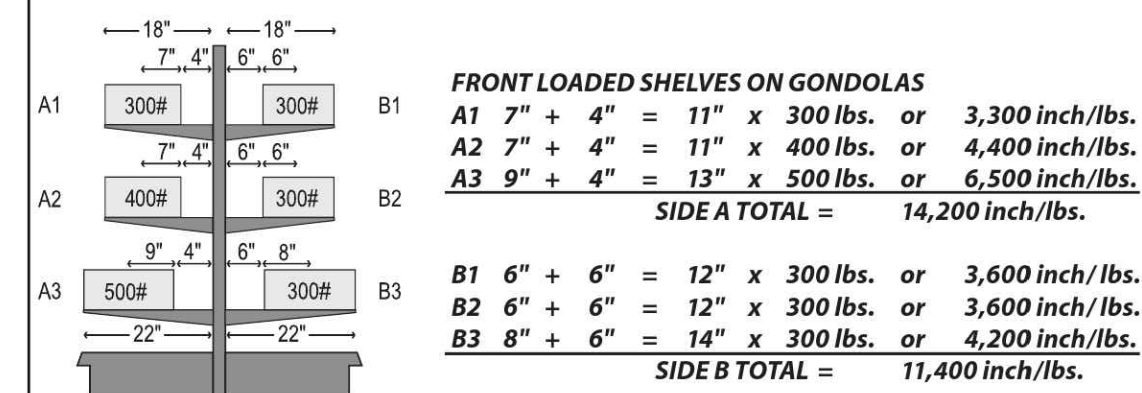


SUBTRACT B FROM A:
 14,200 inch/lbs
 -11,400 inch/lbs
2,800 inch/lbs


SAFE - 2,800 INCH/LBS
DOES NOT EXCEED
15,000 INCH/LBS
MAXIMUM

COLUMN LOADING

Column loading is the vertical load, measured in pounds, that can be applied on any upright. Each upright bears ONE HALF OF THE LOAD OF EACH SHELF THAT IT SUPPORTS. MAXIMUM COLUMN LOAD IS 4,500 POUNDS, DO NOT EXCEED!

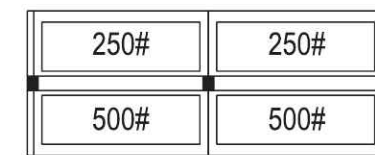

750 lbs. plus 750 lbs. = 1500 lbs.
 1500 lbs. divided by 2 =
 750 lb. column load on the center upright

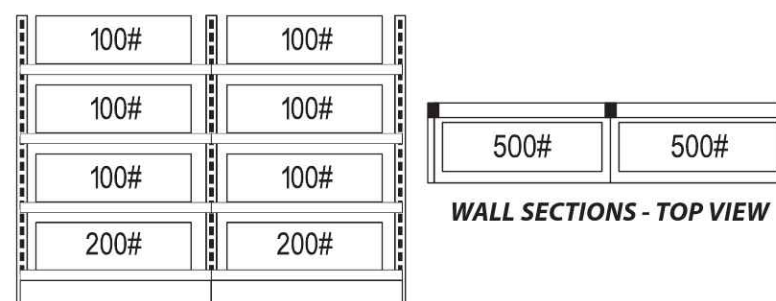

WALL SECTIONS - FRONT VIEW
 500 lbs. plus 500 lbs. = 1000 lbs.
 1000 lbs. divided by 2 =
 500 lb. column load on the center upright



PO BOX 729 TERRELL TEXAS 75160
 214-535-5495 / 800-778-2489
ASY-046 PAGE 13 OF 15 REV.06
 10/18/06 AJB ECN#500000010840

FIXTURE LOADING - PRODUCT SAFETY

WARNING! DO NOT EXCEED ANY OF THE MAXIMUM LOAD LIMITS IN THE FOLLOWING SECTIONS!

OFFSET LOADING


Offset loading is measured in inch/pounds and represents the bending load at the base shoe connection and the upright. To determine if you exceed the load limit of the fixture, take the difference between the larger inch/lb. calculations on one side of the fixture and the inch /lb. calculations on the other. THIS DIFFERENCE CANNOT EXCEED 15,000 INCH/LBS. In the case of wall sections, the calculation for the one side CANNOT EXCEED 15,000 INCH/LBS.

EVENLY LOADED SHELVES ON GONDOLAS

Divide each shelf depth by 2...multiply times the weight on shelf to determine individual shelf load.

D1 18" / 2 = 9" x 300 lbs. or 2,700 inch/lbs.
 D2 18" / 2 = 9" x 400 lbs. or 3,600 inch/lbs.
 D3 22" / 2 = 11" x 500 lbs. or 5,500 inch/lbs.
SIDE D TOTAL = 11,800 inch/lbs.

E1 18" / 2 = 9" x 300 lbs. or 2,700 inch/lbs.
 E2 18" / 2 = 9" x 300 lbs. or 2,700 inch/lbs.
 E3 18" / 2 = 11" x 300 lbs. or 3,300 inch/lbs.
SIDE E TOTAL = 8,700 inch/lbs.

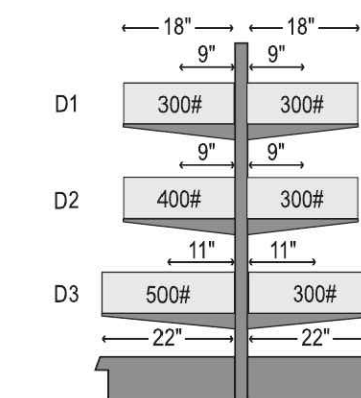


SUBTRACT E FROM D 11,800 inch/lbs.
 - 8,700 inch/lbs.
3,100 inch/lbs.

SAFE! 3,100 INCH/LBS. DOES NOT
EXCEED 15,000 INCH/LBS. MAXIMUM

EVENLY LOADED SHELVES ON WALL SECTIONS

Divide each shelf depth by 2...multiply times the weight on shelf to determine individual shelf load.

F1 18" / 2 = 9" x 300 lbs. or 2,700 inch/lbs.
 F2 18" / 2 = 9" x 400 lbs. or 3,600 inch/lbs.
 F3 22" / 2 = 11" x 500 lbs. or 5,500 inch/lbs.
SIDE F TOTAL = 11,800 inch/lbs.

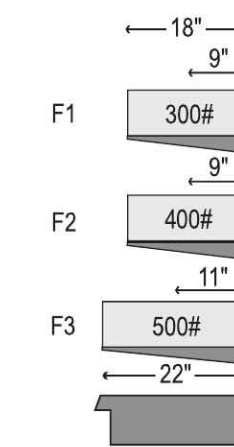

SAFE! 11,800 INCH/LBS. DOES NOT EXCEED
5,000 INCH/LBS. MAXIMUM



PO BOX 729 TERRELL TEXAS 75160
 214-535-5495 / 800-778-2489
ASY-046 PAGE 14 OF 15 REV.06
 10/18/06 AJB ECN#500000010840

POST THIS ENTIRE PAGE IN A CONSPICUOUS PLACE, CLEARLY VISIBLE TO ALL STORE PERSONNEL

RE-LEVELING OF OFFSET LOADED FIXTURES

AFTER THE FIXTURE IS LOADED, IF A GAPPING OF THE SHELVES APPEARS ON THE HEAVILY LOADED SIDE, IT IS POSSIBLE THE ORIGINAL INSTALLATION IS THE CAUSE. CHECK THESE TWO CONDITIONS BEFORE PROCEEDING!
CAUTION! BEFORE MAKING ANY ADJUSTMENTS TO ANY COMPONENTS BE SURE THAT ALL MERCHANDISE HAS BEEN REMOVED.

- ALL UPRIGHTS MUST BE AT THE SAME HEIGHT!
 - Visually sight across the top of the fixture to check for high or low uprights.
 - If a row of shelves at a particular upright appear to rise or sag at this indicates an unlevel section TO CORRECT: Pull a string across the top of the uprights from end to end.
 - IF THE UPRIGHT IS TOO LOW on lightly loaded section...
 - Raise base shoe levelers on each side equally until upright touches stringline.
 - IF UPRIGHT IS TOO HIGH on lightly loaded section...
 - Remove kickplates on both sides of the low upright.
 - Screw upright leveler out, or down, raising the top upright until it touches stringline.
 - Screw base shoe levelers down an equal number of turns until base shoes lock up against the upright.
 - IF UPRIGHT IS TOO HIGH on heavily loaded section...
 - Remove kickplates on both sides of the high upright.
 - Screw upright leveler up into upright, this may solve the "too high" problem, if not...
 - Screw loose shoe levelers up into shoe an equal number of turns until top of upright touches stringline.
- NONE OF THE SECTIONS IN THE RUN HAVE BEEN MOVED OUT OF ALIGNMENT
 - Visually sight along the front of the base shelves.
 - Compare the front of the base shelves to a tile line. TO CORRECT: Facing the wedge shaped gap areas, physically push the section back into line, closing the gaps. Depending on the merchandise, it may be necessary to unload or partially unload the section before moving. Attempt to move the section by applying foot pressure at the kickplate joint only... if not possible,
 - Place a 2 x 4 block against the kickplate joint and tap back into alignment...or...
 - Use a jack and 2 x 4 block against kickplate joint...jack should be braced across the aisle against a long 2 x 4 spanning several kickplate joints.

IF THE ABOVE CONDITIONS ARE NOW CORRECT, look for shelf gaps on the heavily loaded side...the base shelf joint will be tight, but the upper shelves will have increasingly larger wedge shape gaps at the top, REMOVE KICKPLATES ON BOTH SIDES FOR AT LEAST ONE SECTION ON EITHER SIDE OF THE HEAVILY LOADED SECTION.

- ON THE LIGHTLY LOADED SIDE,
 - Run upright levelers down to the floor.
 - Run base shoe leveler up into shoe until the pressure is off of it...1/4" free movement.
- THEN...ON THE HEAVILY LOADED SIDE,
 - Begin at the first heavily loaded upright TO YOUR RIGHT, facing the heavily loaded side...run the base shoe leveler down until all the shelf gaps at that upright close tightly.
 - Repeat c. with remaining heavily loaded uprights, WORKING TO YOUR LEFT.
- THEN...ON THE LIGHTLY LOADED SIDE,
 - Run loose levelers down until shoe locks up against the upright.
 - Replace kickplates on both sides.


CAUTION!
CARE SHOULD BE TAKEN TO AVOID
ACCIDENTS / INJURY WHILE
ADJUSTING MERCHANDISED
FIXTURES!

CAUTION!
DO NOT MOVE LOADED FIXTURES
ALWAYS REMOVE MERCHANDISE
TO MOVE ANY FIXTURE.

DO NOT ATTEMPT TO
ADJUST FIXTURES THAT ARE
ALREADY ANCHORED



PO BOX 729 TERRELL TEXAS 75160
 214-535-5495 / 800-778-2489
ASY-046 PAGE 15 OF 15 REV.06
 10/18/06 AJB ECN#500000010840

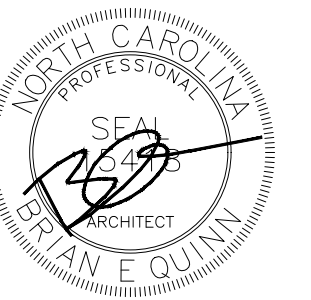

05/17/24

ADA ARCHITECTS

Lakewood, Ohio 44107
 17710 Detroit Avenue
 Phone (216) 521-5134 Fax (216) 521-14824
 www.adaarchitects.com

HARBOR FREIGHT

ERWIN, NC 28639
 46 SHRUI LANE

THESE DOCUMENTS CONTAIN INFORMATION PROPRIETARY TO ADA ARCHITECTS, INC.
 UNAUTHORIZED USE OF THESE DOCUMENTS IS EXPRESSLY PROHIBITED UNLESS AGREED UPON IN WRITING.

DO NOT SCALE THESE DRAWINGS

REVISIONS	
#	DATE
1	
2	
3	
4	
5	
6	
7	
8	
9	
10	

TYPE

DATE

FIXTURE SPECIFICATIONS AND DETAILS

DATE 05/17/24

JOB NO. 23475


A1.7

SHEET NO.

WIDE SPAN SHELVING ASY 061

PAGE 1 OF 10

INSTALLATION INSTRUCTIONS

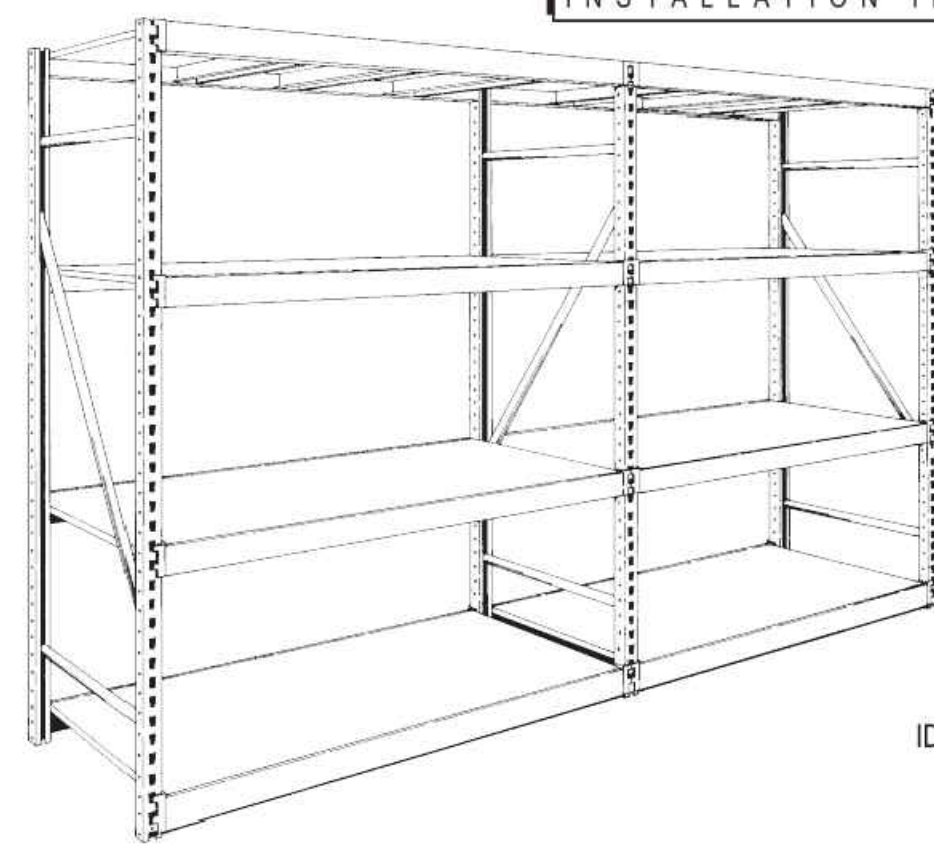

PAGE 2-3
PARTS
IDENTIFICATION

PAGE 4-5
BASIC
INSTALLATION


PAGE 6-7
INSTALLATION OF
EXTRAS

PAGE 8
LOAD
CAPACITY

PAGE 9
SAFETY

PAGE 10
ANCHORING
TO
FLOOR

NOTE!
This publication is intended to be a generic installation instruction for Madix Wide Span, and may possibly be subject to change as required by local building codes...consult the building inspection department at job site.

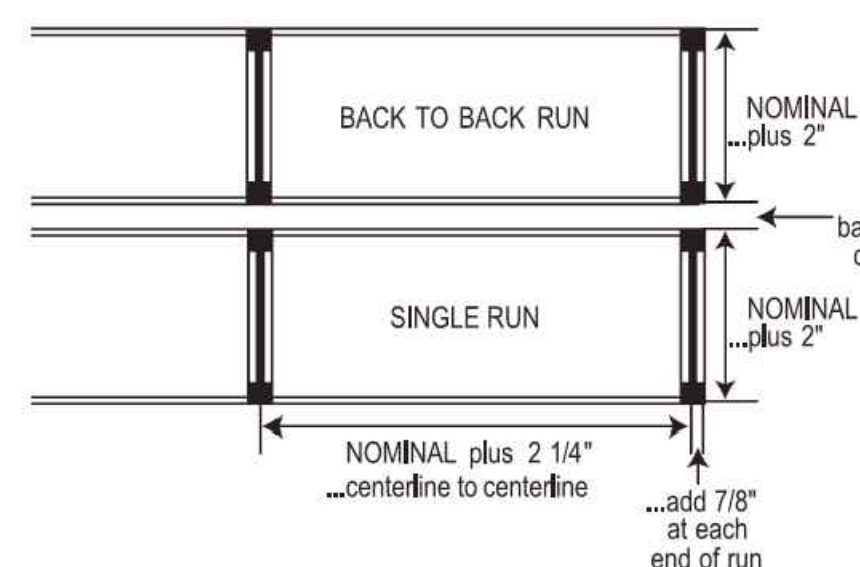



P.O. BOX 729 / TERRELL, TEXAS 75160 / 972.563.6744 / 800.776.2349
P.O. BOX 177 / GOODWATER, ALABAMA 36072 / 206.839.6364 / 800.633.6282



WIDE SPAN SHELVING ASY 061

PAGE 2 OF 10

PARTS IDENTIFICATION

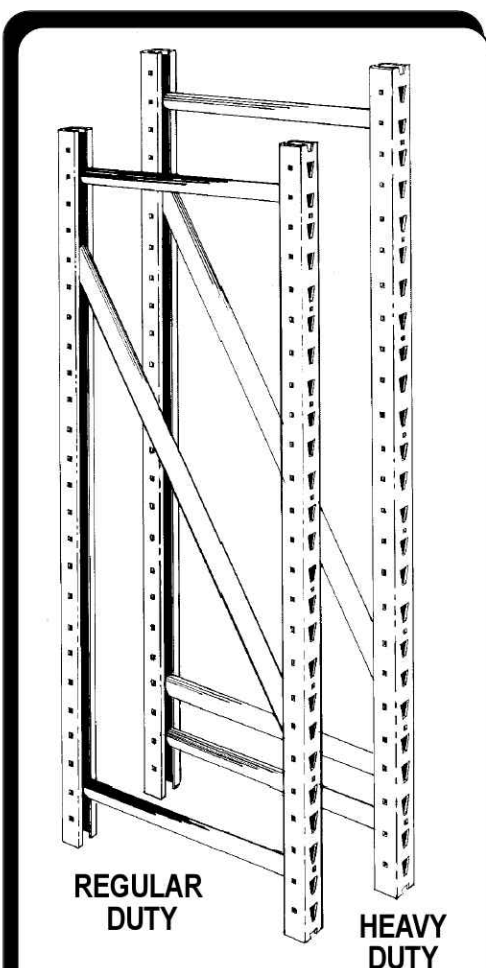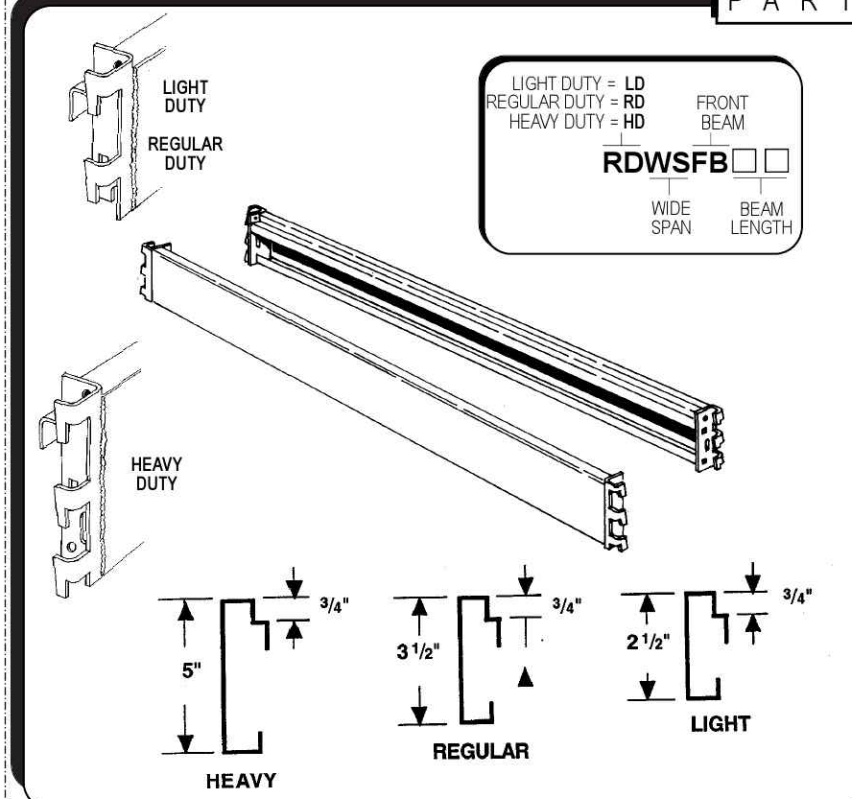

DIMENSIONS	
Deck Supports	Beams
Frame Depth	Actual Length Inside of Brackets
18"	20"
24"	26"
30"	32"
36"	38"
42"	44"
48"	50"

FRAME DIMENSIONS			
Frame Depth	Actual Depth	Frame Height	Actual Height
18"	17 3/4"	48"	48"
24"	23 3/4"	60"	60"
30"	29 3/4"	72"	72"
36"	35 3/4"	84"	84"
42"	41 3/4"	96"	96"
48"	47 3/4"	108"	108"
-	-	120"	120"




P.O. BOX 729 / TERRELL, TEXAS 75160 / 972.563.6744 / 800.776.2349
P.O. BOX 177 / GOODWATER, ALABAMA 36072 / 206.839.6364 / 800.633.6282




WIDE SPAN SHELVING ASY 061

PAGE 3 OF 10

PARTS IDENTIFICATION

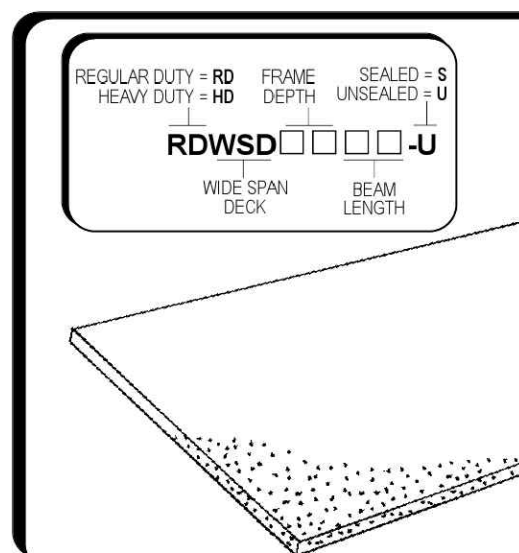

PARTICLE BOARD DECKS			
Frame Depth	Actual Depth	Beam Length	Actual Length
18"	18"	48"	47 29/32"
24"	23 29/32"	60"	60"
30"	30"	72"	72"
36"	36"	84"	84"
42"	42"	96"	96"
48"	48"	-	-

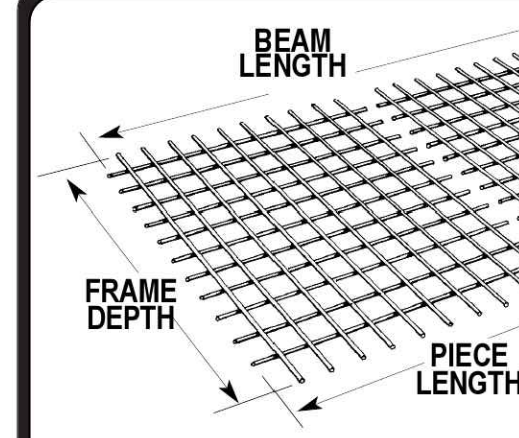

WIRE GRID DECKS, and FLOW THROUGH DECKS			
Frame Depth	Actual Depth	Piece Length	Actual Length
18"	17 3/4"	24"	23 3/4"
24"	23 3/4"	36"	35 3/4"
30"	29 3/4"	48"	47 3/4"
36"	35 3/4"	-	-
42"	41 3/4"	-	-
48"	47 3/4"	-	-

WIRE GRID and FLOW THROUGH PIECE LENGTHS RUN PARALLEL TO BEAM LENGTHS			
BEAM LENGTH	PIECE LENGTHS	# OF DECK SUPPORTS	OF DECK
36"	36"	2	2
48"	48"	2	2
60"	24" plus 36"	4	4
72"	36" plus 36"	4	4
84"	36" plus 48"	4	4
96"	48" plus 48"	4	4



P.O. BOX 729 / TERRELL, TEXAS 75160 / 972.563.6744 / 800.776.2349
P.O. BOX 177 / GOODWATER, ALABAMA 36072 / 206.839.6364 / 800.633.6282




WIDE SPAN SHELVING ASY 061

PAGE 4 OF 10

BASIC INSTALLATION

- 1 Snap chalklines on floor as shown for shelving layout. See diagram on page one for dimensions.
- 2 Raise first frame to vertical position and install first beam... frame will now stand alone.
NOTE! If floor anchors or extension frames are to be used, they should be installed prior to raising frames to the vertical position... see pages 5-6.
- 3 Raise second frame to vertical and install free end of first beam... install second beam on opposite side.
- 4 Install upper beams at designated levels.
- 5 **If using Dart Clips:** Press dart clips through beam bracket and upright on under side of beam as shown. Insert one dart clip at each end of all beams.
If using Retainer Pins: Insert one leg of a retainer pin through beam bracket and upright. Insert one pin at each end of all beams.

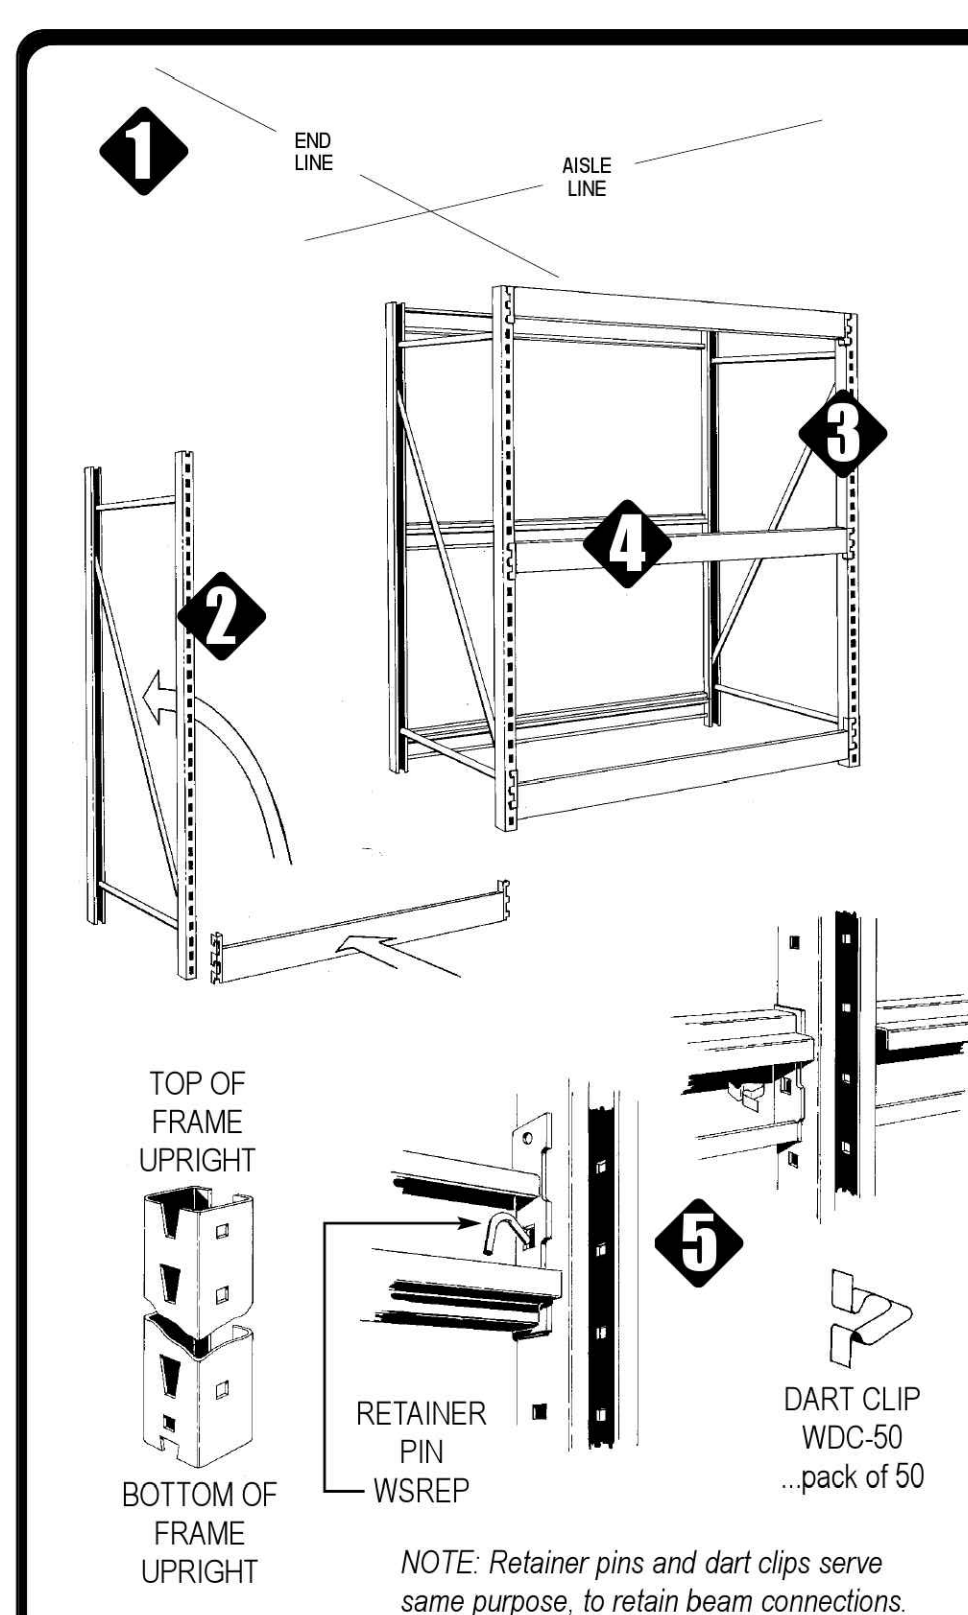

P.O. BOX 729 / TERRELL, TEXAS 75160 / 972.563.6744 / 800.776.2349
P.O. BOX 177 / GOODWATER, ALABAMA 36072 / 206.839.6364 / 800.633.6282




WIDE SPAN SHELVING ASY 061

PAGE 5 OF 10

BASIC INSTALLATION

- 6 Repeat assembly sequence with remaining frames, beams and dart clips/retainer pins.
NOTE! If back to back runs are being installed, see page 6 for back to back connectors.
- 7 Holding the deck support at an angle to the beam, squeeze the open side and insert into the beam, then swing the free end around to the opposite beam, squeeze the open side and insert into the beam.
- 8 Squeeze the open side of the deck support at each end just inside the beam and rotate upwards as shown.
- 9 Correct installed position will look like this... see above for quantity of deck supports per beam length.
- 10 Repeat with the remaining deck supports in the shelving run.
- 11 Install all decks in the shelving run.

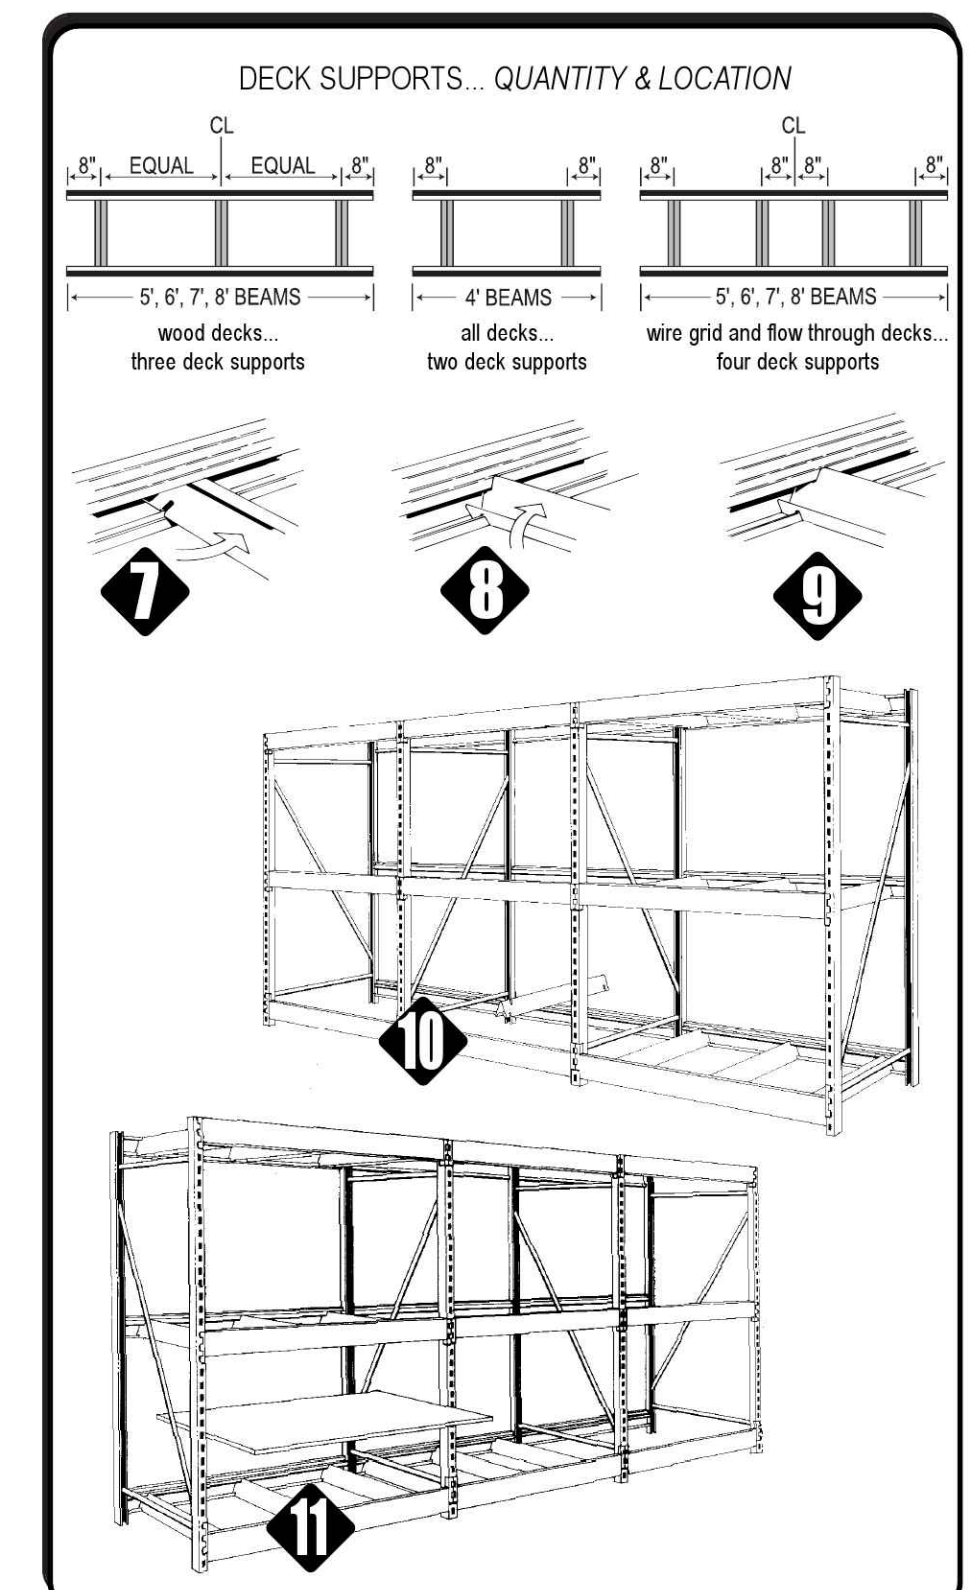

P.O. BOX 729 / TERRELL, TEXAS 75160 / 972.563.6744 / 800.776.2349
P.O. BOX 177 / GOODWATER, ALABAMA 36072 / 206.839.6364 / 800.633.6282




WIDE SPAN SHELVING ASY 061

PAGE 6 OF 10

INSTALLATION OF EXTRAS

- 12 The first sections of the back to back run should be erected with beams at top and bottom of the four frames. Locate the connectors just below the top beams and just above the bottom beams. Secure with the fasteners as shown.
- 13 Repeat with the remaining sections.
- 14 Install all intermediate beams as required, then install a third connector as close as possible to the mid-point of the frames. Complete the shelving run with the deck supports and decks.
- 15 In the sixth square hole from the top of the lower frame, insert a stop to prevent the connector from dropping to the floor.
- 16 Insert connector into frame with flat center of connector facing the slotting.
- 17 Screw connector to lower frame with provided fasteners... remove the stop.
- 18 Repeat above with the 2nd upright of the frame.
- 19 Lower upper frame onto connectors and secure through the sixth hole up from the joint.

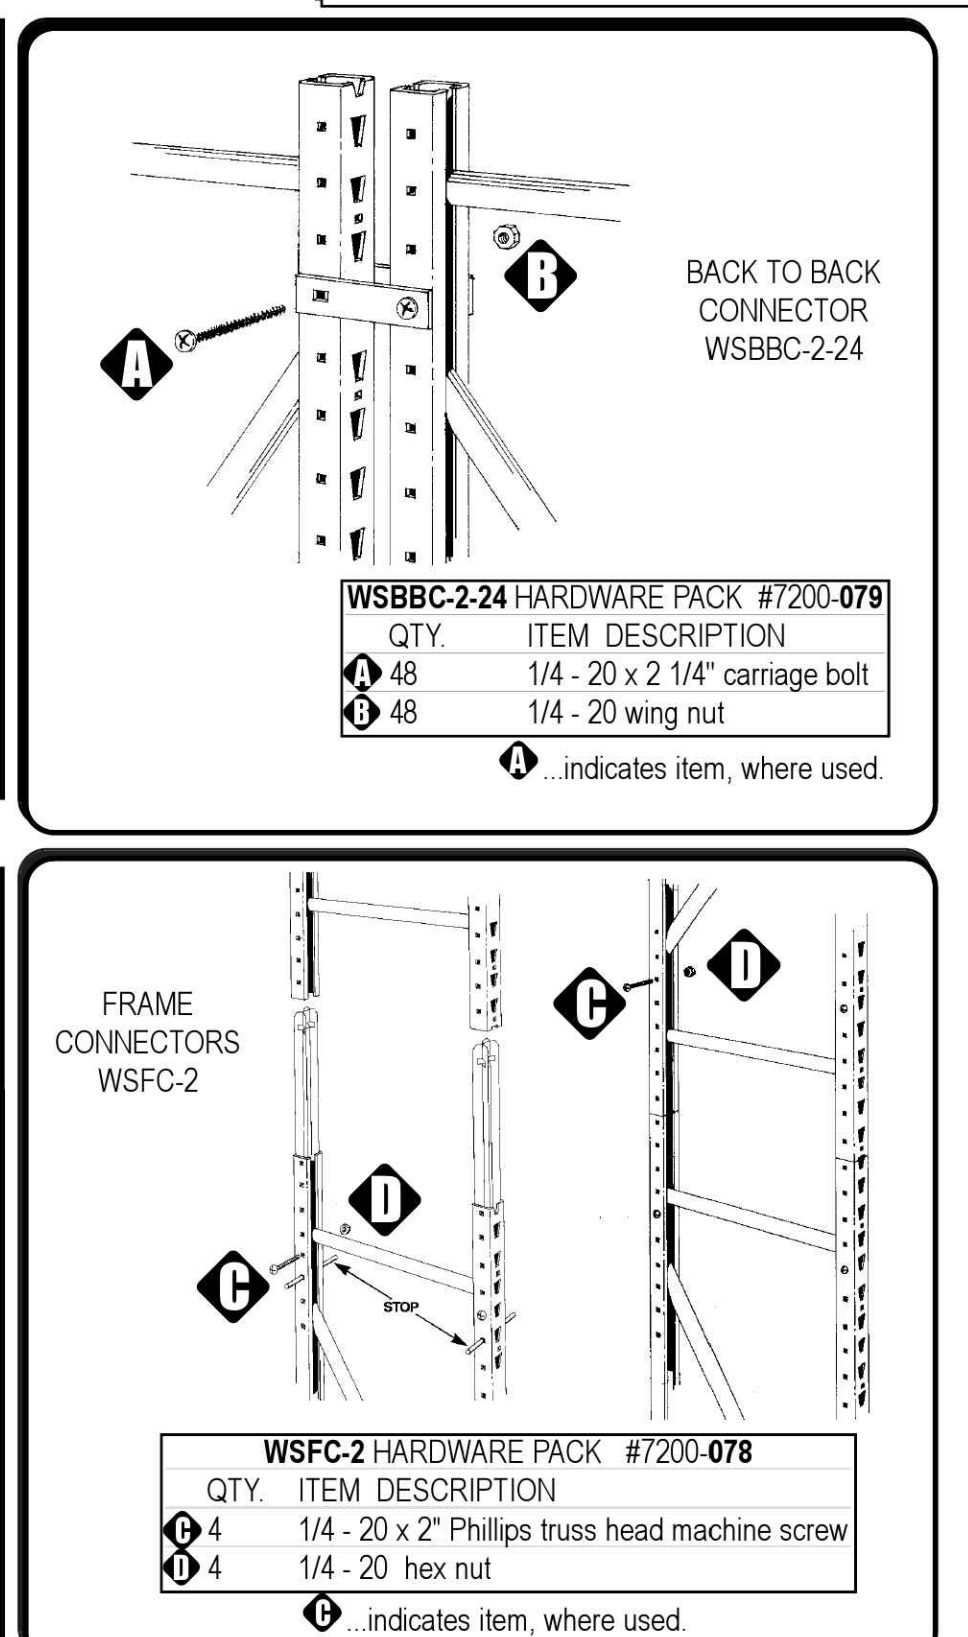

P.O. BOX 729 / TERRELL, TEXAS 75160 / 972.563.6744 / 800.776.2349
P.O. BOX 177 / GOODWATER, ALABAMA 36072 / 206.839.6364 / 800.633.6282



DO NOT SCALE THESE DRAWINGS



05/17/24

ADA ARCHITECTS

Lakewood, Ohio 44107
17710 Detroit Avenue
Phone (216) 521-1534
Fax (216) 521-4824
www.adaarchitects.com

HARBOR FREIGHT

ERWIN, NC 28839
46 SHRUI LANE

THESE DOCUMENTS CONTAIN INFORMATION PROPRIETARY TO ADA ARCHITECTS, INC.
UNAUTHORIZED USE OF THESE DOCUMENTS IS EXPRESSLY PROHIBITED UNLESS AGREED UPON IN WRITING.

REVISIONS									
#	DATE	TYPE							
1									
2									
3									
4									
5									
6									
7									
8									
9									
10									

FIXTURE SPECIFICATIONS AND DETAILS

DATE 05/17/24
JOB NO. 23475

A1.8

SHEET NO.

WIDE SPAN SHELVING ASY 061

PAGE 7 OF 10



FLOOR ANCHOR WSFA-2 INSTALLATION OF EXTRAS

NOTE! IF FRAME HEIGHT, OR TOTAL HEIGHT OF CONNECTED FRAMES, IS MORE THAN SIX TIMES THE FRAME DEPTH...FRAMES MUST BE SECURED WITH FLOOR ANCHORS.


20 Insert floor anchors into the bottom of each frame. They will only insert at 45° to the frame. Make sure that anchors are inserted so that they will not project into aisles or cross aisles.

21 Follow directions on page 4 to step 6, except do not install dart clips on bottom beams. Secure beams to frames through the floor anchor as shown. The screw will go through at one of the two locations, depending on the beam size.


22 Check run alignment to chalkline prior to drilling floor for expansion bolts. Due to varying floor conditions, expansion bolts must be ordered separately. If they were not ordered initially, but are required, see page 8 to order from Madix or purchase locally.

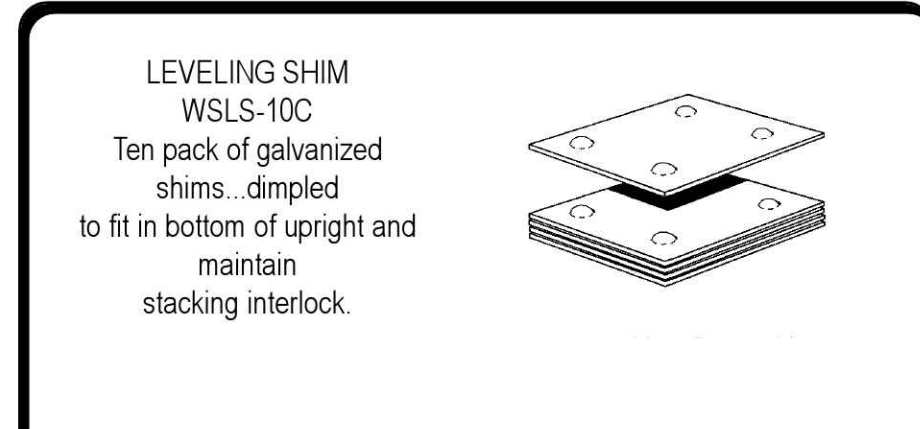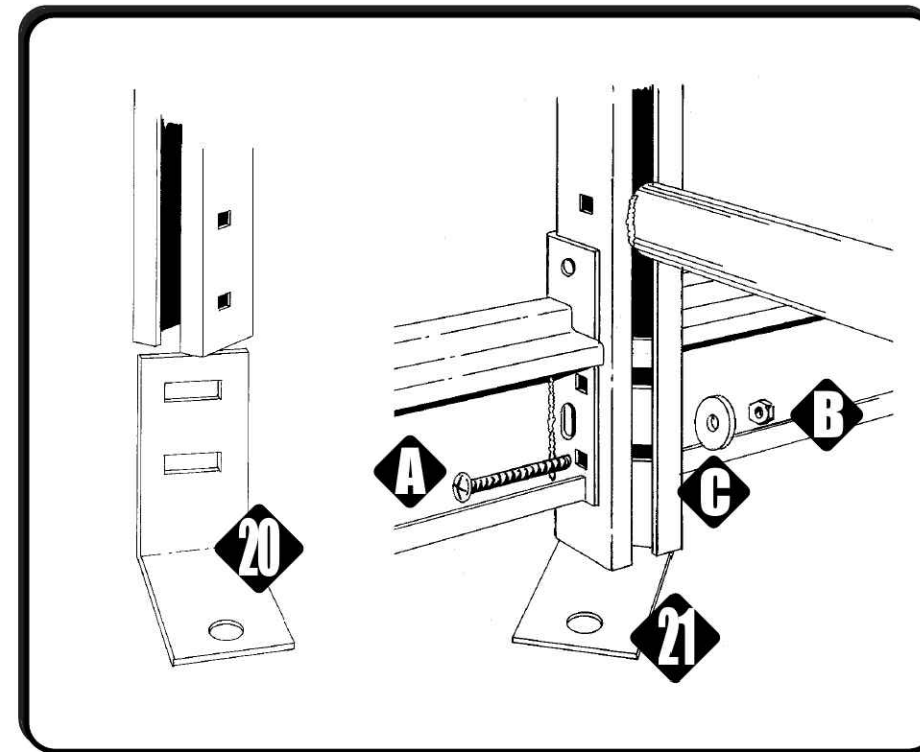

LEVELING SHIM WSL-10C
Ten pack of galvanized shims...dimpled to fit in bottom of upright and maintain stacking interlock.

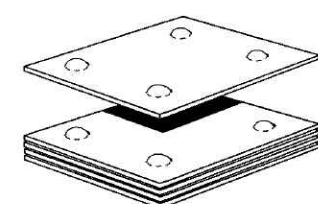

TOP CAP WSTC - □-CL
Packs of 4 or 48 clear plastic top caps, two per frame. Tap into top of each frame upright.

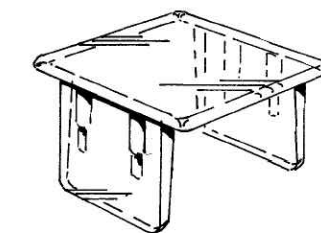

QTY	ITEM	DESCRIPTION
2	1/4 - 20 x 2 1/2"	round head machine screw
2	1/4 - 20	hex nut
2	1/4"	flat washer

WSFA-2 HARDWARE PACK #7200-080

□ indicates item, where used.


WIDE SPAN SHELVING ASY 061

PAGE 8 OF 10

LOAD SAFETY




HAND STACK ONLY!
POWERED FORK TRUCKS
OR STACKERS ARE NOT
RECOMMENDED FOR USE
ON WIDE SPAN SHELVING

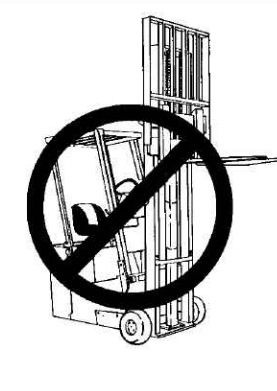

FRAME LOADING

Frame loading is the vertical load, measured in pounds, that can be applied on any Wide span frame. Each Wide span frame will bear ONE HALF OF THE LOAD ON EACH BEAM PAIR that it supports. ALL FRAMES HAVE 10,000 POUND LOAD CAPACITY!

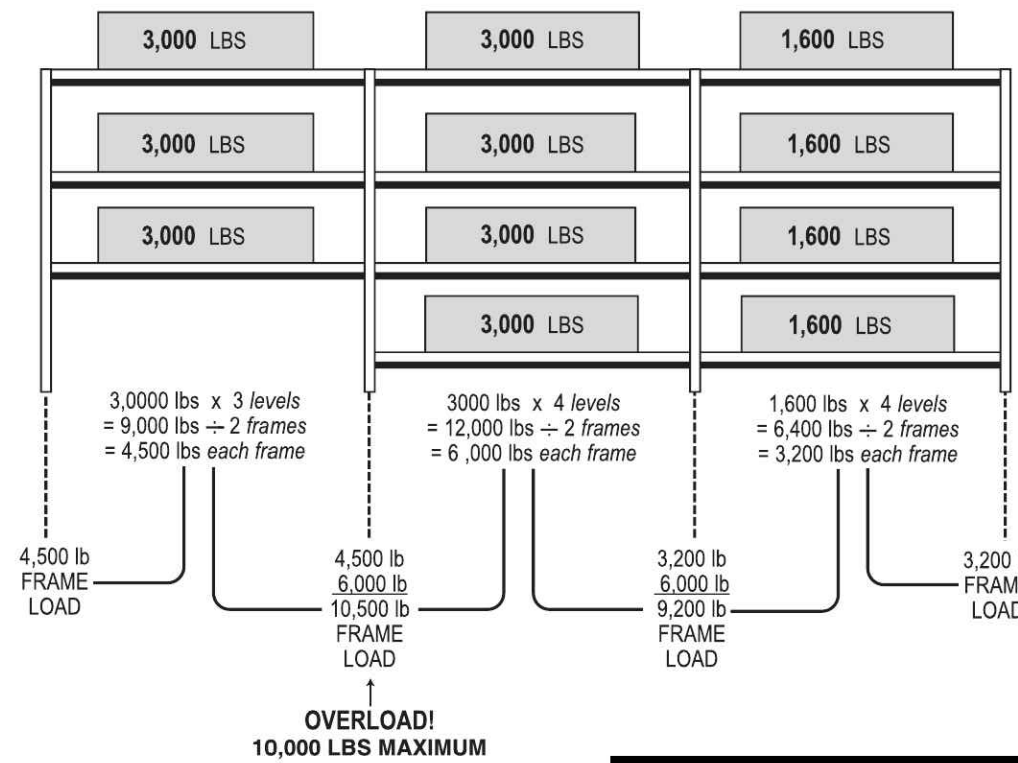

BEAM LENGTH	LIGHT DUTY	REGULAR DUTY	HEAVY DUTY	# OF DECK SUPPORTS
48"	1000 #	1600 #	3000 #	2
60"	1000 #	1600 #	3000 #	3
72"	1000 #	1600 #	3000 #	3
84"	1000 #	1600 #	3000 #	3
96"	1000 #	1600 #	3000 #	3

* Based on evenly distributed loads
* Based on 96" beam length, all frame widths

WIDE SPAN SHELVING ASY 061

PAGE 9 OF 10

SAFETY DURING INSTALLATION

GENERAL

- Contact the local building department prior to starting installation to check on any restrictions.
- Only parts and accessories produced or supplied by Madix are covered by Madix warranty.
- Installation sequence must be followed exactly for assembly and leveling.
- Under no circumstances should damaged parts be used.
- Do not use shelving parts or accessories for any purpose other than originally intended.
- Installation instructions with product load ratings are included with each order and must be followed carefully.
- Merchandisers must be made aware of possible overloading as specified in load ratings. If you do not receive these, please contact your sales or customer service representative.
- Initial installation or relocation of Madix gondola, wall or racking fixtures should be supervised exclusively by qualified personnel.


RACKING... FRAMES / BEAMS

- Observe all prohibitions in the installation instructions on the use of powered lifts.
- A minimum of four people are required to erect frames taller than 8'.
- Be sure all beams or accessories are completely seated and locked or secured in frame slotting.
- Ladders, if used, should be at least frame height.
- Never stand on lower beams to install upper beams.
- Do not walk on decks, especially wire grid.
- Never try to move a completed racking run, especially if merchandised.

WIDE SPAN SHELVING ASY 061

PAGE 10 OF 10

ANCHORING TO THE FLOOR

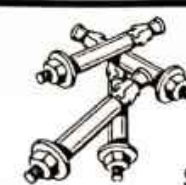

EXPANSION BOLTS FOR FLOOR ANCHORS
...50 expansion bolts, 3/8"-16 x 3 1/2" POWERS/ Power-Stud+SD2 concrete anchors or other ICC (ICBO) approved expansion bolts.

SFA-EB50: See below for other ICC (ICBO) approved expansion bolts which may be used.

NOTE! The expansion anchors provided by Madix for floor anchoring at this site have been supplied by one of the firms listed below. All the anchors have been tested and approved as stated by the following ICC (ICBO) report numbers and all are manufactured in the United States or Canada. If the anchors are not provided by Madix and field substitution other than listed be proven, Madix cannot be held responsible. Should verification be required, call Madix Customer Service at: 800.776.2349

Anchor Type	ICC (ICBO) #
COBRA ANCHORS CORP., Parawedge concrete anchors	ER-2350 S1
DIVERSIFIED FASTENING SYSTEMS, DFS Wedge anchor	ER-4194 S1
GUNNEBO FASTENING CORP., Drop-in concrete anchors	ER-3219 S1
HILTI, INC., Kwik-bolt-TZ concrete anchors	ESR-1917
MKT FASTENING, High Load Anchor SZ	AC-193
ITW RAMSET/RED HEAD, ITW Ramset stud, Trubolt wedge concrete anchors	ESR-2251
MARKSMAN MANUFACTURING CO., Thunderstud wedge and sleeve anchor	ER-2713 S1
POWERS FASTENING INNOV., Power-Stud+SD2 concrete anchors	ESR-2502
WEJ-IT, Wej-it anchors bolt and ANKR-TITE wedge anchor	ER-1825
CYW, INC., POWERBULL Wedge anchor	ESR-2254

*Embedment must be minimum 5x bolt diameter.

OTHER ICC (ICBO) APPROVED ANCHORING MATERIALS... not furnished by Madix

PNEUMATIC OR POWDER-DRIVEN STEEL STUDS AND NAILS

HILTI, INC., Hilti low velocity powder actuated or pneumatically driven fasteners	ESR-1663
ITW RAMSET/RED HEAD, Ramset Powder-Actuated and PowerPoint fasteners	ESR-1799

ADHESIVE/ EPOXY ANCHORS


HILTI, INC., HIT-HY 150 Adhesive anchor system	ESR-2678
ITW RAMSET/RED HEAD, ITW Red Head Epcon system Ceramic G+ epoxy anchors	ESR-3577

REV#	DATE	DESCRIPTION	BY	DATE	REV#	DATE	DESCRIPTION	BY	DATE
01	5/13/96	UPDATED TO CORRECT ANCHOR INFO	BAM	10/14	04	5/13/14	ADDED BOLTING REQ. TO PG 4	NRD	08/21/14
02	5/14/96	ADDED HEIGHT/DEPTH RATIO	CAR	02/14/14					
03	5/16/96	SHOWED LD BEAM DART CLIP ON PG 4	YED	08/29/19					

HYPERMAXI ASY 083

PAGE 1 OF 8


INSTALLATION INSTRUCTIONS

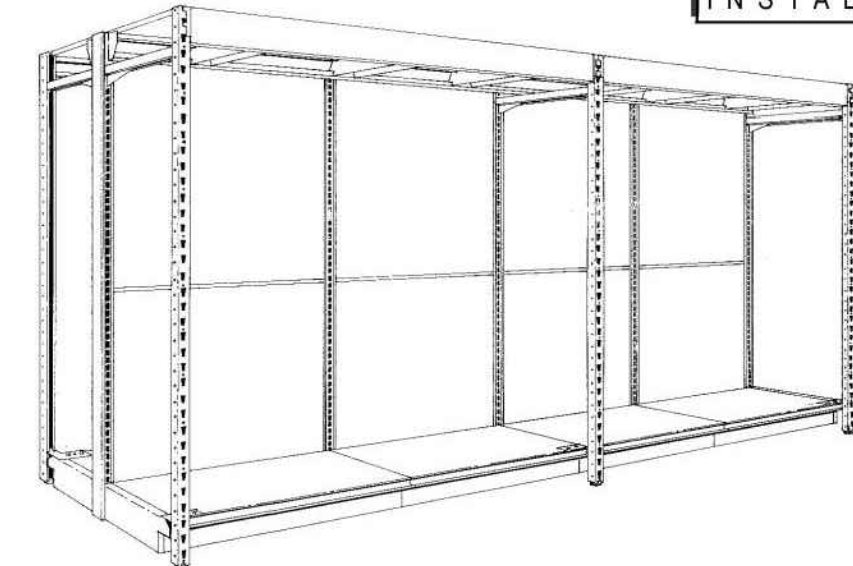

ALL CARTONS CONTAINING HYPERMAXI PARTS ARE LABELED **OPEN 6 SIXTH**

PAGE 2-3 ... PARTS IDENTIFICATION
PAGE 4-6 ... BASIC INSTALLATION
PAGE 7 ... INSTALLATION OF EXTRAS
PAGE 8 ... SAFETY/LOAD CAPACITY

NOTE!
This publication is intended to be a generic installation instruction for Madix Hypermaxi, and may possibly be subject to change as required by local building codes. Consult the building inspection department at job site.

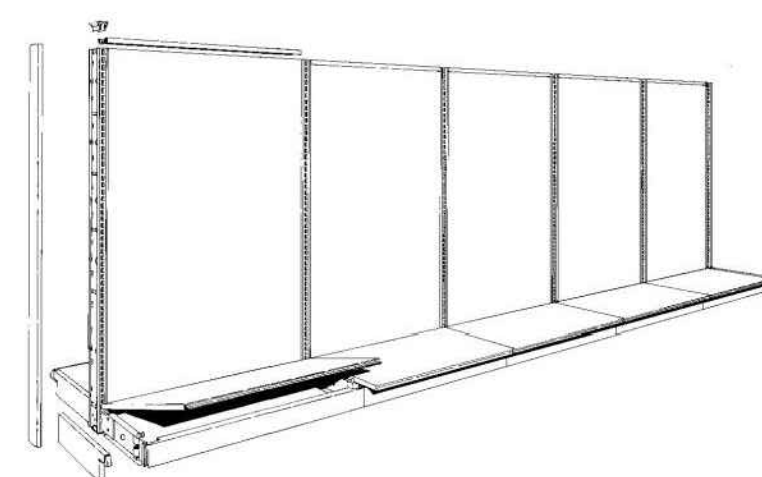


Hypermaxi is an addition to Madix gondola or wall fixtures. See installation instruction ASY 046 to correctly install and level the fixture runs. If floor anchoring of the fixtures is required, see ASY 357 for the correct procedure, and note that IT IS NOT REQUIRED TO ANCHOR THE HYPERMAXI UPRIGHTS, only the fixture base shoes or uprights.

HYPERMAXI ASY 083


PAGE 2 OF 8

PARTS IDENTIFICATION

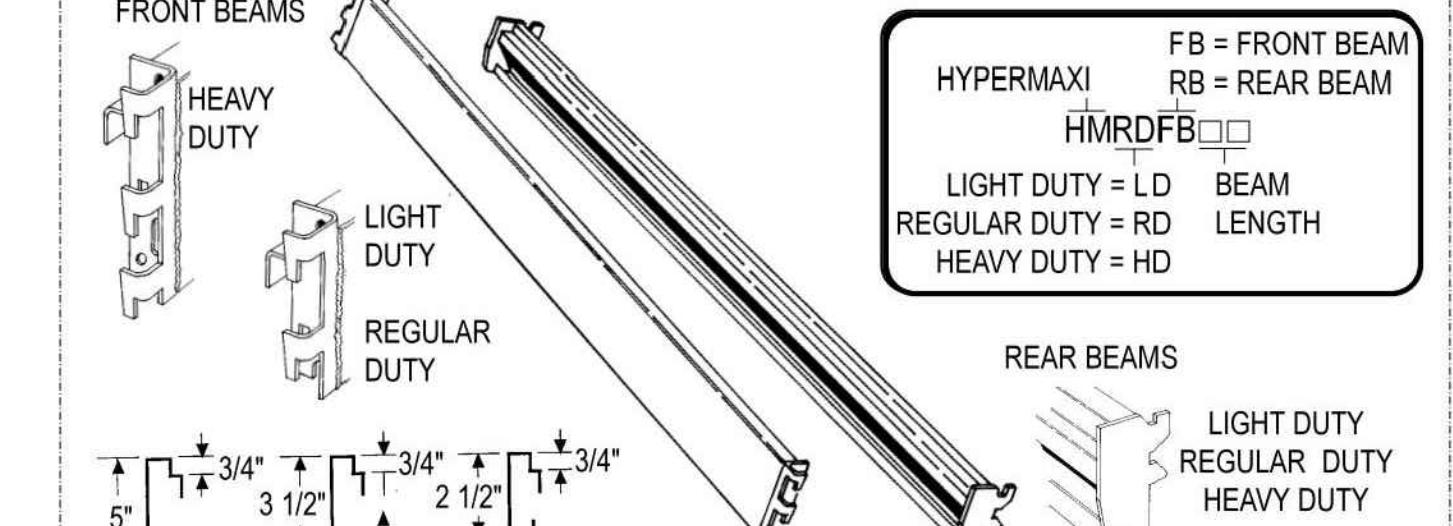

HYPERMAXI FB = FRONT BEAM
RB = REAR BEAM
HMRFB□□
LIGHT DUTY = LD BEAM LENGTH
REGULAR DUTY = RD
HEAVY DUTY = HD

DIMENSIONS			
Deck Supports Upright Depth	Actual Length	Beam Length Inside of brackets	Actual Length
18"	20"	36"	48 3/16"
20"	26"	48"	60 3/16"
22"	32"	72"	72 3/16"
24"	38"	84"	84 3/16"
30"	44"	96"	96 3/16"

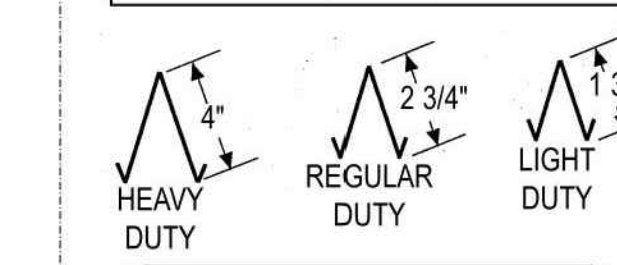

LIGHT DUTY = LD
REGULAR DUTY = RD
HEAVY DUTY = HD
RDWS□□□
WIDE FRAME DEPTH

UPRIGHT DIMENSIONS			
Upright Depth	Actual Depth	Upright Height	Actual Height
18"	20"	72"	48 1/8"
20"	26"	78"	60 1/8"
22"	32"	84"	72 1/8"
24"	38"	90"	84 1/8"
30"	44"	96"	96 1/8"
		102"	102 1/8"
		108"	108 1/8"
		114"	114 1/8"
		120"	120 3/16"
		126"	126 3/16"
		132"	132 3/16"
		138"	138 3/16"
		144"	144 3/16"

*...12 is for mounting light fixtures above the upright arm...see page 7.

OPTIONAL UPRIGHT ARM POSITION
HYPERMAXI HEIGHT POSITION
HMU-□□□□-12
UPRIGHT UPRIGHT DEPTH


DO NOT SCALE THESE DRAWINGS

REVISIONS									
#	DATE	TYPE							
1									
2									
3									
4									
5									
6									
7									
8									
9									
10									

FIXTURE SPECIFICATIONS AND DETAILS

DATE 05/17/24
JOB NO. 23475

A1.9
SHEET NO.

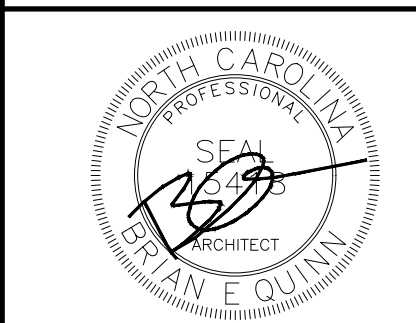

05/17/24

ADA ARCHITECTS
Lakewood, Ohio 44107
17710 Detroit Avenue
Phone (216) 521-5134
Fax (216) 521-4824
www.adaarchitects.com


HARBOR FREIGHT
ERWIN, NC 28839
46 SHRUI LANE

THESE DOCUMENTS CONTAIN INFORMATION PROPRIETARY TO ADA ARCHITECTS, INC.
UNAUTHORIZED USE OF THESE DOCUMENTS IS EXPRESSLY PROHIBITED UNLESS AGREED UPON IN WRITING.

HYPERMAXI ASY 083

PAGE 3 OF 8

PARTS IDENTIFICATION

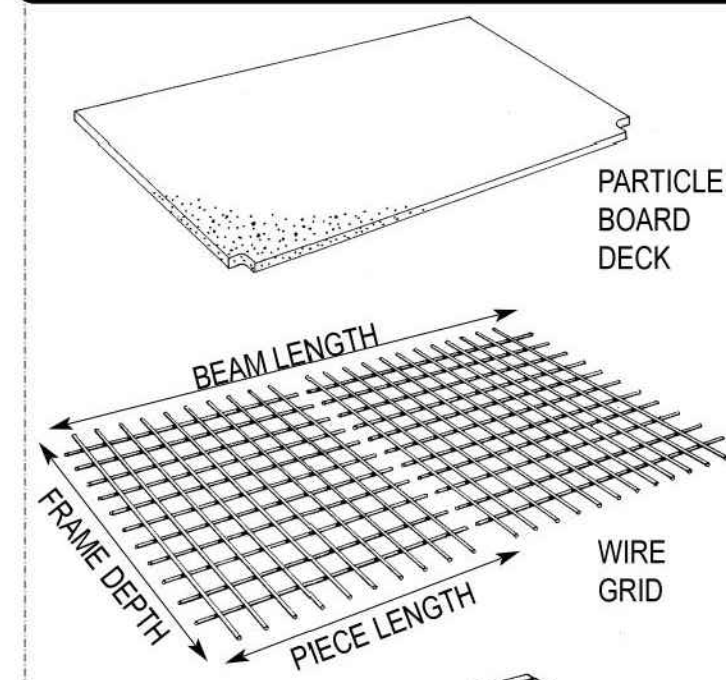

UPRIGHT SEALED = S
HYPERMAXI DEPTH UNSEALED = U
HMRDD□□□□□□□□
REGULAR DUTY = RD BEAM LENGTH
HEAVY DUTY = HD DECK


UPRIGHT DEPTH	ACTUAL DEPTH	PIECE LENGTH	ACTUAL LENGTH
18"	18"	36"	35 17/32"
20"	20"	48"	47 17/32"
22"	22"	60"	59 17/32"
24"	24"	72"	71 17/32"
30"	30"	84"	83 17/32"
-	-	96"	95 17/32"

UPRIGHT GRID SIZE
HYPERMAXI DEPTH ...3" O.C.
HMWMS□□□□□□□□
WIRE GRID DECK BEAM LENGTH
FLOW THROUGH UPRIGHT DEPTH

HYPERMAXI DECK	BEAM LENGTH
FTHMD□□□□□□	

UPRIGHT DEPTH	ACTUAL DEPTH	PIECE LENGTH	ACTUAL LENGTH
18"	17 3/4"	24"	23 3/4"
20"	19 3/4"	36"	35 3/4"
22"	21 3/4"	48"	47 3/4"
24"	23 3/4"	-	-
30"	29 3/4"	-	-

BEAM LENGTH	COMBINATIONS OF PIECE LENGTHS	# OF DECK SUPPORTS
36"	36"	2
48"	48"	2
60"	24" plus 36"	4
72"	36" plus 36"	4
84"	36" plus 48"	4
96"	48" plus 48"	4

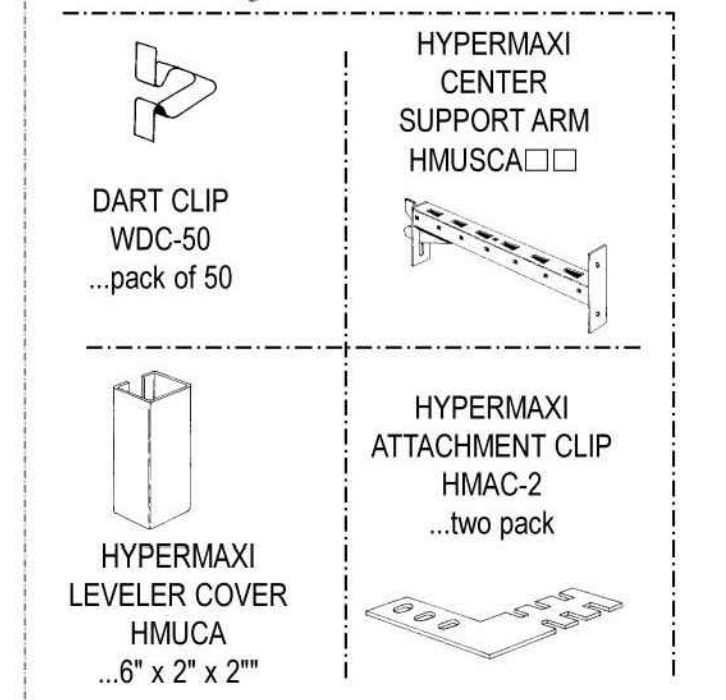

HYPERMAXI LEVELER COVER HMUCA
...6" x 2" x 2"


P.O. BOX 729 / TERRELL, TEXAS 75160 / 972.563.5744 / 800.776.2349
P.O. BOX 177 / GOODWATER, ALABAMA 35072 / 205.839.6354 / 800.633.6282

HYPERMAXI ASY 083

PAGE 4 OF 8

INSTALLATION INSTRUCTIONS

- Run levelers on Hypermaxi uprights all the way up. Slide leveler cover, if used, approximately 6" up Hypermaxi upright and secure with tape.
- If plastic upright end covers, UEC-□□□, are used, they should not be installed at this point. If metal upright end covers, VC-□□□, they should be installed at this point.
- Hold Hypermaxi upright at an angle as shown and insert bracket into the sixth slot from the top of the fixture upright; if using HMU-□□□□-12 is used, insert into the twelfth slot down. The bottom of the Hypermaxi upright will pivot in toward base when bracket is properly engaged.
- Pull down on the bracket arm, using your weight to properly seat bracket in upright.
- Repeat steps 4-5 on opposite side of fixture if it is a gondola.
- Insert screw as shown through fixture slotting and Hypermaxi upright bracket. Secure with washer and nut on other side.

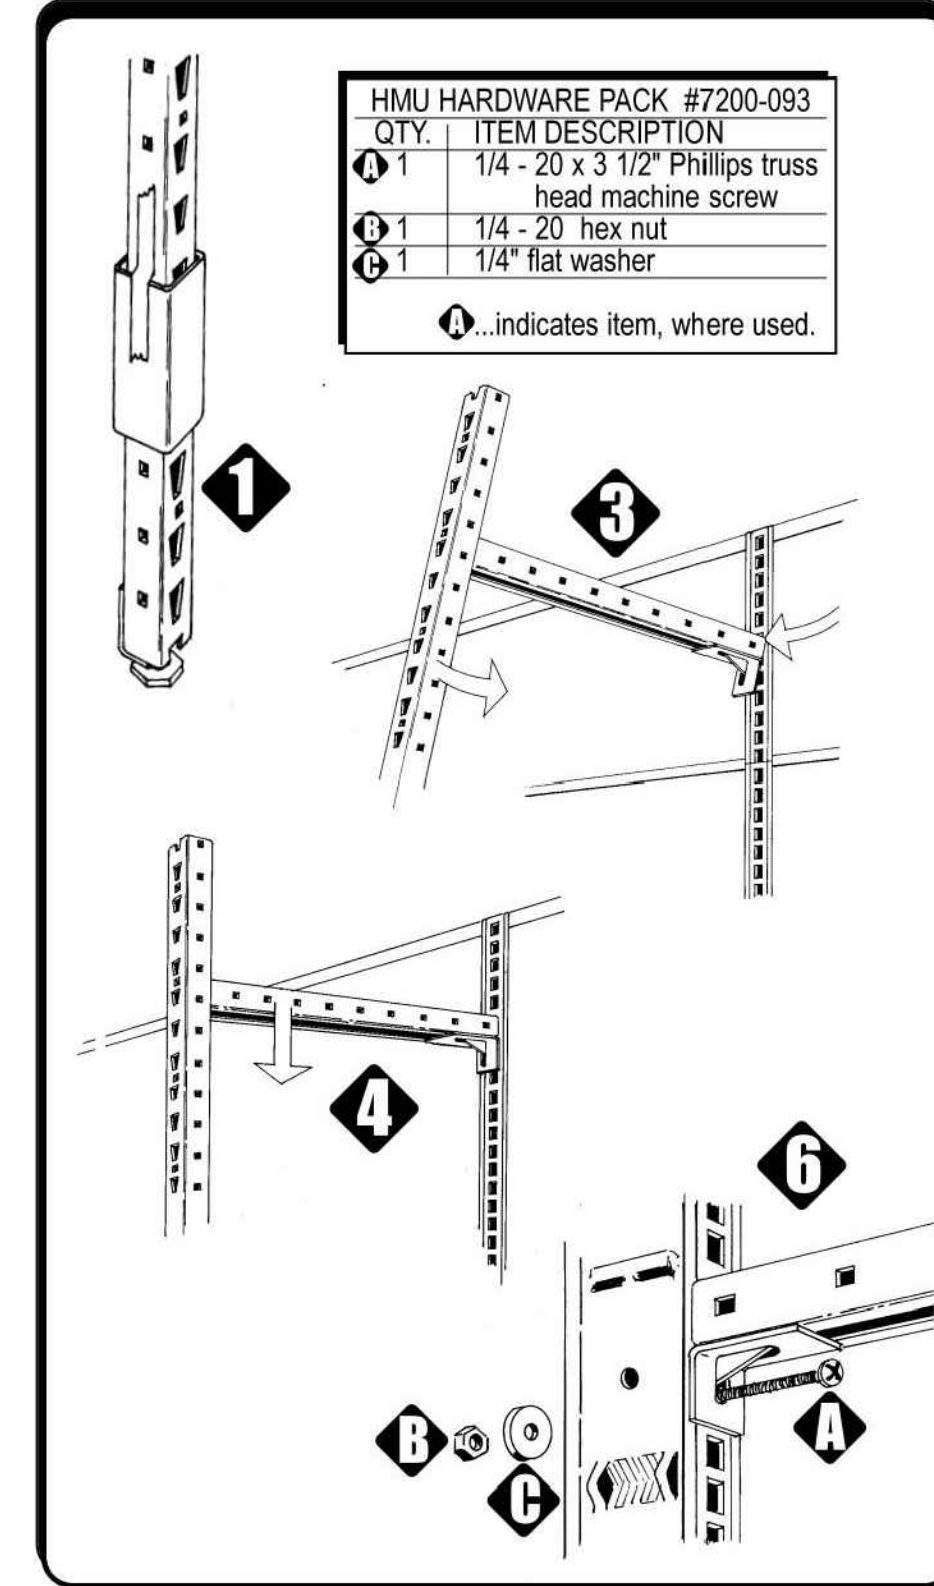

QTY.	ITEM DESCRIPTION
1	1/4" - 20 x 3 1/2" Phillips truss head machine screw
1	1/4" - 20 hex nut
1	1/4" flat washer


P.O. BOX 729 / TERRELL, TEXAS 75160 / 972.563.5744 / 800.776.2349
P.O. BOX 177 / GOODWATER, ALABAMA 35072 / 205.839.6354 / 800.633.6282

HYPERMAXI ASY 083

PAGE 5 OF 8

INSTALLATION INSTRUCTIONS

- Run Hypermaxi upright levelers down to floor... untape leveler cover, if used, and slide cover down to floor.
- Insert the attachment clip into Hypermaxi upright and rotate 90°.
- Select required attachment clip positioning from the diagram below, then secure attachment clip to base shelf with fasteners in hardware pack shown below.
- Install beams at required heights. For front and rear beam sizes and bracket shapes, refer to parts identification on page 2.
- Press dart clips through beam bracket and upright on the under side of beam as shown. Insert one dart clip at each end of all beams.

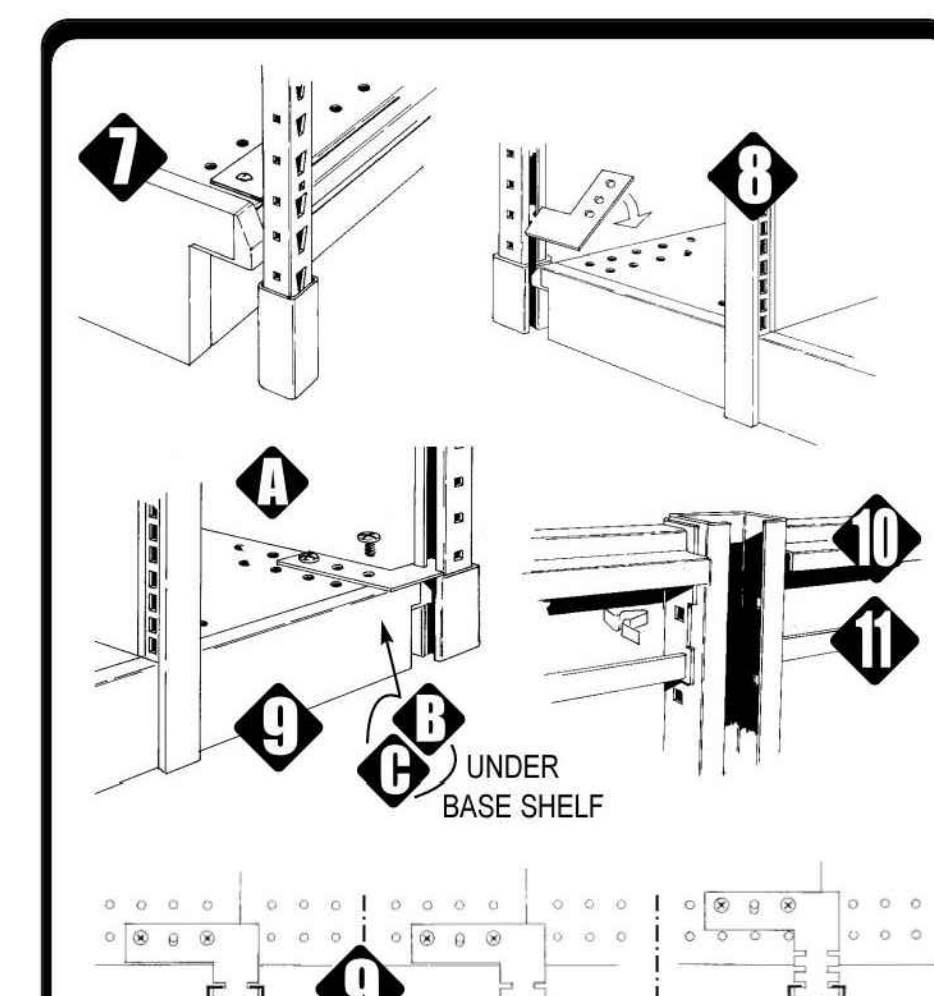

QTY.	ITEM DESCRIPTION
1	1/4" - 20 x 1/2" Phillips truss head machine screw
1	1/4" - 20 hex nut
1	1/4" flat washer
1	1/4" - 20 lock washer
1	# 8 x 1/2" hex head sheet metal screw


P.O. BOX 729 / TERRELL, TEXAS 75160 / 972.563.5744 / 800.776.2349
P.O. BOX 177 / GOODWATER, ALABAMA 35072 / 205.839.6354 / 800.633.6282

HYPERMAXI ASY 083

PAGE 6 OF 8

DECK SUPPORTS: QUANTITY AND LOCATION

- Holding the deck support at an angle to the beam, squeeze the open side and insert into the beam, then swing the free end around to the opposite beam, squeeze the open side and insert into the beam.
- Squeeze the open side of the deck support at each end just inside the beam and rotate upwards as shown.
- Correct installed position will look like diagram 14. See layout diagram for quantity of deck supports per beam length. Supports may be slid or tapped into locations as shown.
- Lay the decks on the deck supports. The notches on the particle board decks are on the front edge to accommodate the Hypermaxi upright.
- Trim the UEC-□□□□, upright end covers, to fit over the Hypermaxi upright bracket prior to installing them.
- Install upper shelves and accessories into the basic fixture upright.

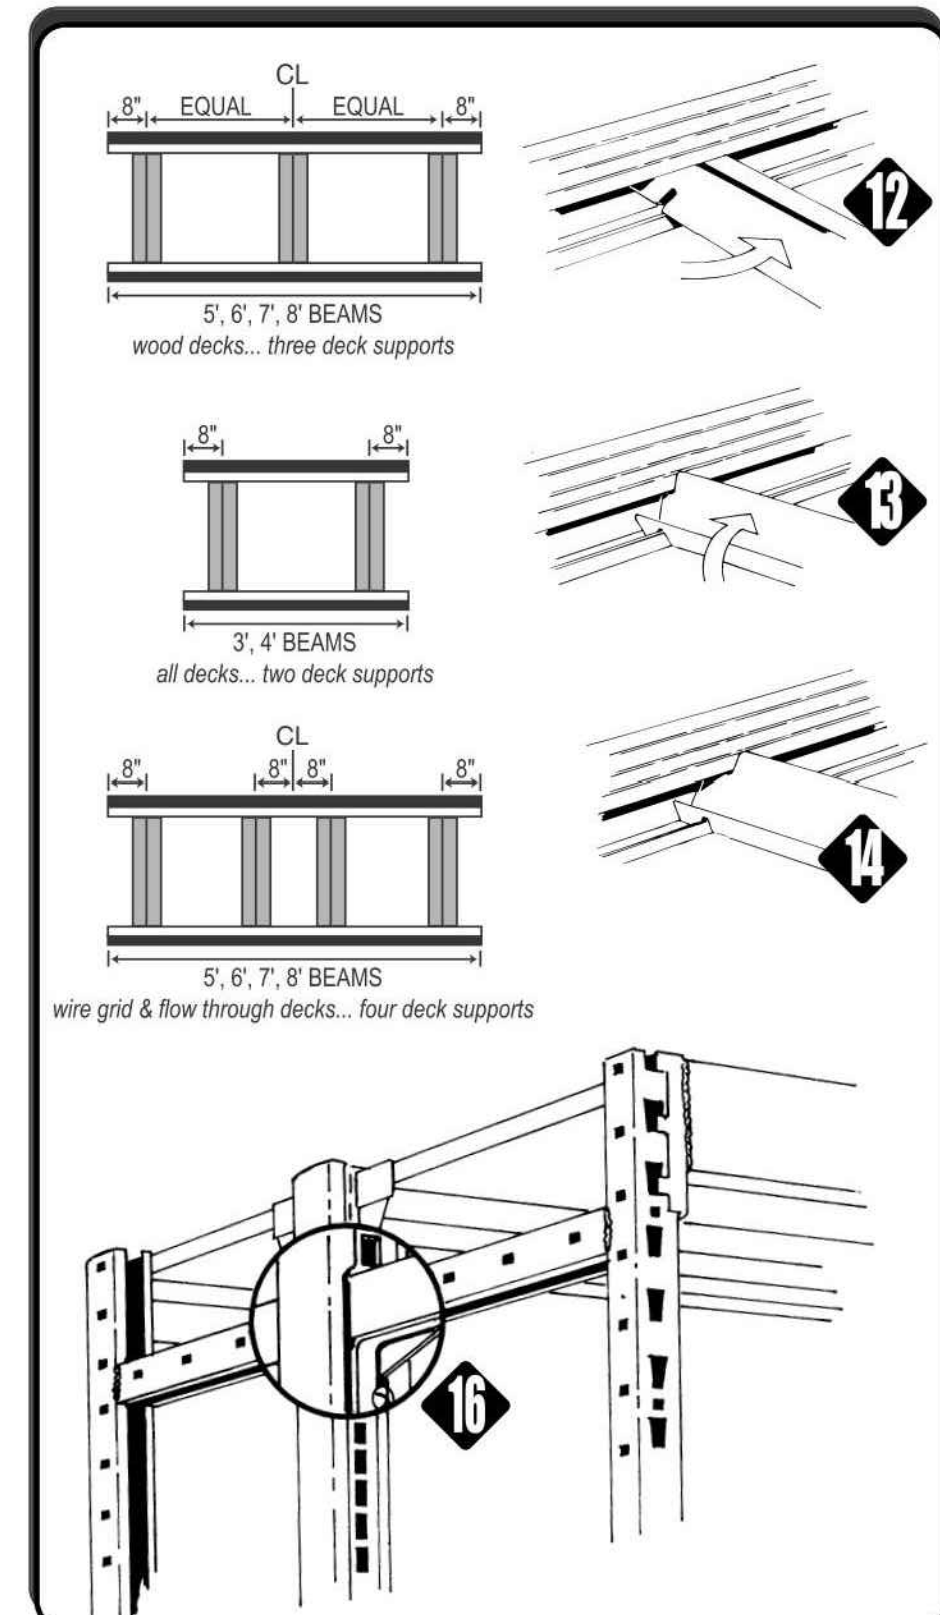


P.O. BOX 729 / TERRELL, TEXAS 75160 / 972.563.5744 / 800.776.2349
P.O. BOX 177 / GOODWATER, ALABAMA 35072 / 205.839.6354 / 800.633.6282

HYPERMAXI ASY 083

PAGE 7 OF 8

INSTALLATION OF EXTRAS

- NOTE!**
The Hypermaxi center support arm must be installed at the approximate midpoint of the Hypermaxi upright and above the installed upper shelves. If two support arms are used on an upright, they should be equally spaced.
- Hold the center support arm at an angle as shown and insert bracket into the basic fixture upright and pull down on the bracket arm, using your weight to properly seat bracket in upright.
 - Pull outward on the Hypermaxi upright and swing the center support arm in behind the upright. Align the mounting plate holes with the upright slots and secure with the fasteners as shown.
 - There are two means of securing the light fixture to the deck support...the fasteners are provided for either one.
 - Use the self drilling Tek-2 screw, item D, as shown. This runs a slight risk of drilling into the interior wiring of the light fixture.
 - OR
 - Use the screw and nut, items B and C, as shown. This will require removing the light fixture cover.
 - Using the self-drilling screws, item E, secure the reflector to the light fixture as shown.

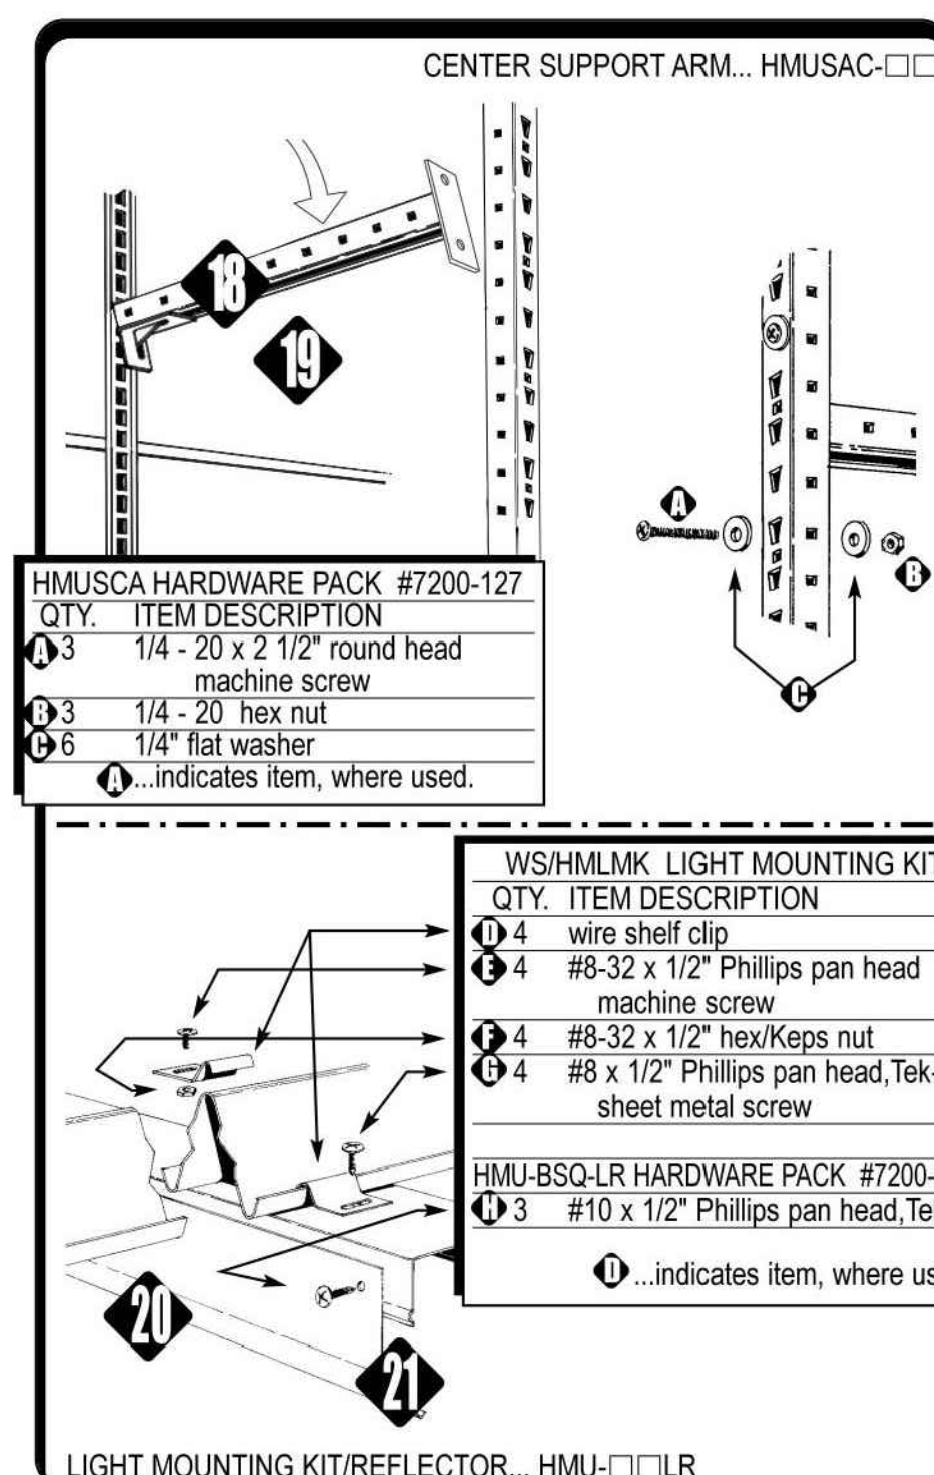

QTY.	ITEM DESCRIPTION
3	1/4" - 20 x 2 1/2" round head machine screw
3	1/4" - 20 hex nut
6	1/4" flat washer

QTY.	ITEM DESCRIPTION
4	wire shelf clip
4	#8-32 x 1/2" Phillips pan head machine screw
4	#8-32 x 1/2" hex/Keps nut
4	#8 x 1/2" Phillips pan head, Tek-2 sheet metal screw


QTY.	ITEM DESCRIPTION
3	#10 x 1/2" Phillips pan head, Tek-2

P.O. BOX 729 / TERRELL, TEXAS 75160 / 972.563.5744 / 800.776.2349
P.O. BOX 177 / GOODWATER, ALABAMA 35072 / 205.839.6354 / 800.633.6282

HYPERMAXI ASY 083

PAGE 8 OF 8

SAFETY / LOAD CAPACITY

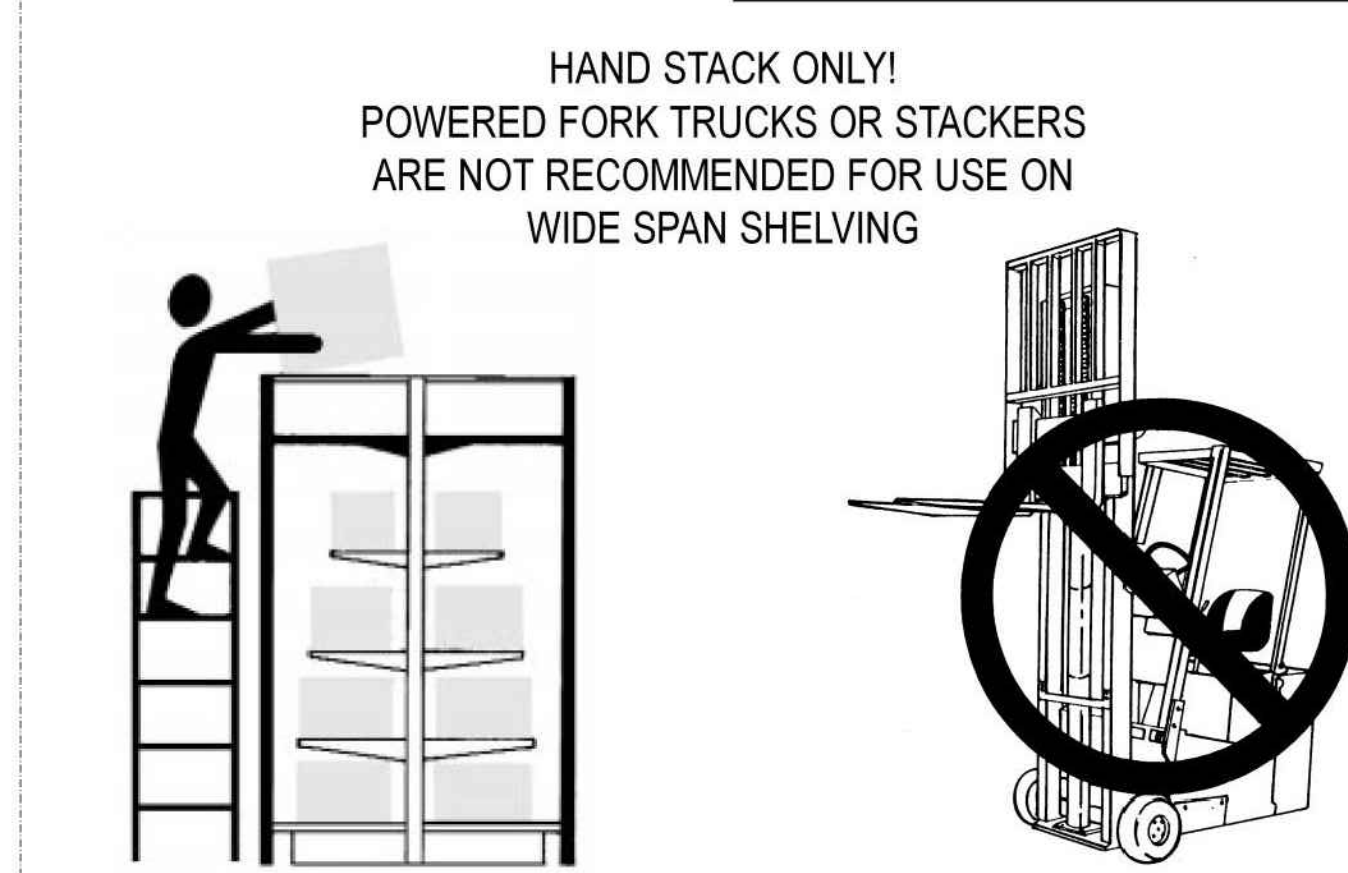

HAND STACK ONLY!
POWERED FORK TRUCKS OR STACKERS ARE NOT RECOMMENDED FOR USE ON WIDE SPAN SHELVING

...PER BEAM PAIR					
BEAM LENGTH	LIGHT DUTY	REGULAR DUTY	HEAVY DUTY	# OF DECK SUPPORTS	
36"	1000 #	1600 #	3000 #	2	
48"	1000 #	1600 #	3000 #	2	
60"	1000 #	1600 #	3000 #	3	
72"	1000 #	1600 #	3000 #	3	
84"	1000 #	1600 #	3000 #	3	
96"	1000 #	1600 #	3000 #	3	

P.O. BOX 729 / TERRELL, TEXAS 75160 / 972.563.5744 / 800.776.2349
P.O. BOX 177 / GOODWATER, ALABAMA 35072 / 205.839.6354 / 800.633.6282

DO NOT SCALE THESE DRAWINGS



ADA ARCHITECTS
Lakewood, Ohio 44107
17710 Detroit Avenue
Phone (216) 521-1534
Fax (216) 521-14824
www.adaarchitects.com

HARBOR FREIGHT
ERWIN, NC 28839
46 SHRUI LANE
THESE DOCUMENTS CONTAIN INFORMATION PROPRIETARY TO ADA ARCHITECTS, INC.
UNAUTHORIZED USE OF THESE DOCUMENTS IS EXPRESSLY PROHIBITED UNLESS AGREED UPON IN WRITING.


REVISIONS									
#	DATE	TYPE							
1									
2									
3									
4									
5									
6									
7									
8									
9									
10									

FIXTURE SPECIFICATIONS AND DETAILS
DATE 05/17/24
JOB NO. 23475
A1.10
SHEET NO.

PALLET RACK ASY 103

PAGE 1 OF 7

ASSEMBLY INSTRUCTIONS

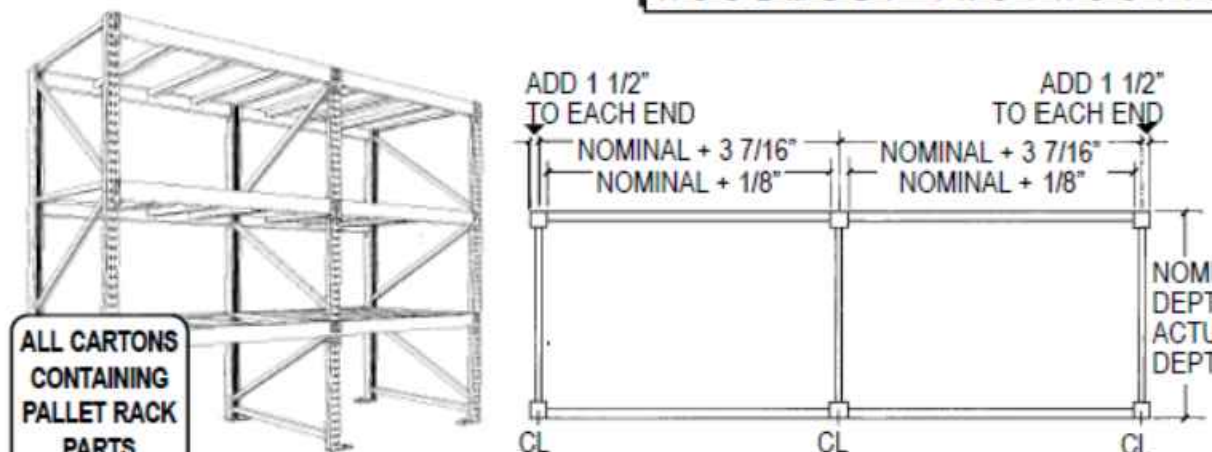


ALL CARTONS CONTAINING PALLET RACK PARTS ARE LABELED OPEN SEVENTH

PAGE 1-3 PARTS IDENTIFICATION
PAGE 3 SAFETY
PAGE 4-5 BASIC INSTALLATION
PAGE 6 LOAD CAPACITY
PAGE 7 ANCHORING TO FLOOR

NOTE! This publication is intended to be a generic installation instruction for Madix Pallet Rack, and may possibly be subject to change as required by local building codes...consult the building inspection department at job site.

PARTS IDENTIFICATION

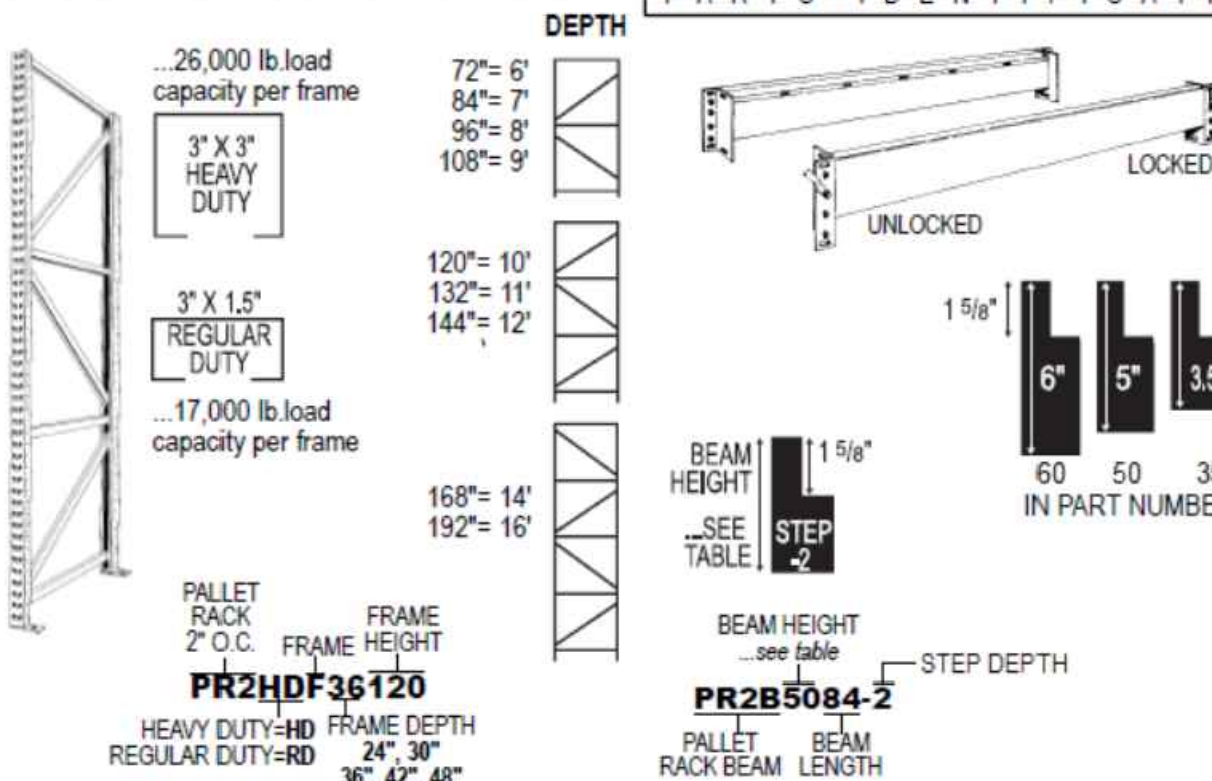

madix STORE FEATURES P.O. BOX 729 / TERRELL, TEXAS 75160 / 972.563.5744 / 800.776.2348
P.O. BOX 177 / GOODWATER, ALABAMA 36072 / 256.535.6354 / 800.533.5252

REV 08

PALLET RACK ASY 103

PAGE 2 OF 7

PARTS IDENTIFICATION

BEAM LENGTH	BEAM HEIGHT	CAPACITY IN LBS/PAIR	ACTUAL LENGTH BETWEEN BRACKETS
48" x 3 1/2"	5"	4,950	48 1/8"
48" x 5"	6"	7,600	48 1/8"
60" x 3 1/2"	5"	4,950	60 1/8"
60" x 5"	6"	7,600	60 1/8"
72" x 3 1/2"	5"	4,950	72 1/8"
72" x 5"	6"	7,600	72 1/8"
84" x 3 1/2"	5"	4,950	84 1/8"
84" x 5"	6"	7,600	84 1/8"
96" x 3 1/2"	5"	4,950	96 1/8"
96" x 5"	6"	7,600	96 1/8"
108" x 3 1/2"	5"	9,110	108 1/8"
108" x 5"	6"	8,000	108 1/8"
120" x 3 1/2"	5"	7,270	120 1/8"
120" x 5"	6"	6,660	120 1/8"
144" x 3 1/2"	5"		144 1/8"
144" x 5"	6"		144 1/8"

PARTICLE BOARD DECK DIMENSIONS		FRAME DEPTH	
NOMINAL	ACTUAL	Frame Depth	Actual Length
24"	21"	24"	20 7/32"
30"	27"	30"	26 7/32"
36"	33"	36"	32 7/32"
42"	39"	42"	38 7/32"
48"	45"	48"	44 7/32"


madix STORE FEATURES P.O. BOX 729 / TERRELL, TEXAS 75160 / 972.563.5744 / 800.776.2348
P.O. BOX 177 / GOODWATER, ALABAMA 36072 / 256.535.6354 / 800.533.5252

REV 08

PALLET RACK ASY 103

PAGE 3 OF 7

PARTS IDENTIFICATION AND SAFETY

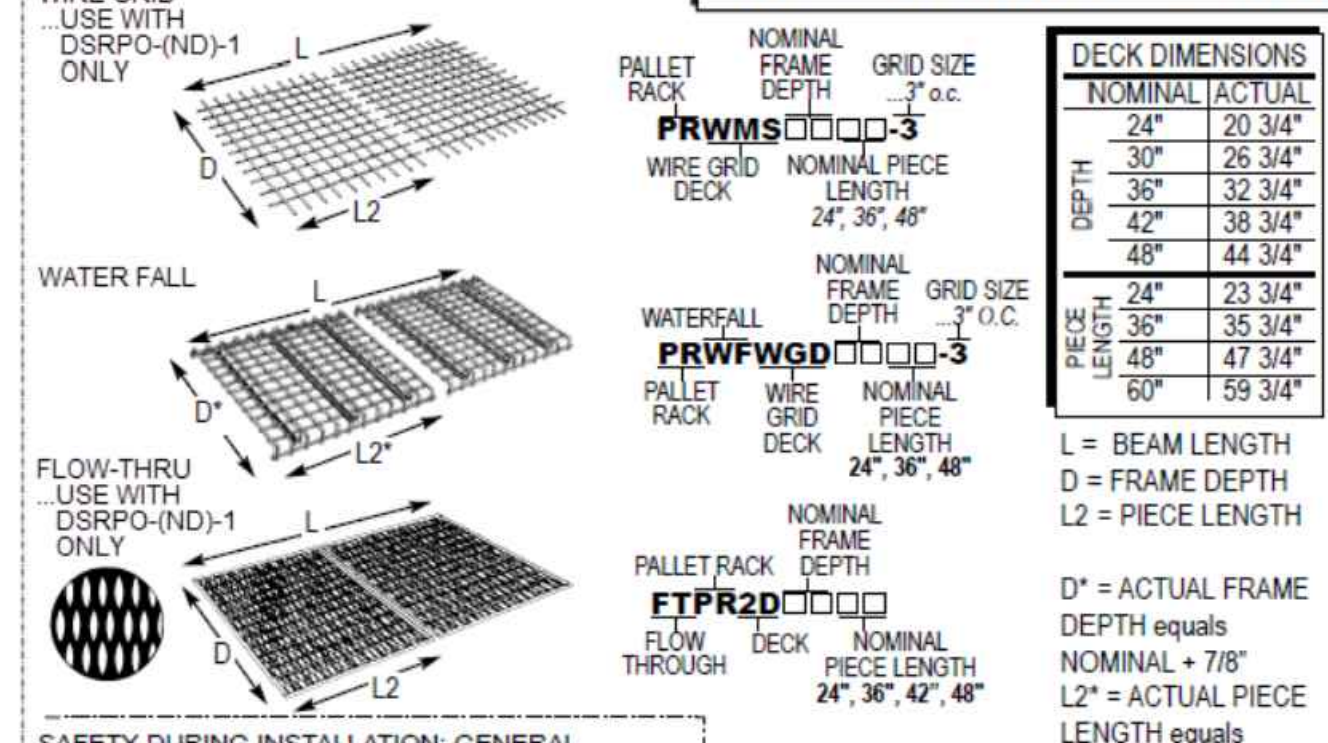

SAFETY DURING INSTALLATION - GENERAL

- Contact the local building department prior to starting installation to check on any restrictions.
- Only parts and accessories produced or supplied by Madix are covered by Madix warranty.
- Installation sequence must be followed exactly for assembly and leveling.
- Under no circumstances should damaged parts be used.
- Do not use shelving parts or accessories for any purpose other than originally intended.
- Merchandisers must be made aware of possible overloading as specified in load ratings. If you do not receive these, please contact your sales or customer service representative.
- Initial installation or relocation of Madix gondola, wall or racking fixtures should be supervised exclusively by qualified personnel.

RACKING - FRAMES/ BEAMS

- Observe all prohibitions in the installation instructions on the use of powered lifts.
- A minimum of four people are required to erect frames taller than 8'.
- Be sure all beams or accessories are completely seated and locked or secured in frame slotting.
- Ladders, if used, should be at least frame height.
- Never stand on lower beams to install upper beams.
- Do not walk on decks, especially wire grid.
- Never try to move a completed racking run, especially if merchandised.
- If installing frame extensions (PR2HDFR or PR2RDFE), Refer to ASY-80033038 for detailed instructions.

Height to Depth Ratio: Ratio should not exceed 4 to 1 measuring to the top of the most load. If ratio exceeds 4 to 1 the constraint can be overcome with proper anchoring or external bracing of the rack structure. CONSULT YOUR STRUCTURAL ENGINEER FOR SOLUTIONS.

DECK TYPE

DECK TYPE	NOMINAL BEAM LENGTH	COMBINE THESE PIECE LENGTHS TO = BEAM LENGTH
SINGLE DECK	36"	36"
	48"	48"
TWO PIECE DECKS	60"	24" plus 36"
	72"	36" plus 36"
	84"	36" plus 48"
	96"	48" plus 48"
THREE PIECE DECKS	108"	36" plus 36" plus 36"
	120"	36" plus 48" plus 36"
	132"	48" plus 36" plus 48"
	144"	48" plus 48" plus 48"


PIECE LENGTH RUNS PARALLEL TO BEAM LENGTH

REV 08

PALLET RACK ASY 103

PAGE 4 OF 7

ASSEMBLY INSTRUCTIONS

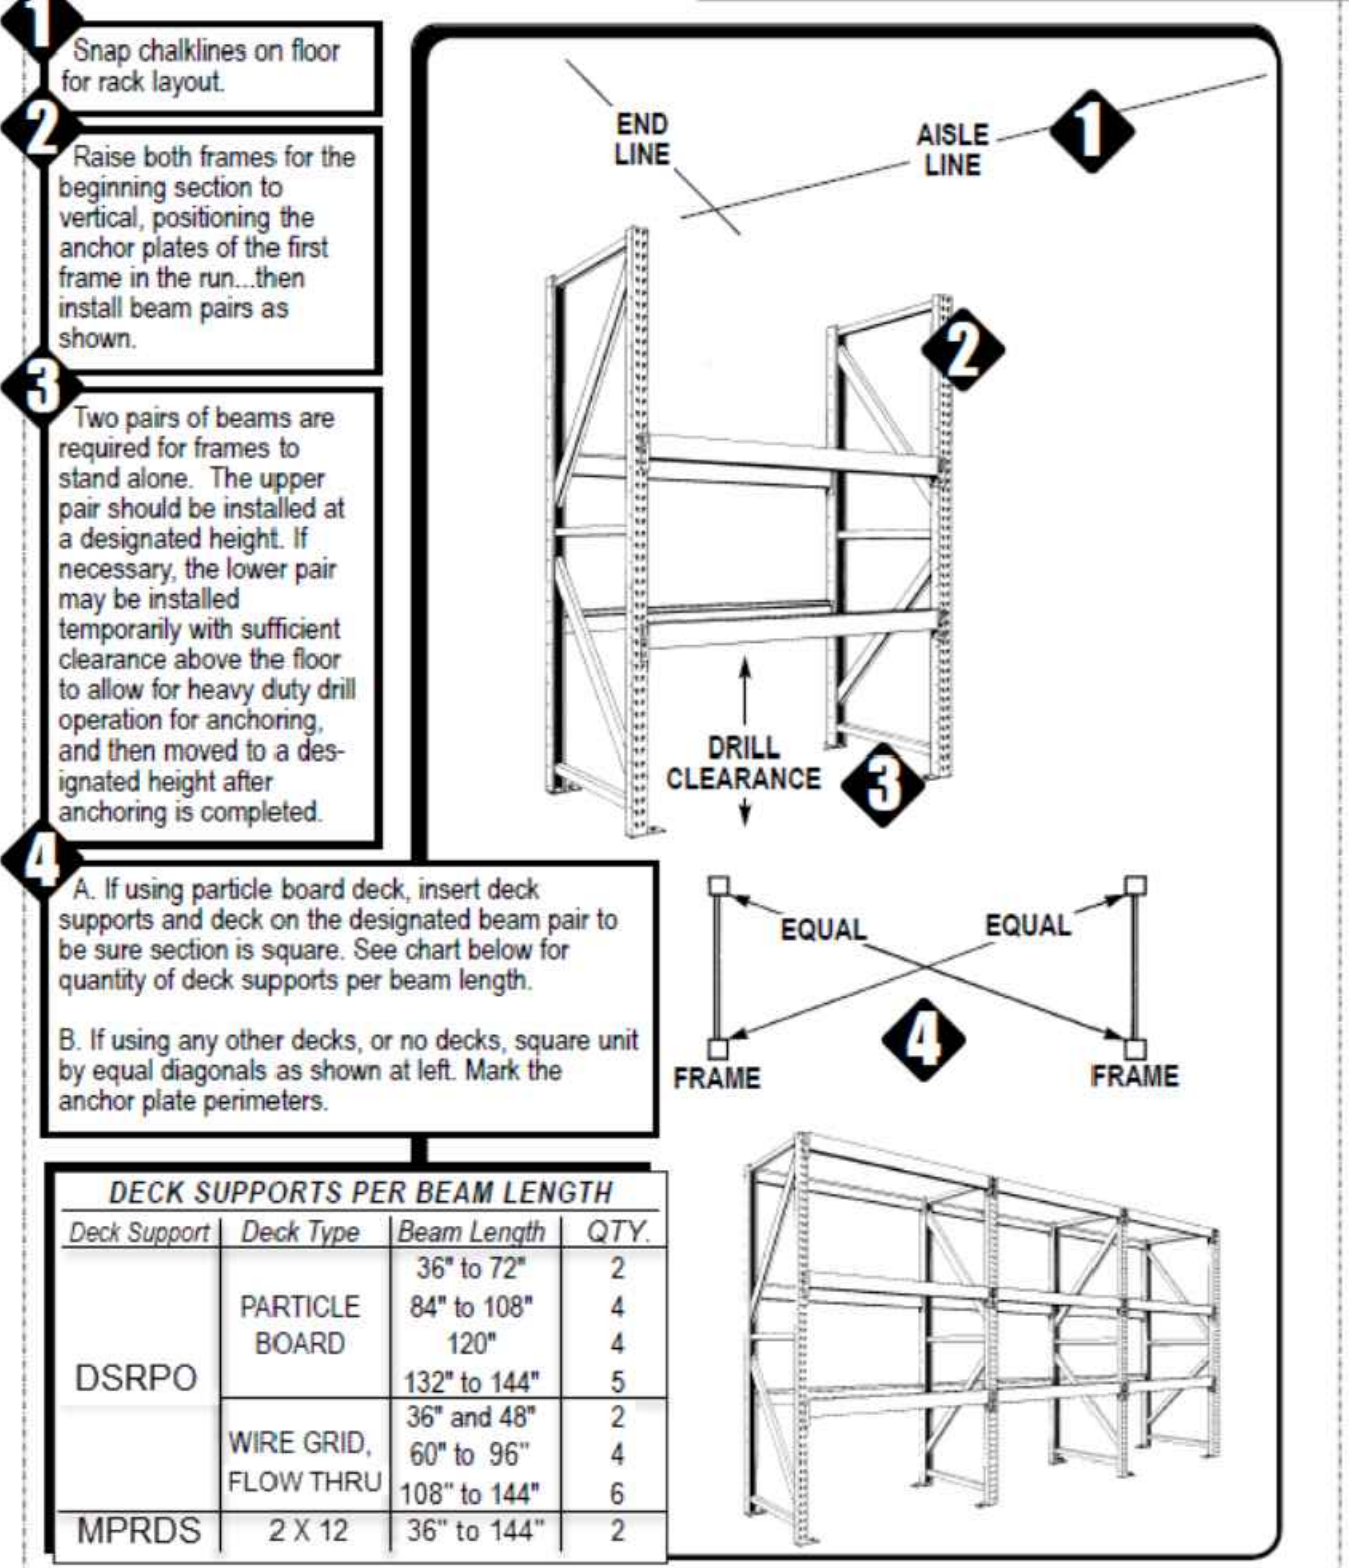

Deck Support	Deck Type	Beam Length	QTY.
DSRPO	PARTICLE BOARD	36" to 72"	2
		84" to 108"	4
		120"	4
MPRDS	WIRE GRID, FLOW THRU	36" and 48"	2
		60" to 96"	4
		108" to 144"	6
MPRDS	2 X 12	36" to 144"	2


madix STORE FEATURES P.O. BOX 729 / TERRELL, TEXAS 75160 / 972.563.5744 / 800.776.2348
P.O. BOX 177 / GOODWATER, ALABAMA 36072 / 256.535.6354 / 800.533.5252

REV 08

PALLET RACK ASY 103

PAGE 5 OF 7

ASSEMBLY INSTRUCTIONS

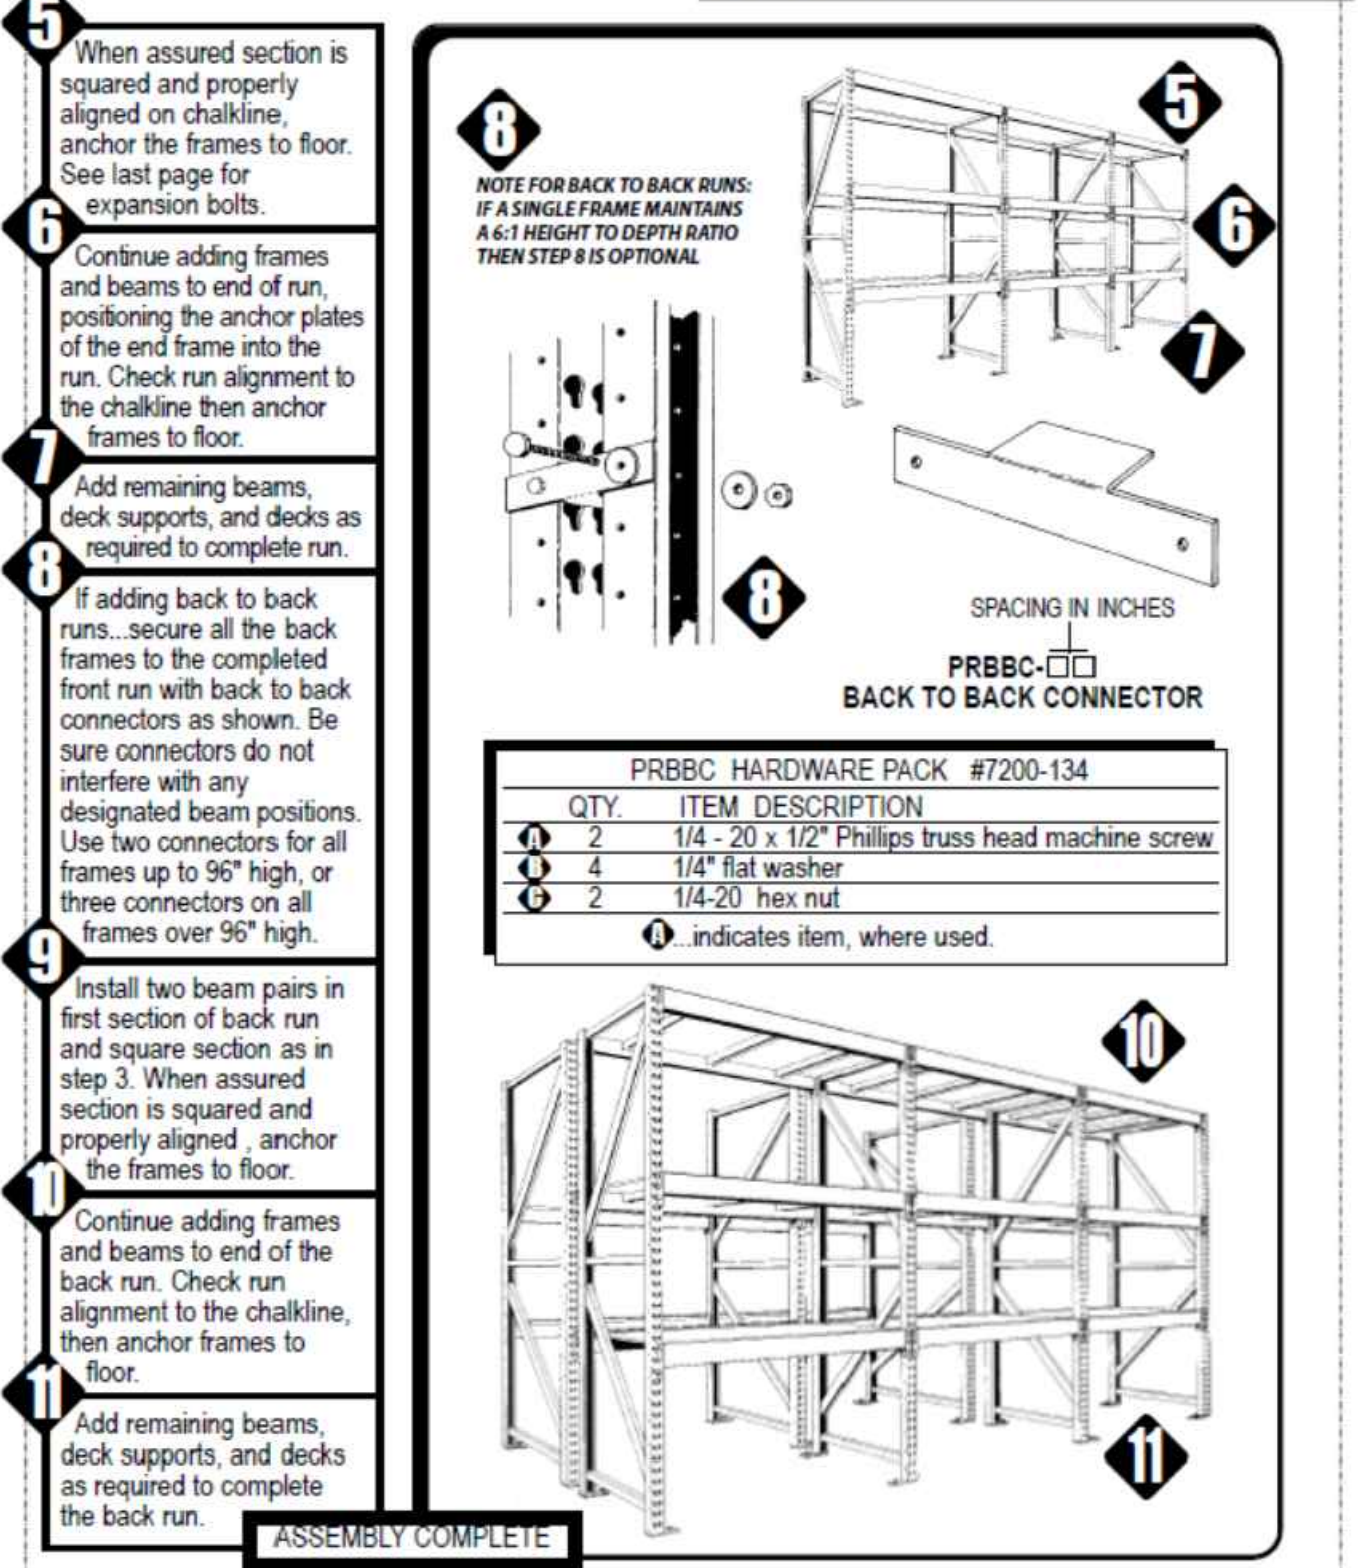


madix STORE FEATURES P.O. BOX 729 / TERRELL, TEXAS 75160 / 972.563.5744 / 800.776.2348
P.O. BOX 177 / GOODWATER, ALABAMA 36072 / 256.535.6354 / 800.533.5252

REV 08

PALLET RACK ASY 103

PAGE 6 OF 7

LOAD CAPACITIES

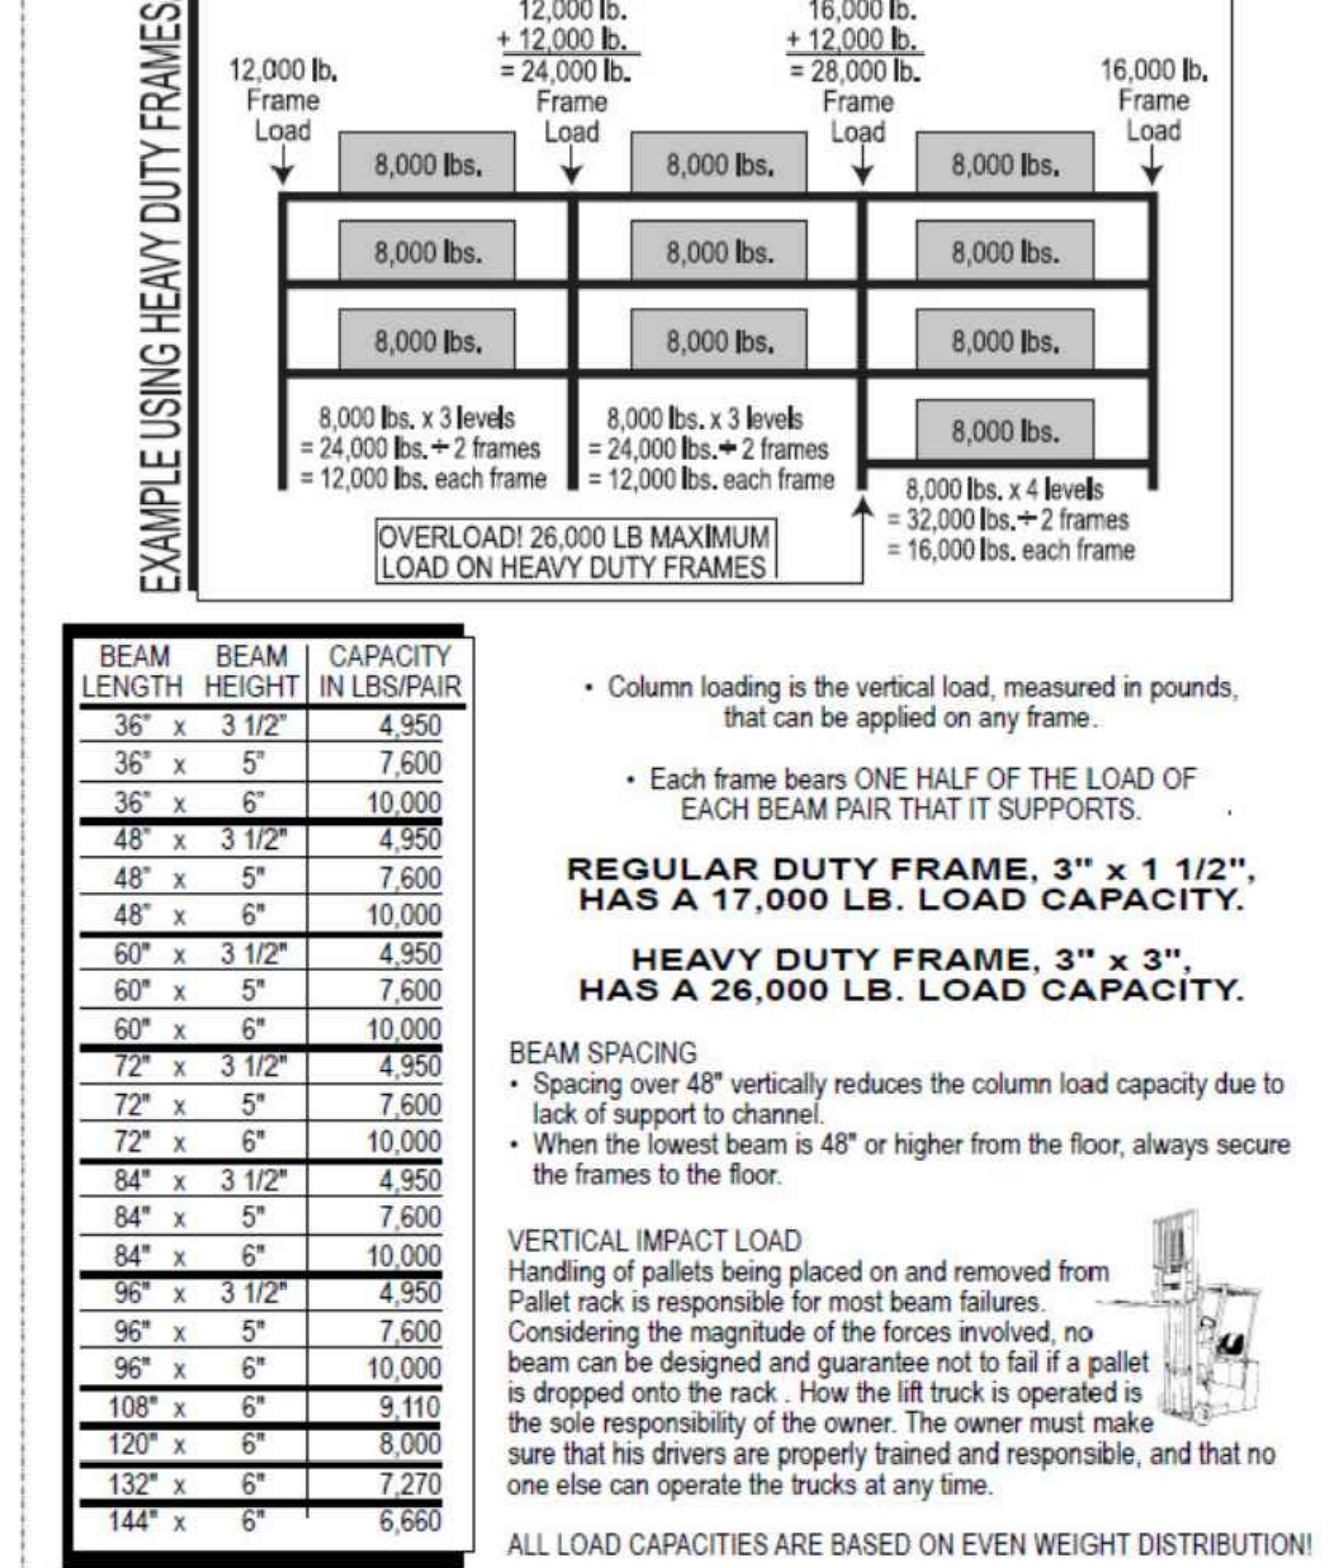

EXAMPLE USING HEAVY DUTY FRAMES:

Beam Length	Beam Height	Capacity
36" x 3 1/2"	5"	4,950
36" x 5"	6"	7,600
48" x 3 1/2"	5"	4,950
48" x 5"	6"	7,600
60" x 3 1/2"	5"	4,950
60" x 5"	6"	7,600
72" x 3 1/2"	5"	4,950
72" x 5"	6"	7,600
72" x 6"	6"	10,000
84" x 3 1/2"	5"	4,950
84" x 5"	6"	7,600
84" x 6"	6"	10,000
96" x 3 1/2"	5"	4,950
96" x 5"	6"	7,600
96" x 6"	6"	10,000
108" x 3 1/2"	5"	9,110
108" x 5"	6"	8,000
120" x 3 1/2"	5"	7,270
120" x 5"	6"	6,660
144" x 3 1/2"	5"	
144" x 5"	6"	

REGULAR DUTY FRAME, 3" x 1 1/2", HAS A 17,000 LB. LOAD CAPACITY.

HEAVY DUTY FRAME, 3" x 3", HAS A 26,000 LB. LOAD CAPACITY.

BEAM SPACING

- Spacing over 48" vertically reduces the column load capacity due to lack of support to channel.
- When the lowest beam is 48" or higher from the floor, always secure the frames to the floor.

VERTICAL IMPACT LOAD

Handling of pallets being placed on and removed from Pallet rack is responsible for most beam failures. Considering the magnitude of the forces involved, no beam can be designed and guaranteed not to fail if a pallet is dropped onto the rack. How the lift truck is operated is the sole responsibility of the owner. The owner must make sure that his drivers are properly trained and responsible, and that no one else can operate the trucks at any time.

ALL LOAD CAPACITIES ARE BASED ON EVEN WEIGHT DISTRIBUTION!

REV 08

madix STORE FEATURES P.O. BOX 729 / TERRELL, TEXAS 75160 / 972.563.5744 / 800.776.2348
P.O. BOX 177 / GOODWATER, ALABAMA 36072 / 256.535.6354 / 800.533.5252


REV 08

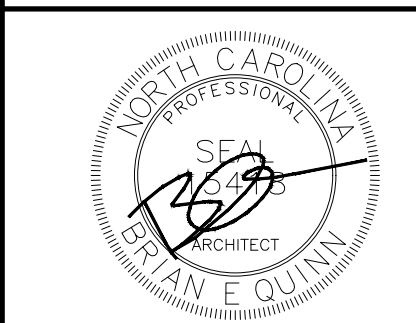

05/17/24

ADA ARCHITECTS

Lakewood, Ohio 44107
17710 Detroit Avenue
Phone (216) 521-5134
Fax (216) 521-4824
www.adaarchitects.com

HARBOR FREIGHT

ERWIN, NC 28839
46 SHRUI LANE

THESE DOCUMENTS CONTAIN INFORMATION PROPRIETARY TO ADA ARCHITECTS, INC. UNAUTHORIZED USE OF THESE DOCUMENTS IS EXPRESSLY PROHIBITED UNLESS AGREED UPON IN WRITING.

REVISIONS	DATE	TYPE
1		
2		
3		
4		
5		
6		
7		
8		
9		
10		

FIXTURE SPECIFICATIONS AND DETAILS

DATE 05/17/24
JOB NO. 23475

A1.11

SHEET NO.

DO NOT SCALE THESE DRAWINGS

PALLET RACK ASY 103

PAGE 7 OF 7

FLOOR ANCHORING



EXPANSION BOLTS FOR FLOOR ANCHORS
 ...4 expansion bolts, 1/2"-13 x 4 1/2" POWERS! Power-Stud + SD2 concrete anchors or other ICC (ICBO) approved expansion bolts.

PRFAK... See below for other ICC (ICBO) approved expansion bolts which may be used.

NOTE! The expansion anchors provided by Madix for floor anchoring at this site have been supplied by one of the firms listed below. All the anchors have been tested and approved as stated by the following ICC (ICBO) report numbers and all are manufactured in the United States or Canada. If the anchors are not provided by Madix and field substitution other than listed be proven, Madix cannot be held responsible. Should verification be required, call Madix Customer Service at:

1.800.776.2349

	ICC (ICBO) #
COBRA ANCHORS CORP., Parawedge concrete anchors	ER-2350 S1
DIVERSIFIED FASTENING SYSTEMS, DFS Wedge anchor	ER-4194 S1
GUINNEBO FASTENING CORP., Drop-in concrete anchors	ER-3219 S1
HILTI, INC., Kwik-bolt-TZ concrete anchors	ESR-1917
ITW RAMSET/RED HEAD, ITW Ramset stud, Trubolt wedge concrete anchor	ESR-2251
MARKSMAN MANUFACTURING CO., Thunderstud wedge and sleeve anchor	ER-2173 S1
POWERS FASTENING INNOV., Power-Stud + SD2 concrete anchors	ESR2502
WEJ-IT, Original Wej-it wedge anchors bolt and ANKR-TITE wedge anchor	ER-1825
CYW, INC., POWER BULL, Wedge anchor	ESR-2254
MKT FASTENING, High Load Anchor SZ	AC193

* Embedment must be minimum 5x bolt diameter.

OTHER ICC (ICBO) APPROVED ANCHORING MATERIALS ...not furnished by Madix

PNEUMATIC OR POWDER-DRIVEN STEEL STUDS AND NAILS	
HILTI, INC., Hilti low velocity powder actuated or pneumatically driven fasteners	ESR-1663
ITW RAMSET/RED HEAD, Ramset Powder-Actuated and PowerPoint fasteners	ESR-1799

ADHESIVE/ EPOXY ANCHORS	
HILTI, INC., HIT-HY 150 Adhesive anchor system	ESR-2678
ITW RAMSET/RED HEAD, ITW Red Head Epoxy system Ceramic 6+ epoxy anchors	ESR-3577

REV#	DATE	BY	DESCRIPTION
A	8/4/03	ACM	REVISED LAYOUT
B1	8/11/03	AJB	CHANGE BEAM SUPPORT INFO
B2	8/19/03	AJB	BEAM LOAD RATE CHANGE

Material Specification

SHEET 1 OF 8



SPECIFICATION #: 80051269 ISSUED BY: JPANTANO DATE: 20190913 ECM #: 500000021849 REVISION: 01

MATERIAL SPECIFICATION: HFTHDWSFP, IMPORT ONLY

Material Thickness or Manufacturer Part Number: _____ Allowed Substitute: WITHIN SPEC Comments: IMPORT ONLY, PACK LOOSE PARTS, SHIPS DISASSEMBLED, FINISH: COLOR MATCH PC005 (LEMON YELLOW)

PART IS EXPOSED SURFACE: _____ PART IS PAINTED: _____ PART IS FORMED 180 DEG: _____

Dimensional Drawing if Required

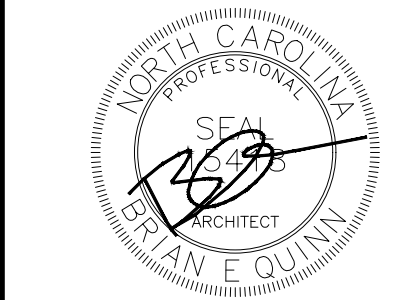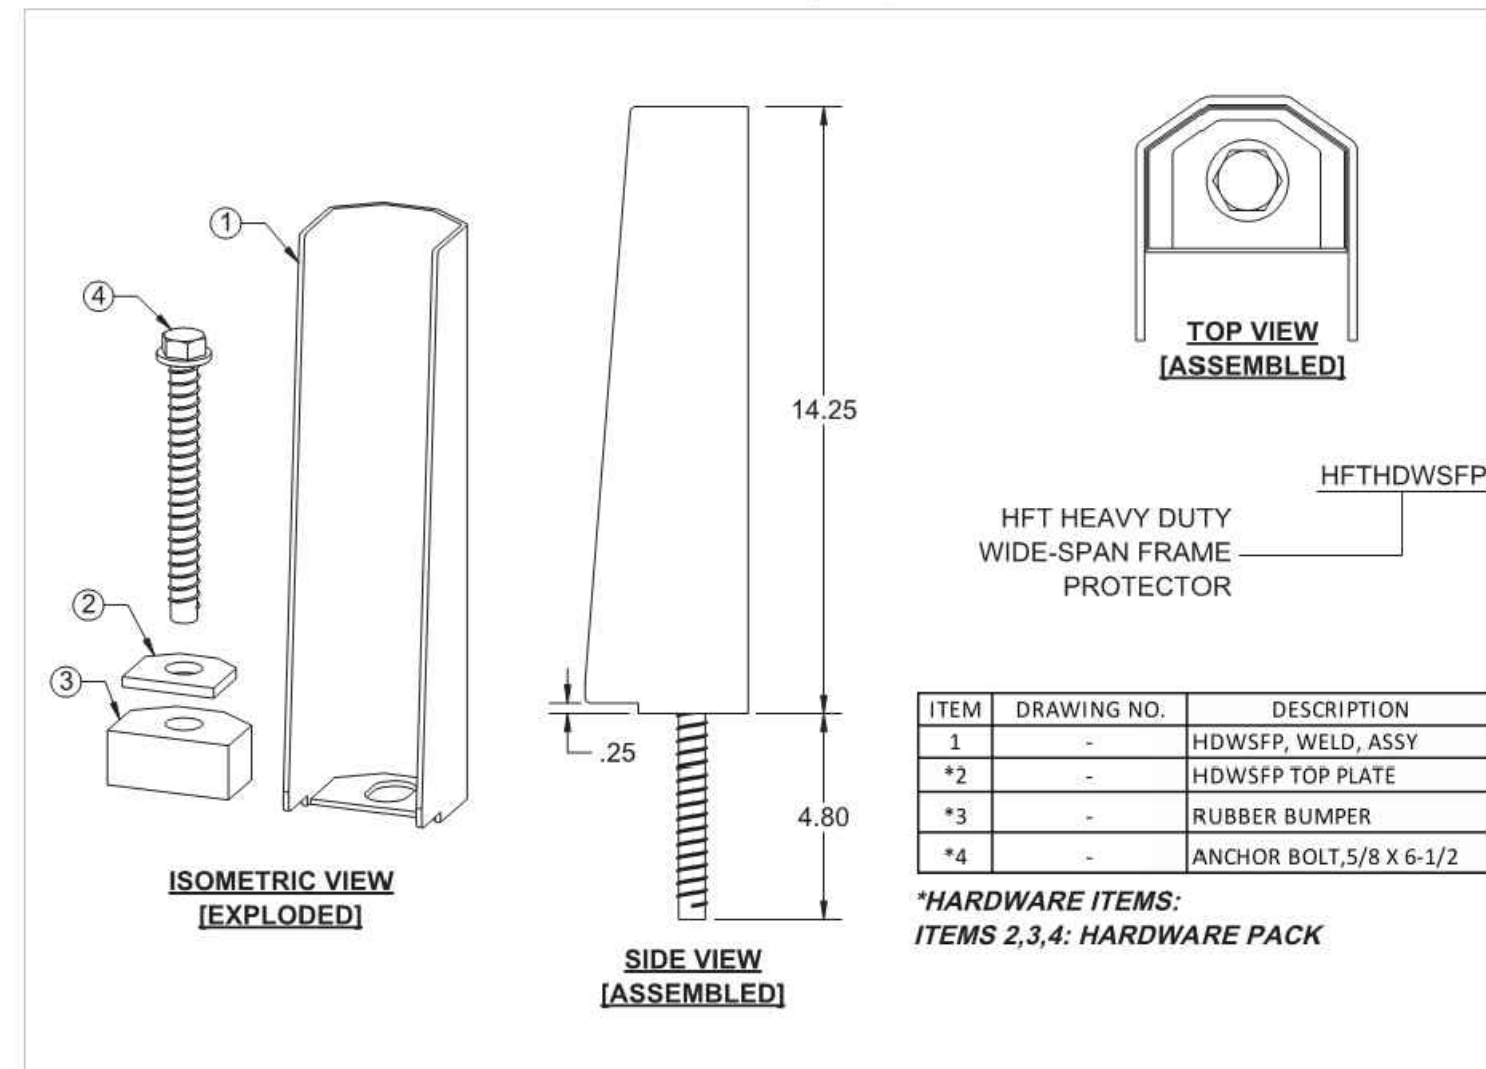

05/17/24

ADA ARCHITECTS

17710 Detroit Avenue
 Phone (216) 521-1534
 Lakewood, Ohio 44107
 Fax (216) 521-4824
 www.adaarchitects.com

HARBOR FREIGHT

46 SHRUI LANE
 ERWIN, NC 28839

THESE DOCUMENTS CONTAIN INFORMATION PROPRIETARY TO ADA ARCHITECTS, INC. UNAUTHORIZED USE OF THESE DOCUMENTS IS EXPRESSLY PROHIBITED UNLESS AGREED UPON IN WRITING.

DO NOT SCALE THESE DRAWINGS


REVISIONS	
#	DATE
1	
2	
3	
4	
5	
6	
7	
8	
9	
10	

FIXTURE SPECIFICATIONS AND DETAILS

DATE: 05/17/24
 JOB NO.: 23475

A1.12

SHEET NO.

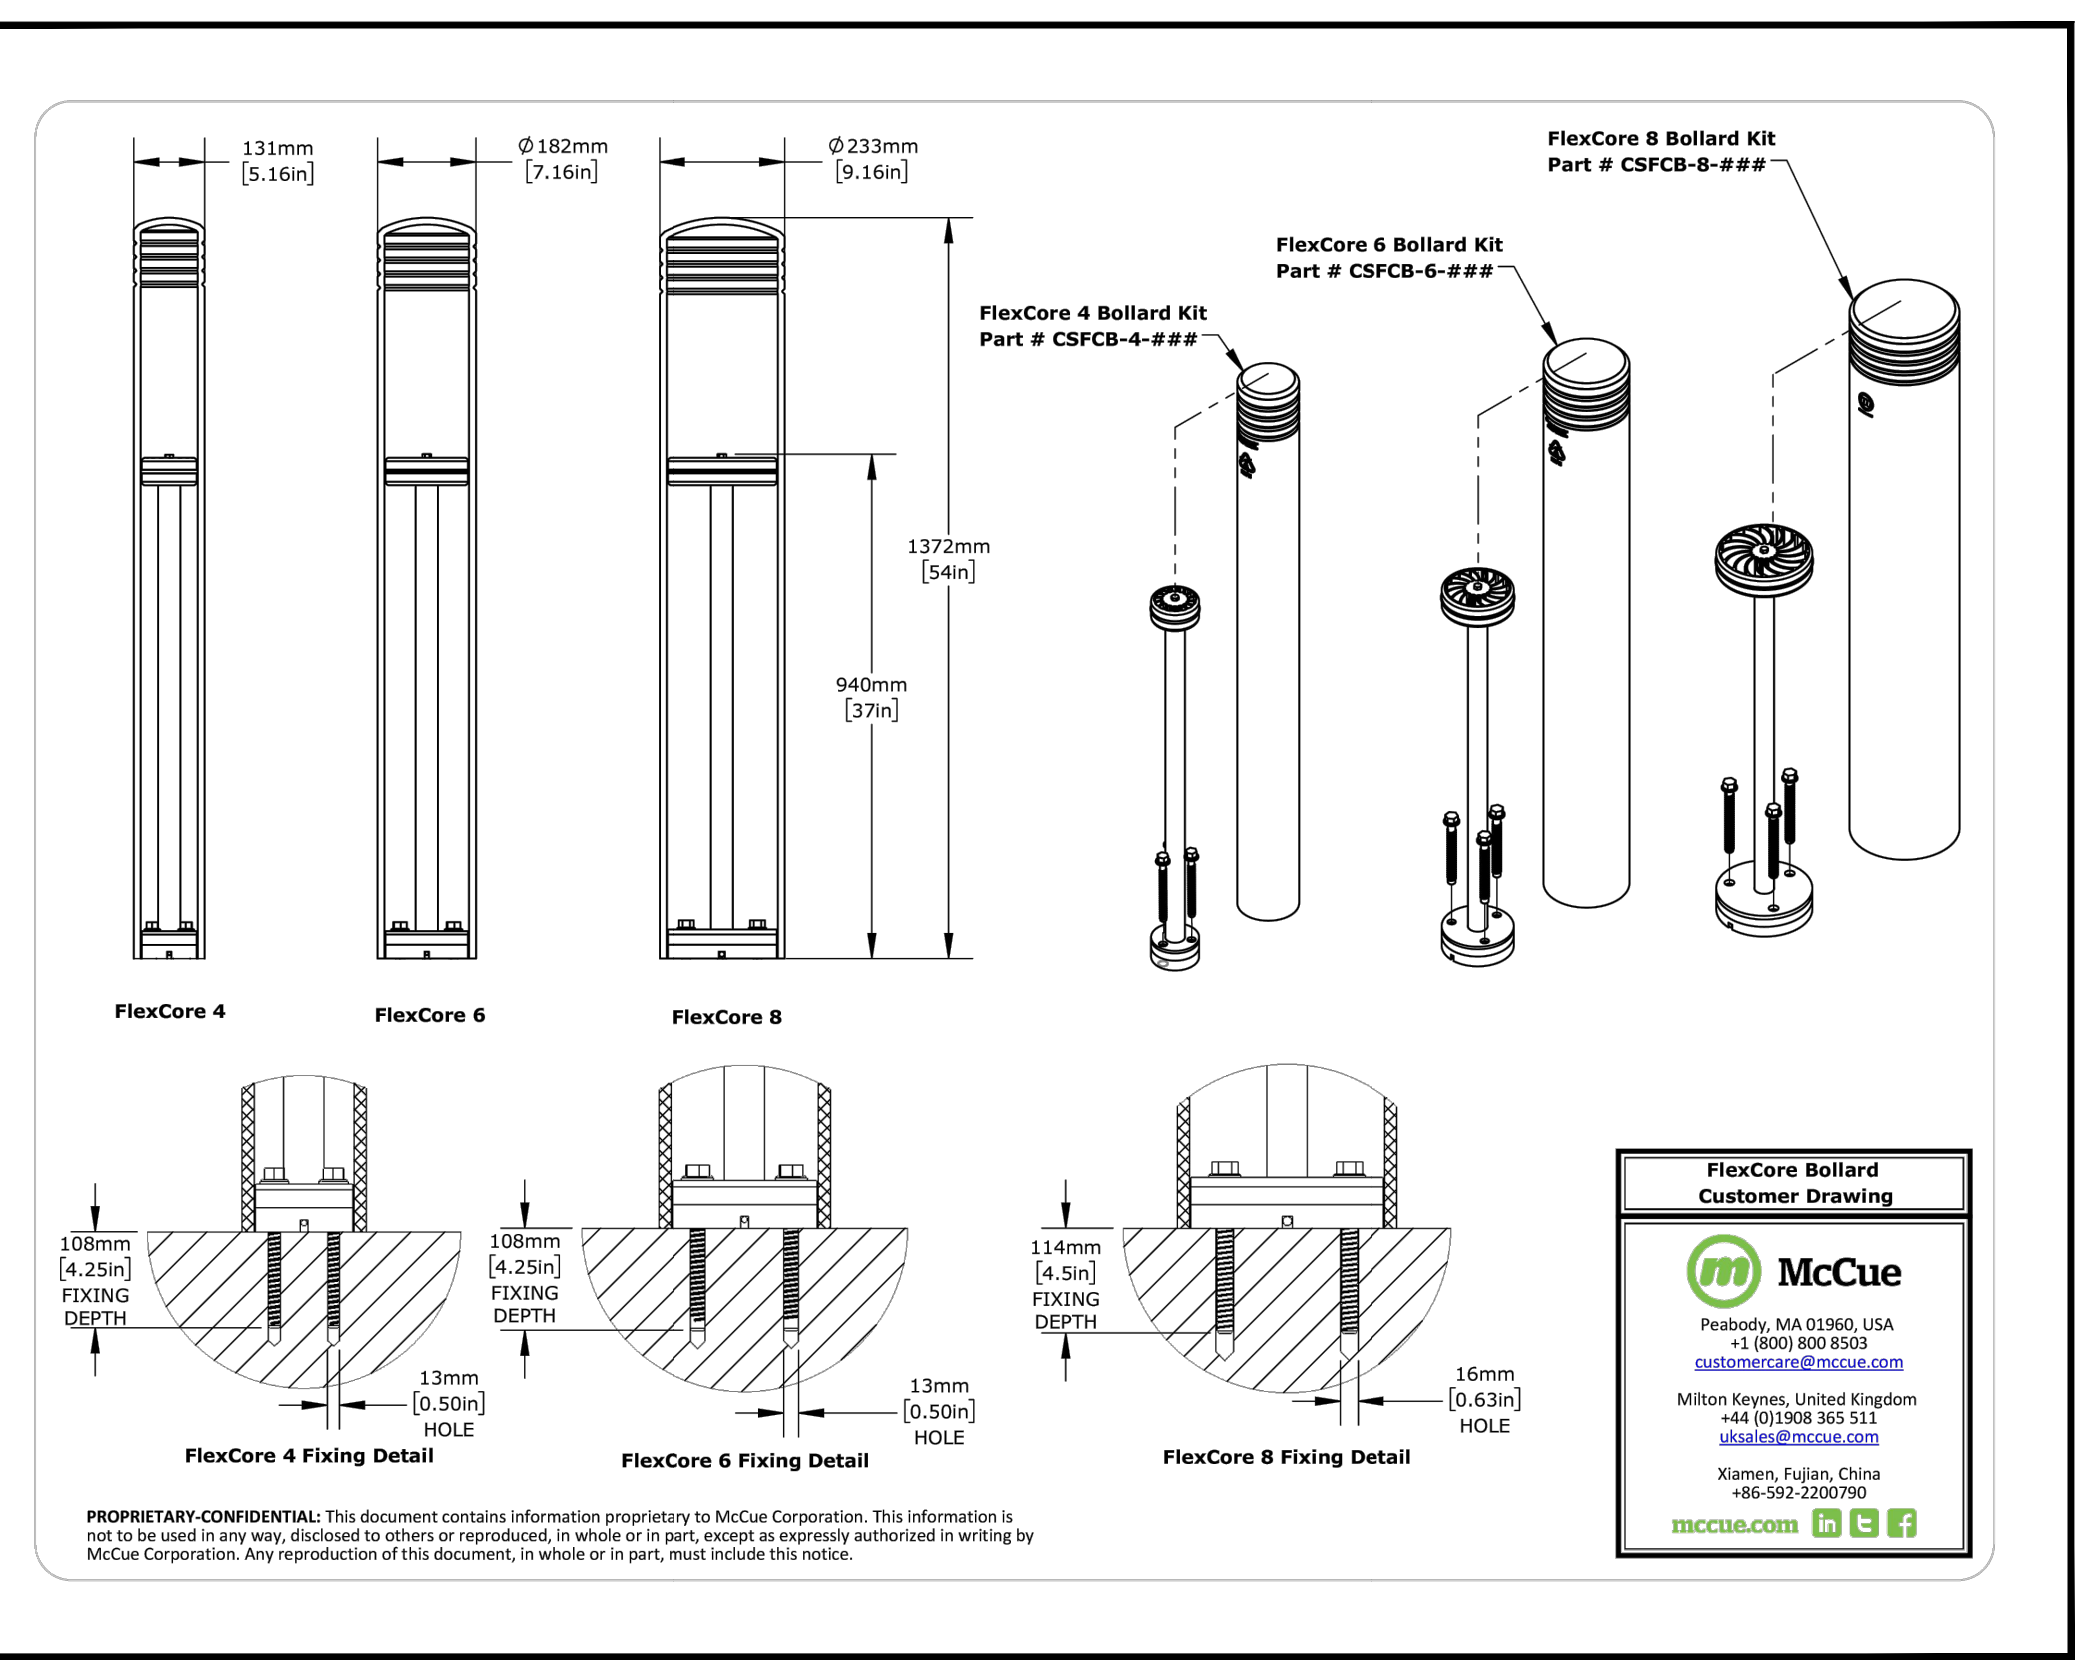



05/17/24

CEILING PLAN LEGEND


2' X 4' RECESSED LIGHT FIXTURE SEE ELECTRICAL DRAWINGS FOR ADDITIONAL INFORMATION		SUPPLY AIR DIFFUSER SEE MECHANICAL PLANS FOR ADDITIONAL INFORMATION	
8' SURFACE MOUNTED LIGHT FIXTURE SEE ELECTRICAL DRAWINGS FOR ADDITIONAL INFORMATION		RETURN AIR DIFFUSER SEE MECHANICAL PLANS FOR ADDITIONAL INFORMATION	
4' SURFACE MOUNTED LIGHT FIXTURE SEE ELECTRICAL DRAWINGS FOR ADDITIONAL INFORMATION		EXHAUST FAN SEE MECHANICAL PLANS FOR ADDITIONAL INFORMATION	
EXTERIOR WALL MOUNTED LIGHT FIXTURE SEE ELECTRICAL DRAWINGS FOR ADDITIONAL INFORMATION		ELECTRIC UNIT HEATER SEE MECHANICAL PLANS FOR ADDITIONAL INFORMATION	
EXTERIOR SURFACE MOUNTED LIGHT FIXTURE SEE ELECTRICAL DRAWINGS FOR ADDITIONAL INFORMATION		GAS FIRED UNIT HEATER SEE MECHANICAL PLANS FOR ADDITIONAL INFORMATION	

CEILING PLAN GENERAL NOTES


- REFER TO GENERAL NOTES OF SHEET A0.2 FOR ADDITIONAL INFORMATION.
- HFT G.C. TO VISIT SITE AND VERIFY EXISTING CONDITIONS PRIOR TO SUBMITTING PROPOSALS AND COMMENCING WORK.
- HFT G.C. TO NOTIFY HFT PROJECT MANAGER IMMEDIATELY AFTER DEMOLITION OR START OF CONSTRUCTION, IF PROPOSED CEILING HEIGHTS & MECHANICAL REQUIREMENTS CAN NOT BE ACHIEVED FOR ANY REASON.
- HFT G.C. IS RESPONSIBLE FOR PATCHING & REPAIRING ALL FIREPROOFING AS REQUIRED DUE TO PRIOR TENANT CONSTRUCTION AND DUE TO ANY NEW DEMOLITION OR NEW CONSTRUCTION TO MEET BOTH LANDLORD AND BUILDING DEPARTMENT REQUIREMENTS.
- HFT G.C. TO PROVIDE CEILING ACCESS PANELS AS REQUIRED TO ACCOMMODATE ELECTRICAL, PLUMBING, SPRINKLER AND / OR MECHANICAL SERVICES THAT PASS THROUGH THE LEASED PREMISES, IE., J-BOXES, DUCT SMOKE DETECTORS, FIRE DAMPERS, FLOW SWITCHES, UTILITY CONNECTION POINTS, ETC.
- SUSPENSION WIRES SHALL BE INSTALLED WITH A MAXIMUM SPACING OF 48" O.C.
- ALL LAY-IN CEILING GRIDS SHALL BE CENTERED IN ROOM U.N.O.
- SEE FP1.0 FOR SPRINKLER INFORMATION.

500 SERIES CEILING PLAN KEY NOTES


- 26" ULINE FULL DOME SAFETY MIRROR. G.C. TO PROVIDE AND INSTALL CHAINS TO STRUCTURE AS REQUIRED TO MOUNT MIRROR AT 10'-0" A.F.F. SEE DETAIL 3 THIS SHEET FOR ADDITIONAL INFORMATION.
- 2' x 4' SUSPENDED CEILING SYSTEM INSTALLED PER MANUFACTURERS SPECIFICATIONS. SEE FINISH SCHEDULE ON A1.3 FOR ADDITIONAL INFORMATION. CEILING TO BE CENTERED IN ROOM U.N.O.
- APPROXIMATE LOCATION OF NEW HVAC ROOFTOP UNIT. G.C. TO CONTRACT WITH LANDLORD ROOFING CONTRACTOR TO MAINTAIN ALL ROOFING WARRANTIES. REFER TO DETAIL 1A2.0, STRUCTURAL, AND MECHANICAL DRAWINGS.
- REWORK EXISTING SPRINKLER SYSTEM TO WORK WITH ROOM LAYOUT. SEE FP1.0 FOR ADDITIONAL INFORMATION.
- EXPOSED STRUCTURE. REMOVE ANY UNUSED EQUIPMENT, WIRES, HANGERS, ETC. FROM STRUCTURE AREA. PAINT ENTIRE STRUCTURE PER FINISH SCHEDULE ON SHEET A1.3.
- NEW LIGHT FIXTURES THROUGHOUT ENTIRE HFT SPACE, UNLESS NOTED OTHERWISE. SEE ELECTRICAL DRAWINGS FOR ADDITIONAL INFORMATION.
- SUPPLY AND RETURN AIR DIFFUSERS OCCUR AT ROOM LOCATIONS. SEE MECHANICAL DRAWINGS FOR ADDITIONAL INFORMATION.
- MOUNT OX-BLUE CAMERAS PER DETAIL 2 THIS SHEET, 12'-0" FROM THE CORNERS OF THE SPACE AT 45° ACROSS THE SALES AND STOCK AREAS. CAMERAS ARE TO BE MOUNTED AT OPPOSITE CORNERS OF THE SPACE. COORDINATE WITH HFT PM FOR FINAL QUANTITIES AND LOCATIONS.
- EXISTING WALL MOUNTED EXTERIOR LIGHT FIXTURE. SEE ELECTRICAL DRAWINGS FOR ADDITIONAL INFORMATION.
- STANDING SEAM METAL ENTRY CANOPY BY LANDLORD UNDER A SEPARATE PERMIT.
- OVERHEAD COIL-UP DOOR HOUSING. SEE SHEET A5.0 FOR ADDITIONAL INFORMATION.
- GYPSUM BOARD SHELF AT 8'-0" A.F.F. TO BE PAINTED. SEE SHEET A1.3 AND DETAIL 1A4.1 FOR ADDITIONAL INFORMATION.
- ELECTRIC UNIT HEATER CABINET. SEE MECHANICAL DRAWINGS FOR ADDITIONAL INFORMATION.
- UNDER CANOPY LIGHTING. SEE ELECTRICAL DRAWINGS FOR ADDITIONAL INFORMATION.
- GAS FIRED UNIT HEATER. SEE MECHANICAL DRAWINGS FOR ADDITIONAL INFORMATION.
- APPROXIMATE LOCATION OF NEW DUCT WORK. SEE MECHANICAL DRAWINGS FOR ADDITIONAL INFORMATION.

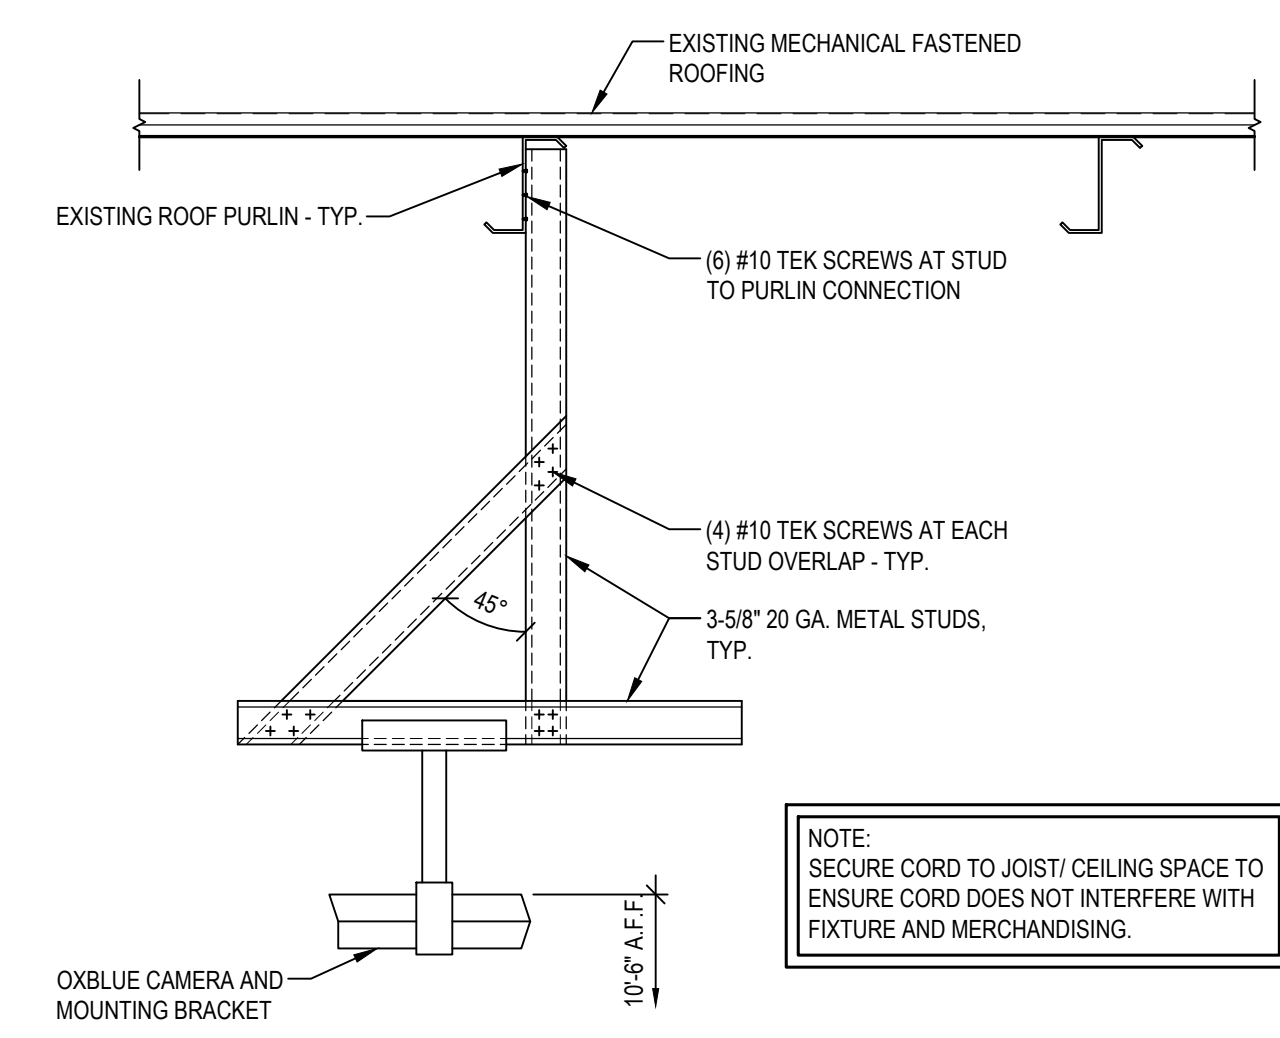


2 OXBLUE MOUNTING DETAIL
SCALE: 3/4" = 1'-0"

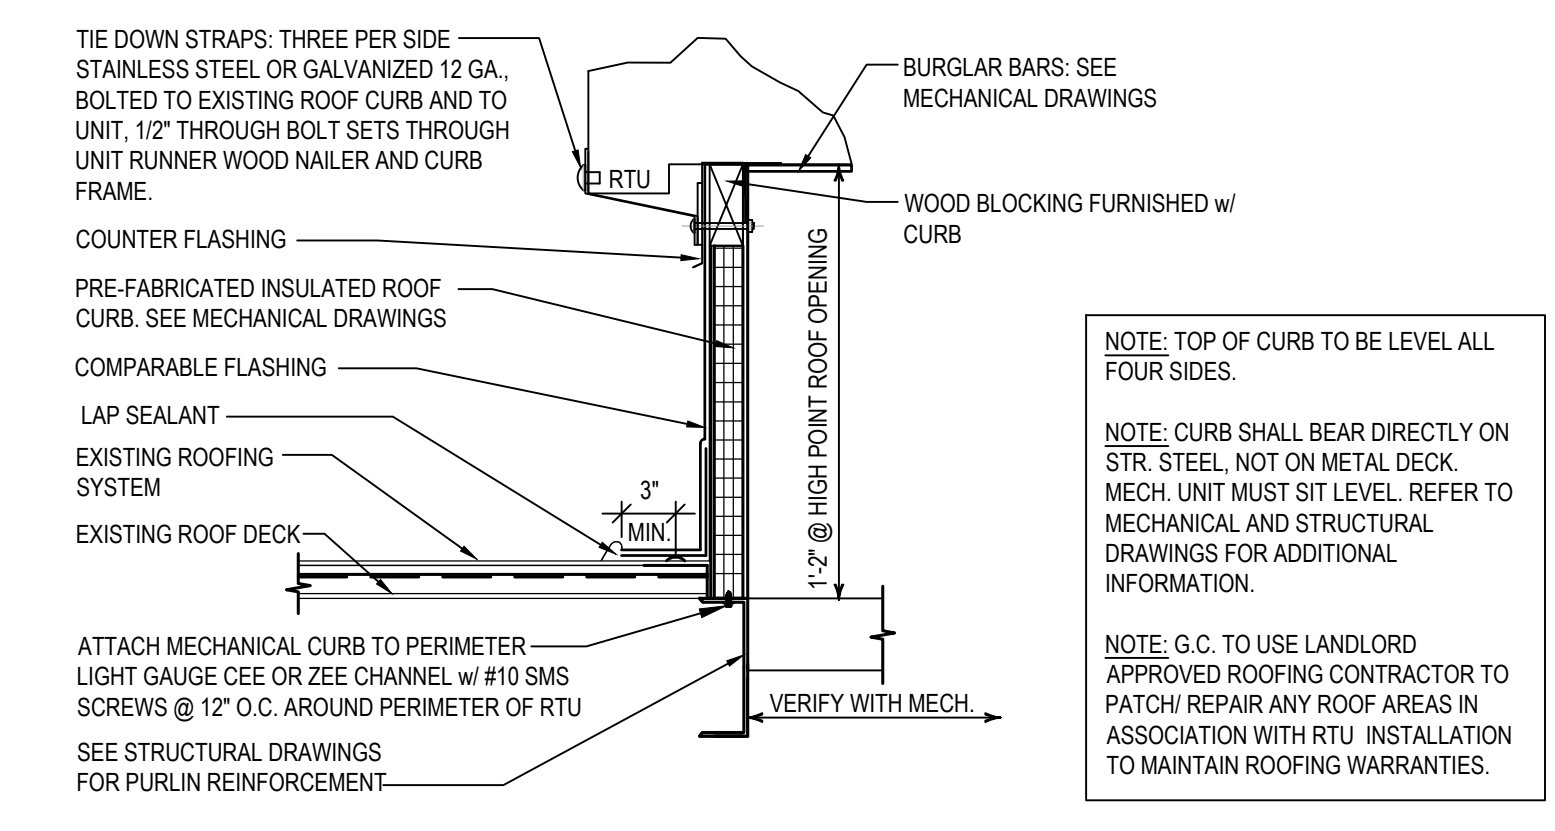

1 MECHANICAL ROOF CURB DETAIL
SCALE: 3/4" = 1'-0"

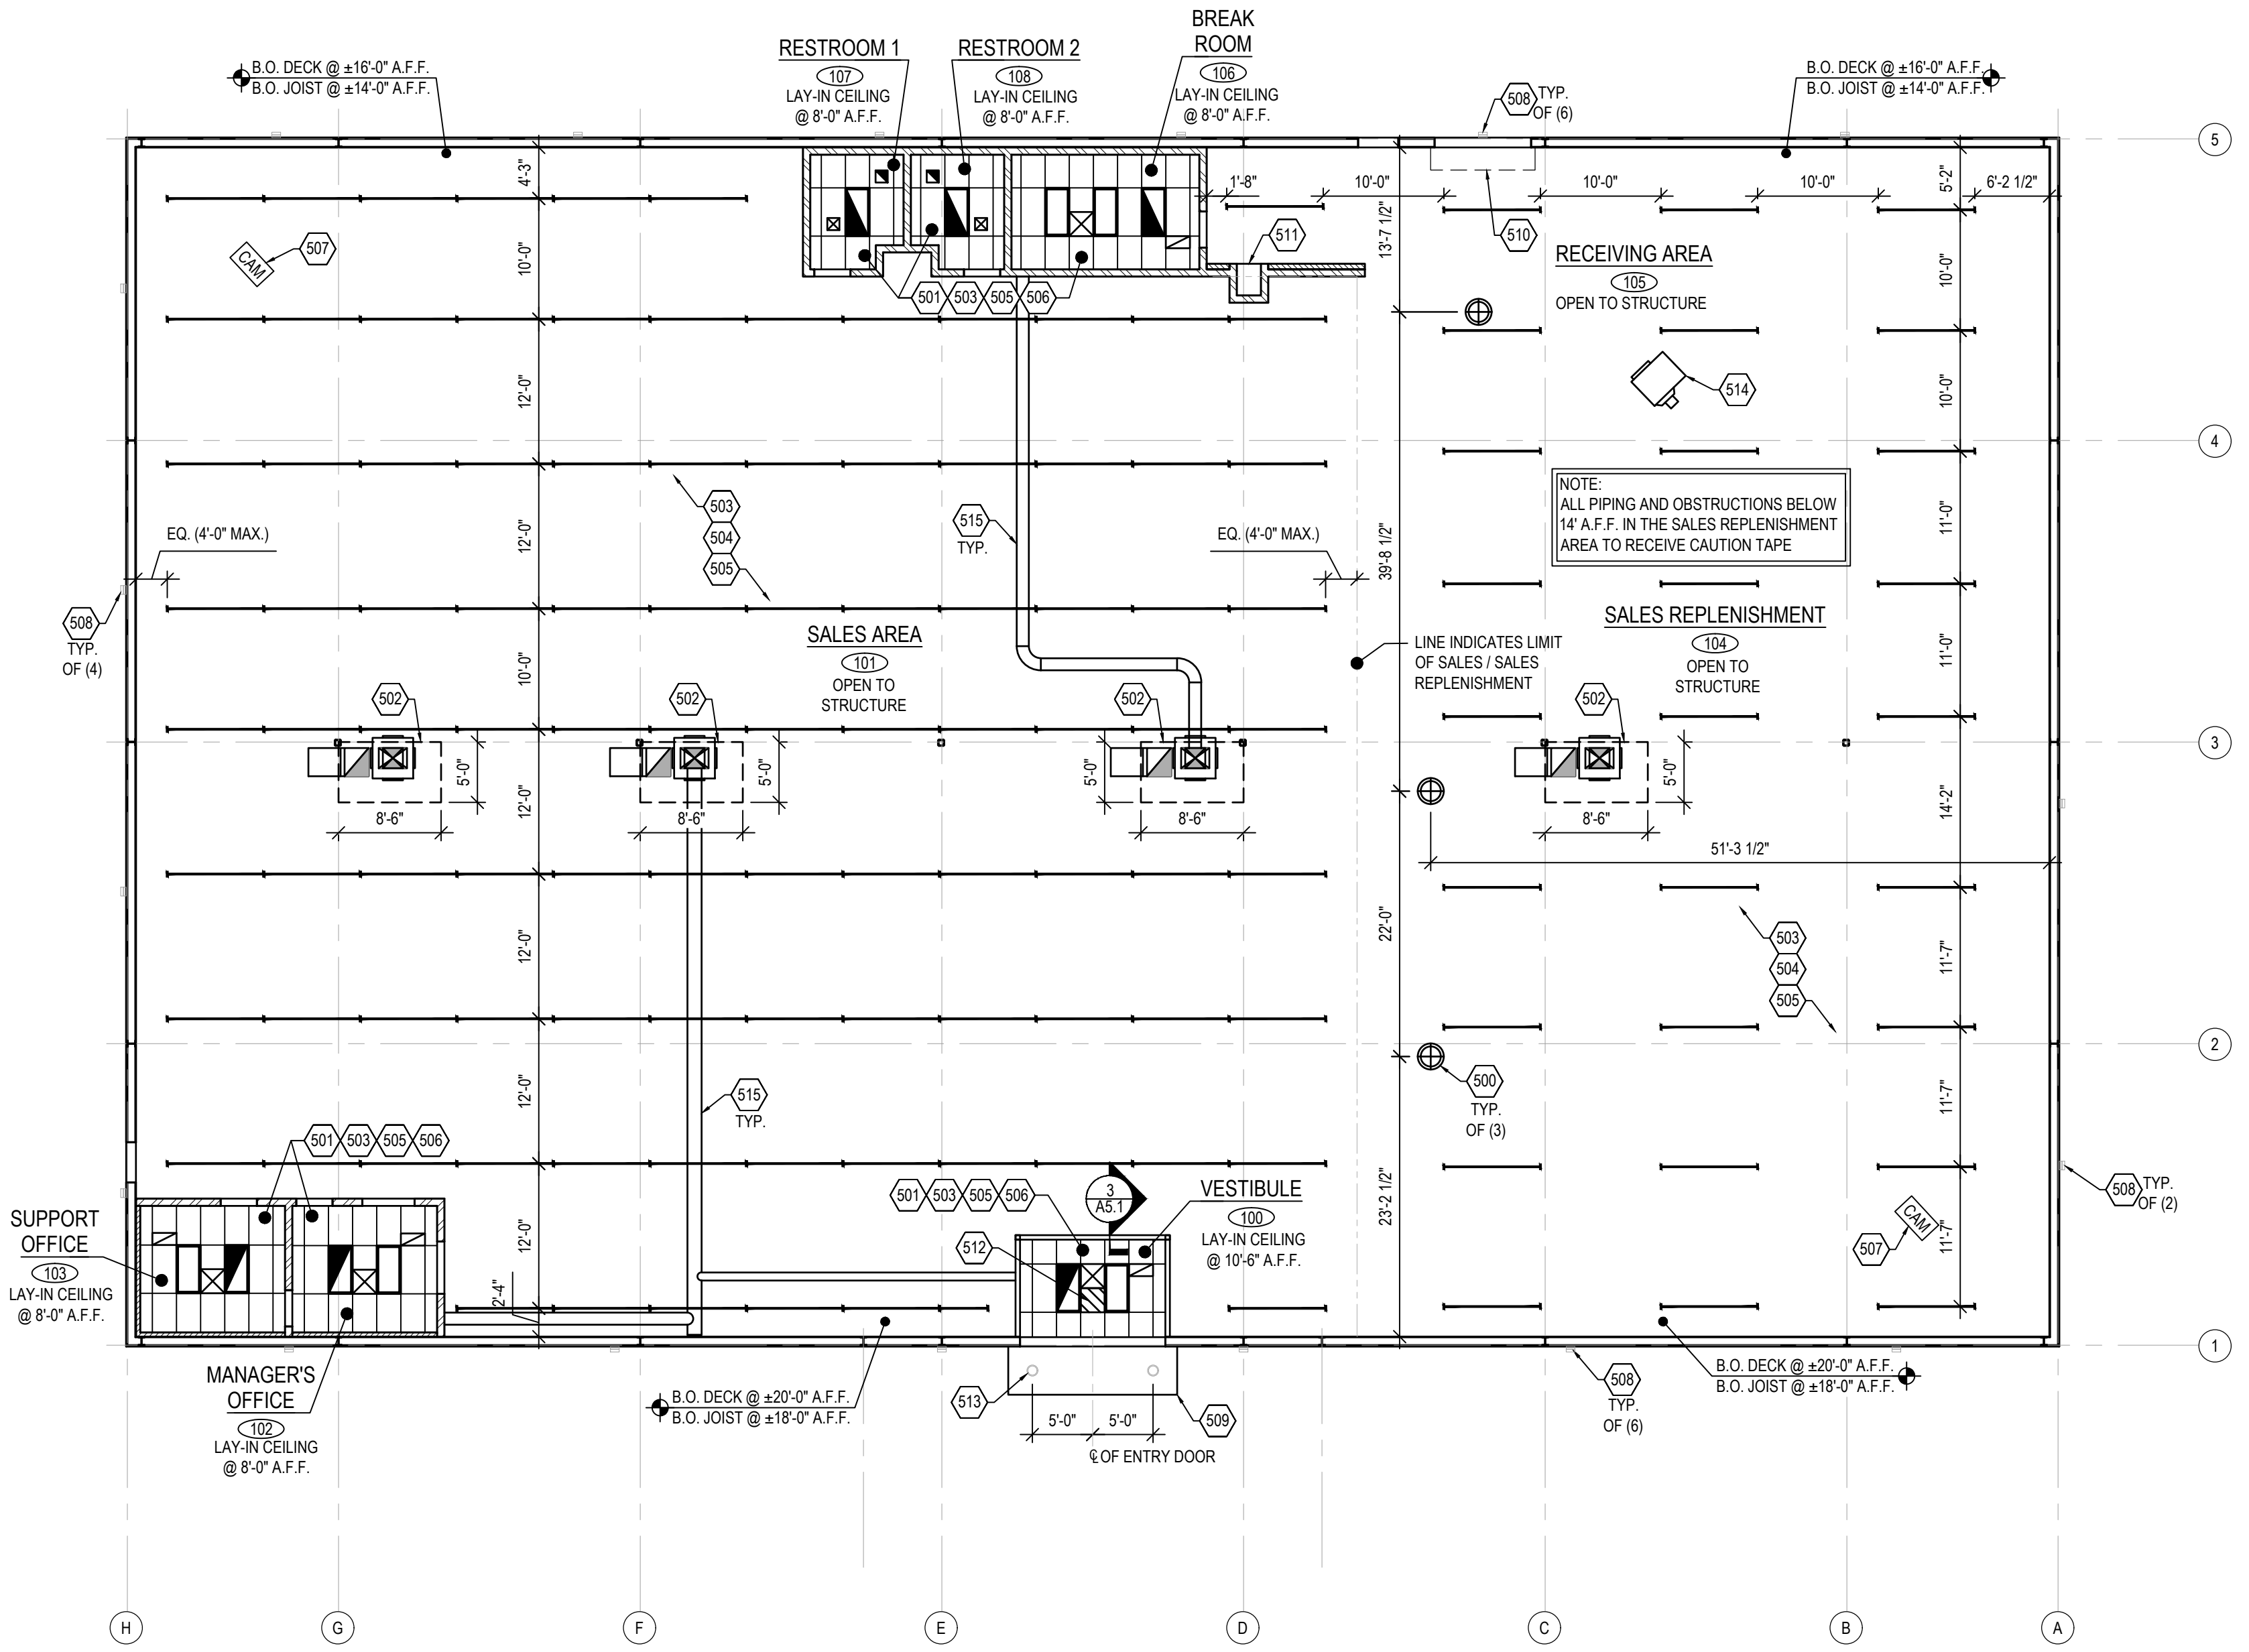

REFLECTED CEILING PLAN
SCALE 3/32" = 1'-0"

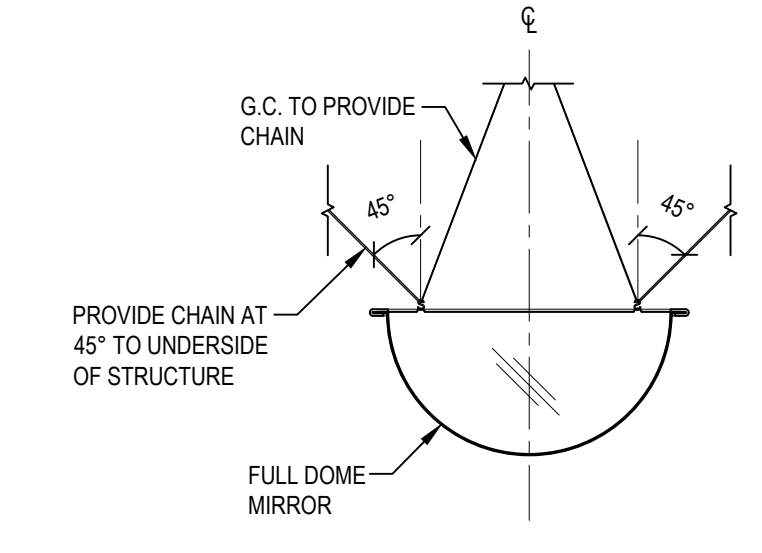

- NOTE:
- BRACING CHAIN SECURED TO MAIN DOME WITHIN 2" OF THE CROSS BRACING INTERSECTION AND PLAYED 90° FROM EACH OTHER AT AN ANGLE NOT EXCEEDING 45° FROM THE PLAN OF THE CEILING.
 - THE SUSPENDED CEILING DOMES SHALL COMPLY WITH CBC 808 AND SEISMIC DESIGN PER ASCE 7-10.
 - SEE MANUFACTURERS INSTRUCTIONS FOR ADDITIONAL INFORMATION.

3 SUSPENDED FULL DOME MIRROR DETAIL
SCALE: 3/4" = 1'-0"

DO NOT SCALE THESE DRAWINGS

REVISIONS	
#	DATE
1	
2	
3	
4	
5	
6	
7	
8	
9	
10	

REFLECTED CEILING PLAN

DATE 05/17/24
JOB NO. 23475

A2.0

SHEET NO.


ADA ARCHITECTS

17710 Detroit Avenue
Lakewood, Ohio 44107
Phone (216) 521-5134 Fax (216) 521-4824
www.adaarchitects.com


HARBOR FREIGHT

46 SHRUI LANE
ERWIN, NC 28839


THESE DOCUMENTS CONTAIN INFORMATION PROPRIETARY TO ADA ARCHITECTS, INC.
UNAUTHORIZED USE OF THESE DOCUMENTS IS EXPRESSLY PROHIBITED UNLESS AGREED UPON IN WRITING.

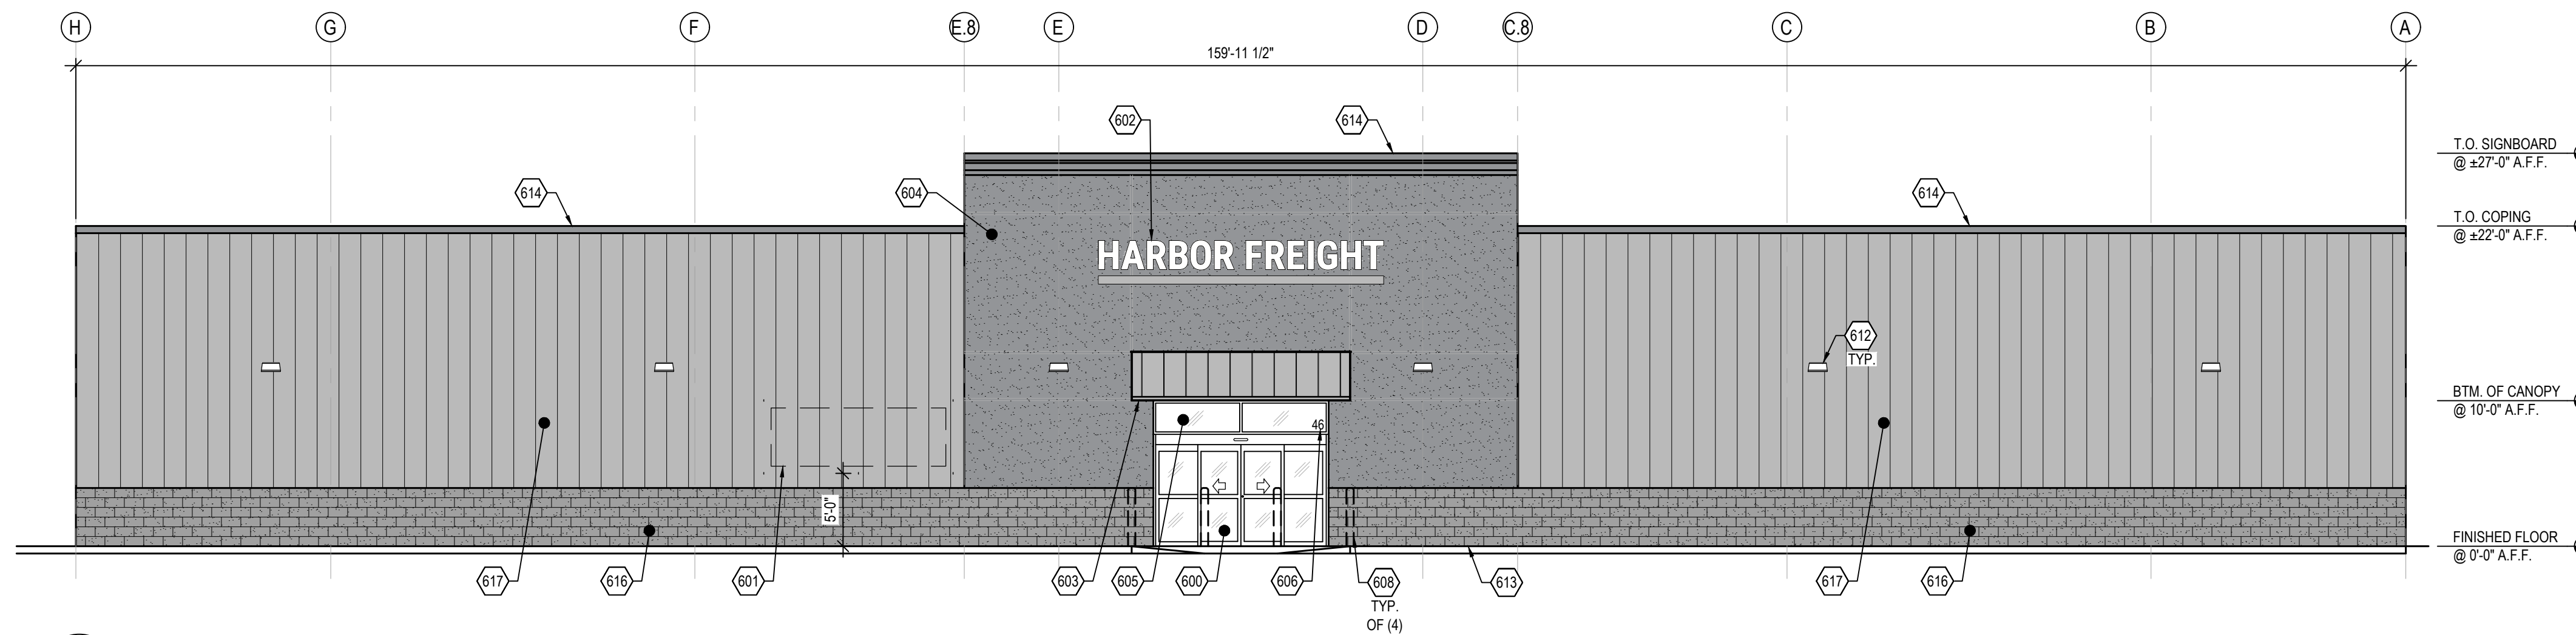


1 NORTH ELEVATION
A3.0 SCALE: 1/8" = 1'-0"

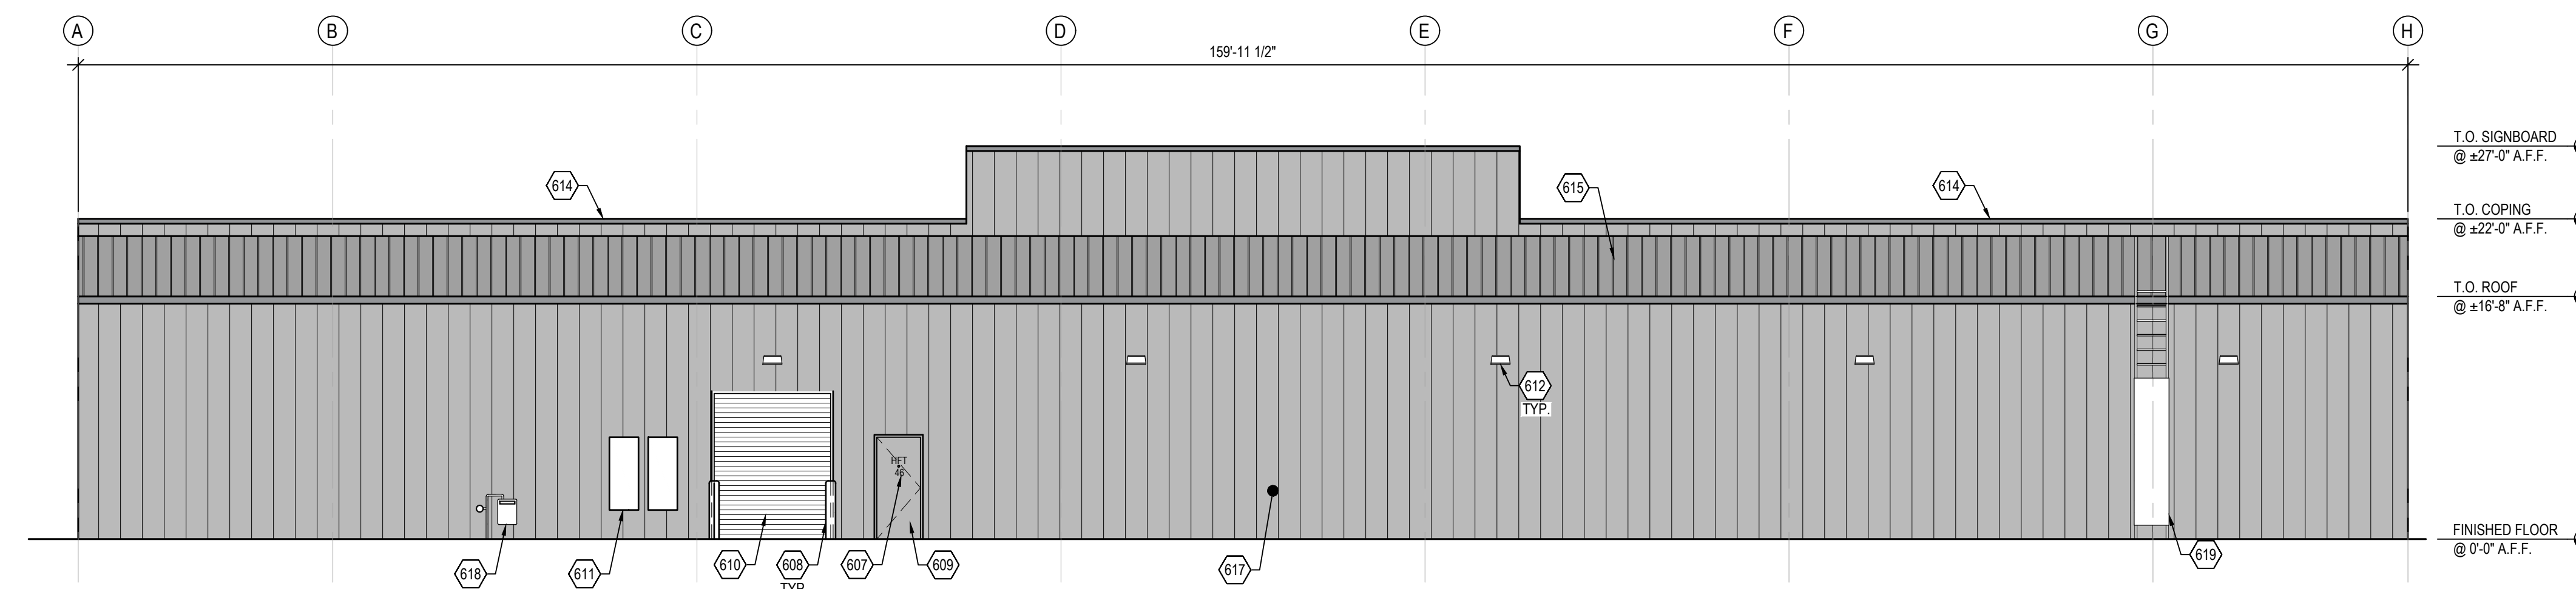

2 SOUTH ELEVATION
A3.0 SCALE: 1/8" = 1'-0"

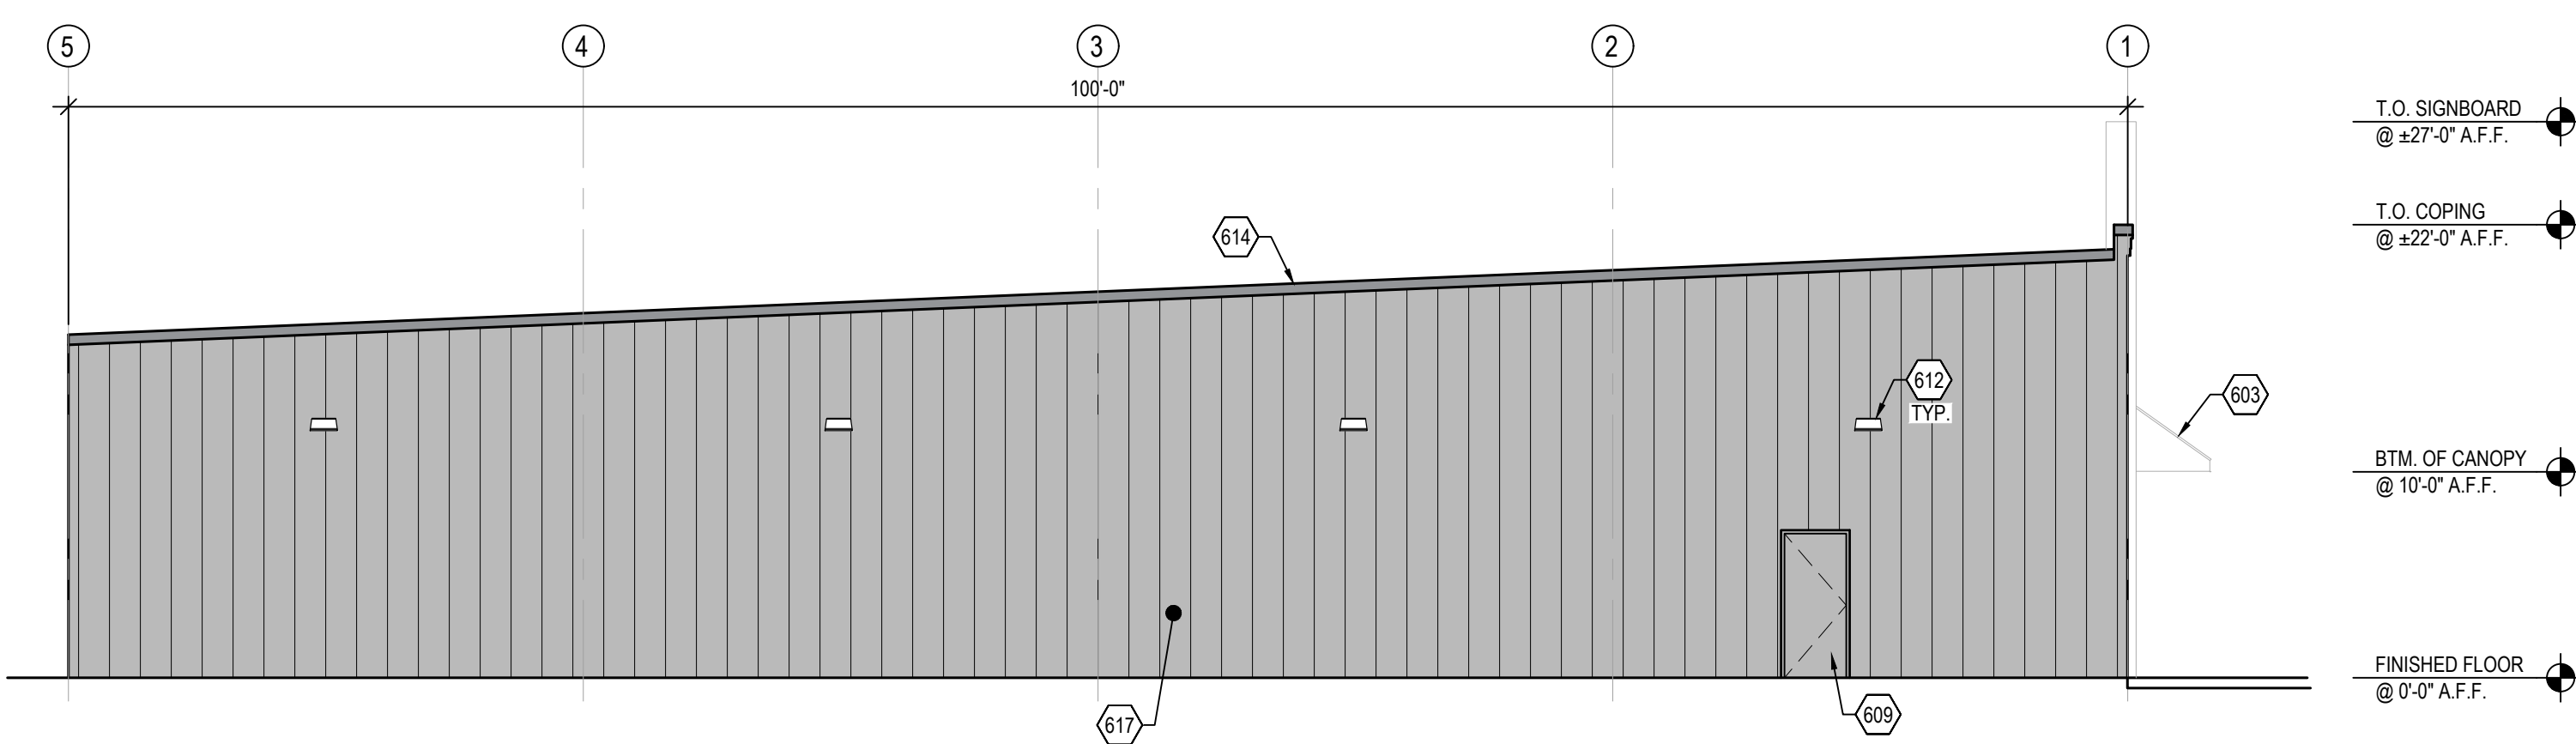

3 EAST ELEVATION
A3.0 SCALE: 1/8" = 1'-0"

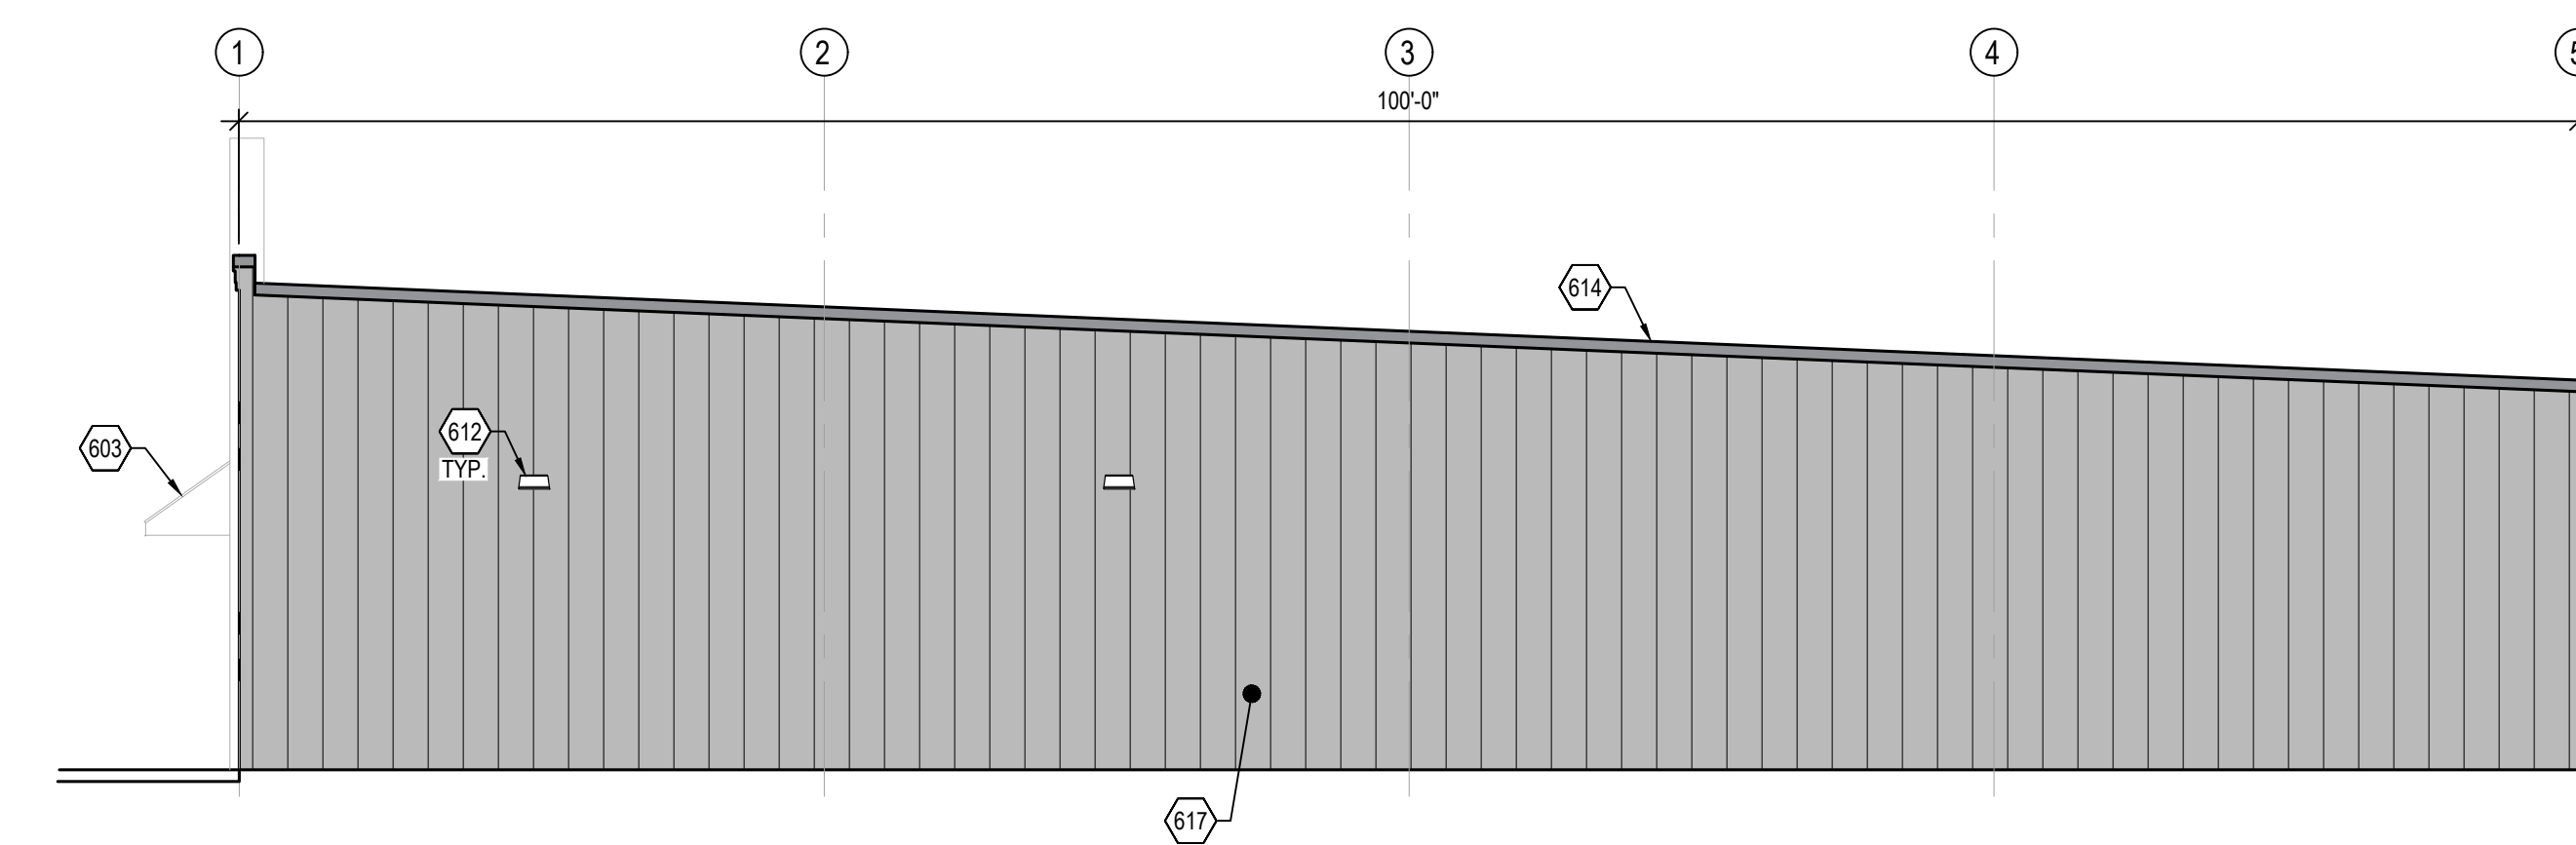

4 WEST ELEVATION
A3.0 SCALE: 1/8" = 1'-0"

GENERAL NOTES


- REFER TO GENERAL NOTES ON SHEET A0.2 FOR ADDITIONAL INFORMATION.
- SIGNAGE PERMIT DRAWINGS TO BE SUBMITTED SEPARATELY.
- HFT GENERAL CONTRACTOR TO VISIT SITE AND VERIFY EXISTING CONDITIONS PRIOR TO SUBMITTING PROPOSALS AND COMMENCING WORK.
- SIGNAGE SHOWN FOR REFERENCE ONLY - ACTUAL SIGNAGE SIZE AND TYPE TO BE DETERMINED BY HFT AND LANDLORD.
- ALL SIGNAGE TO COMPLY WITH LANDLORD TENANT CRITERIA AND STATE / LOCAL CODES.
- COORDINATE WITH SIGNAGE VENDOR FOR ANY SPECIFIC CRITERIA TO BE USED.
- ALL SIGNAGE TO BE UL RATED.
- EXISTING STOREFRONT CONSTRUCTION AND FINISHES TO REMAIN U.N.O.
- WHERE A SURFACE IS NOTED TO BE PAINTED, PAINTING SHALL INCLUDE SURFACE PREPARATION FOR PAINT ACCORDING TO PAINT MANUFACTURER RECOMMENDATIONS.
- EXISTING UNPAINTED SURFACES TO REMAIN UNPAINTED, PAINTED SURFACES TO BE RE-PAINTED U.N.O.

600 SERIES ELEVATION KEY NOTES

- EXISTING DORMA BI-PARTING DOOR SYSTEM. SEE SHEETS A5.0 AND A5.1 FOR ADDITIONAL INFORMATION.
- SIGNAGE BANNER. PROVIDE 3/8" GALVANIZED EYELETS SPACED AS SHOWN ON DETAIL A/A3.0.
- APPROXIMATE LOCATION OF HFT EXTERIOR BUILDING SIGN. BUILDING SIGNAGE PROVIDED AND INSTALLED BY HFT SIGN VENDOR. HFT GENERAL CONTRACTOR TO COORDINATE ACTUAL SIGNAGE LOCATION WITH FINAL APPROVED BRANDBOOK. LOCATION AND SIZE SHOWN ARE APPROXIMATE. ALL SIGNAGE IS BY SEPARATE PERMIT. G.C. TO PROVIDE AND INSTALL SIGNAGE BLOCKING AND POWER AS COORDINATED WITH SIGNAGE VENDOR. G.C. IS RESPONSIBLE FOR PATCH AND REPAIR OF WALL / ROOF WHERE AFFECTED BY SIGNAGE INSTALL. G.C. TO CONTRACT WITH LANDLORD'S ROOFING CONTRACTOR FOR ALL ROOFING WORK TO MAINTAIN ALL ROOFING WARRANTIES.
- EXISTING STANDING SEAM METAL ENTRY CANOPY TO REMAIN. COLOR: COBALT BLUE.
- EXISTING EIFS SIGNBOARD BY LANDLORD TO REMAIN. COLOR: SAFETY RED.
- EXISTING ALUMINUM FRAME TRANSOM SYSTEM TO REMAIN. G.C. TO PROTECT DURING CONSTRUCTION.
- PROVIDE 8" HIGH WHITE VINYL NUMBERS STATING STREET ADDRESS IN HELVETICA FONT STYLE ON TRANSOM. SEE DOOR SCHEDULE NOTES ON SHEETS A5.0 AND A5.1 FOR ADDITIONAL INFORMATION.
- PROVIDE 6" HIGH VINYL LETTERING STATING "HFT" AND STREET ADDRESS IN HELVETICA FONT. COLOR TO CONTRAST WITH DOOR.
- EXISTING BOLLARD TO REMAIN. SEE SHEET A1.1 FOR ADDITIONAL INFORMATION.
- EXISTING HOLLOW METAL DOOR TO REMAIN. SEE SHEETS A1.3 AND A5.0 FOR ADDITIONAL INFORMATION.
- EXISTING OVERHEAD DOOR TO REMAIN. SEE DOOR SCHEDULE ON SHEET A5.0 FOR ADDITIONAL INFORMATION.
- APPROXIMATE LOCATION OF EXISTING EXTERIOR ELECTRICAL EQUIPMENT. SEE ELECTRICAL DRAWINGS FOR ADDITIONAL INFORMATION.
- EXISTING WALL MOUNTED LIGHT FIXTURE TO REMAIN. SEE ELECTRICAL DRAWINGS FOR ADDITIONAL INFORMATION.
- EXISTING CONCRETE WALK.
- EXISTING COPING TO REMAIN. COLOR: CHARCOAL GRAY.
- EXISTING STANDING SEAM METAL ROOF BY LANDLORD TO REMAIN. COLOR: GALVALUME.
- EXISTING PAINTED CMU SPLIT FACE VENEER BY LANDLORD TO REMAIN. COLOR: CITYSCAPE.
- EXISTING R PANEL SYSTEM BY LANDLORD TO REMAIN. COLOR: ASH GRAY.
- APPROXIMATE LOCATION OF GAS METER BY LANDLORD TO REMAIN. SEE PLUMBING DRAWINGS FOR ADDITIONAL INFORMATION.
- EXISTING LADDER WITH GUARD BY LANDLORD UNDER A SEPARATE PERMIT.

NOTES

- HARBOR FREIGHT USES ONE STANDARD SIZE BANNER (4' X 12')
- EYELETS FOR THIS BANNER TO BE GALVANIZED
- ALL ITEMS SUPPLIED BY HFT, UNDER SKU #81487, EXCEPT (3) 5/16" X 4 1/4" SCREW HOOKS AND (2) 5/16" X 4 1/4" EYELETS
- G.C. TO ENSURE EYELETS ARE INSTALLED TO SUITABLE BLOCKING MATERIAL AND CAPABLE OF WITHSTANDING WIND FORCES.
- G.C. TO VERIFY WITH HFT P.M. IF EYELETS ARE ALLOWED PRIOR TO INSTALLATION.

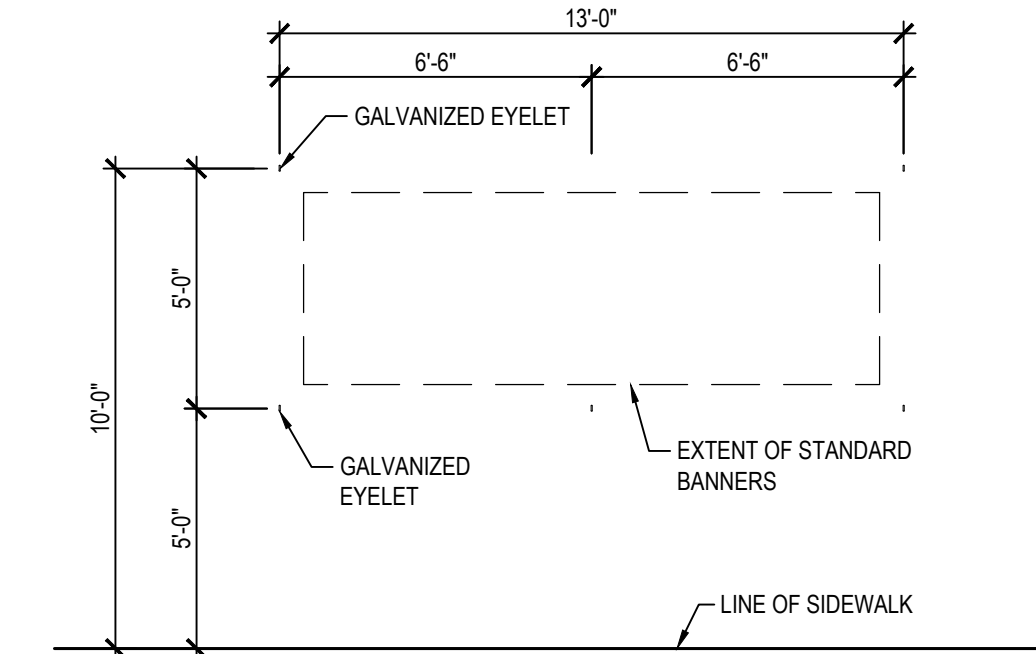

A EYELET AND SCREW HOOK SPACING DETAIL
A3.0 SCALE: 1/4" = 1'-0"

HARBOR FREIGHT

46 SHRUI LANE
ERWIN, NC 28839

THESE DOCUMENTS CONTAIN INFORMATION PROPRIETARY TO ADA ARCHITECTS, INC.
UNAUTHORIZED USE OF THESE DOCUMENTS IS EXPRESSLY PROHIBITED UNLESS AGREED UPON IN WRITING.

Lakewood, Ohio 44107
17710 Detroit Avenue
Phone (216) 521-1534
Fax (216) 521-4824
www.adaarchitects.com

REVISIONS


#	DATE	TYPE
1		
2		
3		
4		
5		
6		
7		
8		
9		
10		

EXTERIOR ELEVATIONS


DATE
JOB NO. 23475

A3.0


SHEET NO.

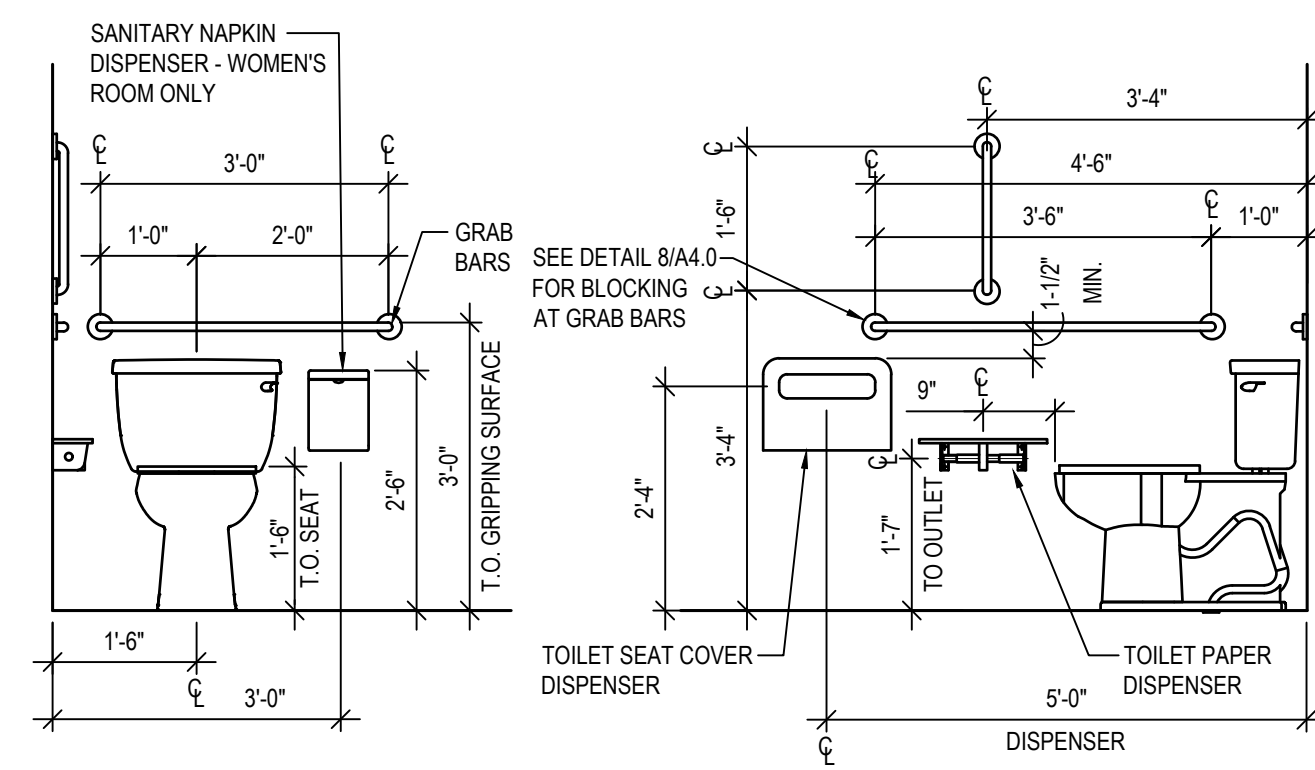


3 ACCESSIBLE WATER CLOSET ELEVATIONS
A4.0 SCALE: 1/2" = 1'-0"

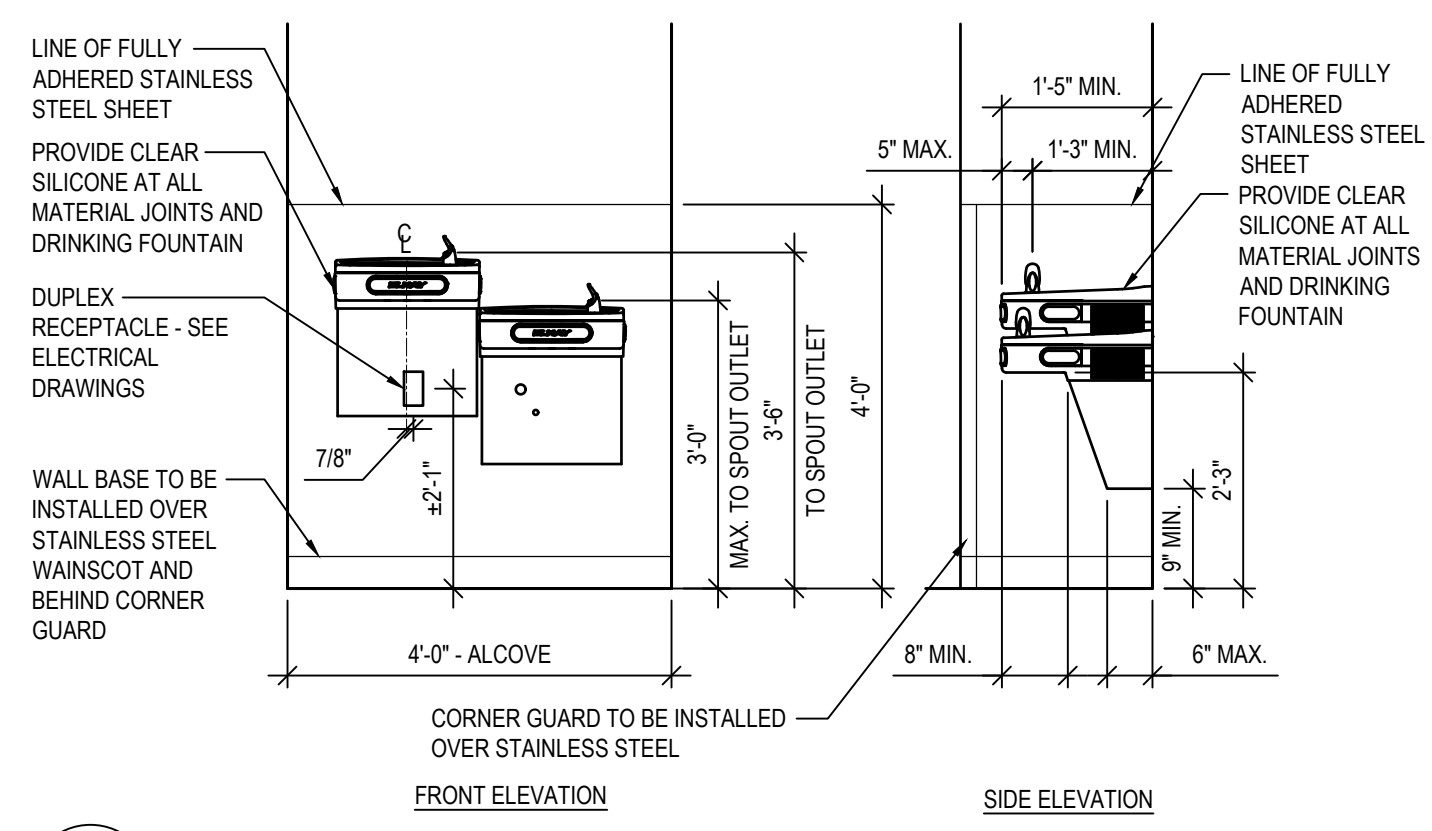


4 ACCESSIBLE DRINKING FOUNTAIN ELEVATIONS
A4.0 SCALE: 1/2" = 1'-0"

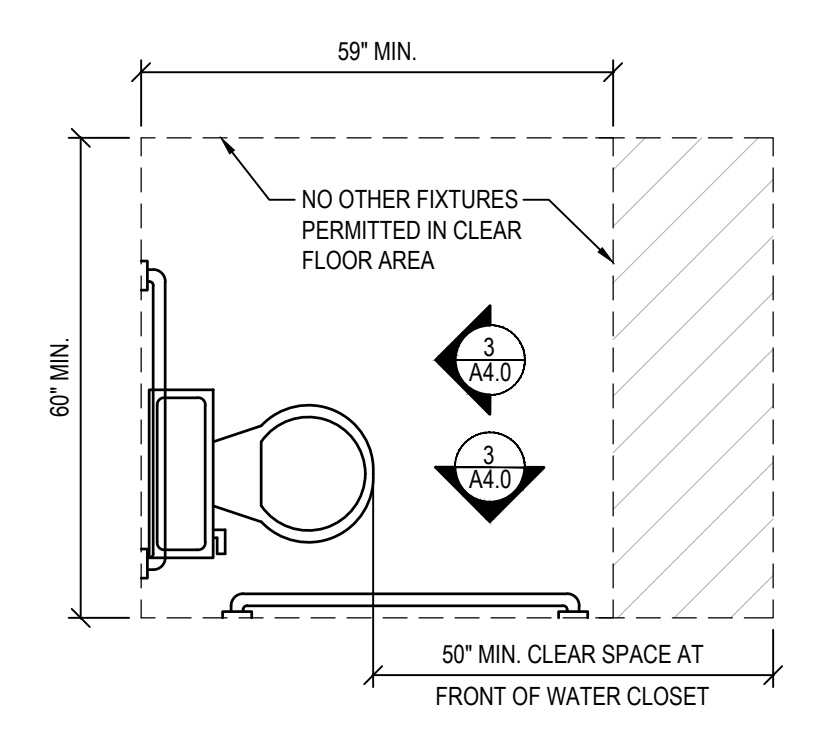

2 ACCESSIBLE TOILET
A4.0 SCALE: 1/2" = 1'-0"

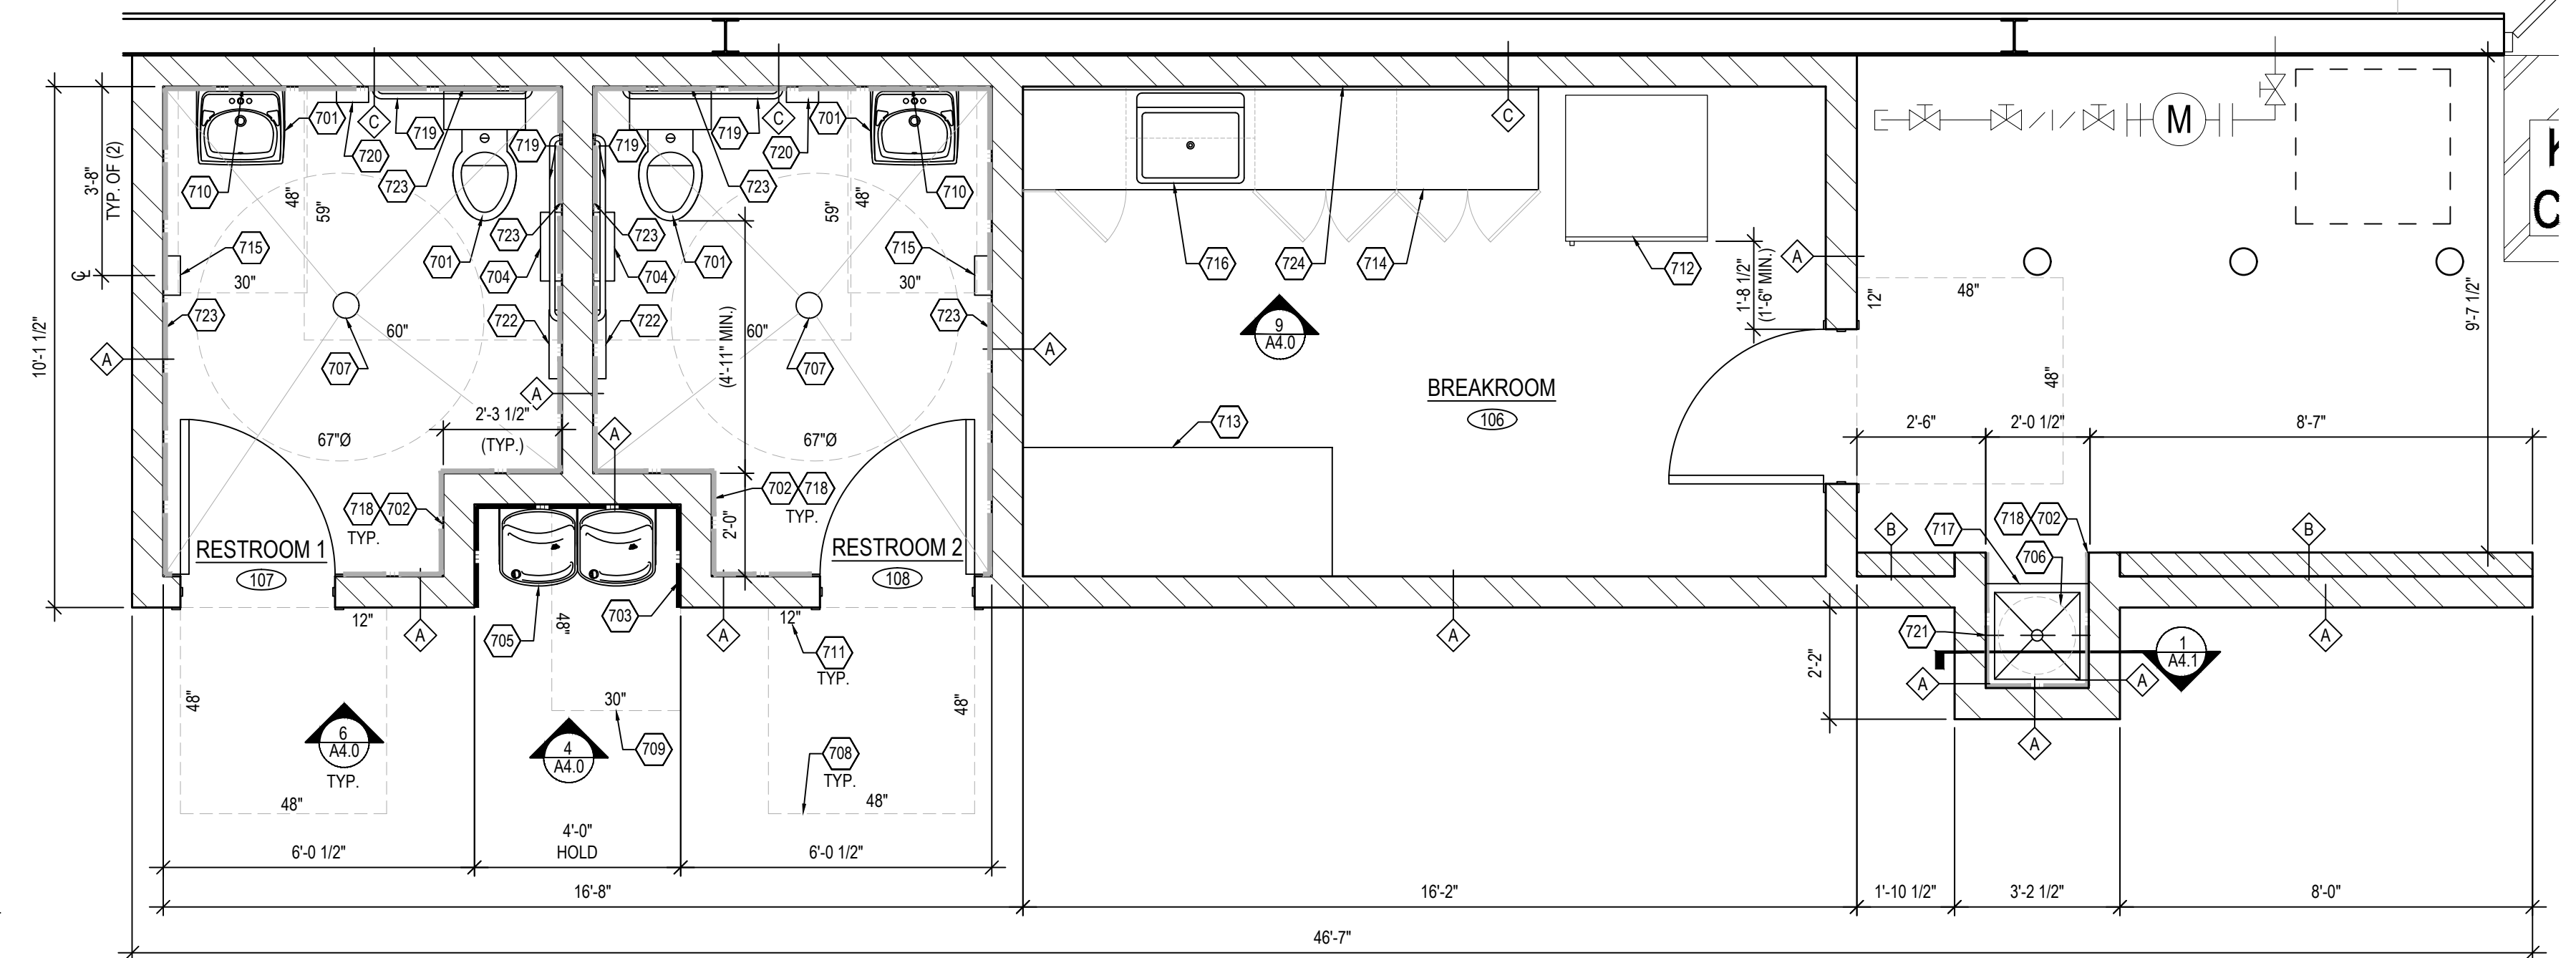


1 ENLARGED RESTROOM / BREAK ROOM PLAN
A4.0 SCALE: 3/8" = 1'-0"

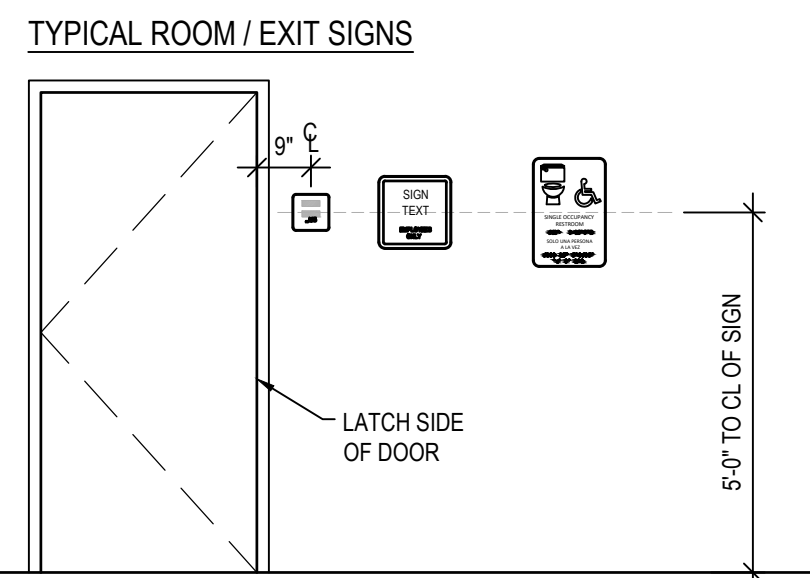


- NOTES:**
- CHARACTERS, SYMBOLS AND THEIR BACKGROUND SHALL HAVE A NON-GLARE FINISH. CHARACTERS AND SYMBOLS SHALL CONTRAST WITH THEIR BACKGROUND.
 - CHARACTERS ON SIGNS SHALL BE RAISED 1/32" MINIMUM & SHALL BE SANS SERIF UPPERCASE CHARACTERS. CHARACTERS SHALL BE A MINIMUM OF 5/8" AND A MAXIMUM OF 2" HIGH.
 - BRILLE SHALL BE GRADE 2 AND SHALL COMPLY SIZE AND SPACING REQUIREMENTS IN THE ACCESSIBILITY CODE. BRILLE CHARACTERS SHALL BE LOCATED BELOW THE SIGN TEXT, WITH A 3/8" MINIMUM SPACE BETWEEN BRILLE AND TEXT OR OTHER SIGNAGE ELEMENTS (BORDER, PICTOGRAM, ETC).
 - PICTOGRAMS SHALL BE ACCOMPANIED BY THE VERBAL DESCRIPTION PLACED DIRECTLY BELOW THE PICTOGRAM. THE OUTSIDE DIMENSION OF THE PICTOGRAM FIELD SHALL BE A MINIMUM OF 6" IN HEIGHT.


6 SIGN DETAILS
A4.0 SCALE: N.T.S.

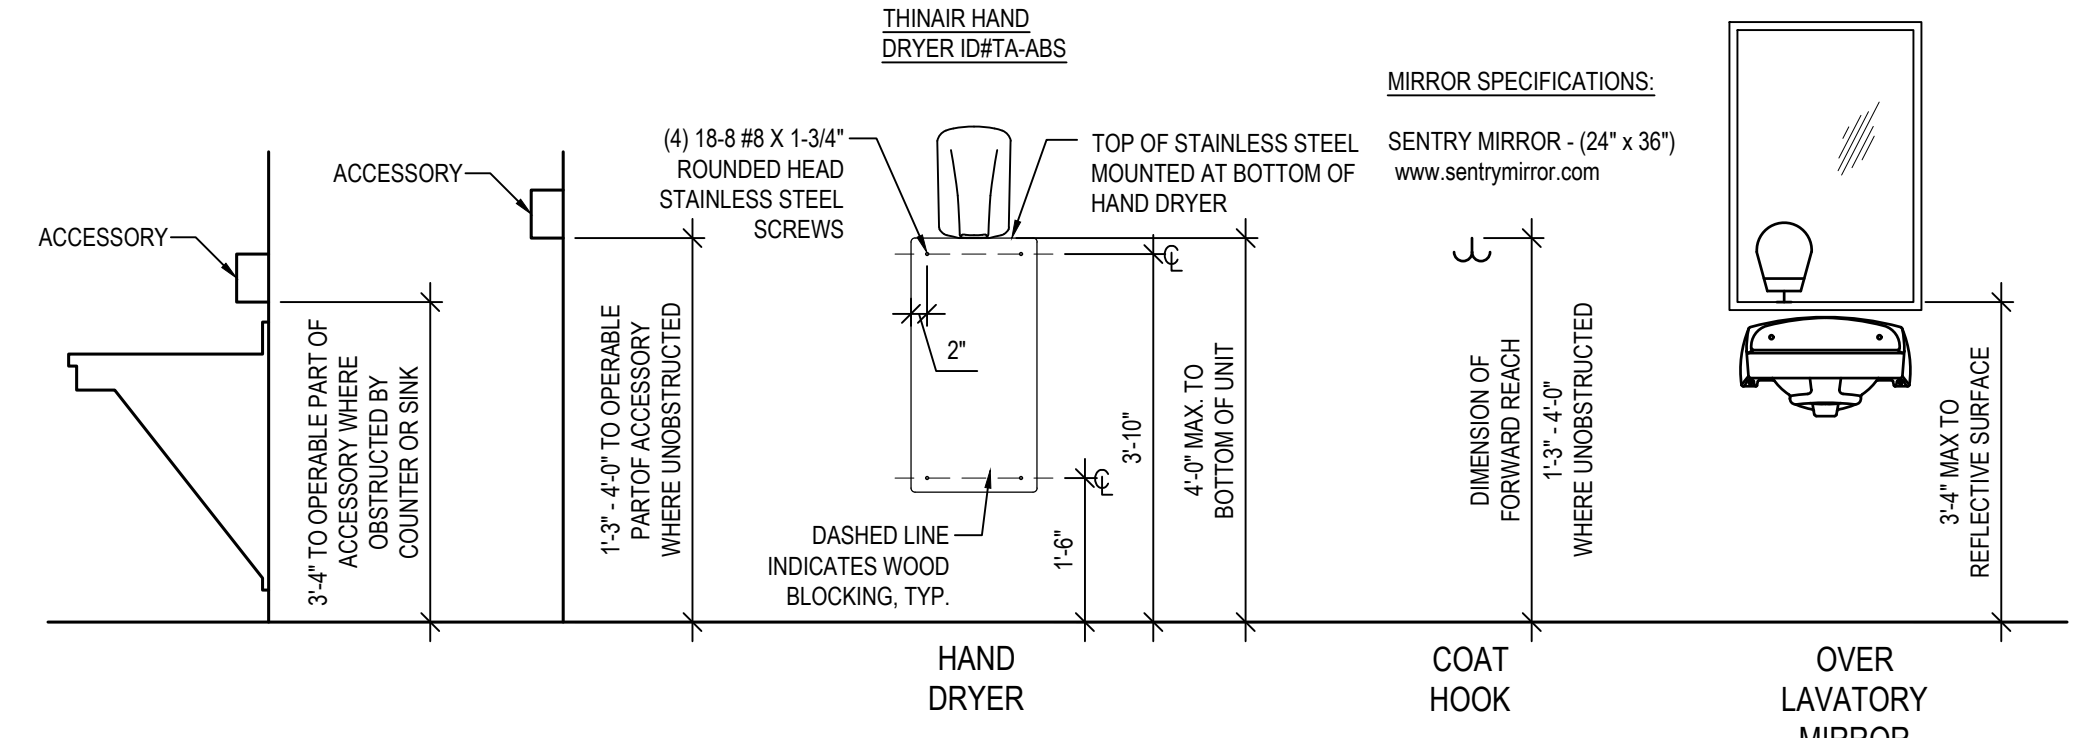


7 ACCESSORY MOUNTING HEIGHTS
A4.0 SCALE: 1/2" = 1'-0"

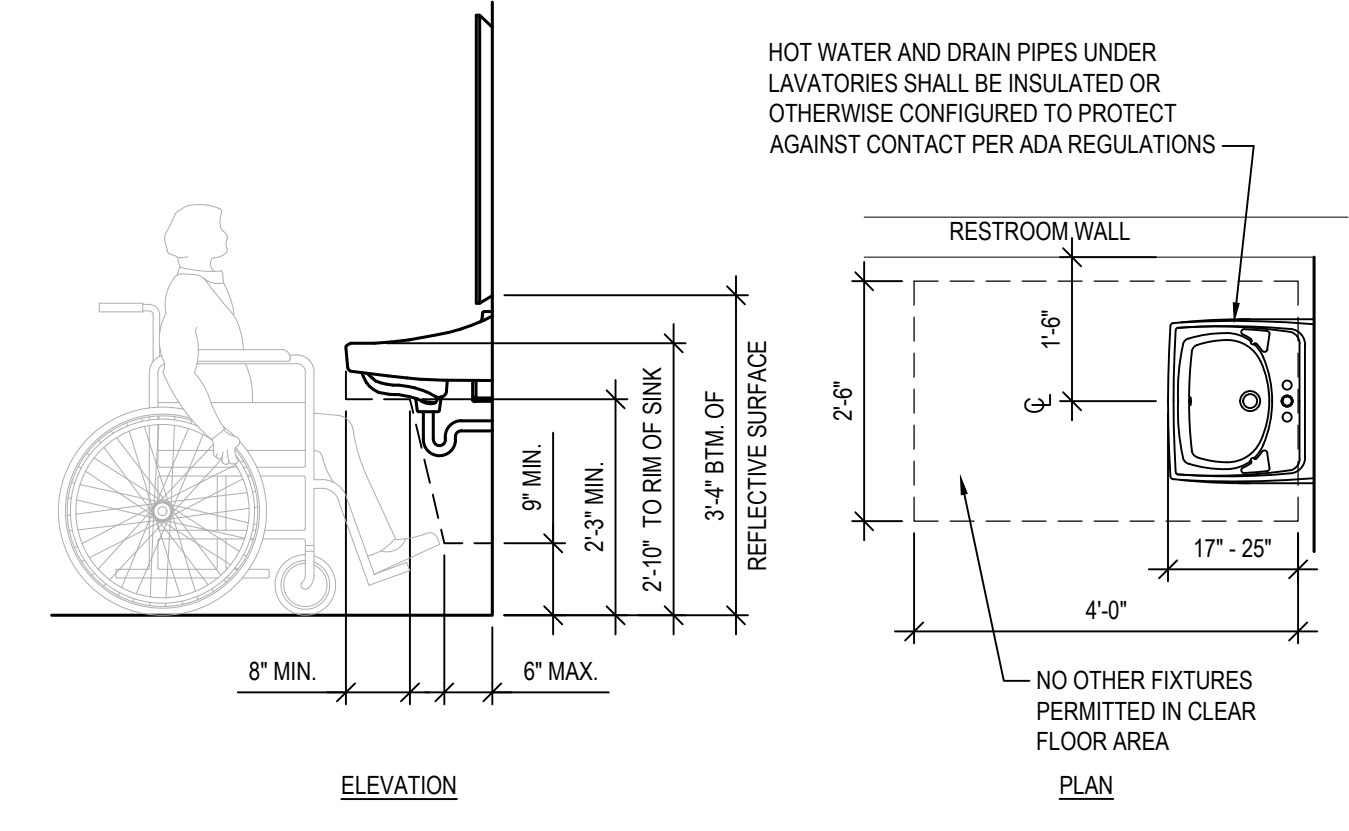


5 ACCESSIBLE LAVATORY PLAN & ELEVATION
A4.0 SCALE: 1/2" = 1'-0"

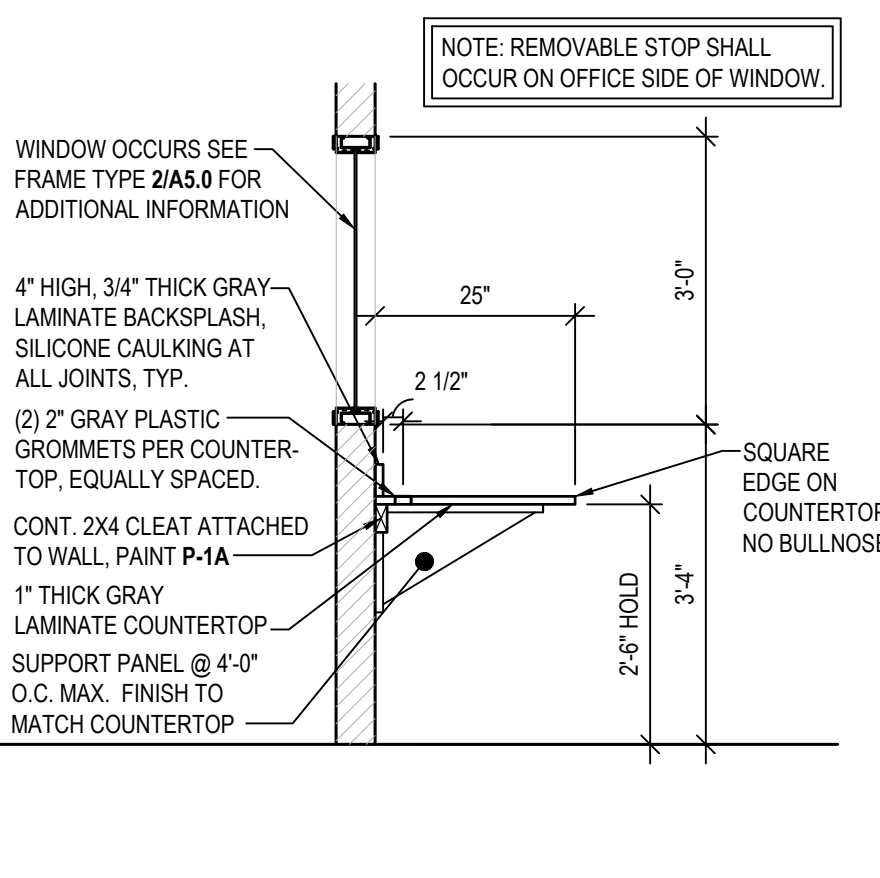


11 OFFICE COUNTERTOP SECTION
A4.0 SCALE: 1/2" = 1'-0"

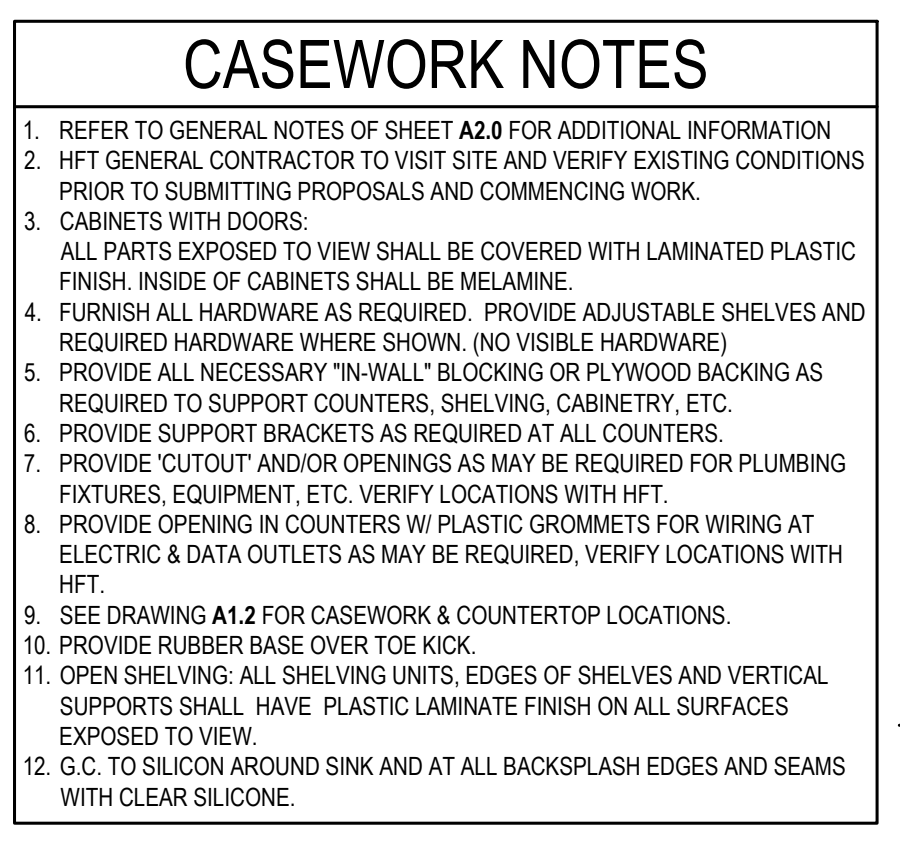

10 COUNTERTOP SECTION @ SINK
A4.0 SCALE: 1/2" = 1'-0"

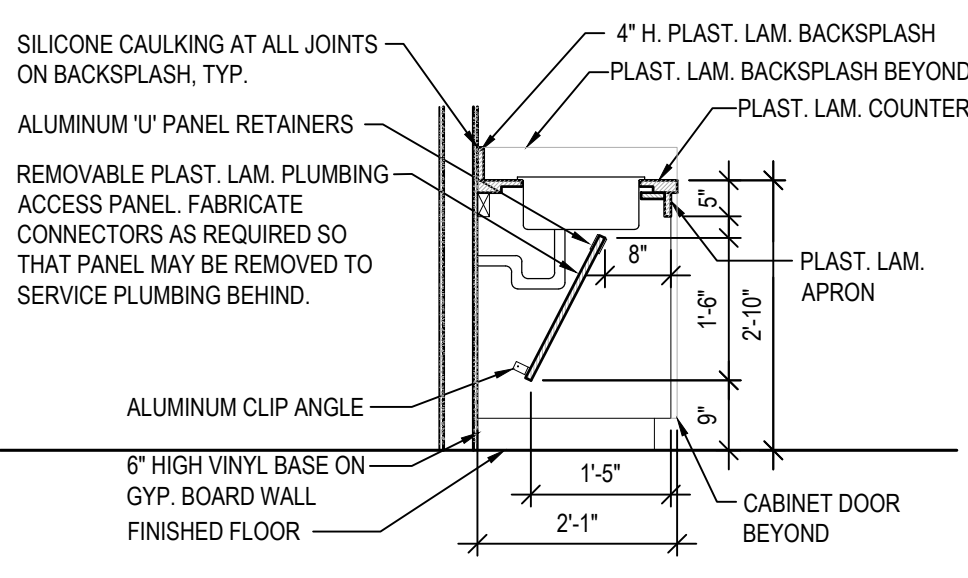


9 BREAK ROOM CASEWORK ELEVATION
A4.0 SCALE: 1/2" = 1'-0"

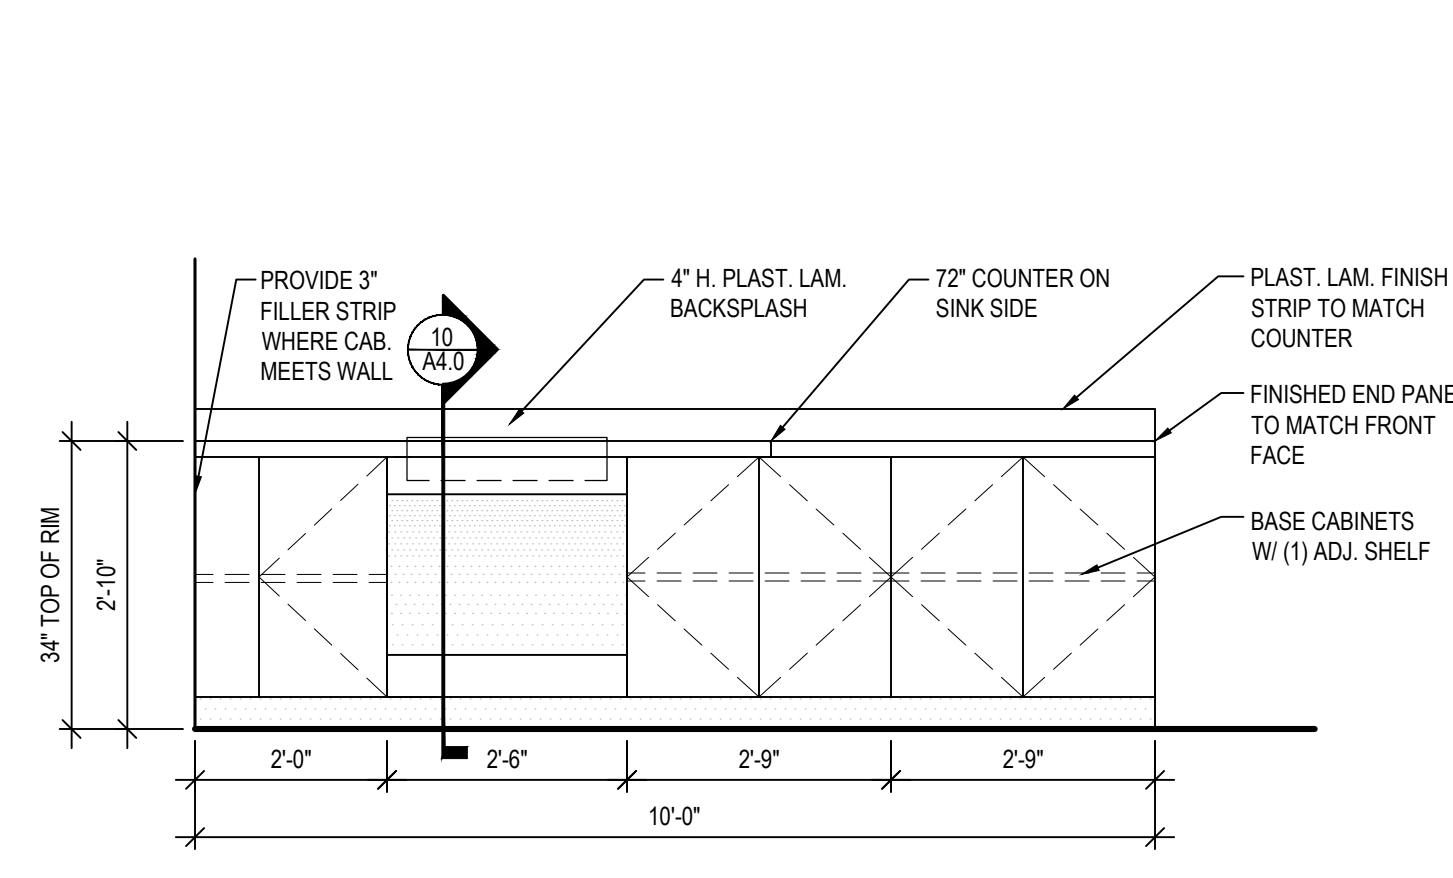

8 GRAB BAR SECTION
A4.0 SCALE: N.T.S.

- 700 SERIES ENLARGED RR / BR PLAN KEY NOTES**
- RESTROOM FIXTURES, SEE DETAILS 2, 3 & 5 / A4.0 AND PLUMBING DRAWINGS FOR ADDITIONAL INFORMATION.
 - DOTTED LINE INDICATES PROVIDE AND INSTALL WC-1 ON WALL AS SHOWN. SEE FINISH SCHEDULE A1.3 FOR ADDITIONAL INFO.
 - GREEN BOARD AND 20 GA. STAINLESS STEEL SHEET TO EXTEND FROM FLOOR TO 4'-0" A.F.F. AT ALL DRINKING FOUNTAIN WALLS. SEE DETAIL A4.0 FOR ADDITIONAL INFORMATION.
 - TOILET PAPER DISPENSER BOBRICK MODEL: HB-2840.
 - DRINKING FOUNTAIN. REFER TO PLUMBING DRAWINGS FOR ADDITIONAL INFORMATION.
 - WATER HEATER MOUNTED ABOVE MOP SINK ON SHELF. SHELF TO BE MOUNTED AT 8'-0" A.F.F. REFER TO PLUMBING DRAWINGS FOR MORE DETAILS.
 - FLOOR DRAIN. REFER TO PLUMBING DRAWINGS FOR MORE DETAILS. CONTRACTOR TO SLOPE FLOOR TOWARDS DRAIN. (SLOPE NOT TO EXCEED 2%). G.C. TO FILL CONCRETE AROUND DRAIN TO ACHIEVE A FLUSH LEVEL FINISH.
 - DASHED LINE INDICATES MIN. CLEAR FLOOR SPACE (TYP.)
 - CLEAR FLOOR SPACE CENTERED ON LOW DRINKING FOUNTAIN.
 - MIRROR LOCATION. SEE DETAIL 7 THIS SHEET FOR MOUNTING HEIGHTS AND DIMENSIONS. NUMBERS INDICATE MINIMUM CLEAR AREA AT FLOOR SPACE DIAGRAMS (TYP.)
 - REFRIGERATOR LOCATION.
 - APPROXIMATE LOCATION OF BREAKROOM TABLE BY HFT.
 - BREAK ROOM CABINETS. SEE DETAILS 9&10 THIS SHEET.
 - THINAIR HAND DRYER (110-120V, 7 AMPS), MODEL #TA-ABS, WITH ANTI-MICROBIAL WALL GUARDS, ID #99S. SEE DETAIL 7 THIS SHEET FOR MOUNTING INFORMATION. SEE ELECTRICAL DRAWINGS FOR ADDITIONAL INFO.
 - BREAKROOM SINK SEE P1.0 PLUMBING FIXTURES SPECIFICATIONS.
 - MOP SINK. REFER TO PLUMBING DRAWINGS FOR ADDITIONAL INFORMATION.
 - USE 3/4" GREEN BOARD IN PLACE OF 1/2" GYP BOARD AS NOTED.
 - GRAB BARS. SEE DETAILS 2, 3, & 8 / A4.0 FOR ADDITIONAL INFORMATION.
 - SANITARY NAPKIN DISPOSAL BOBRICK MODEL: #B-270.
 - (2) 12" DEEP WHITE WIRE SHELVES FOR CLEANING SUPPLIES.
 - TOILET SEAT COVER DISPENSER TORK MODEL: #99A.
 - PROVIDE 5/8" FRT PLYWOOD BLOCKING IN STUD CAVITY.
 - REPLACE 5/8" GYP. BOARD WITH 5/8" GREEN BOARD WITH 5/8" FRT PLYWOOD BLOCKING IN STUD CAVITY.

- GENERAL NOTES**
- SEE TYPICAL RESTROOM DETAILS THIS SHEET FOR ADDITIONAL INFORMATION.
 - SEE SHEETS A1.1 & A4.1 FOR KEY NOTE REFERENCES, WALL TYPE REFERENCES, AND ADDITIONAL INFORMATION.
 - SEE PLUMBING SHEET FOR FIXTURE TYPES.
 - FURNISH ALL HARDWARE AS REQUIRED. PROVIDE ADJUSTABLE SHELVES AND REQUIRED HARDWARE WHERE SHOWN. (NO VISIBLE HARDWARE)
 - SEE ELECTRICAL & PLUMBING DRAWINGS FOR ADDITIONAL INFORMATION.
 - SEE SHEET A0.0 FOR ITEMS FURNISHED BY HFT AND INSTALLED BY G.C.

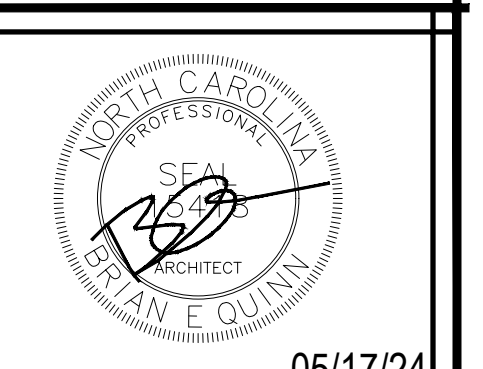

05/17/24

ADA ARCHITECTS
17710 Detroit Avenue
Lakewood, Ohio 44107
Phone (216) 521-5134
Fax (216) 521-4824
www.adaarchitects.com


HARBOR FREIGHT
46 SHRUI LANE
ERWIN, NC 28839

THESE DOCUMENTS CONTAIN INFORMATION PROPRIETARY TO ADA ARCHITECTS, INC.
UNAUTHORIZED USE OF THESE DOCUMENTS IS EXPRESSLY PROHIBITED UNLESS AGREED UPON IN WRITING.


DO NOT SCALE THESE DRAWINGS

REVISIONS	
#	DATE
1	
2	
3	
4	
5	
6	
7	
8	
9	
10	


SECTIONS & DETAILS	
DATE	05/17/24
JOB NO.	23475
A4.0	
SHEET NO.	

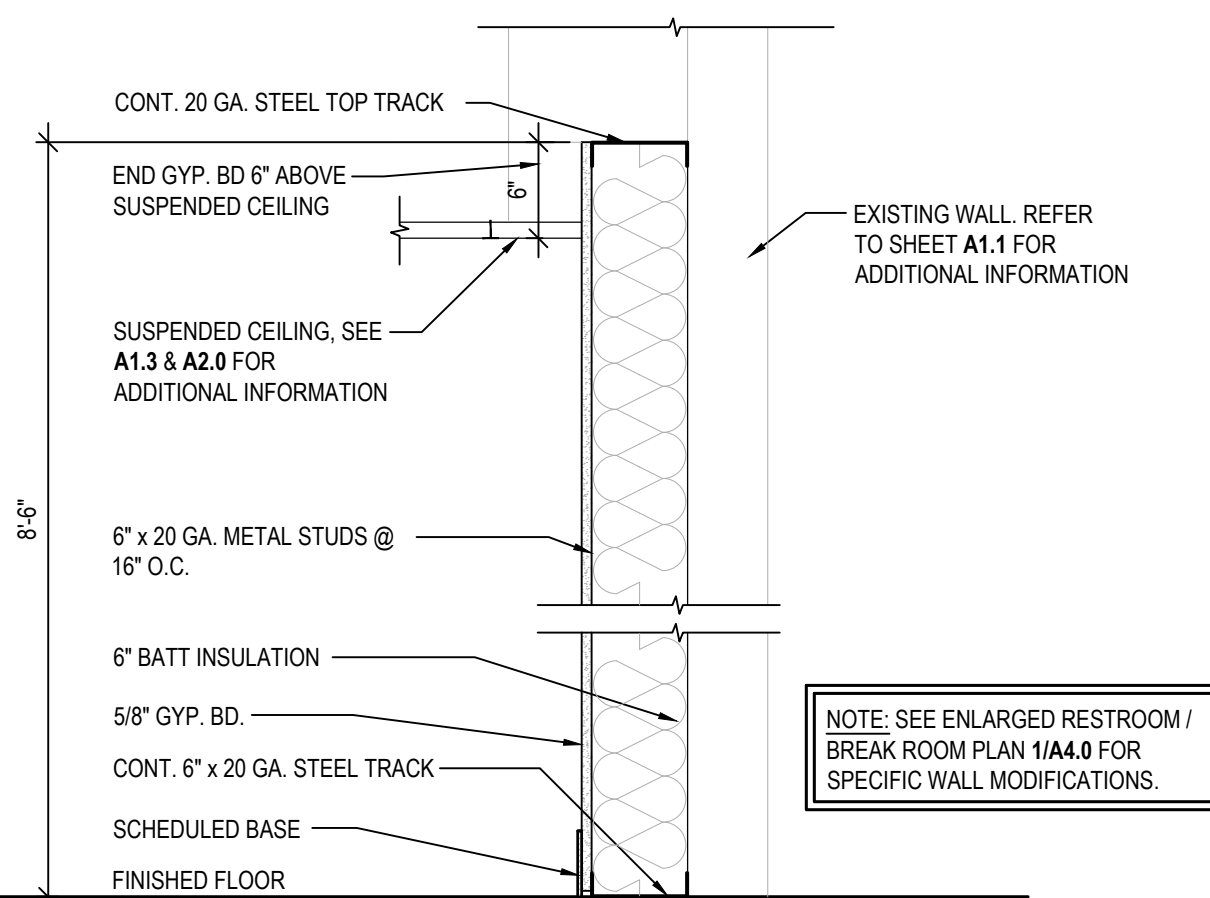

C WALL TYPE C
SCALE: 1" = 1'-0"

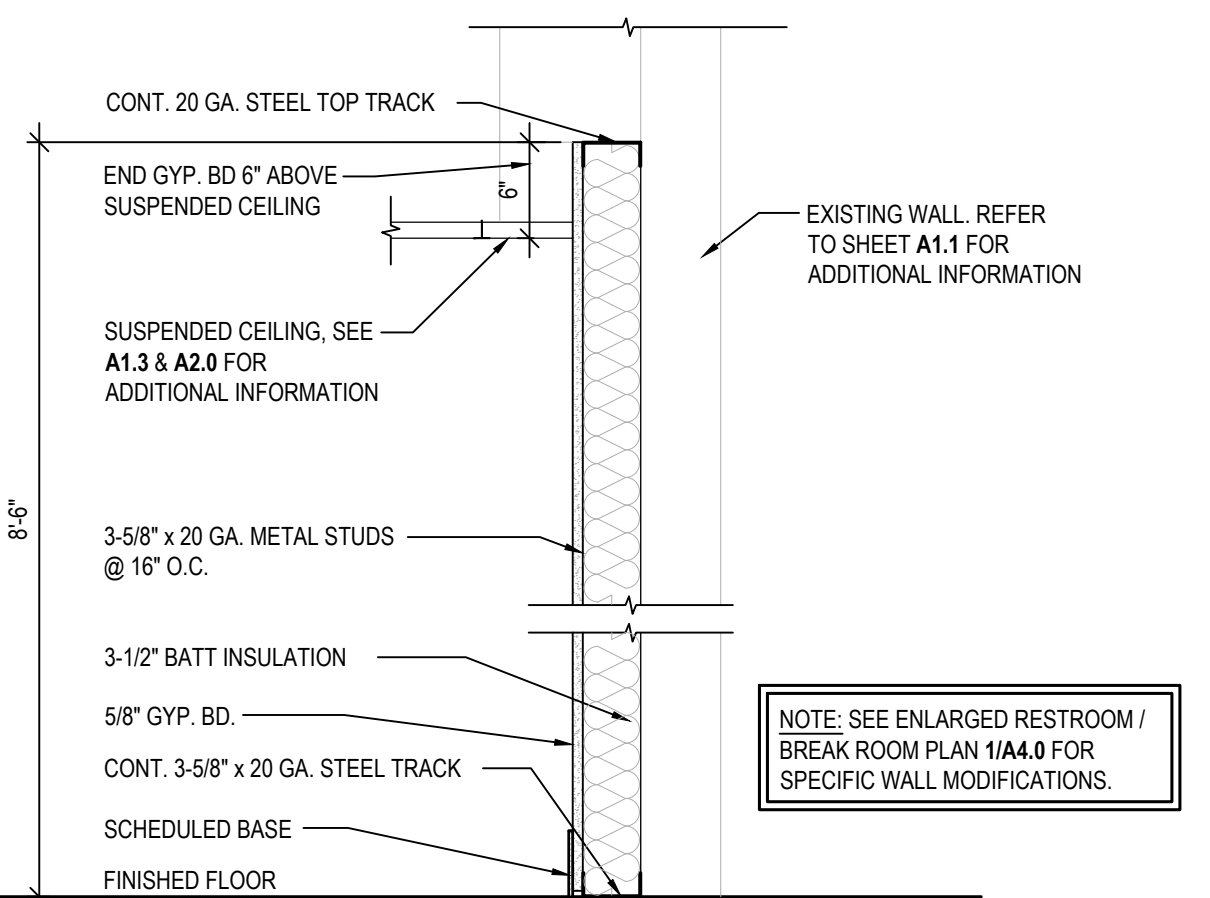


B WALL TYPE B
SCALE: 1" = 1'-0"

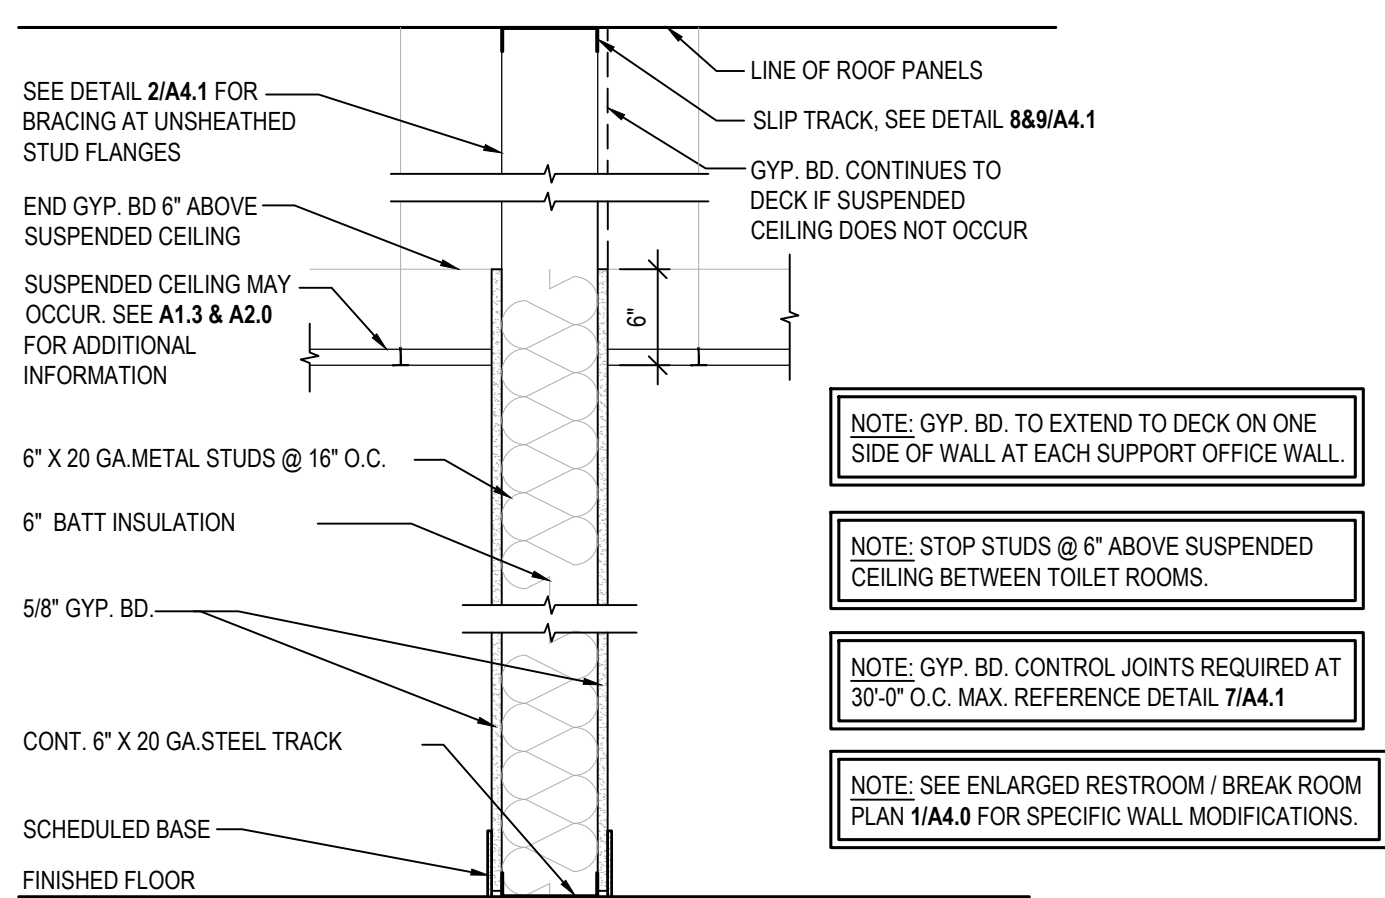


A WALL TYPE A
SCALE: 1" = 1'-0"

WALL TYPE NOTES


- REFER TO GENERAL NOTES ON SHEET A0.2 FOR ADDITIONAL INFORMATION.
- HFT GENERAL CONTRACTOR TO VISIT SITE AND VERIFY EXISTING CONDITIONS PRIOR TO SUBMITTING PROPOSALS AND COMMENCING WORK.
- THE MATERIALS AND DETAILS SHOWN ARE FOR TYPICAL INSTALLATIONS WHERE THE STUD MANUFACTURERS RECOMMENDATIONS OR LOCAL ORDINANCES ARE MORE RESTRICTIVE, THEY SHALL APPLY.
- TYPICAL FASTENERS:
 - METAL STUDS TO METAL STUDS OR TRACKS: #18 X 1 1/2" SMS /2 WITH PHIL PAN HEAD FOR 25 GA. OR 20 GA. #10 - 16 X 9/16" SMS/3 WITH PHIL PAN HEAD FOR INTERCONNECTION OF 18 GA. OR 16 GA.
 - METAL STUDS OR TRACKS TO WOOD PURLINS, GIRDERS & BEAMS: #14-10 X 1 1/2" H.W.H. TYPE "S" METAL - TO WOOD SMS.
 - METAL STUDS OR TRACKS TO STRUCTURAL STEEL (TUBE STEEL, WIDE FLANGE COLUMNS, BEAMS, GIRDERS, ETC.): SMS/3 OR SMS/4 - GAUGE AND LENGTH AS REQUIRED FOR THE COMBINED THICKNESS OF THE FRAMING TO BE DRILLED.
 - PLYWOOD TO METAL STUDS: #10 - 24 X 3/4" SMS/3 (PLYMETAL SMS) WITH THIN WAFER HEAD.
 - GYP. BOARD TO METAL STUDS: #7 X 1 1/4" HI-LO TYPE "S" BUGLE HEAD SCREWS FOR 3/8" TO 5/8" GYP. BOARD TO 25 GAUGE OR 20 GAUGE STUDS. #6 X 1 1/4" TYPE S-12 BUGLE HEAD SCREWS FOR 3/8" TO 5/8" TO 18 GA. OR 16 GA. METAL STUDS OR TRACKS.
 - CONCRETE TO METAL STUDS: 0.157" DIA. SHOT PIN WITH MIN. 3/4" EMBEDMENT @ 16" O.C. SPACING. SEE STRUCTURAL.
- ALL GYPSUM BOARD RETURNS SHALL HAVE METAL CORNER BEADS MINIMUM FLOOR TO CEILING. ALL PENETRATIONS IN DRYWALL CONSTRUCTION ABOVE FINISHED CEILING AND AS NOTED ELSEWHERE SHALL BE EFFECTIVELY SEALED TO PREVENT SOUND LEAKAGE AND FIRE CAULKED AT U.L. RATED PARTITIONS. ALL DRY-WALL JOINTS ABOVE FINISHED CEILING SHALL BE "FIRE TAPED" ALL MECHANICAL CHASES AND OTHER NOTED CHASES ARE TO EXTEND UP TO THE UNDERSIDE OF THE DECK STRUCTURE ABOVE. ALL PLUMBING CHASES UNLESS OTHERWISE NOTED SHALL EXTEND ABOVE THE HIGHEST ADJOINING CEILING AND BE BRACED TO STRUCTURE. ALL VERTICAL DIMENSIONS SHOWN ARE TO THE TOP OF THE SLAB, UNLESS NOTED OTHERWISE.
- DRYWALL CONTROL JOINTS ARE TO BE INSTALLED AT MINIMUM 30'-0" O.C. AT PARTITIONS AND ELSEWHERE AS NOTED.
- AT PARTITIONS HIGHER THAN 12'-0" PROVIDE HORIZONTAL LATERAL BRACINGS WITH 1 1/2" 16GA. COLD ROLLED CHANNELS AT 8'-0" O.C. VERT. ANCHORED TO STUDS. SEE DETAIL 2 THIS SHEET FOR ADDITIONAL INFORMATION.
- ALL HFT FRAMING SHALL BE METAL STUDS.
- ALL WOOD IS TO BE FIRE RETARDANT TREATED, INCLUDING BUT NOT LIMITED TO STUDS, BLOCKING, SHEATHING, ETC. ALL FIRE RETARDANT TREATED LABELS ARE TO BE INSTALLED SUCH THAT LABELS ARE VISIBLE PRIOR TO INSTALLATION OF FINAL FINISH MATERIALS.
- ALL RATED WALLS TO FOLLOW UL DESIGN # U419
- REFER TO STRUCTURAL DRAWINGS FOR CONCRETE AND REINFORCING SPECIFICATIONS
- REFER TO SHEET S1.0 ON STRUCTURAL DRAWINGS FOR APPROVED ADHESIVE ANCHORING SYSTEMS.

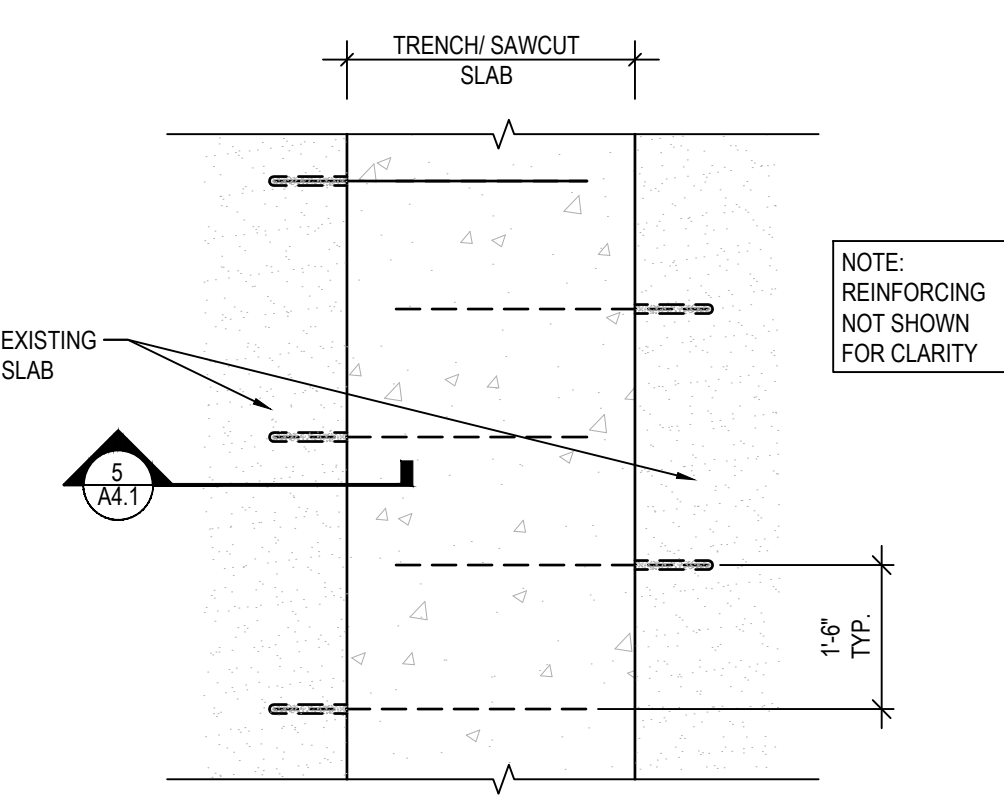


4 TRENCHED SLAB DOWEL PLAN
SCALE: NONE

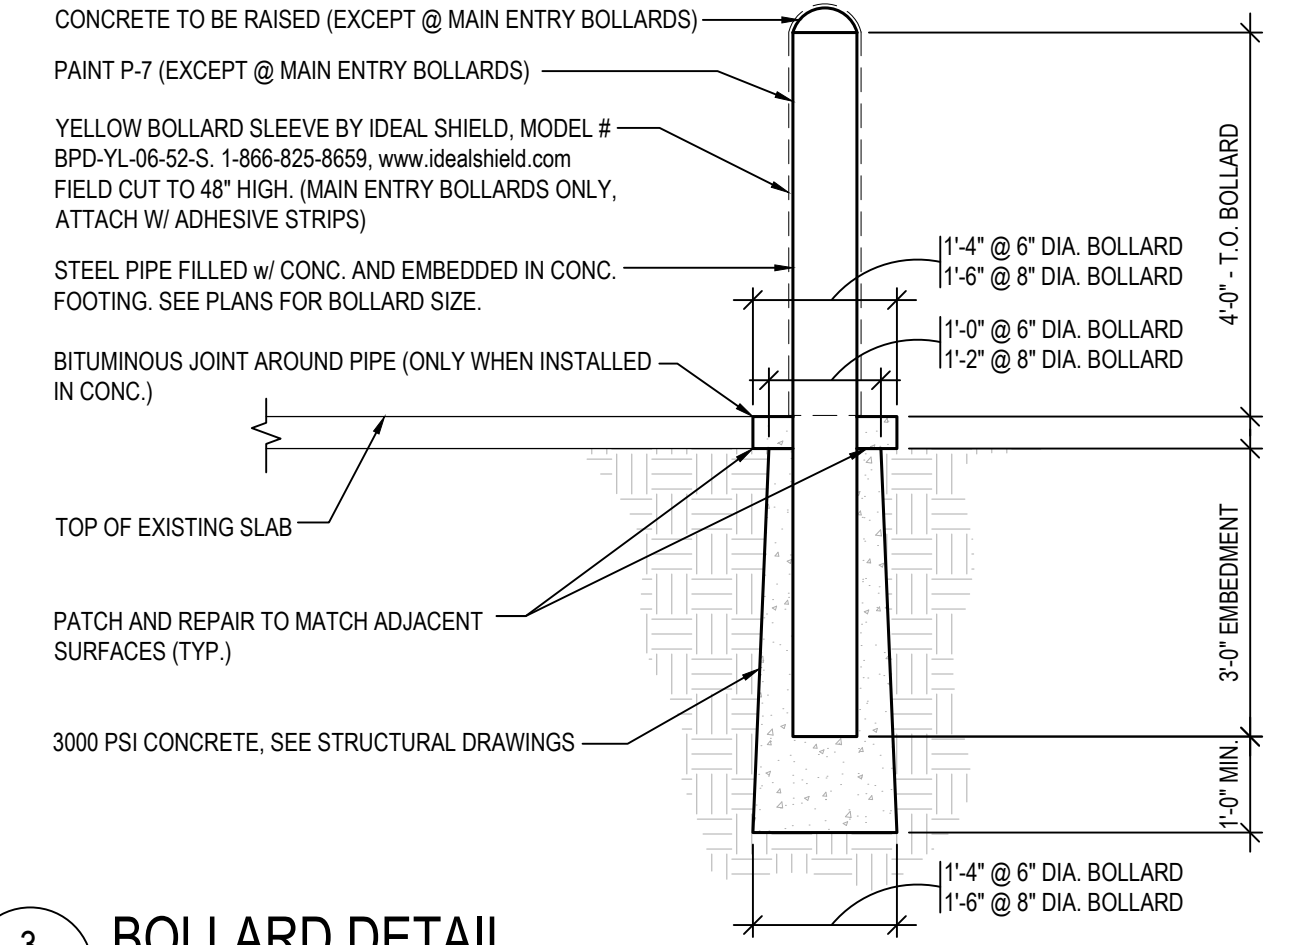

3 BOLLARD DETAIL
SCALE: 1/2" = 1'-0"

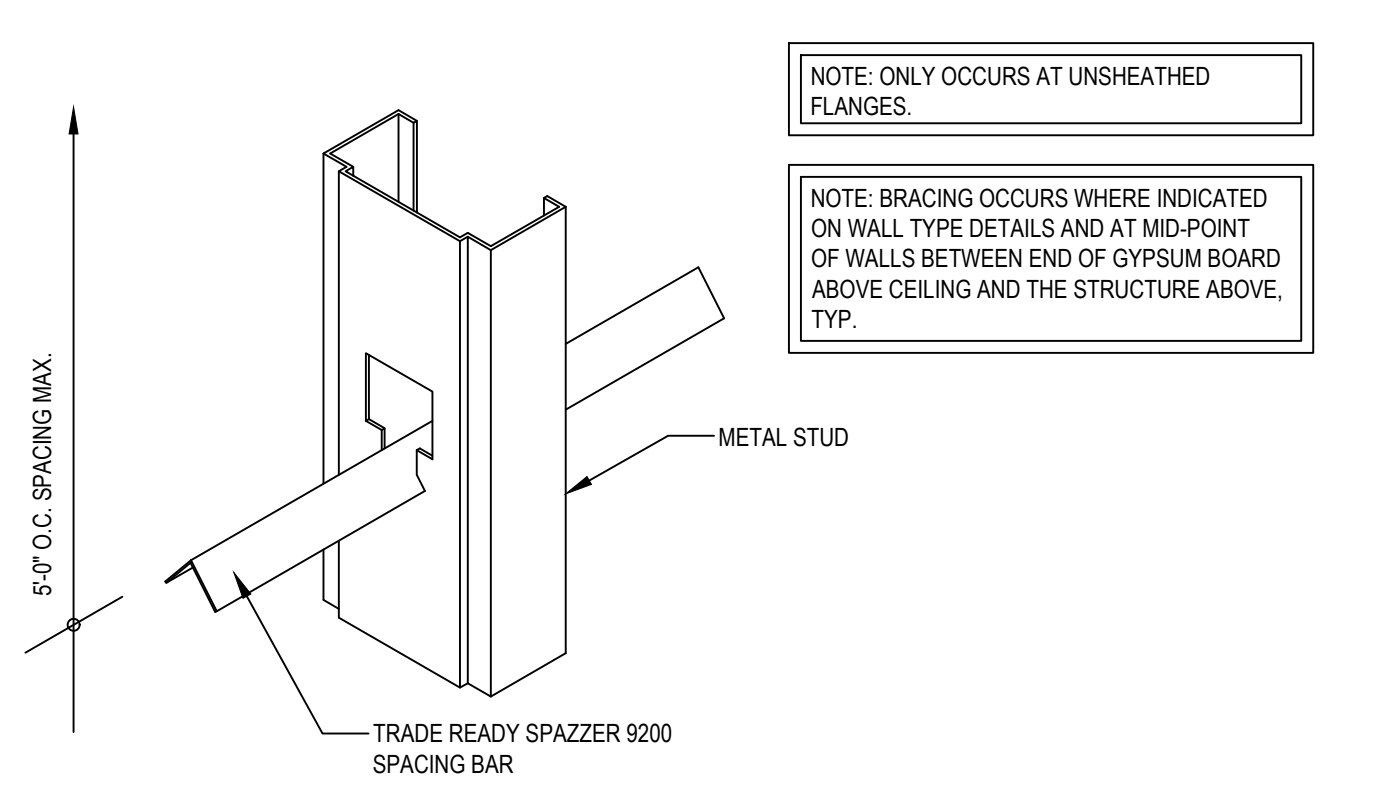


2 LATERAL BRACING @ FREE - STANDING WALLS
SCALE: N.T.S.

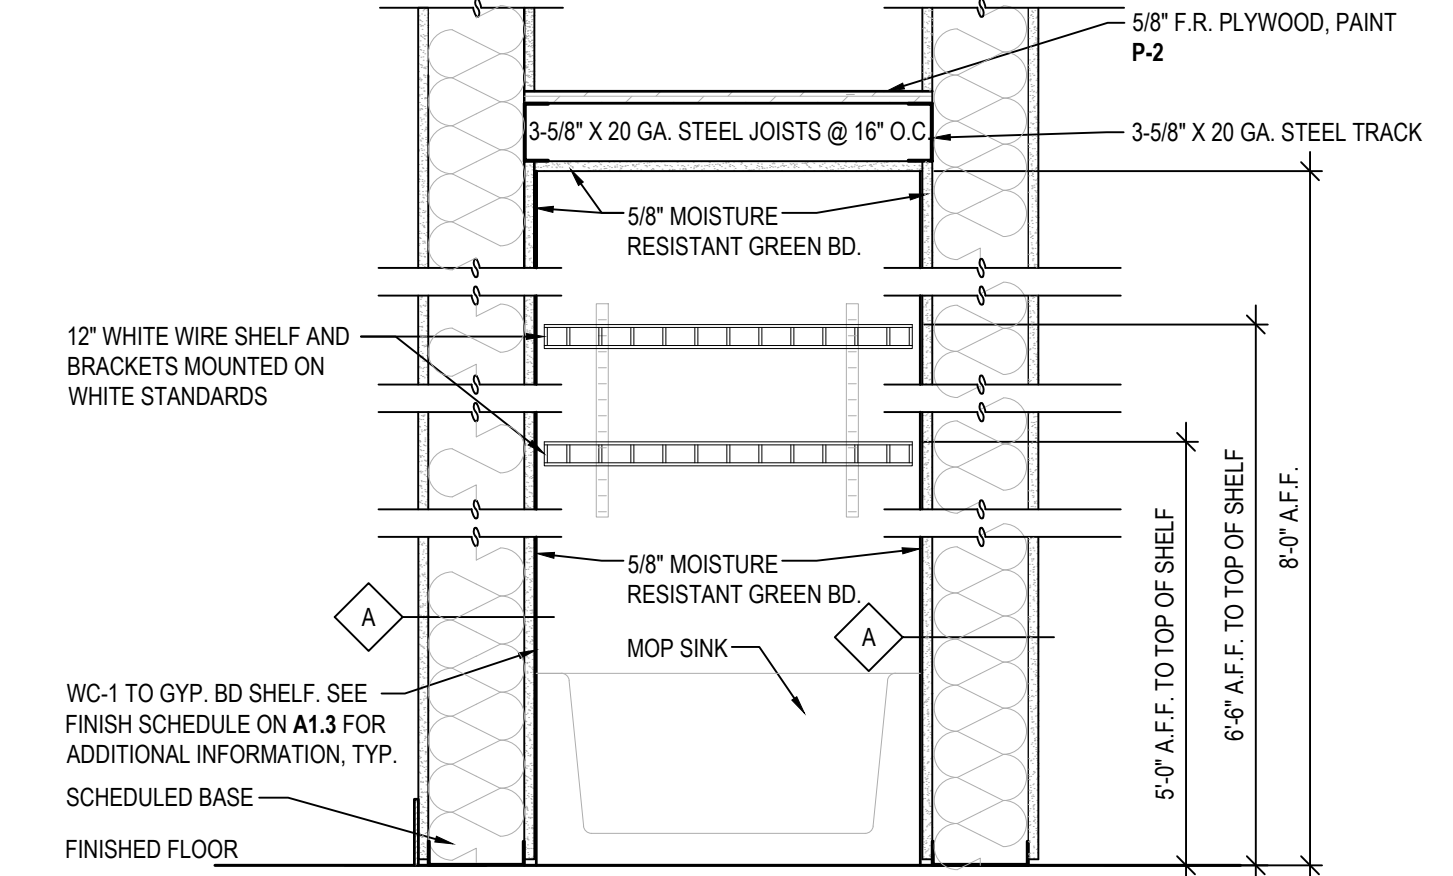


1 MOP SINK - HWH SHELF DETAIL
SCALE: 1" = 1'-0"


SLAB THICKNESS	REINFORCING
t < 4"	4x4 W2.9xW2.9 W.W.M.
4" < t < 6"	#4 @ 18" O.C. EA. WAY

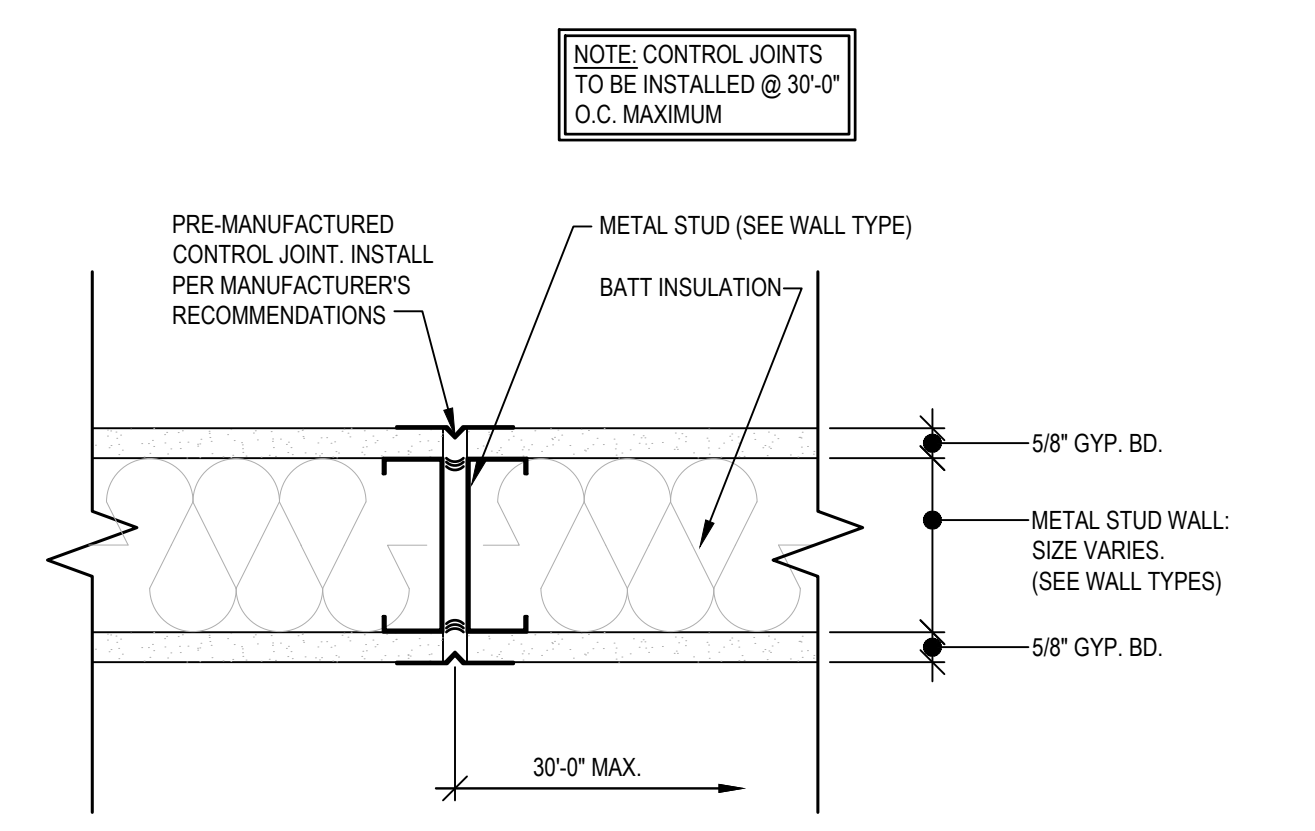


7 GYPSUM BOARD CONTROL JOINT DETAIL
SCALE: 3" = 1'-0"

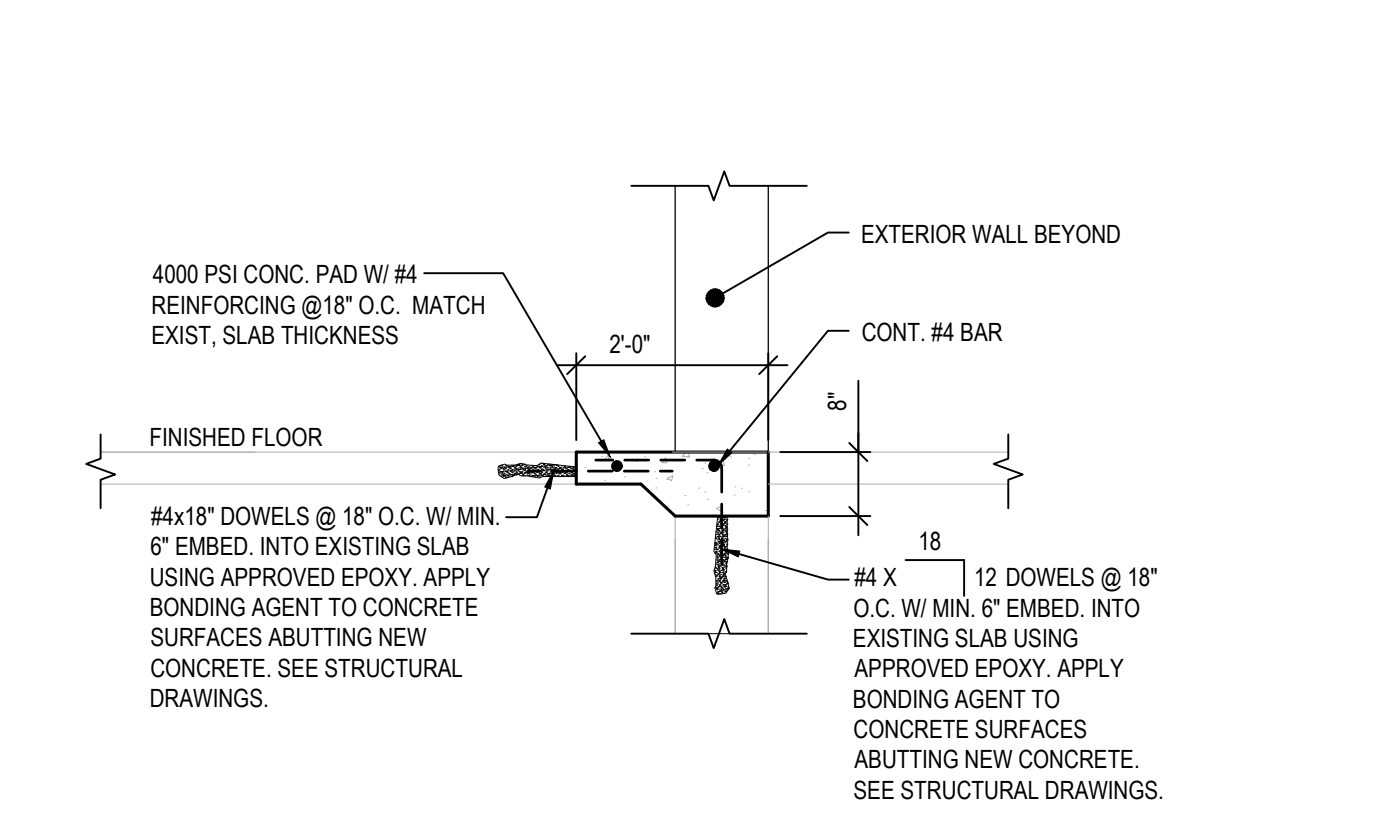


6 FLOOR REPAIR DETAIL
SCALE: 1/2" = 1'-0"

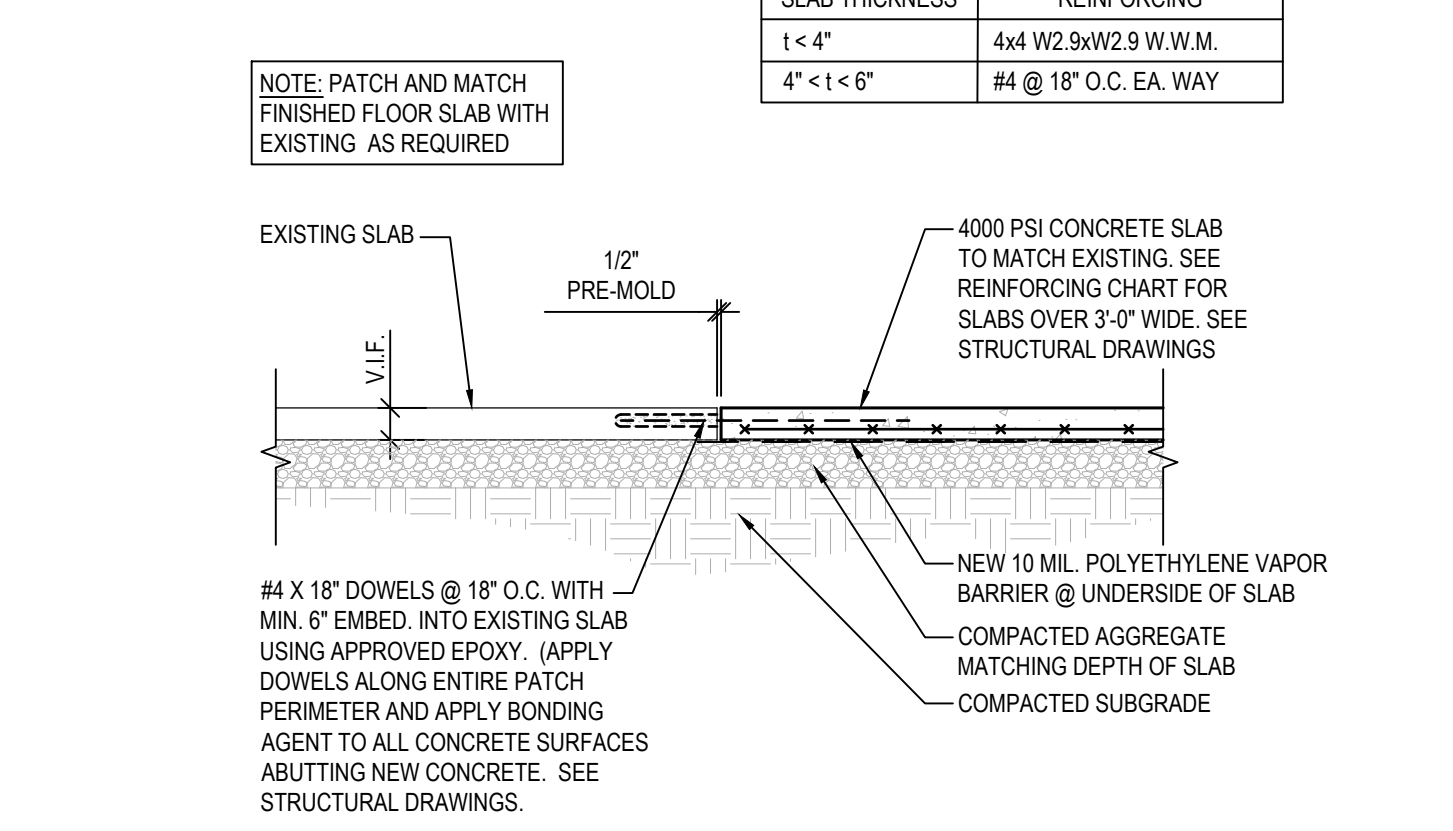

5 TYPICAL SLAB PATCH DETAIL
SCALE: NONE

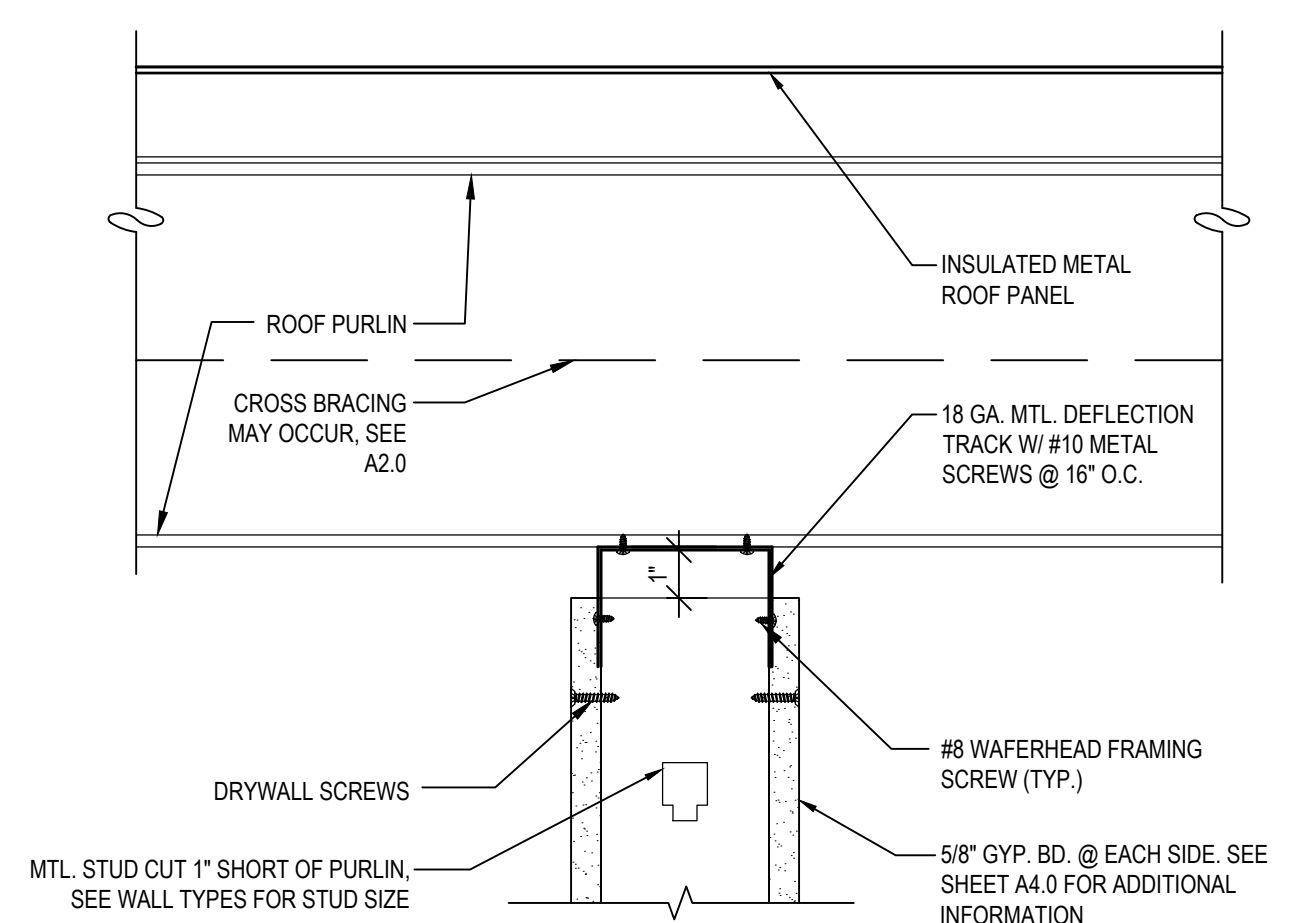

9 SLIP TRACK DETAIL
SCALE: 3" = 1'-0"

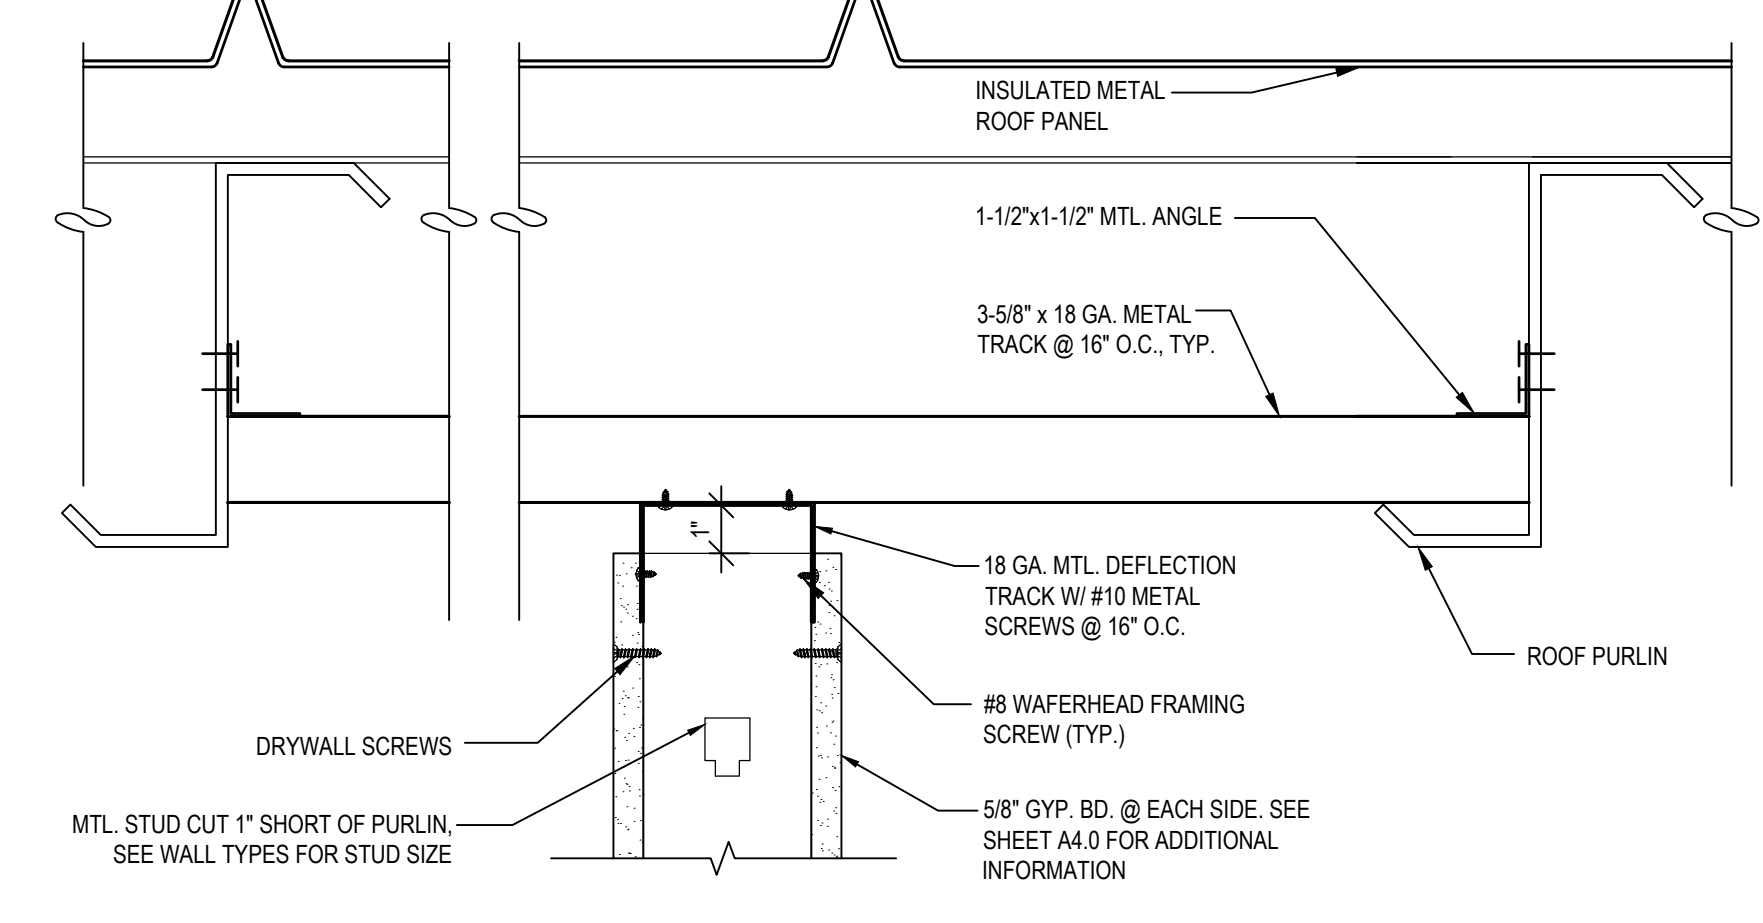

8 SLIP TRACK DETAIL
SCALE: 3" = 1'-0"

DO NOT SCALE THESE DRAWINGS



05/17/24

ADA ARCHITECTS
Lakewood, Ohio 44107
17710 Detroit Avenue
Phone (216) 521-1534
Fax (216) 521-4824
www.adaarchitects.com

HARBOR FREIGHT
46 SHRUI LANE
ERWIN, NC 28839

THESE DOCUMENTS CONTAIN INFORMATION PROPRIETARY TO ADA ARCHITECTS, INC.
UNAUTHORIZED USE OF THESE DOCUMENTS IS EXPRESSLY PROHIBITED UNLESS AGREED UPON IN WRITING.

REVISIONS	
#	DATE
1	
2	
3	
4	
5	
6	
7	
8	
9	
10	

WALL TYPES & DETAILS	
DATE	05/17/24
JOB NO.	23475
A4.1	
SHEET NO.	

DOOR AND FRAME SCHEDULE

DOOR NO.	SIZE	DOOR			FRAME			FIRE LABEL	HARDWARE GROUP	HEAD/JAMB DETAIL	REMARKS
		TYPE	MAT'L	FINISH	TYPE	MAT'L	FINISH				
(E01A)	EXISTING 12'-0" x 7'-8" HFT PACKAGED UNIT										EXISTING DOOR TO REMAIN. G.C. TO PROTECT DURING CONSTRUCTION. G.C. TO CHANGE OUT CORES.
(01B)	12'-0" x 7'-8" HFT PACKAGED UNIT	A	GLASS/ALUM.	CLEAR ANODIZED	PER MANF.	ALUM.	CLEAR ANODIZED	-	SUPPLIED BY DORMA	PER MANF.	G.C. TO COORDINATE FINAL DOOR AND FRAME DIMENSIONS WITH DORMA. SEE VENDOR INFORMATION ON SHEET A0.0 FOR CONTACT INFORMATION. GLAZING TO BE 1/4" TEMPERED
(01C)	8'-0" x 7'-8" HFT PACKAGED UNIT	D	GLASS/ALUM.	CLEAR ANODIZED	PER MANF.	ALUM.	CLEAR ANODIZED	-	SUPPLIED BY DORMA	PER MANF.	G.C. TO COORDINATE FINAL DOOR AND FRAME DIMENSIONS WITH DORMA. SEE VENDOR INFORMATION ON SHEET A0.0 FOR CONTACT INFORMATION. GLAZING TO BE 1/4" TEMPERED
(02)	3'-0" x 7'-0" x 1 3/4"	B	S.C. WOOD	PAINTED	1	H.M.	PAINTED	-	1	A&B/A5.0	SEE DOOR SCHEDULE NOTES.
(03)	3'-0" x 7'-0" x 1 3/4"	B	S.C. WOOD	PAINTED	1	H.M.	PAINTED	-	2	A&B/A5.0	SEE DOOR SCHEDULE NOTES.
(04)	3'-0" x 7'-0" x 1 3/4"	B	S.C. WOOD	PAINTED	1	H.M.	PAINTED	-	2	A&B/A5.0	SEE DOOR SCHEDULE NOTES.
(05)	3'-0" x 7'-0" x 1 3/4"	B	S.C. WOOD	PAINTED	1	H.M.	PAINTED	-	4	A&B/A5.0	UNDERCUT DOOR TO PROVIDE 1" CLEARANCE. LATCH SET SHALL BE "PRIVACY" TYPE.
(06)	3'-0" x 7'-0" x 1 3/4"	B	S.C. WOOD	PAINTED	1	H.M.	PAINTED	-	4	A&B/A5.0	UNDERCUT DOOR TO PROVIDE 1" CLEARANCE. LATCH SET SHALL BE "PRIVACY" TYPE.
(07)	3'-0" x 7'-0" x 1 3/4"	B	S.C. WOOD	PAINTED	1	H.M.	PAINTED	-	3	A&B/A5.0	SEE DOOR SCHEDULE NOTES.
(E08)	EXISTING 8'-0" x 10'-0" x 1 1/2"								5		EXISTING OVERHEAD DOOR TO REMAIN. G.C. TO PROTECT DURING CONSTRUCTION.
(E09)	EXISTING 3'-0" x 7'-0" x 1 3/4"								6		EXISTING DOOR TO REMAIN. G.C. TO PROTECT DURING CONSTRUCTION. INSTALL ADDRESS ON THIS DOOR.
(E10)	EXISTING 3'-0" x 7'-0" x 1 3/4"								6A		EXISTING DOOR TO REMAIN. G.C. TO PROTECT DURING CONSTRUCTION. DO NOT INSTALL ADDRESS ON THIS DOOR.

EXISTING HARDWARE NOTE:
CONTRACTOR TO VERIFY ALL EXISTING HARDWARE TO ENSURE HFT SPECIFIED HARDWARE HAS BEEN INSTALLED. CONTRACTOR SHALL REMOVE AND REPLACE ANY EXISTING HARDWARE THAT DOES NOT MEET HFT SPECIFICATIONS AS NOTED IN HARDWARE GROUPS.

HARDWARE GROUP

GROUP #1 (MANAGER, UTILITY)	GROUP #2 (SUPPORT OFFICE DOORS)	GROUP #3 (BREAK ROOM)	GROUP #4 (RESTROOMS)	GROUP #5 (OVERHEAD DOORS)	GROUP #6 (ALARMED) (SINGLE EXIT DOORS)
BUTTS: 1- 1/2 PAIR MCKINNEY MP 79, 4 1/2" x 4 1/2", 26D.	BUTTS: 1- 1/2 PAIR MCKINNEY MP 79, 4 1/2" x 4 1/2", 26D.	BUTTS: 1- 1/2 PAIR MCKINNEY MP 79, 4 1/2" x 4 1/2", 26D.	BUTTS: 1- 1/2 PAIR HAGER ECBB1100, 4 1/2" x 4 1/2" x US26D.	DOOR PANELS: 2-3/4" INSULATED STEEL INTERLOCKING FLAT SLAT CURTAIN W/ ENDLOCKS @ BOTH ENDS BY VENDOR SCHLAGE KS41F1200	BUTTS: 1- 1/2 PAIR MCKINNEY MP 79, 4 1/2" x 4 1/2", 26D.
LATCH SET: FALCON 'ENTRANCE' LEVER W511HD-D-231F-7 PIN-626	LATCH SET: FALCON 'STOREROOM' LEVER W581HD-D-626	LATCH SET: FALCON 'PASSAGE' LEVER W101S-D-626	LATCH SET: FALCON 'PASSAGE' LEVER T101S-D-626 (MULTI-USE RESTROOMS)		EXIT DEVICE: VON DUPRIN GUARD-X 2670-US28
LATCH GUARD: DON-JO ILP-212-SL	LATCH GUARD: DOOR #3: DON-JO ILP-212-SL DOOR #4: DON-JO ILSL-110-SL	CLOSER: FALCON SC71 RW / PA-689 (MTD. ON INSIDE)	FALCON 'PRIVACY' LEVER T301S-D-626 (SINGLE-USE RESTROOMS)	CYLINDER CORE: FALCON C649 (HCK, IHK)-626 SCHLAGE 80-035-GRN 24 GA. MIN. GALVANIZED STEEL BY VENDOR HAND CHAIN BY VENDOR	CYLINDER CORE: FALCON C207-SC-C26D
CYLINDER CORE: FALCON C649 (CKWY-7 PIN)-626	DEAD BOLT: FALCON D241H-50-231F-7 PIN-626	KICKPLATE: ROCKWOOD K1050 - 10x34 US32D	CLOSER: FALCON SC71 RW / PA-689 (MTD. ON INSIDE)		CONST. CORE: FALCON C607 CCA 7-PIN
CLOSER: FALCON SC71 RW / PA-689 (MTD. ON INSIDE)	CYLINDER CORE: (2) FALCON C649 (CKWY-7 PIN)-626	FLOOR STOP: ROCKWOOD 441-US26D DOME STOP	SILENCER: (3) ROCKWOOD 608-26D	LOCKING: CHAIN KEEPER (BY VENDOR) WITH PADLOCK (SUPPLIED BY HFT GC.)	HOUSING: FALCON C953 (CKWY 7-PIN) 626
KICKPLATE: ROCKWOOD K1050 - 10x34 US32D	CLOSER: FALCON SC71 RW / PA-689 (MTD. ON INSIDE)		FLOOR STOP: ROCKWOOD 441-US26D DOME STOP		CLOSER: FALCON SC71 RW / PA-689 (MTD. INSIDE)
SILENCER: (3) ROCKWOOD 608-26D	KICKPLATE: ROCKWOOD K1050 - 10x34 US32D				KICKPLATE: ROCKWOOD K1050 - 10x34 US32D
FLOOR STOP: ROCKWOOD 441-US26D DOME STOP	SILENCER: (3) ROCKWOOD 608-26D				DOOR STOP: ROCKWOOD 472-26D STOP W/ KEEPER
DOOR VIEWER: ROCKWOOD 622-26D (DOOR VIEWERS FOR MANAGER OFFICE SIDE OF DOORS ONLY - NO DOOR VIEWERS INSTALLED ON UTILITY DOORS)	FLOOR STOP: ROCKWOOD 441-US26D DOME STOP				DOOR VIEWER: DOORSOPE DS2000 AL.S
	DOOR VIEWER: ROCKWOOD 622-26D				DOOR BOTTOM: PEMKO 315-CN MILL 36"
					GASKETING: PEMKO 303 AV (1) 36", (2) 84"
					THRESHOLD: PEMKO 171-A MILL 36"
					DOOR PULL: ROCKWOOD 131-26D (MTD. INSIDE)
					LATCH GUARD: DON-JO NLP-110 (EXTERIOR)
					DRIP EDGE: PEMKO 346C RAIN DRIP 40" (EXTERIOR)

DOOR SCHEDULE NOTES

- RATED DOORS SHALL BE A TIGHT-FITTING SMOKE AND DRAFT CONTROL ASSEMBLY.
- ALL EXISTING / NEW DOORS AND HARDWARE SHALL COMPLY WITH CURRENT ADA REGULATIONS. ALL OPERABLE PARTS ON DOORS AND GATES SHALL BE EASY TO GRASP WITH ONE HAND AND NOT REQUIRE GRASPING, PINCHING OR TWISTING OF THE WRIST TO OPERATE.
- ALL INTERIOR / EXTERIOR METAL DOORS SHALL BE 20 GA. MINIMUM.
- ALL DOOR HARDWARE SHALL BE LEVER TYPE OR PANIC HARDWARE.
- EXTERIOR DOORS SHALL BE OPERABLE FROM THE INSIDE WITHOUT THE USE OF A KEY, SPECIAL KNOWLEDGE OR EFFORT.
- OPENINGS SHALL BE A MINIMUM OF 32" WIDE WHEN DOOR IS AT RIGHT ANGLE TO CLOSED POSITION.
- BOTTOM 10" OF ALL DOORS SHALL HAVE A SMOOTH, UNINTERRUPTED SURFACE FOR OPENING BY WHEELCHAIR FOOT REST.
- MAXIMUM EFFORT TO OPERATE DOORS SHALL NOT EXCEED 5 LBS. FOR EXTERIOR DOORS, AND 3 LBS. FOR INTERIOR DOORS WITH A PUSH OR PULL EFFORT BEING APPLIED AT RIGHT ANGLES TO HINGED DOOR AND AT THE CENTER PLANE OF SLIDING OR FOLDING DOORS. COMPENSATING DEVICES OR AUTOMATIC DOOR OPERATIONS MAY BE UTILIZED TO MEET THE ABOVE STANDARDS, WHEN FIRE DOORS ARE REQUIRED. THE MAXIMUM EFFORT TO OPERATE THE DOORWAY MAY BE INCREASED NOT TO EXCEED 14 LBS. W/ CLOSURE.
- SUBMIT HARDWARE CUT SHEETS FOR ANY ALTERNATES TO HFT REPRESENTATIVE PRIOR TO ORDERING HARDWARE FOR APPROVAL.
- REPLACE ALL EXISTING HARDWARE, TO COMPLY WITH HARDWARE SCHEDULE.
- PROVIDE A SIGN ABOVE ALL ENTRANCE DOOR STATING THAT "THIS DOOR IS TO REMAIN UNLOCKED DURING BUSINESS HOURS". LETTERS SHALL BE AT LEAST 1" IN HEIGHT AND SHALL BE WHITE ON A CONTRASTING BACKGROUND.
- CONTRACTOR SHALL COORDINATE KEYING OF LOCKS WITH OWNER PRIOR TO INSTALLATION.
- ALL HARDWARE LISTED TO BE SUPPLIED BY LISTED MANUFACTURER OR EQUAL.
- REPLACE ALL EXISTING HARDWARE, TO COMPLY WITH HARDWARE SCHEDULE.
- EXTERIOR DOORS & FRAMES, EXCLUDING OVERHEAD DOOR, TO BE PAINTED TO MATCH THE ADJ. FINISH ON THE EXTERIOR AND PAINTED P-8 ON THE INTERIOR. SEE FINISH SCHEDULE ON SHEET A1.3.
- INTERIOR DOORS AND FRAMES TO BE PAINTED P-8. SEE FINISH SCHEDULE ON SHEET A1.3.
- BI-PARTING DOOR THRESHOLDS TO BE PROVIDED AND INSTALLED BY DOOR VENDOR.
- PROVIDE 8" HIGH WHITE VINYL NUMBERS STATING STREET ADDRESS IN HELVETICA FONT STYLE ON TRANSOM AT MAIN ENTRY DOOR.
- INTERIOR DOOR FRAMES SHALL BE MIN. 20GA. U.N.O. EXTERIOR DOOR FRAMES SHALL BE MIN. 16GA. WELDED FRAMES, U.N.O.
- ALL EXTERIOR DOORS TO BE ALARMED, U.N.O.

GROUP #6A (ALARMED) NOTE: (NO HARDWARE ON EXTERIOR SIDE, U.N.O.)

BUTTS: 1- 1/2 PAIR MCKINNEY MP 79, 4 1/2" x 4 1/2", 26D.

EXIT DEVICE: VON DUPRIN GUARD-X 2670-US28

CYLINDER CORE: FALCON C207-SC-C26D

CONST. CORE: FALCON C607 CCA 7-PIN

HOUSING: FALCON C953 (CKWY 7-PIN) 626

CLOSER: FALCON SC71 RW / PA-689 (MTD. INSIDE)

KICKPLATE: ROCKWOOD K1050 - 10x34 US32D

DOOR STOP: ROCKWOOD 472-26D STOP W/ KEEPER

DOOR BOTTOM: PEMKO 315-CN MILL 36"


GASKETING: PEMKO 303 AV (1) 36", (2) 84"

THRESHOLD: PEMKO 171-A MILL 36"


DOOR PULL: ROCKWOOD 131-26D (MTD. INSIDE)

LATCH GUARD: DON-JO NLP-110 (EXTERIOR)


DRIP EDGE: PEMKO 346C RAIN DRIP 40" (EXTERIOR)

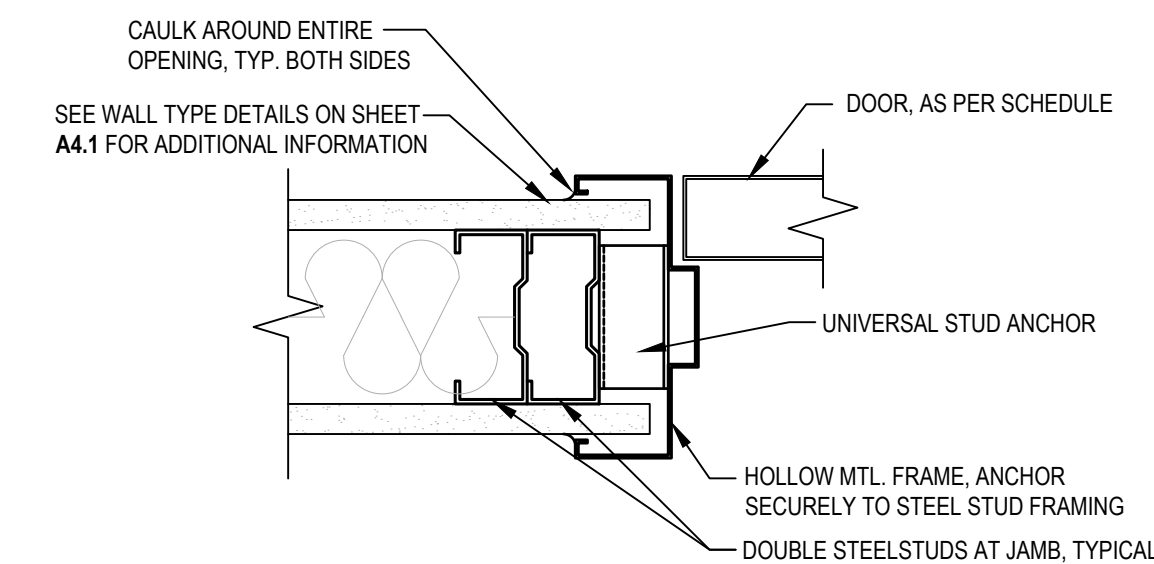

A TYP. INTERIOR DOOR JAMB DETAIL
SCALE: 3" = 1'-0"

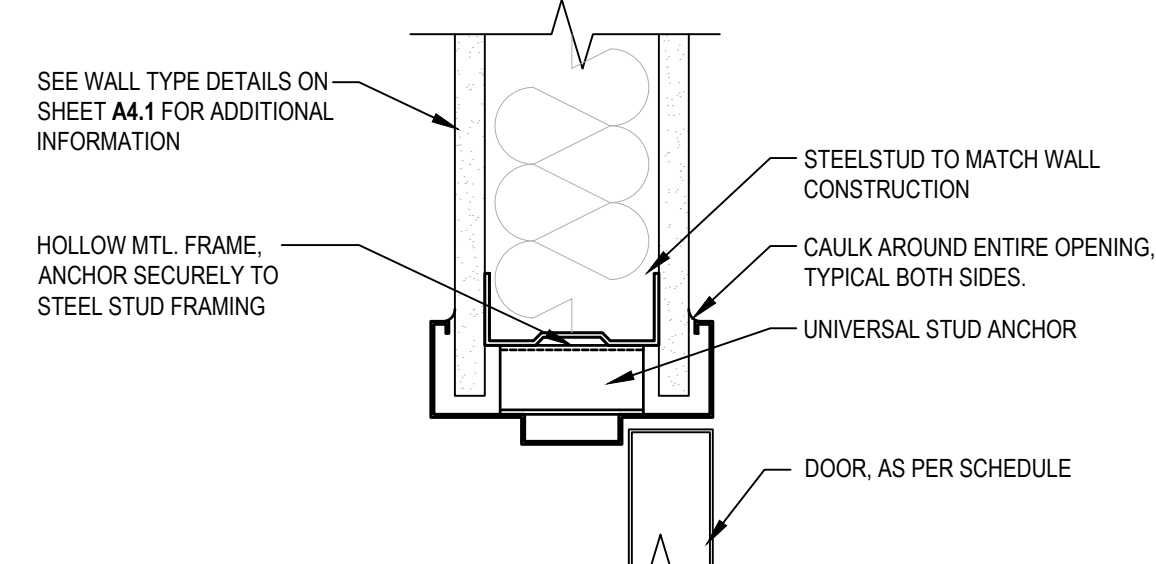


B TYP. INTERIOR DOOR HEAD DETAIL
SCALE: 3" = 1'-0"

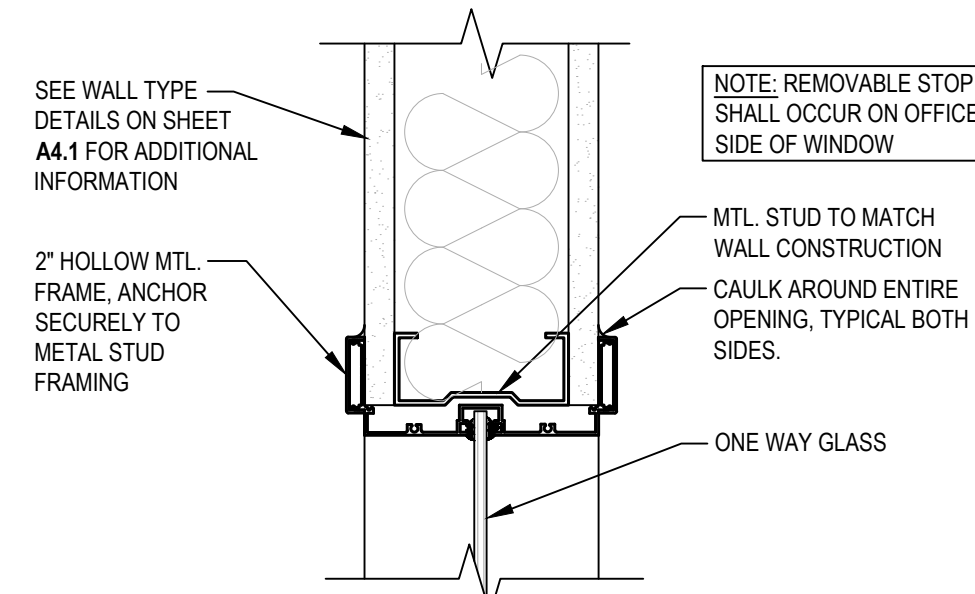


C TYP. INTERIOR WINDOW HEAD DETAIL
SCALE: 3" = 1'-0"

DOOR TYPES

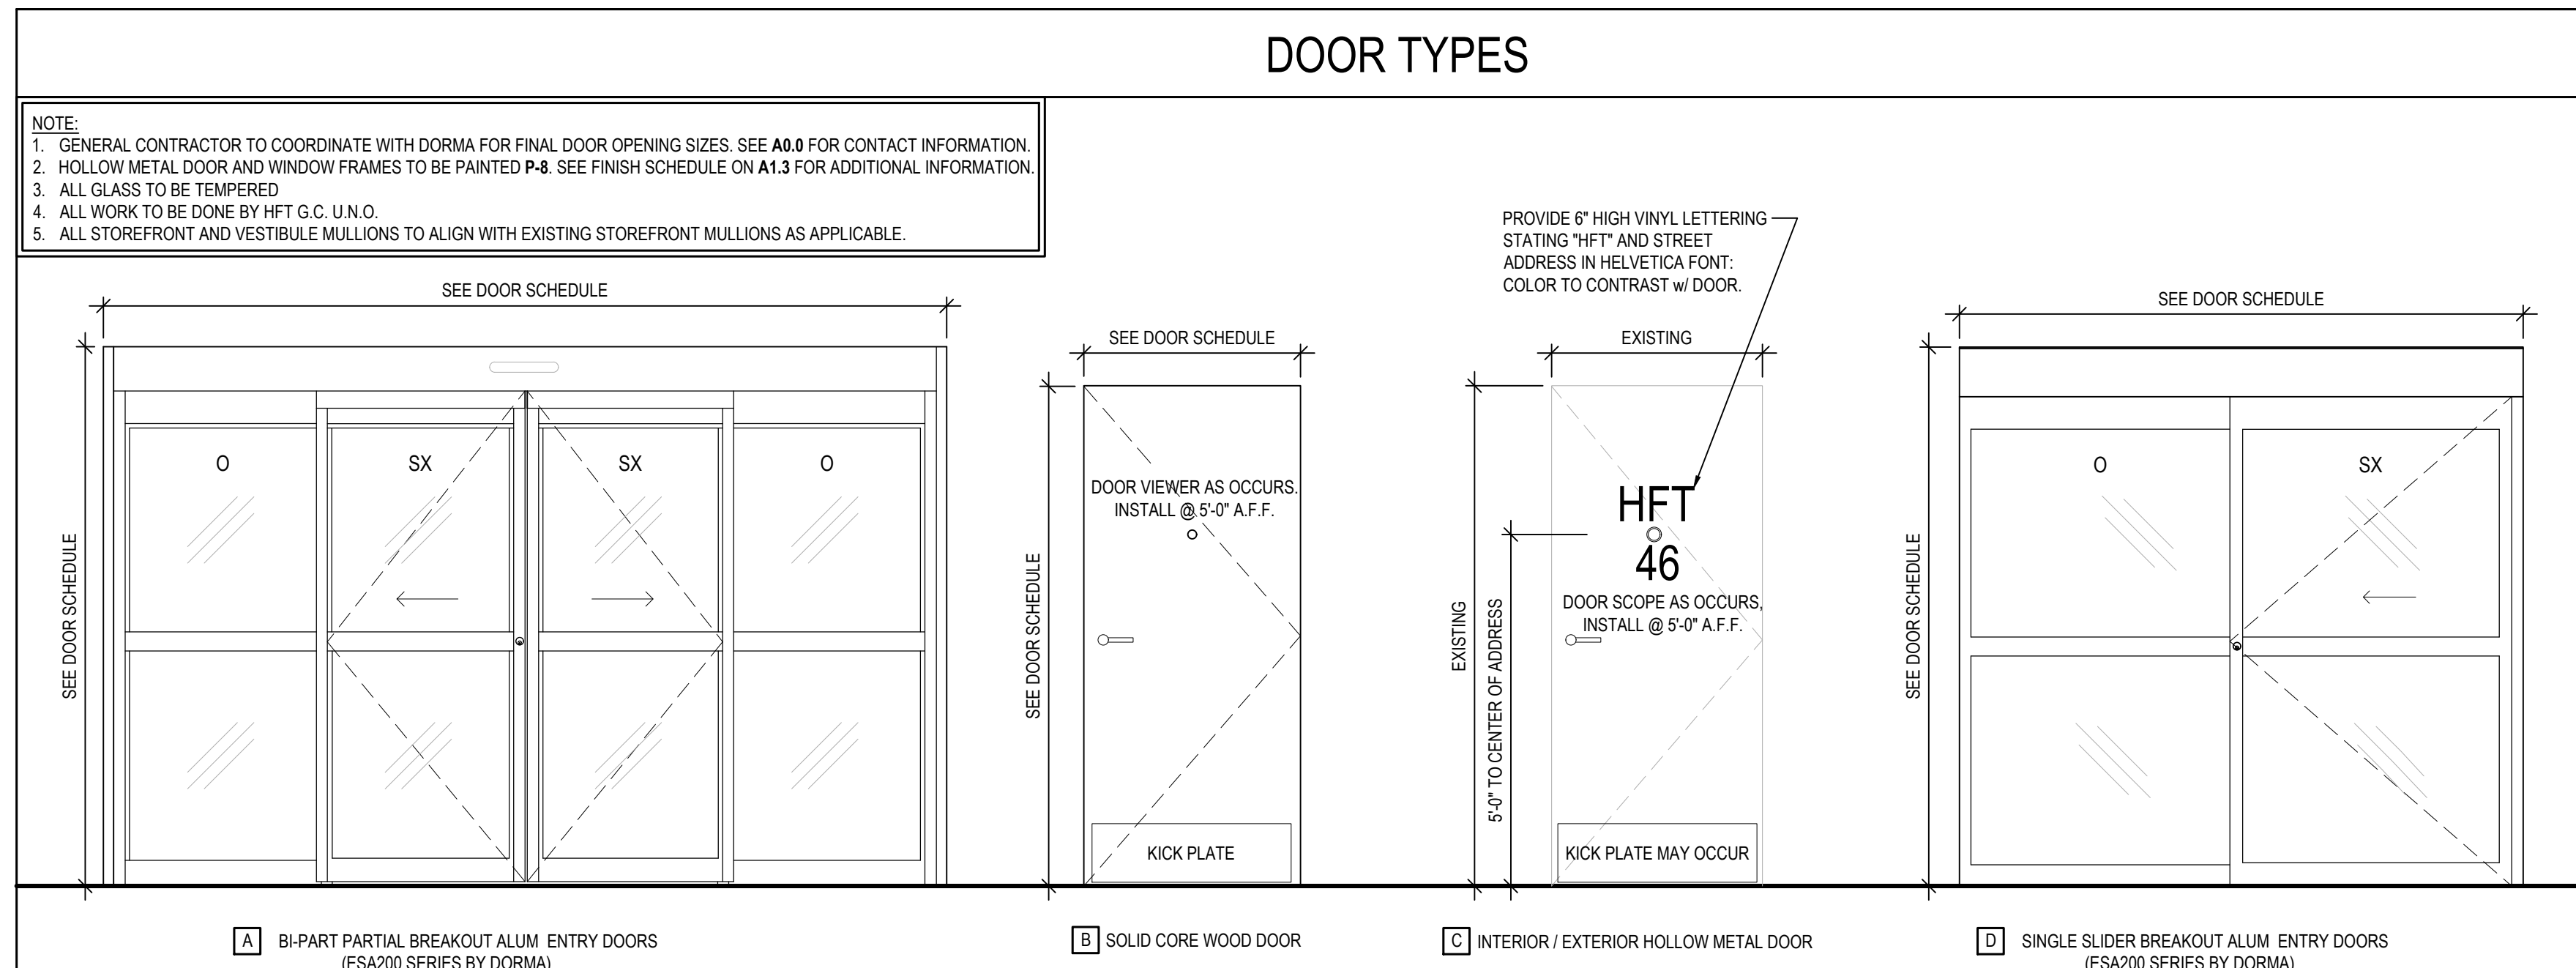

FRAME TYPES

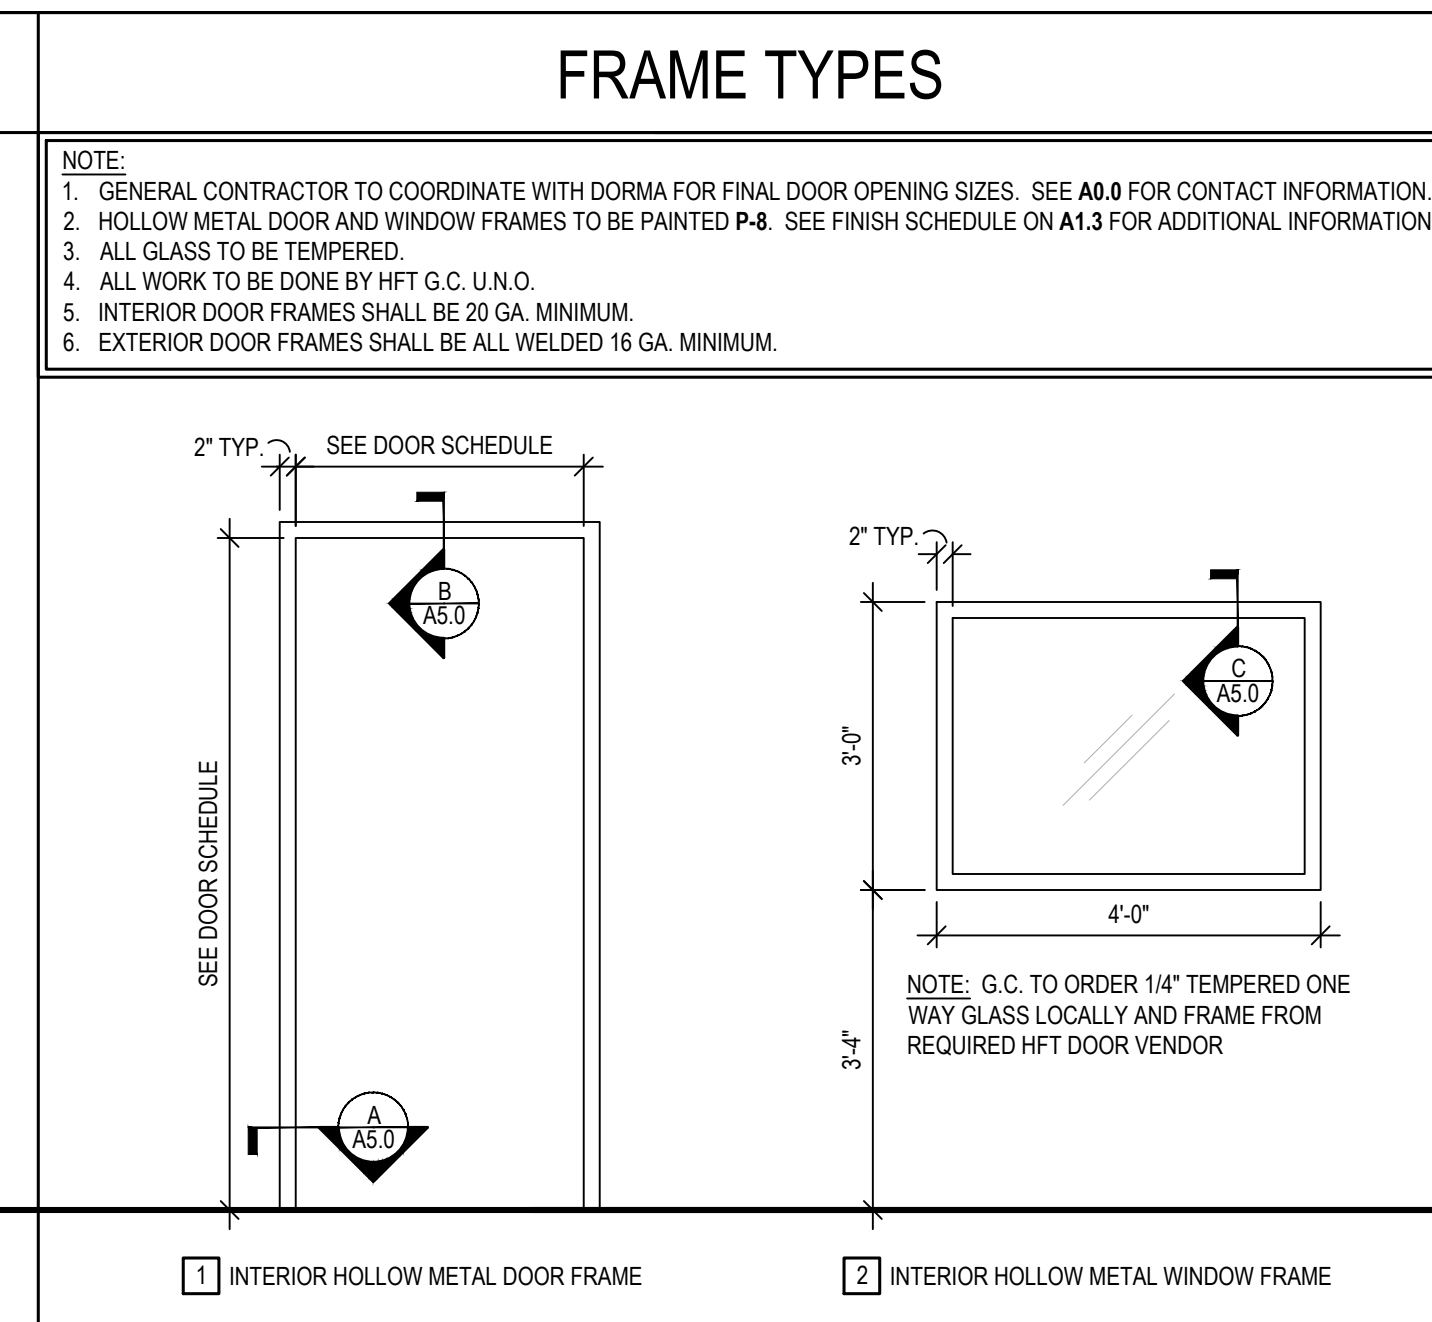

DO NOT SCALE THESE DRAWINGS

REVISIONS

#	DATE	TYPE
1		
2		
3		
4		
5		
6		
7		
8		
9		
10		

DOOR SCHEDULE & DETAILS

DATE: 05/17/24

JOB NO.: 23475

A5.0

SHEET NO.


ADA ARCHITECTS
Lakewood, Ohio 44107
17710 Detroit Avenue
Phone (216) 521-1534
Fax (216) 521-4824
www.adaarchitects.com

HARBOR FREIGHT
46 SHRUI LANE
ERWIN, NC 28839

THESE DOCUMENTS CONTAIN INFORMATION PROPRIETARY TO ADA ARCHITECTS, INC. UNAUTHORIZED USE OF THESE DOCUMENTS IS EXPRESSLY PROHIBITED UNLESS AGREED UPON IN WRITING.



05/17/24

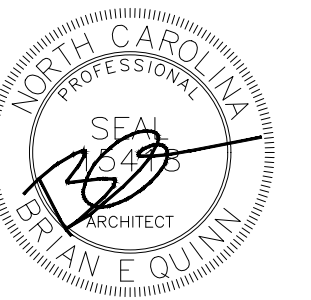

05/17/24

GENERAL NOTES

- ALL GLAZING TO BE 1/4" TEMPERED.
- ALL WORK TO BE DONE BY HFT G.C. U.N.O.
- ALL STOREFRONT AND VESTIBULE MULLIONS TO ALIGN WITH EXISTING STOREFRONT MULLIONS AS APPLICABLE.

800 SERIES VESTIBULE KEY NOTES


- DENOTES EMERGENCY DOOR BREAK OUT.
- DENOTES DORMA BI-PARTING ENTRY DOOR PACKAGE. TO BE CONSTRUCTED BY DORMA.
- STOREFRONT SYSTEM TO MATCH EXISTING STOREFRONT FINISH.
- 4-1/2" ALUMINUM POST, FINISH TO MATCH DOOR SYSTEM, TYP.
- DENOTES DORMA SINGLE SLIDING ENTRY DOOR PACKAGE. TO BE CONSTRUCTED BY DORMA.
- EXISTING DORMA BI-PARTING ENTRY DOOR WITH EMERGENCY BREAK OUT BY LANDLORD UNDER A SEPARATE PERMIT.

NOTE: G.C. TO FIELD VERIFY ALL EXISTING DIMENSIONS AND COORDINATE WITH DORMA DOOR BEFORE ORDERING. NOTIFY ARCHITECT OF ANY DISCREPANCIES.


NOTE: ALL NEW ALUMINUM STOREFRONT FINISH TO MATCH DOOR SYSTEM IN DOOR SCHEDULE ON SHEET A5.0 (FINISH: CLEAR ANODIZED)

NOTE: ANY PENETRATIONS MADE INTO ROOF DECK MUST USE GALVANIZED SMS WITH APPROPRIATE RUBBER WASHERS TO PREVENT WATER INFILTRATION


NOTE: ANY PENETRATIONS MADE INTO ROOF DECK MUST USE GALVANIZED SMS WITH APPROPRIATE RUBBER WASHERS TO PREVENT WATER INFILTRATION

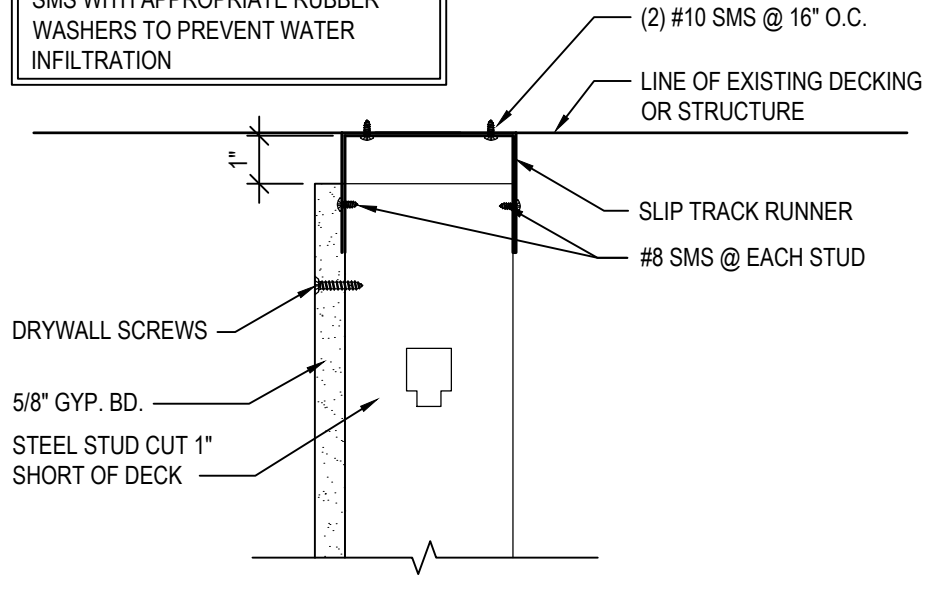


5 TYPICAL SLIP TRACK DETAIL
A5.1 SCALE: 3" = 1'-0"

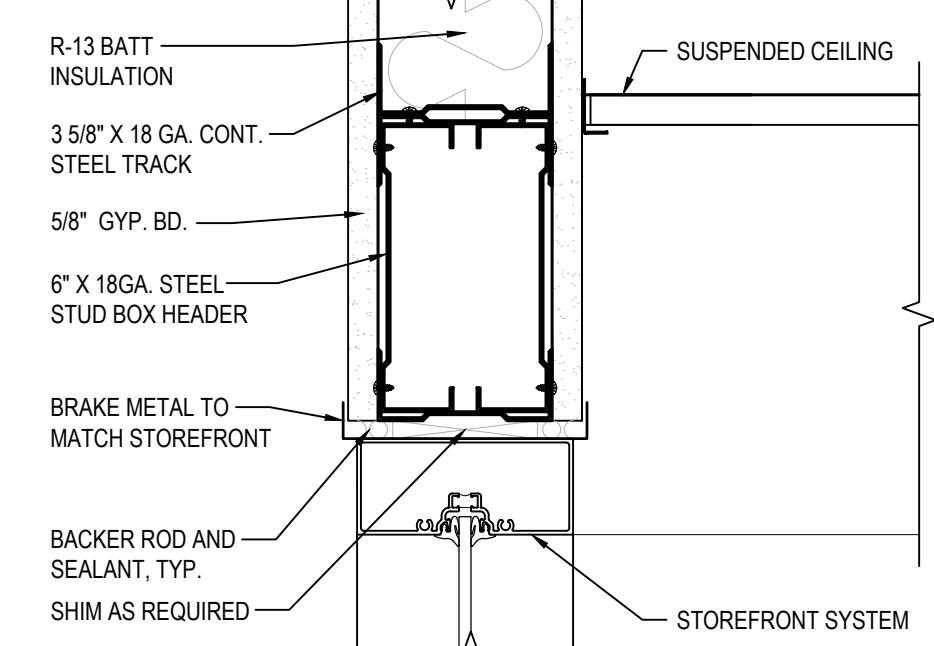

4 VESTIBULE HEAD DETAIL
A5.1 SCALE: 3" = 1'-0"

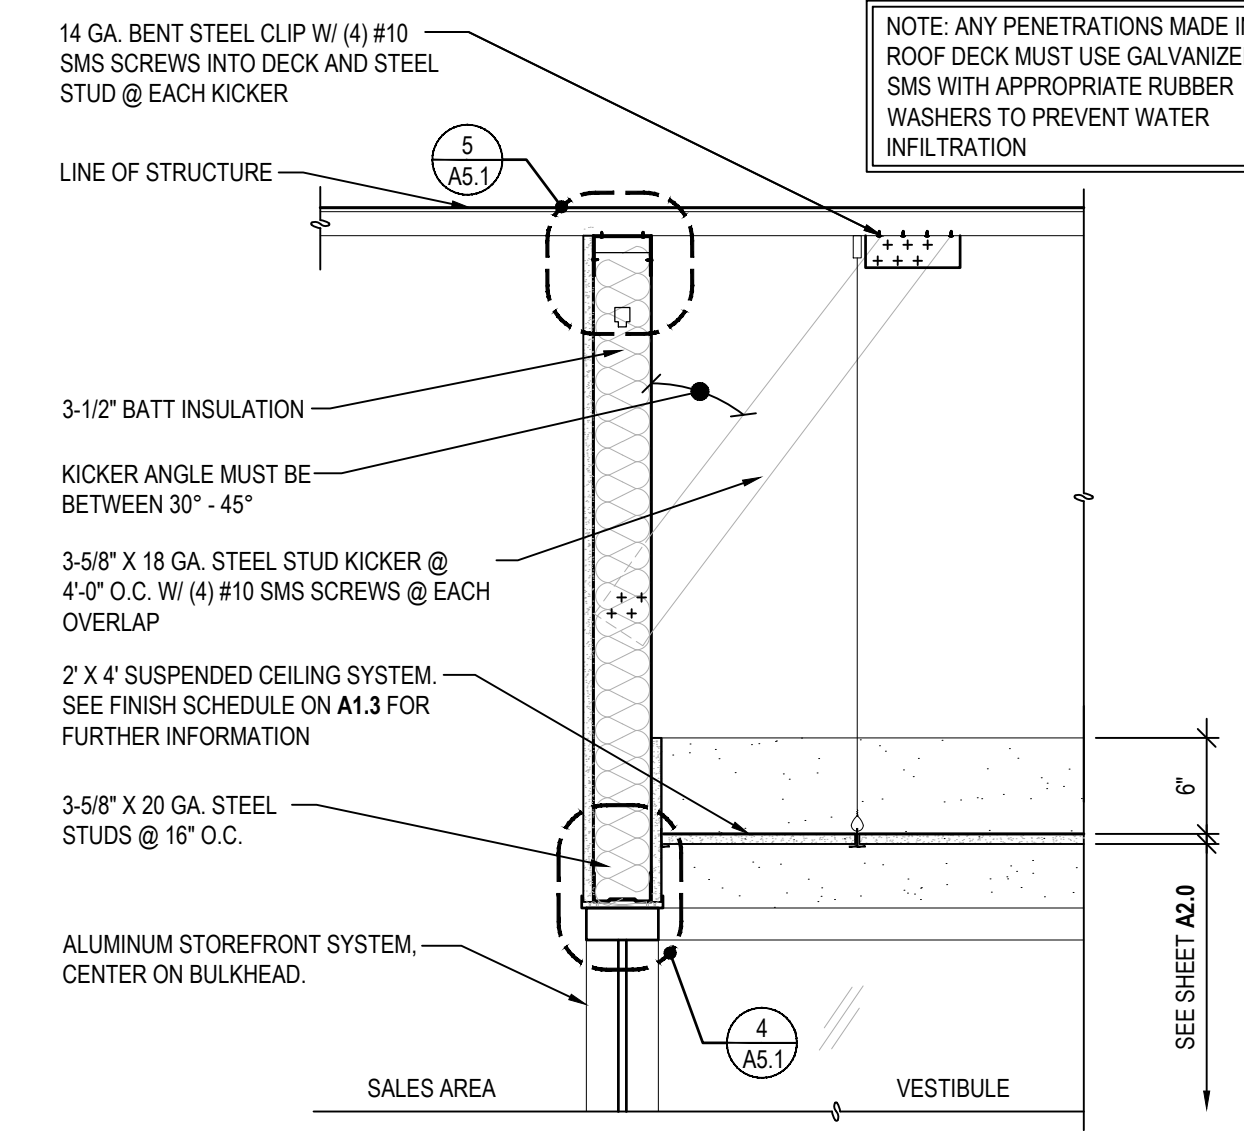


3 VESTIBULE BULKHEAD SECTION
A5.1 SCALE: 1" = 1'-0"

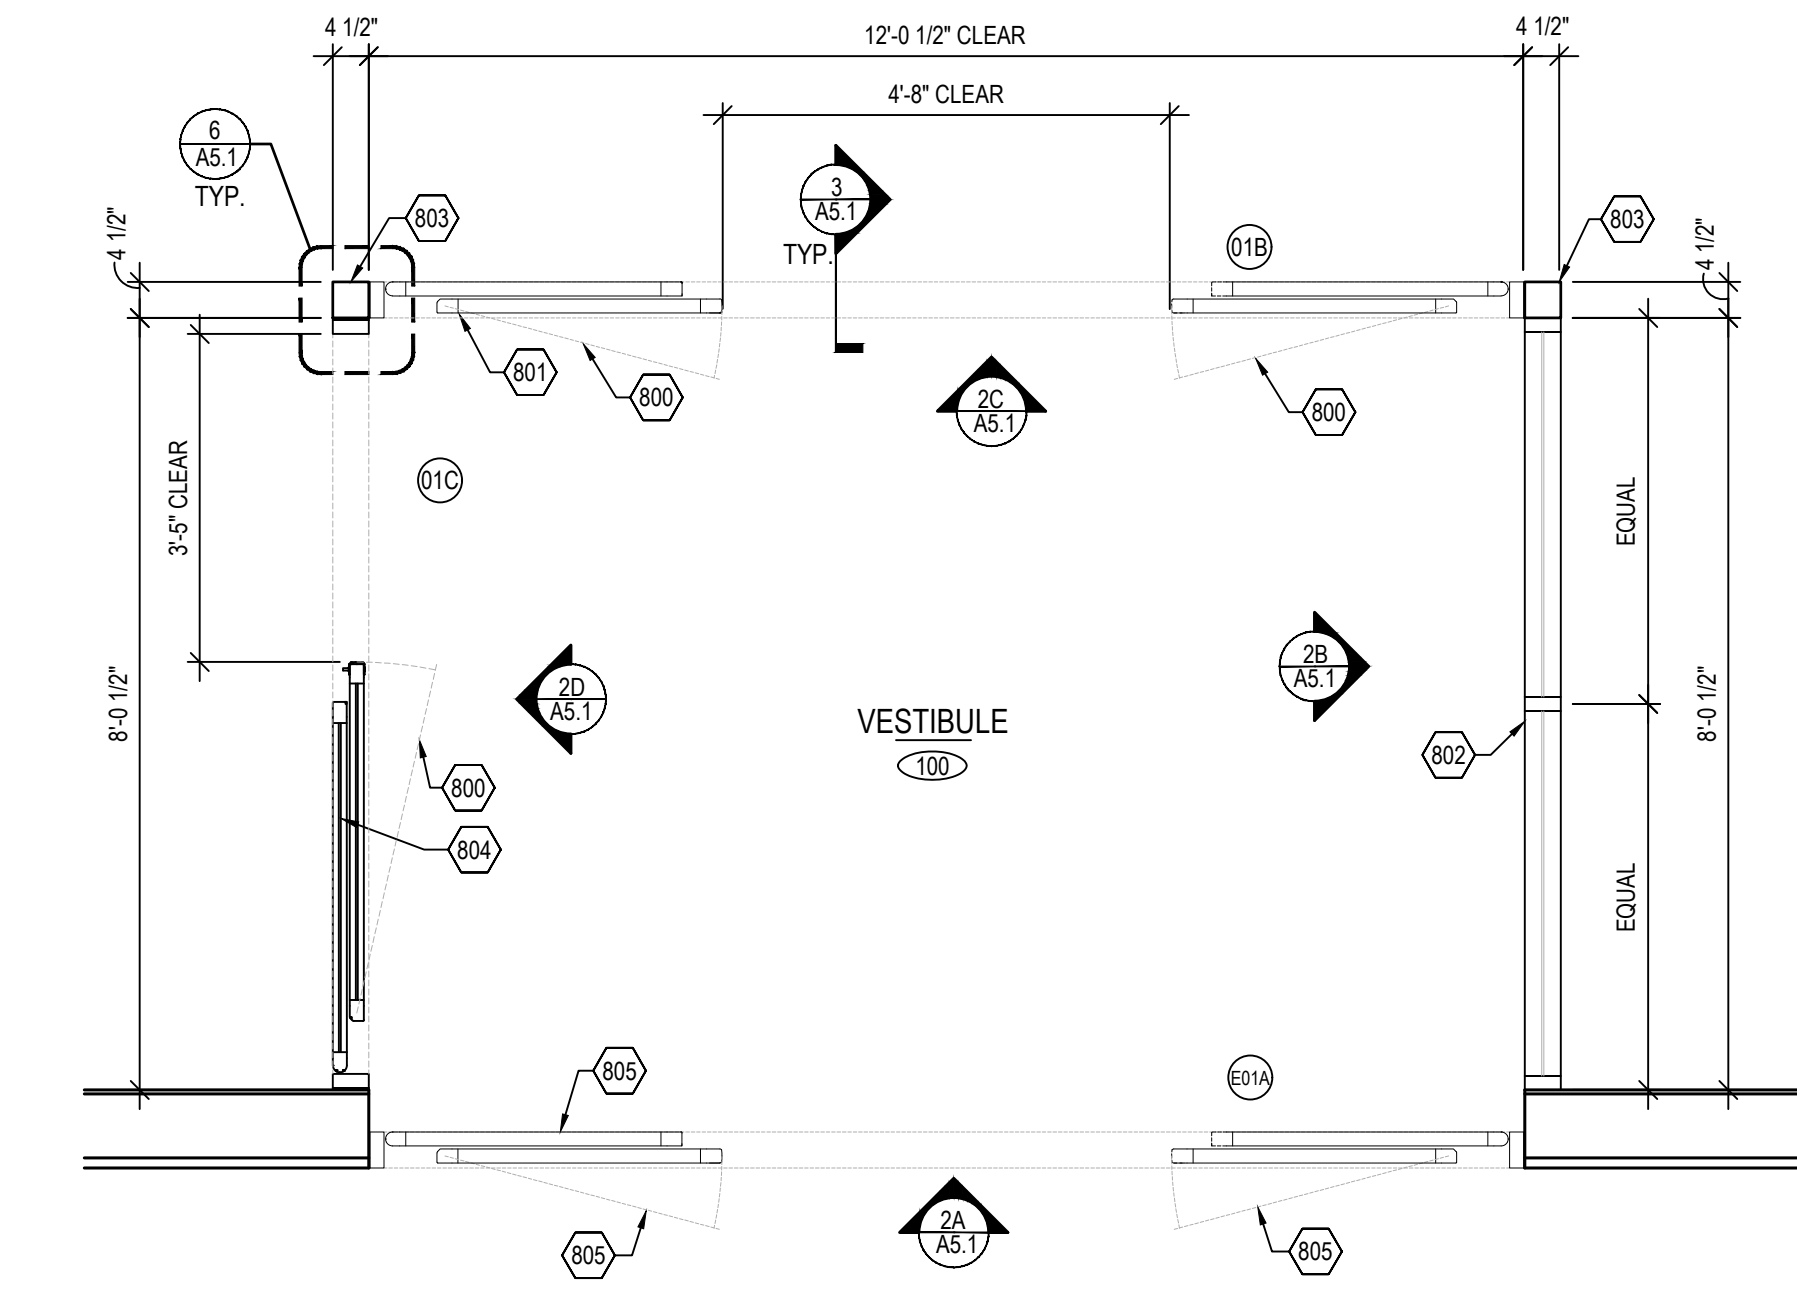


1 VESTIBULE PLAN DETAIL
A5.1 SCALE: 1/2" = 1'-0"


NOTE: ALL BUILDING ENTRANCES ACCESSIBLE TO & USABLE BY PERSONS WITH DISABILITIES SHALL BE IDENTIFIED WITH AT LEAST ONE STANDARD SIGN AND WITH ADDITIONAL DIRECTIONAL SIGNS, AS REQUIRED, TO BE VISIBLE TO PERSONS ALONG APPROACHING PEDESTRIAN WAYS.

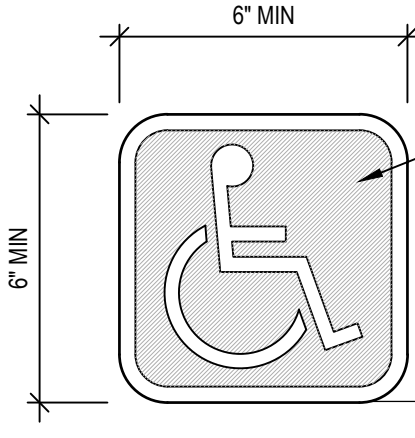

7 ACCESSIBLE ENTRANCE SIGNAGE
A5.1 SCALE: 3" = 1'-0"

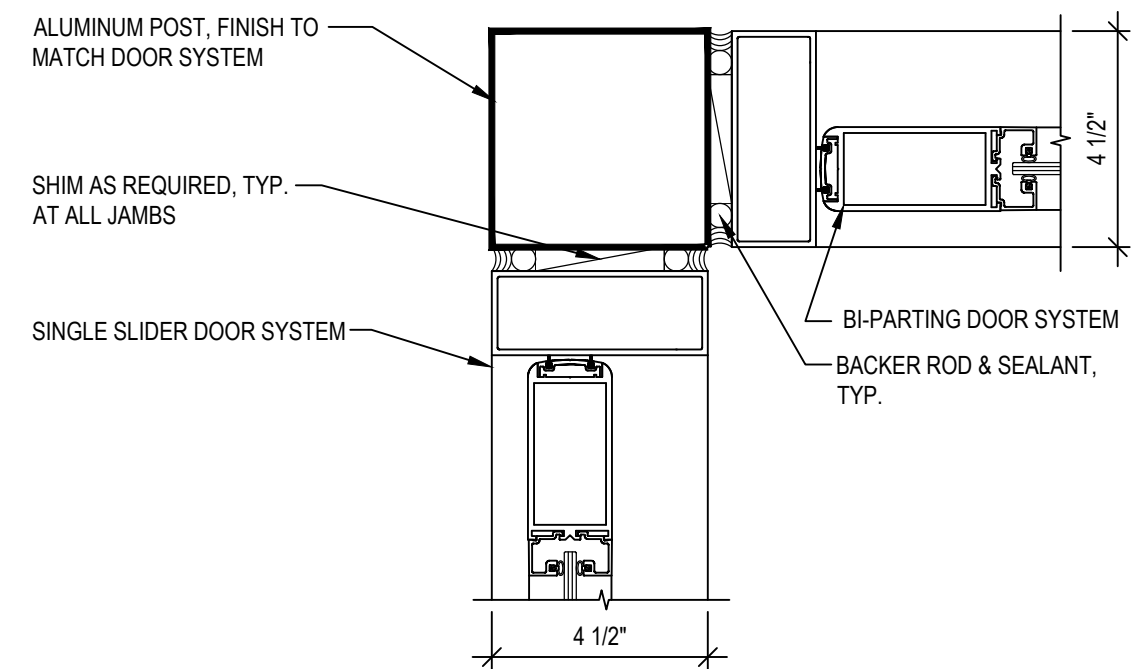


6 STOREFRONT JAMB DETAIL
A5.1 SCALE: 3" = 1'-0"

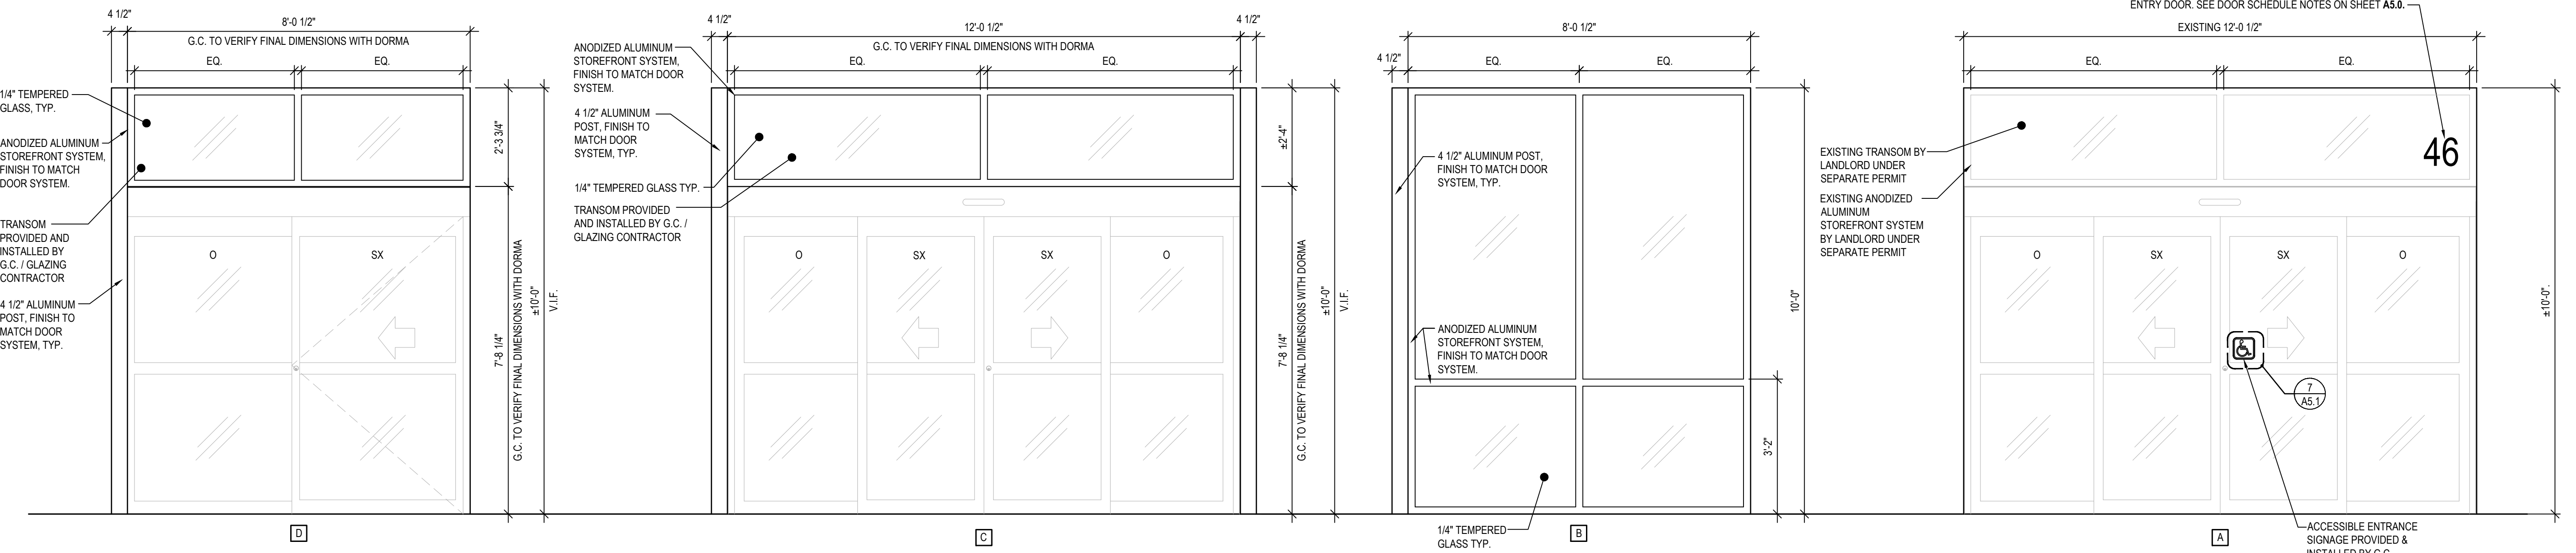

2 STOREFRONT ELEVATIONS
A5.1 SCALE: 1/2" = 1'-0"

PROVIDE 8" HIGH WHITE VINYL NUMBERS STATING STREET ADDRESS IN HELVETICA FONT STYLE ON TRANSOM AT MAIN ENTRY DOOR. SEE DOOR SCHEDULE NOTES ON SHEET A5.0.

46

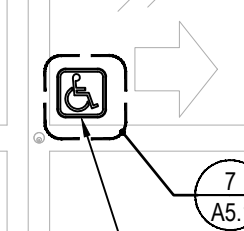

ACCESSIBLE ENTRANCE SIGNAGE PROVIDED & INSTALLED BY G.C.

DO NOT SCALE THESE DRAWINGS

ADA ARCHITECTS
Lakewood, Ohio 44107
17710 Detroit Avenue
Phone (216) 521-5134 Fax (216) 521-4824
www.adaarchitects.com

HARBOR FREIGHT
ERWIN, NC 28839
46 SHRUI LANE

THESE DOCUMENTS CONTAIN INFORMATION PROPRIETARY TO ADA ARCHITECTS, INC.
UNAUTHORIZED USE OF THESE DOCUMENTS IS EXPRESSLY PROHIBITED UNLESS AGREED UPON IN WRITING.

REVISIONS	
#	DATE
1	
2	
3	
4	
5	
6	
7	
8	
9	
10	

ENLARGED VESTIBULE PLAN & DETAILS

DATE 05/17/24
JOB NO. 23475


A5.1
SHEET NO.




05/17/24

GENERAL NOTES


1. ALL TURNSTILE COMPONENTS TO BE SUPPLIED BY HFT, U.N.O.
2. ALL WORK TO BE DONE BY G.C., U.N.O.
3. SEE SHEET **A0.0** FOR ADDITIONAL INFORMATION.

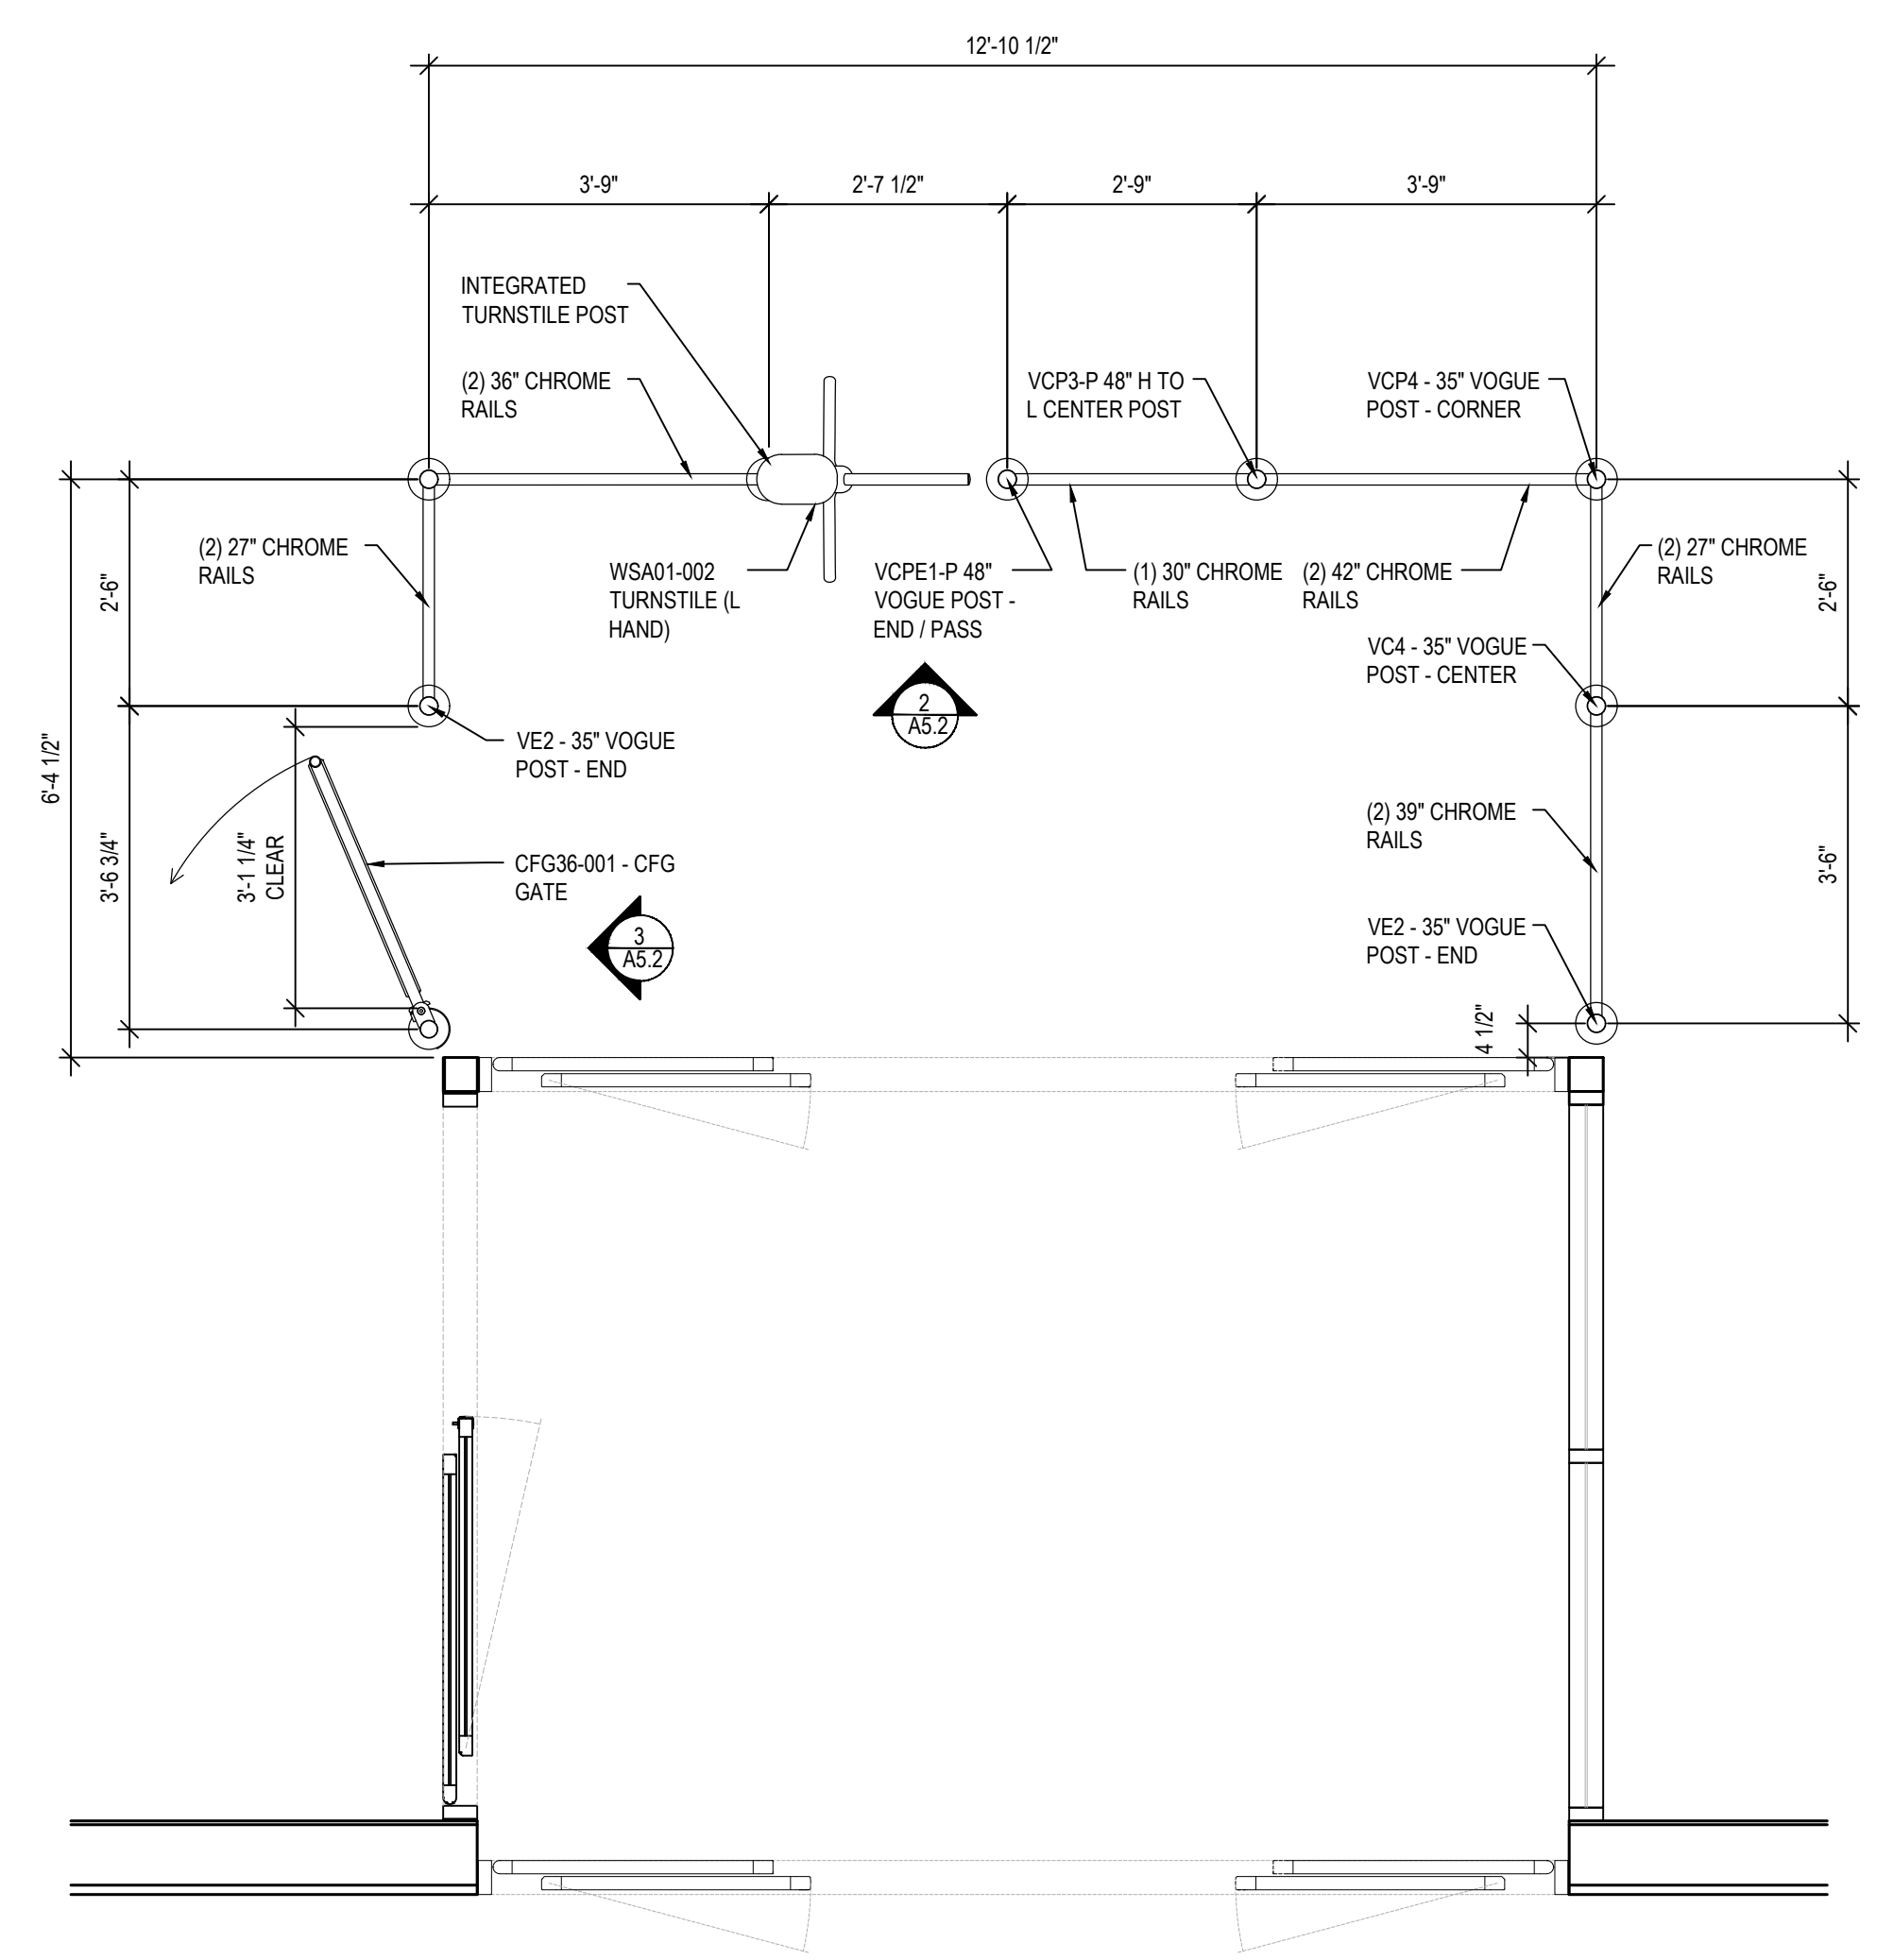

1
TURNSTILE PLAN DETAIL
SCALE: 1/2" = 1'-0"

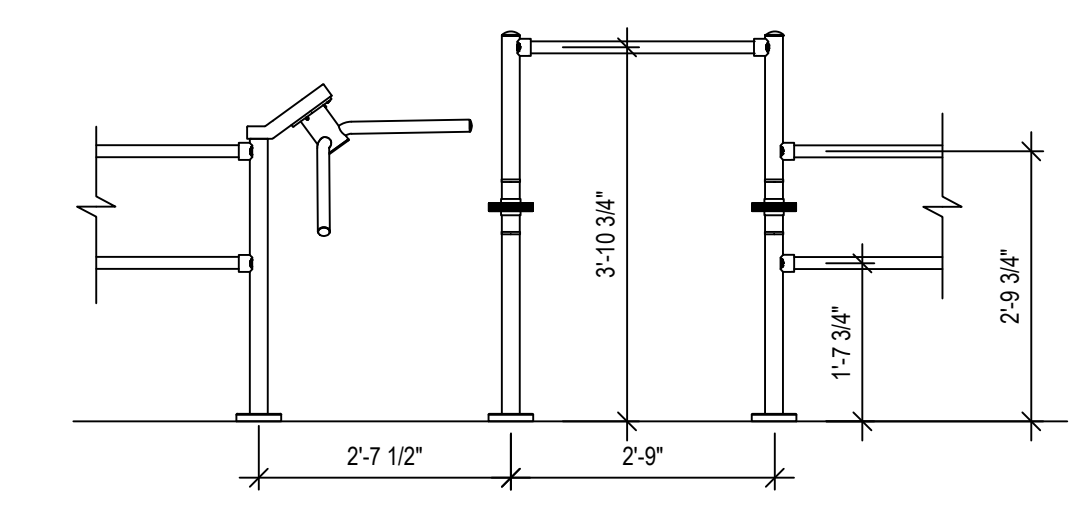

2
TURNSTILE ELEVATION
SCALE: 1/2" = 1'-0"

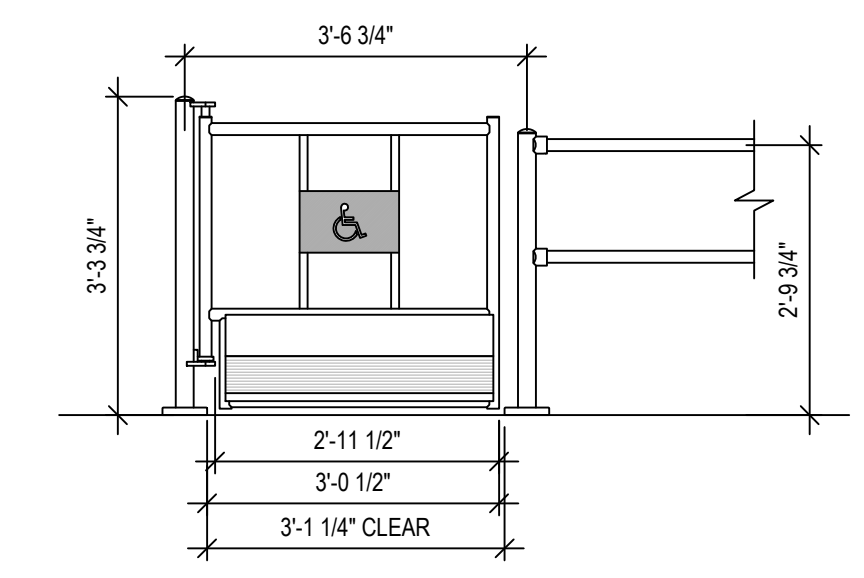

3
GATE ELEVATION
SCALE: 1/2" = 1'-0"

DO NOT SCALE THESE DRAWINGS

REVISIONS	
#	DATE
1	
2	
3	
4	
5	
6	
7	
8	
9	
10	

ENLARGED
TURNSTILE PLAN
& DETAILS

DATE 05/17/24

JOB NO. 23475

A5.2
SHEET NO.

HARBOR FREIGHT

46 SHRUI LANE
ERWIN, NC 28839

THESE DOCUMENTS CONTAIN INFORMATION PROPRIETARY TO ADA ARCHITECTS, INC.
UNAUTHORIZED USE OF THESE DOCUMENTS IS EXPRESSLY PROHIBITED UNLESS AGREED UPON IN WRITING.



17710 Detroit Avenue
Lakewood, Ohio 44107
Phone (216) 521-5134
Fax (216) 521-4824
www.adaarchitects.com

MECHANICAL EQUIPMENT TAG NOTES:

- MECHANICAL CONTRACTOR SHALL INSTALL NEW LENNOX ROOFTOP UNIT AND ROOF CURB. MECHANICAL CONTRACTOR SHALL FURNISH AND INSTALL ROOF CURB FOR NEW ROOFTOP UNIT. PROVIDE NEW ROOF OPENINGS AS NECESSARY TO ACCOMMODATE NEW ROOFTOP UNIT. REFER TO ROOFTOP UNIT SCHEDULE ON DWG. M1.1 FOR ADDITIONAL INFORMATION. THE WEIGHT OF THE NEW ROOFTOP UNIT IS 1600 LBS.
- MECHANICAL CONTRACTOR SHALL INSTALL NEW LENNOX ROOFTOP UNIT AND ROOF CURB. MECHANICAL CONTRACTOR SHALL FURNISH AND INSTALL ROOF CURB FOR NEW ROOFTOP UNIT. PROVIDE NEW ROOF OPENINGS AS NECESSARY TO ACCOMMODATE NEW ROOFTOP UNIT. REFER TO ROOFTOP UNIT SCHEDULE ON DWG. M1.1 FOR ADDITIONAL INFORMATION. THE WEIGHT OF THE NEW ROOFTOP UNIT IS 1400 LBS.

NOTE:
MECHANICAL CONTRACTOR SHALL ENSURE ALL NEW EXPOSED DUCTWORK IS SEALED CLEANLY IN THE EVENT IT DOES NOT RECEIVE A FINAL PAINTED FINISH. COORDINATE WORK WITH GENERAL CONTRACTOR AND HARBOR FREIGHT TOOLS' PROJECT MANAGER.

NOTE:
MECHANICAL CONTRACTOR SHALL PERFORM AN HVAC SYSTEM CHECK PRIOR TO AND AFTER COMPLETION OF SIEMENS' SCOPE OF WORK INCLUDING THE SMOKE DETECTOR "TEST/RESET" BUTTON.

NOTE:
MECHANICAL CONTRACTOR SHALL FURNISH AND INSTALL BURGLAR BARS IN THE DUCT DROPS OF THE NEW ROOFTOP UNITS.

NOTE:
MECHANICAL CONTRACTOR SHALL REFER TO DRAWING M1.1 FOR LABELING OF EQUIPMENT PROCEDURE.

NOTE:
MECHANICAL CONTRACTOR SHALL REMOVE ALL EXISTING UNUSED MECHANICAL EQUIPMENT, UNIT HEATERS, EXHAUST FAN(S), DUCTWORK, DIFFUSER(S), ETC... COMPLETELY UNLESS OTHERWISE NOTED TO REMAIN. GENERAL CONTRACTOR SHALL ENGAGE LANDLORD'S ROOFING CONTRACTOR FOR ALL ROOFING WORK. MECHANICAL CONTRACTOR SHALL COORDINATE WITH ELECTRICAL CONTRACTOR TO DISCONNECT ELECTRICAL SERVICE FROM EQUIPMENT BEING REMOVED AND COORDINATE WITH PLUMBING CONTRACTOR FOR DISCONNECTING GAS FROM EQUIPMENT BEING REMOVED.

NOTE:
GENERAL CONTRACTOR SHALL ENGAGE LANDLORD'S ROOFING CONTRACTOR FOR ANY ROOFING WORK.

NOTE:
MECHANICAL CONTRACTOR SHALL REFER TO THE SIEMENS EMS DRAWING SET (EMS-1 THRU EMS-4) FOR COMPLETE INTERFACE REQUIREMENTS.

NOTE:
MECHANICAL CONTRACTOR SHALL LEAVE ROOFTOP UNITS IN WIRED THERMOSTAT MODE UNTIL COMMISSIONING.


MECHANICAL GENERAL NOTES:

- THESE DRAWINGS ARE DIAGRAMMATIC IN NATURE. THE MECHANICAL CONTRACTOR SHALL INCLUDE ALL NEEDED OFFSETS, CHANGES IN DIRECTION, TRANSITIONS, ETC. NEEDED FOR COMPLETE AND OPERATIONAL SYSTEMS.
- PERFORM ALL WORK IN ACCORDANCE WITH THE RULES & REGULATIONS OF THE APPROPRIATE STATE AND LOCAL BUILDING CODES AND SUBTITLES.
- QUESTIONS REGARDING THESE DRAWINGS SHALL BE ADDRESSED TO THE ENGINEER PRIOR TO THE AWARDED OF THE CONTRACT. OTHERWISE THE ENGINEER'S INTERPRETATION OF THE MEANING AND INTENT OF THE DRAWINGS SHALL BE FINAL.
- IF CONFLICTS EXIST, PRIORITY OF LOCATION IN REFLECTED CEILING GRID SHALL BE AS FOLLOWS FROM HIGH TO LOW: SPRINKLER, MECHANICAL, LIGHTS, AND FIRE ALARM DEVICES (AS APPLICABLE).
- SENSORS AS MANUFACTURED BY SIEMENS. MECHANICAL CONTRACTOR SHALL LABEL EACH SENSOR APPROPRIATELY TO THE CORRESPONDING ROOFTOP UNIT IT SERVES. TOUCHPAD SHALL BE LOCATED IN THE MANAGER'S OFFICE. MECHANICAL CONTRACTOR SHALL COORDINATE WITH ELECTRICAL CONTRACTOR.

MECHANICAL GENERAL NOTES (CONTINUED):

- MECHANICAL CONTRACTOR SHALL PROVIDE AN AIR BALANCE REPORT TO VERIFY THAT THE HVAC EQUIPMENT IS FULLY OPERATIONAL. AIR BALANCE REPORT SHALL BE PREPARED BY A THIRD PARTY HIRED BY THE GENERAL CONTRACTOR. PAYMENT OF ALL COSTS FOR TESTING SHALL BE MADE BY THE MECHANICAL CONTRACTOR. TURN OVER AIR BALANCE REPORT TO HARBOR FREIGHT TOOLS' GENERAL CONTRACTOR FOR DISTRIBUTION. REFER TO MECHANICAL SPECIFICATIONS ON DWG. M1.3 FOR ADDITIONAL INFORMATION REGARDING TESTING AND BALANCING.
- MECHANICAL CONTRACTOR ENSURE THERE ARE FILTERS IN ALL ROOFTOP UNITS DURING CONSTRUCTION AND SHALL INSTALL NEW FILTERS DURING CONSTRUCTION AND REPLACE ALL FILTERS PRIOR TO TURNOVER AND DATE ALL FILTERS WITH INSTALL DATE.
- MECHANICAL CONTRACTOR SHALL RUN ALL DUCTWORK AS HIGH AS POSSIBLE; MINIMUM OF 12'-6" A.F.F.
- MECHANICAL CONTRACTOR SHALL COORDINATE THE EXACT LOCATION OF SPACE TEMPERATURE SENSORS, RELATIVE HUMIDITY SENSOR AND CARBON DIOXIDE SENSORS WITH SALES FLOOR FIXTURES AND GENERAL CONTRACTOR PRIOR TO INSTALLING SENSORS.
- THE MECHANICAL CONTRACTOR SHALL BE ON SITE AS THE EMS COMMISSIONING IS BEING PERFORMED TO ENSURE ALL THE REQUIREMENTS ARE RESPONDED TO IF NOT PERFORMING CORRECTLY.
- MECHANICAL CONTRACTOR SHALL FURNISH AND INSTALL ROOF CURBS COMPLETE WITH BURGLAR BARS FOR ROOFTOP UNITS. MECHANICAL CONTRACTOR SHALL CONFIRM ROOF CURB HEIGHT, ROOF SLOPE, ETC. TO ORDER PROPER ROOF CURB.

MECHANICAL LEGEND	
SYMBOL	DESCRIPTION
SA	SUPPLY AIR
EA	EXHAUST AIR
EF	EXHAUST FAN
EG	EXHAUST GRILLE
CD	CEILING DIFFUSER
OA	OUTSIDE AIR
RA	RETURN AIR
TG	TRANSFER GRILLE
RTU	ROOFTOP UNIT
AFF	ABOVE FINISH FLOOR
MC	MECHANICAL CONTRACTOR
PC	PLUMBING CONTRACTOR
EC	ELECTRICAL CONTRACTOR
GC	GENERAL CONTRACTOR
LL	LANDLORD
Ⓚ	DUCT TEMPERATURE SENSOR
Ⓛ	THERMOSTAT (MTD. 4'-0" AFF)
Ⓜ	SPACE TEMPERATURE SENSOR (AS NOTED)
Ⓝ	SMOKE DETECTOR
Ⓞ	RELATIVE HUMIDITY
Ⓟ	FLEXIBLE DUCT (8'-0" MAX. LENGTH)
Ⓠ	FLEXIBLE DUCT CONNECTOR
Ⓡ	MANUAL VOLUME DAMPER
Ⓢ	ELBOW W/ DBL THICKNESS TURNING VANES
Ⓣ	FRESH RETURN EXHAUST AIR DUCT
Ⓤ	SUPPLY AIR DUCT
E.S.P.	EXTERNAL STATIC PRESSURE

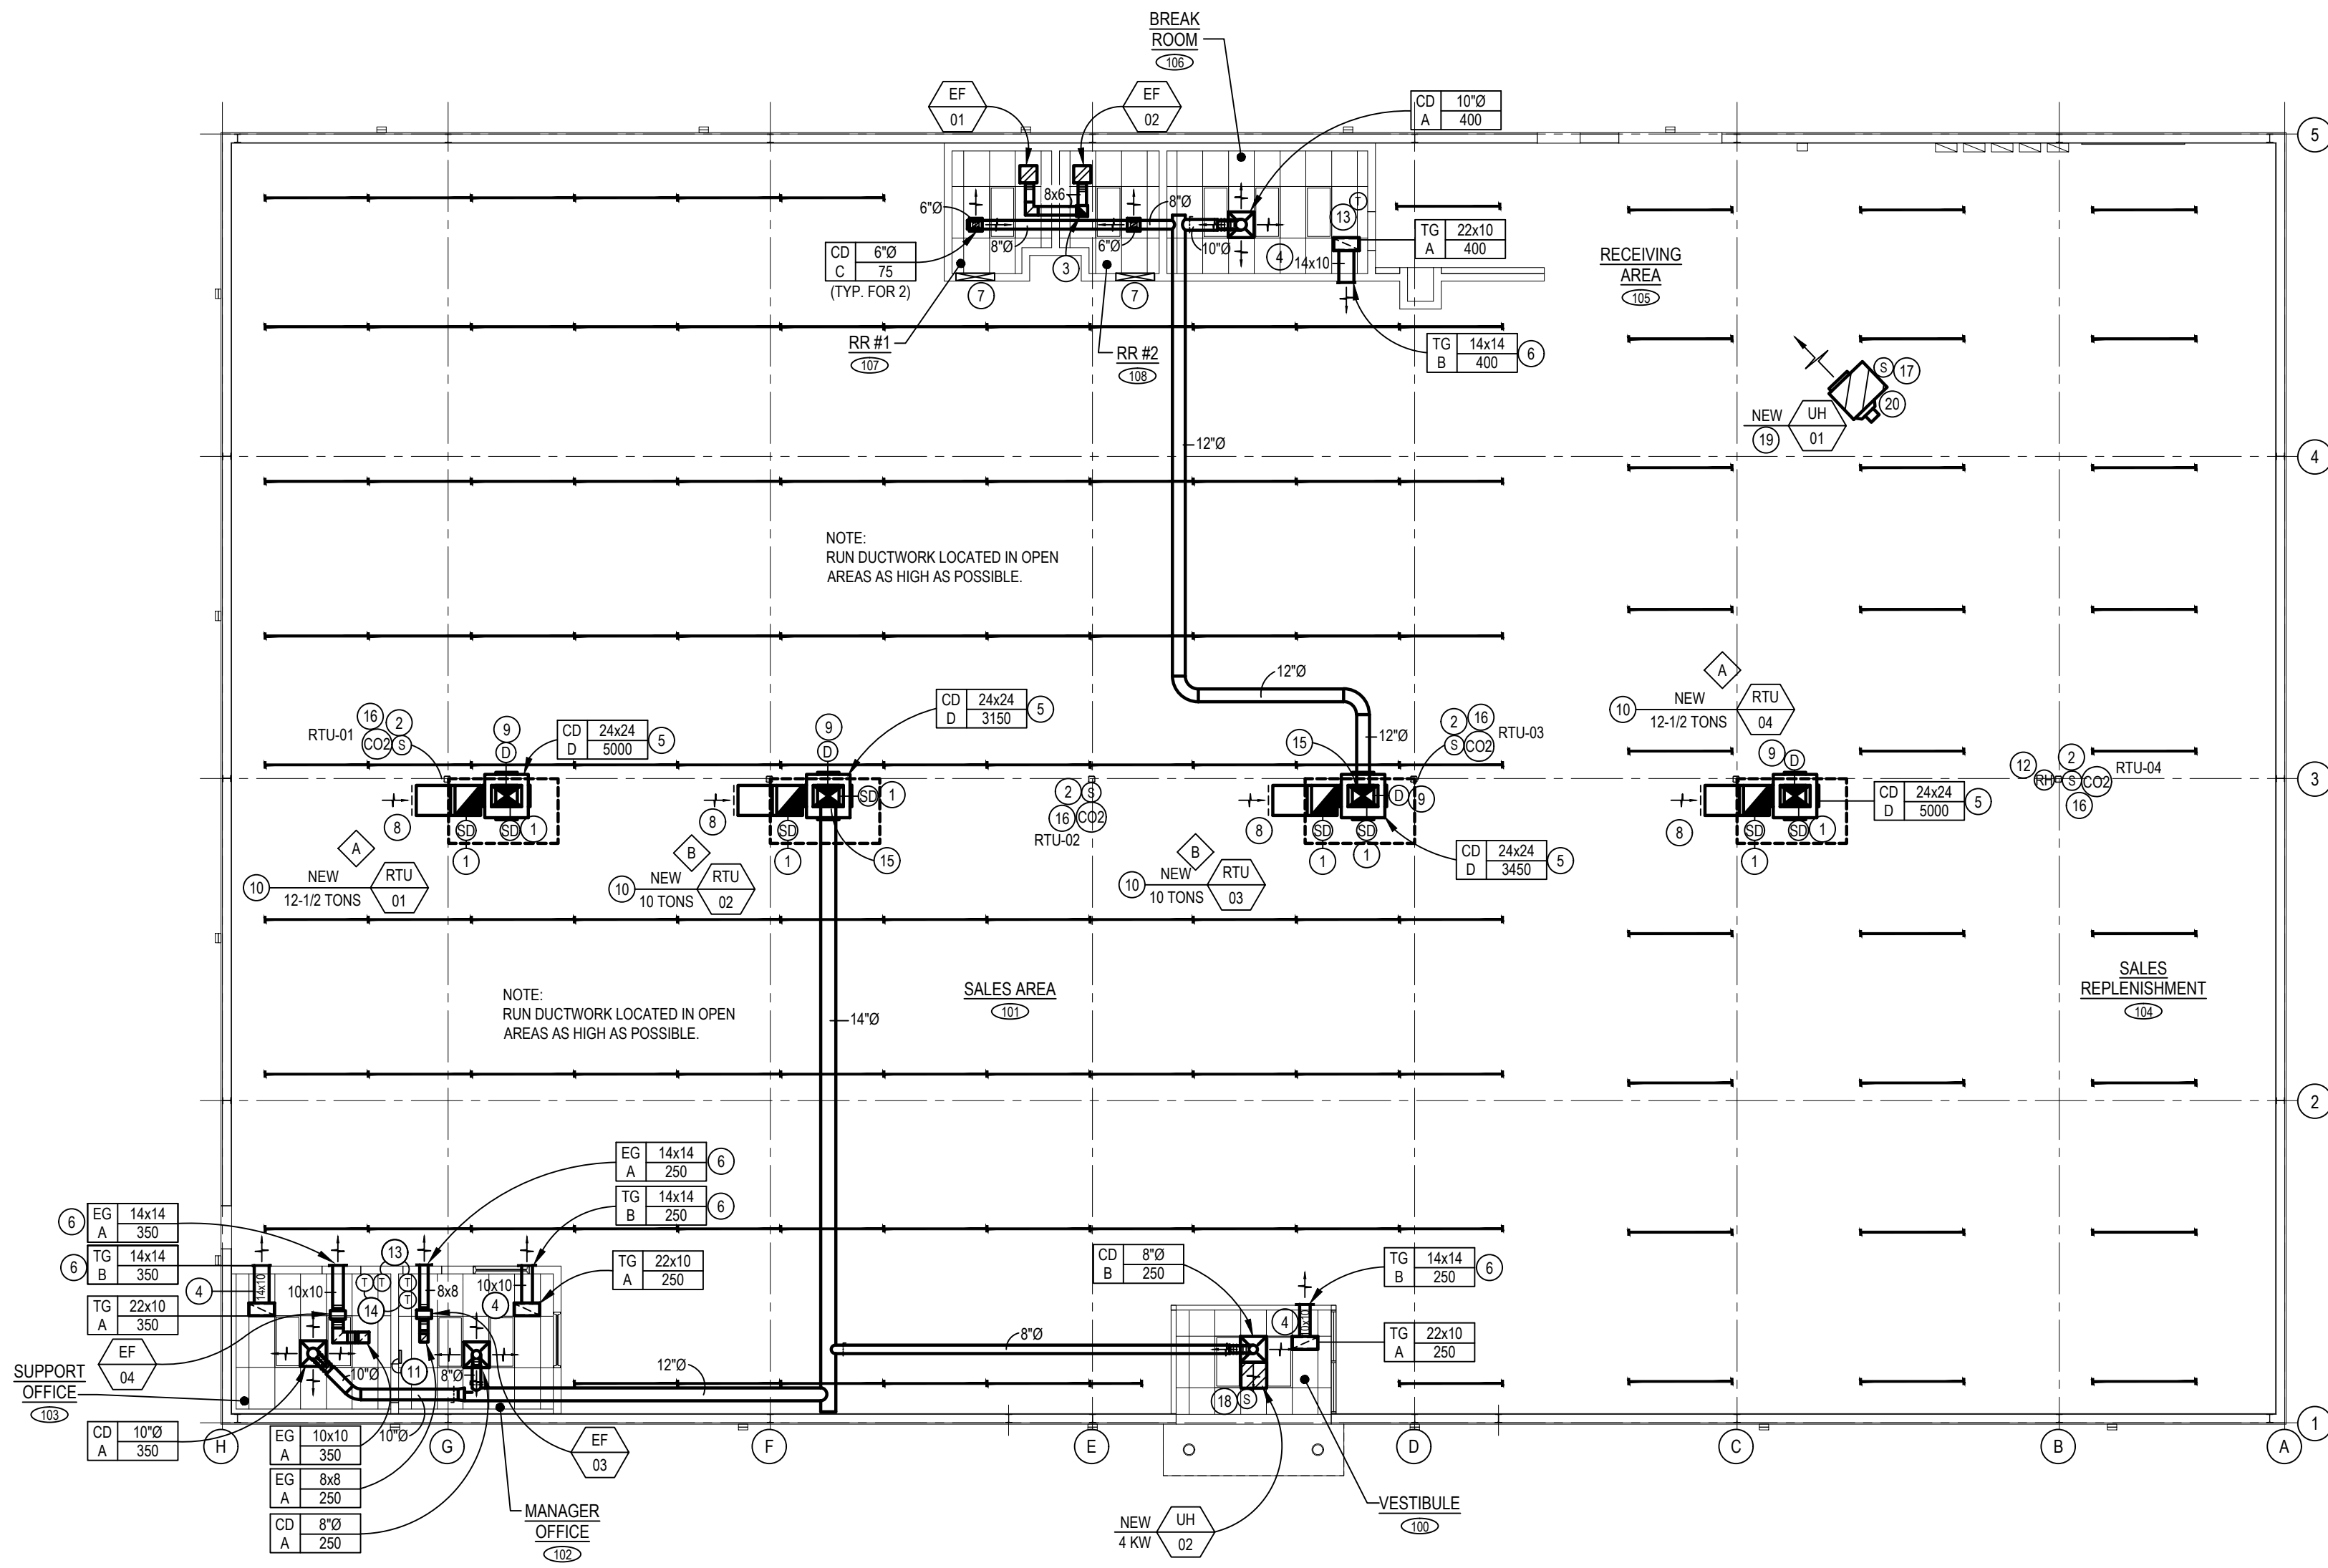

MECHANICAL PLAN TAG NOTES:

- LENNOX SHALL FURNISH AND INSTALL SMOKE DETECTORS IN THE SUPPLY AND RETURN AIR DUCTS. MECHANICAL CONTRACTOR SHALL FURNISH, INSTALL AND WIRE REMOTE TEST STATION WITH AUDIO VISUAL ALARM "SYSTEM SENSOR" MODEL RTS2-AS NEXT TO THE PHONE BOARD OR AT A LOCATION APPROVED BY THE AUTHORITY HAVING JURISDICTION. MECHANICAL CONTRACTOR SHALL PROVIDE CONTROL WIRING TO RTU AND INTERLOCKING WIRING TO OTHER DUCT DETECTORS (AS REQUIRED) FOR GLOBAL SHUT-DOWN. MECHANICAL CONTRACTOR SHALL WIRE DETECTORS TO FIRE ALARM SYSTEM (IF REQUIRED). SEE DUCT DETECTOR DETAIL ON DRAWING M1.2 FOR WIRING.
- SPACE TEMPERATURE SENSOR MOUNTED ON COLUMN AT 7'-0" A.F.F.
- 8x8 EXHAUST AIR DUCT RISER THRU ROOF IN PRE-FAB INSULATED ROOF CURB TO GOOSENECK WITH BIRDSCREEN. COORDINATE ROOF OPENING AND ROOFING REPAIR WITH LANDLORD AND LANDLORD'S ROOFING CONTRACTOR.
- MECHANICAL CONTRACTOR SHALL FURNISH AND INSTALL TRANSFER AIR DUCT WITH 1" THICK ACOUSTIC LINING.
- MECHANICAL CONTRACTOR SHALL TRANSITION SUPPLY AIR DUCT IN DROP AND CONNECT TO DROP DIFFUSER SYSTEM. MOUNT DROP DIFFUSER SYSTEM AS HIGH AS POSSIBLE. REFER TO RTU DROP BOX DIFFUSER DETAIL ON DWG. M1.2 FOR ADDITIONAL INFORMATION. OFFSET DROP DIFFUSER SYSTEM AS NECESSARY TO AVOID LIGHTS.
- MOUNT TRANSFER AIR AND/OR EXHAUST AIR GRILLE ON WALL AS HIGH AS POSSIBLE. APPROXIMATELY 2 FEET BELOW STRUCTURE. MECHANICAL CONTRACTOR SHALL FURNISH AND INSTALL 14"x12" PLENUM BOX BEHIND GRILLE. MECHANICAL CONTRACTOR SHALL EXTEND AND CONNECT TRANSFER OR EXHAUST AIR DUCT INTO BACK OF PLENUM BOX.
- 1" TOTAL FREE AREA BETWEEN FLOORING AND BOTTOM OF DOOR. UNDERCUT DOOR BY GENERAL CONTRACTOR.
- EXTEND RETURN AIR DUCT, FULL SIZE, WITH ELBOW AS HIGH AS POSSIBLE. REFER TO RTU DROP BOX DIFFUSER DETAIL ON DWG. M1.2. COVER RETURN AIR DUCT OPENING WITH 1"x1" WIRE MESH SCREEN. FURNISH AND INSTALL RETURN AIR DUCT WITH 1" THICK ACOUSTIC LINING.
- DUCT TEMPERATURE SENSOR, MOUNTED IN BOTTOM OF MAIN SUPPLY AIR DUCT. REFER TO THE SIEMENS EMS DRAWING SET (EMS-1 THRU EMS-4) FOR MORE INFORMATION.
- ROOFTOP UNIT DIGITAL ZONE CONTROLLER. REFER TO THE SIEMENS EMS DRAWING SET (EMS-1 THRU EMS-4) FOR MORE INFORMATION.
- EMS TOUCHPAD. COORDINATE WITH ELECTRICAL CONTRACTOR AND EMS DRAWINGS FOR MORE INFORMATION.
- RELATIVE HUMIDITY SENSOR MOUNTED ON COLUMN AT 7'-0" A.F.F. NOTE: REFER TO SIEMENS EMS DRAWINGS SET FOR ADDITIONAL INFORMATION.
- THERMOSTAT MOUNTED ON WALL AT 4'-0" A.F.F. TO CONTROL DIFFUSER.
- THERMOSTAT MOUNTED ON WALL AT 4'-0" A.F.F. TO EXHAUST FAN.
- EXTEND AND CONNECT NEW SUPPLY AIR BRANCH DUCT, SIZE AS INDICATED ON PLAN, INTO SUPPLY AIR DUCT MAIN PRIOR TO CONCENTRIC DIFFUSER. INSTALL OPPOSED BLADE DAMPER BETWEEN BRANCH SUPPLY AIR DUCT TAKE-OFF AND DROP BOX DIFFUSER.
- CARBON DIOXIDE SENSOR MOUNTED ON COLUMN AT 7'-0" A.F.F. REFER TO THE SIEMENS EMS DRAWING SET (EMS-1 THRU EMS-4) FOR MORE INFORMATION.
- UH-01 SENSOR. REFER TO THE SIEMENS EMS DRAWING SET (EMS-1 THRU EMS-4) FOR MORE INFORMATION.
- UH-02 SENSOR. REFER TO THE SIEMENS EMS DRAWING SET (EMS-1 THRU EMS-4) FOR MORE INFORMATION.
- NEW GAS-FIRED UNIT HEATER. SUSPEND GAS UNIT HEATER WITH ALL THREADED RODS AND NEOPRENE VIBRATION ISOLATORS FROM STRUCTURE FRAMING AS HIGH AS POSSIBLE. COORDINATE IN FIELD. MOUNT A MINIMUM OF 12'-0" A.F.F.
- MECHANICAL CONTRACTOR SHALL EXTEND CONCENTRIC INTAKE/EXHAUST FLUE THRU ROOF IN PRE-FAB INSULATED ROOF CURB. REFER TO GAS-FIRED UNIT HEATER DETAIL ON DWG. M1.2. MECHANICAL CONTRACTOR SHALL COORDINATE ALL ROOFING WORK WITH LANDLORD AND LANDLORD'S APPROVED ROOFING CONTRACTOR.

NOTE:
MECHANICAL CONTRACTOR SHALL MOUNT EXHAUST FANS (EF-03 AND EF-04) 8 TO 10 FEET ABOVE FINISHED FLOOR WITH ALL THREADED RODS AND VIBRATION ISOLATORS LOCATED ABOVE OFFICE CEILINGS. PROVIDE FLEXIBLE CONNECTIONS AT THE INLET AND OUTLET OF THE EXHAUST FAN. TRANSITION INLET AND OUTLET OF EXHAUST FAN CONNECTIONS TO RECTANGULAR DUCT AS INDICATED ON THE MECHANICAL PLAN. PROVIDE A MINIMUM OF 18" OF EXHAUST DUCTWORK AT THE INLET AND OUTLET OF THE EXHAUST FAN. EXHAUST AIR DUCT TO TERMINATE AT FACE OF OFFICE WALL WITH NEW EXHAUST GRILLE 'A' FLUSH TO WALL. GRILLE TO BE LOCATED 2 FEET BELOW STRUCTURE. THERMOSTATS CONTROLLING THE EXHAUST FANS SHALL BE LOCATED BEHIND THE DOORS AND THE POWER AND SPEED CONTROL SWITCH ASSOCIATED WITH THE FAN SHALL BE LOCATED ABOVE THE CEILING APPROXIMATELY 10" AWAY FROM THE INSIDE WALL. THE EXHAUST FANS SHALL BE LOCATED 1 FOOT ABOVE THE CEILING OVER THE ENTRY DOOR INTO THE ROOM FOR EASE OF MAINTENANCE. NOTE: GRILLES TO BE CENTERED OVER THE DOORS WHEN POSSIBLE. ALL GRILLES TO BE AT THE SAME ELEVATION.

NOTE:
EMS TOUCHPAD LOCATED IN MANAGER'S OFFICE. REFER TO MECHANICAL GENERAL NOTE #5 ON THIS DWG. FOR ADDITIONAL INFORMATION

MECHANICAL PLAN

SCALE: 3/32" = 1'-0"



TONNAGE BREAKDOWN	
TOTAL TONNAGE	45
TOTAL SQUARE FOOTAGE	16,000
SQUARE FOOT/TON	356



ADA ARCHITECTS
17710 Detroit Avenue
Lakewood, Ohio 44107
Phone (216) 521-5134 Fax (216) 521-4824
www.adaarchitects.com

HARBOR FREIGHT
46 SHRJUI LANE
ERWIN, NC 28339

REVISIONS

#	DATE	TYPE
1		
2		
3		
4		
5		
6		
7		
8		
9		

MECHANICAL PLAN

DATE 05/17/24

JOB NO. 23475

M1.0
SHEET NO.

THESE DOCUMENTS CONTAIN INFORMATION PROPRIETARY TO ADA ARCHITECTS, INC. UNAUTHORIZED USE OF THESE DOCUMENTS IS EXPRESSLY PROHIBITED UNLESS AGREED UPON IN WRITING.

ROOFTOP UNIT SCHEDULE (NO SUBSTITUTIONS ALLOWED)																			
TAG	LABEL TAG	MANUFACTURER & MODEL NUMBER	NOMINAL TONNAGE	CFM	E.S.P. (IN.)	OUTDOOR AIR	HEATING CAPACITY			GROSS COOLING CAPACITY				ELECTRICAL DATA			WEIGHT (LBS)	REMARKS	
							1st STAGE (MBH)	2nd STAGE (MBH)	AFUE (%)	EAT DBWB	TOTAL (MBH)	SENSIBLE (MBH)	EER/SEER IEER	AMBIENT TEMP	S/A FAN HP	VOLTAGE			MCA
RTU 01	XXXX-RTU-01	LENNOX LGT150H4EH1Y	12-1/2	5000	0.6"	1250	156/126.4	240/194	81	80/67	146.1	108.1	10.8 EER 14.6 IEER	95°F	3.75 HP 208/230V 3 PH	61	80	1600	SEE NOTES BELOW.
RTU 02	XXXX-RTU-02	LENNOX LGT120H4EH1Y	10	4000	0.8"	1000	156/126.4	240/194	81	80/67	121.9	89.0	12.1 EER 15.5 IEER	95°F	3.75 HP 208/230V 3 PH	52	60	1400	SEE NOTES BELOW.
RTU 03	XXXX-RTU-03	LENNOX LGT120H4EH1Y	10	4000	0.8"	1000	156/126.4	240/194	81	80/67	121.9	89.0	12.1 EER 15.5 IEER	95°F	3.75 HP 208/230V 3 PH	52	60	1400	SEE NOTES BELOW.
RTU 04	XXXX-RTU-04	LENNOX LGT150H4EH1Y	12-1/2	5000	0.6"	750	156/126.4	240/194	81	80/67	146.1	108.1	10.8 EER 14.6 IEER	95°F	3.75 HP 208/230V 3 PH	61	80	1600	SEE NOTES BELOW.

FURNISH WITH THE FOLLOWING:

- 1" HIGH PRE-FABRICATED INSULATED ROOF CURB BY MECHANICAL CONTRACTOR
- BAROMETRIC RELIEF DAMPERS
- HIGH PERFORMANCE ECONOMIZER 0-100% COMPLETE WITH FAULT DETECTOR AND DIAGNOSTICS SYSTEM (FDD)
- DIRTY FILTER SWITCH, 2" MERV 8 FILTERS
- BURGLAR BARS BY MECHANICAL CONTRACTOR
- MSAV (MULTI-STAGE AIR VOLUME) SUPPLY AIR BLOWER
- FACTORY INSTALLED UNIT NON-FUSED DISCONNECT - WEATHERPROOF
- R-410a REFRIGERANT
- HINGED ACCESS PANELS
- HIGH AND LOW PRESSURE SWITCHES
- FREESTAT
- SERVICE VALVES
- COMBINATION HALICOIL GUARD
- 5-YEAR COMPRESSOR WARRANTY
- GFCI - FACTORY INSTALLED/FIELD WIRED BY ELECTRICIAN
- AES INDUSTRIES DROP DIFFUSER SYSTEM (4) ADB-1 10-12.5
- ROOFTOP UNITS REMOTE SPACE TEMPERATURE SENSORS AND CARBON DIOXIDE SENSORS REFER TO THE SIEMENS EMS DRAWING SET (EMS-1 THRU EMS-4) FOR MORE INFORMATION.
- SMOKE DETECTORS IN THE SUPPLY AND RETURN
- DRAIN PAN OVERFLOW SWITCH

NOTE: MECHANICAL CONTRACTOR SHALL PROVIDE REMOTE TEST STATIONS FOR DUCT DETECTORS. REFER TO MECHANICAL PLAN TAG NOTE #1 ON DWG. M1.0 FOR ADDITIONAL INFORMATION.

LENNOX CONTACT: Gary Baker: LennoxNationalAccounts@Lennoxind.com (972) 497-6665
LENNOX NATIONAL ACCOUNT TECH SUPPORT: (800) 367 6285 option 2

GRILLE, REGISTER AND DIFFUSER SCHEDULE											
TAG	MANUFACTURER & MODEL NUMBER	CFM	AIR PATTERN	NECK SIZE	DAMPER	FRAME STYLE	PANEL SIZE	MAXIMUM NC LEVEL	FINISH	MATERIAL	REMARKS
CD A	PRICE PRODIGY PPD2	AS NOTED	AS SHOWN	AS NOTED	OPPOSED BLADE	LAY-IN CEILING	24x24	30	WHITE POWDER COAT	STEEL	PROVIDE WITH WALL MOUNTED ROOM TSTAT W/ILCD DISPLAY. MC TO PROVIDE 120/24V CONTROL TRANSFORMER. MC SHALL WIRE LOW VOLTAGE TSTATS. PROVIDE WITH INSULATED BACKPANS.
CD B	PRICE SPD	AS NOTED	AS SHOWN	AS NOTED	OPPOSED BLADE	LAY-IN CEILING	24x24	30	WHITE POWDER COAT	STEEL	
CD C	PRICE SPD	AS NOTED	AS SHOWN	AS NOTED	OPPOSED BLADE	SURFACE MOUNTED	12x12	30	WHITE POWDER COAT	STEEL	
CD D	AES INDUSTRIES ADB-1 10-12.5	AS NOTED	4-WAY	24x24	-	EXPOSED	34x34	36	MILL FINISH	STEEL	FURNISHED BY LENNOX AND INSTALLED BY THE MECHANICAL CONTRACTOR.
EG A	PRICE 535	AS NOTED	EXHAUST	AS NOTED	-	SURFACE MOUNTED	NECK SIZE + 1.34"	30	WHITE POWDER COAT	STEEL	
TG A	PRICE 81	AS NOTED	TRANSFER	AS NOTED	-	LAY-IN CEILING	24x12	30	WHITE POWDER COAT	ALUMINUM	
TG B	PRICE 535	AS NOTED	TRANSFER	AS NOTED	-	SURFACE MOUNTED	NECK SIZE + 1.34"	30	WHITE POWDER COAT	STEEL	


FIELD INSTALLED OPTIONS NOTE: MECHANICAL CONTRACTOR SHALL BE RESPONSIBLE FOR ALL ITEMS LISTED ABOVE AS A FIELD INSTALLED OPTION IF ROOFTOP UNIT COMES AS BARE BONES STYLE (NO CHANGE ORDERS WILL BE APPROVED). MECHANICAL CONTRACTOR SHALL COORDINATE WITH GENERAL CONTRACTOR AND THE ELECTRICAL CONTRACTOR FOR ALL THE FIELD INSTALLED ITEMS.

VENTILATION AIR REQUIREMENT						
HVAC UNIT	AREA SERVED	OCCUPANT LOAD	REQUIRED VENTILATION	O.A. REQUIRED (CFM)	O.A. (MIN.) SUPPLIED (CFM)	REMARKS
RTU 01-03	SALES AREA 101	141 (9,381 SF)	7.5 CFM/PERSON 12 CFM/SF (1.25)	2729	2900	PER NORTH CAROLINA MECHANICAL CODE
RTU 04	RECEIVING / SALES REPLENISHMENT AREA 104 & 105	6 (5,959 SF)	5 CFM/PERSON .06 CFM/SF (1.25)	484	750	PER NORTH CAROLINA MECHANICAL CODE
RTU 02	SUPPORT OFFICE 103	1 (126 SF)	5 CFM/PERSON .06 CFM/SF (1.25)	16	88	PER NORTH CAROLINA MECHANICAL CODE
	MANAGER OFFICE 102	1 (128 SF)	5 CFM/PERSON .06 CFM/SF (1.25)	16	62	PER NORTH CAROLINA MECHANICAL CODE
	VESTIBULE 100	(97 SF)	.06 CFM/SF (1.25)	7	62	PER NORTH CAROLINA MECHANICAL CODE
RTU 03	BREAK ROOM 106	6 (154 SF)	5 CFM/PERSON .06 CFM/SF (1.25)	49	100	PER NORTH CAROLINA MECHANICAL CODE
EF 01	RESTROOM #1 107	1 WC	70 CFM EXH./WC	70 EXH	100 EXH	QUANTITIES ARE EXHAUSTED (19 CFM OF O.A. - RTU-03)
EF 02	RESTROOM #2 108	1 WC	70 CFM EXH./WC	70 EXH	100 EXH	QUANTITIES ARE EXHAUSTED (19 CFM OF O.A. - RTU-03)

NOTE: NORTH CAROLINA MECHANICAL CODE BREATHING ZONE OUTDOOR AIR FLOW (CFM) Vz = RpPz + RaAz x 1.25
WHERE:
Az = ZONE FLOOR AREA
Pz = POPULATION
Rp = TABLE 6.1 OUTDOOR AIR PER PERSON
Ra = TABLE 6.1 OUTDOOR AIR PER AREA

DUCTWORK SCHEDULE				
DUCT SYSTEM	SMACNA PRESSURE CLASS	SMACNA SEAL CLASS	DUCT MATERIAL	INSULATION
EXPOSED SUPPLY AIR DUCTWORK	2" W.C.	B	GALVANIZED STEEL	REFER TO SPECIFICATIONS
CONCEALED SUPPLY AIR DUCTWORK	2" W.C.	B	GALVANIZED STEEL	2" DUCT WRAP
RETURN AIR DUCTWORK	1" W.C.	C	GALVANIZED STEEL	1" DUCT LINING
EXHAUST AIR DUCTWORK	1" W.C.	C	GALVANIZED STEEL	NONE

NOTE: ALL DUCTWORK SIZES ARE AIRWAY DIMENSIONS

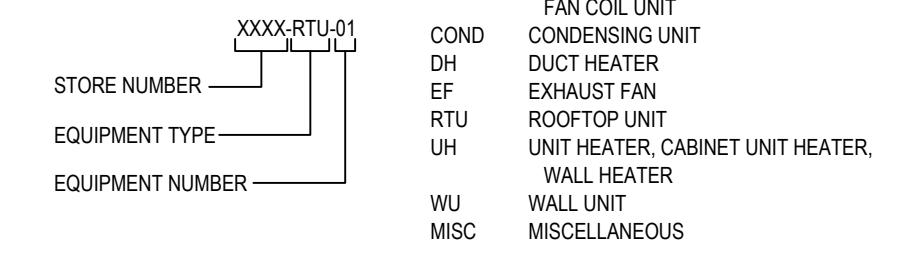

NOTE: MECHANICAL CONTRACTOR SHALL COORDINATE WITH THE CONSTRUCTION PM TO ACQUIRE THE STORE NUMBER PRIOR TO LABELING THE EQUIPMENT. THE MECHANICAL CONTRACTOR SHALL UPDATE THE ASBUILT DRAWINGS WITH THE STORE NUMBER.

DIRECTIONS: MECHANICAL CONTRACTOR SHALL LABEL ALL EQUIPMENT SO THEY ARE VISIBLE FROM BELOW. EQUIPMENT SHALL BE IDENTIFIED WITH THE LABEL TAG AS INDICATED ABOVE. SPACE TEMPERATURE SENSORS AND THERMOSTATS SHALL BE IDENTIFIED WITH THE EQUIPMENT PLAN TAG THAT SERVES THEM. THERMOSTAT AND SENSOR LABELS ARE TO BE 1/4" TALL BLACK STICKERS AND ARIAL FONT. EXHAUST FAN AND UNIT HEATER (ALL TYPES) LABELS ARE TO BE 1/2" TALL BLACK STICKERS AND ARIAL FONT. ROOFTOP EQUIPMENT LABELS ARE TO BE 2" TALL BLACK STICKERS AND ARIAL FONT. CONCENTRIC DIFFUSER LABELS ARE TO BE 2" TALL BLACK STICKERS AND ARIAL FONT. OTHER DIFFUSERS IN ENCLOSED SPACES ARE TO BE LABELED WITH THE RTU THAT SERVES THEM WITH 1/2" TALL BLACK STICKERS AND ARIAL FONT. NOTE: EXTERIOR LABELS MUST BE SUITABLE FOR WEATHER APPLICATIONS AND FADE RESISTANT. EQUIPMENT LABELS SHALL BE MOUNTED NEXT TO THE UNIT MOUNTED DISCONNECT. IF THE UNIT DOES NOT HAVE A UNIT MOUNTED DISCONNECT, THEN PLACE ON THE MOST VISIBLE PLACE.

FAN SCHEDULE												
PLAN TAG	LABEL TAG	MANUFACTURER & MODEL NUMBER	AREA SERVED	SERVICE	CFM	ESP	WATTS & VOLTAGE	FAN RPM	FAN TYPE	MAX SOUND LEVEL	WEIGHT (LBS)	REMARKS
EF 01	XXXX-EF-01	GREENHECK SP-A190	RESTROOM #1	EXHAUST	100	.3"	113 WATTS 120V/10	1400	CEILING MTD.	3.4 SONES	17	SEE NOTES 1 - 7 BELOW
EF 02	XXXX-EF-02	GREENHECK SP-A190	RESTROOM #2	EXHAUST	100	.3"	113 WATTS 120V/10	1400	CEILING MTD.	3.4 SONES	17	SEE NOTES 1 - 7 BELOW
EF 03	XXXX-EF-03	FANTECH FG 8	MANAGER'S OFFICE	EXHAUST	250	.5"	119 WATTS 120V/10	2550	IN-LINE		12	SEE NOTES 3 & 8 BELOW
EF 04	XXXX-EF-04	FANTECH FG 10	SUPPORT OFFICE	EXHAUST	350	.5"	138 WATTS 120V/10	3000	IN-LINE		12	SEE NOTES 3 & 8 BELOW

NOTES: PROVIDE WITH THE FOLLOWING ITEMS:

1. DISCONNECT SWITCH
2. GRAVITY BACKDRAFT DAMPER
3. INTEGRAL SPEED CONTROL SWITCH FOR BALANCING
4. METAL CEILING GRILLE
5. CONTROLLED BY LIGHT SWITCH (WHEN LIGHT SWITCH IS ACTIVATED THE FAN WILL ENGAGE)
6. 14" HIGH PRE-FAB ROOF CURB
7. HANGING KIT WITH NEOPRENE VIBRATION ISOLATORS
8. LINE VOLTAGE (120V) COOLING ONLY THERMOSTAT TPI #ET9SRTS

GAS UNIT HEATER SCHEDULE													
PLAN TAG	LABEL TAG	MANUFACTURER & MODEL NUMBER	AREA SERVED	GAS MBH		CFM	AFUE	HP & VOLTAGE	FLA	MCCP	VENT CONN.		REMARKS
				INPUT	OUTPUT						INLET	OUTLET	
UH 01	XXXX-UH-01	REZTOR UB2125	RECEIVING	120	99.6	2049	83%	3/4 HP 120V/1 PH.	13.2	30	4" DIA.	4" DIA.	SEE NOTES BELOW

NOTES: PROVIDE WITH THE FOLLOWING ITEMS:

1. VERTICAL CONCENTRIC COMBUSTION AIR/VENT KIT(CC2)
2. FACTORY INSTALLED DISCONNECT SWITCH
3. SUMMER FAN SWITCH
4. 30" DOWNTURN NOZZLE.
5. UNIT HEATER TO BE CONTROLLED FROM "UNIT MOUNTED" ZONE CONTROLLER SENSOR (REFER TO THE SIEMENS EMS DRAWING SET EMS-1 THRU EMS-4 FOR MORE INFORMATION.)

ELECTRIC CABINET UNIT HEATER SCHEDULE								
PLAN TAG	LABEL TAG	MANUFACTURER & MODEL NUMBER	HEATING CAPACITY		VOLTAGE	CFM	AMPS	REMARKS
			KW	BTU/HR				
UH 02	XXXX-UH-02	MARKEL F3484	4	13,600	208V 1 PHASE	425	19.2	SEE NOTES BELOW

NOTES:

1. PROVIDE INTEGRAL DISCONNECT, LOUVER OUTLET, AND MOUNTING HARDWARE
2. HEATER TO BE RECESSED CEILING (LAY-IN) MOUNTED
3. UNIT HEATER TO BE CONTROLLED FROM "UNIT MOUNTED" ZONE CONTROLLER SENSOR (REFER TO THE SIEMENS EMS DRAWING SET EMS-1 THRU EMS-4 FOR MORE INFORMATION.)

NOTE: MECHANICAL CONTRACTOR SHALL REFER TO ARCHITECTURAL DRAWING A0.0 FOR MECHANICAL EQUIPMENT AND ACCESSORIES PROVIDED BY HARBOR FREIGHT TOOLS.

NOTE: MECHANICAL CONTRACTOR TO REVIEW AND COMPLY WITH THE REQUIREMENTS OF GENERAL NOTES ON SHEET A0.2.











17710 Detroit Avenue
Lakewood, Ohio 44107
Phone (216) 521-5134 Fax (216) 521-4824
www.adaarchitects.com

HARBOR FREIGHT
46 SHRILJI LANE
ERWIN, NC 28339

THESE DOCUMENTS CONTAIN INFORMATION PROPRIETARY TO ADA ARCHITECTS INC.
UNAUTHORIZED USE OF THESE DOCUMENTS IS EXPRESSLY PROHIBITED UNLESS AGREED UPON IN WRITING.

REVISIONS								
#	DATE	TYPE	1	2	3	4	5	6

MECHANICAL SCHEDULES
DATE 05/17/24
JOB NO. 23475
M1.1
SHEET NO.

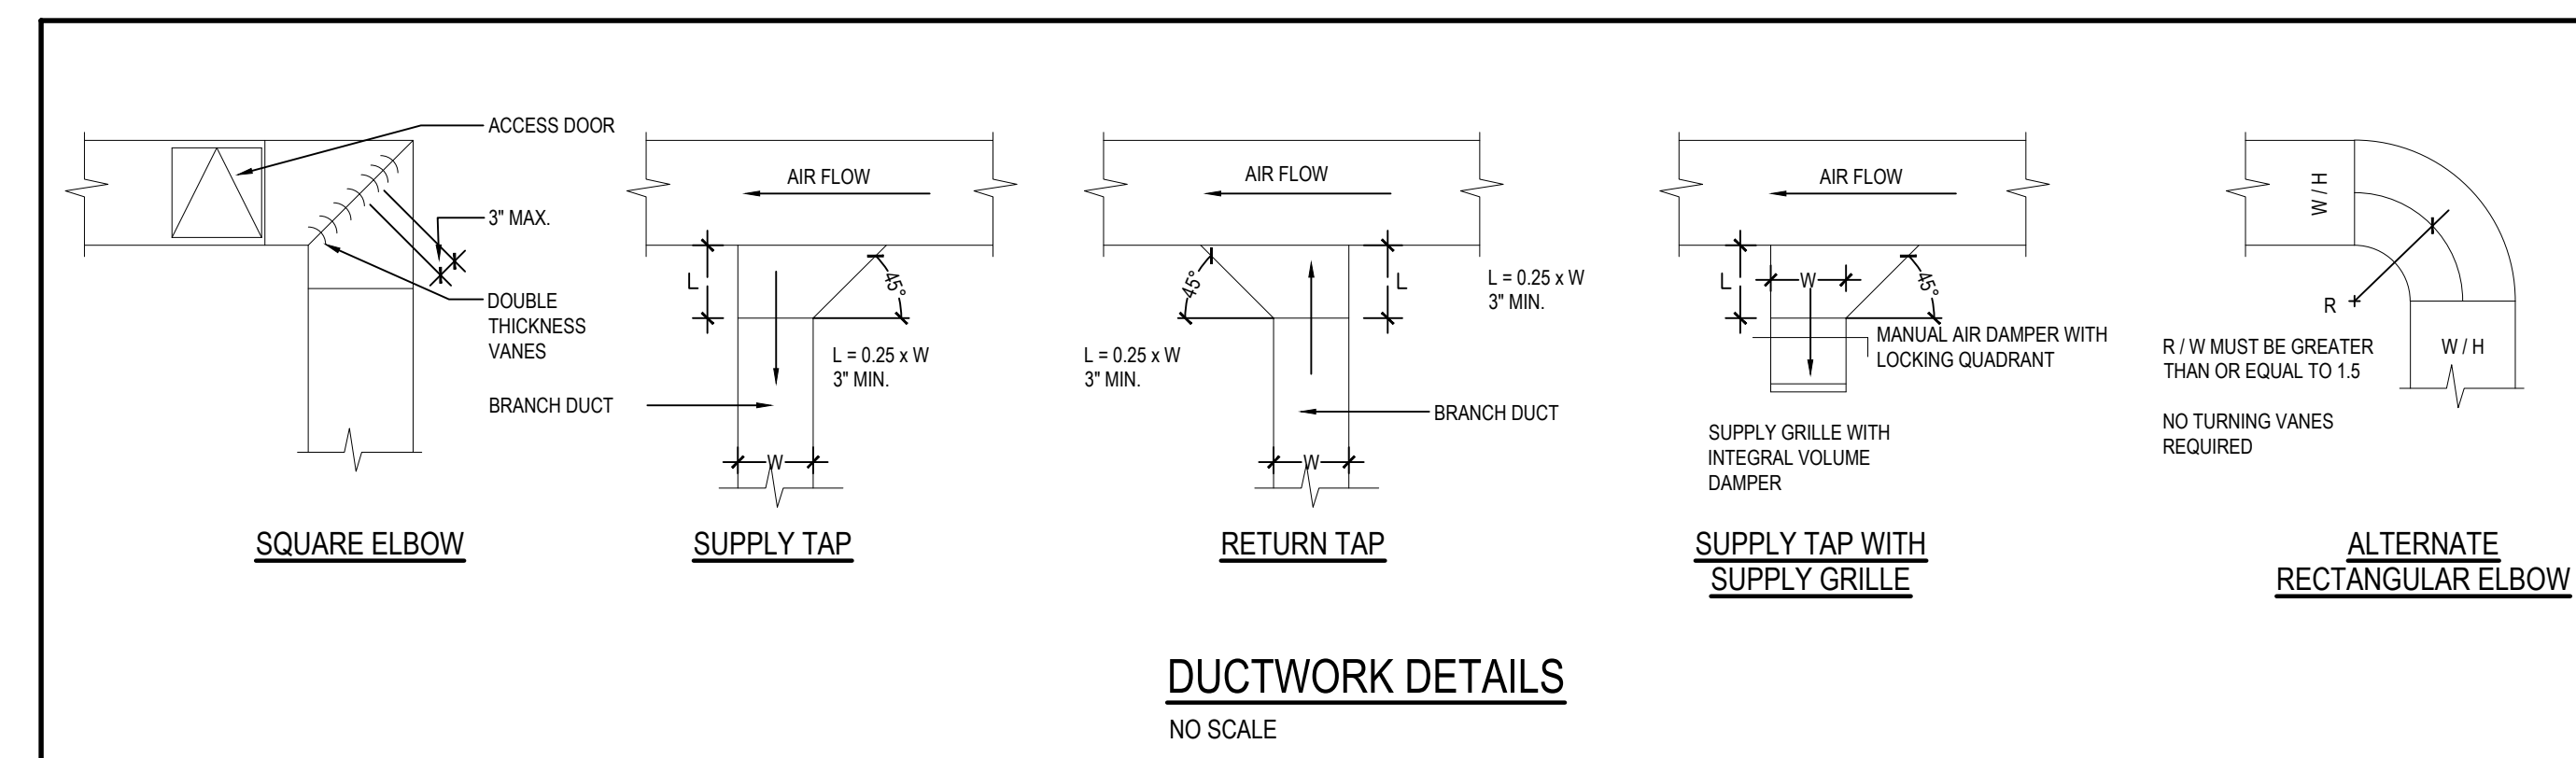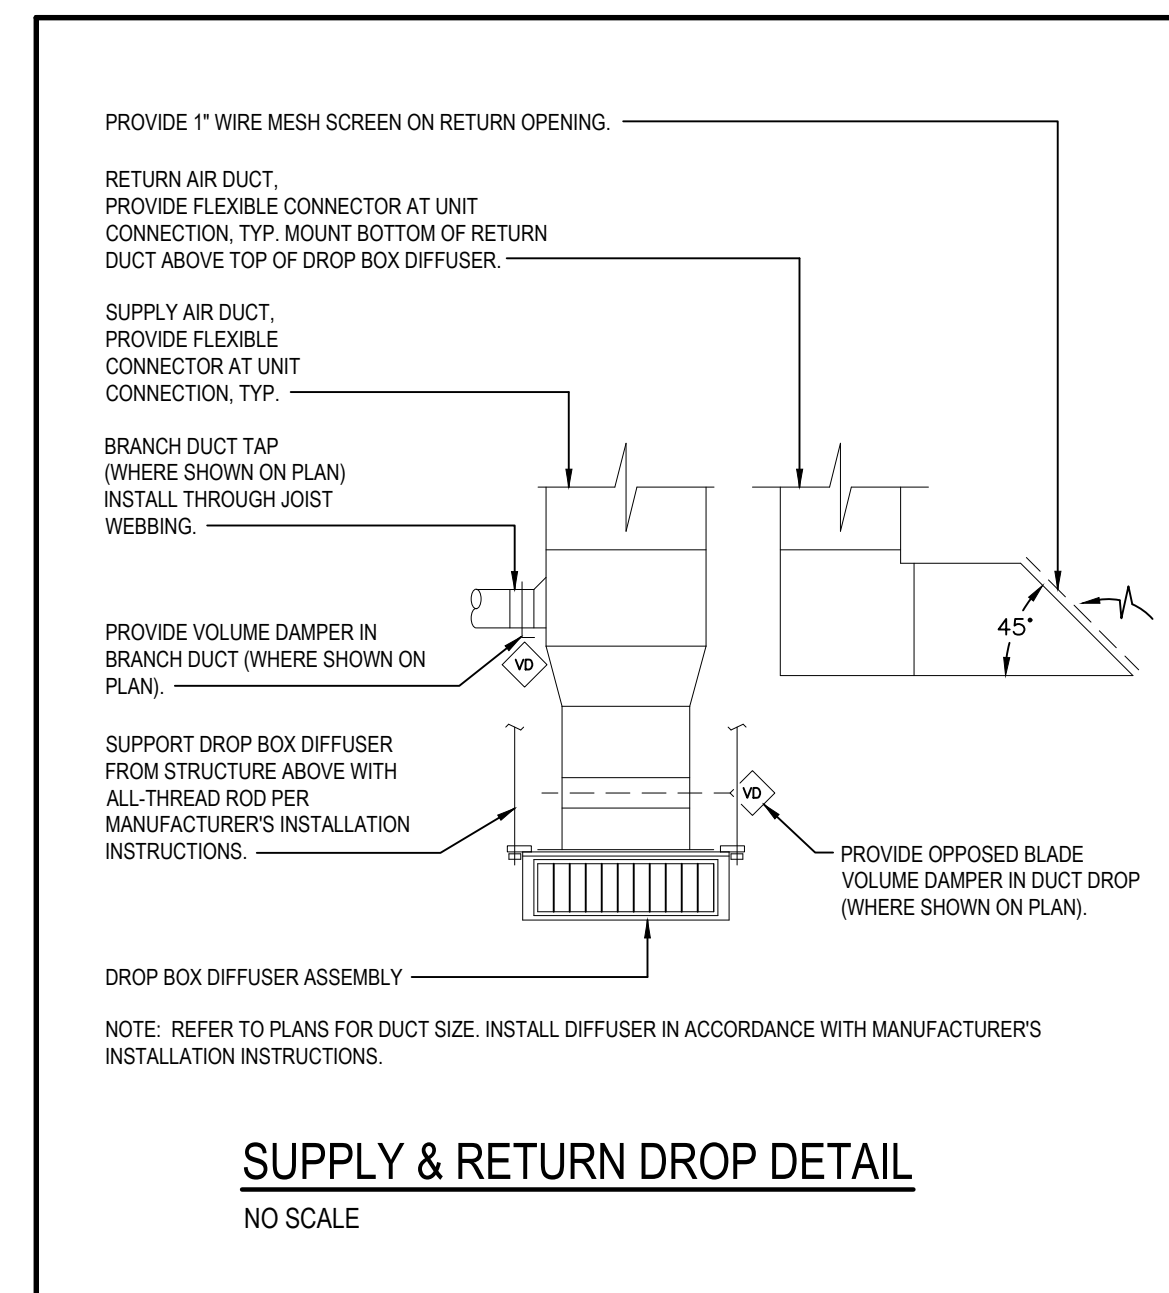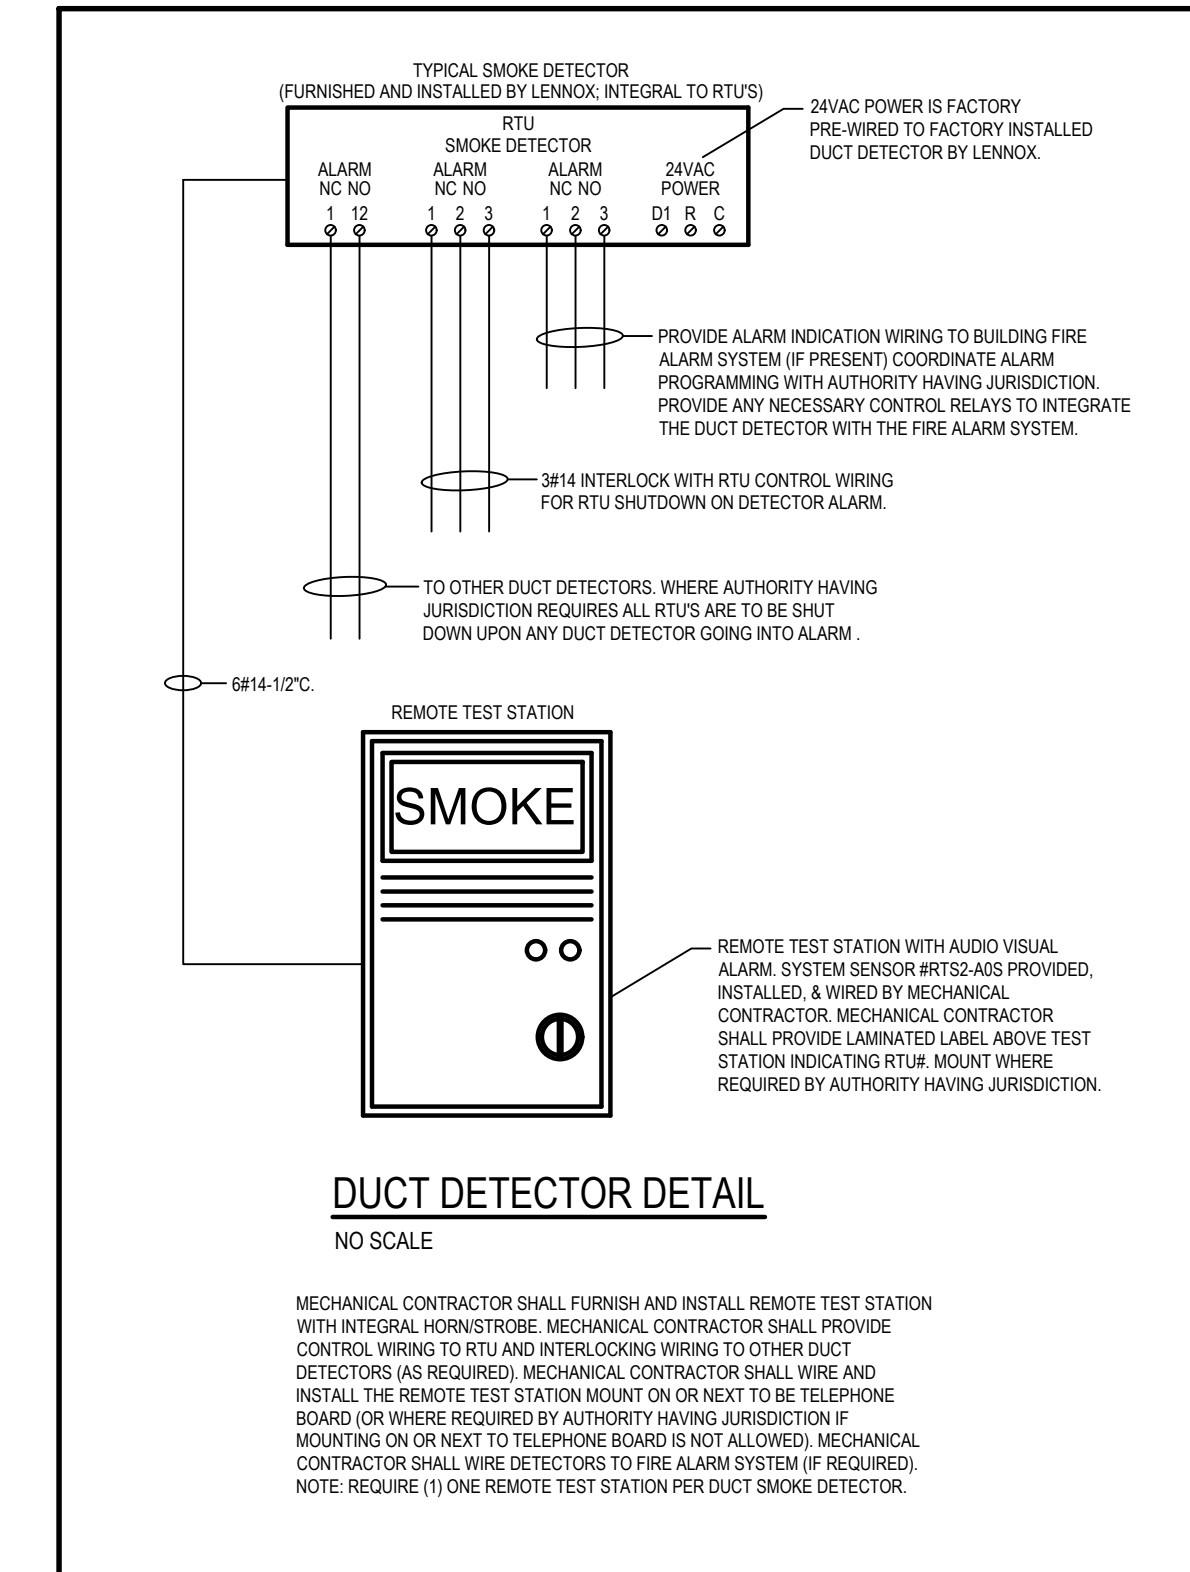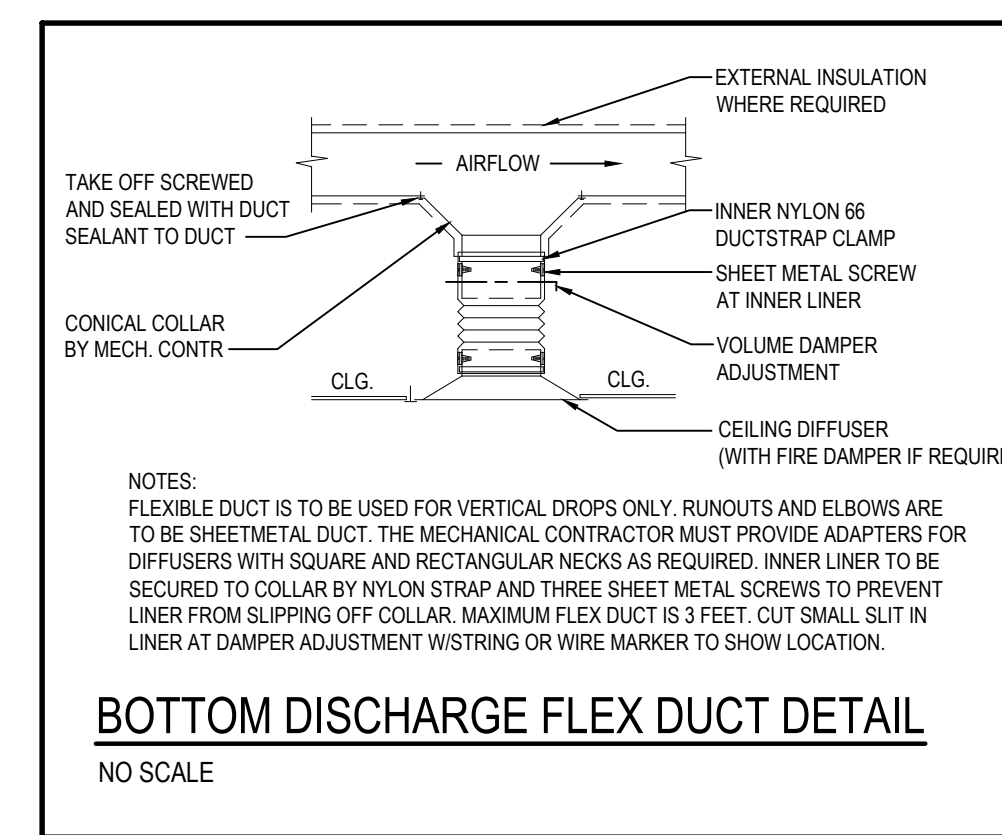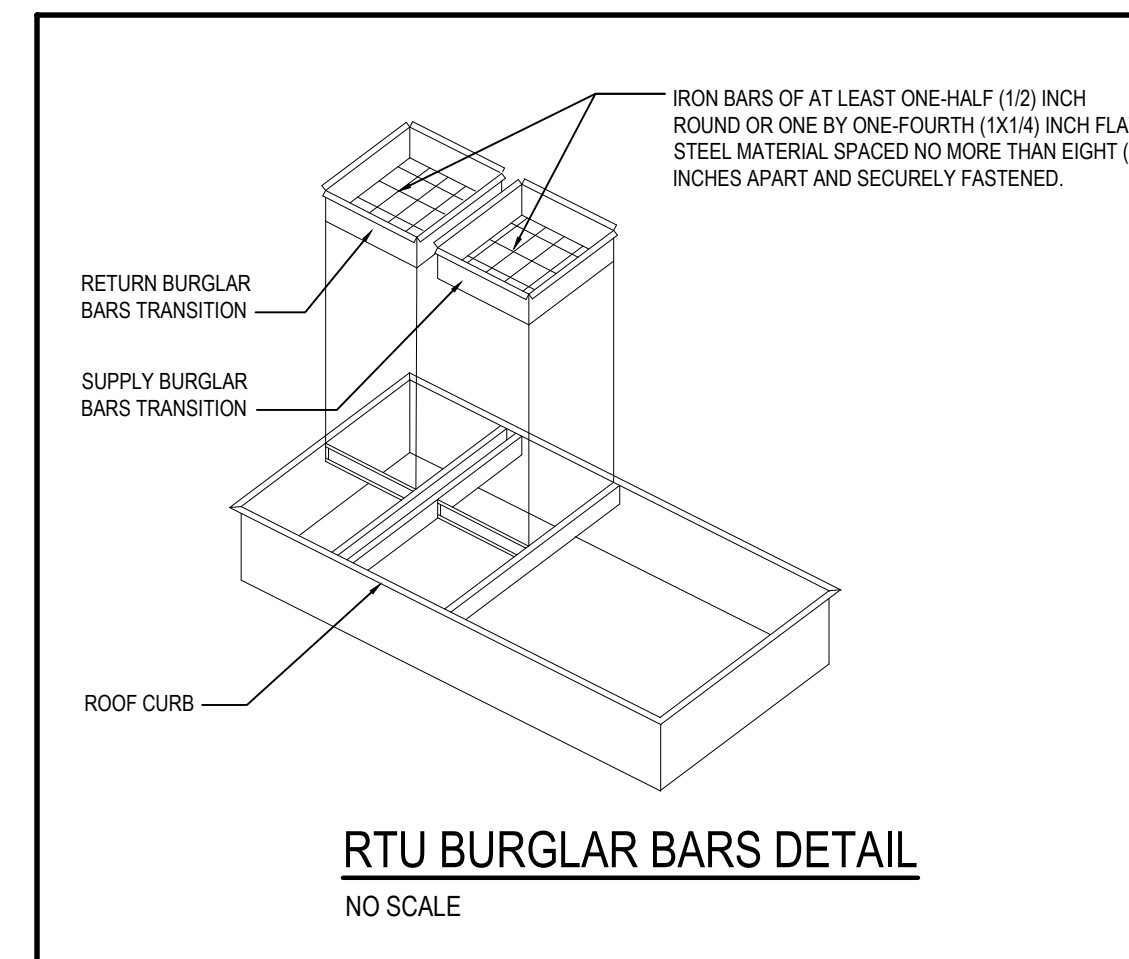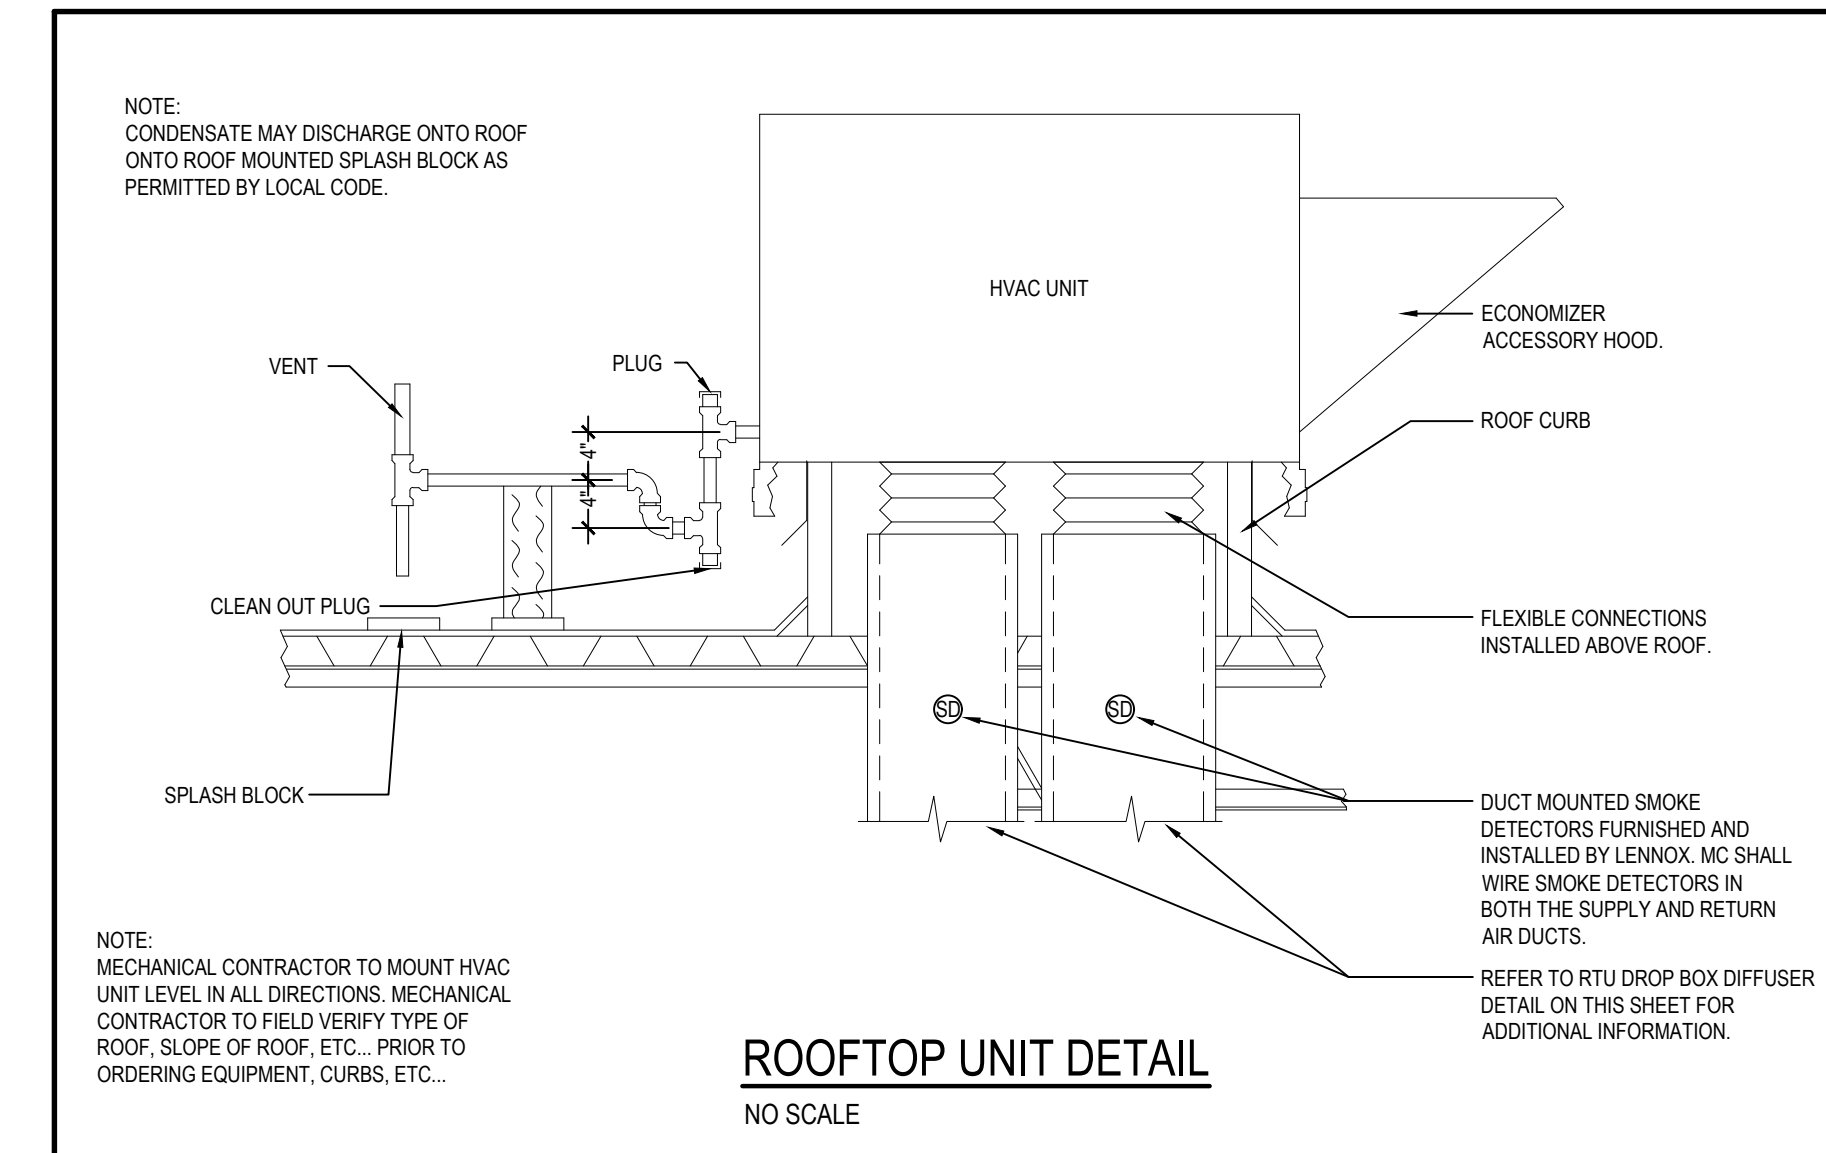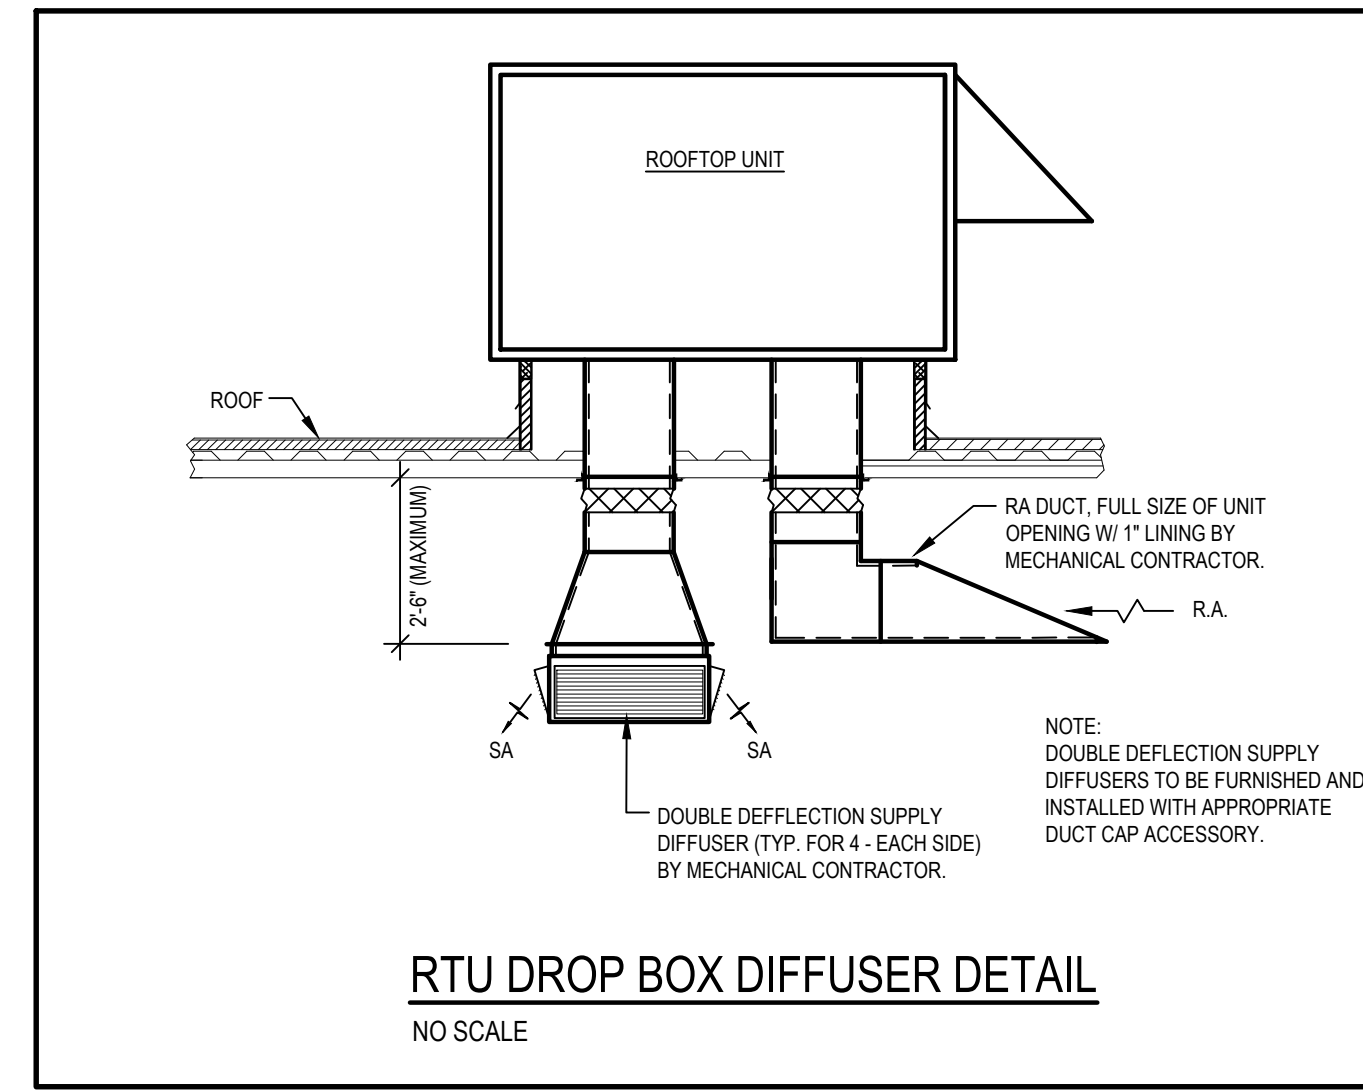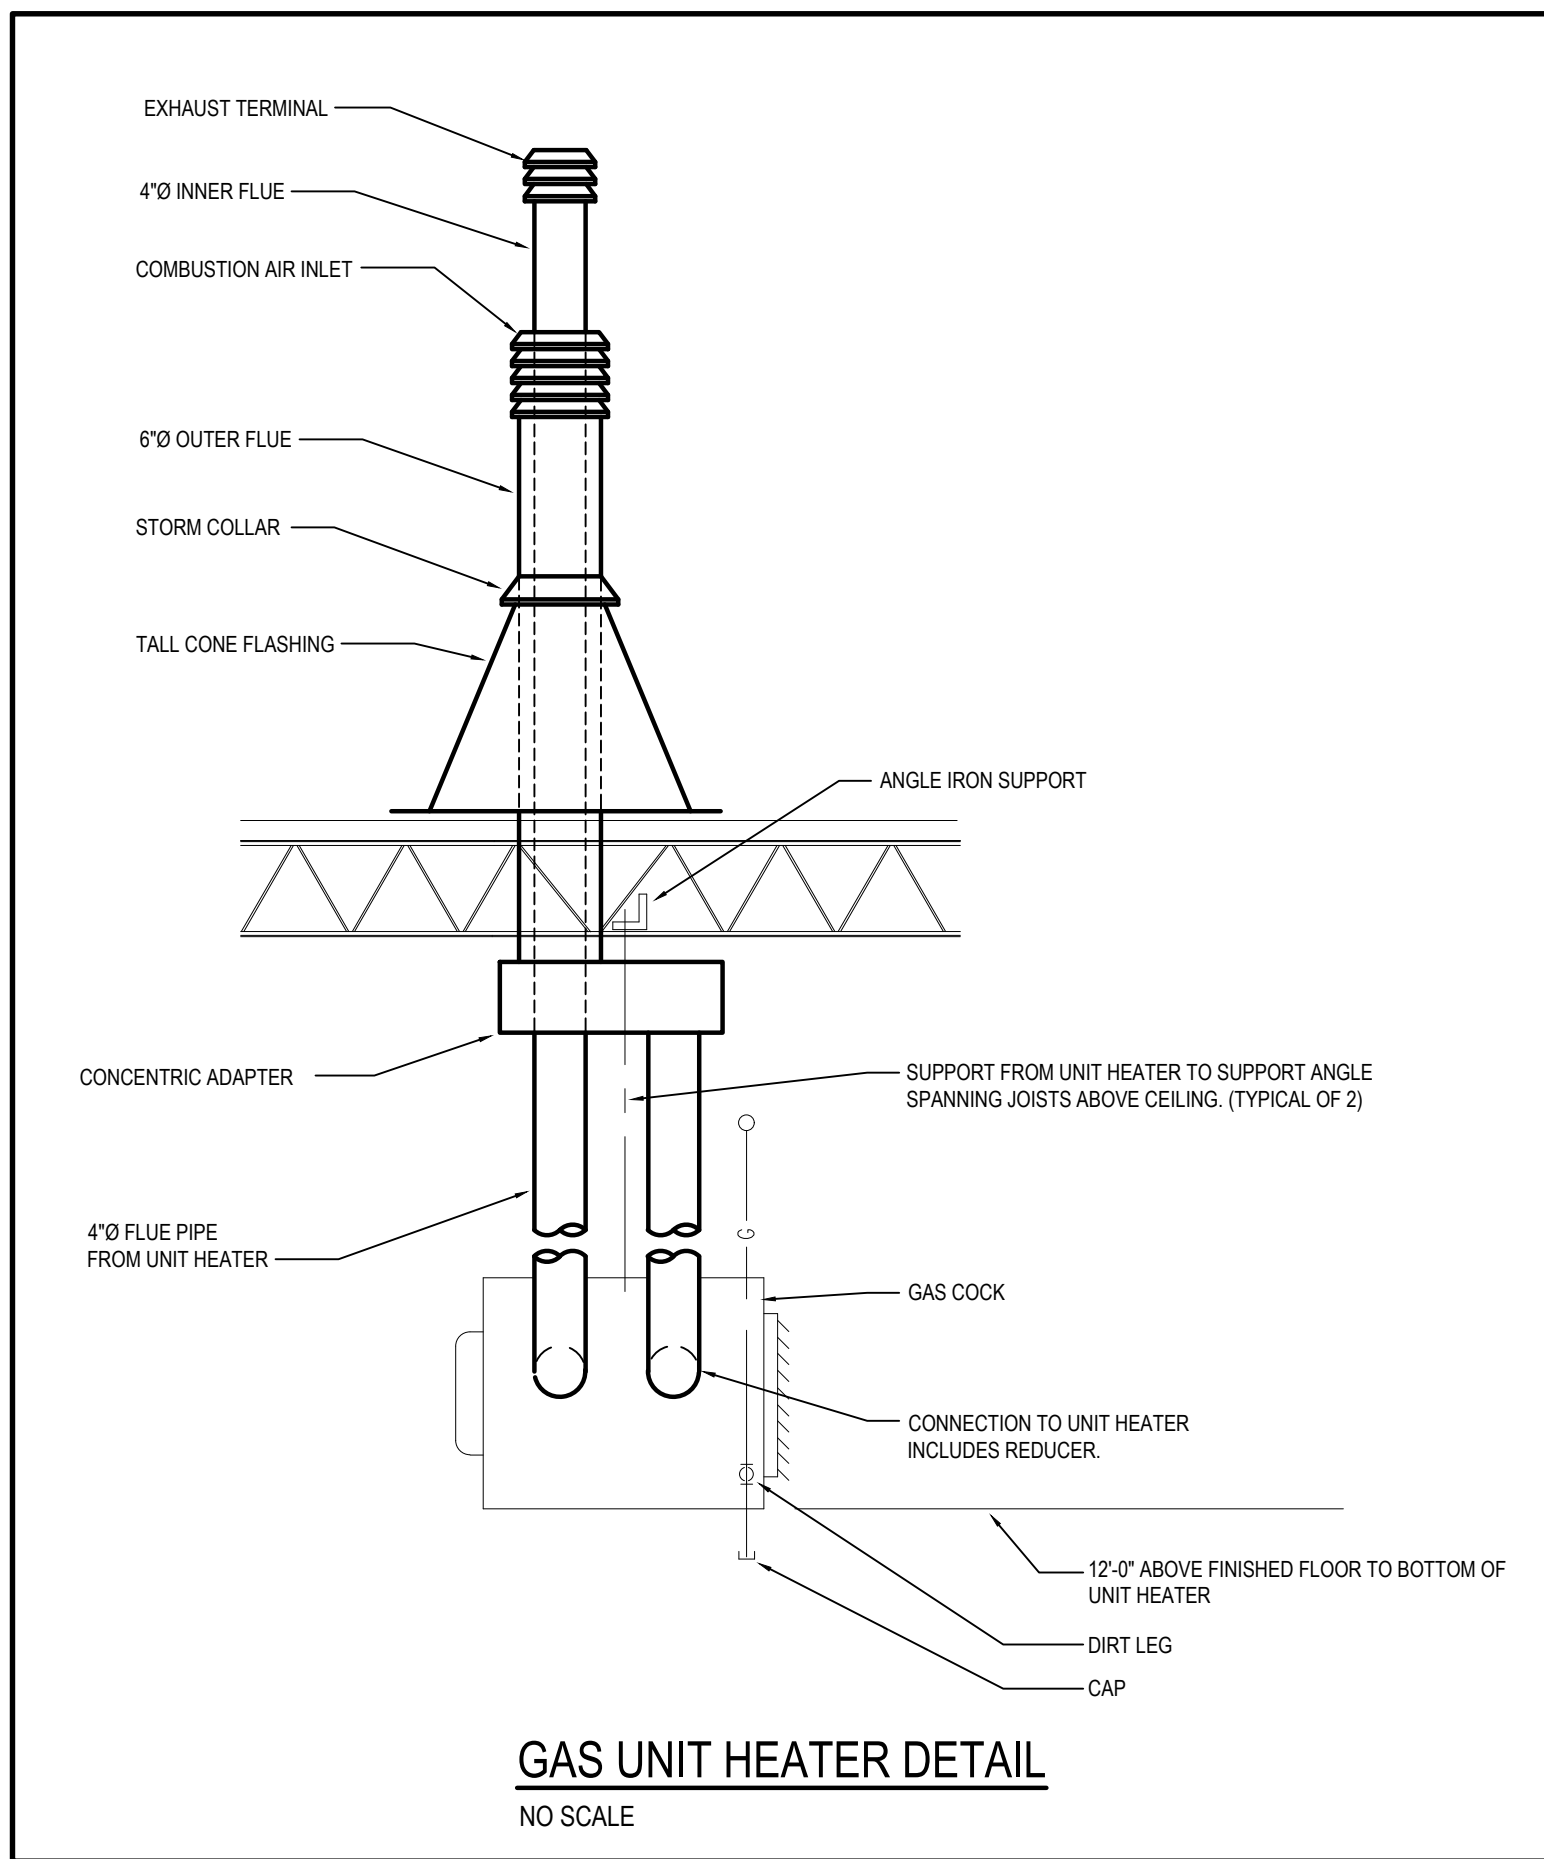

ADA ARCHITECTS
17710 Detroit Avenue
Lakewood, Ohio 44107
Phone (216) 521-5134 Fax (216) 521-4824
www.adaarchitects.com

HARBOR FREIGHT
46 SHRJJI LANE
ERWIN, NC 28339

THESE DOCUMENTS CONTAIN INFORMATION PROPRIETARY TO ADA ARCHITECTS, INC. UNAUTHORIZED USE OF THESE DOCUMENTS IS EXPRESSLY PROHIBITED UNLESS AGREED UPON IN WRITING.

REVISIONS

#	DATE	TYPE
1		
2		
3		
4		
5		
6		
7		
8		
9		

MECHANICAL DETAILS

DATE 05/17/24

JOB NO. 23475

M1.2
SHEET NO.

GAS PIPING NOTES:

- PLUMBING CONTRACTOR TO NOTIFY THE AUTHORITY HAVING JURISDICTION WHEN THE INSTALLATION IS READY FOR INSPECTION (AT ROUGH-IN PRIOR TO COVERING AND FINAL).
- PLUMBING CONTRACTOR SHALL FURNISH AND INSTALL GAS PRESSURE REGULATOR, MANUAL SHUT-OFF VALVE, DRIPS AND/OR SEDIMENT TRAPS AT EACH PIECE OF EQUIPMENT AND AT THE OUTLET OF THE METER. VALVES AND DRIPS SHALL BE READILY ACCESSIBLE TO PERMIT CLEANING, EMPTYING OR SERVICING.
- GAS PIPING IS SIZED WITH LONGEST LENGTH METHOD AND BASED ON THE INTERNATIONAL FUEL GAS CODE, SCHEDULE 40 METALLIC PIPE TABLE 402.4(2).
- PLUMBING CONTRACTOR SHALL BE RESPONSIBLE FOR PRESSURE TESTING AND INSPECTION PRIOR TO ACCEPTANCE. PER NFPA 54. TEST PRESSURE SHALL BE NO LESS THAN 1-1/2 TIMES THE MAXIMUM WORKING PRESSURE, BUT NOT LESS THAN 3 PSI. TEST SHALL BE NOT LESS THAN 1/2 HOUR PER 500 CF OF PIPE VOLUME.
- GAS PIPING ABOVE GROUND SHALL BE SCHEDULE 40 BLACK STEEL WITH 125 POUND BLACK MALLEABLE IRON SCREWED FITTINGS FOR 2" AND SMALLER AND WELDED FOR 2-1/2" AND ABOVE. GAS PIPING COMPOUND AT JOINTS SHALL BE PER NFPA BULLETIN #54 AND LOCAL CODES. GAS VALVES SHALL BE UL LISTED FOR GAS SERVICE SUCH AS DEZURICK MODEL S-425 FOR 2" AND LESS AND MODEL F-425 FOR 2-1/2" AND LARGER. NOTE: WELDED PIPE TO BE WITH APPROVED WELD-O-LET FITTINGS.
- GAS PIPING SERVING HARBOR FREIGHT TOOLS' LEASE SPACE IS TO BE PRIMED AND PAINTED WITH TWO (2) COATS OF RUST RESISTANT PAINT. PAINT EXTERIOR GAS PIPING TO MATCH BUILDING COLOR AND NEW GAS PIPING ON ROOF SHALL BE PAINTED SAFETY YELLOW AS REQUIRED BY SECTION 404 OF THE INTERNATIONAL FUEL GAS CODE.

HARBOR FREIGHT TOOLS' GAS DEMAND

ROOFTOP UNIT (RTU-01, NEW)	240.0 CFH (240,000 BTU/HR)
ROOFTOP UNIT (RTU-02, NEW)	240.0 CFH (240,000 BTU/HR)
ROOFTOP UNIT (RTU-03, NEW)	240.0 CFH (240,000 BTU/HR)
ROOFTOP UNIT (RTU-04, NEW)	240.0 CFH (240,000 BTU/HR)
GAS-FIRED UNIT HEATER (UH-01, NEW)	120.0 CFH (120,000 BTU/HR)
TOTAL GAS DEMAND	1,080.0 CFH (1,080,000 BTU/HR)

NOTES:

- INLET PRESSURE ASSUMED TO BE 7" W.C. CONFIRM GAS DELIVERY PRESSURE PRIOR TO STARTING WORK.
- GAS PIPE SIZES ARE BASED ON THE 2018 INTERNATIONAL FUEL GAS CODE TABLE 402.4(2) SCHEDULE 40 METALLIC PIPE. INLET PRESSURE OF LESS THAN 2 PSI. PRESSURE DROP OF 0.5 IN W.C. AND 300 FEET (TOTAL LENGTH OF PIPE).

NOTE:

PLUMBING CONTRACTOR SHALL RELOCATE ALL REQUIRED PIPING; WATER, VENTS, GAS, SANITARY WASTE, ETC., AS NECESSARY TO MAINTAIN A MINIMUM CLEARANCE OF 13'-6" ABOVE FINISHED FLOOR.

PLUMBING DEMOLITION GENERAL NOTES:

- THE PLUMBING CONTRACTOR SHALL FIELD VERIFY LOCATIONS OF ALL EXISTING PIPING, EQUIPMENT AND FIXTURES REQUIRING DEMOLITION. THE CONTRACTOR SHALL COORDINATE ALL DEMOLITION WORK WITH THE ARCHITECT, GENERAL CONTRACTOR, AND WITH THE OWNER.
- THE PLUMBING CONTRACTOR SHALL CUT EXISTING SANITARY AND WASTE PIPING 3" BELOW FLOOR AND PLUG WITH PERMANENT STOPPER.
- THE PLUMBING CONTRACTOR SHALL REMOVE ANY FLOOR DRAINS THAT ARE NOT USED FOR NEW SPACE LAYOUT. CUT WASTE LINE TO 3" BELOW FLOOR AND PLUG WITH PERMANENT STOPPER.
- THE PLUMBING DEMOLITION WORK SHALL BE PERFORMED EXCLUSIVELY BY THE PLUMBING CONTRACTOR UNLESS OTHERWISE INDICATED.
- ALL PATCHING AND SEALING OF WALLS, FLOORS, CEILINGS, ETC... TO BE DONE BY GENERAL CONTRACTOR.
- THE PLUMBING CONTRACTOR TO MAKE ALL FINAL PLUMBING CONNECTIONS TO FIXTURES & EQUIPMENT.
- THE PLUMBING CONTRACTOR SHALL CUT AND CAP UNUSED EXISTING WATER AND VENT LINES BELOW FLOOR.
- THE PLUMBING CONTRACTOR SHALL REMOVE ALL UNUSED EXPOSED EXISTING WASTE, VENT, GAS AND WATER PIPING COMPLETE.
- PLUMBING CONTRACTOR SHALL CAP ALL UNUSED SANITARY BRANCH LINES NEAR MAIN WITHIN 2'-0" WHERE POSSIBLE. NO DEAD END RUNS ARE ALLOWED PER CODE.

PLUMBING DEMISE CRITERIA:

WATER SERVICE:

THE LANDLORD SHALL PROVIDE A NEW 1-1/2" DOMESTIC WATER SERVICE, WATER METER AND BACKFLOW PREVENTER FOR HARBOR FREIGHT TOOLS' LEASE SPACE. PLUMBING CONTRACTOR SHALL CONFIRM THE EXISTENCE OF A BACKFLOW PREVENTER SERVING HARBOR FREIGHT TOOLS' LEASE SPACE. IF NONE EXISTS, THEN PLUMBING CONTRACTOR SHALL FURNISH AND INSTALL A BACKFLOW PREVENTER, AS APPLICABLE, PER LOCAL WATER DEPARTMENT REQUIREMENTS. FIELD VERIFY THE EXACT SIZE AND LOCATION OF THE EXISTING DOMESTIC WATER SERVICE PROVIDED BY LANDLORD PRIOR TO STARTING ANY WORK.

SEWER SERVICE:

THE LANDLORD SHALL PROVIDE A 4" SANITARY SEWER STUB AT THE PROPOSED RESTROOMS. PLUMBING CONTRACTOR SHALL TIE INTO STUB AND PERFORM THE REMAINDER OF THE UNDERGROUND PIPING. PLUMBING CONTRACTOR SHALL FIELD VERIFY EXACT LOCATION, SIZE, DIRECTION OF FLOW AND INVERT ELEVATION OF EXISTING SANITARY SEWER PRIOR TO STARTING ANY WORK. ALL NEW CONCRETE PATCHING FROM TRENCHING OF EXISTING CONCRETE SLAB FLOOR SHALL BE PATCHED TO MATCH EXISTING MATERIALS BY GENERAL CONTRACTOR. HARBOR FREIGHT TOOLS' PLUMBING CONTRACTOR SHALL FLUSH EXISTING SANITARY SYSTEM TO ENSURE IT IS IN PROPER WORKING CONDITION.

GAS SERVICE:


THE LANDLORD SHALL PROVIDE A NEW GAS METER AT THE SOUTHEAST CORNER OF THE BUILDING. PLUMBING CONTRACTOR SHALL EXTEND NEW 3" GAS LINE, FROM LANDLORD PROVIDED GAS METER, UP ALONG EXTERIOR BUILDING WALL TO ROOF. REPLACE EXIST. GAS METER AS NECESSARY TO ACCOMMODATE NEW GAS DEMAND. NEW GAS DEMAND = 1,080.0 CFH. COORDINATE WORK WITH LOCAL GAS COMPANY. FIELD VERIFY EXISTING CONDITIONS PRIOR TO STARTING WORK.

STORM SERVICE:

STORM WATER WILL EVACUATE THE ROOF VIA GUTTER AND DOWNSPOUTS THAT WILL BE ROUTED TO A SUB-GRADE SYSTEM.

PLUMBING LEGEND	
SYMBOL	DESCRIPTION
---	COLD WATER PIPING (CW)
---	HOT WATER PIPING (HW)
---	SANITARY SEWER (BELOW GRADE)
⊖	CLEANOUT
---	SANITARY VENT PIPING
G	GAS PIPING
⊗	SHUT-OFF VALVE IN RISER
⊗	SHUT-OFF VALVE
↘	RISER DOWN (ELBOW)
↗	RISER UP (ELBOW)
⊕	BRANCH-TOP CONNECTION
⊖	BRANCH-BOTTOM CONNECTION
⊕	TEE
⊔	ELBOW
WC	WATER CLOSET
LAV	LAVATORY
SK	SINK
DF	DRINKING FOUNTAIN
MS	MOP SINK
LL	LANDLORD
PC	PLUMBING CONTRACTOR
GC	GENERAL CONTRACTOR
EC	ELECTRICAL CONTRACTOR
MC	MECHANICAL CONTRACTOR

GAS PIPING HANGER SPACING SCHEDULE			
STEEL PIPE, NOMINAL SIZE OF PIPE (INCHES)	SPACING OF SUPPORT (FEET)	NOMINAL SIZE OF TUBING, SMOOTH-WALL (INCHES O.D.)	SPACING OF SUPPORT (FEET)
1/2	6	1/2	4
3/4 TO 1	8	5/8 OR 3/4	6
1-1/4 OR LARGER (HORIZONTAL)	10	7/8 OR 1 (HORIZONTAL)	8
1-1/4 OR LARGER (VERTICAL)	EVERY FLOOR LEVEL	1 OR LARGER (VERTICAL)	EVERY FLOOR LEVEL

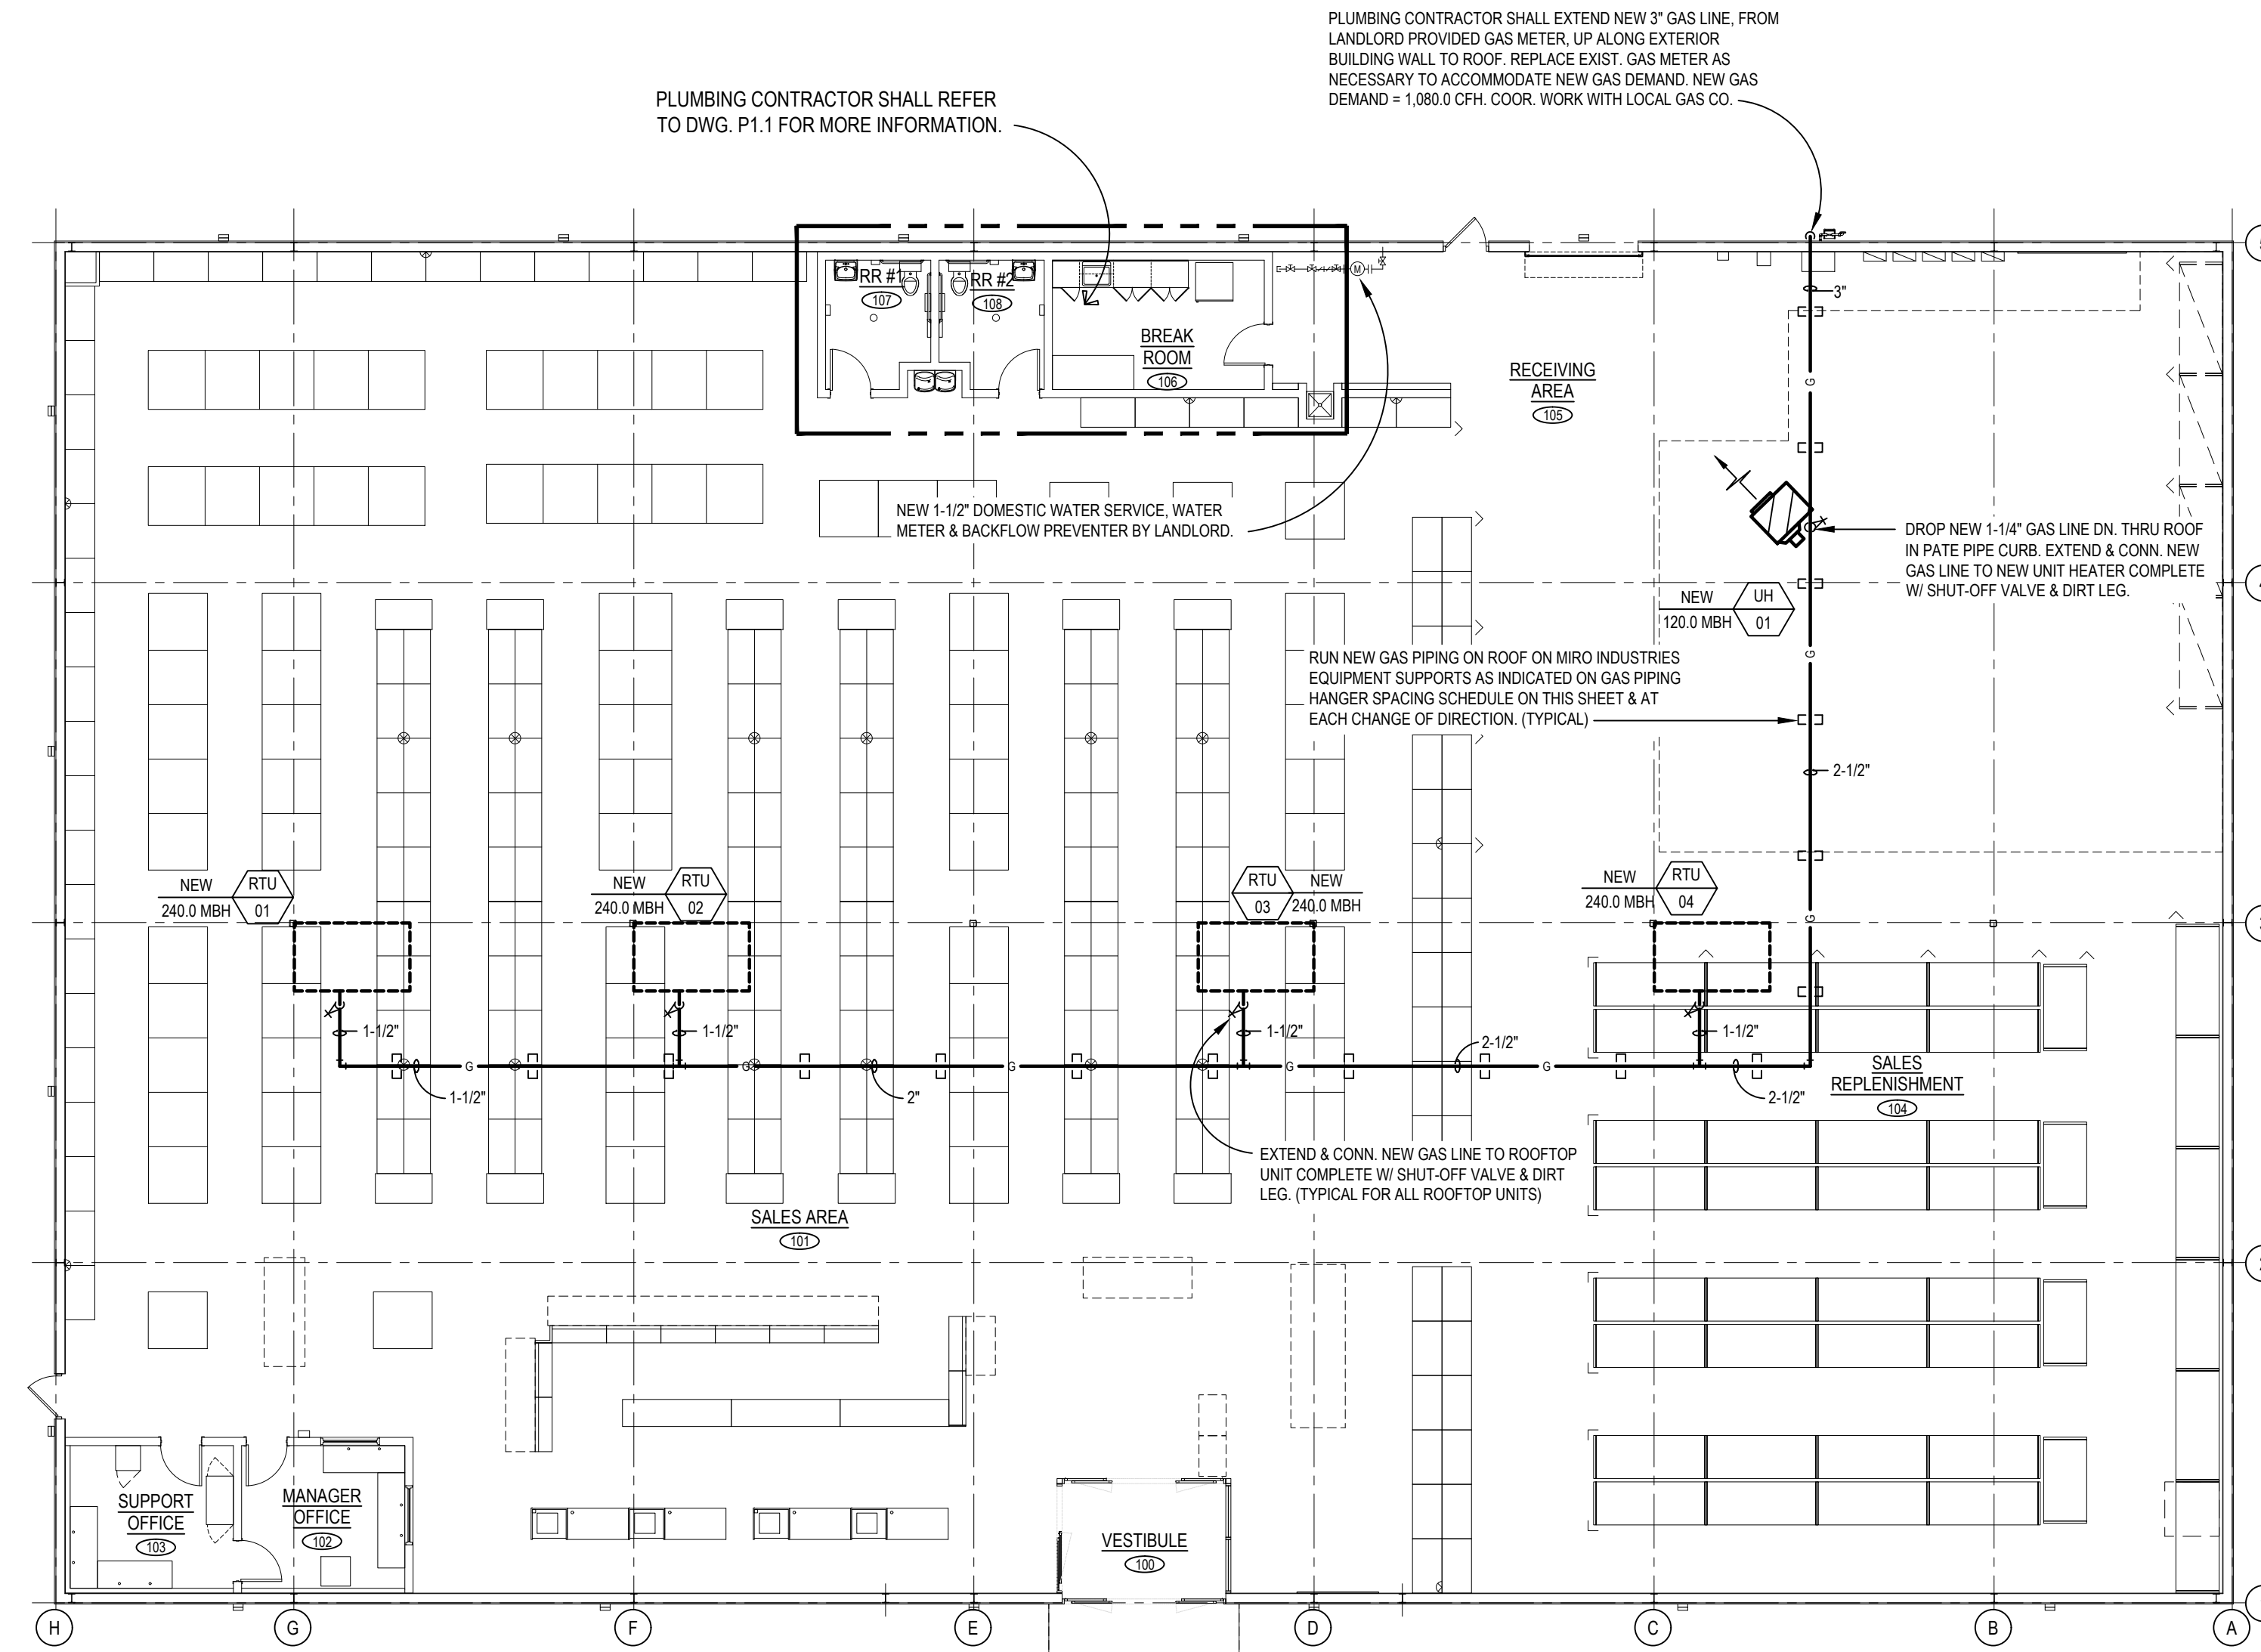

PLUMBING PLAN

SCALE: 3/32" = 1'-0"



HARBOR FREIGHT

46 SHRJI LANE ERWIN, NC 28339

REVISIONS

#	DATE	TYPE
1		
2		
3		
4		
5		
6		
7		
8		
9		

PLUMBING PLAN

DATE 05/17/24

JOB NO. 23475

P1.0

SHEET NO.

NOTE: PLUMBING CONTRACTOR SHALL REFER TO DWG. M1.3 FOR PLUMBING SPECIFICATIONS



ADA ARCHITECTS

17710 Detroit Avenue Lakewood, Ohio 44107
Phone (216) 521-5134 Fax (216) 521-4824
www.adaarchitects.com











THESE DOCUMENTS CONTAIN INFORMATION PROPRIETARY TO ADA ARCHITECTS, INC. UNAUTHORIZED USE OF THESE DOCUMENTS IS EXPRESSLY PROHIBITED UNLESS AGREED UPON IN WRITING.

PLUMBING GENERAL NOTES:

- EACH LENGTH OF PIPE, FITTINGS, TRAP, FIXTURE, MATERIAL, ETC., UTILIZED IN THE PLUMBING SYSTEM SHALL BEAR THE IDENTIFICATION OF THE MANUFACTURER, AND APPLICABLE STANDARD TO WHICH IT WAS MANUFACTURED.
- ALL MATERIALS USED SHALL BE INSTALLED IN STRICT ACCORDANCE WITH THE STANDARDS UNDER WHICH THE MATERIALS ARE ACCEPTED. ALSO THE MANUFACTURER'S INSTALLATION INSTRUCTIONS SHALL BE FOLLOWED.
- PIPES PASSING THROUGH CONCRETE SHALL BE PROTECTED AGAINST EXTERNAL CORROSION BY A PROTECTIVE SHEATHING OR WRAPPING.
- PLUMBING SYSTEM SHALL BE INSTALLED SO AS TO PREVENT STRAINS AND STRESSES THAT EXCEED THE STRUCTURAL STRENGTH OF THE PIPE.
- JOINTS AT THE FLOOR, ROOF AND AROUND VENT PIPES SHALL BE MADE WATER TIGHT.
- HANGERS, ANCHORS AND SUPPORTS SHALL SUPPORT THE PIPING AND THE CONTENT OF THE PIPING. HANGERS AND STRAPPING MATERIALS SHALL BE OF APPROVED MATERIALS THAT WILL NOT PROMOTE GALVANIC ACTION. PIPE SHALL BE SUPPORTED AS FOLLOWS:

CAST IRON PIPE	MAXIMUM HORIZONTAL 5'-0"
COPPER PIPE	MAXIMUM HORIZONTAL 12'-0"
COPPER TUBING 1-1/4" AND LESS	MAXIMUM HORIZONTAL 6'-0"
COPPER TUBING 1-1/2" AND LARGER	MAXIMUM HORIZONTAL 10'-0"
- RIGID SUPPORT SWAY BRACING SHALL BE PROVIDED AT CHANGES IN DIRECTION OVER 45° FOR PIPE SIZE 4" AND ABOVE.
- PLUMBING CONTRACTOR SHALL MAKE THE APPLICABLE TESTS. PLUMBING CONTRACTOR TO GIVE REASONABLE ADVANCE NOTICE TO THE CITY WHEN THE PLUMBING WORK IS READY FOR TESTS. THE FOLLOWING TESTS ARE REQUIRED:

DRAINAGE & VENT WATER TEST:	MINIMUM 10 FEET OF HEAD AND KEPT IN FOR AT LEAST 15 MINUTES BEFORE INSPECTION STARTS
DRAINAGE & VENT AIR TEST:	MINIMUM 5 PSI FOR AT LEAST 15 MINUTES
DRAINAGE & VENT FINAL TEST:	SHALL BE VISUAL AND IN SUFFICIENT DETAIL TO DETERMINE COMPLIANCE
WATER DISTRIBUTION SYSTEM:	MINIMUM 100 PSI WATER PRESSURE
- THE SUPPLY LINES AND FITTINGS FOR EVERY FIXTURE SHALL BE INSTALLED TO PREVENT BACKFLOW.
- THE FIXTURES SHALL BE SET LEVEL AND IN PROPER ALIGNMENT.
- CONNECTIONS BETWEEN THE DRAIN AND FLOOR OUTLET PLUMBING FIXTURE SHALL BE MADE WITH A FLOOR FLANGE.
- FLOOR DRAIN SHALL CONFORM TO ASME A112.6.3 OR ASME A112.3.1.
- WATER HEATER RELIEF VALVE SHALL CONFORM TO ANSI Z21.22.
- WATER HEATER DRAIN VALVE SHALL CONFORM TO ASSE 1005.
- AFTER CONSTRUCTION THE INDIVIDUAL WATER SUPPLY SYSTEM SHALL BE PURGED OF DELETERIOUS MATTER AND DISINFECTED.
- WATER-HAMMER ARRESTOR SHALL BE INSTALLED IN ACCORDANCE WITH THE MANUFACTURER'S SPECIFICATION AND ASSE 1010.
- COPPER OR COPPER-ALLOY TUBING (TYPE K, L & M) SHALL MEET ASTM B75, ASTM B88, ASTM B251, ASTM B447. WATER PIPING TO CONFORM TO NSF61 AND SHALL HAVE A MINIMUM PRESSURE RATING OF 100 PSI. THE JOINING OF SUPPLY PIPING TO BE MADE WITH LEAD-FREE (LESS THAN .2 PERCENT) SOLDER AND FLUXES.
- SANITARY DRAINAGE SYSTEM SHALL HAVE MINIMUM 1/8" PER FOOT SLOPE. FOR PIPING 3" TO 4" & 1/4" PER FOOT SLOPE FOR 2-1/2" PIPE & LESS.
- MECHANICAL JOINTS COUPLINGS FOR HUBLESS PIPE AND FITTINGS SHALL COMPLY WITH CISPI 310 OR ASTM C1277. THE ELASTOMERIC SEALING SLEEVE SHALL CONFORM TO ASTM C564.
- CLEANOUTS PLUGS TO BE BRASS. HORIZONTAL DRAINS SHALL HAVE CLEANOUTS AT 50 FEET ON CENTERS, AT EACH CHANGE (45 DEGREE) IN DIRECTION AND AT EACH BASE OF STACK. CLEANOUTS TO HAVE A MINIMUM CLEARANCE OF 18" FOR RODDING.
- VENT PIPES SHALL EXTEND THROUGH THE ROOF AND TERMINATE AT LEAST 12 INCHES ABOVE THE ROOF. VENT PIPE THROUGH ROOF TO BE MADE WATER TIGHT.
- THESE DRAWINGS ARE DIAGRAMMATIC IN NATURE. THE PLUMBING CONTRACTOR SHALL INCLUDE ALL NEEDED OFFSETS, CHANGES IN DIRECTION, ETC. NEEDED FOR COMPLETE AND OPERATIONAL SYSTEMS.
- THE CONTRACTOR WILL VISIT THE SITE AND BE FAMILIAR WITH SITE CONDITIONS. NO EQUIPMENT OR MATERIAL IS TO BE ORDERED OR FABRICATED PRIOR TO FIELD VERIFICATION OF ALL MEASUREMENTS, CLEARANCES, POTENTIAL CONFLICTS WITH EXISTING CONDITIONS OR THAT OF OTHER TRADES ON THE JOB.
- PERFORM ALL WORK IN ACCORDANCE WITH THE RULES & REGULATIONS OF THE APPROPRIATE STATE AND LOCAL BUILDING CODES AND SUBTITLES.
- QUESTIONS REGARDING THESE DRAWINGS SHALL BE ADDRESSED TO THE ENGINEER PRIOR TO THE AWARDED OF THE CONTRACT. OTHERWISE THE ENGINEER'S INTERPRETATION OF THE MEANING AND INTENT OF THE DRAWINGS SHALL BE FINAL.
- TENANT'S CONTRACTOR IS TO VERIFY POINTS OF CONNECTION OF ALL VENT, SEWER AND WATER LINES WITH LANDLORD BEFORE PROCEEDING WITH WORK.
- INSTALL SHUT OFF VALVES AT ALL PLUMBING FIXTURES.
- INSTALL HAMMER ARRESTORS AT ALL PLUMBING FIXTURES.
- ALL EXPOSED PIPING ABOVE TENANT'S CEILING SHALL BE INSULATED WITH A MINIMUM OF 1" GLASS FIBER WITH NON-COMBUSTIBLE UL RATED VAPOR BARRIER JACKET PER CODE.
- TENANT'S CONTRACTOR IS RESPONSIBLE FOR COMPLIANCE WITH ALL WITHIN THE LANDLORD'S TENANT CRITERIA MANUAL INCLUDING MALL MANAGEMENT'S RULES AND REGULATIONS.
- THE MOUNTING HEIGHTS OF ALL ACCESSORY ITEMS AND HARDWARE SHALL COMPLY WITH NBHA "RECOMMENDED LOCATIONS FOR BUILDERS HARDWARE" AND/OR THE LATEST REQUIREMENTS OF THE A.D.A. REGULATIONS, OR CABO/ANSI STANDARDS WHICHEVER APPLICATION IS MORE STRINGENT FOR ITS USE.
- TENANT CONTRACTOR IS TO HAVE ALL WEATHERPROOFING OF ROOF PENETRATIONS DONE BY LANDLORD'S APPROVED ROOFING CONTRACTOR.
- PLUMBING CONTRACTOR TO INSULATE ANY EXISTING EXPOSED OR RE-INSULATE ANY DAMAGED, MISSING PIPE INSULATION WITH NEW PIPE INSULATION.
- PLUMBING CONTRACTOR SHALL SNAKE ALL EXISTING SANITARY SEWERS A MINIMUM OF 250 FEET. ANY EXTERIOR TRUCK DOCK DRAINS SHALL BE SNAKED A MINIMUM OF 100 FEET.
- PLUMBING CONTRACTOR SHALL VIDEO ALL STORM AND SANITARY LINES DURING THE FIRST WEEK OF CONSTRUCTION AND AFTER CONSTRUCTION IS COMPLETE. VIDEO OF SANITARY LINES SHALL INCLUDE ALL FLOOR DRAINS AND CLEANOUTS. PLUMBING CONTRACTOR SHALL ISSUE WRITTEN EVALUATIONS TO HARBOR FREIGHT TOOLS' PROJECT MANAGER UPON COMPLETION OF EACH VIDEO AND UPLOAD BOTH VIDEOS TO PROTRACK AND PROVIDE A CD IN CLOSEOUT PACKAGE.
- THE SPOUTS OF DRINKING FOUNTAINS AND WATER COOLERS SHALL BE AT THE FRONT OF THE UNIT AND SHALL DIRECT THE WATER FLOW IN A TRAJECTORY THAT IS PARALLEL OR NEARLY PARALLEL TO THE FRONT OF THE UNIT. THE SPOUT SHALL PROVIDE A FLOW OF WATER AT LEAST 4 IN. HIGH SO AS TO ALLOW THE INSERTION OF A CUP OR GLASS UNDER THE FLOW OF WATER. ON AN ACCESSIBLE DRINKING FOUNTAIN WITH A ROUND OR OVAL BOWL, THE SPOUT MUST BE POSITIONED SO THE FLOW OF WATER IS WITHIN 3 IN. OF THE FRONT EDGE OF THE FOUNTAIN.

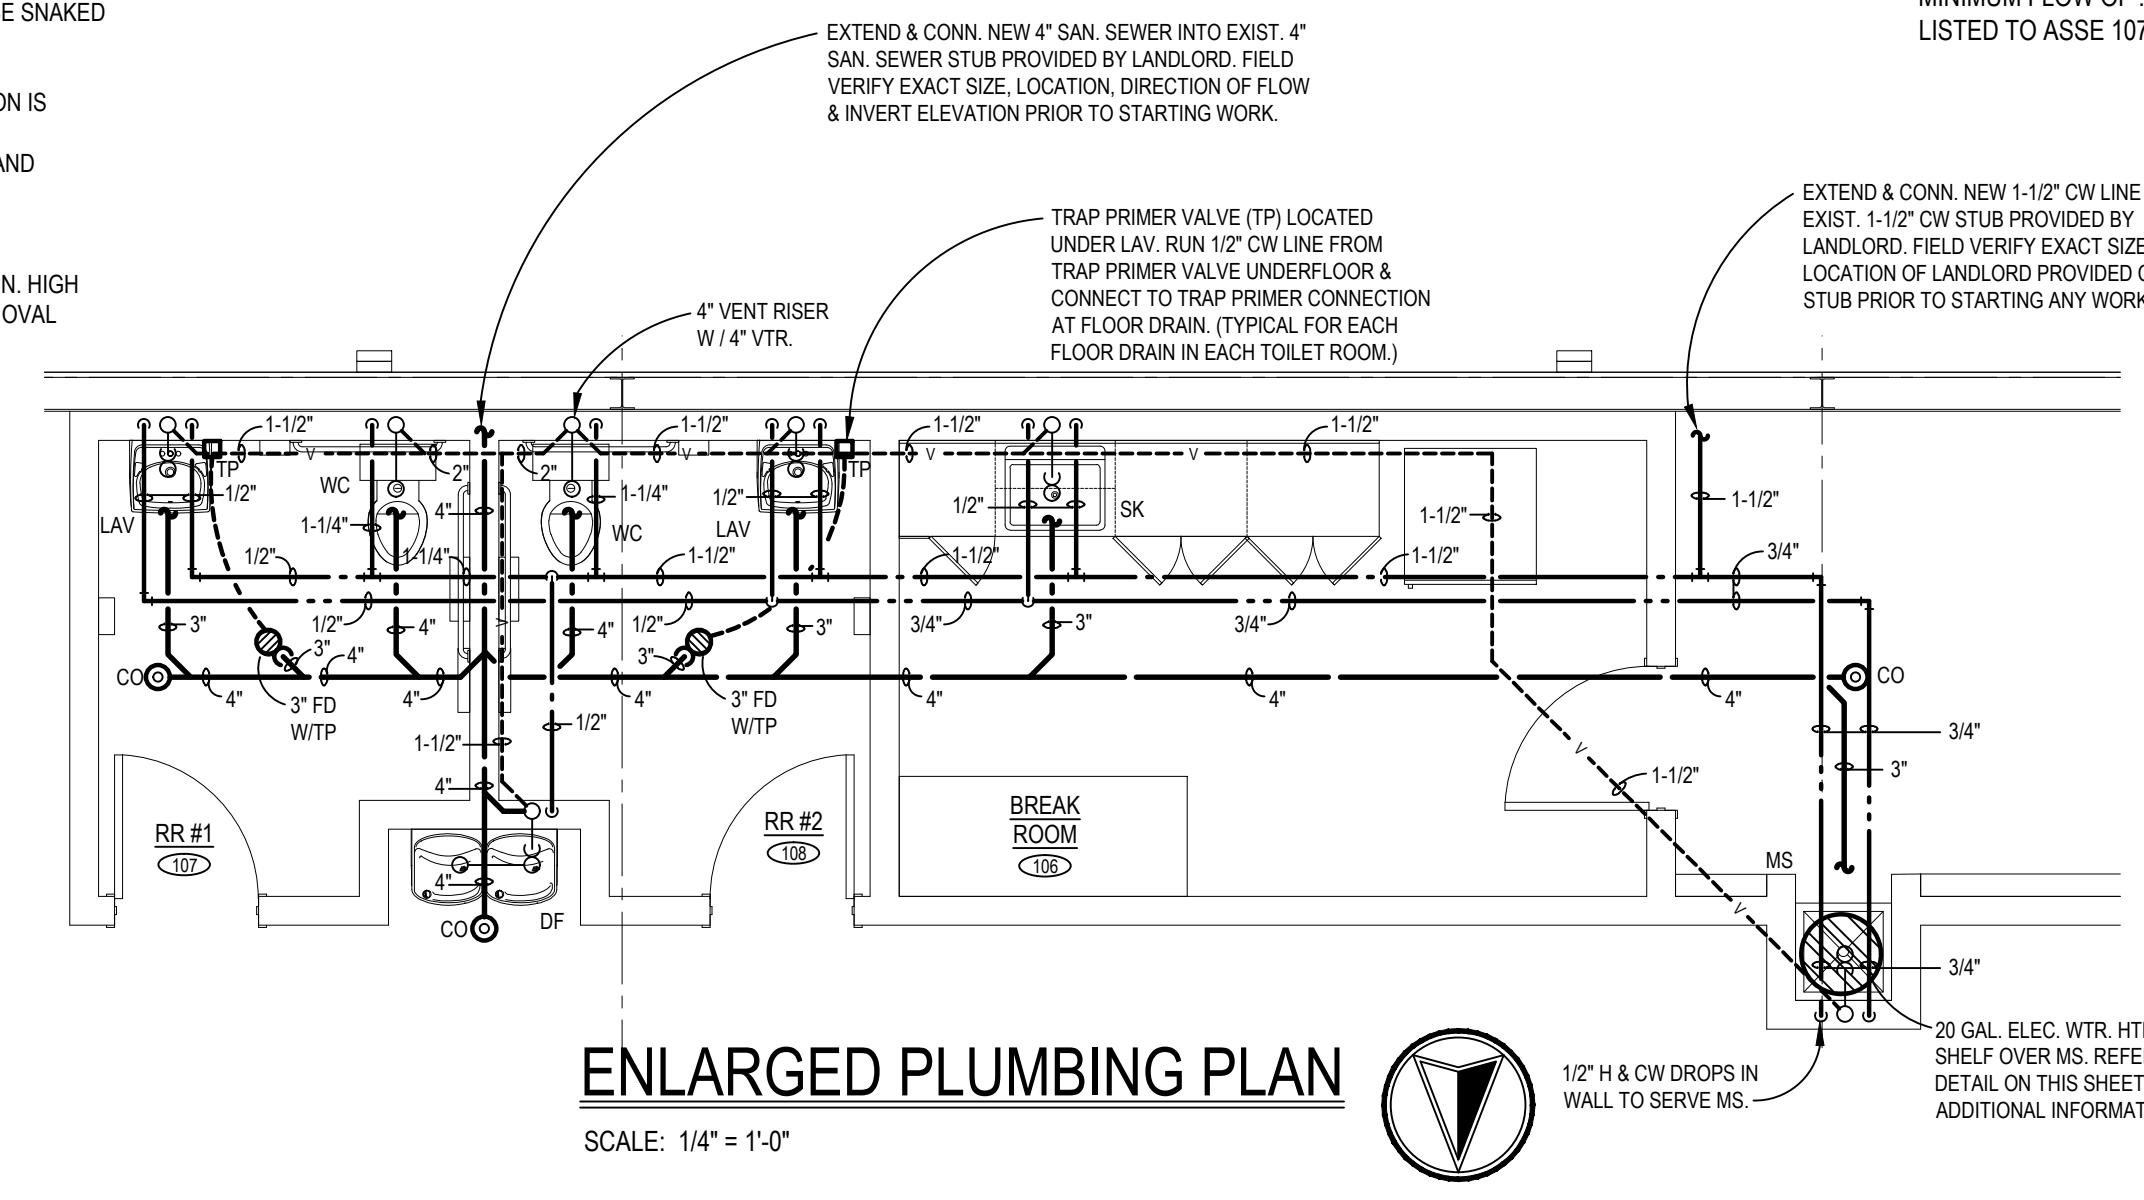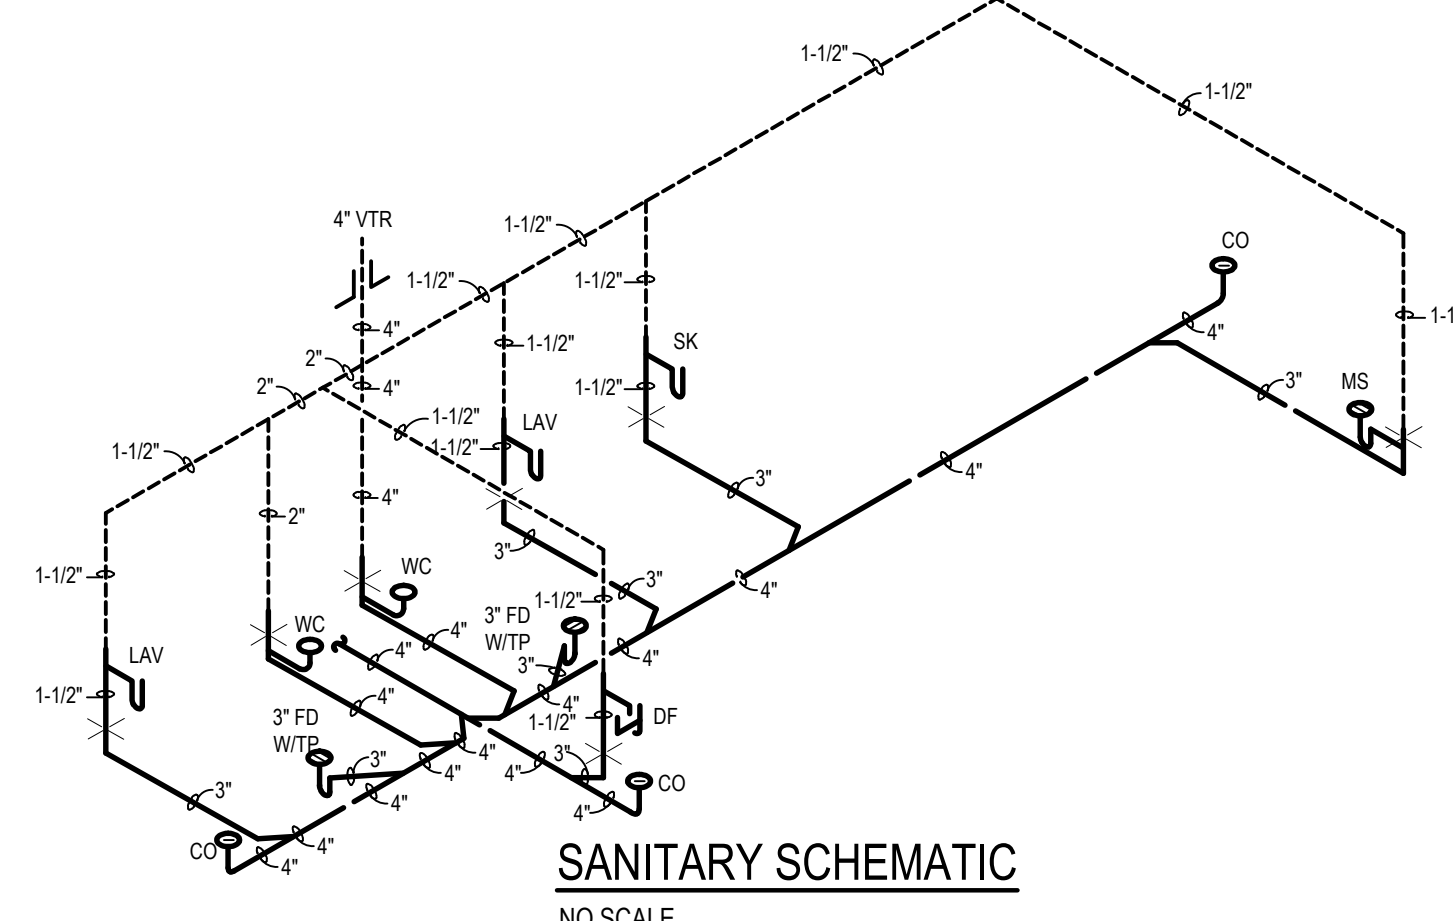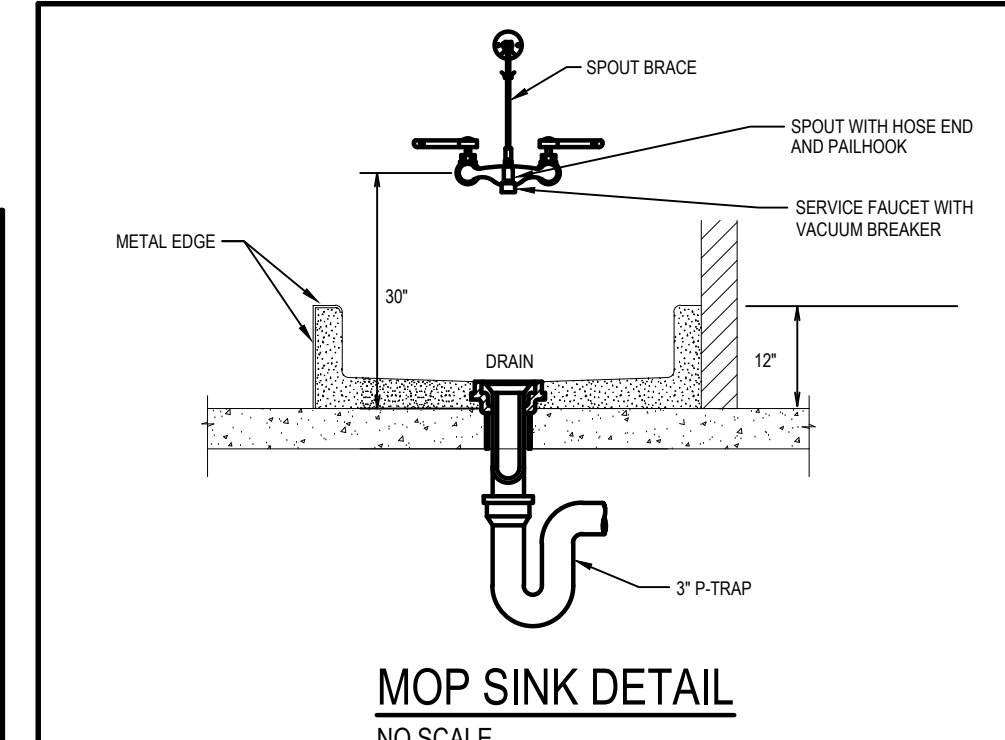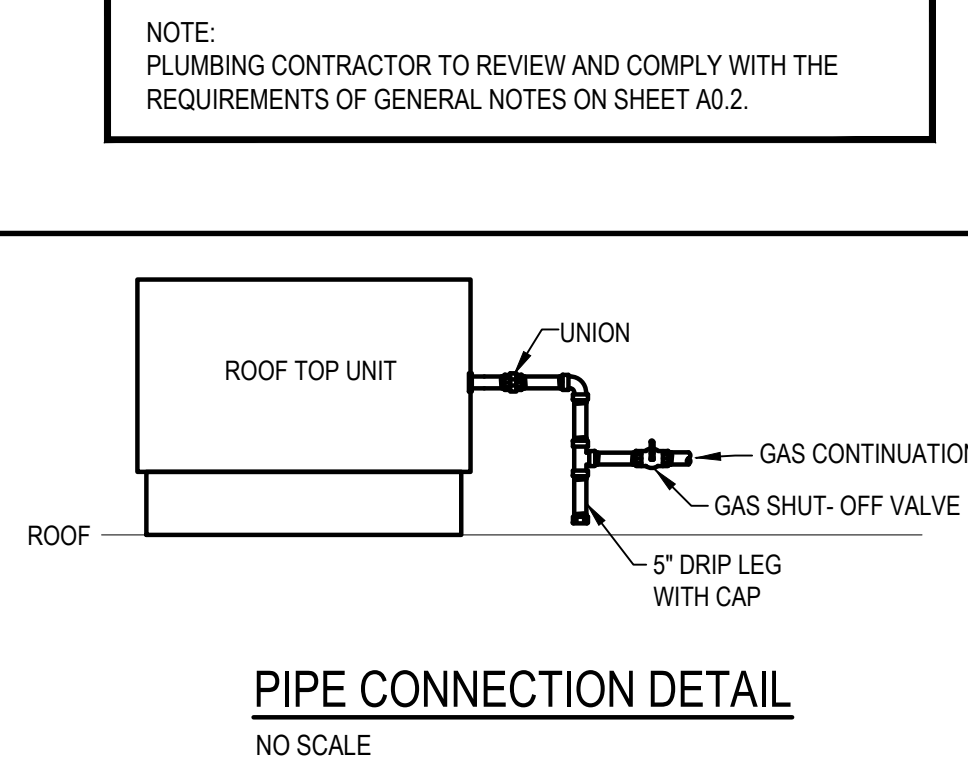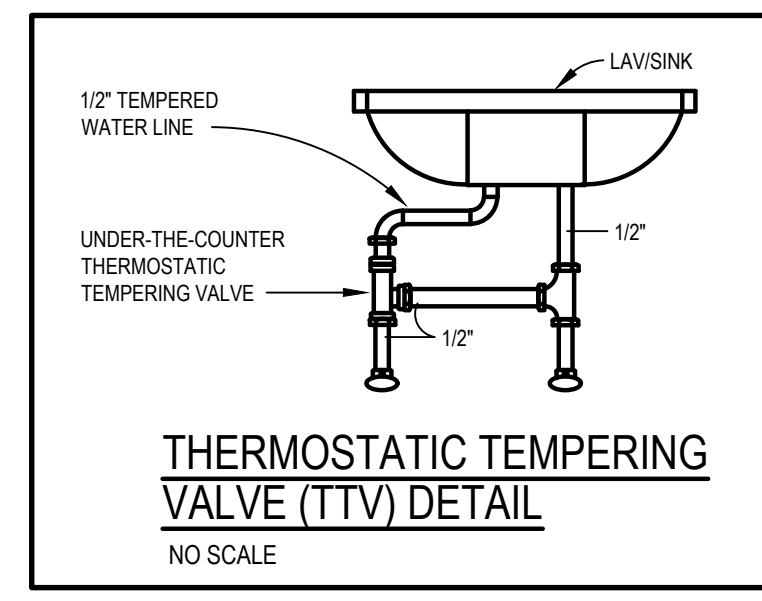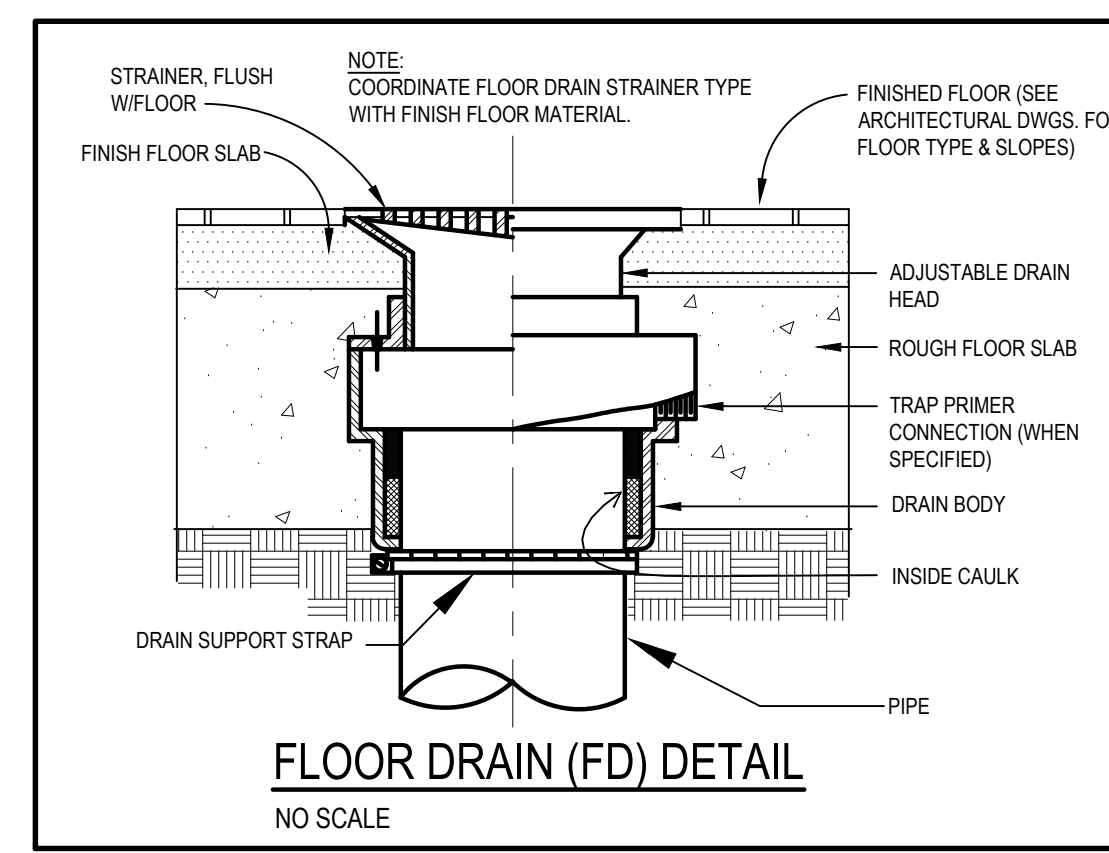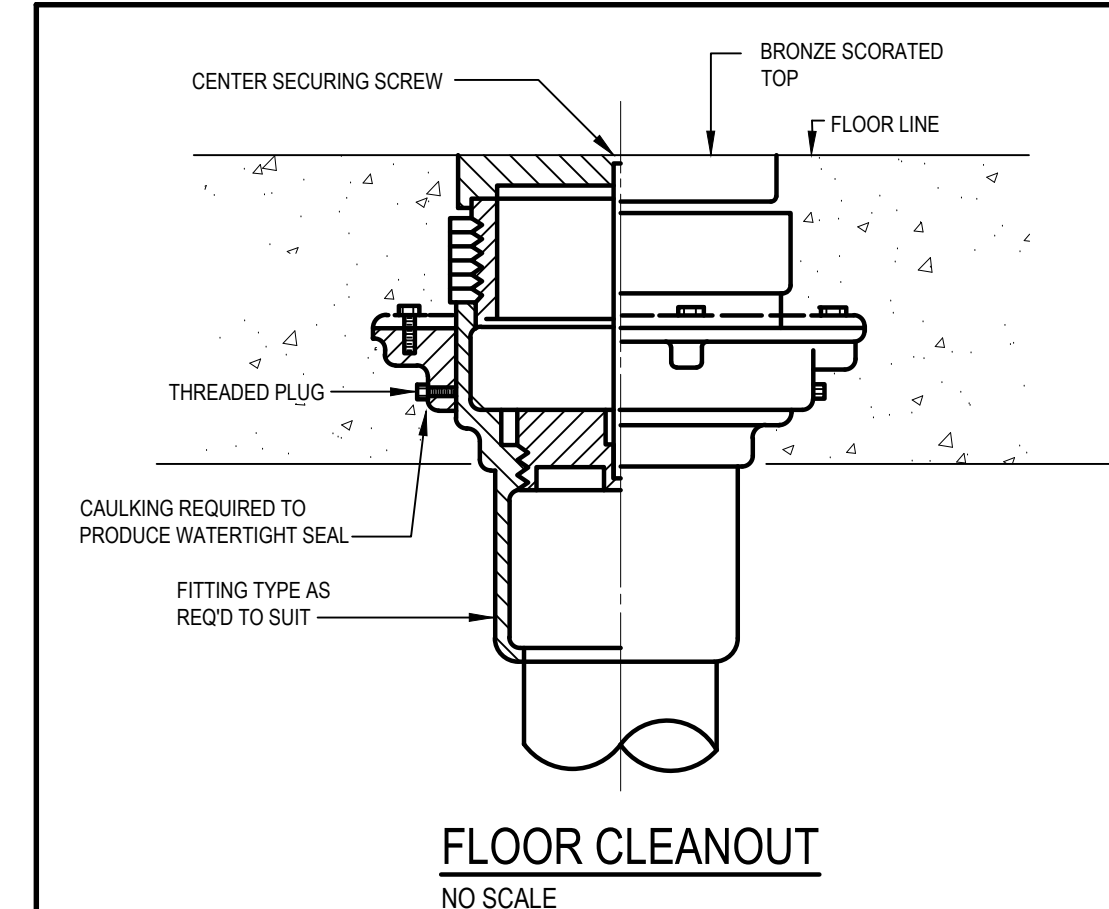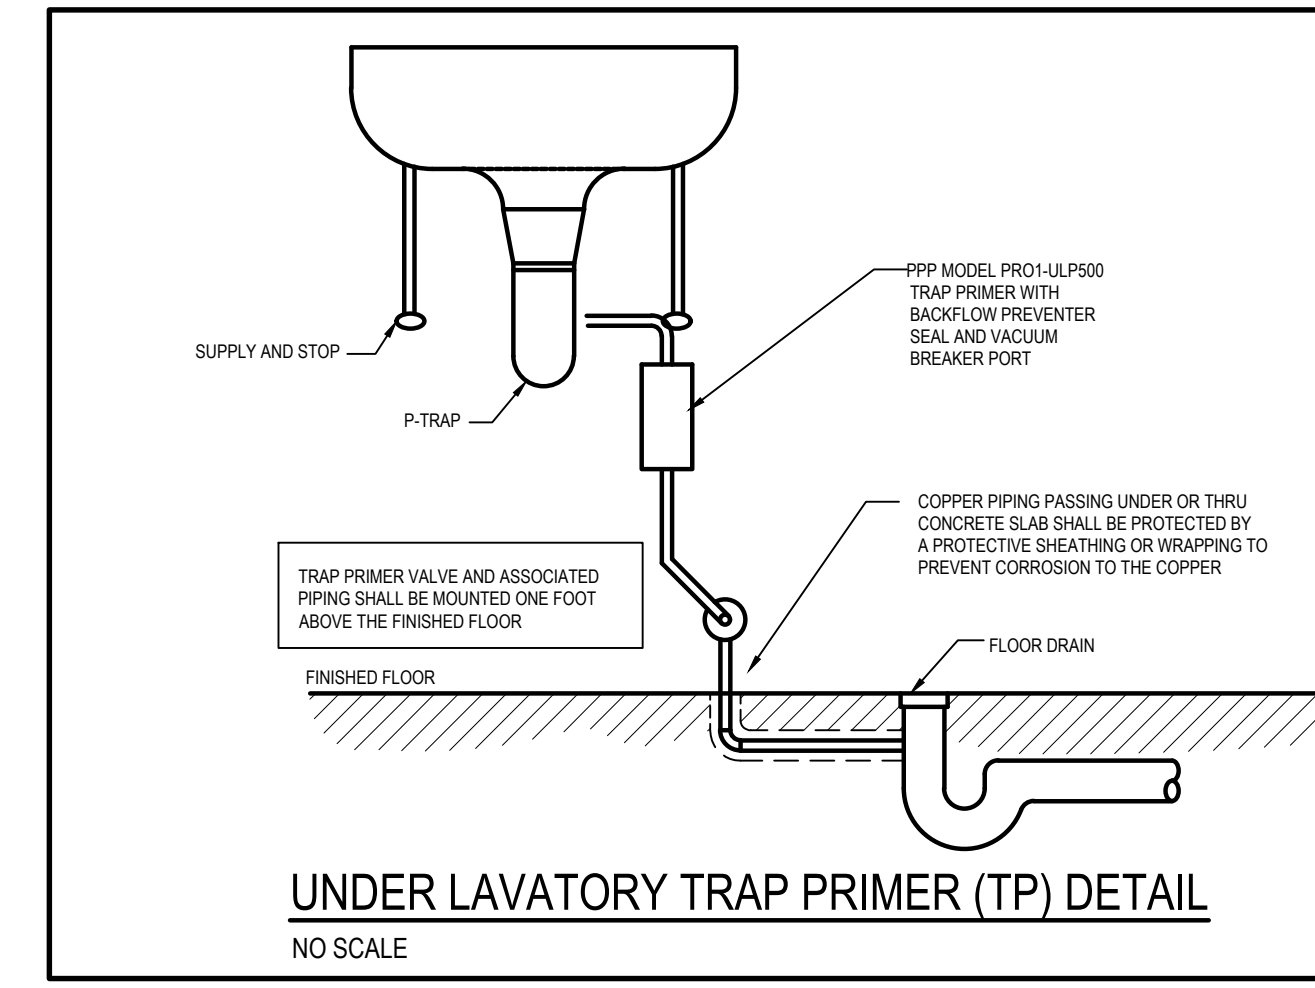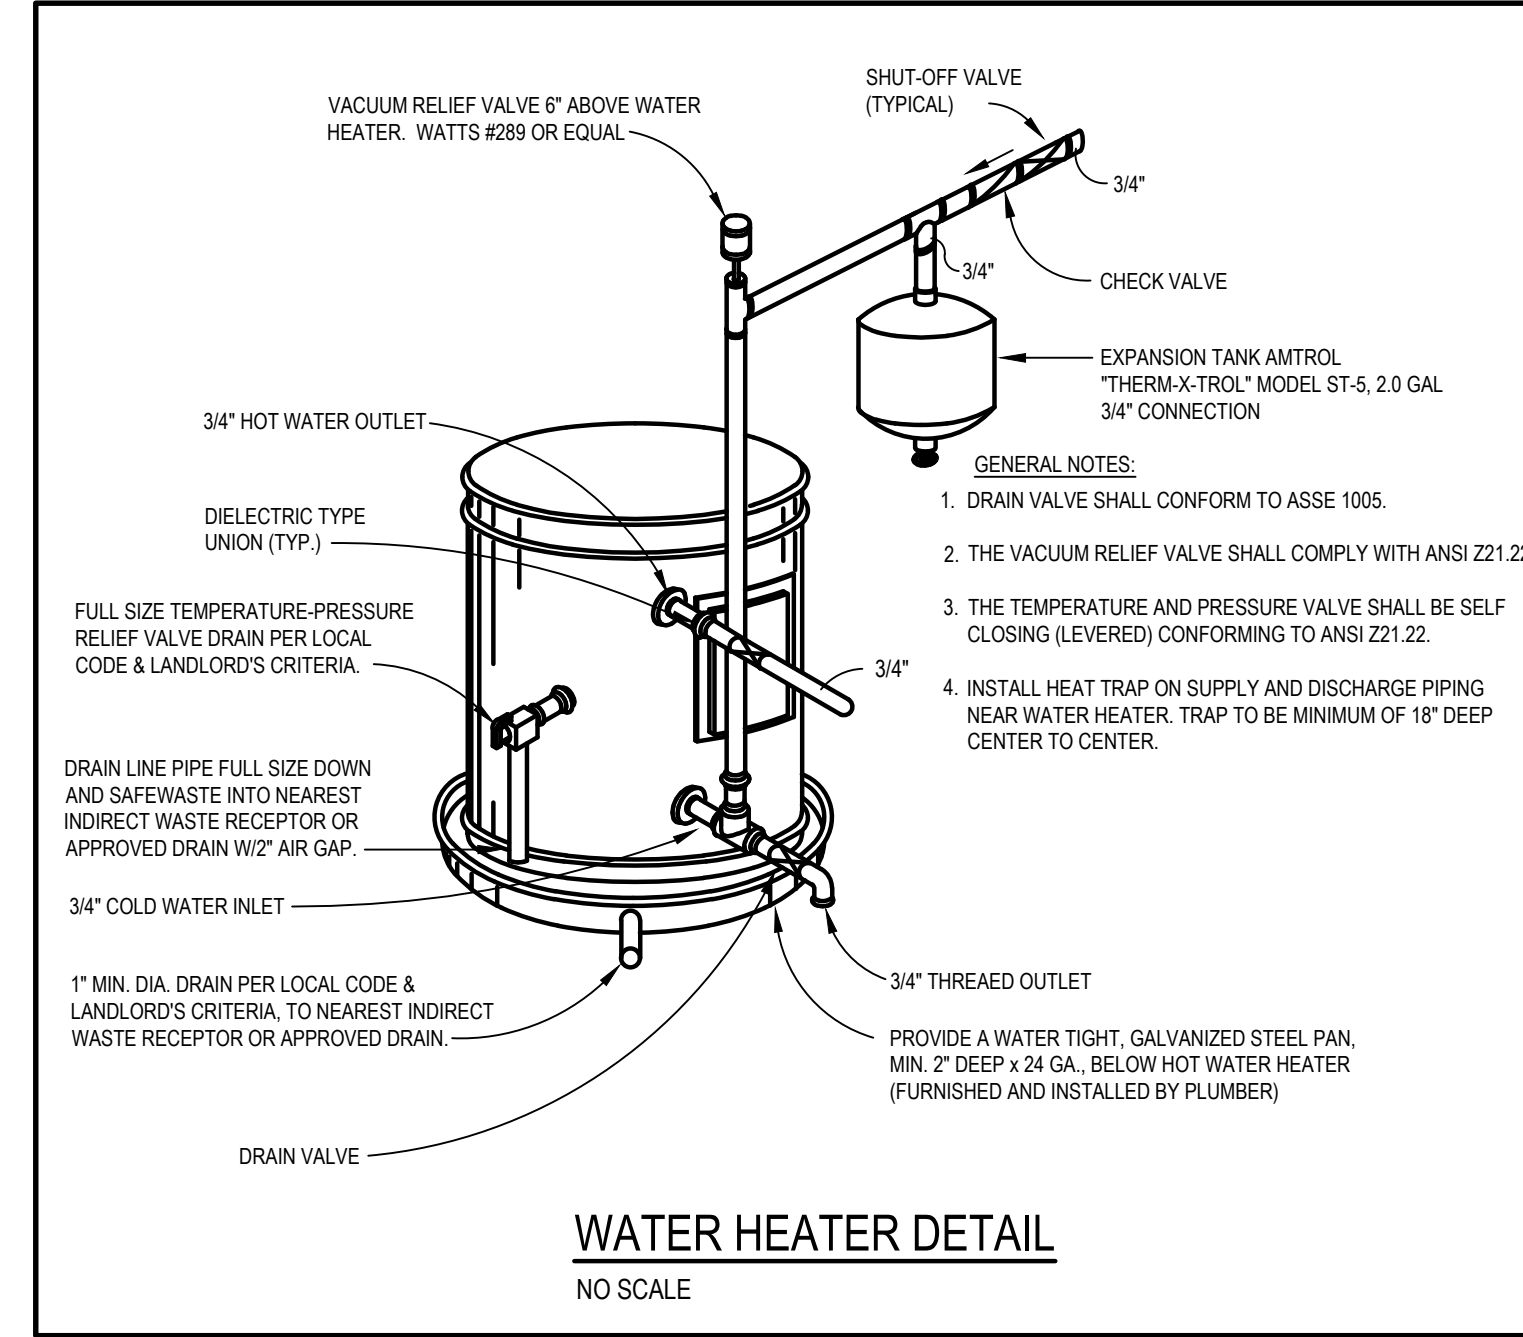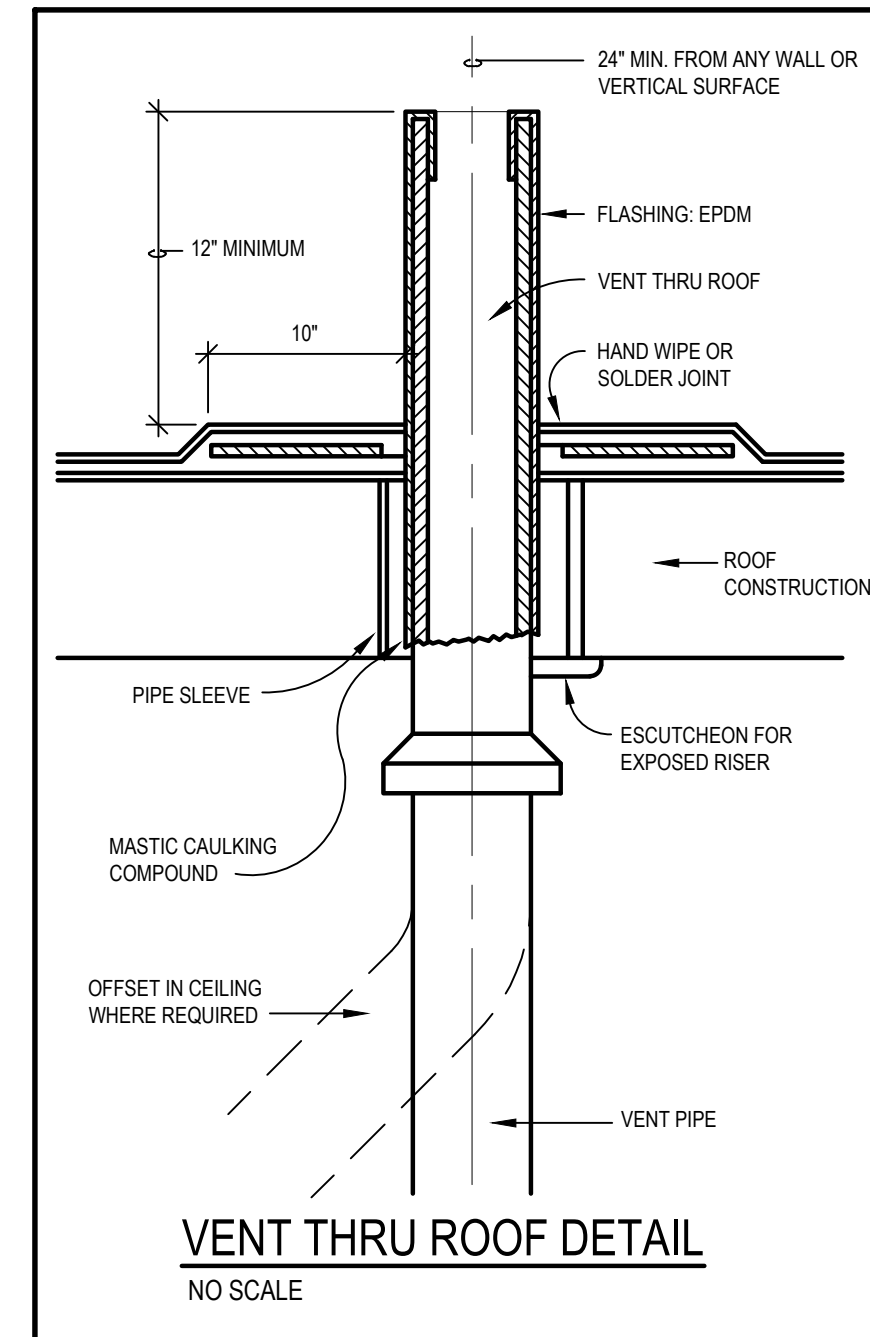

FIXTURE CONNECTION SCHEDULE					
TAG	DESCRIPTION	CW (IN.)	HW (IN.)	WASTE (IN.)	VENT (IN.)
WC	WATER CLOSET	1	-	4	2
LAV	LAVATORY	1/2	1/2 (105°F)	1-1/2	1-1/2
DF	DRINKING FOUNTAIN	1/2	-	1-1/2	1-1/2
SK	SINK	1/2	1/2 (105°F)	1-1/2	1-1/2
MS	MOP SINK	1/2	1/2	3	1-1/2

PLUMBING FIXTURE SPECIFICATIONS

FLOOR DRAIN (FD) - J.R. SMITH NO. 2005-P050 WITH ADJUSTABLE ROUND STRAINER HEAD AND TRAP PRIMER CONNECTION.

FLOOR CLEANOUT (CO) - J.R. SMITH NO. 4021S ADJUSTABLE CAST NIKALLOY FLOOR CLEANOUT WITH INTERNAL BRONZE COUNTERSINK PLUG AND SOLID SCORIATED SECURED ROUND COVER.

WALL CLEANOUT (WCO) - J.R. SMITH MODEL NO. 4422 DUCCO CAST IRON CAULK FERRULE WITH CAST BRONZE TAPER THREAD PLUG WITH STAINLESS STEEL COVER.

WATER HEATER (WH) - RHEEM POINT-OF-USE MODEL EGSP20, 20 GALLON STORAGE CAPACITY WITH 1.500 WATT HEATING ELEMENT, 120V, 1 PHASE WITH GALVANIZED STEEL PAN, RUN DRAIN LINE TO MOP SINK.

WATER CLOSET (WC) - AMERICAN STANDARD "MADERA FLOWWISE" MODEL 2857.111 FLOOR MOUNTED, ELONGATED FLUSHOMETER TOILET SYSTEM WITH MANUAL FLUSH VALVE, ULTRA LOW-CONSUMPTION (1.1 GPF), AND 16-1/2" RIM HEIGHT. SEAT: BEMIS MODEL NO. 1065SSC OPEN FRONT SEAT LESS COVER WITH SELF-SUSTAINING CHECK HINGES WITH NON-CORROSIVE STAINLESS STEEL POSTS, PINTLES, AND HARDWARE. NOTE: MOUNT FLUSH LEVER OPPOSITE SIDE OF WALL.

LAVATORY (LAV) - AMERICAN STANDARD "LUCERNE" MODEL 0355.012 WALL HUNG, BARRIER-FREE LAVATORY. FAUCET: MOEN MODEL NO. 8886 4" CENTERSET METERING FAUCET WITH 0.5 GPM VANDAL RESISTANT MULTI-STREAM LAMINAR FLOW, AND CHROME PLATED SOLID BRASS CONSTRUCTION. PROVIDE COMPLETE WITH GRID STRAINER, FOOTED WALL CHAIR CARRIER SUPPORT ZURN MODEL Z1231, CHROME TRAP WITH CLEANOUT AND CHROME SUPPLIES WITH LOOSE KEY STOPS. INSULATE WASTE AND WATER LINES WITH TRUEBRO "LAV GUARD 2" INSULATION KIT WITH WHITE FINISH TO CONFORM TO ADA REQUIREMENTS. MOUNT AT ELEVATION AS INDICATED ON THE ARCHITECTURAL DRAWINGS.

MOP SINK (MS) - "FIAT" MODEL TSB100 TERRAZZO MOP SERVICE BASIN (24"x24"x12"). PROVIDE COMPLETE WITH STAINLESS STEEL CAPS ON ALL CURBS, HOSE AND HOSE BRACKET MODEL 832A-A, (3) WALL GUARDS AND (2) ANGLE BRACKETS MODEL MSC2424; STAINLESS STEEL STRAINER MODEL 1453B; SILICONE SEALANT MODEL 833AA. FAUCET: CHICAGO FAUCETS MODEL NO. 897-CP WALL MOUNTED SERVICE FAUCET WITH VACUUM BREAKER, WALL BRACE, VANDAL PROOF LEVER HANDLES, AND 3/4" MALE HOSE THREAD OUTLET.

BREAKROOM SINK (SK) - JUST NO. SL-ADA-2019-A-GR, 18 GAUGE TYPE 304 ADA COMPLIANT SINGLE BOWL SELF-RIMMING STAINLESS STEEL SINK, 20"x19"x5-1/2" DEEP SINK WITH CENTER REAR DRAIN. FIXTURE WITH FAUCET LEDGE. SET IN BED OF PUTTY. FAUCET: JUST NO. J-902 SINGLE LEVER DECK MOUNTED FAUCET WITH SPRAYER, AND 2.2 GPM AERATOR. DRAIN: JUST NO. J-ADA35-FS STAINLESS STEEL DRAIN WITH REMOVABLE STRAINER WITH 1-1/2" 17 GAUGE OFFSET TAILPIECE. MCGUIRE NO. 8912-C-F-1-1/2" 17 GAUGE TUBULAR CHROME PLATED BRASS ADJUSTABLE P-TRAP WITH BRASS CLEANOUT WITH ESCUTCHEON AND CHROME SUPPLIES WITH LOOSE KEY STOPS.

DRINKING FOUNTAIN (DF) - ELKAY MODEL EZSTLDDLC TWO-LEVEL BARRIER-FREE WALL MOUNTED DRINKING FOUNTAIN WITH FLEXI-GUARD SAFETY BUBBLER AND FRONT AND SIDE PUSH BUTTONS AND LIGHT GRAY GRANITE FINISH. REFER TO PLUMBING GENERAL NOTE #36 FOR ADDITIONAL INFORMATION.

TEMPERING VALVE SERVING LAVATORY AND BREAK ROOM SINK SHALL BE WATTS SERIES LFMMV WITH A MINIMUM FLOW OF 5 GPM @ 0 & PSI PRESSURE DIFFERENTIAL. NOTE: TEMPERING VALVE SHALL BE LISTED TO ASSE 1070 STANDARD. SET OUTLET TEMPERATURE TO 105°F.

NOTE: PLUMBING CONTRACTOR SHALL REFER TO ARCHITECTURAL DRAWING A0.0 FOR PLUMBING FIXTURES AND ACCESSORIES PROVIDED BY HARBOR FREIGHT TOOLS.

NOTE: PLUMBING CONTRACTOR TO REVIEW AND COMPLY WITH THE REQUIREMENTS OF GENERAL NOTES ON SHEET A0.2.

20 GAL. ELEC. WTR. HTR. ON SHELF OVER MS. REFER TO DETAIL ON THIS SHEET FOR ADDITIONAL INFORMATION.



ADA ARCHITECTS
17710 Detroit Avenue, Lakewood, Ohio 44107
Phone (216) 521-5134 Fax (216) 521-4824
www.adaarchitects.com



HARBOR FREIGHT
ERWIN, NC 28339
46 SHRJJI LANE

THESE DOCUMENTS CONTAIN INFORMATION PROPRIETARY TO ADA ARCHITECTS INC. UNAUTHORIZED USE OF THESE DOCUMENTS IS EXPRESSLY PROHIBITED UNLESS AGREED UPON IN WRITING.

DATE	TYPE	#	1	2	3	4	5	6	7	8	9

PLUMBING DETAILS

DATE 05/17/24
JOB NO. 23475
P1.1
SHEET NO.

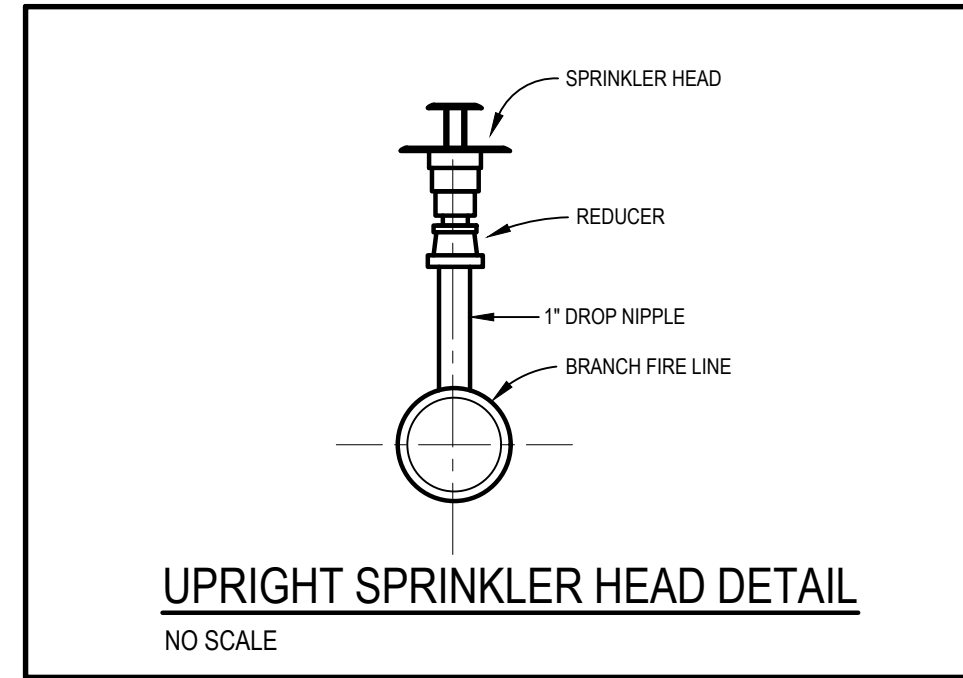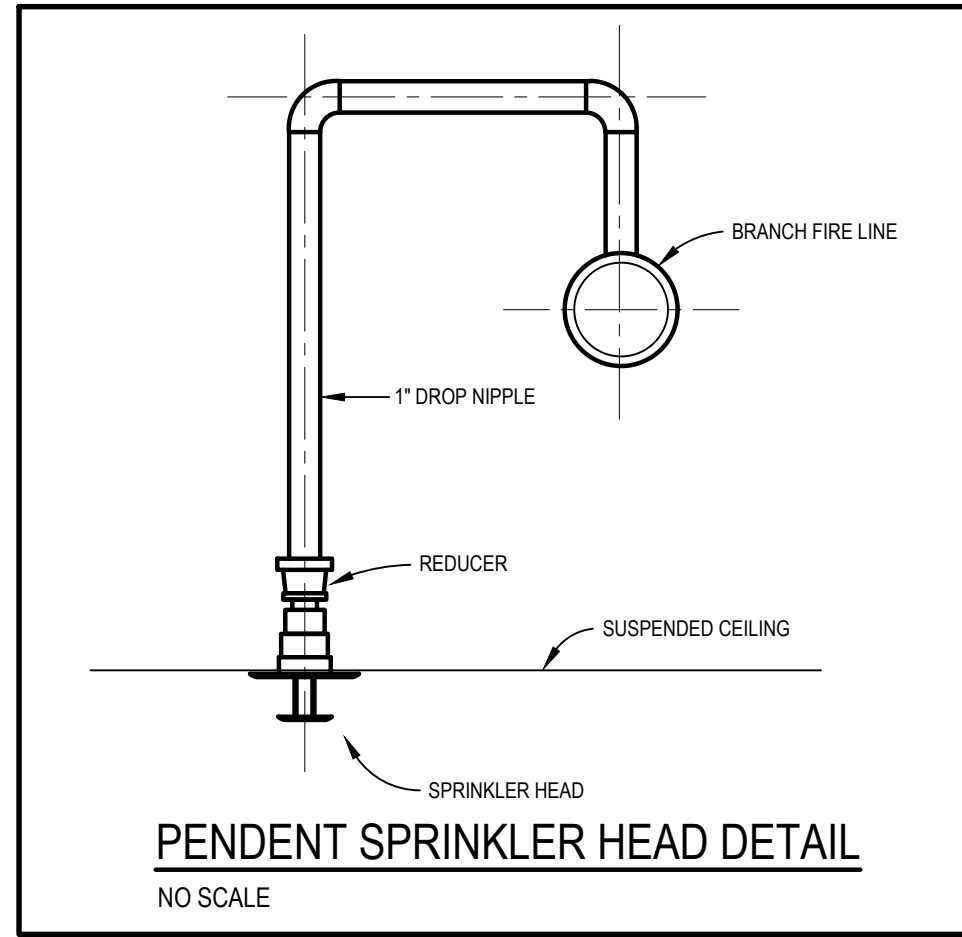

NOTE:
THE SPACE IS FULLY SUPPRESSED BY A 6"Ø FIRE RISER LOCATED TO THE WEST OF THE RECEIVING OVERHEAD DOOR.

NOTE:
GENERAL CONTRACTOR SHALL COORDINATE WITH BV AND LANDLORD FOR MONITORING REQUIREMENTS.

NOTE:
SPRINKLER CONTRACTOR SHALL RELOCATE ALL REQUIRED PIPING, ETC TO ALLOW HEIGHTS AS NOTED ON CEILING PLAN.

NOTE:
SPRINKLER CONTRACTOR SHALL ENSURE THAT EXISTING FIRE PROTECTION SYSTEM IS IN PROPER WORKING ORDER INCLUDING BUT NOT LIMITED TO BACKFLOW PREVENTION, FLOW AND TAMPER SWITCHES, ALARMS, ETC... AND MEETS NFPA-13 AND LOCAL FIRE DEPARTMENT REQUIREMENTS. PROVIDE 5 YEAR SYSTEM CERTIFICATION AT ROUGH INSPECTION.

NOTE:
GENERAL CONTRACTOR SHALL VERIFY SPRINKLER SYSTEM MONITORING, CERTIFICATION STATUS AND PREFERRED VENDOR REQUIREMENTS WITH HARBOR FREIGHT TOOLS' PROJECT MANAGER AND LANDLORD PRIOR TO SUBMITTING BID.

FIRE PROTECTION KEY NOTES:

- 1. MODIFY SPRINKLERS AND PIPING OF EXISTING FIRE PROTECTION SYSTEM AS NECESSARY TO ACCOMMODATE THE INSTALLATION OF NEW FULL HEIGHT WALLS, CEILING GRIDS AND LIGHTS PER NFPA 13 REQUIREMENTS. SPRINKLER HEADS SHALL BE PENDENT TYPE.
- 2. MODIFY SPRINKLERS AND PIPING OF EXISTING FIRE PROTECTION SYSTEM AS NECESSARY TO ACCOMMODATE THE INSTALLATION OF NEW LIGHTS AND WALLS PER NFPA 13 REQUIREMENTS. SPRINKLER HEADS SHALL BE UPRIGHT TYPE IN OPEN AREAS TO MATCH EXISTING.

DESIGN CRITERIA

FIRE PROTECTION AREA TYPES:

A) ORDINARY HAZARD II - 0.20 GPM/SQ.FT. OVER 1500 SQ.FT. WITH 250 GPM HOSE ALLOWANCE. SPRINKLERS SHALL BE SPACED AT A 130 SQ.FT. MAXIMUM WITH SPRINKLER HEADS AT A MAXIMUM OF 13'-0" APART AND SPACED AT A MAXIMUM OF 6'-6" FROM ALL WALLS.


NOTE: ORDINARY HAZARD IS BASED ON COMMODITY PLACEMENT.

B) LIGHT HAZARD - 0.10 GPM/SQ.FT. OVER 1500 SQ.FT. WITH 100 GPM HOSE ALLOWANCE. SPRINKLERS SHALL BE SPACED AT A 225 SQ.FT. MAXIMUM WITH SPRINKLER HEADS AT A MAXIMUM OF 15'-0" APART AND SPACED AT A MAXIMUM OF 7'-6" FROM ALL WALLS.

SALES: ORDINARY HAZARD II
SALES REPLENISHMENT: ORDINARY HAZARD II
BREAK ROOM: LIGHT HAZARD
TOILET ROOMS: LIGHT HAZARD

FIRE PROTECTION NOTES:

1. THIS DRAWING IS FOR REFERENCES PURPOSE ONLY. THE FIRE SPRINKLER CONTRACTOR SHALL BE RESPONSIBLE FOR THE FULL DESIGN OF THE SPRINKLER SYSTEM AND ITS CONFORMANCE TO NFPA 13 AND ANY LOCAL CODE REQUIREMENTS. THE FIRE PROTECTION CONTRACTOR SHALL INCLUDE ALL NEEDED OFFSETS, CHANGES IN DIRECTION, TRANSITIONS, ETC. NEEDED FOR COMPLETE AND OPERATIONAL SYSTEMS.
2. THE CONTRACTOR WILL VISIT THE SITE AND BE FAMILIAR WITH SITE CONDITIONS. NO EQUIPMENT OR MATERIAL IS TO BE ORDERED OR FABRICATED PRIOR TO FIELD VERIFICATION OF ALL MEASUREMENTS, CLEARANCES, POTENTIAL CONFLICTS WITH EXISTING CONDITIONS OR THAT OF OTHER TRADES ON THE JOB.
3. PERFORM ALL WORK IN ACCORDANCE WITH THE, RULES & REGULATIONS OF THE APPROPRIATE STATE AND LOCAL BUILDING CODES AND SUBTITLES.
4. QUESTIONS REGARDING THESE DRAWINGS SHALL BE ADDRESSED TO THE ENGINEER PRIOR TO THE AWARDED OF THE CONTRACT. OTHERWISE THE ENGINEER'S INTERPRETATION OF THE MEANING AND INTENT OF THE DRAWINGS SHALL BE FINAL.
5. SPRINKLER CONTRACTOR RESPONSIBLE TO OBTAIN A COPY OF THE SPECIFICATION ON DWG. M1.3 AND COMPLYING WITH THE REQUIREMENTS THEREIN.
6. SPRINKLER CONTRACTOR SHALL REVIEW ARCHITECTURAL DRAWINGS FOR CEILING TYPES, HEIGHTS, COLOR, ELEVATIONS, SOFFITS, DISPLAY WINDOWS, ETC.
7. FIRE PROTECTION SHOP DRAWINGS MUST BE SUBMITTED FOR LOCAL AUTHORITY DEPARTMENT REVIEW AND APPROVAL AT LEAST TWO WEEKS BEFORE THE PROJECTED INSTALLATION DATE.
8. FAILURE TO OBTAIN APPROVAL OF THESE DRAWINGS BEFORE INSTALLATION COULD RESULT NOT ONLY IN DELAY OF THE FINAL INSPECTION AND ISSUANCE OF AN OCCUPANCY PERMIT, BUT ALSO IN REMOVAL AND RECONSTRUCTION OF INSTALLATIONS WHICH FAIL TO MEET LOCAL AND NFPA REQUIREMENTS.
9. SPRINKLER CONTRACTOR SHALL SUBMIT WORKING FIRE PROTECTION PLANS, HYDRAULIC CALCULATIONS, ETC... TO THE FIRE DEPARTMENT FOR SEPARATE PLAN CHECK.

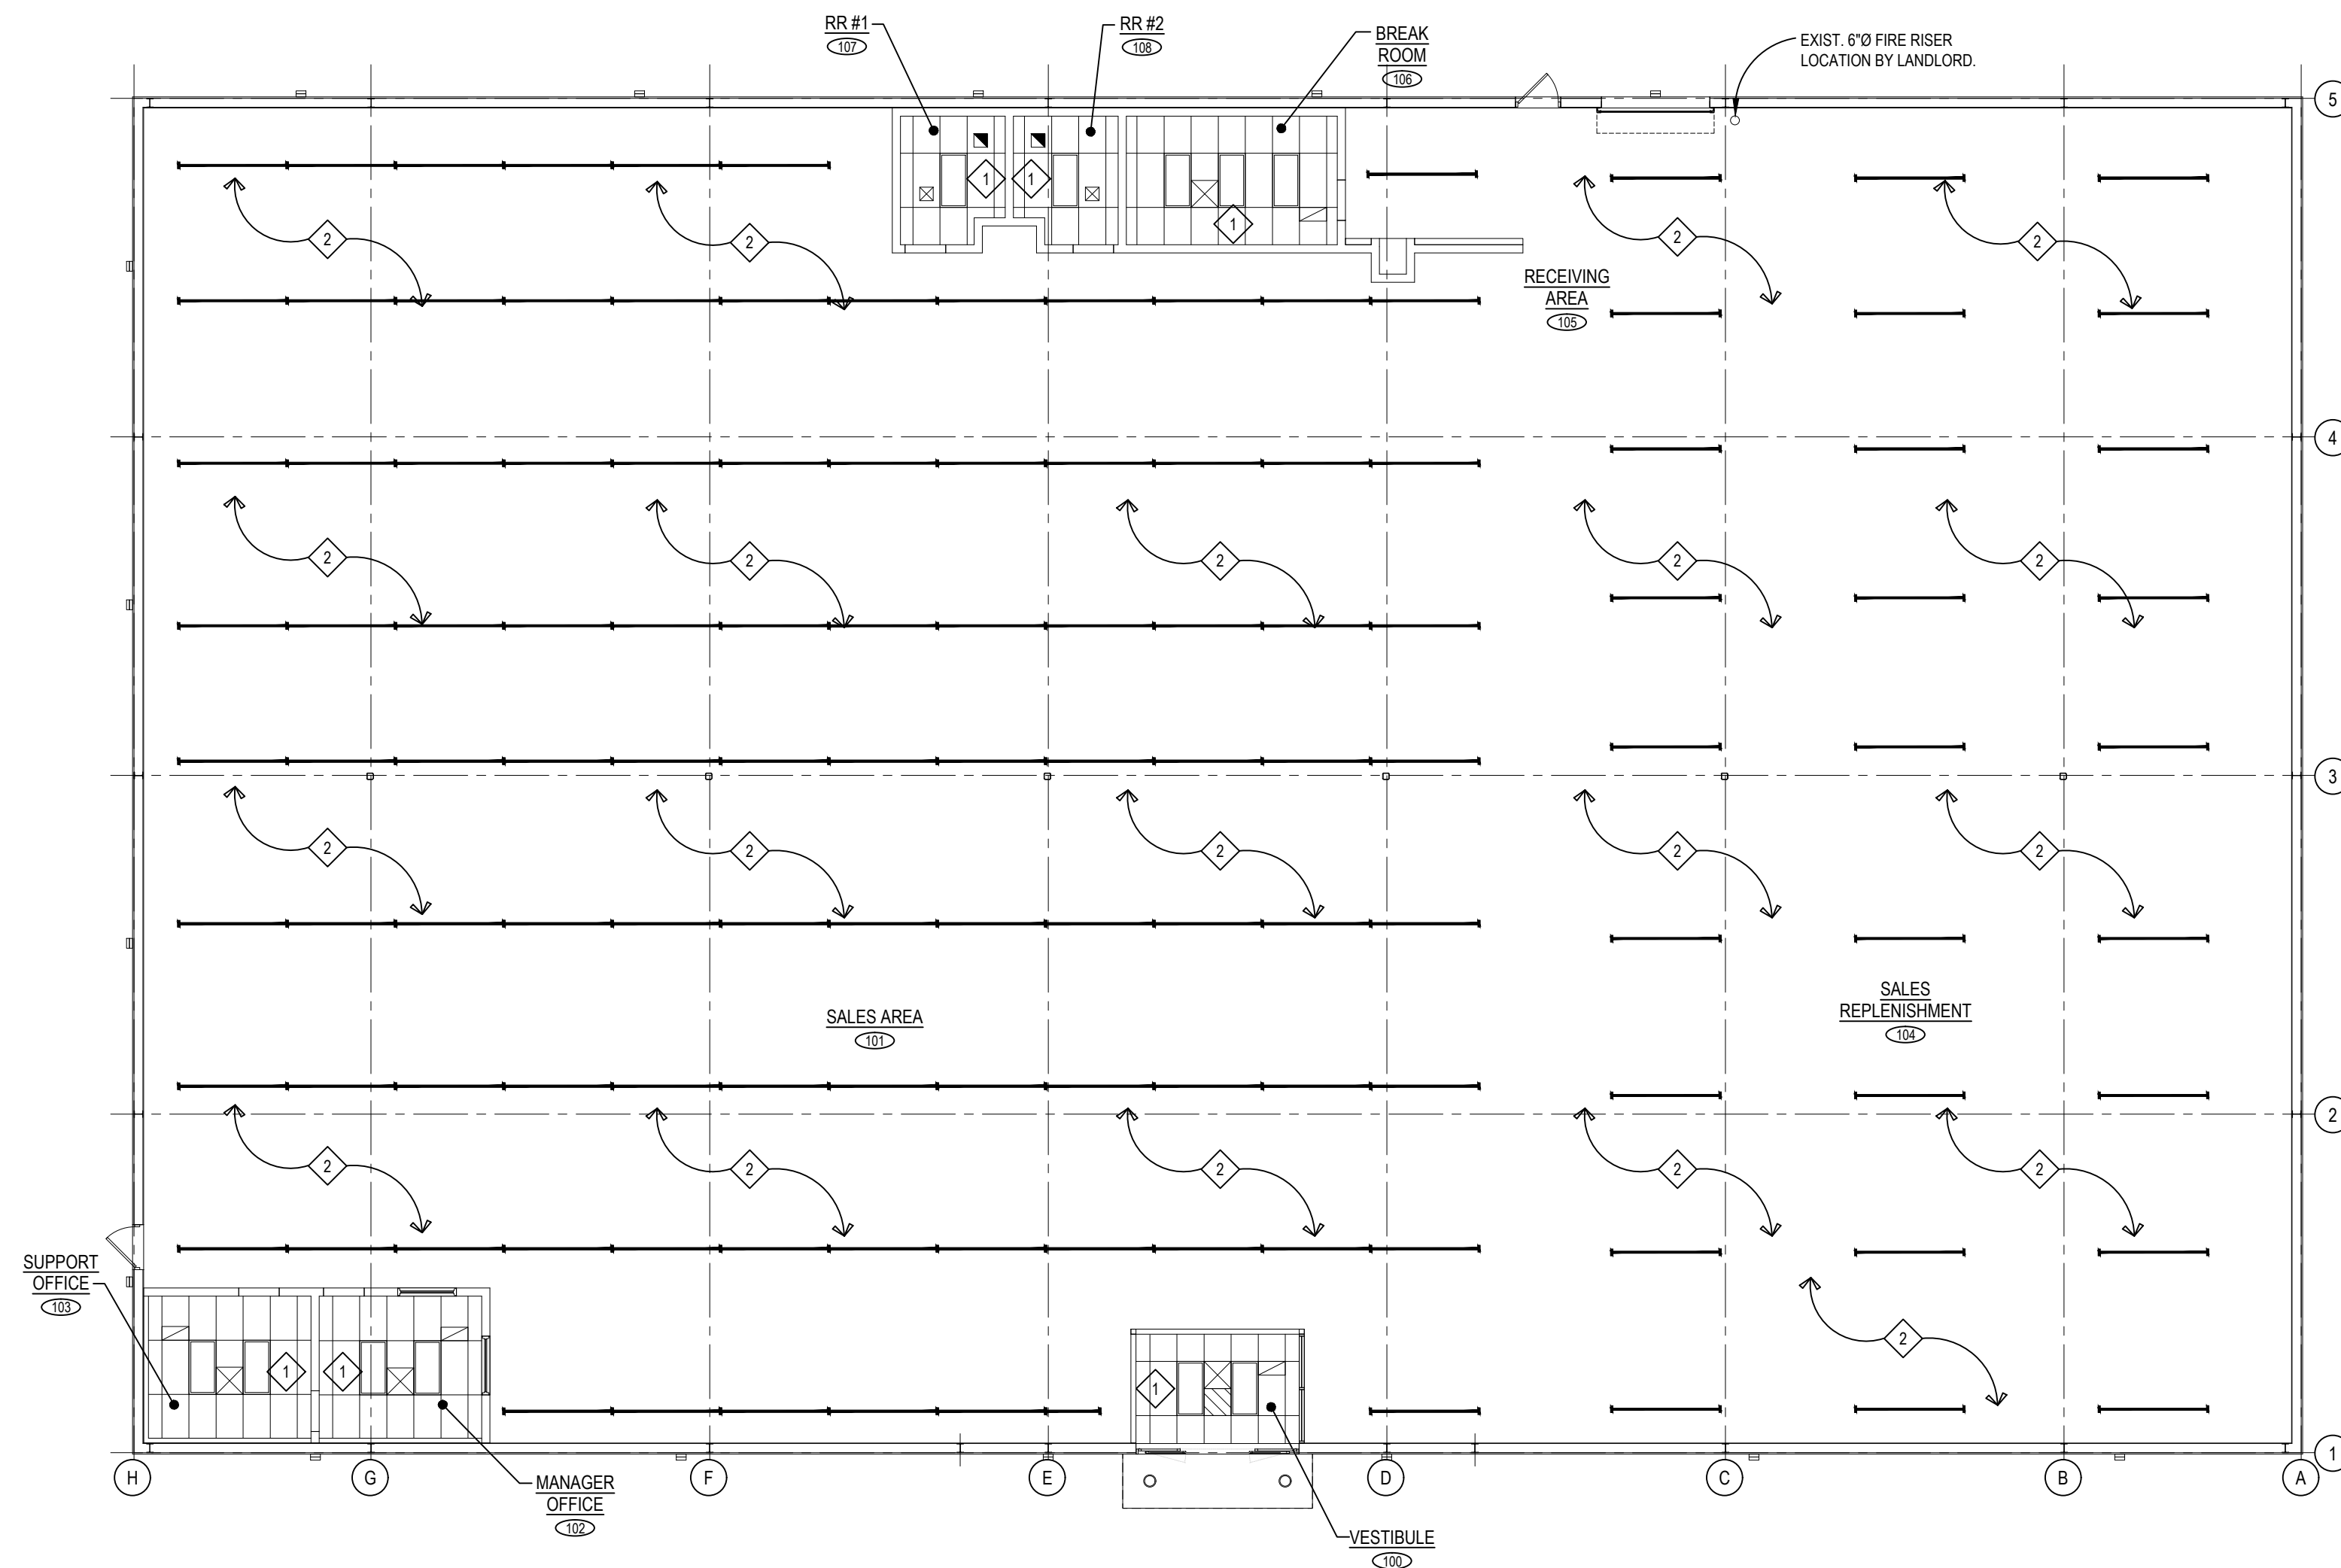

FIRE PROTECTION PLAN

SCALE: 3/32" = 1'-0"



ADA ARCHITECTS
17710 Detroit Avenue
Phone (216) 521-5134
www.adaarchitects.com

Lakewood, Ohio 44107
Fax (216) 521-4824

HARBOR FREIGHT

46 SHRJJI LANE
ERWIN, NC 28339

THESE DOCUMENTS CONTAIN INFORMATION PROPRIETARY TO ADA ARCHITECTS INC. UNAUTHORIZED USE OF THESE DOCUMENTS IS EXPRESSLY PROHIBITED UNLESS AGREED UPON IN WRITING.

REVISIONS

#	DATE	TYPE
1		
2		
3		
4		
5		
6		
7		
8		
9		

FIRE PROTECTION PLAN

DATE 05/17/24

JOB NO. 23475

FP1.0
SHEET NO.

ELECTRICAL SPECIFICATIONS

A. DESCRIPTION OF WORK

- 1. The electrical contractor shall provide all labor, material, equipment, and tools necessary for demolition and removal of existing and the complete installation of the new electrical work, ready to use, as shown on the drawings or specified herein. Work shall include, but not be limited to the following:
 - i. Furnish and install new conduit and wire.
 - ii. Furnish and install new fuses, circuit breakers, panelboards etc.
 - iii. Install new lighting fixtures as indicated.
 - iv. Furnish & install new light fixtures as indicated.
 - v. Furnish & install new communications devices.
- 2. The exact location of all items shown on the electrical drawings is dependent upon field conditions. Review the plans and specifications for all parts and consult with other trades of this project for pertinent data on sizes, locations, wiring, etc., as required for a complete electrical installation.
- 3. The electrical contractor shall not attach to, cover up, or finish against any defective work, or install in a manner which will prevent proper installation of the work of other trades.
- 4. The electrical contractor shall warrant all work & material indicated on these electrical drawings for a period of 1 year from the date of final acceptance. Warranty shall include any additional labor or material required to repair or replace defective item.

B. CODES, PERMITS AND FEES

- 1. All work included by the drawings and specifications, together with all material (or equipment) furnished, shall comply with the latest published codes and standards listed insofar as such shall apply. All electrical items shall be new and UL labeled & listed.
- 2. The contractor shall secure all permits and pay all fees that are required by the applicable local and state codes.
- 3. Perform all work in accordance with the latest edition of applicable codes including, but not necessarily limited to those listed below:
 - i. The National Electrical Code - sometimes referred to herein as the "NEC" - (NFPA-70)
 - ii. National Electrical Safety Code (ANSI-C2)
 - iii. All applicable state and local codes.
 - iv. Applicable provisions of the Occupational Safety and Health Act.

C. GENERAL REQUIREMENTS FOR SUBMITTING & BID

- 1. The drawings represent the design for the listed manufacturers' requirements. If any substitutions are accepted by the engineer, this contractor shall be responsible for all necessary modifications, including cost, to the electrical system required because of the substituted equipment or material.
- 2. The electrical, mechanical, architectural, structural, and all other drawings as well as the specifications and addendums are part of the contract documents. Any electrical requirements called for on other trades contract documents shall be included in the electrical bid.
- 3. Co-ordination & knowledge of local standards of utility companies is required to submit a bid. Any required deviation from the design by local utility shall be brought to the attention of the Architect or Engineer prior to submitting bid. No extra compensation will be awarded for adjustments to the design that are required by the local utility company.

- 4. The contractor shall visit the job site and become familiar with all existing conditions. Submission of a bid assumes the contractor has reviewed or accepts all field Conditions and existing conditions. No additional compensations shall be allowed for labor or material because of ignorance of these conditions before or after bid submission.
- 5. Discrepancies between the drawings or between the drawings and actual field conditions shall be brought to the attention of the architect and the engineer prior to submitting the bid. The more comprehensive and most expensive scope of work shall be considered for the electrical bid unless written clarification is provided by the architect and the engineer prior to submitting the bid.

D. RACEWAYS

- 1. EMT conduit shall be used in all interior locations which call for conduit unless noted otherwise. Conduits routed thru areas of significant temperature differences shall be provided with seal-off fittings to minimize condensation. Conduits penetrating fire walls shall be firestopped per NEC & Underwriters Laboratories.
- 2. Rigid PVC Schedule 40 shall be used for all underground or below slab conduit runs.
- 3. Heavy wall rigid steel conduit shall be used in exterior exposed applications. Provide 2 coats of rust inhibiting paint for exterior runs. Paint shall match surface conduct is attached to.
- 4. 'MC' cable may be used for all branch circuits located above ceilings or in wall cavities or exposed & attached to supports of suspended light fixtures as allowed by the National Electrical Code & the authority having jurisdiction. Cable shall be installed in a neat professional manner adhering to industry standards.
- 5. When power or control conductors are installed in a raceway, a green equipment grounding conductor shall be included in each raceway system and shall be sized on the drawings or if not noted on the drawings, then in accordance with Table 250-122 of the NEC, or as indicated on the drawings (if green insulation is not available, the grounding conductor shall be bare and clearly and permanently marked with all tap and terminating points by green "scotch" marking tape, code markers, or other approved means).
- 6. All conduit shall be securely fastened in full accordance and as directed by the latest edition of the National Electrical Code. In addition to the NEC requirements, conduit hangers, supports, or fastenings shall be provided at each elbow and at the end (within 6") of each straight run terminating at a box or cabinet.
- 7. Conduits or boxes may not be supported by ceiling support wires or other ceiling supporting hardware.
- 8. Horizontal and vertical conduit runs may be supported by one-hole malleable straps, clamp blocks, or other approved devices with suitable bolts, expansion shields (where needed) or beam type clamps for mounting to building structure or special brackets.
- 9. The use of perforated iron for supporting conduits will not be permitted.
- 10. Conduit runs between outlets shall contain not more than the equivalent of three (3) quarter bends. Provide junction and/or pull boxes where shown on the drawings or as required, whether shown on the drawings or not. Pull boxes shall be approved for use in the area where they are to be installed. Pull boxes or junction boxes shall be provided in accordance with the following schedule:
 - i. Straight runs - not over one hundred (100) feet apart.
 - ii. One (1) 90 degree bend - not over seventy five (75) feet apart.
 - iii. Two (2) or more 90 degree bends - not over fifty (50) feet apart.

- 11. In Class I and Class II hazard areas, as designated on the drawings, explosion-proof flexible metal conduit shall be used for all final conduit terminations at motors and to all other devices subject to vibration or movement. This shall include all pendant mounted lighting fixtures and conduit runs at building expansion joints in Class I and Class II hazard areas. Electrical ground continuity shall be provided as noted above.
- 12. Telephone and data (including other special communication systems such as cable TV) conduits shall be a minimum of 3/4" in size unless noted otherwise, and shall run continuous from outlet to outlet and back to the main terminal board, or shall be stubbed into the ceiling space (6" above the ceiling) and provided with a plastic bushing. Bond conduit stub with a #10 bare copper conductor to the nearest electrical outlet box or continuous metal conduit body. Refer to plans for specific details about the routing of the conduits. All empty conduits shall be provided with a #10 pull wire.
- 13. Cables installed in plenums without conduit shall be UL classified for low flame resistance and low smoke properties with "FEP" Teflon or Halar insulation suitable for plenum applications per Article 760 of the N.E.C.
- 14. Conduits below grade shall be installed in conformance with:
 - i. Provide all necessary trenching, backfill & removal of trenched material from site.
 - ii. The bottom of the trench shall be undisturbed earth or thoroughly compacted fill. The contractor shall be responsible for such compaction. The bottom shall be free of projecting rocks or other foreign matter. Where muck or unstable ground is encountered in the bottom of the trench, it shall be excavated to a depth of at least 12in. below the bottom line of the ducts and replaced with pea gravel in the proper grade. Duct shall not be installed on or in a frozen ground, sheathing or bracing shall be provided where necessary to protect the work or adjacent property. Sheeting, bracing, and pea gravel shall be installed by the electrical contractor at no additional expense to the owner. Backfill shall consist of 3 inches of compacted sand below conduits and 12" above conduits. Clean screened fill shall be installed and compacted to 6" below final grade or as detailed in architectural specifications. Final grade patch shall be by E.C.
 - iii. Duct joints shall be sealed with waterproof joint compound. Ducts shall be supported at least 3in. above the trench bottom on plastic supports with spacing not exceed 5'. Before duct is placed, supports shall be aligned, set to grade, and placed in concrete to prevent movement when encasement is placed. Ducts shall be secured to supports and spacers placed for later ducts.
 - iv. All secondary power service underground ducts shall be encased with 3000 psi concrete. All underground ducts shall be 4" in diameter schedule 40 rigid non-metallic (P.V.C.) ducts with ground wires, unless specifically indicated otherwise on the drawings; concrete encasement shall be in accordance with the applicable provisions of the general trades portion of the specifications.
 - v. Encasement shall be continuous monolithic pour providing a minimum of 3" completely around the ducts. Concrete shall not be poured directly on top of the ducts, but shall be poured from the sides and allowed to flow over the ducts.
 - vi. Bell ends shall be installed at all duct terminations or as required by the power company. Fittings, couplings and other accessories, as recommended by the manufacturer, shall be provided and installed.
 - vii. Ducts shall be cleaned by rodding and brushing. It shall be the contractor's responsibility to assure a full bore opening throughout the duct system.

E. FITTINGS FOR CONDUIT

- 1. Couplings and connectors for EMT: Die cast zinc, steel, or aluminum compression type. Set screw type will also be permitted. Approved manufacturers, Thomas & Betts, Steel City, O-Z Gedney.
- 2. Fittings for rigid plastic conduit: Polyvinyl chloride, joints solvent welded in field, providing continuity of mechanical strength and water tightness. Fittings and cement shall be produced by the same manufacturer as the conduit.
- 3. Fittings for rigid conduit: Cast or malleable iron bodies, zinc or cadmium plated, with full threaded hubs, screw covers and gaskets when located in areas requiring gaskets. Approved manufacturers: Crouse-Hinds, Pyle National, Appleton.

- 4. Couplings and connectors for flexible steel conduit: Malleable iron or steel, zinc or cadmium plated, and shall fasten to the conduit by a clamping action around the periphery. Connectors for "liquid-tight" flexible conduit shall be approved for the purpose and maintain the liquid-tight feature of the installation. Approved manufacturers: Thomas & Betts, Steel City, O-Z Gedney.
- 5. Bushings: Grounding type, with insulating plastic insert, malleable iron, zinc or cadmium plated, for steel conduit and aluminum alloy for aluminum conduit. Install grounding type bushings as required in the grounding section of this specification.
- 6. Fittings for conduits: All conduit runs at building expansion joints shall be provided with O-Z type expansion fittings. Sizes shall be as dictated by the conduit size. A bonding jumper shall be securely connected to each conduit. Exterior exposed runs of PVC conduit shall be provided with expansion fittings at intervals not exceeding manufacturers recommendations.
- 7. Outlet, Pull, Terminal and Junction Boxes in Classified (Hazardous) Areas: Cast boxes shall be copper-free aluminum with integral hubs or box wall thickness sufficient for a minimum of five full lap threaded threads. Covers shall be screw-on bolt-on through 1/2" x 1/2" boxes and hinged removable bolt-on covers for larger boxes. Boxes other than outlet boxes shall be equipped with a breather drain and equipment grounding lug and all boxes shall be, as applicable, for installation in the particular classified (hazardous) areas which are designated on the drawings. Approved Manufacturers: Crouse-Hinds, Pyle-National, Appleton, Adialet, O-Z Gedney, or Killark.
- 8. Conduit Fittings in Classified (Hazardous) Areas: Conduit seals and/or drain seals shall be installed in strict accordance with the NEC in classified (Hazardous) areas designated on the drawings, with special attention to the following:
 - i. Entering or cross-connecting enclosures containing arcing or high temperature devices.
 - ii. Two-inch conduit and larger entering any enclosure.
 - iii. Passing from Division 1 to Division 2, from Division 2 to non-classified areas, with or without a barrier.
 - iv. Multi-conductor and shielded cables.

F. ELECTRICAL SUPPORTING DEVICES

- 1. Supports shall be suitable for the device or equipment to be mounted. All supports shall present a neat appearance, and shall be installed in such a way that they do not detract from the appearance of the space. Supports shall have adequate strength and shall be installed so as to properly support the device or equipment mounted on them.
- 2. Electrical supports shall be attached to the structure by one of the following methods:
 - i. Wood - wood screws.
 - ii. Concrete - expansion bolts or cast in place anchors.
 - iii. Structural steel - approved brackets or machine bolts.

G. CONDUCTORS

- 1. Conductors shall be new, 600 volt, 90c, type XHHW, THHN or THWN insulation, stranded copper for feeders rated above 60 amps. Compact aluminum may be used for feeders of 150amps or higher. Minimum size shall be #12 AWG for runs of less than 100 feet total circuit length (out and back for single phase circuits and out only for three phase circuits with no neutral). Use #10 AWG for circuits longer than 100 feet. Other sizes shall be as noted. Control wiring may be #14 AWG. All 120 volt and 277 volt circuits shall have a dedicated neutral conductor. The neutral conductor shall be the same size as the phase conductor. All conductors shall be copper. The conductor sizes for feeders and branch circuits are designed to maintain a voltage drop of less than 5 percent, (2 percent for feeders and 3 percent for branch circuits)
- 2. Compression type lugs and connectors shall be used for all terminations and splices. All terminations shall be permanently identified and numbered, using "Brady" labels or other approved equivalent. Wire numbering shall be panelboard and circuit numbers. Also, all wiring which passes through junction or pull boxes shall be identified with appropriate numbers. When panelboard/circuit numbers are not appropriate for identification, the contractor shall assign a unique number and record this number on the construction set.

H. WIRING DEVICES

- 1. Provide wiring devices which are UL listed and which comply with NEMA WD 1 and all other applicable UL and NEMA standards. Device Color shall be white unless otherwise noted. Coverplate color shall match device color. Confirm color selection with architect before purchasing and installing.
- 2. Receptacles: Devices shall be specification grade, NEMA 5-20R configuration, Duplex type, Hubbell Cat No. CS1221, single outlet type, Hubbell Cat No. CR5361, GFCI duplex, Hubbell Cat No. CR GF5362. Catalog numbers for Hubbell are shown for reference purposes and equivalent receptacles by other manufacturers are noted above as also approved. Receptacles shall comply with UL 498 and NEMA WD 1. Special receptacles not shown below shall be specification grade with Nema configuration as noted on the drawings.
- 3. Ground-fault interrupter (GFI or GFCI) receptacles as indicated above shall be designed for and installed in a 2-3/4 inch deep outlet box without adaption, grounding type, Class A, Group 1, per UL Standard 94.3.
- 4. Snap switches: Devices shall be specification grade quiet type, 20 A 120/277V, single pole Hubbell Cat No. CS1221, two pole Hubbell Cat No. CS1222, three pole, Hubbell Cat No. CS1223, two pole pole, Hubbell Cat No. CS1224. Catalog numbers for Hubbell are shown for reference purposes and equivalent receptacles by other manufacturers as noted above as also approved. Devices shall be specification grade, quiet type ac switches, and shall comply with UL 20 and NEMA WD1.
- 5. Approved manufacturers for wiring devices: Hubbell, P & S.
- 6. Dimmer switches: solid state dimmer switches conforming to NEMA WD 1, mounted in outlet boxes. For incandescent fixtures, switch poles and wattage as indicated, 120 V, 60-Hz; continuously adjustable toggle, single-pole, with on-off switch. Equip with electromagnetism type to eliminate noise, RF and TV interference. Dimmers to be Lutron "Nova T-Star" series for dimmers rated up to 1500 watts and "Nova" series for 2000 watt dimmers. Lighting switches shown adjacent to wiring devices shall be Lutron "Nova T-Star" or standard "Nova" style to match dimmers and shall be provided with a single, one piece coverplate. Color shall be specified by architect.

7. Wiring device accessories

- i. Wall plates: Single and combination, of types, sizes, and with ganging and cutouts as indicated. Provide plates and attachment screws which mate and match with wiring devices to which attached. Provide wall plates with engraved legend where indicated. Provide smooth nylon coverplates for finished areas, and galvanized steel plate for unfinished areas.
- ii. Floor service outlets: Modular, above-floor service outlets and fittings of types and ratings indicated. Construct of die cast aluminum, satin finish. Use design compatible with floor outlet wiring methods indicated. Provide 20 Amperes, 125 Volts, gung duplex receptacles. NEMA configuration 5-20R where indicated. Provide with 3/4 inch or 1 inch NPT, 1 inch long, locking nipple for installation where compatible with wiring method.

8. Wiring device installation:

- i. Install switches and receptacles in outlet boxes as specified elsewhere in this specification. Install single pole toggle switches so that the switch is on in the "up" position. Install receptacles with the U-shaped ground slot at the top or to the left.
- ii. Duplex receptacles shall be wired with the neutral wire to the silver binding screw.
- iii. Three phase receptacles shall be wired such that all have the same phase sequence.
- iv. The receptacle circuit and panel number shall be indicated on the inside of all outlet boxes, or directly on the conductors by means of a wire labeling system.
- v. Combination switch/receptacle shall be installed in a two gang box with a combination switch/receptacle coverplate. Connect the receptacle to the lighting circuit ahead of the switch and locate the switch on the side of the box closest to the door. Note, this method is to be used only for 120 Volt lighting system. 277 Volt lighting switches and 120 Volt receptacles shall be located in separate boxes.
- vi. Confirm final location of all wiring devices and outlet boxes with owner/architect prior to rough-in.

- 9. Wiring devices listed or noted on the drawings as weatherproof shall be provided with a cover which maintains the weatherproof integrity when the cover is closed. Receptacles noted as suitable for operation in wet locations shall be provided with a cover which will allow the receptacle to remain operational during wet conditions with a plug inserted into the receptacle.

I. LIGHTING

- 1. Lighting Fixtures: see drawings for manufacturers catalog numbers.
- 2. Indoor Installation:
 - i. The Contractor shall refer to the Architectural drawings for ceiling type, construction and details of mounting. Adjust fixture trim ring as required for correct mounting in ceiling fixture to be installed. All fixtures shall be supported per NEC Article 410.
 - ii. Suspended ceiling systems shall be supported for fixture installation as noted above, and as a minimum condition, as noted in ANSIASTM C636-76, par. 2-7, CEILING FIXTURES.
 - iii. Install fixtures in accordance with the Architectural Reflected Ceiling Plans. Where substantial differences may occur between the Reflected Ceiling Plans and the Electrical Plans, inform the Architect/Engineer for resolution of the discrepancy.
 - iv. The Contractor shall coordinate fixture construction details with ceiling system in which they are installed, i.e., support system dimensions, fanges where required, acoustical tile or pan pattern, etc.
 - v. Rows of fixtures shall be installed accurately as to line and level. Fixtures shall be securely mounted so that they will not be distorted by handling incidental to normal maintenance.
 - vi. Surface type fluorescent lighting fixtures mounted on acoustical ceiling must be coordinated with the Architectural drawings in order that a main "T" runner will be placed in the center of each fixture and/or each row of fixtures. Main "T" runner shall be of at least the same length as the lighting fixture and shall be supported to carry at least twice the weight of the lighting fixture.
 - vii. All fixtures shall be securely supported with approved hangers. Where fixtures will be installed in suspended ceilings, any Code-required additional ceiling supports as approved by the Architect, shall be provided by this Contractor.
 - viii. Provide supports for all lighting fixtures as detailed on the Drawings, as specified, or as required by the fixture specified. Fixtures installed in unfinished areas (areas including but not necessarily limited to warehouses, factory areas, manufacturing areas, office spaces without lay-in ceilings, and spaces above lay-in ceilings) shall not be fastened directly to the structure. In these cases, unistrut type channel along with the appropriate fasteners and clips shall be used to support the fixtures.
 - ix. Fixtures shall not hang directly from conduit boxes unless the boxes have been specifically designed for such purposes. These boxes shall be supported independent of the conduit system and shall not rely upon the conduit for support.

- x. Lay-in troffers in suspended ceilings and surface type fixtures mounted to suspended ceilings shall be secured mechanically by screws, rivets, clips, etc. as per Article 410, NEC. Additionally, lay-in fixtures shall also be supported by two independent support wires running from diagonally opposite corners of the future to the overhead structure. Surface mount fixtures shall be additionally supported by means of at least two clips for each fixture which surround the T-bar and are tied to the overhead structure with a separate wire. The surface fixtures shall be secured to these clips.
- xi. Plaster frames shall be furnished for each recessed fixture installed in plaster ceilings and walls.
- xii. Pendant mounted fixtures shall utilize pipe stems to mount fixtures at elevations as noted on the drawings. Chains or cords will not be accepted. Wherever the mounting surface slopes, fixtures shall be provided with universal type fixture hangers to allow the fixture to hang plumb.
- xiii. Fixtures shall be installed with due regard for beams, piping, ductwork, and other mechanical or plumbing equipment.
- xiv. Branch circuit conductors shall be run in fluorescent fixture wiring channels only as permitted by the N.E.C. The Contractor shall be responsible for providing all necessary boxes and conduit for an approved installation.
- xv. Where a modular wiring system is installed, all ceiling mounted recessed fluorescent lighting fixtures shall be furnished with suitable receptacles to match the modular wiring system furnished and installed by this Contractor. Each fixture shall be equipped to permit either single or multiple fixture circuit wiring as is appropriate for the fixture type.
- xvi. When fixtures are installed in a fire proof ceiling, the fixture shall be U. L. listed to maintain the fire proof rating or the fixture shall be fire proofed by the electrical contractor using a U. L. accepted standard; see architectural drawings for ceiling ratings.
- xvii. At the time of final inspection all fixtures and equipment shall be complete with all required glassware and/or reflectors, clean and free of defects. Any glass-ware or reflectors, etc., which have defects shall be replaced at the Contractor's expense before final acceptance.
- xviii. All lamps shall be in working order at the time of final acceptance of the work by the Owner and Architect/Engineer. This Contractor shall replace all defective lamps with new lamps until the work is finally accepted.
- xix. Low voltage lighting transformers should be protected by fuses. Fuse sizes shall be as recommended by the transformer manufacturer. Busman type HR5 or Littlefuse 155020, fuse holders are recommended.
- xx. Solid state transformers for low voltage lighting shall not be used for dimming applications unless the transformer and dimmer are a U. L. listed assembly specifically intended for the application.

3. Outdoor and Site Lighting Installation:

- i. Site lighting luminaires shall be as called for on the drawings.
- ii. Bases for site and roadway luminaires where required, shall be augered into the earth and concrete shall be poured into the augered hole without a soria tube below grade to allow the concrete to fill the natural crevices in the earth. Portion of base above grade shall be formed using a sonatube. Exposed portion of finished base shall be smoothed, and voids filled with grout.
- iii. Bases shall have reinforcing steel as indicated on the contract drawings and shall be Class 'A' concrete. iv. Anchor bolts for poles shall be performed for the pole bolt circle at the factory.

J. Panelboards

- 1. Panelboards for 480/277, 208/120, or 240/120 panels shall be dead front type, conforming to NEMA standard PB-1-1-71 and UL 67, and consisting of three phase, three or four wire solid neutral, main lugs or main overcurrent device as indicated, branch overcurrent devices as noted and equipment ground bar, all in a surface or flush mounted code gauge galvanized sheet steel cabinet as indicated. Enclosure to be NEMA 1 unless noted otherwise with primer and finish paint of the manufacturers standard. All busing shall be copper.

- i. Standard enclosure shall be NEMA 1, unless noted otherwise, with primer and finish paint of the manufacturers standard. Cabinets shall be oversized where necessary to accommodate the entrance of several large conduits and/or when necessary to avoid overcrowding except cabinets for panels mounted flush shall be not more than 22 inches wide and 5-3/4 inches deep unless otherwise approved by the architect/engineer. All panels (branch & distribution style) within HFT space shall have trim that contain hinged doors and shall be equipped with flush chrome plated combination key locks and catches. Locks shall be all keyed alike and two keys furnished to the owner.

- ii. Column-type enclosures shall be similar to the standard enclosure except panel shall be approximately 8-1/2 inches wide for mounting between building column webs as indicated, and provided with extension trough and pulldown with neutral bar when shown on the drawings.

- iii. Where spaces are noted on the drawing, equip the panelboard with bus and all necessary hardware for future circuit breaker installation.
- iv. Metal frame and plastic covered typewritten card shall be mounted inside each panel door. Information entered onto the cards shall correspond to the circuit numbers as installed in the field.

2. Overcurrent Protective Devices

- i. General use circuit breakers for panelboards shall be bolt-on molded plastic case type, 1, 2, or 3 pole, quick-make, quick-break, with trip-free operating handle, position indicating and thermal-magnetic trip device. Furnish 2 and 3 pole breakers with common operating handle and common trip mechanism. All circuit breakers used for switching applications shall be listed type "SNYD" for that application, all circuit breakers used for protection of motors, refrigeration equipment, or HVAC equipment shall be U.L. listed type "HACR" for that application.
- ii. Circuit breakers furnished with panelboards shall conform to the following interrupting ratings (symmetrical) in amperes unless otherwise noted:

Voltage Rating	Trip Rating	No. of Poles	I.e. Amperes (Symmetrical)	Frame Size	100 amp	225 amp	400 amp	1000 amp
120	15-100	ampere	1	22,000	100 amp			
240	15-100	ampere	2&3	22,000	100 amp			
240	125-225	ampere	2&3	22,000	225 amp			
240	250-400	ampere	2&3	42,000	400 amp			
277	15-100	ampere	1	25,000	100 amp			
480	15-100	ampere	2&3	25,000	100 amp			
480	125-225	ampere	2&3	30,000	225 amp			
480	250-400	ampere	2&3	42,000	400 amp			
480	400-800	ampere	2&3	42,000	800 amp			
- iii. Ground fault circuit interrupters shall be similar to general use circuit breakers specified; 15-20 ampere, 1 or 2 pole with 5ma sensitivity. Furnish when indicated on drawing.
- iv. Fuses over 600 ampere shall be Busman Hi-cap time delay KRP-C, or Gould Shawmut A4BQ (601-2000 ampere) or Gould Shawmut A4BY (2001-6000 ampere) 600 volt, UL Class I with minimum interrupting rating of 200,000 ampere rms symmetrical.
- v. Fuses 600 ampere or below shall be Busman low-volt dual element type LPM-RK (250 volt) or LPS-RK (600 volt) or Gould Shawmut Amp-trap type AKK (250 volt) or A6K (600 volt) UL Class RK1 with minimum interrupting rating of 200,000 ampere rms symmetrical.
- vi. Provide spare circuit breakers installed in panelboards as indicated on the panel schedule as shown on the drawings. Provide 10% spare (minimum of 3) of each type and rating of fuses installed.

3. Safety Switches

- i. Provide fusible or non-fusible safety switches as indicated on the drawings. Switches shall be quick-make, quick-break, heavy duty visible blade type, horsepower and 1 squared T rated. Use NEMA 12 enclosures in factory areas, NEMA 1 enclosures in other indoor areas and NEMA 4X stainless steel type enclosures outside unless otherwise indicated on the drawings. Furnish three pole, single-throw switches unless otherwise indicated, with current and voltage ratings as indicated.
- ii. Provide safety switches with an external operating handle interlocked with the cover door to prevent the door from being opened while the switch is in the "on" position except by operating an inconspicuous interlock defeating mechanism. Provide means for padlocking the operating handle in the "off" position. Equip switches with auxiliary contacts when indicated.
- iii. Fuse clips shall be rejection type for fuses specified (up to 600 ampere). Fuses clips for 601 ampere to 6000 ampere shall be suitable for UL Class I fuses.

4. Transformers

- i. Transformers shall be indoor dry, two winding, quiet type, with ventilated enclosure, conforming to NEMA standards, 220 degrees celcius insulation for continuous operation in a 40 degree celcius ambient temperature with a temperature rise not to exceed 90 degrees celcius. Provide a minimum of two 2-1/2% FCMB and four 2-1/2% FCMB taps in the primary winding for transformers over 25 KVA and a minimum of two 2-1/2% FCMB taps for transformers 25 KVA and below. Transformers 25 KVA through 75 KVA shall be designed for floor or wall mounting.
- ii. Sound levels shall not exceed those established in ANSI standard C89 shown in the following table:

KVA	dB level
0-150	42
- iii. Furnish transformers having voltage, KVA ratings and connections as indicated on the drawings.

5. Panelboard and Transformer Installation

- i. Mount panelboards at uniform height throughout the building, and such that the top switch is not more than 79 inches above floor when measured to the center of the switch handle.
- ii. Install handle guards on all breakers for night lighting, emergency, and similar circuits when indicated.
- iii. Each panelboard shall be identified with a legend plate of lamicooid plastic inside the door for panelboards in finished areas and on the outside of panelboards in unfinished areas with the panel designation as shown on the drawings.
- iv. Install not less than two spare 1-1/4 inch conduits from each flush mounted panel to an accessible area above the ceiling.
- v. When branch circuits are not scheduled on the drawing, they shall be arranged to balance the phase loads on each panelboard and the loads shall be equally distributed on each of the phases of the panelboard.

- vi. Mount panelboard, safety switches, and similar equipment securely to walls or steel supports. Equipment mounted on the building perimeter foundation walls shall be shimmed at least 1/4 inch from the wall to permit back ventilation.
- vii. Provide supports for truss mounted and wall mounted transformers. All transformers which are mounted above panelboards shall be mounted away from the wall an amount equal to the depth of the panelboard. The width of the panelboard shall also be maintained clear behind the transformer.
- viii. Approved Manufacturers for Power Distribution Equipment:

General Electric Company	Siemens
Cutler Hammer/Westinghouse	Cleveland Switchboard Co.
Square D	

K. RACEWAY AND GENERAL GROUNDING

- 1. The entire power, lighting system as well as building structure, mechanical & plumbing systems, fences & similar metal objects shall be permanently and effectively grounded in accordance with the minimum requirements of the National Electrical Code, or as specified herein, whichever is the more stringent.
- 2. Ground conductors shall be stranded, annealed copper with green insulation (insulation material as specified for general building use).
- 3. The entire power and lighting system shall be permanently and effectively grounded including panels, starter enclosures, motor frames, and other exposed, non-current carrying parts of the electrical equipment. The equipment ground conductor shall be separate from the neutral conductor and shall not be used as a load current carrying conductor.
- 4. Any item covered by the preceding paragraph which is within six feet of grounded metal and not directly interconnected with the grounded metal shall have a flexible bare copper cable connection not smaller than #6 AWG to the grounding system.
- 5. Where building type conductors are installed in a raceway, a green equipment grounding conductor shall be included in each raceway system.
- 6. Lighting fixtures permanently connected to the conduit system shall be grounded by means of a grounding conductor run inside the conduit. Fixtures mounted on trolleys or portable lighting units shall be grounded by means of a grounding conductor in the portable box.
- 7. Convenience outlets shall be self-grounding type or shall have a green grounding conductor installed from the ground lug on the outlet to the outlet box.
- 8. Motors shall be connected to the equipment ground conductor with a conduit grounding bushing and with a bolted solderless lug connection on the metal frame.
- 9. The armor of interlocked armor cable, wiring channels, cable trays, and all metallic conduit including rigid, EMT, and flexible conduit shall be connected at each end to the equipment ground conductor utilizing a conduit grounding bushing. Junction boxes and other enclosures (sizes above 6" x 5") shall utilize an equipment ground lug to securely bond the equipment grounding conductor to the enclosure.
- 10. Where any grounding conductor requires physical protection to maintain grounding integrity, it shall be run through a non-ferrous conduit or bonded to a continuous steel conduit at both ends.
- 11. The grounding electrode system shall consist of 3/2" diameter x 10' copper clad ground rods. Exterior ground rods shall be driven to 12" below finished grade & be provided with a 12" diameter x 30" long rigid pvc pipe w/ screw cover for inspection purposed. center ground rod in pipe & install pipe flush with grade. pvc pipe and cover shall be traffic rated. Interior ground rods shall be driven to 6" above grade & installed as close to a wall as possible, all connections to ground rods shall be cadweld type.

L. EXECUTION

- 1. The contractor shall exercise due caution when working so as not to damage that portion of the electrical system that is to remain.
- 2. Positively no conduit or wire removed shall be reused in the new installation.
- 3. All circuits shall be identified on the panel directories by this contractor. At the completion of the job, the contractor shall be responsible for the removal of all conduits, junction boxes and other enclosures (sizes above 6" x 5") shall utilize an equipment ground lug and the new loads as installed.
- 4. The contractor shall keep on the job, one complete set of working drawings on which he shall record any deviations or changes from such contract drawings made during construction. Record drawings shall show changes in the following:
 - i. Size, type, capacity, etc. of any material, device or piece of equipment.
 - ii. Location of any device or piece of equipment.
 - iii. Location of any outlet or source in the building service system.
 - iv. Routing of any conduit, or other building electrical service.

- These drawings shall be kept clean and undamaged, and shall not be used for any other purpose than recording deviations from working drawings and exact locations of concealed work. After the job is completed, this set of drawings shall be delivered to the owner in good condition, as a permanent record of the installation as actually constructed.

M. CUTTING AND REPAIRING

- 1. All necessary cutting in walls, floors and other such work shall be neatly and carefully done and the work shall be repaired in an approved and workmanlike manner. No cutting into the structural parts of the building, which may impair its strength, shall be performed without the prior written approval of the owner. If such cutting is permitted, the area shall be suitably reinforced to restore the structural integrity of the work to its designed value.
- 2. The electrical contractor shall be responsible for all damage to work of his, or other trades, caused by this work or through the neglect of his workmen. All patching and repairing of damaged work shall be done by the trade which originally installed it, at the direction of the owner's representative, and the cost of such repair shall be paid by the electrical contractor.
- 3. Absolutely no cutting of wall, floor or other finished material or fastening of electrical components to the exposed surfaces of finished areas will be permitted.

N. TESTING

- 1. The testing work shall include all labor, materials, tools, and equipment to perform and record all necessary tests and adjustments of equipment, including Load Center Unit Substations, Motor Control Centers, High Voltage Cable, 600 Volt Wire and Cable, and Grounding, as indicated on the drawings, specified herein, or where necessary to verify performance requirements.
- 2. Inspection tests shall provide a visual inspection of electrical equipment for manufacturing, shipping or installation defects.
- 3. Acceptance tests shall show that the methods and materials used in the installation of equipment conform to applicable codes and standards, and the manufacturers installation instructions, and to determine that the equipment involved may be energized for operational tests.
- 4. Operational tests shall show the electrical equipment will perform the functions for which it was designed.
- 5. The services of a recognized independent testing laboratory shall be engaged to conduct all tests described herein with the exception of routine insulation resistance, continuity and rotation tests.
- 6. Perform all acceptance and operational tests in the presence of the Architect/Engineer. Notify the Architect/Engineer of time of test at least two (2) days prior to testing. Notify manufacturers of electrical equipment to permit their representatives to witness the test should they so request.
- 7. Submit test reports, including complete data and actual readings taken, for all equipment tested to the Architect/Engineer for approval after each test performed. Do not energize any equipment for acceptance tests until data has been approved. Include copies of the final approved test reports upon completion of the work as part of the required operating and maintenance data to be furnished as specified in Division 1.
- 8. Give each power feeder and subfeeder cable (600 Volt Wire and Cable) a continuity and megger test. Isolate power cables to be megger tested by opening switches at each end of cable prior to testing. Apply megger tests, using a 1000 volt megger, between each conductor and ground with the other two conductors in the conduit grounded to the same ground. Minimum acceptable readings for disconnected cables shall be 1 (one) megohm. Cable must pass megger test to be reported as acceptable.
- 9. The following test and inspections shall be made on the grounding system.
 - i. Inspect ground conductors and connections for compliance with plans and specifications and for satisfactory workmanship. After installation of the grounding electrodes, provide ground resistance testing prior to the interconnection of other grounding systems. Do not perform tests under unusually wet weather; tests should be performed during normal weather conditions.
 - ii. Reports shall include all resistance readings obtained, temperature, humidity and condition of the soil at the time of the tests.
- 10. Operational tests shall be performed on all electrical systems, and shall include, but not be limited to, building lighting system, panelboards, motor starters and control devices, alarm circuits and light lighting equipment.


O. GUARANTEE

- 1. Material, equipment and installation shall be guaranteed for a period of one year from the date of acceptance. Defects which appear during that time period shall be corrected by this contractor at his expense.

Brian M. Schuler, P.E.

165 Williamsburg Drive
Avon Lake, Ohio 44012
Phone: 216-244-4120

BRIAN M. SCHULER
05-17-24

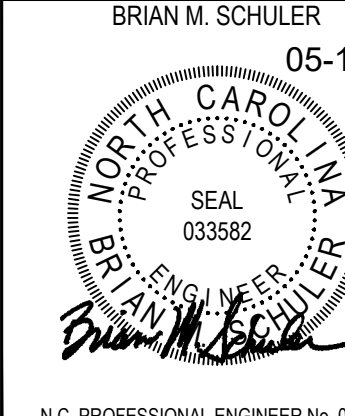

N.C. PROFESSIONAL ENGINEER No. 033582

ADOA ARCHITECTS
17710 Detroit Avenue
Phone (216) 521-5134
Fax (216) 521-1484
www.adaarchitects.com

ERWIN, NC 28839

46 SHRIJU LANE

THESE DOCUMENTS CONTAIN INFORMATION PROPRIETARY TO ADA ARCHITECTS, INC.
UNAUTHORIZED USE OF THESE DOCUMENTS IS EXPRESSLY PROHIBITED UNLESS AGREED UPON IN WR

MECHANICAL EQUIPMENT SCHEDULE								
MARK	DESCRIPTION	LOAD	VOLTAGE & PHASE	PANEL	CIRCUIT	C.B.	WIRE	NOTES
RTU-1	ROOF TOP UNIT	61 MCA	208V-3PH	M	1.3.5	803	4-3	1.3
RTU-2	ROOF TOP UNIT	52 MCA	208V-3PH	M	2.4.6	603	6-3	1.3
RTU-3	ROOF TOP UNIT	52 MCA	208V-3PH	M	7.9.11	603	6-3	1.3
RTU-4	ROOF TOP UNIT	61 MCA	208V-3PH	M	8.10.12	803	4-3	1.3
UH-01	UNIT HEATER	1.8 KW	120V-1PH	P	22	301	10-2	1.3
UH-02	UNIT HEATER	4 KW	208V-1PH	L	39.41	252	8-2	1.2
EF-1	EXHAUST FAN #1	0.1 KW	120V-1PH	P	41	201	12-2	1.2,4
EF-2	EXHAUST FAN #2	0.1 KW	120V-1PH	P	41	201	12-2	1.2,4
EF-3	EXHAUST FAN #3	0.1 KW	120V-1PH	P	35	201	12-2	1.2,5
EF-4	EXHAUST FAN #4	0.1 KW	120V-1PH	P	35	201	12-2	1.2,5

MECHANICAL EQUIPMENT SCHEDULE NOTES:

1. VERIFY LOAD, LOCATION AND CONNECTION REQUIREMENTS WITH MECHANICAL & PLUMBING DESIGN DRAWINGS, SHOP DRAWINGS, AND MECHANICAL & PLUMBING CONTRACTOR IN THE FIELD. ADJUST CONNECTION DEVICE, MOUNTING HEIGHT, WIRE, CONDUIT AND CIRCUIT BREAKER AS REQUIRED IN ORDER TO POWER THE EQUIPMENT. COORDINATE WITH THE EQUIPMENT INSTALLING CONTRACTOR PRIOR TO ROUGH-IN.
2. PROVIDE A LOCAL NEMA 3R HEAVY DUTY NON FUSED DISCONNECT SWITCH SIZED PER EQUIPMENT NAMEPLATE DATA.
3. PROVIDE A LOCAL NEMA 3R HEAVY DUTY FUSED DISCONNECT SWITCH SIZED AND FUSED PER EQUIPMENT NAMEPLATE DATA. WIRE AHEAD OF THE INTEGRAL UNIT BREAKER.
4. CONTROL CIRCUIT WITH TIME CLOCK.
5. WIRE TO 120 VOLT TSTAT AND LOUVER.

NEW HORIZONTAL CONDUITS TO BE INSTALLED ABOVE 12'-0" A.F.F. OR AS HIGH AS POSSIBLE IN JOIST SPACE AT SALES FLOOR WALLS.

ELECTRICAL CONTRACTOR SHALL REFER TO ARCHITECTURAL DRAWING A0.0 FOR ELECTRICAL DEVICES AND ACCESSORIES PROVIDED BY HARBOR FREIGHT TOOLS

ELECTRICAL CONTRACTOR TO REVIEW AND COMPLY WITH THE REQUIREMENTS OF GENERAL NOTES ON SHEET A0.2

CONDUITS OR MOUNTING HARDWARE SHALL NOT BE DIRECTLY MOUNTED TO THE ROOF DECK.


OUTLET COVER PLATES SHALL MATCH ADJACENT WALL COLOR UNLESS NOTED OTHERWISE.

GENERAL ELECTRICAL DEMOLITION NOTES

- A) NO ATTEMPT HAS BEEN MADE TO INDICATE ALL EXISTING ELECTRICAL DEVICES, LIGHT FIXTURES, COMMUNICATION DEVICES, WIRING, CONDUIT, ETC. TO BE REMOVED AND/OR RELOCATED. HOWEVER, THE ELECTRICAL CONTRACTOR SHALL FIELD VERIFY THE EXTENT OF DEMOLITION PRIOR TO SUBMITTING BID. ALL ITEMS SHOWN ON THESE DRAWINGS ARE NEW UNLESS OTHERWISE NOTED.
- B) REMOVE AND/OR RELOCATE EXISTING ELECTRICAL DEVICES NOT NOTED AS EXISTING TO REMAIN. COORDINATE SUCH CONDITIONS WITH ARCHITECTURAL DRAWINGS.
- C) EXISTING CONDUITS, CIRCUITS OR SYSTEMS IN WALLS OR CEILING BEING REMOVED WHICH SERVE SURROUNDING UNREMODELED AREAS SHALL BE REWORKED AND MAINTAINED.
- D) EXISTING CONDUITS, CIRCUITS OR SYSTEMS PASSING THROUGH THE REMODELED AREAS WHICH SERVE UNREMODELED AREAS SHALL REMAIN AND BE PROTECTED DURING DEMOLITION AND REMODELING, AND SHALL BE RELOCATED AND REROUTED.
- E) CONTINUITY OF CIRCUITS INTERRUPTED BY REMOVAL OF ELECTRICAL DEVICES SHALL BE MAINTAINED.
- F) ALL UNUSED WIRE (POWER & COMMUNICATION) SHALL BE REMOVED.
- G) ALL EXISTING WIRING (POWER & COMMUNICATION) THAT IS TO REMAIN SHALL BE REWORKED OR REPLACED WITH CODE COMPLIANT MATERIAL & SUPPORTS. ANY EXISTING SURFACE MOUNTED CONDUITS SHALL BE REMOVED OR RELOCATED SO THAT THEY ARE IN THE JOIST SPACE OR WITHIN WALL CAVITIES.
- H) EXISTING LIGHT FIXTURES THAT REMAIN OR ARE BEING RELOCATED SHALL BE CLEANED AND RE-LAMPED WITH 4' T8 LAMPS. BROKEN LENSES SHALL BE REPLACED. PROVIDE NEW T8 BALLASTS IF REQUIRED.
- I) EXISTING LIGHT FIXTURES, ELECTRICAL, TELECOMMUNICATION DEVICES, PANELBOARDS ETC. THAT ARE NOT TO BE REMOVED SHALL BE NOTED AS EXISTING TO REMAIN ON THE DRAWINGS. SEE ARCHITECTURAL & MECHANICAL DRAWINGS FOR ADDITIONAL INFORMATION ON SCOPE OF DEMOLITION.

POWER PLAN NOTES

- 01 PROVIDE A JUNCTION BOX ON WALL ABOVE CEILING FOR RACK POWER. RUN MC CABLE IN WALL CAVITY TO STRIKE RACK. PENETRATE RACK & INSTALL A SEPARATE ORANGE ISOLATED GROUND QUAD RECEPTACLE MOUNTED IN RACK. COORDINATE EXACT LOCATION WITH HFT PRIOR TO INSTALLATION.
- 02 PROVIDE A DEDICATED CIRCUIT & WIRE THRU TIME CLOCK. UTILIZE SAME CIRCUIT IF THERE ARE TWO EXHAUST FANS.
- 03 DEDICATED ISOLATED GROUND QUAD OUTLET ON DEDICATED CIRCUIT. COLOR TO BE ORANGE.
- 04 DEDICATED ISO GROUND QUAD OUTLET MOUNTED WITHIN THE CASHWRAP SO THAT BOTTOM OF QUAD IS 2' ABOVE LOWEST SHELF. SEE DETAIL ON E1.1A. COLOR TO BE ORANGE.
- 05 COORDINATE ROUGH-IN LOCATION WITH MANUFACTURERS SHOP DRAWINGS PRIOR TO INSTALLATION. PROVIDE STANDARD 20A-120V RECEPTACLE & WIRE TO A GFCI TYPE CIRCUIT BREAKER.
- 06 DUPLEX OUTLET MOUNTED ON WALL AT 12" ABOVE WINDOW. MOUNT FLUSH IN CEILING IF CEILING IS WITHIN 12" OF TOP OF WINDOW.
- 07 DUPLEX OUTLET MOUNTED FLUSH IN WALL ABOVE GLASS FOR NEON SIGNS BY T.G.C.
- 08 J-BOXES WITH SERVICE DISC SWITCH FOR SIGN CIRCUITS. COORDINATE ROUGH-IN REQUIREMENTS WITH SYSTEM CONTRACTOR. COORDINATE EXACT LOCATION WITH ARCHITECTURAL ELEVATIONS PRIOR TO ROUGH-IN.
- 09 15'-0" HIGH 2 COMPARTMENT POWER POLE TO BE FURNISHED BY HFT AND INSTALLED BY E.C. SHALL EXTEND UNISTRUT FROM THE POWER POLE UP TO THE ROOF STRUCTURE AND CONNECT TO UNISTRUT SECURED TO ROOF STRUCTURE (UNISTRUT TO BE PAINTED TO MATCH THE CEILING). SEE ARCHITECTURAL DRAWINGS FOR ROOF STRUCTURE HEIGHTS.
- 10 24 VAC WEATHERPROOF PUSH BUTTON MOUNTED 48" CONNECT TO LOAD SIDE OF TRANSFORMER. DORTRONICS #WR5716-HD23.
- 11 SERVICE BELL MOUNTED TO BOTTOM OF ROOF STRUCTURE. EDWARDS #340-605/598-348.
- 12 REMOVE EXISTING ELECTRICAL PANELS IF NOT SHOWN ON THIS PLAN OR E2.0 AS EXISTING TO REMAIN.
- 13 EXISTING 600A SECONDARY CONDUCTORS, CT BOX, METER, 600A DISCONNECT SWITCH, AND MAIN DISTRIBUTION PANEL TO REMAIN. (LANDLORD TO PROVIDE AND INSTALL UNDER SEPARATE CONTRACT)
- 14 DUPLEX RECEPTACLE FOR SUSPENDED MONITOR. E.C. SHALL PROVIDE MC CABLE & CAST BOX & MOUNT RECEPTACLE ON MONITOR ARM. COORDINATE EXACT LOCATION WITH COMMUNICATIONS CONTRACTOR.
- 15 208/240V CHARGER WIRE & INSTALLED BY ELECTRICAL CONTRACTOR. COORDINATE ROUGH-IN REQUIREMENTS WITH EQUIPMENT MANUFACTURER PRIOR TO INSTALLATION.
- 16 UTILIZE EXHAUST FAN CIRCUIT & CONNECT POWERED LOUVER AND CONTROL TRANSFORMER LOCATED IN DUCT WORK WITH (2) #12 #12 GND. INSTALL CONTROL TRANSFORMER PROVIDED BY MECHANICAL CONTRACTOR. COORDINATE ROUGH-IN REQUIREMENTS WITH MECHANICAL CONTRACTOR. WIRE TO LINE VOLTAGE TSTAT.
- 17 LOCATION OF FIRE ALARM CONTROL PANEL IF REQUIRED. ELECTRICAL CONTRACTOR TO LABEL PANEL & CONNECT TO CIRCUIT P-32 WITH (2) #12 #12 GND-3/4".
- 18 LANDLORD TO PROVIDE 1-1/2" EMPTY CONDUIT WITH PULL STRING FROM EXISTING TELEPHONE DEMARK TO HFT PHONE BOARD.
- 19 3 GANG RECESSED METALLIC JUNCTION BOX WITH METAL OVERALL COVER PLATE MOUNTED FLUSH WITH DRYWALL MOUNTED AT 43 INCHES TO THE BOTTOM OF THE BOX FOR THE EMS SYSTEM TOUCHSCREEN CONTROLLER. STUB (1) 3/4" EMT CONDUIT ABOVE CEILING WITH GROMMET FOR COMMUNICATION CABLES. STUB A SECOND EMT 3/4" CONDUIT TO A TWO GANG DEEP BOX MOUNTED 6" ABOVE CEILING FOR POWER SUPPLY WIRING. FROM TWO GANG BOX MOUNTED ABOVE CEILING HOMERUN BRANCH CIRCUIT TO PANEL. 2 GANG BOX ABOVE CEILING & 3 GANG BOX MOUNTED AT 43 INCHES SHALL BE WITHIN 6 FEET OF EACH OTHER. E.C. SHALL PROVIDE A 2 INCH DIAMETER HOLE GROUND SMOOTH IN METALLIC COVER PLATE. SEE DRAWING EMS-1 FOR INSTALLATION DETAILS.
- 20 SURFACE MOUNTED TERMINAL BOX MOUNTED NEXT TO SECURITY PANEL FOR EMS TO SECURITY SYSTEM INTERFACE.
- 21 ELECTRICAL CONTRACTOR SHALL INSTALL THE LIGHTING CONTROL PANEL (LCP), E.C. SHALL PROVIDE 120 VOLT POWER FOR THE POWER SUPPLY AND WIRE ALL LIGHTING CIRCUITS THROUGH THE CONTRACTORS AS SHOWN ON DRAWING E2.0 AND 2.1.
- 22 THE ELECTRICAL CONTRACTOR SHALL INSTALL THE ENERGY MANAGEMENT CONTROL PANEL (SLP), E.C. SHALL PROVIDE THE 120 VOLT CIRCUIT. (2) 1" CONDUITS STUBBED TO JOIST SPACE FOR CONTROL WIRING AND (1) 1" CONDUIT BETWEEN THE SLP AND SLP FOR CONTROL WIRING. SEE DRAWING E2.0 AND THE EMS DRAWINGS FOR FURTHER DETAILS.
- 23 E.C. SHALL PROVIDE HEAVY RIGID STEEL CONDUIT THRU RTU CURB AND INSTALL ON RTU ON SIDE OPPOSITE OF THE CONDENSING FAN. SEE EMS DRAWINGS FOR DETAILS. EMS VENDOR SHALL WIRE AND INSTALL OSD.
- 24 ELECTRICAL CONTRACTOR SHALL INSTALL A RECEPTACLE MOUNTED AT 96" AFF. CONTROLLED BY A SWITCH MOUNTED AT 48" AFF AND AN UNSWITCHED RECEPTACLE AT 24" AFF ALL CONNECTED TO THE CIRCUIT INDICATED ON THE FLOOR PLAN.
- 25 STUB 3/4" CONDUIT FROM THE BOTTOM OF THE SECURITY PANEL TO 96" AFF (BELOW CEILING). STUB TO BE WITHIN 6" HORIZONTAL OF QUAD RECEPTACLE. TYPICAL FOR 2. SECURITY CONTRACTOR SHALL ROUTE SECURITY PANEL POWER CABLE THRU CONDUITS PROVIDED.
- 26 ELECTRICAL CONTRACTOR SHALL INSTALL A HEAVY DUTY NEMA 3R DISCONNECT SWITCH. PROVIDE REJECTION TYPE FUSES SIZED PER THE MOPC OF THE UNIT. CONNECT SWITCH AHEAD OF THE INTEGRAL UNIT MOUNTED CIRCUIT BREAKER. THE FUSED DISCONNECT SWITCH IS REQUIRED TO MINIMIZE THE AVAILABLE SHORT CIRCUIT CURRENT AT THE MECHANICAL EQUIPMENT.
- 27 ELECTRICAL CONTRACTOR SHALL PROVIDE A JUNCTION BOX AND BRANCH CIRCUIT WIRING MOUNTED IN JOIST SPACE FOR FUTURE POWER DROP TO FURNITURE.
- 28 THE ELECTRICAL CONTRACTOR SHALL INSTALL A QUAD RECEPTACLE AT 6'-6" TO THE BOTTOM OF THE OUTLET. PROVIDE A RECESSED SYSTEM WHERE WALLS ARE FURRED FOR SURFACE MOUNTED APPLICATIONS. RUN A 3/4" EMT CONDUIT VERTICALLY DOWN WALL FROM JOIST SPACE TO OUTLET. MOUNT RECEPTACLE IN A GRAY OR TO MATCH WALL FINISH CAST BOX AND PAINT EMT CONDUIT TO MATCH WALL SURFACE.
- 29 ELECTRICAL CONTRACTOR SHALL PROVIDE A JUNCTION BOX WITH SWIVEL BALL HANGER FITTING IN JOIST SPACE ABOVE RECEPTACLE. INSTALL A VERTICALLY RUN 3/4" MC CONDUIT FROM THE BALL HANGER TO A QUAD RECEPTACLE MOUNTED IN A WHITE CASTE BELL BOX MOUNTED AT 6'-6" TO THE BOTTOM OF THE BOX. PAINT THE WHOLE INSTALLATION GRAY OR TO MATCH WALL FINISH.
- 30 UTILIZE LOCAL RECEPTACLE CIRCUIT AND CONNECT POWERED LOUVER AND CONTROL TRANSFORMER LOCATED IN DUCT WORK WITH (2) #12 #12 GND. INSTALL CONTROL TRANSFORMER PROVIDED BY MECHANICAL CONTRACTOR. COORDINATE ROUGH-IN REQUIREMENTS WITH MECHANICAL CONTRACTOR. WIRE TO LINE VOLTAGE THERMOSTAT.

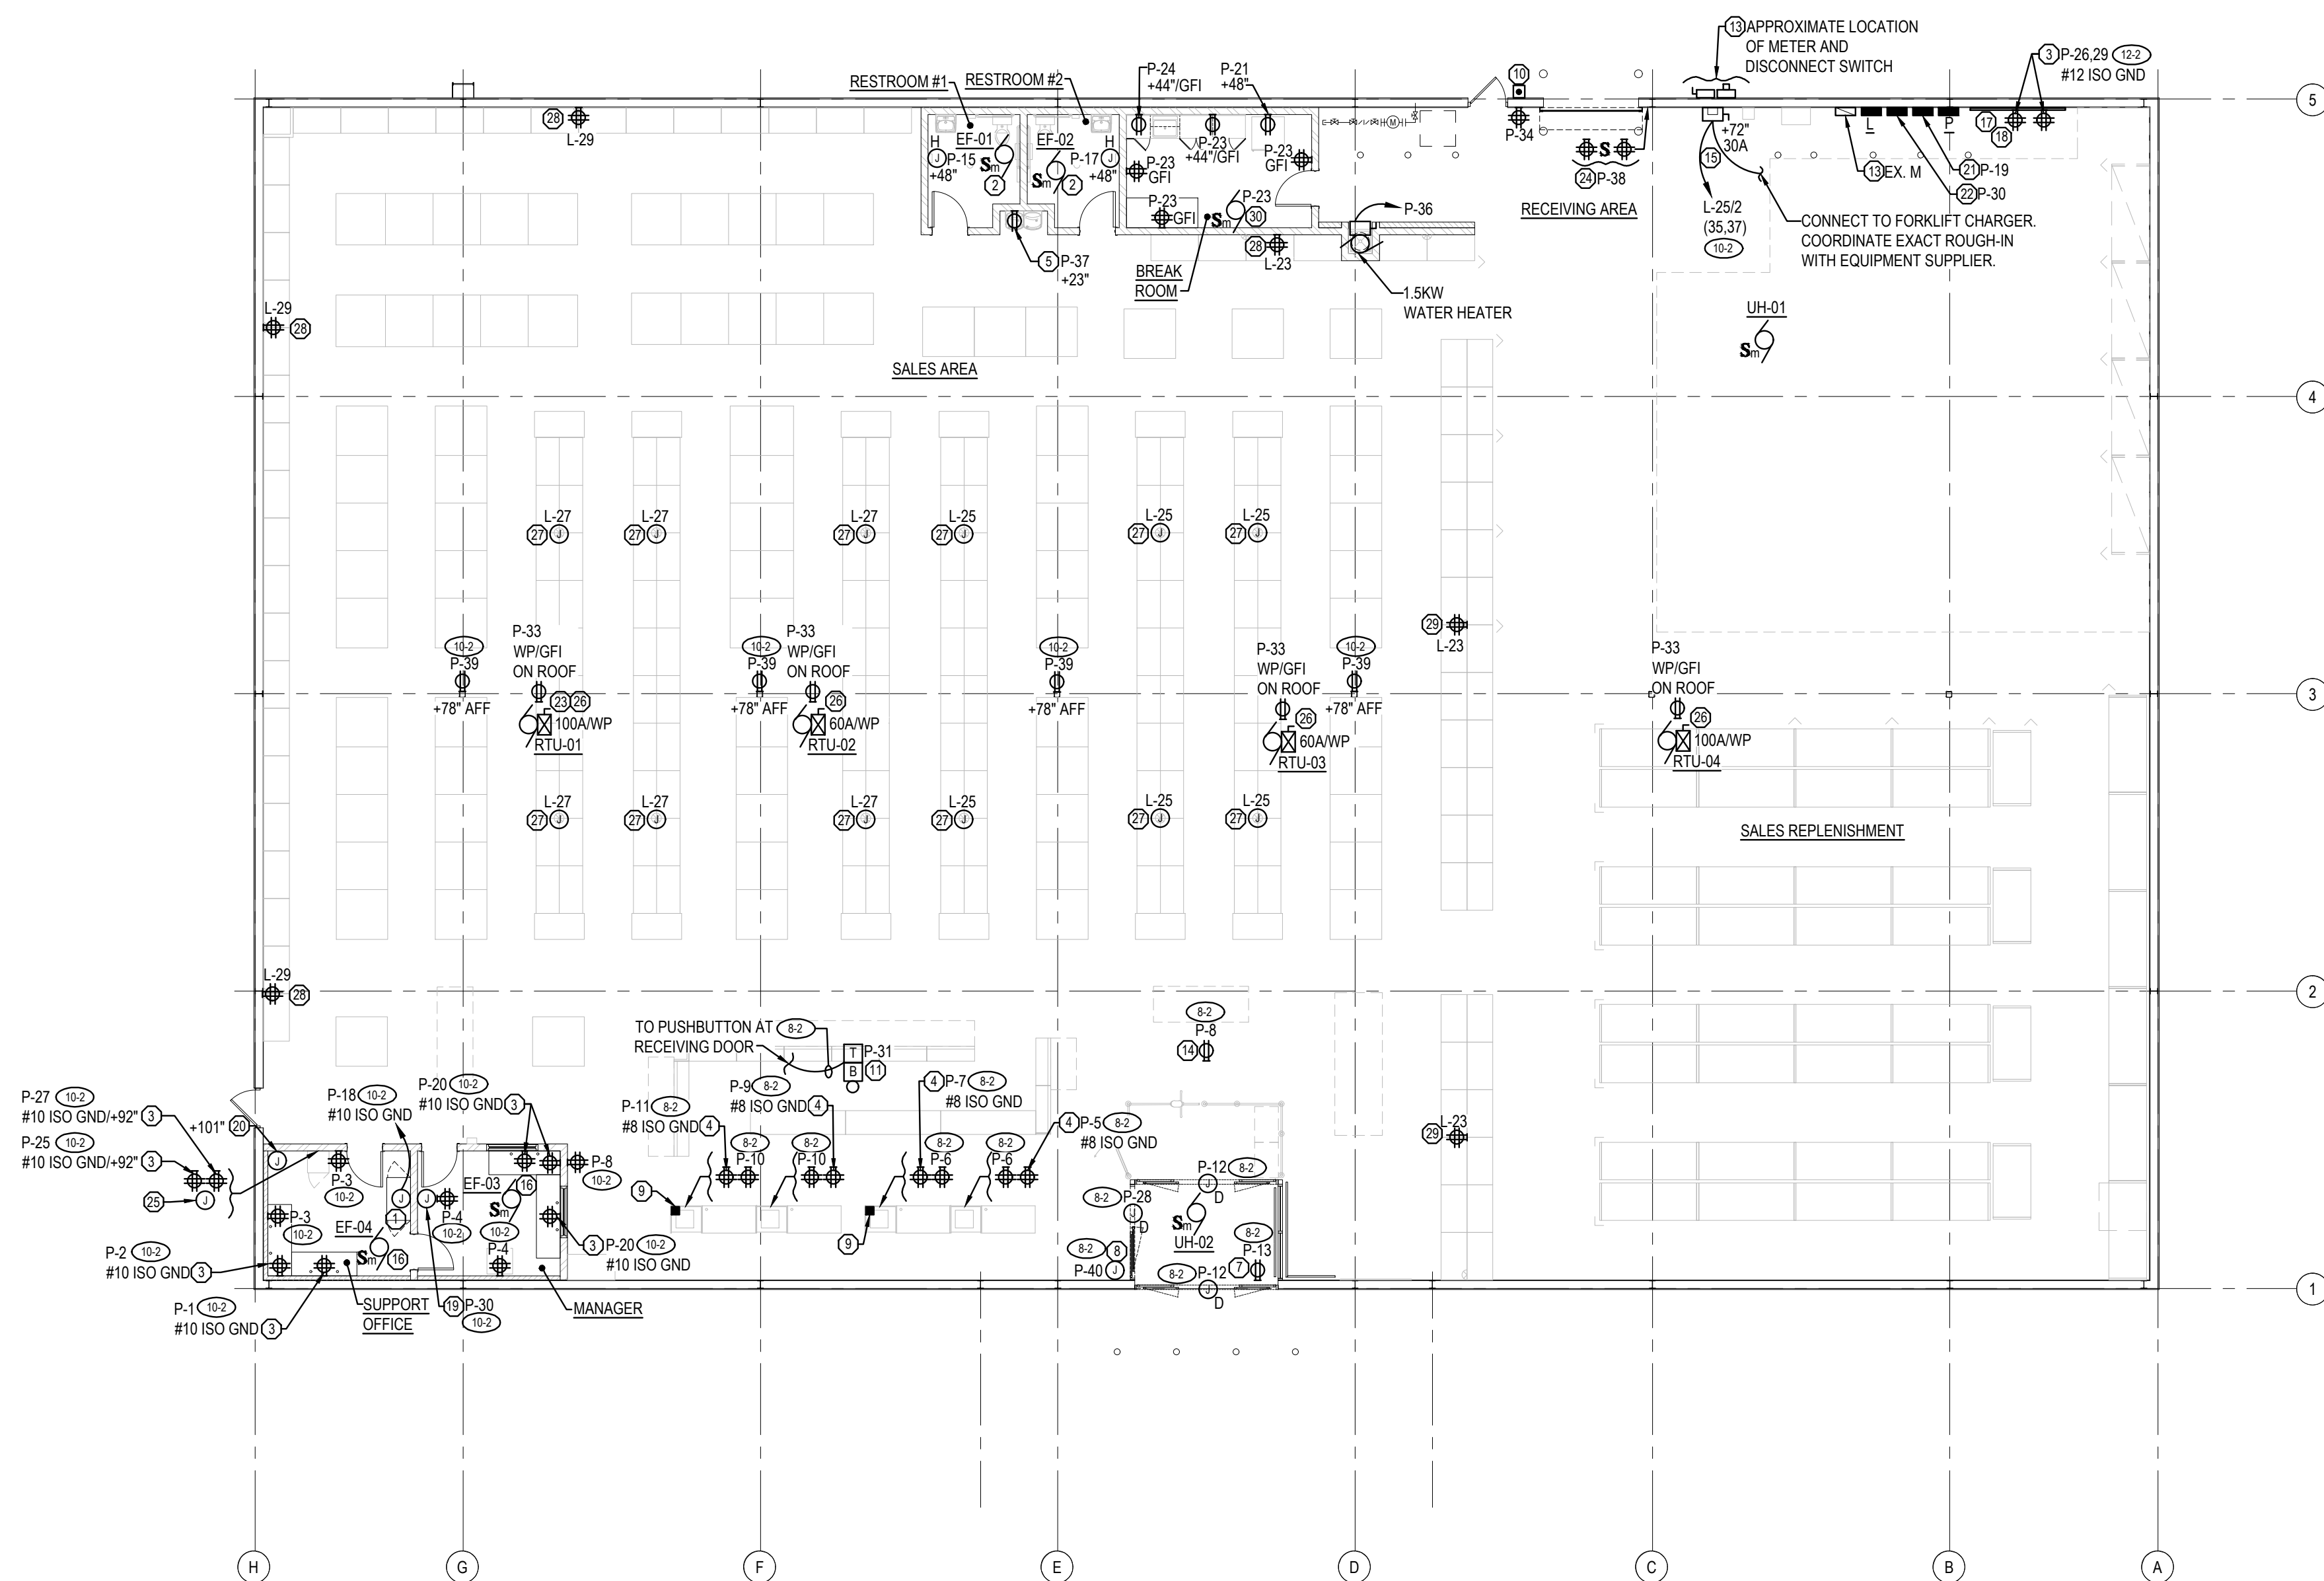


POWER PLAN
SCALE 3/32" = 1'-0"

Brian M. Schuler, P.E.

155 Williamsburg Drive
Avon Lake, Ohio 44012
Phone: 216-244-4120

BRIAN M. SCHULER
05-17-24

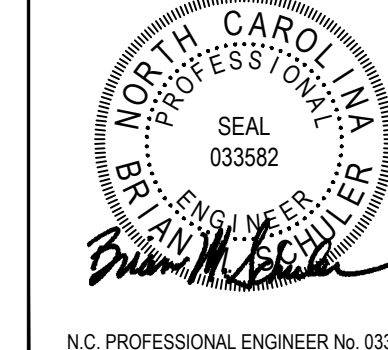

N.C. PROFESSIONAL ENGINEER No. 033582

DO NOT SCALE THESE DRAWINGS

REVISIONS

#	DATE	TYPE
1		
2		
3		
4		
5		
6		
7		
8		
9		
10		

POWER PLAN

DATE 05/17/24

JOB NO. 23475

E1.0

SHEET NO.

ADA ARCHITECTS
Lakewood, Ohio 44107
17710 Detroit Avenue
Phone (216) 521-5134
Fax (216) 521-4824
www.adaarchitects.com

HARBOR FREIGHT

ERWIN, NC 28839

46 SHRUI LANE

THESE DOCUMENTS CONTAIN INFORMATION PROPRIETARY TO ADA ARCHITECTS, INC.
UNAUTHORIZED USE OF THESE DOCUMENTS IS EXPRESSLY PROHIBITED UNLESS AGREED UPON IN WRITING.

GENERAL NOTES

- A ALL SALES & SALES REPLENISHMENT AREA LIGHTING CIRCUITS SHALL BE 10-2 10-3
- B ALL NIGHT / EMERGENCY / EXIT LIGHTING CIRCUITS SHALL BE 8-2
- C ALL EXTERIOR LIGHTING CIRCUITS SHALL BE 8-2
- D EMERGENCY LIGHT FIXTURES AND EXIT SIGNS HAVE BATTERY BACK UP INSTALLED, DESIGNED, AND MANUFACTURED TO CONFORM WITH THE NATIONAL ELECTRICAL CODE ARTICLE 700. THE EMERGENCY LIGHTING SYSTEM ILLUMINATION IS DESIGNED TO CONFORM WITH STATE BUILDING CODE SECTION 1008. EXIT SIGNS ARE INTERNALLY ILLUMINATED AND CONSTRUCTED TO CONFORM WITH STATE BUILDING CODE SECTION 1013.
- E FIXTURES LOCATED IN THE SALES REPLENISHMENT & RECEIVING AREA SHALL BE MOUNTED AS HIGH AS POSSIBLE MAXIMUM 15' AFF TO THE BOTTOM OF THE JOISTS OR ON UNSTRUCT MOUNTED TO THE BOTTOM OF THE JOIST WHERE FIXTURE LOCATIONS DO NOT LINE UP WITH THE JOIST. IF JOISTS ARE HIGHER THAN 15'-6" AFF TO BOTTOM CHANGE TYPE 'D' FIXTURES TO TYPE 'C' FIXTURES & MOUNT FIXTURES AT 15'-0" AFF.
- F ELECTRICAL CONTRACTOR SHALL INSTALL ALL EMERGENCY BALLASTS IF SHIPPED SEPARATELY. COORDINATE WITH VENDOR.
- G FOR EMERGENCY FIXTURES AE, A1E, BE, CE, C1E, DE & D1E NOT SHOWN AS NIGHT LIGHTS, RUN AN EXTRA HOT CONDUCTOR (BYPASSING ALL CONTROL) AND CONNECT TO EMERGENCY BALLAST. FIXTURES SHALL BE SHUT OFF WITH LOCAL LIGHT FIXTURE CONTROL.

LIGHTING PLAN NOTES


- 01 APPROXIMATE LOCATION OF TOUCH SCREEN CONTROL. TOUCH CONTROLLER CONTROLLER SHALL PROVIDE MANUAL ON / OFF CONTROL OF SALES AREA AND SALES REPLENISHMENT LIGHT FIXTURES. THE TOUCH SCREEN PROVIDES 2 POINTS OF CONTROL FOR THE SALES AREA REDUCING THE LIGHTING DENSITY BY 1/3 OR 2/3. EACH TOUCH POINT INDICATES WHETHER THE CONTROLLED LOAD IS ON OR OFF.
- 02 MOUNT SWITCH @ 44" A.F.F.
- 03 EXISTING EXTERIOR WALL LIGHTING TO REMAIN. EXISTING LIGHTING TO RUN THRU LIGHTING CONTACTOR PANEL AND CONNECT TO PANEL 'L' AS SHOWN.
- 04 PASSIVE INFRARED OCCUPANCY SENSOR. PROVIDED BY LIGHTING VENDOR WIRED AND INSTALLED TO FIXTURE BY E.C. MASK SENSOR SO THAT FIXTURE AREA OF DETECTION DOES NOT EXCEED AISLE OR AISLEWAY BOUNDARIES THAT FIXTURE IS LOCATED IN.
- 05 FIXTURES MOUNTED IN CONTINUOUS ROWS WITH A NIGHT LIGHT LOCATED IN THE RUN SHALL BE CONNECTED TO BRANCH CIRCUIT WIRING VIA A VERTICAL DROP FROM THE CEILING AT A MINIMUM OF ONCE FOR EACH NIGHT LIGHT CIRCUIT AND ONCE ON EITHER SIDE OF THE NIGHT LIGHT.
- 06 FIXTURE TYPE 'D' OR 'DE' LABELED AS 'NL' DO NOT RECEIVE OCCUPANCY SENSORS.
- 07 EXISTING PYLON SIGN TO REMAIN. EXISTING CIRCUITING TO REMAIN AND RE-ROUTE THRU LIGHTING CONTACTOR AS SHOWN ON DRAWING E2.1.
- 08 EXISTING SITE LIGHTING TO REMAIN. EXISTING CIRCUITING TO REMAIN AND RE-ROUTE THRU LIGHTING CONTACTOR AS SHOWN ON DRAWING E2.1.

SWITCH COVER PLATES SHALL MATCH ADJACENT WALL COLOR UNLESS NOTED OTHERWISE.

FIXTURES LOCATED IN THE SALES AREA (C, C1, CE, C1E) HAVE A 7 WIRE HARNESS AND THRU PIN CONNECTORS TO UTILIZE FOR BRANCH CIRCUIT WIRING THROUGH THE FIXTURES MOUNTED IN CONTINUOUS ROWS.

SALES FLOOR LIGHTING SHALL BE CHAIN MOUNTED AT 12'-0" TO THE BOTTOM OF THE FIXTURE.

SURFACE OR PENDANT MOUNTED LIGHT FIXTURES & ASSOCIATED MOUNTING HARDWARE AS WELL AS ANY CONDUITS SHALL NOT BE DIRECTLY MOUNTED TO THE ROOF DECK.

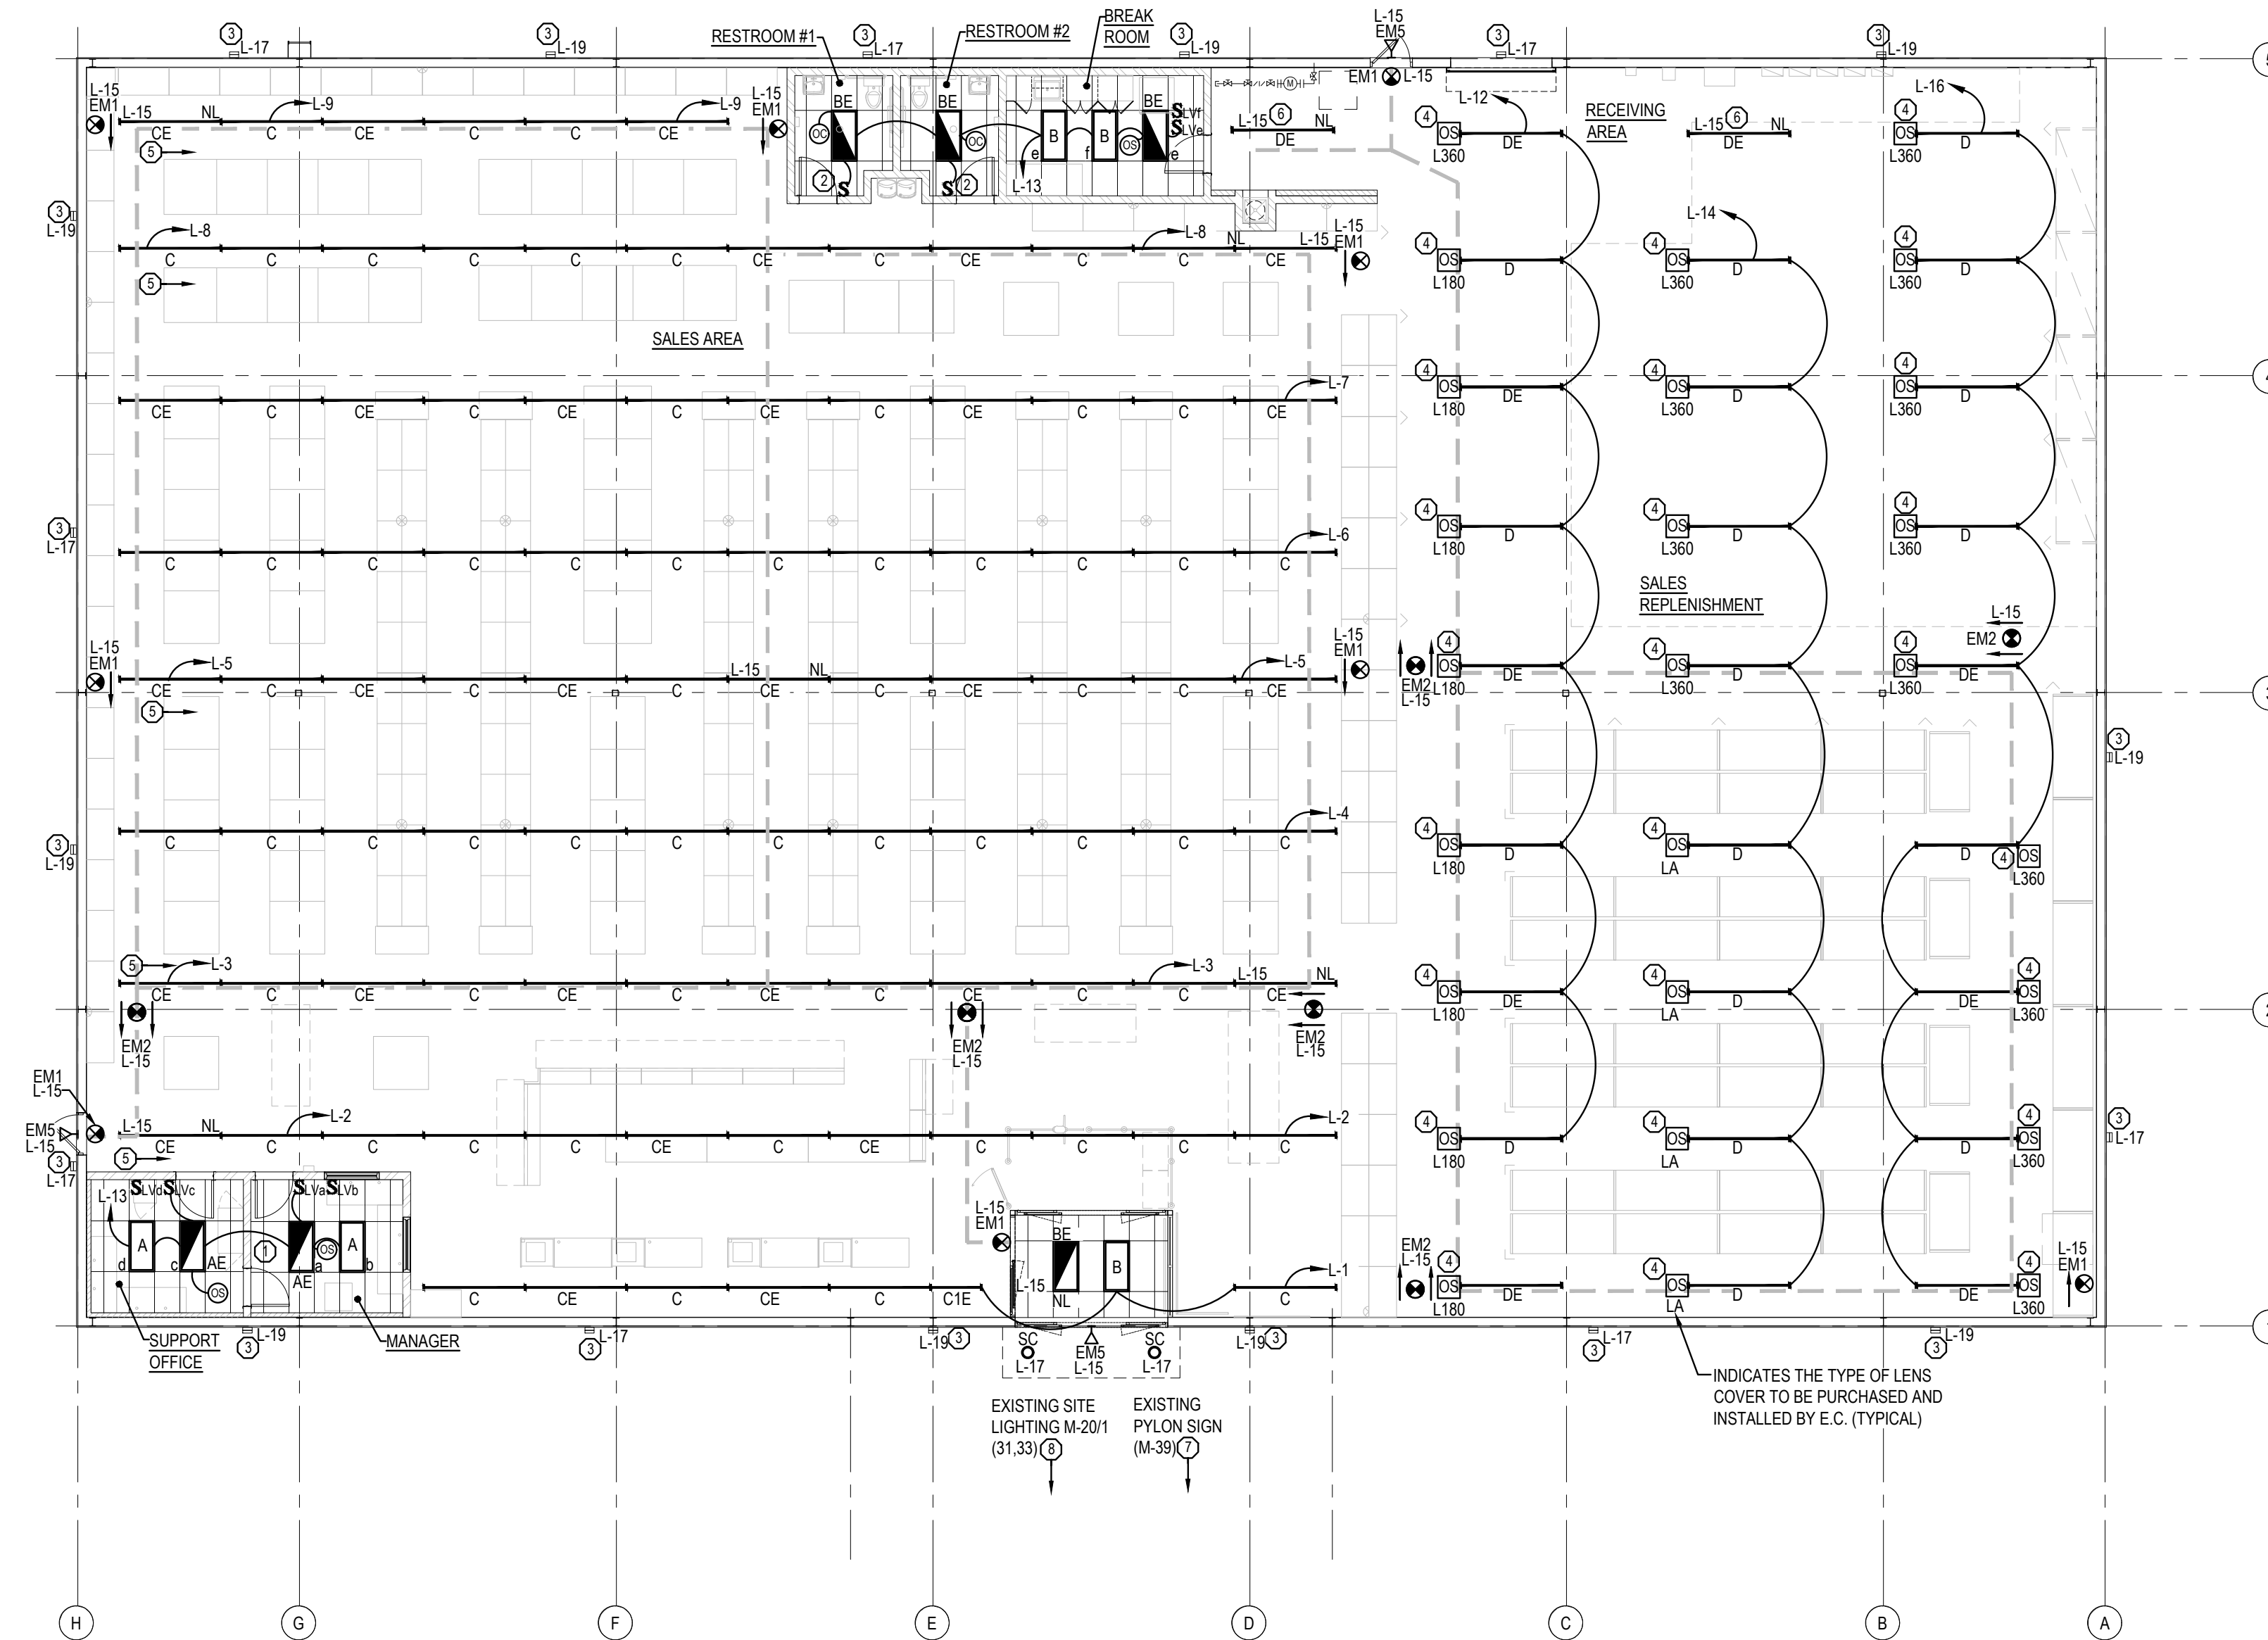

LIGHTING PLAN
SCALE 3/32" = 1'-0"

Brian M. Schuler, P.E.

155 Williamsburg Drive
Avon Lake, Ohio 44012
Phone: 216-244-4120

BRIAN M. SCHULER
05-17-24



DO NOT SCALE THESE DRAWINGS


REVISIONS	
#	DATE
1	
2	
3	
4	
5	
6	
7	
8	
9	
10	

LIGHTING PLAN	
DATE	05/17/24
JOB NO.	23475
E1.1	
SHEET NO.	

ADA ARCHITECTS
Lakewood, Ohio 44107
17710 Detroit Avenue
Phone (216) 521-5134
Fax (216) 521-4824
www.adaarchitects.com

HARBOR FREIGHT
46 SHRUI LANE
ERWIN, NC 28839


THESE DOCUMENTS CONTAIN INFORMATION PROPRIETARY TO ADA ARCHITECTS, INC. UNAUTHORIZED USE OF THESE DOCUMENTS IS EXPRESSLY PROHIBITED UNLESS AGREED UPON IN WRITING.

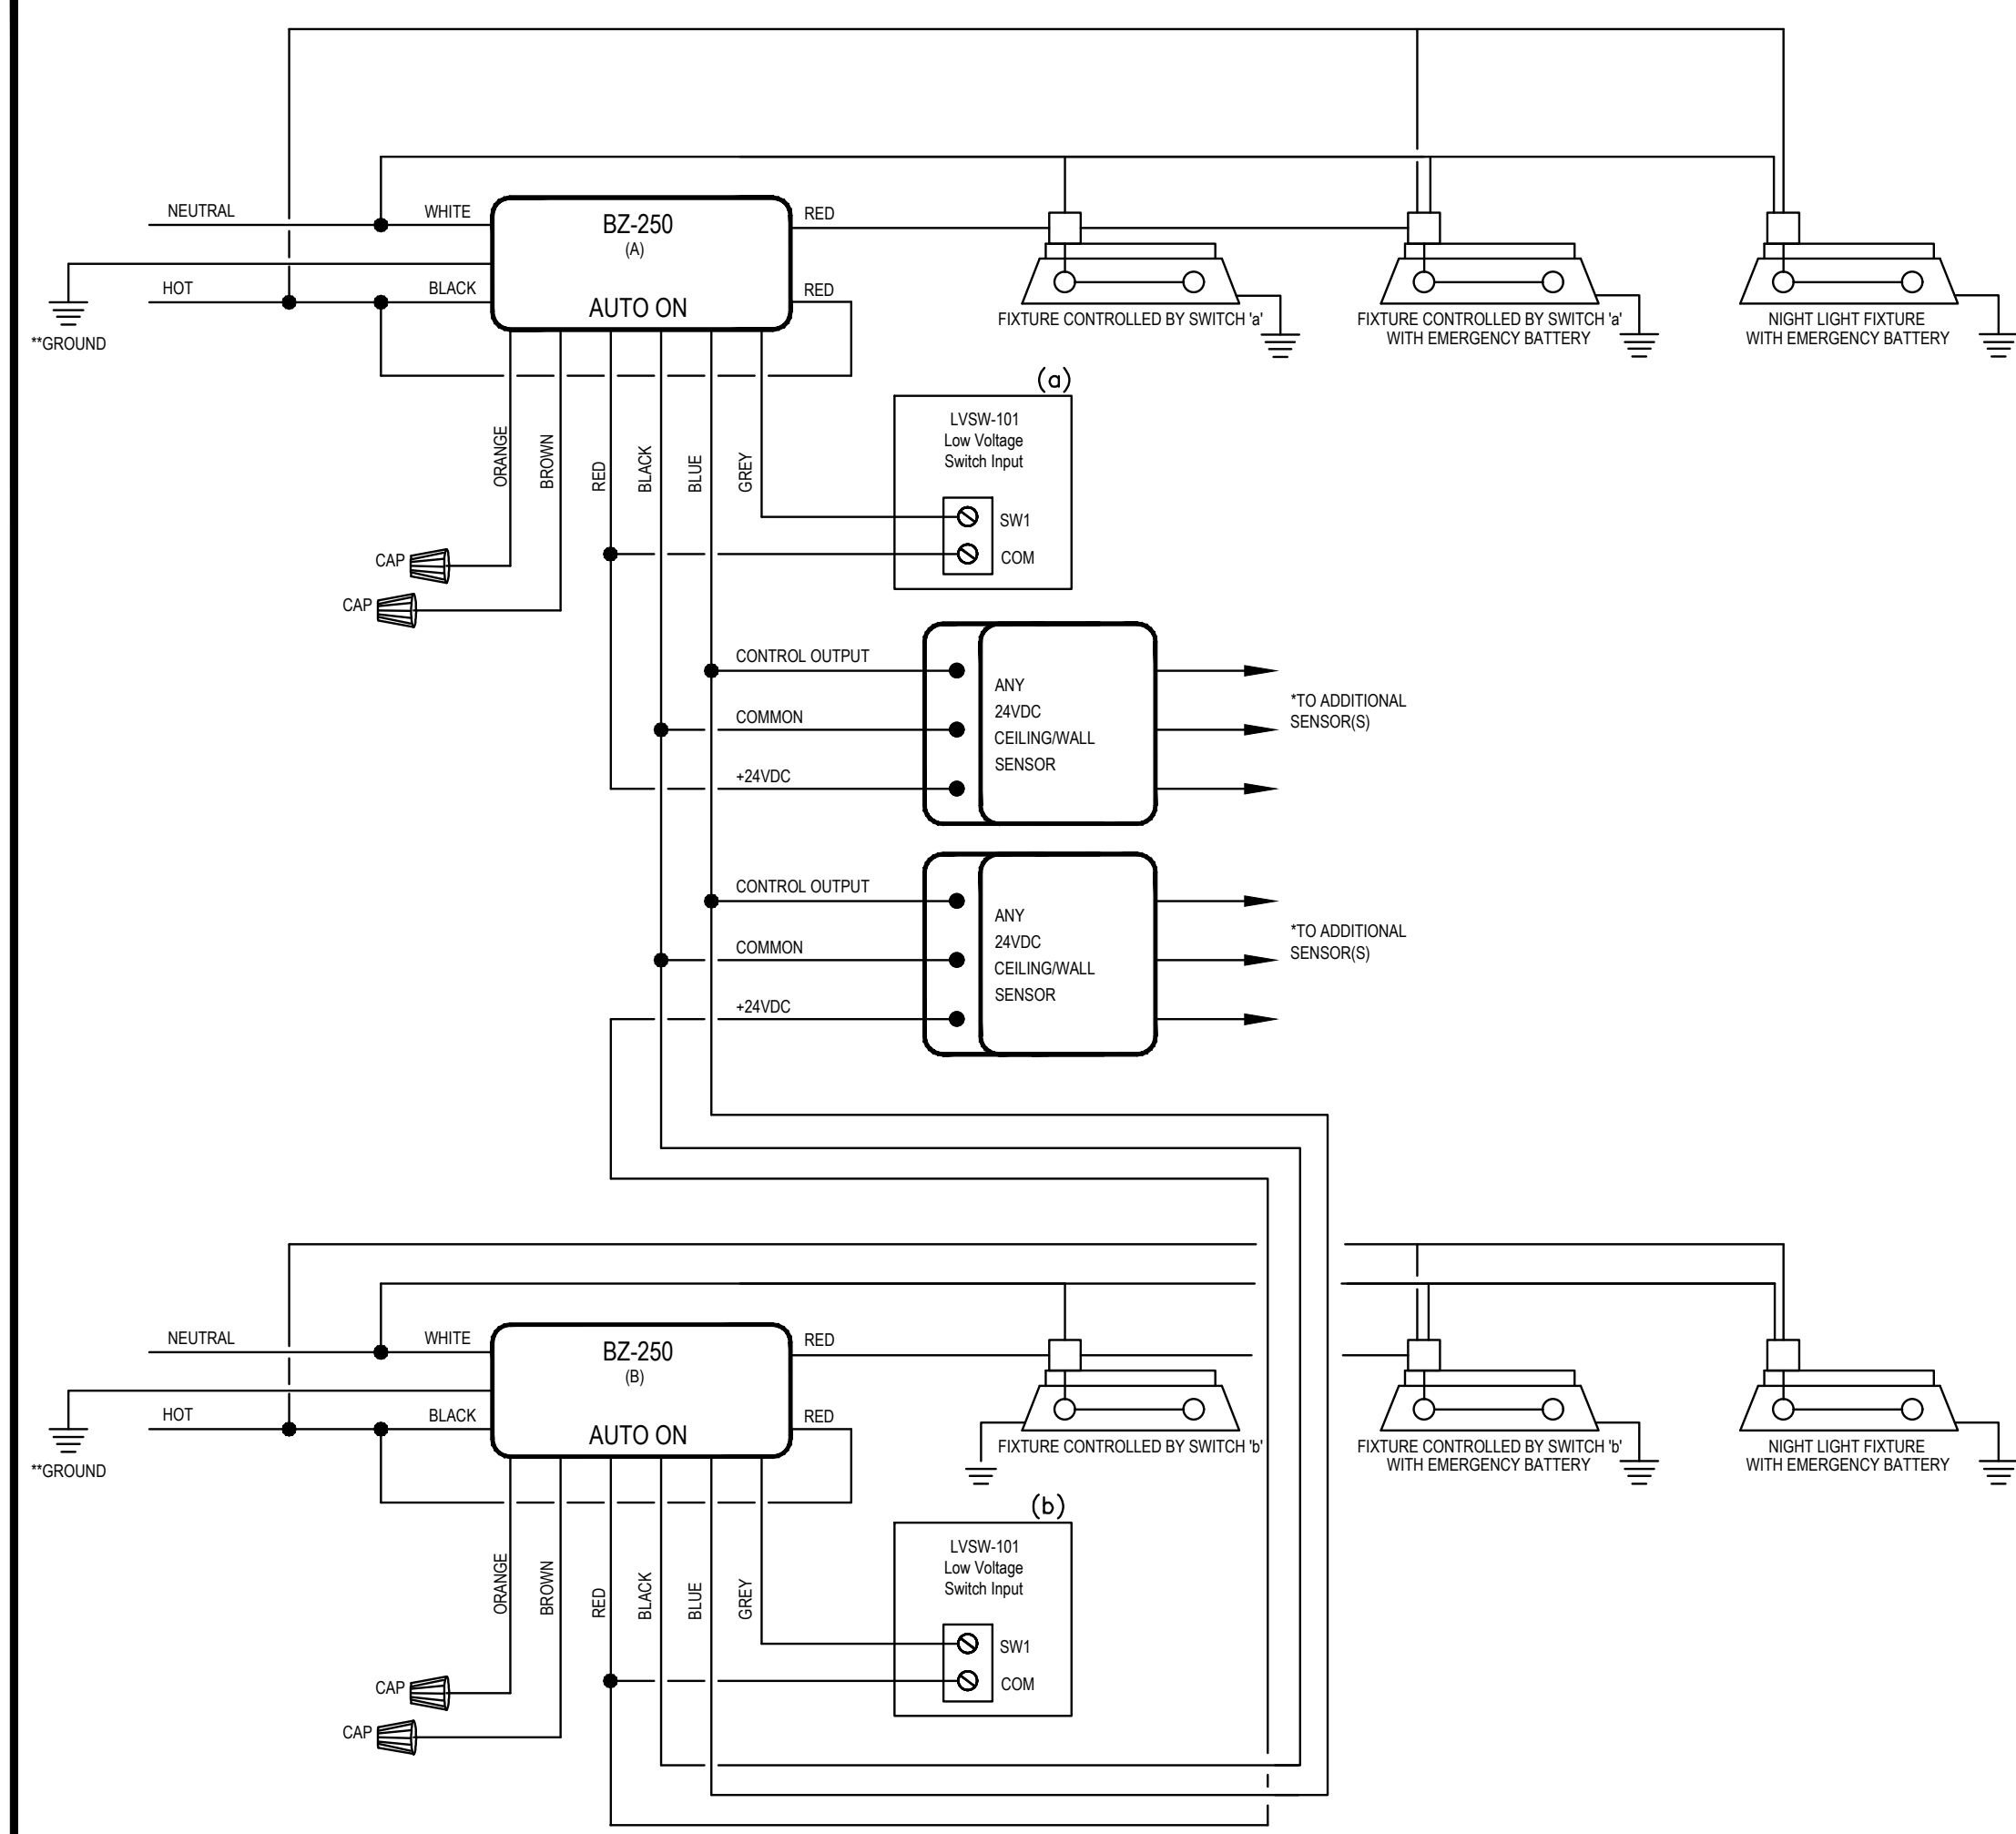

* At least 3 Sensors can be powered by the power pack. See Sensor data sheet. Provide a power pack for each circuit controlled and each low voltage switch installed.


** BZ-250 Power Pack must be grounded to ensure signal integrity, not for safety ground.

CEILING MOUNTED VACANCY / OCCUPANCY SENSOR & WALL MOUNTED LOW VOLTAGE SWITCH WIRING SCHEMATIC
N.T.S.

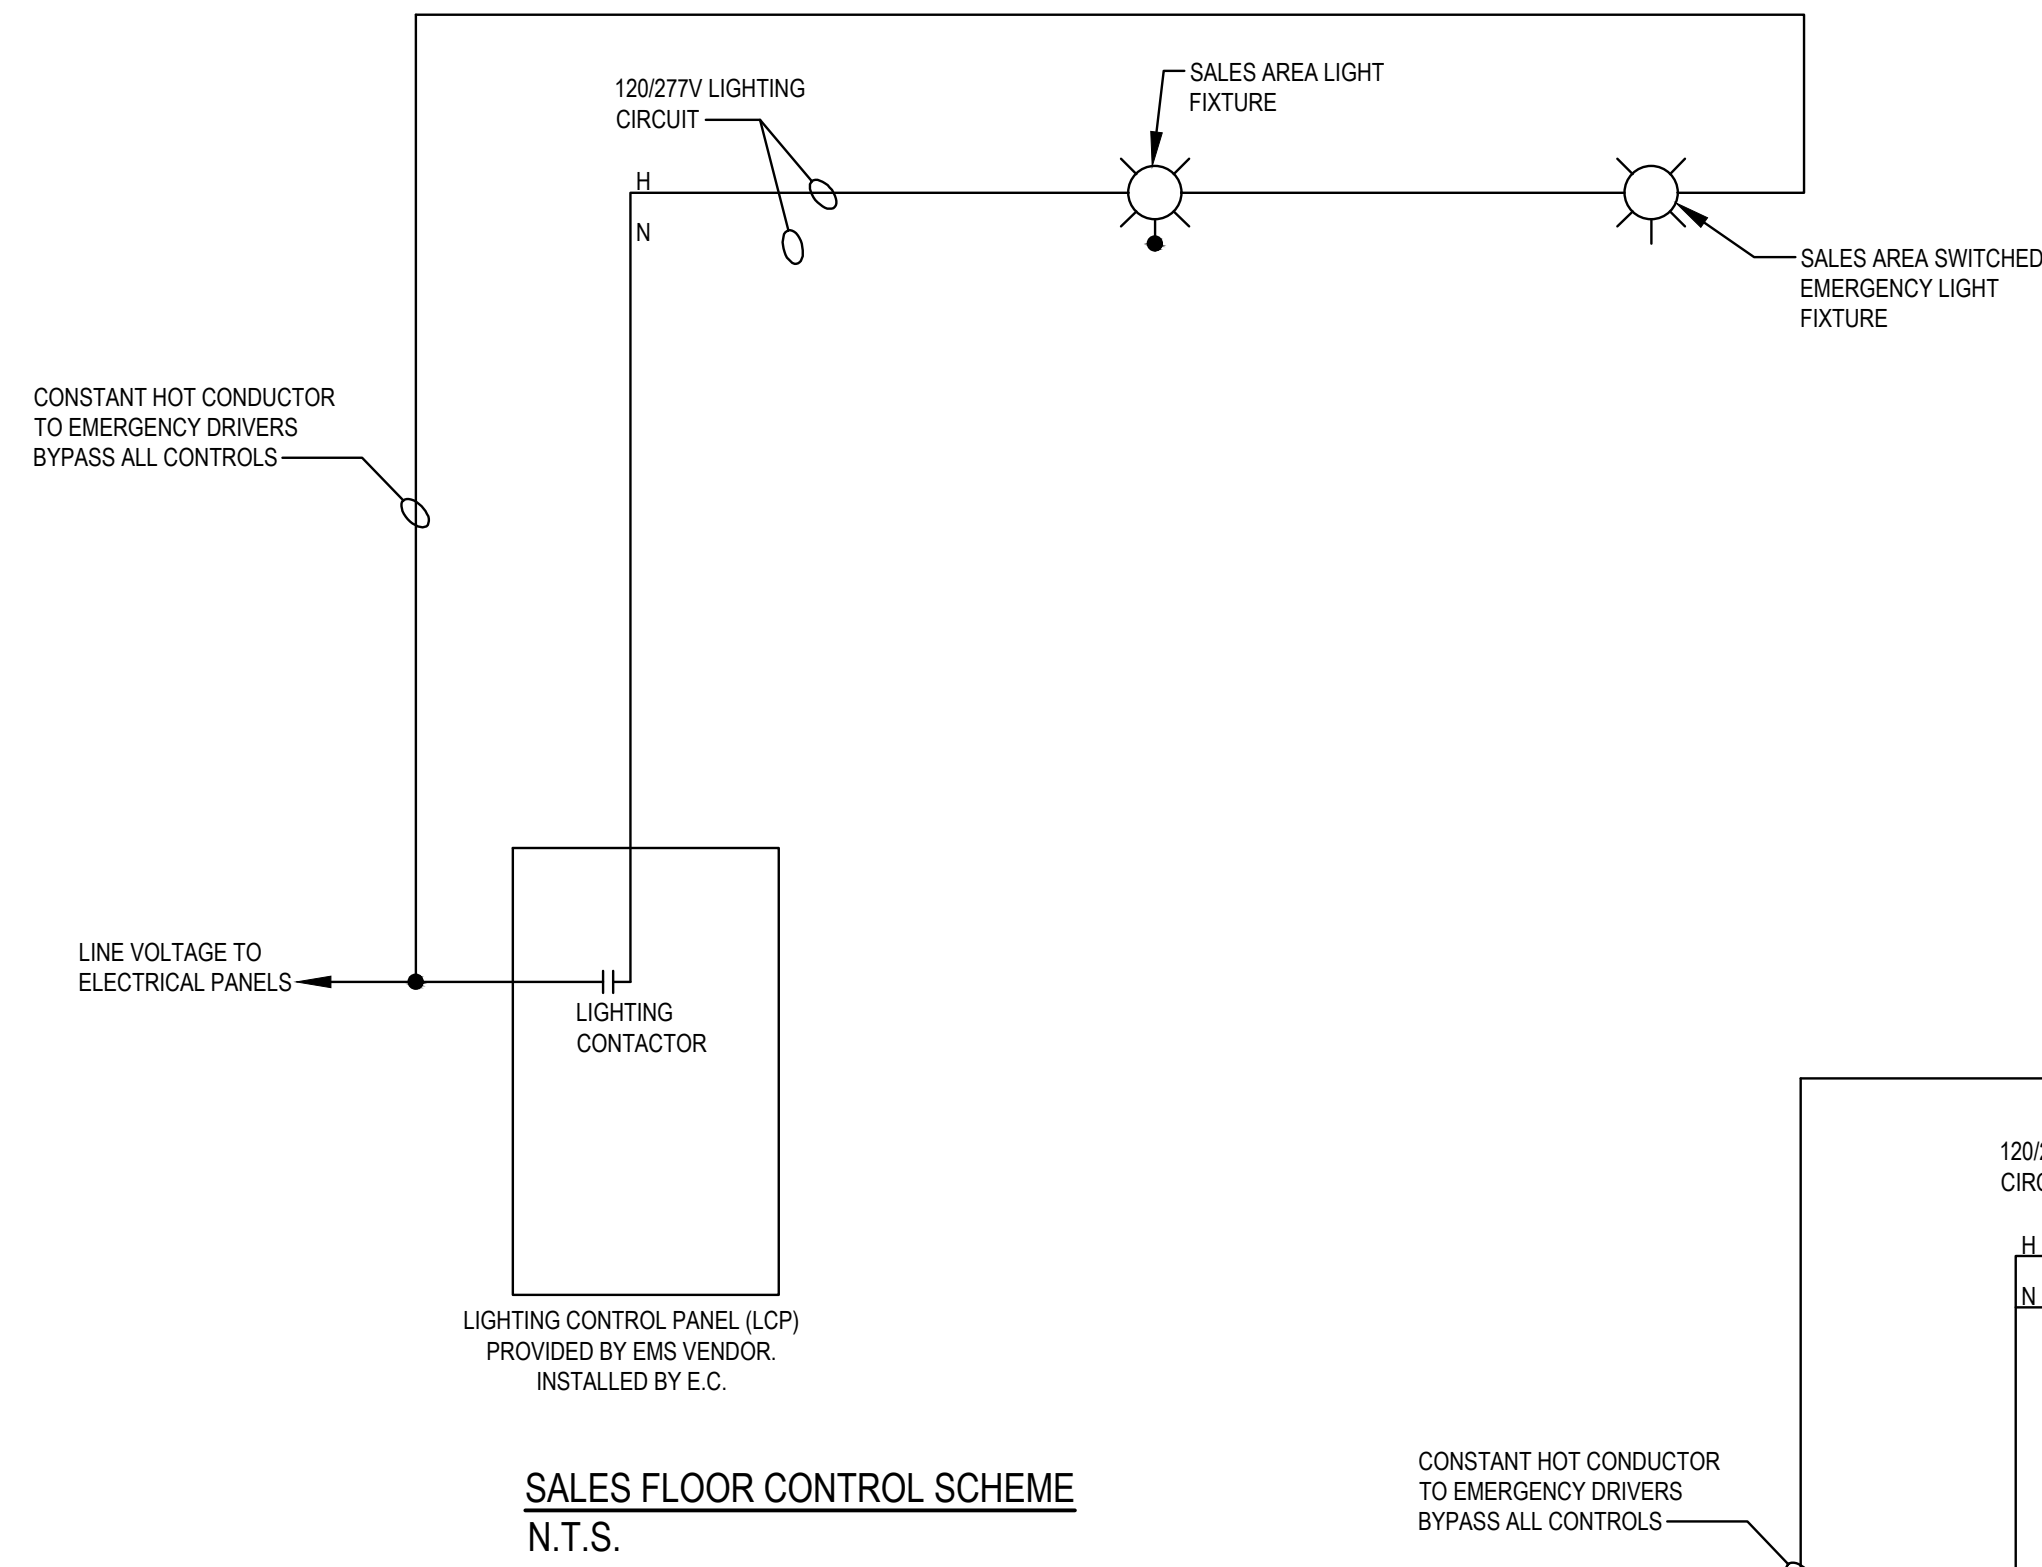


SALES FLOOR CONTROL SCHEME
N.T.S.


- ### ELECTRICAL SYSTEMS COMMISSIONING CHECKLIST
- THE ELECTRICAL CONTRACTOR SHALL COMMISSION OR PAY FOR THE SERVICES OF A LOCAL LICENSED COMMISSIONING AGENT IF REQUIRED BY THE AHJ. THE POWER & LIGHTING SYSTEMS INSTALLED PER SECTION C405 OF THE 2015 IECC ENERGY CODE COMMISSIONING PERFORMANCE & DOCUMENTATION SHALL COMPLY WITH SECTION C408.
 - ITEMS TO BE TESTED & DOCUMENTED ARE LISTED BELOW BUT NOT LIMITED TO:
 - LIGHTING SYSTEM FUNCTIONAL TESTING & TRAINING IN THE PRESENCE OF THE OWNER SHALL BE PERFORMED PER SECTION C408.3.1. ENSURE THAT THE CONTROL HARDWARE & SOFTWARE HAVE BEEN TESTED, CALIBRATED AND OR PROGRAMMED IN ACCORDANCE WITH THE CONSTRUCTION DOCUMENTS & MANUFACTURERS INSTRUCTIONS.
 - EACH OCCUPANCY SENSOR SHALL BE LOCATED & AIMED IN ACCORDANCE WITH MANUFACTURERS RECOMMENDATIONS.
 - VERIFY THE CORRECT OPERATION OF EACH OCCUPANCY SENSOR WHETHER DESIGNED FOR AUTOMATIC ON AT 50 PERCENT LIGHT LEVEL OR MANUAL ON.
 - VERIFY SENSORS ARE SHIELDED FROM MOVEMENT IN ADJACENT AREA OR BY HVAC OPERATION.
 - INTERIOR & EXTERIOR LIGHTING SYSTEMS THAT ARE CONTROLLED VIA TIME SWITCH AND/OR PHOTOCELLS SHALL BE TESTED AS FOLLOWS:
 - TIME SWITCH CONTROL IS PROGRAMMED WITH ACCURATE WEEKDAY, WEEKEND & HOLIDAY SCHEDULES. VERIFY SCHEDULES WITH OWNER & PROVIDE DOCUMENTATION.
 - VERIFY CORRECT TIME & DATE IN TIME SWITCH.
 - VERIFY BATTERY BACK UP IS INSTALLED & OPERATIONAL.
 - VERIFY OVERRIDE TIME LIMIT IS SET NOT TO EXCEED 2 HOURS.
 - VERIFY THAT THE OVERRIDE SWITCH ONLY CONTROLS INTERIOR LIGHT FIXTURES.
 - EACH DAYLIGHT SENSOR SHALL BE LOCATED IN ACCORDANCE WITH MANUFACTURERS RECOMMENDATIONS.
 - SENSORS ARE CALIBRATED FOR ACCURATE THRESHOLD LIGHT LEVELS.
 - DAYLIGHT CONTROLLED LIGHT FIXTURES AUTOMATICALLY ADJUST TO LIGHT LEVEL SET POINTS IN RESPONSE TO AVAILABLE DAYLIGHT.
 - WRITTEN DOCUMENTATION CERTIFYING THAT THE INSTALLED LIGHTING SYSTEM & CONTROLS MEET THE PERFORMANCE REQUIREMENTS OF THE DRAWINGS & SPECIFICATION AS WELL AS THE CRITERIA SET FORTH IN SECTION C405. DOCUMENTATION SHALL BE PROVIDED TO THE OWNER BEFORE THE RECEIPT OF THE CERTIFICATE OF OCCUPATION. PROVIDE AHJ WITH DOCUMENTATION IF REQUIRED.

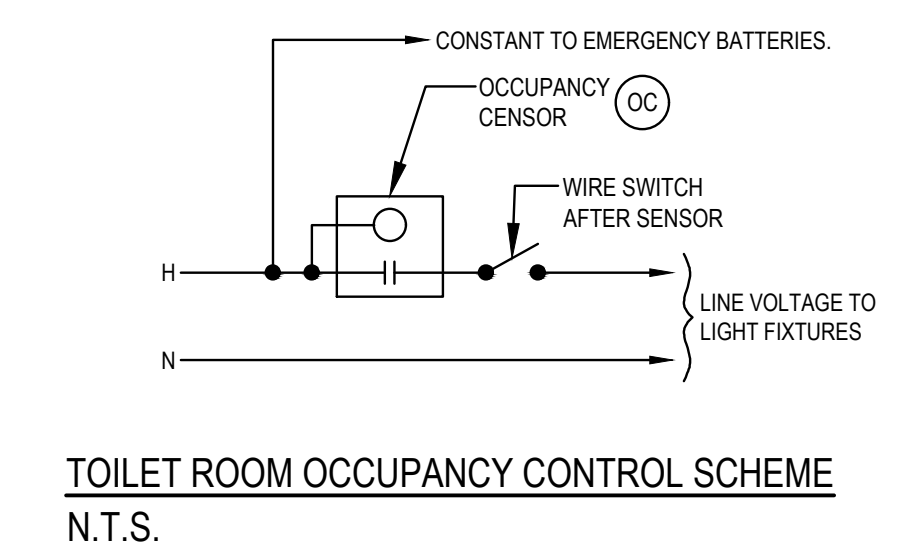

TOILET ROOM OCCUPANCY CONTROL SCHEME
N.T.S.

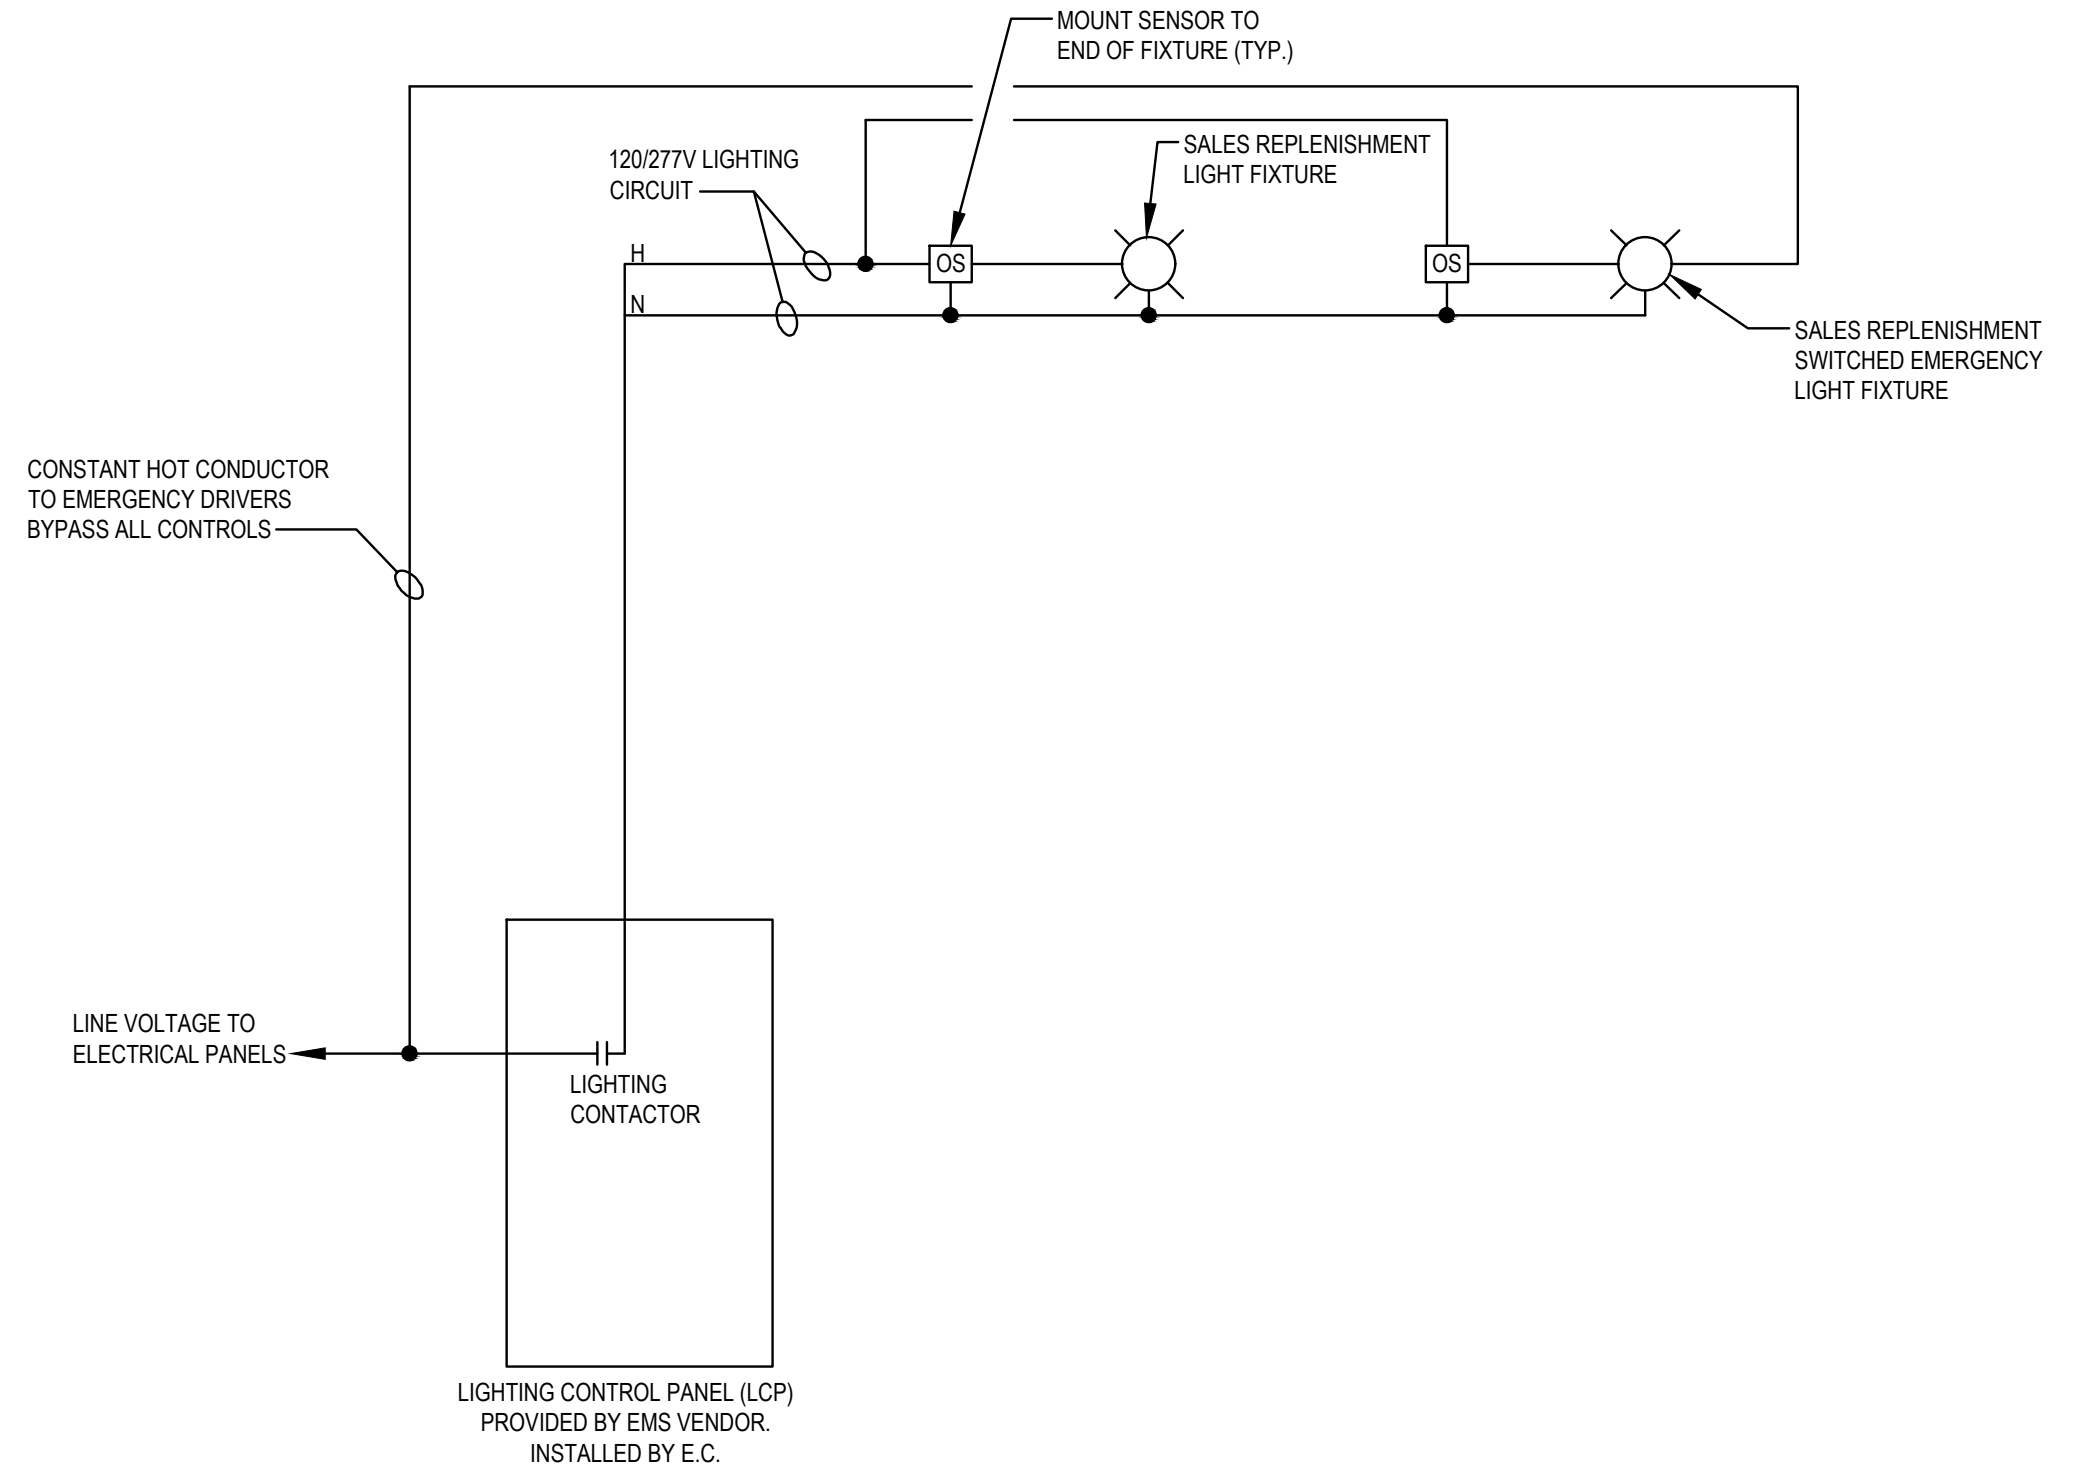

SALES REPLENISHMENT CONTROL SCHEME
N.T.S.

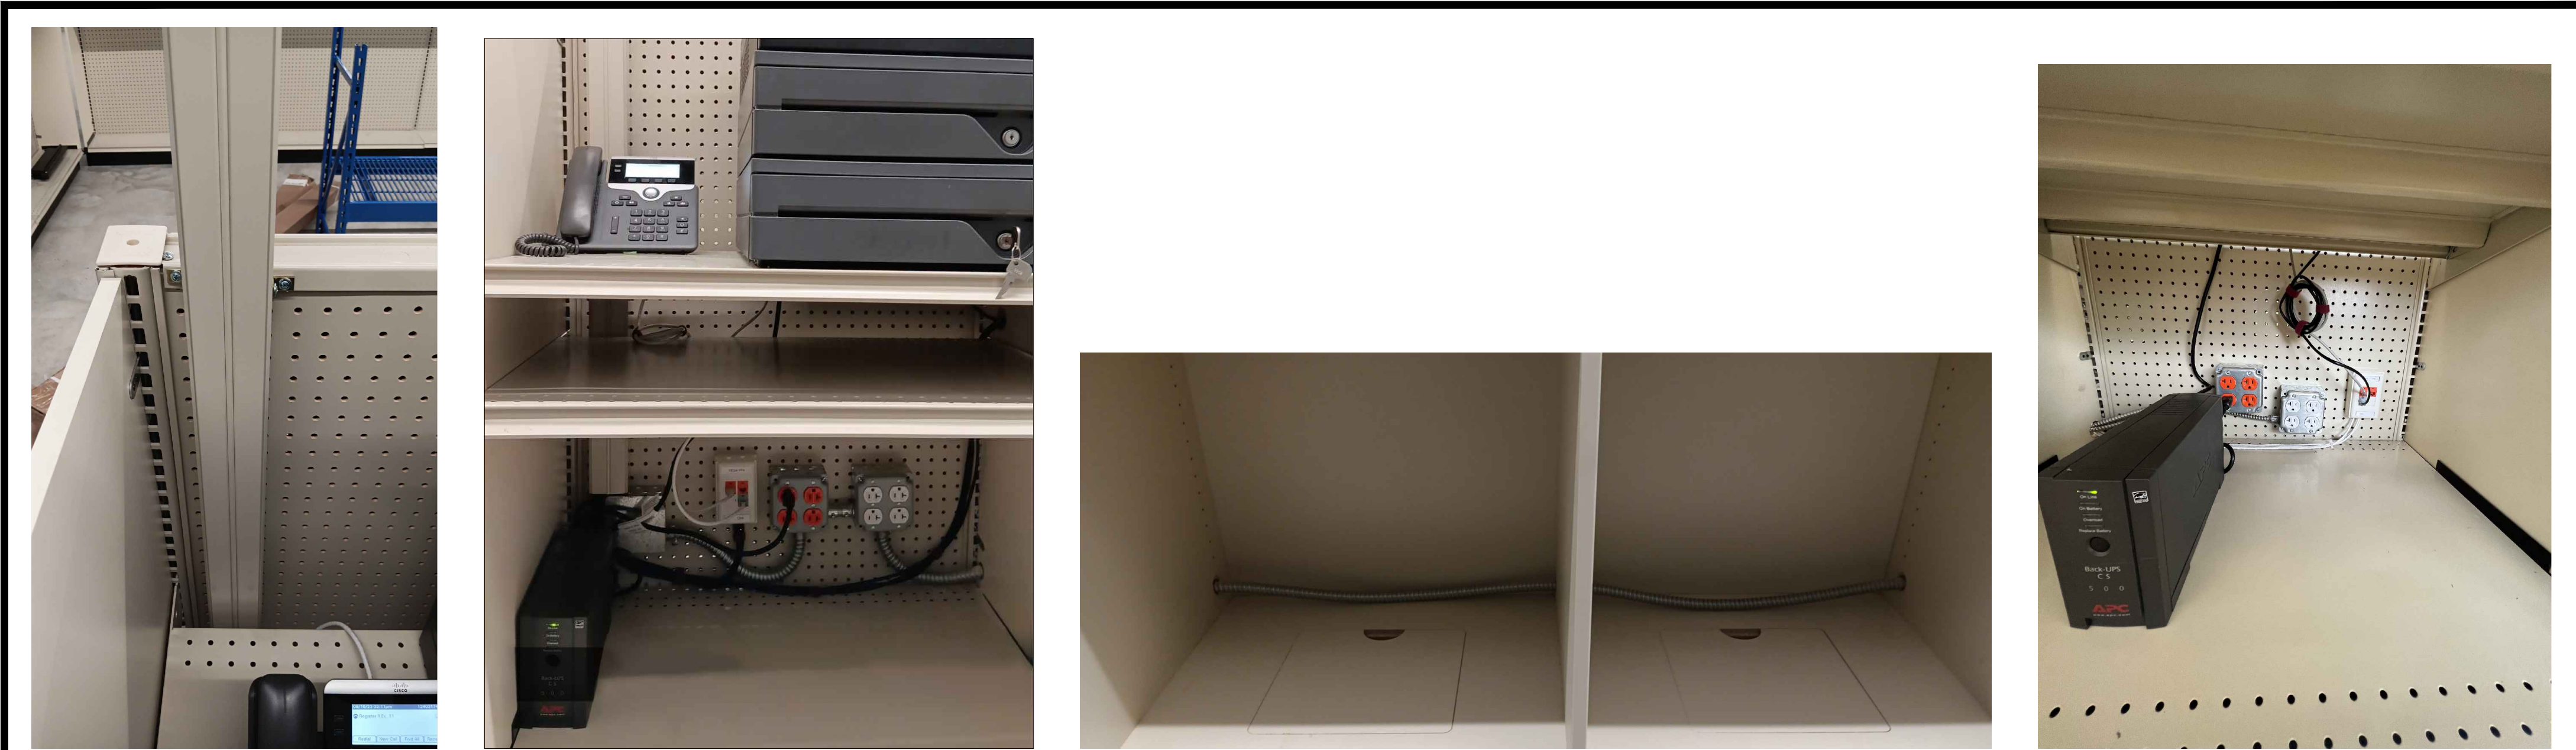

CASH WRAP POWER / COMMUNICATION DETAIL
N.T.S.

ALL DEVICES SHOWN FOR OCCUPANCY / DIMMING CONTROL INDICATED ON THIS DRAWING ARE NOT PART OF THE SIEMENS EMS SYSTEM (U.O.N). THE ELECTRICAL CONTRACTOR SHALL PURCHASE, WIRE, INSTALL LINE AND LOW VOLTAGE DIMMING SWITCHES, OCCUPANCY/VACANCY SENSORS, RELAYS, ETC.

Brian M. Schuler, P.E.

155 Williamsburg Drive
Avon Lake, Ohio 44012
Phone: 216-244-4120

BRIAN M. SCHULER 05-17-24



N.C. PROFESSIONAL ENGINEER No. 033582

DO NOT SCALE THESE DRAWINGS

REVISIONS	
#	DATE
1	
2	
3	
4	
5	
6	
7	
8	
9	
10	

ROOM LIGHTING CONTROL / DIMMING SYSTEM DETAILS

DATE 05/17/24

JOB NO. 23475

E1.1A
SHEET NO.

HARBOR FREIGHT

46 SHRUI LANE
ERWIN, NC 28839

THESE DOCUMENTS CONTAIN INFORMATION PROPRIETARY TO ADA ARCHITECTS, INC.
UNAUTHORIZED USE OF THESE DOCUMENTS IS EXPRESSLY PROHIBITED UNLESS AGREED UPON IN WRITING.

www.adaarchitects.com
17710 Detroit Avenue
Lakewood, Ohio 44107
Phone (216) 521-5134
Fax (216) 521-4824

ADA ARCHITECTS

GENERAL ELECTRICAL / COMMUNICATION / SECURITY NOTES

- 01 HFT COMMUNICATIONS CONTRACTOR SHALL PROVIDE & INSTALL ALL CABLE, JACKS, PATCH CORDS, TELEPHONE EQUIPMENT ETC FOR A COMPLETE LOW VOLTAGE COMMUNICATIONS SYSTEM. GC IS RESPONSIBLE FOR COMPLETE SECURITY SYSTEM INSTALLATION, REFER TO VENDOR SCOPE OF WORK SUMMARY ON SHEET A0.0 FOR ANY HFT VENDOR PROVIDED ITEMS.
- 02 THE ELECTRICAL CONTRACTOR SHALL PROVIDE ALL CONDUIT, BOXES, PULL STRINGS, 120V POWER SLEEVES FOR COMMUNICATIONS WIRING & EQUIPMENT. COORDINATE WITH COMMUNICATIONS CONTRACTOR & SEE SYMBOL LEGEND FOR ADDITIONAL DETAILS. THE E.C. SHALL PROVIDE WIRE AND COMPLETELY INSTALL ALL COMPONENTS OF THE SECURITY SYSTEM INCLUDING BUT NOT LIMITED TO: COMPONENTS, DEVICES, PANELS, WIRE, CONDUIT, BOXES, AND SYSTEM INTERCONNECTIONS.
- 03 ALL CONDUITS SHALL BE PROVIDED WITH PLASTIC BUSHINGS AT EACH END, PULL STRINGS & BE BONDED TO LOCAL BUILDING STEEL.
- 04 ALL LOW VOLTAGE CABLES SHALL BE PLENUM RATED.
- 05 THE COMMUNICATIONS CONTRACTOR SHALL PROVIDE A COMPLETE DATA COMMUNICATIONS SYSTEM WITH EQUIPMENT, PATCH PANELS, CABLE, JACKS, J-hooks, BOXES, LABELING, TESTING, ETC. ALL EQUIPMENT SHALL BE SUPPLIED & INSTALLED PER CATEGORY 6 (BICSI AND EIA/TIA) INSTALLATION STANDARDS.
- 06 THE COMMUNICATIONS CONTRACTOR SHALL PROVIDE A COMPLETE COMMUNICATIONS SYSTEM LABELING SYSTEM, INCLUDE BUT NOT LIMITED TO: CABLES, JACKS, PATCH PANEL RACKS, ETC. ALL LABELING SHALL COMPLY WITH STANDARDS OF EIA/TIA 606.
- 07 THE COMMUNICATIONS CONTRACTOR SHALL TEST EACH CABLE AFTER INSTALLATION AND TERMINATION TO CERTIFY THAT EACH CABLE COMPLIES WITH TIA/EIA CATEGORY 6 STANDARDS. PROVIDE DOCUMENTATION PER HFT REQUIREMENTS.
- 08 SECURITY SYSTEM WIRING SHALL BE 224 STRANDED UNSHIELDED CABLE.
- 09 EACH SPECIFIED ALARM CONTACT AND EACH SPECIFIED ALARM SENSOR SHOULD BE WIRED IN A CLOCKWISE MANNER TO ITS OWN DESIGNATED ZONE STARTING AT THE MAIN CUSTOMER ENTRANCE / EXIT DOOR CONTACTS.
- 10 EACH SPECIFIED ALARM CONTACT AND EACH SPECIFIED ALARM SENSOR SHOULD BE SPECIFICALLY LABELED ACCORDING TO ITS DESIGNATED CONTACT OR SENSOR NAME, ITS LOCATION WITHIN THE STORE & PROGRAMMED SEPARATELY TO ITS OWN DESIGNATED ZONE.
- 11 THE CONTRACTOR SHOULD NEVER PROGRAM / INSTALL ANY TYPE OF LOCKOUT CODE INTO THE PANEL OR EXPANDER.
- 12 COORDINATE CONDUIT AND/OR JUNCTION BOXES AS REQUIRED FOR SECURITY SYSTEM.
- 13 ALL PRODUCTS SPECIFIED ARE FEATURED IN PRODUCT BROCHURES FROM THE MANUFACTURER.
- 14 SECURITY / LOW VOLTAGE SUBCONTRACTOR TO LABEL, PROGRAM, AND INSTALL WIRING TO SECURITY PANEL.

SECURITY SYSTEM NOTES

- S1 (1)HONEYWELL ADEMP00 VISTA - 20P (8) ZONE CONTROL PANEL AND (1) HONEYWELL #4219 ADEMO VISTA EXPANDER MOUNTED IN THE CASH OFFICE ABOVE CEILING. SECURITY CONTRACTOR TO CLEARLY LABEL SECURITY PANEL.
- S2 (1)HONEYWELL #6160 KEYPAD MOUNTED OUTSIDE OF THE MANAGERS OFFICE WALL. BOTTOM OF KEYPAD SHALL BE 44" AFF.
- S3 (1)HONEYWELL WAVE2 2-TONE SOUNDER (SIREN HORN) ON THE MANAGERS OFFICE WALL FACING THE SALES FLOOR MOUNTED AT 12" AFF.
- S4 (1)HONEYWELL #FG1625 GLASS BREAK DETECTOR CEILING MOUNTED IN THE MIDDLE OF THE VESTIBULE 5 FEET FROM THE PERIMETER GLASS PANES ENTRANCE/EXIT DOORS. GLASS BREAK DETECTOR SHOULD FACE GLASS PANES.
- S5 (1)HONEYWELL #FG1625 GLASS BREAK DETECTOR ALONG THE INTERIOR OF GLASS STOREFRONT 5 FEET FROM GLASS PANES FOR EVERY 25 FEET OF STOREFRONT GLASS. GLASS BREAK DETECTORS SHOULD FACE GLASS PANES.
- S6 (1)WALL MOUNTED BOSCH #SC-PDL1-W15G SERIES TRITECH PIR/MICROWAVE DETECTOR MOUNTED AT 9'-6" AFF FOR 60 LINEAR FOOT OF STOREFRONT GLASS SHOOTING SIDEWAYS ACROSS THE GLASS. NO MOTION DETECTORS IN THE VESTIBULE.
- S7 (1)CEILING MOUNTED 360° BOSCH #DS9370 PANORAMIC TRITECH DETECTOR AT 12' TO 25' AFF FOR STOREFRONT GLASS IN THE EVENT (S6) CANNOT BE WALL MOUNTED.
- S8 (1)WALL MOUNTED BOSCH #SC-PDL1-W15G SERIES TRITECH PIR/MICROWAVE DETECTOR ABOVE VESTIBULE DOOR FRAME FACING SALES FLOOR MOUNTED AT 9'-6" AFF.
- S9 (1)CEILING MOUNTED 360° BOSCH #DS9370 PANORAMIC TRITECH DETECTOR IN THE CENTER OF THE CASH OFFICE AWAY FROM ANY AIR DEVICES.
- S10 (1)WALL MOUNTED BOSCH #SC-PDL1-W15G SERIES TRITECH PIR/MICROWAVE DETECTOR ABOVE ALL EGRESS DOOR FRAMES (EXCEPT IF EGRESS DOOR IS ADJACENT TO RECEIVING OVERHEAD DOOR) AT 8'-0" AFF.
- S11 MAIN CUSTOMER ENTRANCE / EXIT DOORS: FOR NEW DORMA DOORS, WIRE INTO THE DOOR FRAME HEADER TO POINT OF CONNECTION TERMINAL STRIP.
- S12 (1) NASCOM N200A/UST DOOR CONTACT FOR EXTERIOR DOORS AND ROOF HATCH (IF APPLICABLE). (2) DOOR CONTACTS REQUIRED AT DOUBLE DOORS.
- S13 (1) HONEYWELL #999 DOOR CONTACT FOR OVERHEAD DOOR.
- S14 (1) CEILING MOUNTED 360° BOSCH #DS9370 PANORAMIC TRITECH DETECTOR IN THE CENTER OF THE RECEIVING AREA MOUNTED AT 15' TO 25' AFF. (NO OTHERS NEEDED IN SALES REPLISHMENT).

GENERAL ELECTRICAL DEMOLITION NOTES

- 1) NO ATTEMPT HAS BEEN MADE TO INDICATE ALL EXISTING ELECTRICAL DEVICES, LIGHT FIXTURES, COMMUNICATION DEVICES, WIRING, CONDUIT, ETC. TO BE REMOVED AND/OR RELOCATED. HOWEVER, THE ELECTRICAL CONTRACTOR SHALL FIELD VERIFY THE EXTENT OF DEMOLITION PRIOR TO SUBMITTING BID.
- 2) REMOVE AND/OR RELOCATE EXISTING DEVICES ON WALLS OR CEILING BEING REMOVED. COORDINATE SUCH CONDITIONS WITH ARCHITECTURAL DRAWINGS.
- 3) ALL UNUSED WIRE (POWER & COMMUNICATION) SHALL BE REMOVED.
- 4) ALL EXISTING WIRING (POWER & COMMUNICATION) THAT IS TO REMAIN SHALL BE REWORKED OR REPLACED WITH CODE COMPLIANT MATERIAL & SUPPORTS. ANY EXISTING SURFACE MOUNTED CONDUITS SHALL BE REMOVED OR RELOCATED SO THAT THEY ARE IN THE JOIST SPACE OR WITHIN WALL CAVITIES.

ELECTRICAL KEY NOTES

- E1 4"x8"x1/4" PAINTED FIRE RATED PLYWOOD FOR TELEPHONE BACKBOARD. REFER TO DETAIL ON SHEET E2.2 FOR MORE DETAILS.
- E2 1-1/2" EMT CONDUIT FROM 9' AFF TO JOIST SPACE HOMERUN CONTINUOUS CONDUIT TO TELEPHONE DEMARK (COORDINATE LOCATION WITH LANDLORD). STUB CONDUIT AT 8' AFF TO TELEPHONE DEMARK.
- E3 12"x1/2" COPPER BUS BAR MOUNTED AT 84" AFF U.O.N. ON INSULATORS. PROVIDE BAR WITH (6) EQUALLY SPACED 3/8" DIAMETER HOLES. CONNECT BAR TO HFT'S MAIN PANELS GROUND BAR WITH #4AWG COPPER CONDUCTORS.
- E4 4" DIAMETER EMT CONDUIT RISER FROM JOIST SPACE INTO TOP OF RACK.
- E5 2 COMPARTMENT POWER POLE.
- E6 20A 120 VOLT DUPLEX RECEPTACLE AT JOIST SPACE FOR SECURITY CAMERA MONITOR. COORDINATE EXACT LOCATION WITH COMMUNICATIONS CONTRACTOR. MOUNT FLUSH IN CEILING WHERE CEILING OCCUR. RECEPTACLE SHALL BE WHITE WITH WHITE COVER PLATE. COORDINATE EXACT LOCATION WITH SECURITY VENDOR.
- E7 PROVIDE 2 GANG BOX WITH 1 1/2" CONDUIT & PULL STRING TO JOIST SPACE.
- E8 (3) 1 1/2" CONDUITS & PULL STRINGS FROM TOP OF SECURITY PANEL TO JOIST SPACE.
- E9 1" CONDUIT WITH PULL STRING FROM AMPLIFIER TO JOIST SPACE.
- E10 FLUSH SINGLE GANG BOX MOUNTED AT 48" AFF WITH 3/4" EMT CONDUIT STUB TO CEILING JOIST.
- E11 FLUSH SINGLE GANG BOX MOUNTED AT 114" AFF AT VESTIBULE AND AT 96" AFF AT ALL OTHER LOCATIONS WITH 3/4" EMT CONDUIT TO JOIST SPACE FOR MOTION SENSOR.
- E12 3/4" CONDUIT STUBBED INTO DOOR FRAME FOR DOOR CONTACT.
- E13 PROVIDE 2 GANG BOX AT 4" AFF. WITH 3/4" CONDUIT STUB TO JOIST SPACE FOR OVERHEAD DOOR CONTACT.
- E14 PROVIDE OCTAGONAL BOX ON BOTTOM OF JOIST.

COMMUNICATIONS KEY NOTES

- C1 25 PAIR CAT3 24AWG TWISTED PAIR CABLE. TERMINATE AT TELEPHONE DEMARK AS DIRECTED BY TELEPHONE COMPANY. TERMINATE AT HFT PHONE BOARD ON 66 PUNCH DOWN BLOCK.
- C2 (3) 4 PAIR CAT 6 24AWG CABLES BETWEEN HFT PHONE BOARD & RACK. TERMINATE ON BOTH ENDS.
- C3 24"Wx43"Dx8"H FLOOR MOUNTED LOCKABLE RACK PER HFT STANDARDS.
- C4 (2) 4 PAIR CAT 6 24AWG DATA CABLE BETWEEN REGISTERS & HFT RACK. TERMINATE ON BOTH ENDS.
- C5 (1) 4 PAIR CAT 6 24AWG CABLE BETWEEN REGISTER & HFT RACK FOR TELEPHONE. TERMINATE ON BOTH ENDS.
- C6 HFT VENDOR SHALL PROVIDE, WIRE & INSTALL SALES AREA SPEAKERS.
- C7 HFT VENDOR SHALL PROVIDE, WIRE & INSTALL SALES REPLISHMENT AREA SPEAKERS.
- C8 (1) 4 PAIR CAT 6 24AWG CABLE BETWEEN DOCK DOOR & HFT RACK FOR TELEPHONE. TERMINATE ON BOTH ENDS.
- C9 SECURITY CAMERA & (1) CAT 6 24AWG 4 PAIR CABLE FROM CAMERA TO RACK. TERMINATE CABLES AT BOTH ENDS. VERIFY EXACT LOCATION OF CAMERAS WITH CCTV VENDOR PRIOR TO ROUGH IN.
- C10 (1) CAT 6 24AWG CABLE FROM TRAFFIC COUNTER TO HFT RACK. TERMINATE AT BOTH ENDS.
- C11 (1) CAT 6 24AWG CABLE FROM WIRELESS ACCESS POINT TO HFT RACK. TERMINATE AT BOTH ENDS.
- C12 (1) CAT 6 24AWG 4 PAIR CABLE FROM TIME CLOCK (CENTERED BETWEEN WINDOW & DOOR) TO HFT RACK. TERMINATE AT BOTH ENDS.
- C13 (2) CAT 6 24AWG 4 PAIR CABLES FROM PRINTER/FAX TO HFT RACK. TERMINATE AT BOTH ENDS.
- C14 (2) CAT 6 24AWG 4 PAIR CABLES FROM MANAGERS WORK STATION TO HFT RACK. TERMINATE AT BOTH ENDS.
- C15 (1) RG59 COAXIAL CABLE FROM CCTV MONITOR TO RACK. TERMINATE AT BOTH ENDS.
- C16 (1) CAT 6 24AWG 4 PAIR CABLE FROM CASH ROOM TO HFT RACK. TERMINATE AT BOTH ENDS.
- C17 (1) RJ31X PHONE JACK MOUNTED AT -10" AFF FOR SECURITY PANEL.
- C18 (1) RJ31X PHONE JACK & 4 PAIR CAT 6 24AWG CABLE BETWEEN PHONE BOARD & HFT RACK FOR FIRE ALARM PANEL. TERMINATE ON BOTH ENDS. (TO BE PROVIDED WHEN FIRE ALARM SYSTEM IS TO BE INSTALLED).


COMMUNICATIONS SYMBOL LEGEND

SYMBOL	DESCRIPTION
	SECURITY CAMERA
	DOOR CONTACT
	GLASS BREAK DETECTOR
	CEILING MOUNTED 360° DETECTOR
	WALL MOUNTED MOTION DETECTOR
	POWER POLE
	SPEAKERS
	WIRELESS ACCESS POINT
	DATA CABLE
	SPEAKERS & AMPLIFIER

COMMUNICATIONS CONTRACTOR SHALL REFER TO ARCHITECTURAL DRAWING A0.0 FOR COMMUNICATIONS DEVICES AND ACCESSORIES PROVIDED BY HARBOR FREIGHT TOOLS

COMMUNICATIONS CONTRACTOR TO REVIEW AND COMPLY WITH THE REQUIREMENTS OF GENERAL NOTES ON SHEET A0.2

CONDUITS, LOW VOLTAGE WIRING OR MOUNTING HARDWARE SHALL NOT BE DIRECTLY MOUNTED TO THE ROOF DECK.

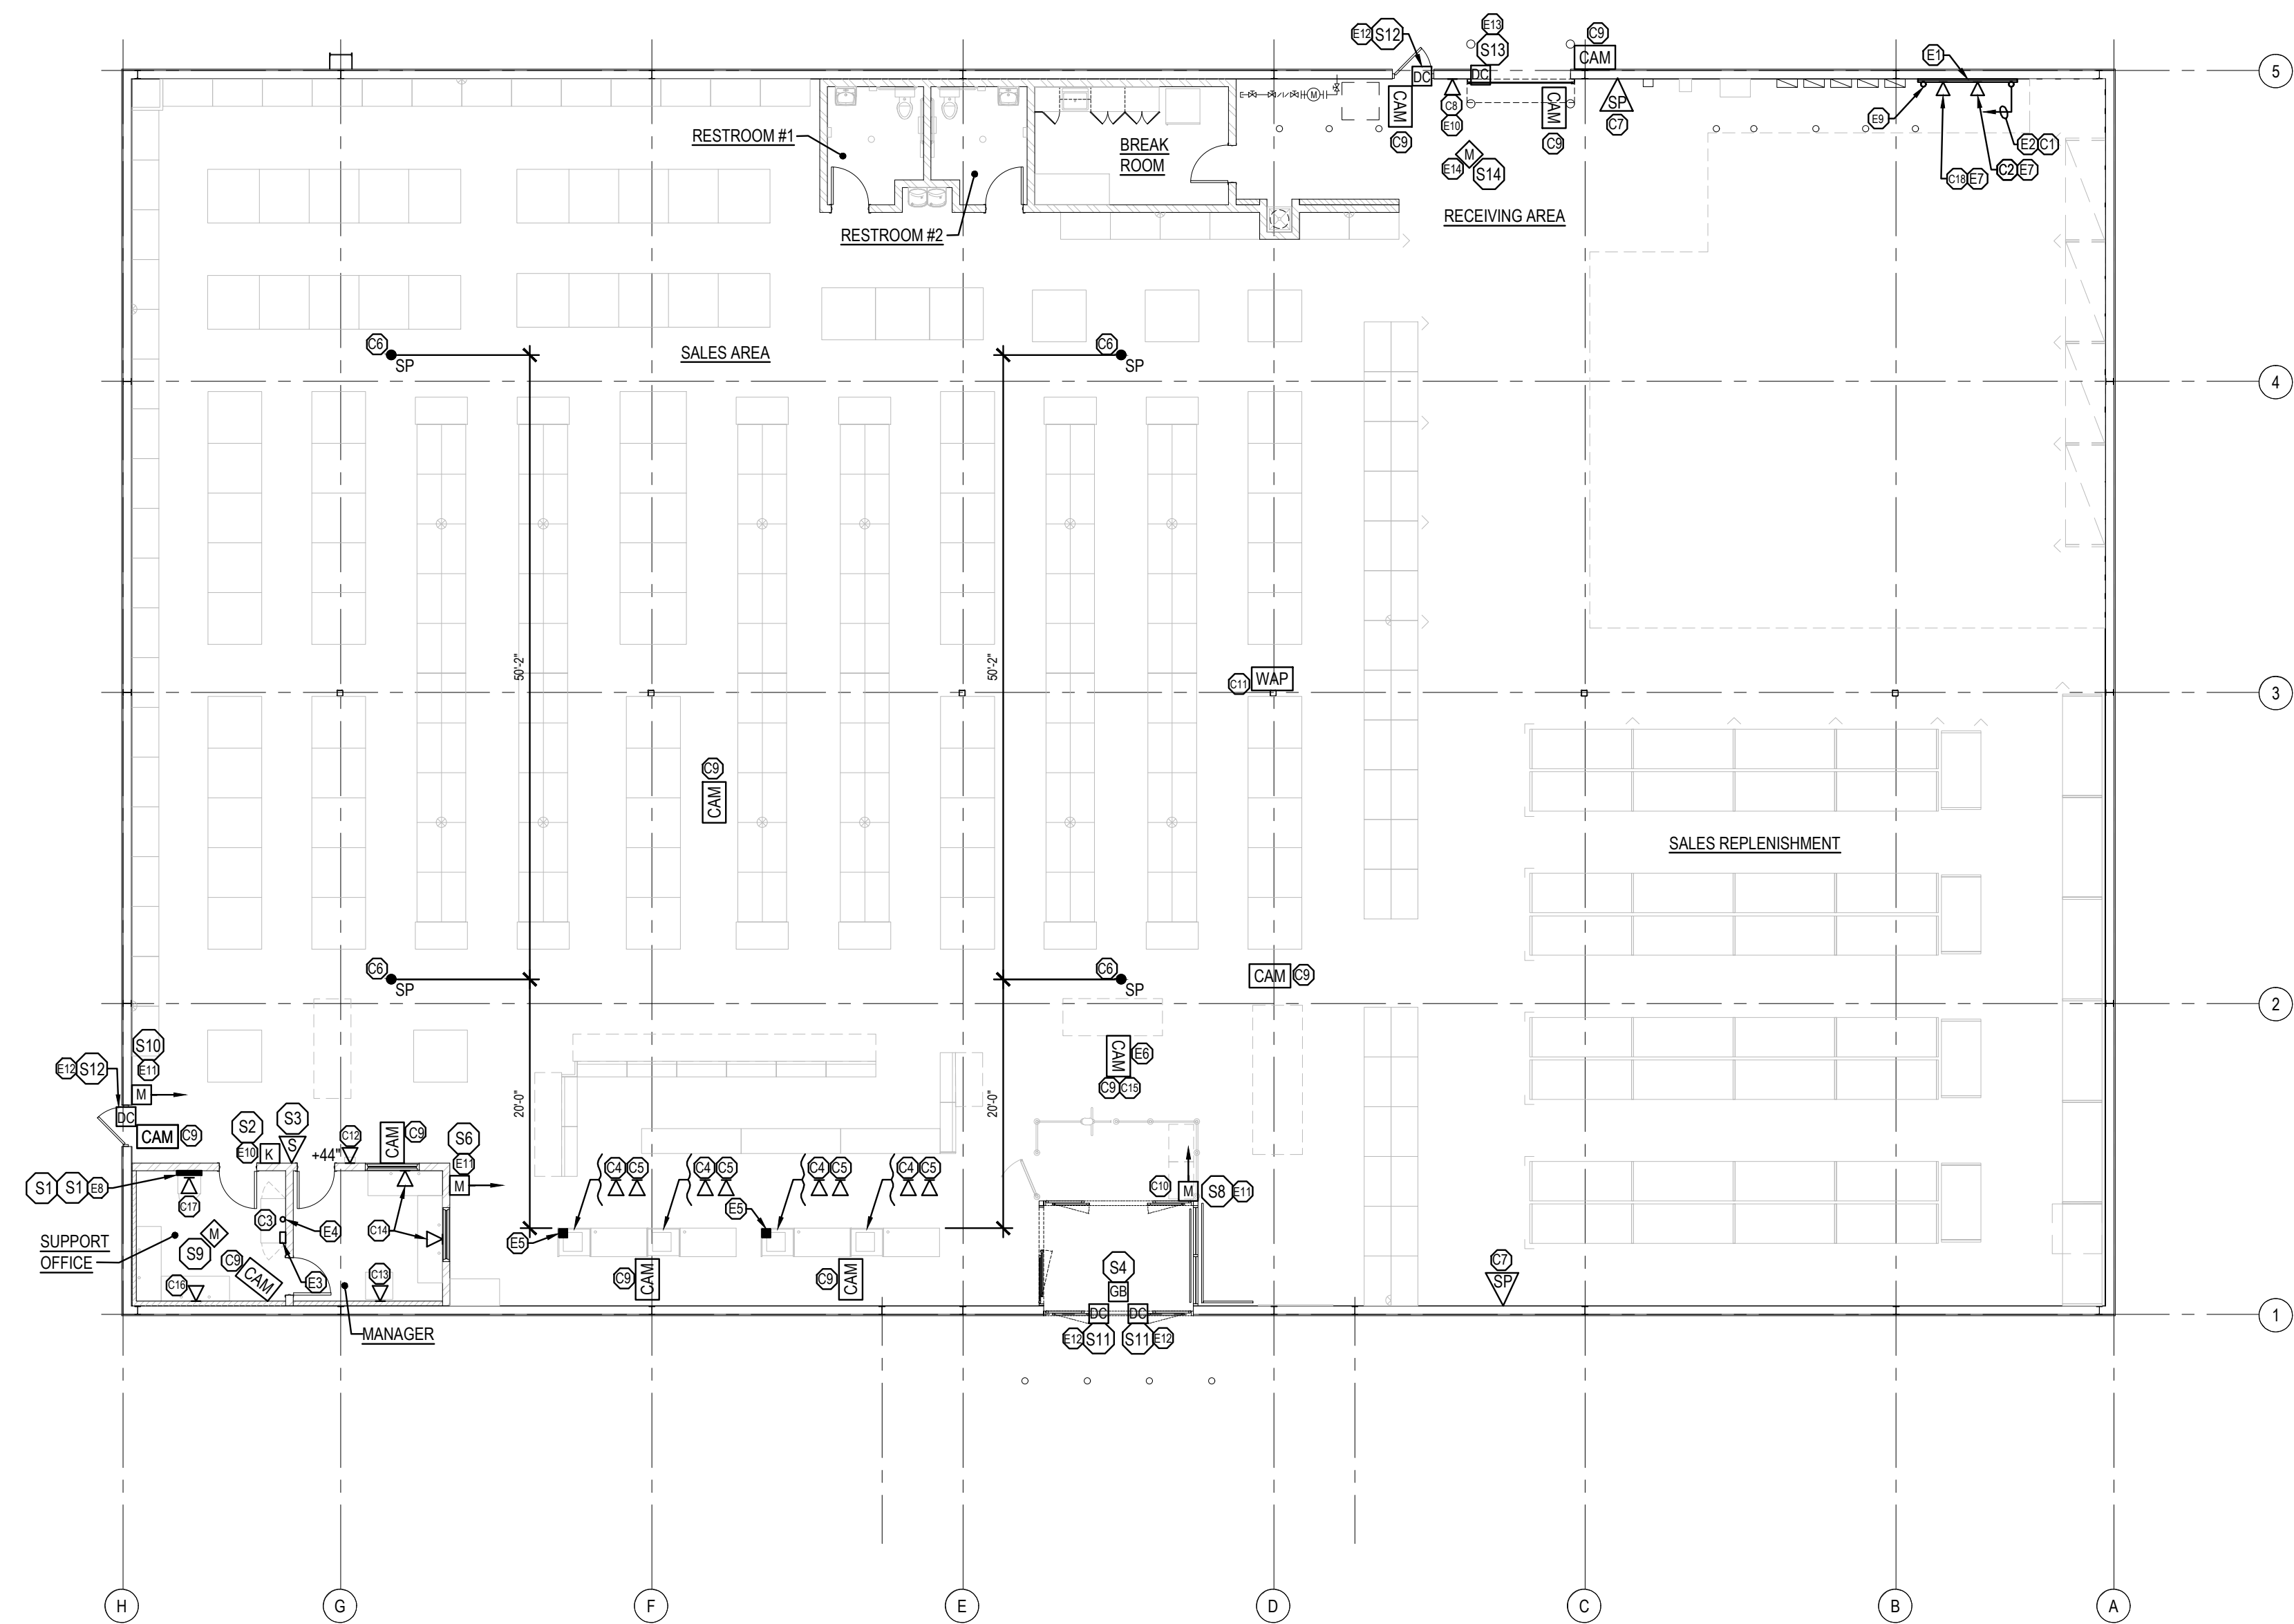

COMMUNICATIONS PLAN
SCALE 3/32" = 1'-0"

Brian M. Schuler, P.E.

155 Williamsburg Drive
Avon Lake, Ohio 44012
Phone: 216-244-4120

BRIAN M. SCHULER
05-17-24



DO NOT SCALE THESE DRAWINGS

#	DATE	TYPE
1		
2		
3		
4		
5		
6		
7		
8		
9		
10		

REVISIONS

COMMUNICATIONS PLAN

DATE 05/17/24

JOB NO. 23475


E1.2
SHEET NO.

ADDA ARCHITECTS
Lakewood, Ohio 44107
17710 Detroit Avenue
Phone (216) 521-5134
Fax (216) 521-4824
www.addaarchitects.com


HARBOR FREIGHT
ERWIN, NC 28839
46 SHRILJI LANE

THESE DOCUMENTS CONTAIN INFORMATION PROPRIETARY TO ADA ARCHITECTS, INC.
UNAUTHORIZED USE OF THESE DOCUMENTS IS EXPRESSLY PROHIBITED UNLESS AGREED UPON IN WRITING.

SYMBOL	DESCRIPTION
A-2 → A-2	HOMERUN TO PANEL "A" INDICATING CIRCUIT NUMBER(S) - ALL WIRING SHALL BE #12 WITH EQUIPMENT GROUND WIRE UON (INCREASE TO #10 FOR CIRCUITS OVER 100 FT.) - ALL HOMERUNS ARE TO A 20 AMPERE, 1 POLE CIRCUIT BREAKER U.O.N. - QUANTITY OF CONDUCTORS AS NECESSARY TO ACCOMMODATE CIRCUITS AND CONTROL INDICATED. CROSS HATCHES INDICATE REQUIRED LIGHTING CONTROL U.O.N.
---	CONDUIT RUN UNDER FLOOR SLAB (1" C. MINIMUM, UON) (INSIDE)
---	SCHEDULE 40 PVC CONDUIT RUN AT 36" BELOW FINISHED GRADE U.O.N. CONTRACTOR SHALL BORE BELOW STREET. COORDINATE WITH CITY. TRANSITION TO HEAVYWALL RIGID STEEL CONDUIT 2 FEET BELOW GRADE WHEN CONDUIT IS TO RISE ABOVE GRADE. (OUTSIDE)
S	SWITCH - 20 AMPERE, 120/277 VOLT, SINGLE POLE - MTD AT 48" AFF UON ("n" DENOTES SWITCHING, "K" = KEY OPERATED, "P" = PILOT LIGHT, "L" = ILLUMINATED TOGGLE, "3" = THREE-WAY, "4" = FOUR-WAY, "M" = MANUAL MOTOR STARTER, "D" = DIMMER SWITCH "LUTRON NOVA SERIES")
⊕	DUPLEX RECEPTACLE - 20 AMPERE, 125 VOLT - MOUNTED AT 15" AFF UON (TO BOTTOM), SUBSCRIPT "T" DENOTES TAMPER RESISTANT. C=WHITE RECEPTACLE & COVER MOUNTED FLUSH IN CEILING. IF CEILING IS MORE THEN 15" ABOVE TOP OF WINDOW MOUNT RECEPTACLES 12" ABOVE TOP OF WINDOW. IG= ISOLATED GROUND TYPE. TVSS= SURGE PROTECTED TYPE. ALL EXTERIOR RECEPTACLES SHALL BE WEATHER RESISTANT LABELED "WR".
⊕	DOUBLE DUPLEX RECEPTACLE - 20 AMPERE, 125 VOLT - MOUNTED AT 15" AFF UON (TO BOTTOM)
⊕	DUPLEX RECEPTACLE MOUNTED IN A FLUSH FLOOR BOX. PROVIDE ALUMINIUM DUAL FLIP LID ACTIVATION KIT.
⊕	JUNCTION BOX - MOUNTING HEIGHT AND SIZE AS REQUIRED BY CODE OR AS NOTED ON DRAWINGS
⊕	JUNCTION BOX - FOR SIGN. PROVIDE LOCAL DISCONNECT & COORDINATE LOCATION & MOUNTING HEIGHT WITH SIGN CONTRACTOR IN THE FIELD.
⊕	HEAVY DUTY NON FUSIBLE DISCONNECT SWITCH.
⊕	HEAVY DUTY FUSIBLE DISCONNECT SWITCH. FUSE SIZE TO BE DETERMINED FROM EQUIPMENT TO BE SERVED NAMEPLATE DATA.
⊕	FLUSH COMMUNICATIONS OUTLET WITH TWO GANG BOX SINGLE GANG EXTENSION RING. MOUNTED AT 15" AFF U.O.N. (TO BOTTOM) AND 1" CONDUIT, STUBBED TO NEAREST ACCESSIBLE CEILING. PROVIDE BLANK COVER. W=MOUNTED 54" AFF.
⊕	COMMUNICATION OUTLET MOUNTED IN A FLUSH FLOOR BOX. PROVIDE (4) JACKS AND AN ALUMINIUM DUAL FLIP LID ACTIVATION KIT.
⊕	SPECIAL NEMA CONFIGURED OUTLET MOUNTED AS REQUIRED TO SERVE APPLIANCE. VERIFY CONFIGURATION PRIOR TO ROUGH-IN AND ADJUST WIRING AND CIRCUIT BREAKER SIZE AS REQUIRED.
• GR	GROUND ROD- 3/4" X 10' COPPER CLAD
12-4	WIRE LEGEND TAG (12= CONDUCTOR SIZE, 4= QUANTITY OF CONDUCTORS)
DD	DUCT MOUNTED SMOKE DETECTOR. SEE DETAIL THIS SHEET.
AFF	ABOVE FINISHED FLOOR
AC	INDICATES DEVICE MOUNTED AT 8" ABOVE COVER
EC	ELECTRICAL CONTRACTOR
GFI	GROUND FAULT CIRCUIT INTERRUPTER TYPE
UON	UNLESS OTHERWISE NOTED
IG	ISOLATED GROUND
EX	EXISTING TO REMAIN
NL	NIGHT LIGHT
Soc	WALL MOUNTED MULTI TECHNOLOGY DUAL CIRCUIT VACANCY SENSOR WITH WHITE FINISH HUBBEL # LHMTS-2WH
Soc	WALL MOUNTED MULTI TECHNOLOGY SINGLE CIRCUIT OCCUPANCY SENSOR WITH WHITE FINISH HUBBEL # LHMTS1WH
⊕	CEILING MOUNTED OCCUPANCY SENSOR HUBBELL #OMNIDT1000-UVPP
R	20A 120 VOLT RECEPTACLE MOUNTED AT 15" AFF U.O.N. CONTROLLED BY LOCAL OCCUPANCY SENSOR. PROVIDE COVERPLATE WITH BLACK SCREENED LETTERS "SWITCHED".
OS	FIXTURE MOUNTED OCCUPANCY SENSOR. INSTALL LOW MOUNT LENS FOR FIXTURES MOUNTED AT 16" AND LOWER. CAP INTEGRAL PHOTOCELL CONTROL WIRES. SET TIMED OFF TO 20 MINUTES. HUBBELL #WSP-EM-LIN-V-(L360, L180, OR L4)
S _{DL}	LED DIMMER SWITCH FOR MANUAL CONTROL OF SALES AND SALES REPLENISHMENT FLOOR LIGHTING. PROVIDED BY E.C. FOR SIEMENS EMS SYSTEM. 0-10V DIMMER EATON #SF10P-W.
S _{oc}	WALL MOUNTED DUAL TECHNOLOGY VACANCY SENSOR WITH INTEGRAL PHOTOCELL & 0-10V DIMMER. HUBBELL #LHDMTS-2WH.
⊕	PHOTO SENSOR FOR SIEMENS EMS SYSTEM. WIRED AND INSTALLED BY EMS VENDOR.
S _{LV}	LOW VOLTAGE CONTROLLER. (DO NOT WIRE DIMMING FUNCTION.) WATTSTOPPER #LV-SW-101.
⊕	CEILING MOUNTED VACANCY SENSOR / POWER PACK. WATTSTOPPER #DT300-BZ-250.

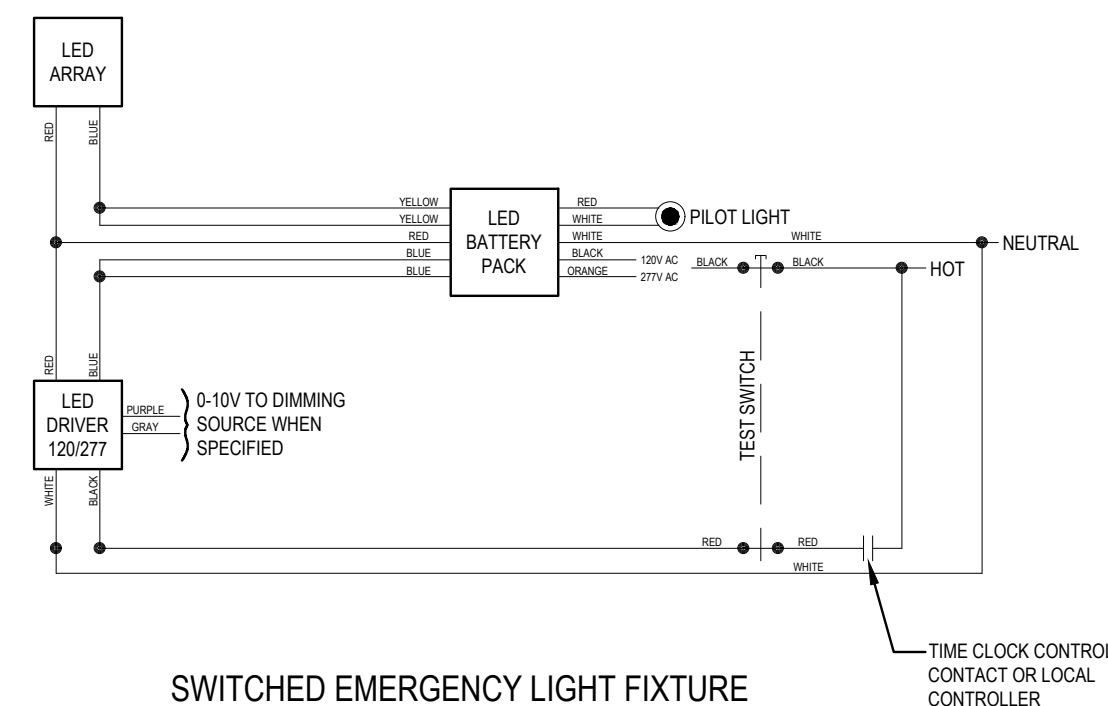

SWITCHED EMERGENCY LIGHT FIXTURE TYPICAL WIRING SCHEMATIC

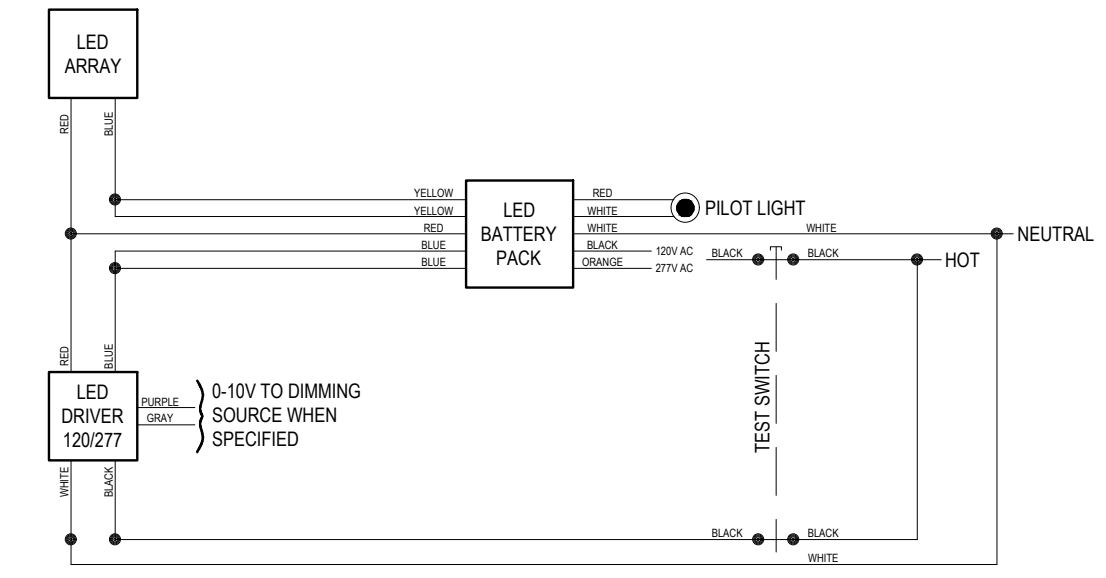

EMERGENCY NIGHT LIGHT FIXTURE TYPICAL WIRING SCHEMATIC

	LIGHTING SCHEDULE				INTERIOR SIGN	
	PARKING LOT / NON SECURITY BUILDING FIXTURES	EXTERIOR SIGNS / SECURITY BUILDING FIXTURES	INDOOR LIGHTS (MON-SAT.)	INDOOR LIGHTS (SUNDAY)	MON-SAT	SUNDAY
ON	DUSK (BY PHOTOCELL)	DUSK TO DAWN PHOTOCELL (ALWAYS ON DURING DARK)	7:00 AM	8:00 AM	STORE OPEN	STORE OPEN
OFF	10:15 PM	DURING THE DAY	10:00 PM	8:00 PM	9:00 PM	6:00 PM
LIGHTING CONTROL ZONE	GROUP 4	GROUP 3	GROUP 1	GROUP 1	GROUP 2	GROUP 2
NOTES:	THE SYSTEM CAN BE OVERRIDDEN BY THE SECURITY KEYPAD. THE TOUCH SCREEN CONTROLLER SHALL BE CAPABLE OF MANUALLY TURNING OFF GROUP 2 LIGHTING CONTACTORS. COORDINATE ON/OFF TIMES WITH HARBOR FREIGHT PRIOR TO PROGRAMMING.					


WIRE LEGEND					
Tag	Fill	Tag	Fill	Tag	Fill
(No Tag)	(2) #12, #12GND-3/4" C	(4)	(4) #4, #4GND-1 1/4" C	(40-3)	(3) #40, #2GND-2" C
12-3	(4) #12, #12GND-3/4" C	(2-2)	(2) #2, #4GND-1" C	(40-4)	(4) #40, #2GND-2 1/2" C
12-4	(4) #12, #12GND-3/4" C	(2-3)	(2) #2, #4GND-1 1/4" C	(300-2)	(2) 300KCMIL #10GND-2" C
10-2	(2) #10, #10GND-3/4" C	(2-4)	(2) #2, #4GND-1 1/4" C	(300-3)	(3) 300KCMIL #10GND-2 1/2" C
10-3	(3) #10, #10GND-3/4" C	(1-2)	(2) #1, #4GND-1 1/4" C	(300-4)	(4) 300KCMIL #10GND-2 1/2" C
10-4	(4) #10, #10GND-3/4" C	(1-3)	(3) #1, #4GND-1 1/4" C	(350-2)	(2) 350KCMIL #30GND-2" C
8-2	(2) #8, #8GND-3/4" C	(1-4)	(4) #1, #4GND-1 1/2" C	(350-3)	(3) 350KCMIL #30GND-2 1/2" C
8-3	(3) #8, #8GND-1" C	(10-2)	(2) #10, #2GND-1 1/4" C	(350-4)	(4) 350KCMIL #30GND-3" C
8-4	(4) #8, #8GND-1" C	(10-3)	(3) #10, #2GND-1 1/2" C	(500-2)	(2) 500KCMIL #30GND-2 1/2" C
6-2	(2) #6, #6GND-1" C	(10-4)	(4) #10, #2GND-2 1/2" C	(500-3)	(3) 500KCMIL #30GND-3" C
6-3	(3) #6, #6GND-1" C	(30-2)	(2) #30, #2GND-1 1/2" C	(500-4)	(4) 500KCMIL #30GND-3 1/2" C
6-4	(4) #6, #6GND-1" C	(30-3)	(3) #30, #2GND-2" C	(600-2)	(2) 600KCMIL #30GND-3" C
4-2	(2) #4, #4GND-1" C	(30-4)	(4) #30, #2GND-2" C	(600-3)	(3) 600KCMIL #30GND-3 1/2" C
4-3	(3) #4, #4GND-1" C	(40-2)	(2) #40, #2GND-2" C	(600-4)	(4) 600KCMIL #30GND-3 1/2" C

NOTE: CONDUIT SIZES ARE FOR EMT & MC. FOR PVC & RSC INCREASE CONDUIT BY (1) TRADE SIZE. FOR FLEXIBLE CONDUIT SIZES REFER TO NEC. ALL WIRE SIZES SHOWN ON DRAWINGS ARE FOR COPPER CONDUCTORS. INCREASE CONDUIT ONE TRADE SIZE FOR ISOLATED GROUND CONDUCTOR IF REQUIRE TO ACCOMMODATE ALL CONDUCTORS

ELECTRICAL CONTRACTOR SHALL PROVIDE & INSTALL HEAVY DUTY WATERPROOF PAD LOCK FOR EACH DISCONNECT SWITCH. AMERICAN LOCK #A5460. PADLOCKS SHALL BE KEYS ALIKE. PROVIDE 15 KEYS TO LANDLORD & 15 KEYS TO HFT.

CONTRACTOR SHALL COORDINATE ALL LOCAL REQUIREMENTS WITH REGARDS TO CONNECTING THE ELECTRICAL SERVICE METER, CT BOXES, DISCONNECT SWITCHES ETC. SHALL BE PURCHASED & INSTALLED PER THE LOCAL POWER COMPANY REQUIREMENTS & AUTHORITY HAVING JURISDICTION. COORDINATION SHALL OCCUR WITHIN **1 WEEK** OF RECEIVING CONTRACT. INCLUDE IN BID ANY EXPEDITED SHIPPING CHARGES FOR ANY LONG LEAD ELECTRICAL DISTRIBUTION EQUIPMENT. COORDINATE ANY REQUIRED SERVICE SHUT DOWNS WITH LANDLORD.

FOR ANY SUBSTITUTIONS OF THE ELECTRICAL DISTRIBUTION EQUIPMENT INVOLVING EQUIPMENT WITH A LOWER SHORT CIRCUIT RATING THAN WHAT IS SPECIFIED ON THE DRAWINGS, THE ELECTRICAL CONTRACTOR SHALL PROVIDE IN WRITING THE AVAILABLE SHORT CIRCUIT CURRENT AT THE POWER COMPANY TRANSFORMER FROM THE POWER COMPANY AS WELL AS A SHORT CIRCUIT ANALYSIS TO THE MAIN PANEL POWERING THE SPACE (INCLUDE 4 TIMES THE MOTOR LOAD OF THE SYSTEM IN YOUR CALCULATION) IN ORDER FOR THE ENGINEER TO EVALUATE IF THE SUBSTITUTION IS VALID. FAILURE TO DO SO WILL RESULT IN AUTOMATIC REJECTION OF THE SUBSTITUTION.

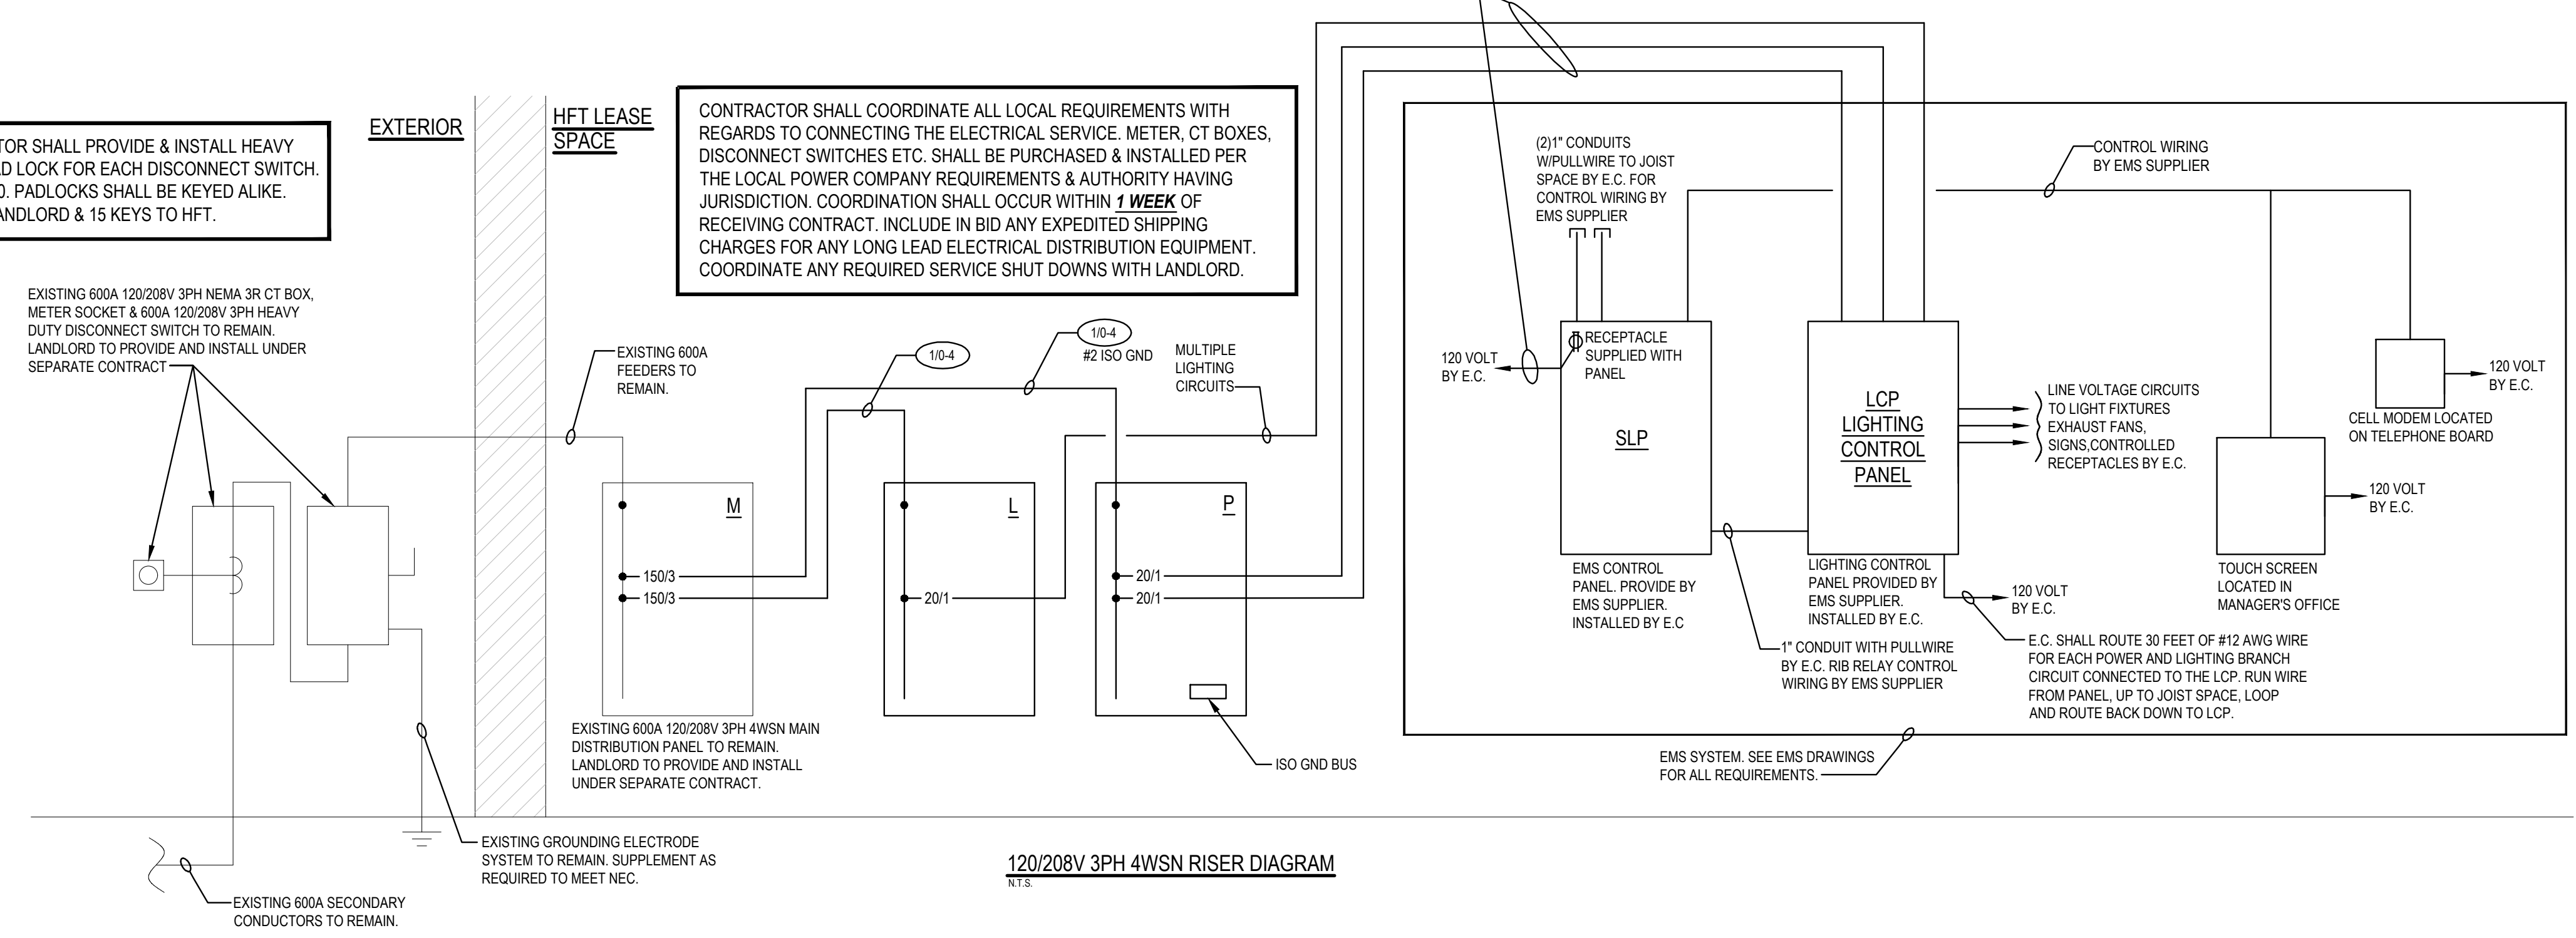

Brian M. Schuler, P.E.
 155 Williamsburg Drive
 Avon Lake, Ohio 44012
 Phone: 216-244-4120

BRIAN M. SCHULER
 05-17-24
 SEAL 033582
 N.C. PROFESSIONAL ENGINEER No. 033582

DO NOT SCALE THESE DRAWINGS

ADAA ARCHITECTS

Lakewood, Ohio 44107
 17710 Detroit Avenue
 Phone (216) 521-5134
 Fax (216) 521-1484
 www.adaarchitects.com

HARBOR FREIGHT

46 SHRUI LANE
 ERWIN, NC 28839

THESE DOCUMENTS CONTAIN INFORMATION PROPRIETARY TO ADA ARCHITECTS, INC. UNAUTHORIZED USE OF THESE DOCUMENTS IS EXPRESSLY PROHIBITED UNLESS AGREED UPON IN WRITING.

#	DATE	TYPE
1		
2		
3		
4		
5		
6		
7		
8		
9		
10		

ONE LINE DIAGRAM & DETAILS

DATE: 05/17/24
 JOB NO.: 23475

E2.0

SHEET NO.

'LCP' LIGHTING CONTACTOR SCHEDULE				
CIRCUIT	DESCRIPTION	ZONE	CONTACTOR SIZE	CONTACTOR #
L-1	EMPLOYEE LIGHTING	GROUP 1	30A4P	1
L-3	EMPLOYEE LIGHTING	GROUP 1		
L-6	EMPLOYEE LIGHTING	GROUP 1		
L-9	EMPLOYEE LIGHTING	GROUP 1	30A4P	2
P-41	EXHAUST FAN	GROUP 1		
L-12	SALES REPLISHMENT LTG.	GROUP 1		
L-14	SALES REPLISHMENT LTG.	GROUP 1	30A4P	3
L-16	SALES REPLISHMENT LTG.	GROUP 1		
-	SPARE	GROUP 1		
-	SPARE	GROUP 1	30A4P	4
-	SPARE	GROUP 1		
L-2	CUSTOMER LIGHTING	GROUP 2		
L-4	CUSTOMER LIGHTING	GROUP 2	30A4P	5
L-5	CUSTOMER LIGHTING	GROUP 2		
L-7	CUSTOMER LIGHTING	GROUP 2		
L-8	CUSTOMER LIGHTING	GROUP 2	30A4P	6
P-13	INTERIOR SIGN	GROUP 2		
-	SPARE	GROUP 2		
L-23	FURNITURE RECEPTACLES	GROUP 2	30A4P	7
L-25	FURNITURE RECEPTACLES	GROUP 2		
L-27	FURNITURE RECEPTACLES	GROUP 2		
L-29	FURNITURE RECEPTACLES	GROUP 2	30A4P	8
L-17	EXTERIOR SECURITY LIGHTING	GROUP 3		
P-40	EXTERIOR SIGN	GROUP 3		
M-39	EXISTING PYLON SIGN	GROUP 3	30A4P	9
-	SPARE	GROUP 3		
L-19	EXTERIOR LIGHTING	GROUP 4		
-	SPARE	GROUP 4	30A4P	10
-	SPARE	GROUP 4		
M-31	EXISTING SITE LIGHTING	GROUP 4		
M-33	EXISTING SITE LIGHTING	GROUP 4	30A4P	10
-	SPARE	GROUP 4		
-	SPARE	GROUP 4		

LIGHT FIXTURE SCHEDULE												
TYPE	SYMBOL	DESCRIPTION	MANUFACTURER	LAMPS	VOLT	WATTS	REMARKS					
A		2x4 LED TROFFER FOR INSTALLATION IN LAY-IN ACOUSTIC CEILING TILE GRID	COLUMBIA LIGHTING# LCAT24-40LV-G-U-EDU-PNCS	LED 4000K	120/277	59	OFFICES	FACTORY INSTALLED WHIP CONNECTION.				
AE		2x4 LED TROFFER WITH 1400 LUMEN BATTERY FOR INSTALLATION IN LAY-IN ACOUSTIC CEILING TILE GRID	COLUMBIA LIGHTING# LCAT24-40LV-G-U-EDU-PNCS-ELL14	LED 4000K	120/277	59	OFFICES	EMERGENCY BATTERY. SEE GENERAL NOTE #1. VERIFY THAT EM BALLAST IS WIRED FOR APPROPRIATE VOLTAGE PRIOR TO WIRING FIXTURE. FACTORY INSTALLED WHIP CONNECTION.				
B		2x4 LED TROFFER FOR INSTALLATION IN LAY-IN ACOUSTIC CEILING TILE GRID	COLUMBIA LIGHTING# LCAT24-40LV-G-U-EDU-PNCS	LED 4000K	120/277	36	TOILET ROOM	FACTORY INSTALLED WHIP CONNECTION.				
BE		2x4 LED TROFFER WITH 1400 LUMEN BATTERY FOR INSTALLATION IN LAY-IN ACOUSTIC CEILING TILE GRID	COLUMBIA LIGHTING# LCAT24-40LV-G-U-EDU-PNCS-ELL14	LED 4000K	120/277	36	TOILET ROOM	EMERGENCY BATTERY. SEE GENERAL NOTE #1. FACTORY INSTALLED WHIP CONNECTION.				
C		8' - LED CHAIN MOUNTED STRIP FIXTURE	COLUMBIA LIGHTING# MPS-8-40-HLHE-CW-EDV-INT-LBC	LED 4000K	120/277	100	SALES & STORAGE AREA	FOR OPEN CEILINGS PROVIDE CHAIN & INSTALL AT HEIGHT NOTED ON E1.1 (CSHC). RUN IN CONTINUOUS ROWS WHERE SHOWN. PROVIDED WITH COUPLER. NOTE #2 & #4				
CE		8' - LED CHAIN MOUNTED STRIP WITH 1400 LUMEN BATTERY	COLUMBIA LIGHTING# MPS-8-40-HLHE-CW-EDV-ELL14-INT-LBC	LED 4000K	120/277	100	SALES & STORAGE AREA	FOR OPEN CEILINGS PROVIDE CHAIN & INSTALL AT HEIGHT NOTED ON E1.1 (CSHC). RUN IN CONTINUOUS ROWS WHERE SHOWN. EMERGENCY BATTERY. SEE GENERAL NOTE #1.2.A. PROVIDED WITH COUPLER.				
C1		4' - LED CHAIN MOUNTED STRIP FIXTURE	COLUMBIA LIGHTING# MPS-4-40-HLHE-CW-EDV-INT-LBC	LED 4000K	120/277	50	SALES & STORAGE AREA	FOR OPEN CEILINGS PROVIDE CHAIN & INSTALL AT HEIGHT NOTED ON E1.1 (CSHC). RUN IN CONTINUOUS ROWS WHERE SHOWN. PROVIDED WITH COUPLER. NOTE #2 & #4				
C1E		4' - LED CHAIN MOUNTED STRIP FIXTURE WITH 1400 LUMEN BATTERY	COLUMBIA LIGHTING# MPS-4-40-HLHE-CW-EDV-ELL14-INT-LBC	LED 4000K	120/277	50	SALES & STORAGE AREA	FOR OPEN CEILINGS PROVIDE CHAIN & INSTALL AT HEIGHT NOTED ON E1.1 (CSHC). RUN IN CONTINUOUS ROWS WHERE SHOWN. EMERGENCY BATTERY. SEE GENERAL NOTE #1.2.A. PROVIDED WITH COUPLER.				
D		8' - LED SURFACE MOUNTED STRIP FIXTURE	COLUMBIA LIGHTING# MPS-8-40-HLHE-CW-EDV	LED 4000K	120/277	100	SALES & STORAGE AREA	SURFACE MOUNTED. FOR CEILING / JOIST MOUNT PROVIDE CEILING CLIPS & SUPPORT FROM STRUCTURE AS REQUIRED BY CODE. FOR JOIST MOUNT, PROVIDE MOUNTING HARDWARE & UNISTRUT AS REQUIRED. RUN IN CONTINUOUS ROWS WHERE SHOWN. PROVIDED WITH COUPLER.				
DE		8' - LED SURFACE MOUNTED STRIP FIXTURE WITH 1400 LUMEN BATTERY	COLUMBIA LIGHTING# MPS-8-40-HLHE-CW-EDV-ELL14	LED 4000K	120/277	100	SALES & STORAGE AREA	SURFACE MOUNTED. FOR CEILING / JOIST MOUNT PROVIDE CEILING CLIPS & SUPPORT FROM STRUCTURE AS REQUIRED BY CODE. FOR JOIST MOUNT, PROVIDE MOUNTING HARDWARE & UNISTRUT AS REQUIRED. RUN IN CONTINUOUS ROWS WHERE SHOWN. EMERGENCY BATTERY. SEE GENERAL NOTE #1.2. PROVIDED WITH COUPLER.				
D1		4' - LED SURFACE MOUNTED STRIP FIXTURE	COLUMBIA LIGHTING# MPS-4-40-HLHE-CW-EDV	LED 4000K	120/277	50	SALES & STORAGE AREA	SURFACE MOUNTED. FOR CEILING / JOIST MOUNT PROVIDE CEILING CLIPS & SUPPORT FROM STRUCTURE AS REQUIRED BY CODE. FOR JOIST MOUNT, PROVIDE MOUNTING HARDWARE & UNISTRUT AS REQUIRED. RUN IN CONTINUOUS ROWS WHERE SHOWN. PROVIDED WITH COUPLER.				
D1E		4' - LED SURFACE MOUNTED STRIP FIXTURE WITH 1400 LUMEN BATTERY	COLUMBIA LIGHTING# MPS-4-40-HLHE-CW-EDV-ELL14	LED 4000K	120/277	50	SALES & STORAGE AREA	SURFACE MOUNTED. FOR CEILING / JOIST MOUNT PROVIDE CEILING CLIPS & SUPPORT FROM STRUCTURE AS REQUIRED BY CODE. FOR JOIST MOUNT, PROVIDE MOUNTING HARDWARE & UNISTRUT AS REQUIRED. RUN IN CONTINUOUS ROWS WHERE SHOWN. EMERGENCY BATTERY. SEE GENERAL NOTE #1.2. PROVIDED WITH COUPLER.				
EM1		SELF-POWERED EXIT SIGN WITH LED LAMPS - UNIVERSAL MOUNTED - SINGLE FACE NOTE #3	COMPASS# CER	LED	120/277	5	SALES & STORAGE AREA	EMERGENCY EXIT LIGHTS EQUIPPED WITH 90 MINUTE BATTERY BACK-UP. WIRE AHEAD OF LOCAL CONTROL.				
EM2		SELF-POWERED EXIT SIGN WITH LED LAMPS - UNIVERSAL MOUNTED - DOUBLE FACE NOTE #3	COMPASS# CER	LED	120/277	5	SALES & STORAGE AREA					
EM3		SURFACE MOUNTED 2 HEAD EMERGENCY UNIT WITH REMOTE CAPACITY	DUAL LITE# L215-03L	LED	120/277	5	SALES & STORAGE AREA	REMOTE CAPACITY				
EM4		EXTERIOR WP 2 LAMP REMOTE HEADS	DUAL LITE# CCR-D-W-0603L	LED	6	-	EXTERIOR	PROVIDE WITH 2 HEAD MOUNTING PLATE. WIRE TO EM3.				
EM5		EXTERIOR WP LED EMERGENCY FIXTURE WITH 4 LAMPS	HUBBELL LIGHTING# PS2	LED	120/277	5	EXTERIOR	WIRE SO THAT FIXTURE IS OFF WHEN BUILDING POWER IS AVAILABLE.				
SA		EXTERIOR WALL MOUNTED FIXTURE	HUBBELL LIGHTING# SG1-20-4K7-0B	LED 4000K	120/277	20	EXTERIOR WALL MOUNTED FIXTURE.	SEE ARCHITECTURAL ELEVATIONS FOR MOUNTING HEIGHT.				
SB		EXTERIOR WALL MOUNTED FIXTURE	HUBBELL LIGHTING# SG2-80-4K7-FT-INV-0B	LED 4000K	120/277	80	EXTERIOR WALL MOUNTED FIXTURE AT 15'-0" ABOVE FINISHED GRADE.					
SC		EXTERIOR CEILING MOUNTED FIXTURE	BEACON# SRT1-35-4K7-50W	LED 4000K	120/277	35	SURFACE MOUNT ON CANOPY.					

LIGHTING FIXTURE SCHEDULE NOTES (SEE REMARKS)

- FOR EMERGENCY FIXTURES AE, A1E, BE, CE, C1E, DE & D1E NOT SHOWN AS NIGHT LIGHTS, RUN AN EXTRA HOT CONDUCTOR (BYPASSING ALL CONTROL) AND CONNECT TO EMERGENCY BATTERY. FIXTURES SHALL BE SHUT OFF WITH LOCAL LIGHT FIXTURE CONTROL.
- FOR ALL CHAIN MOUNTED FIXTURES E.C. SHALL PROVIDE EXTENSIONS AS REQUIRED TO INSTALL LIGHT FIXTURES AT HEIGHTS AS NOTED.
- MOUNT EXIT SIGNS A MAXIMUM OF 1'-0" ABOVE TOP OF EGRESS DOOR, PROVIDE PENDANT IF REQUIRED. FOR SIGNS NOT MOUNTED DIRECTLY ABOVE AN EGRESS DOOR, IN SALES AREA MOUNT EXIT SIGNS 6' BELOW TYPE 'C' FIXTURES. IN SALES REPLISHMENT AREA MOUNT EXIT SIGNS 12' BELOW TYPE 'D' FIXTURES.
- THE LIGHT FIXTURE SHALL BE PROVIDED WITH A 7 WIRE HARNESS WITH PIN CONNECTORS FOR BRANCH CIRCUIT THROUGH WIRING FOR CONTINUOUS ROW MOUNTING.

REFER TO SHEET A0.0 FOR LIGHTING VENDOR CONTACT INFORMATION.

M															
MOUNTING: SURFACE						LOCATION:			BREAKER REMARKS						
BUS RATING: 200A						A.I.C.: 65,000			C-CONTACTOR CONTROLLED, S-SHUNT TRIP, L-LOCK ON, G-GFCI, A-ARC FAULT, SW-SWITCHING DUTY, HA-HACR, HI-HID						
200A MAIN LUG ONLY						AMPS CONN.: 346.7			AMPS DEMAND: 368.9						
VOLTAGE: 120/208V-3PH-4W						COMMENTS: EXISTING PANEL TO REMAIN. PROVIDE MATCHING STYLE CIRCUIT BREAKERS TO ACCOMMODATE LOADS AS SHOWN.									
CKT.	DESCRIPTION	KVA CONNECTED				C/B	REMARKS	C/B	KVA CONNECTED				DESCRIPTION	CKT	
1	RTU-01	LTG.	REC.	HVAC	MISC.				MISC.	HVAC	REC.	LTG.			
3				5.9		80/3	-	-	5.0				RTU-02	2	
5				5.9			-	-	5.0					4	
7				5.9			-	-	5.0					6	
9	RTU-03			5.0		60/3	-	-	5.9				RTU-04	8	
11				5.0			-	-	5.9					10	
13				5.0			-	-	5.9					12	
15	PANEL 'L'	20.2	-	4.0	4.0	150/3	-	-	10.4	2.6	13.8	2.4	PANEL 'P'	14	
17				-			-	-	-					16	
19				-			-	-	-					18	
21	SPARE			-		80/3	-	-	-				SPARE	20	
23				-			-	-	-					22	
25	SPARE			-		20/1	-	-	-				SPARE	24	
27	SPARE			-		20/1	-	-	-				SPARE	26	
29	SPARE			-		20/1	-	-	-				SPARE	28	
31	EXISTING SITE LIGHTING	0.4				20/1	C	-	0.4				SPARE	30	
33	EXISTING SITE LIGHTING	0.4				20/1	C	-	0.4				SPARE	32	
35	SPARE			-		20/1	-	-	-				SPARE	34	
37	SPARE			-		20/1	-	-	-				SPARE	36	
39	EXISTING PYLON SIGN	1.2				20/1	C	-	1.2				SPARE	38	
41	SPARE			-		20/1	-	-	-				SPARE	40	
TOTALS		22.2	0.00	36.7	4.0				10.4	35.3	13.8	2.4	TOTALS	42	
LOAD		CONNECTED				DEMAND									
LIGHTING		24.6				30.4									
RECEPTACLE		13.8				11.9									
HVAC		72.0				76.4									
MISC		14.4				14.4									


L															
MOUNTING: SURFACE						LOCATION:			BREAKER REMARKS						
BUS RATING: 200A						A.I.C.: 65,000			C-CONTACTOR CONTROLLED, S-SHUNT TRIP, L-LOCK ON, G-GFCI, A-ARC FAULT, SW-SWITCHING DUTY, HA-HACR, HI-HID						
200A MAIN LUG ONLY						AMPS CONN.: 78.3			AMPS DEMAND: 95.3						
VOLTAGE: 120/208V-3PH-4W						COMMENTS: CAN BE SERIES RATED WITH MANUFACTURERS TESTED BREAKER COMBINATION. UPSTREAM BREAKER CAN BE IN A SEPARATE PANEL OR A MAIN CIRCUIT BREAKER IN THIS PANEL. UPSTREAM BREAKER SHALL BE FULLY RATED TO THE AIC RATING SHOWN ON THIS PANEL. PROVIDE ALL NECESSARY DOCUMENTATION FROM THE MANUFACTURER ON PANELBOARDS PER NATIONAL ELECTRIC CODE.									
CKT.	DESCRIPTION	KVA CONNECTED				C/B	REMARKS	C/B	KVA CONNECTED				DESCRIPTION	CKT	
1	SALES LIGHTING	LTG.	REC.	HVAC	MISC.				MISC.	HVAC	REC.	LTG.			
3	SALES LIGHTING	0.7				20/1	C	C	0.4				SALES LIGHTING	2	
5	SALES LIGHTING	1.1				20/1	C	C	1.2				SALES LIGHTING	4	
7	SALES LIGHTING	1.1				20/1	C	C	1.2				SALES LIGHTING	6	
9	SALES LIGHTING	1.2				20/1	C	C	1.1				SALES LIGHTING	8	
11	SPARE	0.5				20/1	C	-	0.5				SPARE	10	
13	OFFICE, BREAKROOM, TOILET LIGHTING					20/1	-	C	0.8				SALES REPLISHMENT LIGHTING	12	
15	NIGHT / EMERGENCY LIGHTING	0.4				20/1	-	C	0.9				SALES REPLISHMENT LIGHTING	14	
17	EXTERIOR LIGHTING	1.2				20/1	L	C	0.8				SALES REPLISHMENT LIGHTING	16	
19	EXTERIOR LIGHTING	1.0				20/1	C	-	0.8				SPARE	18	
21	SPARE					20/1	C	-	0.8				SPARE	20	
23	FURNITURE RECEPTACLE	1.2				20/1	C	-	1.2				SPARE	22	
25	FURNITURE RECEPTACLE	1.2				20/1	C	-	1.2				SPARE	24	
27	FURNITURE RECEPTACLE	1.2				20/1	C	-	1.2				SPARE	26	
29	FURNITURE RECEPTACLE	1.2				20/1	C	-	1.2				SPARE	28	
31	SPARE					20/1	-	-	0.8				SPARE	30	
33	SPARE					20/1	-	-	0.8				SPARE	32	
35	CHARGER					20/1	-	-	0.8				SPARE	34	
37						20/1	-	-	0.8				SPARE	36	
39	UH-02					20/1	-	-	0.8				SPARE	38	
41						20/1	-	-	0.8				SPARE	40	
TOTALS		13.0	0.00	4.0	4.0				0.00	0.00	0.00	7.2	TOTALS	42	
LOAD		CONNECTED				DEMAND									
LIGHTING		20.2				25.3									
RECEPTACLE		-				-									
HVAC		4.0				5.0									
MISC		4.0				4.0									

P														
MOUNTING: SURFACE						LOCATION:			BREAKER REMARKS					
BUS RATING: 200A						A.I.C.: 65,000			C-CONTACTOR CONTROLLED, S-SHUNT TRIP, L-LOCK ON, G-GFCI, A-ARC FAULT, SW-SWITCHING DUTY, HA-HACR, HI-HID, LO-PERMANENTLY INSTALLED LOCK OUT					
200A MAIN LUG ONLY						AMPS CONN.: 81.1			AMPS DEMAND: 78.9					
VOLTAGE: 120/208V-3PH-4W						COMMENTS: CAN BE SERIES RATED WITH MANUFACTURERS TESTED BREAKER COMBINATION. UPSTREAM BREAKER CAN BE IN A SEPARATE PANEL OR A MAIN CIRCUIT BREAKER IN THIS PANEL. UPSTREAM BREAKER SHALL BE FULLY RATED TO THE AIC RATING SHOWN ON THIS PANEL. PROVIDE ALL NECESSARY DOCUMENTATION FROM THE MANUFACTURER ON PANELBOARDS PER NATIONAL ELECTRIC CODE.								
CKT.	DESCRIPTION	KVA CONNECTED				C/B	REMARKS	C/B	KVA CONNECTED				DESCRIPTION	CKT
1	ISO GND RECEPTACLE	LTG.	REC.	HVAC	MISC.				MISC.	HVAC	REC.	LTG.		
3	GENERAL RECEPTACLE					20/1	-	-	0.4				ISO GND RECEPTACLE	2
5	CASHWRAP RECEPTACLE (D) (ISO GND.)					20/1	-	-	0.8				GENERAL RECEPTACLE	4
7	CASHWRAP RECEPTACLE (D) (ISO GND.)					20/1	-	-	0.8				CASHWRAP RECEPTACLE	6
9	CASHWRAP RECEPTACLE (D) (ISO GND.)					20/1	-	-	0.4				SALES OUTLET	8

8'-0"

4'-0"


2'-0"

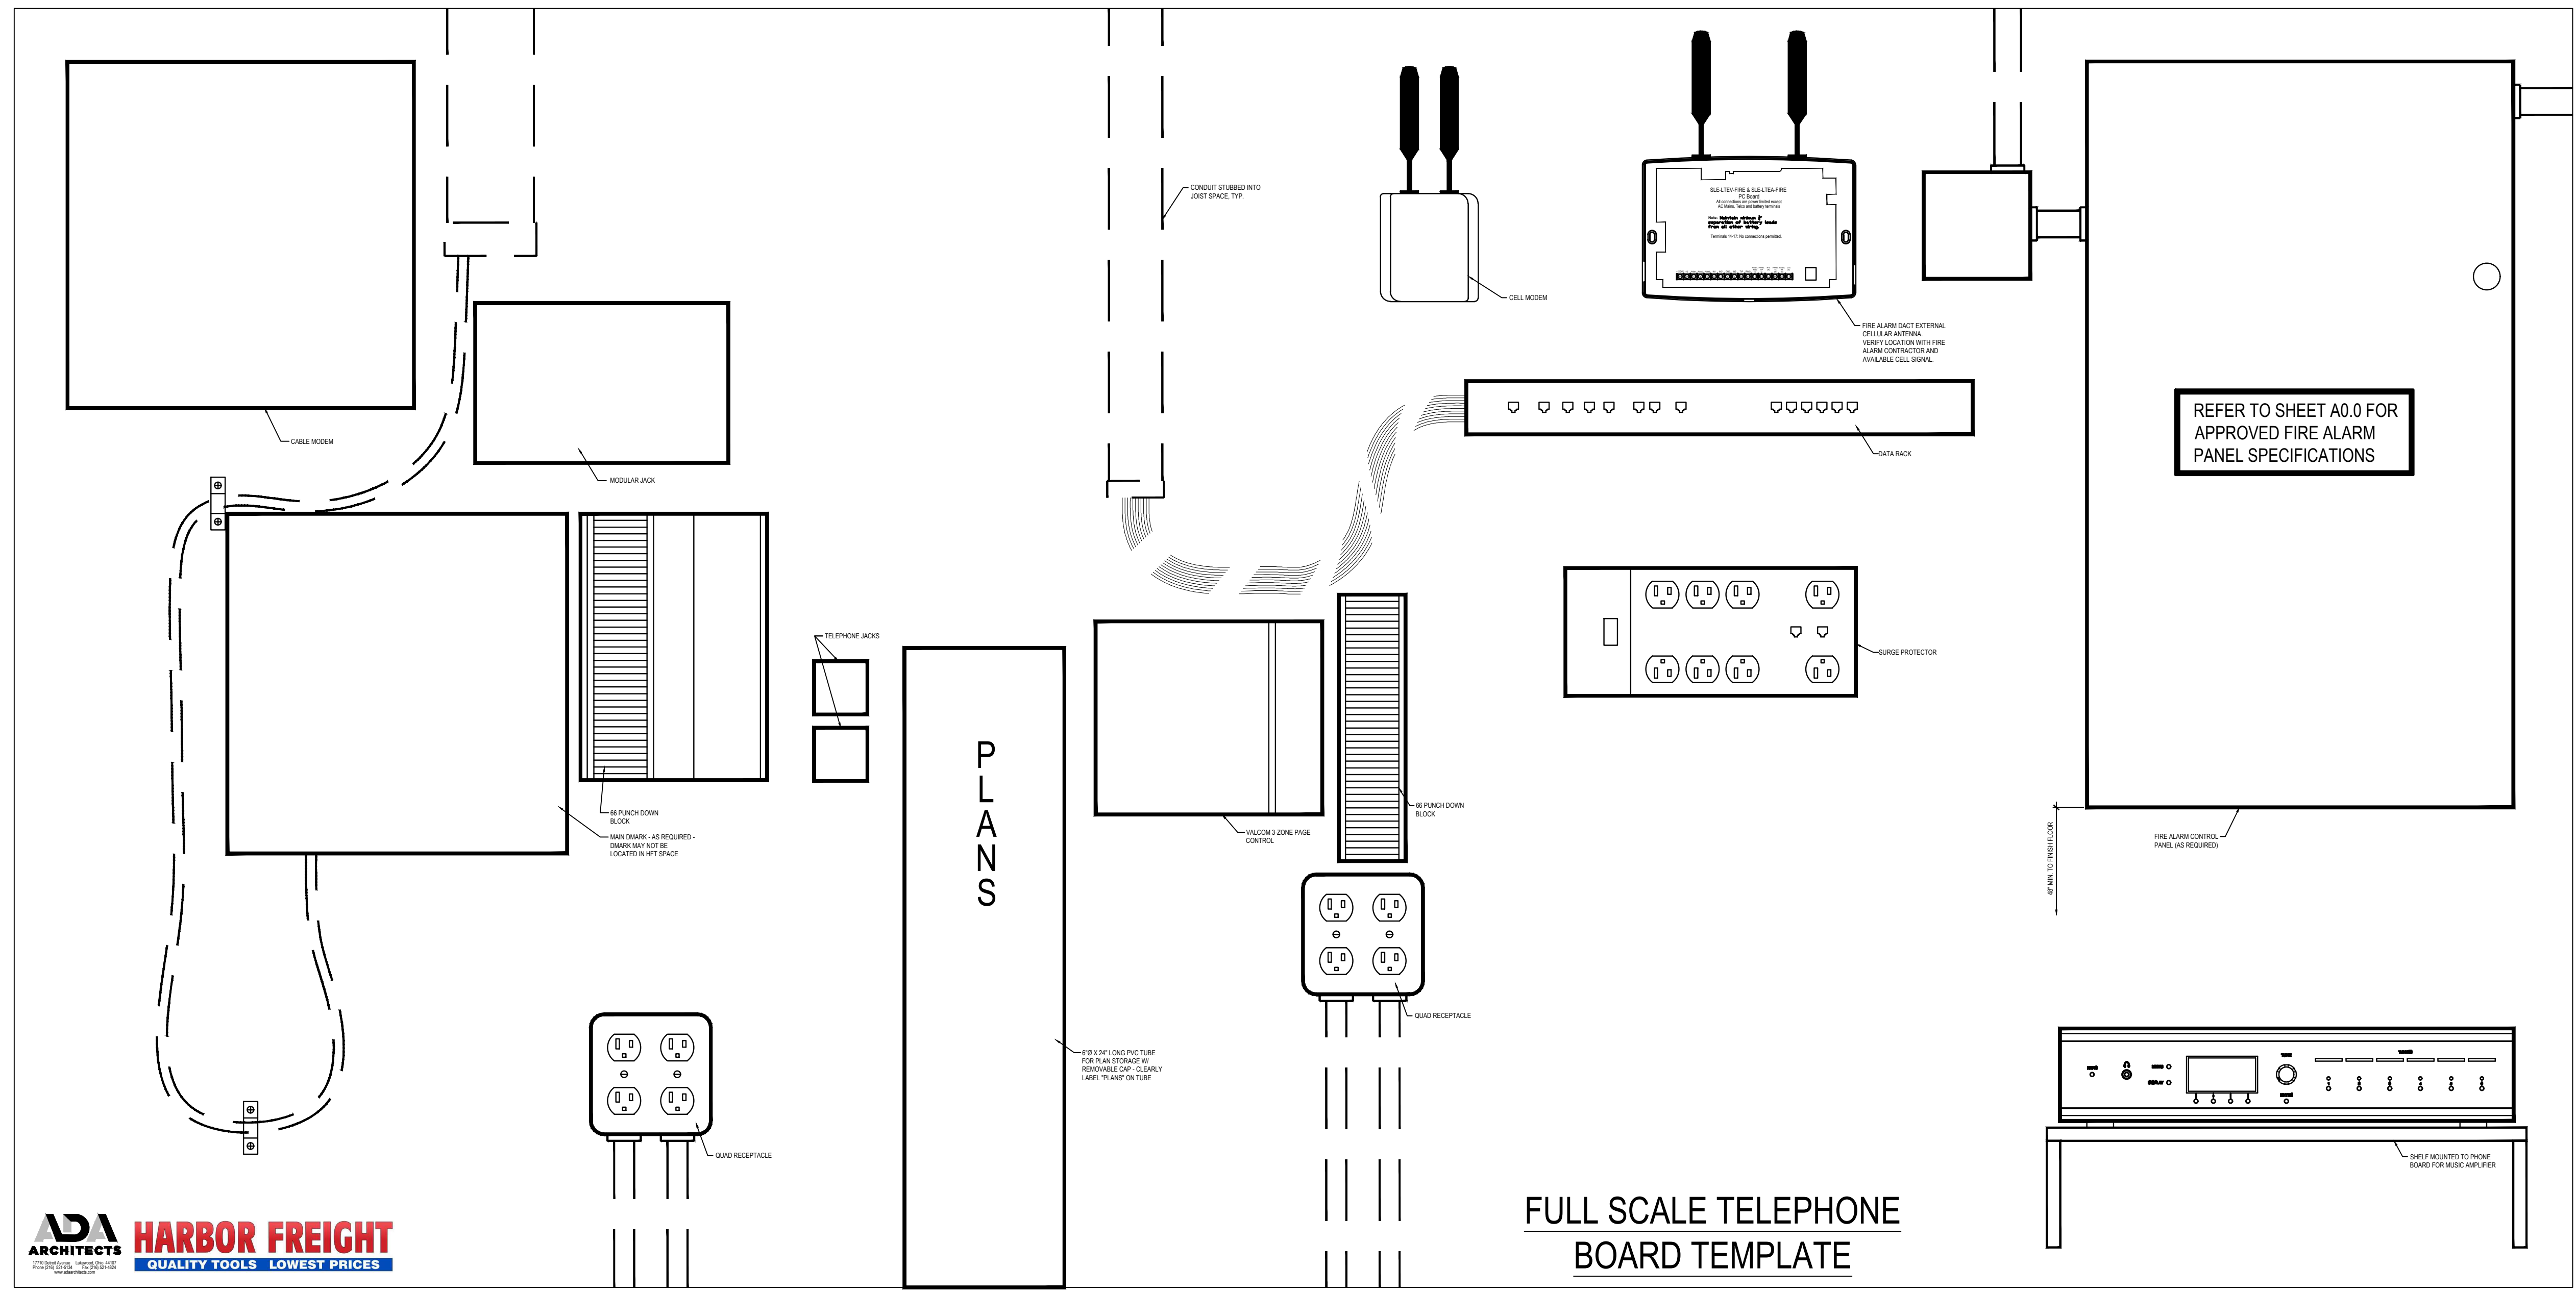

FULL SCALE TELEPHONE BOARD TEMPLATE



Brian M. Schuler, P.E.
 155 Williamsburg Drive
 Avon Lake, Ohio 44012
 Phone: 216-244-4120

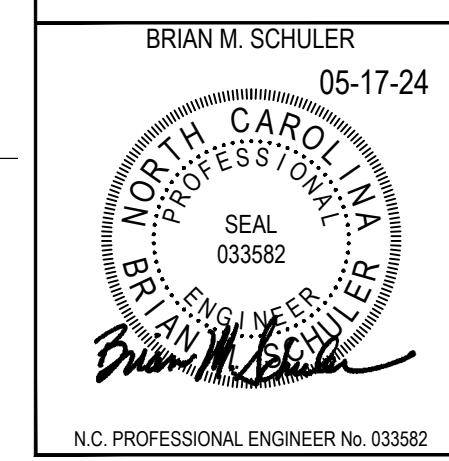

G.C. TO USE FULL SCALE TEMPLATE FOR TELCO BOARD EQUIPMENT LOCATIONS. G.C. TO CONTACT SE BLUEPRINT AT (216)241-2250 TO ORDER FULL SCALE PHONE BOARD TEMPLATE FOR DELIVERY TO SITE.

DO NOT SCALE THESE DRAWINGS



HARBOR FREIGHT

46 SHRUI LANE
 ERWIN, NC 28839

17710 Detroit Avenue
 Lakewood, Ohio 44107
 Phone (216) 521-5134
 Fax (216) 521-4824
 www.adaarchitects.com

THESE DOCUMENTS CONTAIN INFORMATION PROPRIETARY TO ADA ARCHITECTS, INC. UNAUTHORIZED USE OF THESE DOCUMENTS IS EXPRESSLY PROHIBITED UNLESS AGREED UPON IN WRITING.

REVISIONS	
#	DATE
1	
2	
3	
4	
5	
6	
7	
8	
9	
10	

PHONE BOARD DETAIL

DATE 05/17/24
 JOB NO. 23475

E2.2
 SHEET NO.

EMS DEVICES SCHEDULE AND CONSTRUCTION INSTALLATION RESPONSIBILITIES MATRIX									
HFT GENERAL CONTRACTOR IS TO MANAGE AND VALIDATE THE EMS INSTALLATION AND COMMISSIONING THROUGH COMPLETION AND FINAL OPERATION.									
SYMBOL	DEVICE	QUANTITY SUPPLIED BY SIEMENS	DEVICE CABLE TYPE	DEVICE LOCATION	PROVIDED BY	MOUNTING	BOX/RACEWAYS	INSTALL CABLE/WIRE, TERMINATE BOTH ENDS	INSTALLATION NOTES
Ⓢ	CARBON DIOXIDE SENSOR	1 PER HVAC UNIT WITH CO2 (AS REQUIRED PER MECHANICAL DRAWINGS)	18/4 & 18/2	NEXT TO ZONE TEMP SENSOR	SIEMENS	SIEMENS	E.C.	SIEMENS	
Ⓢ	DUCT TEMPERATURE SENSOR	1 PER CONTROLLED HVAC EXCEPT UNIT HEATERS	18/2	BOTTOM OF MAIN SUPPLY AIR DUCT DROP	SIEMENS	SIEMENS	E.C.	SIEMENS	
Ⓢ	DIMMING CONTROL PANEL	1 (AS REQUIRED PER ELECTRICAL DRAWINGS)	VARIES PER CONNECTED DEVICES.	NEAR LCP	SIEMENS	E.C.	E.C.	E.C. / SIEMENS WILL TERMINATE LOW VOLTAGE WIRING AT DCP	4
Ⓢ	DIGITAL ZONE CONTROLLER (WALL MOUNT VERSION)	1 PER UNIT HEATER	18/4 TO UNIT HEATER / 24-1P DAISY CHAIN	RETURN SIDE OF UNIT HEATER	SIEMENS	SIEMENS	E.C.	SIEMENS	
Ⓢ	DIGITAL ZONE CONTROLLER (ROOFTOP VERSION)	1 PER CONTROLLED HVAC (EXCEPT UNIT HEATER)	18/10 TO RTU'S CTRL TERMINAL / 24/1P DAISY CHAIN / SENSORS AS REQUIRED	HVAC CONTROLS SECTION	SIEMENS	SIEMENS	E.C.	SIEMENS	
Ⓢ	INDOOR LIGHT SENSOR	AS REQUIRED PER ELECTRICAL DRAWINGS	18/4	IN DAYLIGHT HARVESTING ZONE	SIEMENS	SIEMENS	E.C.	SIEMENS	
Ⓢ	LIGHTING CONTROL PANEL	1 (TYPICAL)	AS REQUIRED	NEAR BREAKER PANELS FEEDING LIGHTING CIRCUITS	SIEMENS	E.C.	E.C.	E.C. / SIEMENS WILL TERMINATE LOW VOLTAGE WIRING AT LCP	1
Ⓢ	MICRO I/O	1 (STOCK ROOM RTU)	AS REQUIRED	MOUNTED ON DZC-RT	SIEMENS	SIEMENS	N/A	SIEMENS	
Ⓢ	OUTSIDE SENSING DEVICE	1	18/4	ROOF	SIEMENS	SIEMENS	M.C.	SIEMENS	
Ⓢ	RELATIVE HUMIDITY SENSOR	1	18/4	STOCK ROOM	SIEMENS	SIEMENS	E.C.	SIEMENS	
Ⓢ	ZONE TEMPERATURE SENSOR	1 PER CONTROLLED HVAC	18/2	1 IN EACH ZONE (SEE CONSTRUCTION DRAWING FOR LOCATIONS)	SIEMENS	SIEMENS	E.C.	SIEMENS	
Ⓢ	SCREAM LOGIC PANEL	1	VARIES PER CONNECTED DEVICES.	ELECTRICAL ROOM OR STOCKROOM	SIEMENS	E.C.	E.C.	E.C. / SIEMENS WILL TERMINATE LOW VOLTAGE WIRING AT SLP	
Ⓢ	SLIDER SWITCH	1 PER EACH DIMMING GROUP ON SALES FLOOR PROVIDED BY ELECTRICAL CONTRACTOR	18/2	WALL BETWEEN STOCK AND SALES FLOOR	E.C.	E.C.	E.C.	E.C. / SIEMENS	4
	SECURITY INTERFACE	1	18 /4	WITHIN 10 FEET OF SECURITY RELAY PANEL	SIEMENS	SIEMENS	E.C.	SIEMENS	
	SPLICE BOX	1 PER EACH DIMMING GROUP ON SALES FLOOR (AS REQUIRED)	AS REQUIRED	NEXT TO DCP	SIEMENS	SIEMENS	E.C.	SIEMENS	
Ⓢ	TOUCH SCREEN PANEL	1	CAT-5	MANAGERS OFFICE	SIEMENS	E.C.	E.C.	E.C.	5, 2, 3

INSTALLATION SUMMARY

1. LOW VOLTAGE CABLE:
 I. SIEMENS SHALL FURNISH THE LOW VOLTAGE CABLE FOR THE EMS SYSTEM. THE CABLE SHALL BE AS SPECIFIED IN THE CABLE SCHEDULE.
 II. REFER TO "EMS DEVICES SCHEDULE AND CONSTRUCTION INSTALLATION RESPONSIBILITY MATRIX" FOR ADDITIONAL INFORMATION ON RESPONSIBILITIES FOR INSTALLATION OF LOW VOLTAGE CABLE.

2. EQUIPMENT DELIVERY:
 I. SITE CONTROLS SHALL PROVIDE THE EMS EQUIPMENT IN 1 SHIPMENT.
 II. IT SHALL BE UP TO THE G.C. TO CALL FOR EMS EQUIPMENT DELIVERY THE EQUIPMENT WILL BE SHIPPED WITHIN 2 DAYS OF RECEIVING A VALID REQUEST. A VALID REQUEST SHALL CONSIST OF THE FOLLOWING:
 1 - NAME AND PHONE NUMBER OF PERSON RESPONSIBLE FOR RECEIVING THE EMS EQUIPMENT AND STORE NUMBER.
 2 - A VALID SHIPPING ADDRESS (CONFIRMABLE BY THE DELIVERY AGENT).

3. CONTACT INFORMATION:
 I. PLEASE DIRECT ALL SHIPPING AND PROJECT MANAGEMENT REQUESTS TO SIEMENS RCS AT (512) 751-5942 OR PROJECT MANAGER:
 EMELY CORDON AT EMELY.CORDON@SIEMENS.COM

4. EMS COMMISSIONING:
 I. IT SHALL BE UP TO THE G.C. TO CALL FOR EMS COMMISSIONING AT LEAST 2 WEEKS PRIOR TO TURN OVER AND BEFORE THE INSTALLING CONTRACTOR HAS LEFT THE PROJECT. SIEMENS WILL BE ON SITE PER HFT REQUEST 1 WEEK AFTER THE HFT "FIXTURE DATE".
 THE FOLLOWING CONDITIONS MUST BE MET PRIOR TO SIEMENS ARRIVAL:
 1-ALL EMS DEVICES AND PANELS HAVE BEEN INSTALLED AND WIRED
 2-ALL LINE VOLTAGE WIRING HAS BEEN COMPLETED
 3-ALL CONTROLLED EQUIPMENT HAS BEEN INSTALLED AND STARTED
 II. FAILURE TO MEET THESE CONDITIONS COULD RESULT IN DELAY OF STORE OPENING AND ADDITIONAL CHARGES.
 III. E.C. & M.C. MUST BE PRESENT FOR COMMISSIONING OF EMS.
 NOTE: TITLE 23 REPRESENTATIVE SHALL ALSO BE PRESENT AT CALIFORNIA LOCATIONS.

GENERAL EMS CONSTRUCTION NOTES

1. SIEMENS SHALL PROVIDE THE INSTALLATION LABOR AND MATERIALS TO INSTALL THE LOW VOLTAGE PORTION OF THE EMS SYSTEM ACCORDING TO THE EMS SCHEDULES AND THE FOLLOWING:
 I. INSTALL EMS DEVICES AT LOCATIONS SHOWN ON THE MECHANICAL DRAWINGS AND MOUNT ACCORDING TO THE EMS DETAILS.
 II. PROVIDE AND INSTALL THE LOW VOLTAGE CABLING FROM THE EMS DEVICES TO THE RTU'S AND LCP
 III. TERMINATE THE LOW VOLTAGE CABLING AT BOTH ENDS.
 IV. CLEARLY IDENTIFY (LABEL) THE CABLES AT BOTH ENDS.

2. THE ELECTRICAL CONTRACTOR SHALL PROVIDE THE LABOR AND MATERIALS TO INSTALL THE LINE VOLTAGE PORTION OF THE EMS SYSTEM ACCORDING TO THE EMS SCHEDULES AND THE FOLLOWING:
 I. PROVIDE AND INSTALL ELECTRICAL BOXES WITH 3/4" EMT STUB-UPS TO ABOVE CEILING GRID FOR WALL MOUNTED EMS AND CONTROL DEVICES.
 II. PROVIDE AND INSTALL A 5' SECTION OF 1/2" RIGID FOR ROOF MOUNTED OSD.
 III. SIEMENS SHALL PROVIDE THE LABOR AND MATERIALS TO INSTALL THE LINE VOLTAGE PORTION OF THE EMS SYSTEM ACCORDING TO THE EMS SCHEDULES AND THE FOLLOWING:
 I. MOUNT EMS PANELS AND PIPE TOGETHER ACCORDING TO THE EMS DRAWINGS.
 II. SIEMENS SHALL INSTALL AND TERMINATE OSD AND CABLE.
 4. NOTES ABOVE DO NOT ALLEVIATE CONTRACTORS OF OVERALL RESPONSIBILITIES OF PROVIDING A COMPLETE AND OPERATIONAL SYSTEM.
 5. TITLE 24 - THE E.C. SHALL WIRE AND INSTALL A LOW VOLTAGE DIMMER LOCATED OUTSIDE OF THE BREAK ROOM FOR SALES REPLACEMENT.

GENERAL CONSTRUCTION NOTES

1. SIEMENS SHALL INSTALL LOW VOLTAGE CABLE IN RACEWAYS PROVIDED BY E.C. AND TERMINATE BOTH ENDS. LINE VOLTAGE CONDUIT, WIRING AND TERMINATIONS BY E.C.
 2. SIEMENS SHALL TERMINATE ALL LOW VOLTAGE CABLES AT THE TOUCHSCREEN.
 3. E.C. TO PROVIDE DEDICATED POWER CIRCUIT TO TOUCHSCREEN.
 4. E.C. SHALL BE RESPONSIBLE FOR INSTALLATION OF POWER WIRING AND LOW VOLTAGE DIMMING CONTROL SIGNALS TO LIGHTING FIXTURES. SIEMENS SHALL BE RESPONSIBLE FOR INSTALLATION OF ADDITIONAL CONTROL WIRING IN RACEWAYS INSTALLED BY E.C.
 5. THE MAXIMUM DISTANCE BETWEEN THE TSP AND THE OUTLET IS 4 FEET. THE MAXIMUM LENGTH OF THE CAT-5 BETWEEN THE SLP AND TSP MUST NOT EXCEED 300 FEET.
 GENERAL - NON-EMS CONTROLS

1. COMBUSTION AIR VENTILATION AND OTHER EQUIPMENT:
 I. CONTROLS FOR COMBUSTION AIR VENTILATION AND ANY OTHER EQUIPMENT NOT SPECIFICALLY MENTIONED IN THE EMS SCHEDULES SHALL BE FURNISHED AND INSTALLED ACCORDING TO THE MECHANICAL AND ELECTRICAL BID DOCUMENTS.
 2. EXHAUST FAN, TRANSFER FAN AND OTHER "HARD-WIRED" INTERLOCKS (SEE INTERLOCK EXAMPLE BELOW):
 I. WHEN HARD-WIRED INTERLOCKING IS SPECIFIED IN THE MECHANICAL AND/OR ELECTRICAL SCHEDULES, THE INTERLOCKS SHALL BE FURNISHED AND INSTALLED BY THE TRADES SPECIFIED.
 INTERLOCKING IS NOT PART OF EMS SYSTEM.
 II. WHERE EXHAUST FAN AND RTU INTERLOCKS ARE CALLED OUT, THE CONTRACTOR SHALL CONNECT DIRECTLY TO THE SUPPLY FAN CONTACTOR COIL AND WIRE IN PARALLEL TO THE COIL OF A PROPERLY SIZED CONTACTOR OR STARTER SERVING THE INTERLOCKED EQUIPMENT. DO NOT USE THE EMS SYSTEM TO INTERLOCK EQUIPMENT.
 3. LIFE SAFETY AND FIRE ALARM SYSTEMS:
 I. LIFE SAFETY AND FIRE ALARM SYSTEMS ARE NOT PART OF THE EMS SYSTEM AND SHALL BE FURNISHED AND INSTALLED AS SPECIFIED IN THE MECHANICAL AND ELECTRICAL BID DOCUMENTS.
 II. MECHANICAL EQUIPMENT SHUTDOWN SHALL BE WIRED AS TO NOT AFFECT THE EMS SYSTEM.
 4. MANUFACTURER SUPPLIED HUMIDITY CONTROLLERS:
 I. DEHUMIDIFYING ROOFTOP UNITS:
 SOME ROOFTOP UNITS MAY COME EQUIPPED WITH A DEHUMIDIFICATION CYCLE AND SPACE HUMIDITY SENSOR. THIS SENSOR SHALL BE INSTALLED IN ADDITION TO THE EMS SYSTEM AND CABLED ACCORDING TO THE MANUFACTURER'S INSTRUCTION.

INSTALLATION NOTES




1. SIEMENS SHALL INSTALL LOW VOLTAGE CABLE IN RACEWAYS PROVIDED BY E.C. AND TERMINATE BOTH ENDS. LINE VOLTAGE CONDUIT, WIRING AND TERMINATIONS BY E.C.
 2. SIEMENS SHALL TERMINATE ALL LOW VOLTAGE CABLES AT THE TOUCHSCREEN.
 3. E.C. TO PROVIDE DEDICATED POWER CIRCUIT TO TOUCHSCREEN.
 4. E.C. SHALL BE RESPONSIBLE FOR INSTALLATION OF POWER WIRING AND LOW VOLTAGE DIMMING CONTROL SIGNALS TO LIGHTING FIXTURES. SIEMENS SHALL BE RESPONSIBLE FOR INSTALLATION OF ADDITIONAL CONTROL WIRING IN RACEWAYS INSTALLED BY E.C.
 5. THE MAXIMUM DISTANCE BETWEEN THE TSP AND THE OUTLET IS 4 FEET. THE MAXIMUM LENGTH OF THE CAT-5 BETWEEN THE SLP AND TSP MUST NOT EXCEED 300 FEET.
 GENERAL - NON-EMS CONTROLS

1. COMBUSTION AIR VENTILATION AND OTHER EQUIPMENT:
 I. CONTROLS FOR COMBUSTION AIR VENTILATION AND ANY OTHER EQUIPMENT NOT SPECIFICALLY MENTIONED IN THE EMS SCHEDULES SHALL BE FURNISHED AND INSTALLED ACCORDING TO THE MECHANICAL AND ELECTRICAL BID DOCUMENTS.
 2. EXHAUST FAN, TRANSFER FAN AND OTHER "HARD-WIRED" INTERLOCKS (SEE INTERLOCK EXAMPLE BELOW):
 I. WHEN HARD-WIRED INTERLOCKING IS SPECIFIED IN THE MECHANICAL AND/OR ELECTRICAL SCHEDULES, THE INTERLOCKS SHALL BE FURNISHED AND INSTALLED BY THE TRADES SPECIFIED.
 INTERLOCKING IS NOT PART OF EMS SYSTEM.
 II. WHERE EXHAUST FAN AND RTU INTERLOCKS ARE CALLED OUT, THE CONTRACTOR SHALL CONNECT DIRECTLY TO THE SUPPLY FAN CONTACTOR COIL AND WIRE IN PARALLEL TO THE COIL OF A PROPERLY SIZED CONTACTOR OR STARTER SERVING THE INTERLOCKED EQUIPMENT. DO NOT USE THE EMS SYSTEM TO INTERLOCK EQUIPMENT.
 3. LIFE SAFETY AND FIRE ALARM SYSTEMS:
 I. LIFE SAFETY AND FIRE ALARM SYSTEMS ARE NOT PART OF THE EMS SYSTEM AND SHALL BE FURNISHED AND INSTALLED AS SPECIFIED IN THE MECHANICAL AND ELECTRICAL BID DOCUMENTS.
 II. MECHANICAL EQUIPMENT SHUTDOWN SHALL BE WIRED AS TO NOT AFFECT THE EMS SYSTEM.
 4. MANUFACTURER SUPPLIED HUMIDITY CONTROLLERS:
 I. DEHUMIDIFYING ROOFTOP UNITS:
 SOME ROOFTOP UNITS MAY COME EQUIPPED WITH A DEHUMIDIFICATION CYCLE AND SPACE HUMIDITY SENSOR. THIS SENSOR SHALL BE INSTALLED IN ADDITION TO THE EMS SYSTEM AND CABLED ACCORDING TO THE MANUFACTURER'S INSTRUCTION.

SIZE	DESCRIPTION	MANUFACTURER	SIEMENS PART #
18/2	18AWG, 2 CONDUCTOR, SHIELDED, STRANDED, PLENUM, WHITE	ANIXTER	RCS-2C18-CMP-WH
18/4	18AWG, 4 CONDUCTOR, SHIELDED, PLENUM, WHITE	ANIXTER	RCS-4C18-CMP-WH
18/10	18AWG, 10 CONDUCTOR, UNSHIELDED, STRANDED, PLENUM, WHITE	ANIXTER	RCS-10C18-CMP-WH
24/1P	24AWG, TWISTED PAIR, SHIELDED, STRANDED, PLENUM, WHITE	ANIXTER	RCS-TP24-CMP-WH
CAT-5	CATEGORY 5, UNSHIELDED, SOLID, TWISTED PAIR WHITE	ANIXTER	RCS-E-4UTP-CAT5E-OMR-WH

CABLE PURCHASING INSTRUCTIONS

ANIXTER INC. IS THE AUTHORIZED DISTRIBUTOR OF SPECIFIED CABLE FOR SIEMENS INDUSTRY, INC. BUILDING TECHNOLOGIES DIVISION. (PLEASE, CONSULT ANIXTER OR SIEMENS COMMODITY MANAGER FOR THE MOST CURRENT PRICING STRUCTURE.)
 CONTACT INFORMATION:
 PHONE: (888) 479-3830
 FAX: (888) 479-3834
 EMAIL: SBT@anixter.com
 WEBSITE FOR SIEMENS BT: www.anixter.com/SBT (BUILDING AUTOMATION TAB)
 WO REFERENCE NUMBER: 30209634

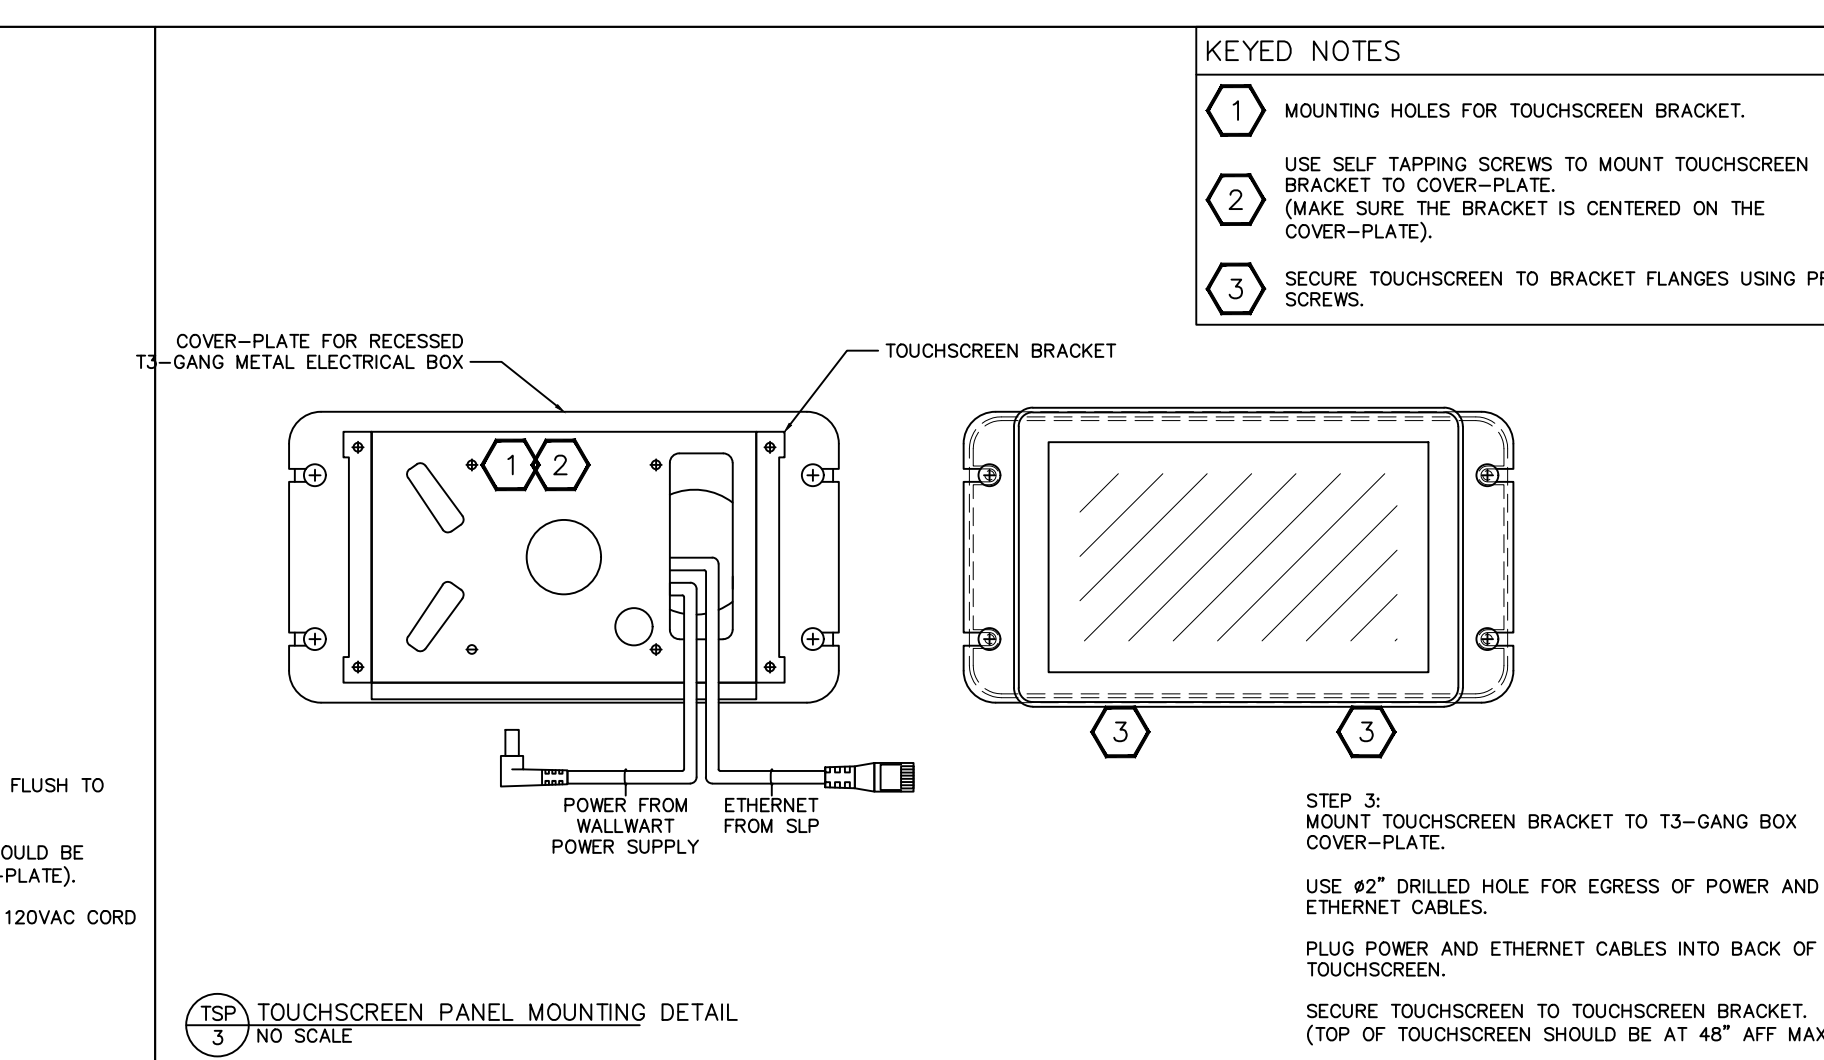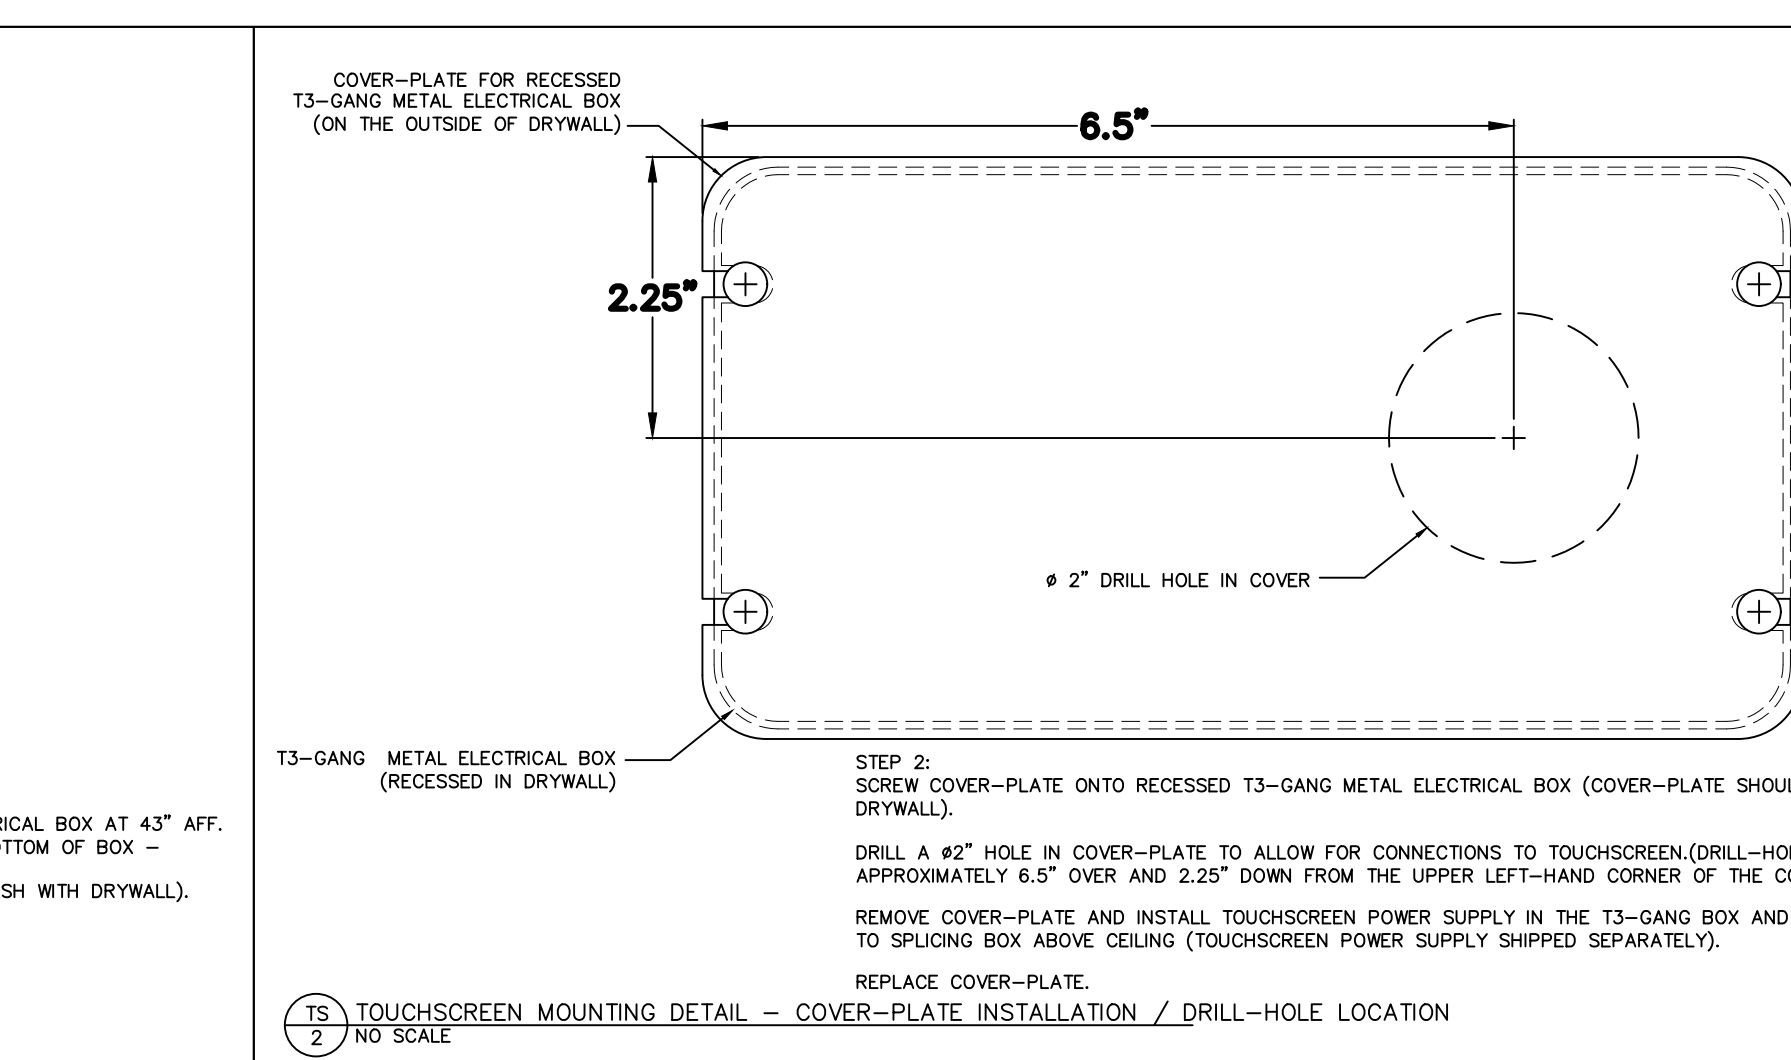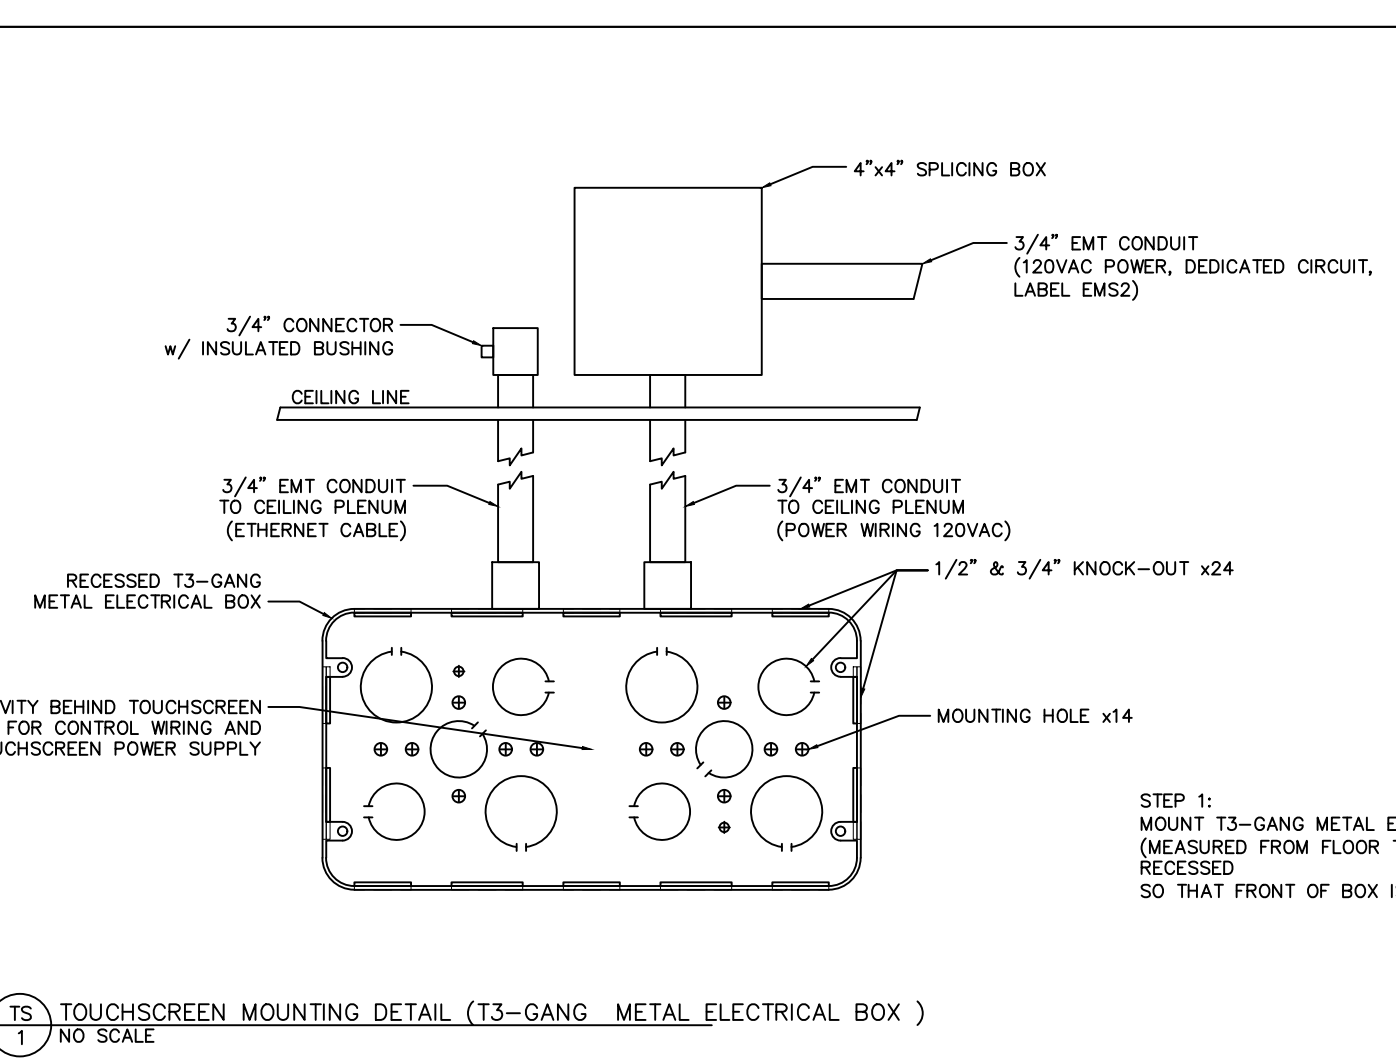

KEYED NOTES

- MOUNTING HOLES FOR TOUCHSCREEN BRACKET.
- USE SELF TAPPING SCREWS TO MOUNT TOUCHSCREEN BRACKET TO COVER-PLATE. (MAKE SURE THE BRACKET IS CENTERED ON THE COVER-PLATE).
- SECURE TOUCHSCREEN TO BRACKET FLANGES USING PROVIDED SCREWS.

STEP 3: MOUNT TOUCHSCREEN BRACKET TO T3-GANG BOX COVER-PLATE.
 USE #2" DRILLED HOLE FOR EGRESS OF POWER AND ETHERNET CABLES.
 PLUG POWER AND ETHERNET CABLES INTO BACK OF TOUCHSCREEN.
 SECURE TOUCHSCREEN TO TOUCHSCREEN BRACKET. (TOP OF TOUCHSCREEN SHOULD BE AT 48" AFF MAX).

SIEMENS

9225 BEE CAVES ROAD, BLDG. B, SUITE 100,
 AUSTIN, TEXAS 78733 Phone: 512-421-6257

Project: **HARBOR FREIGHT PROTOTYPICAL NEW CONSTRUCTION NATIONAL EMS BID SET**

Description: **PROTOTYPICAL NATIONAL EMS BID SET**



Date: 11-15-17 Scale: NTS

Drawing File Name/Origin: Harbor Freight-Bid Set-Rev8.dwg

REVISIONS


#	DESCRIPTION	DATE	BY
0	Initial Release	11-15-17	MS
4	Revised	8-12-19	MS
5	Revised	10-10-19	MS
6	Revised	3-3-20	MS
7	Revised	4-13-20	MS
8	Revised	6-2-20	MS
9	Revised	6-28-22	MS

EMS-1

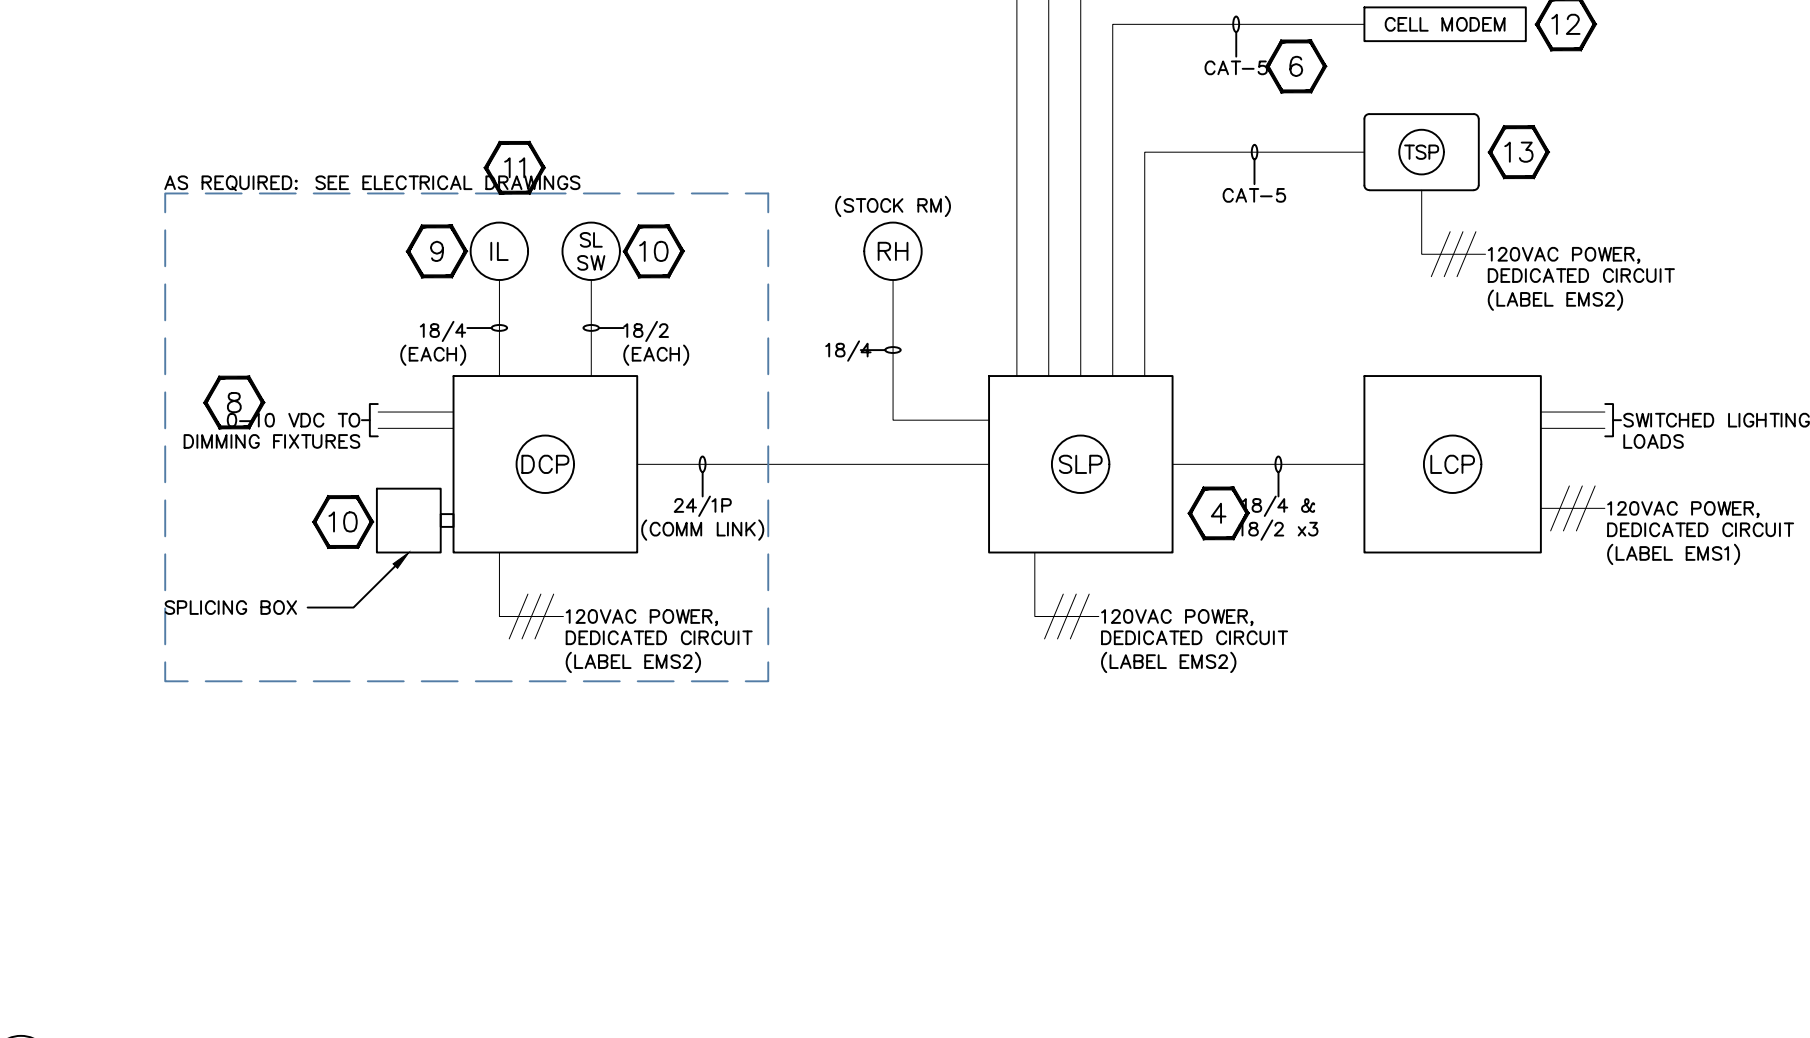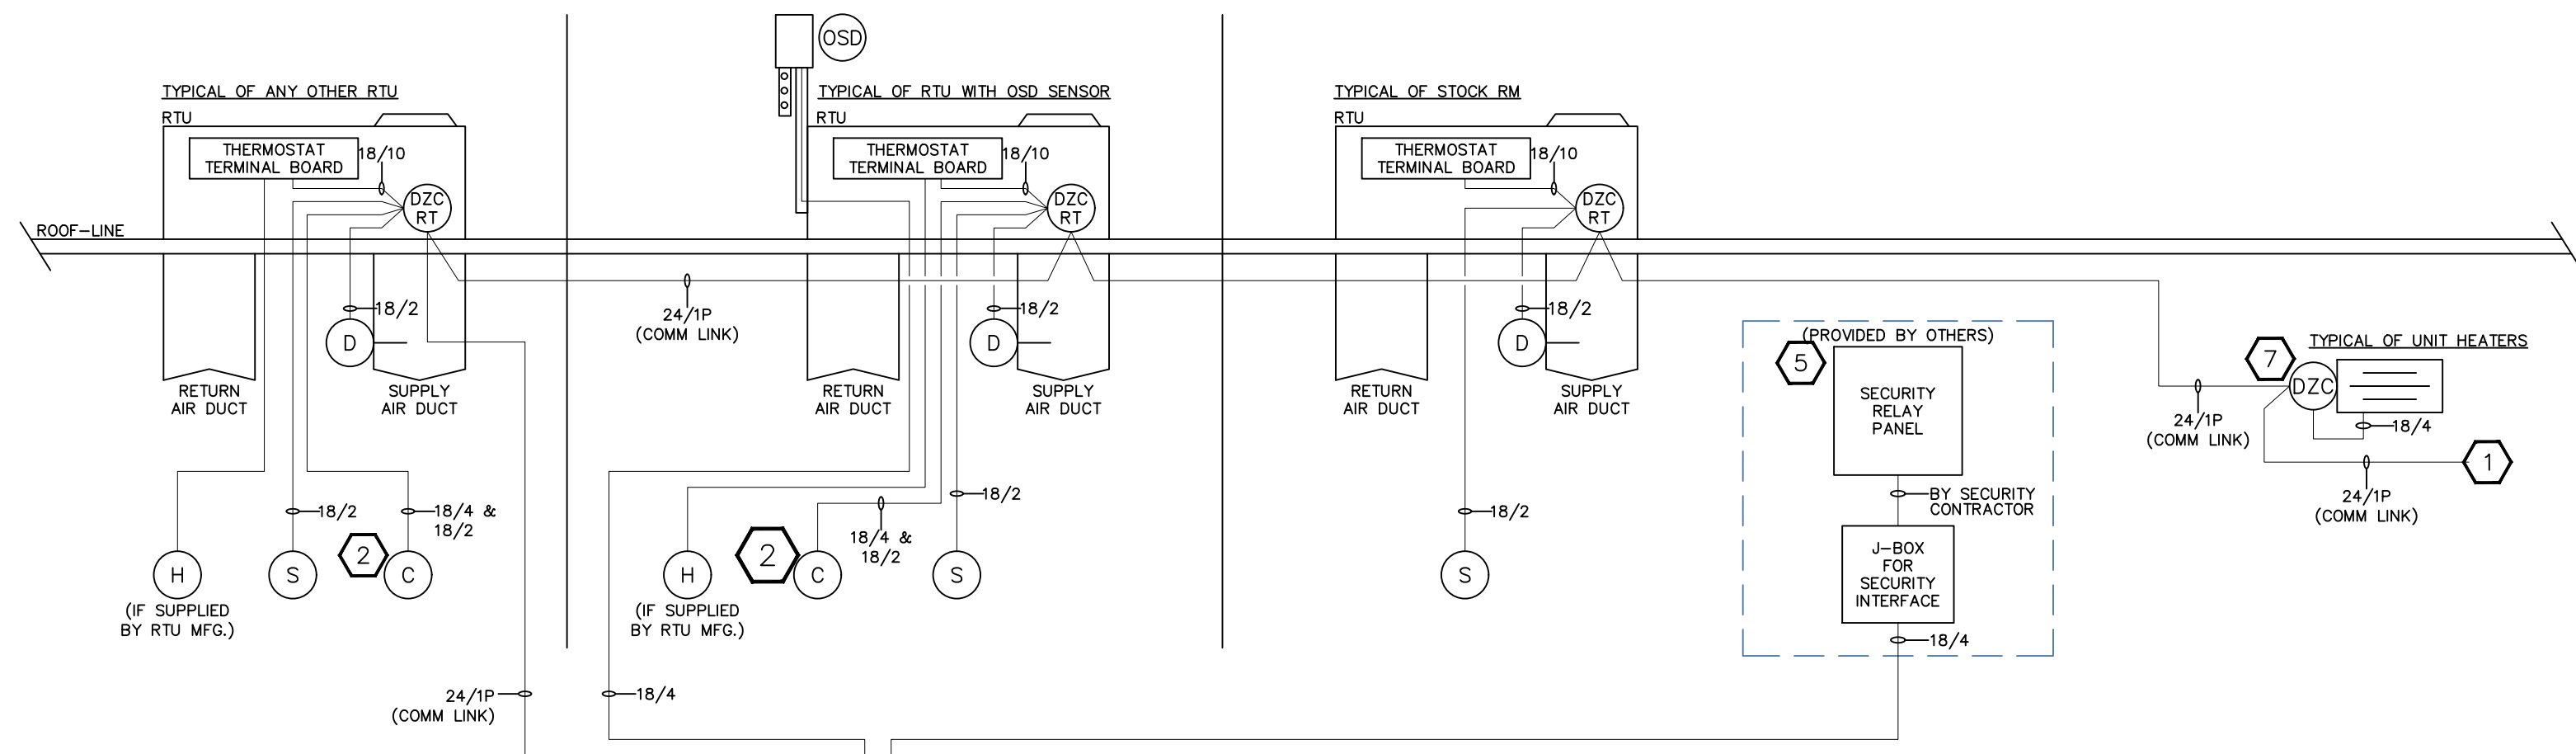


SLED SINGLE LINE DIAGRAM
1 NO SCALE


- KEYED NOTES**
- DAISY CHAIN COMMUNICATION CABLE TO EACH ADDITIONAL DZC.
 - WHEN REQUIRED A CO2 SENSOR WILL BE INSTALLED NEXT TO THE ZONE TEMPERATURE SENSOR FOR CONTROL OF HVAC. ENSURE ADEQUATE LENGTH OF 18/2 TO REACH ECONOMIZER SECTION OF RTU.
 - NOTE REMOVED.
 - WHEN THE INSTALLATION OF ADDITIONAL LIGHTING CONTROL PANELS IS REQUIRED, CONTROL SIGNALS FROM THE SLP MUST BE DAISY CHAIN TO ANY ADDITIONAL LCP (AS REQUIRED).
 - REFER TO "SECURITY INTERFACE" DETAIL FOR TERMINATIONS.
 - INSTALL CELL MODEM IN NETWORK RACK. PULL AND TERMINATE CAT-5 BETWEEN SLP AND CELL MODEM.
 - UNIT HEATER MUST BE FURNISHED WITH A CLASS 2 24VAC CTRL TRANSFORMER. MOUNT DZC ON RETURN INTAKE OF UNIT.
 - CONTROL SIGNAL TO DIMMING FIXTURES. MAXIMUM LOAD PER DIMMING CHANNEL MUST NOT EXCEED 80mA.
 - TYPICAL OF 1 IL SENSOR PER EACH DAYLIGHT HARVESTING ZONE. REFER TO CONSTRUCTION DRAWINGS FOR NUMBER AND LOCATIONS.
 - TYPICAL OF EACH DIMM GROUP IN SALES FLOOR (INCLUDING DAYLIGHT HARVEST GROUP). EACH DIMMING GROUP IN THE SALES FLOOR REQUIRES INSTALLATION OF ONE SLED DIMMER ON THE WALL SEPARATING THE SALES FLOOR FROM THE STOCK ROOM (INSIDE STOCK ROOM) AND ONE SPLICE BOX AT THE DCP.
 - AS REQUIRED FOR SITES WITH DIMMING CONTROLS: SEE ELECTRICAL DRAWINGS FOR ADDITIONAL INFORMATION.
 - MOUNT CELL MODEM IN NETWORK RACK.
 - INSTALL TOUCH SCREEN PANEL IN THE MANAGER'S OFFICE AT 48" AFF.

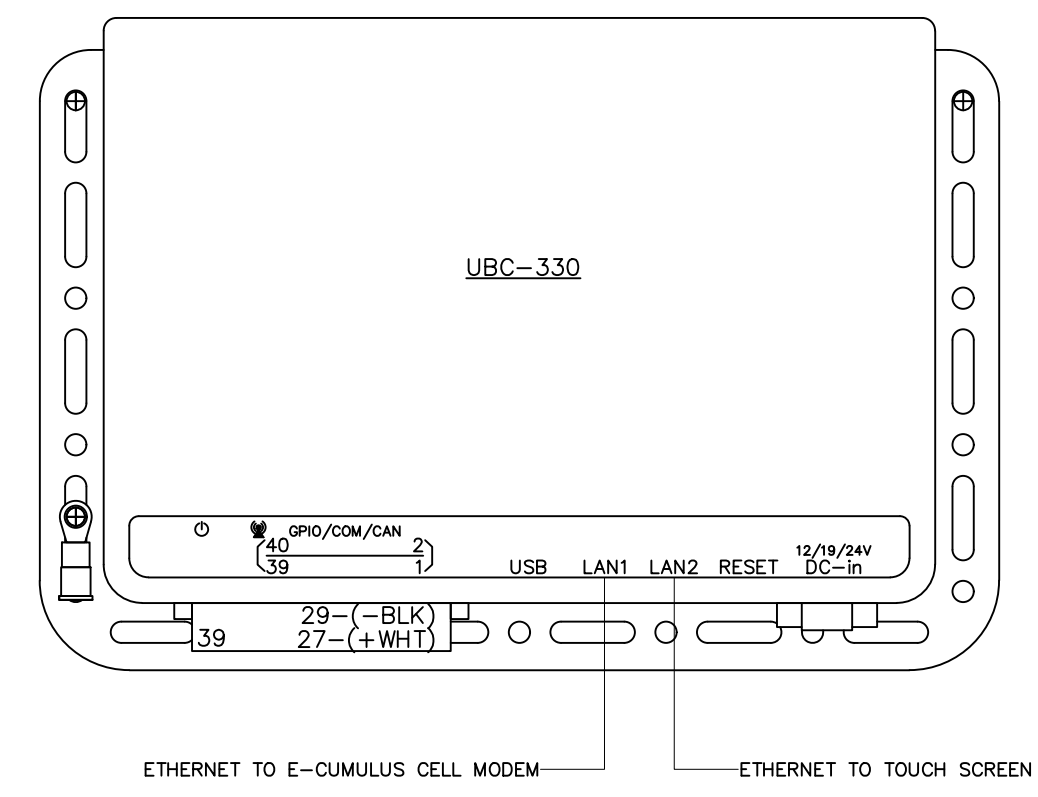

UBC-330 (SCREAM) WIRING DETAIL
1 NO SCALE

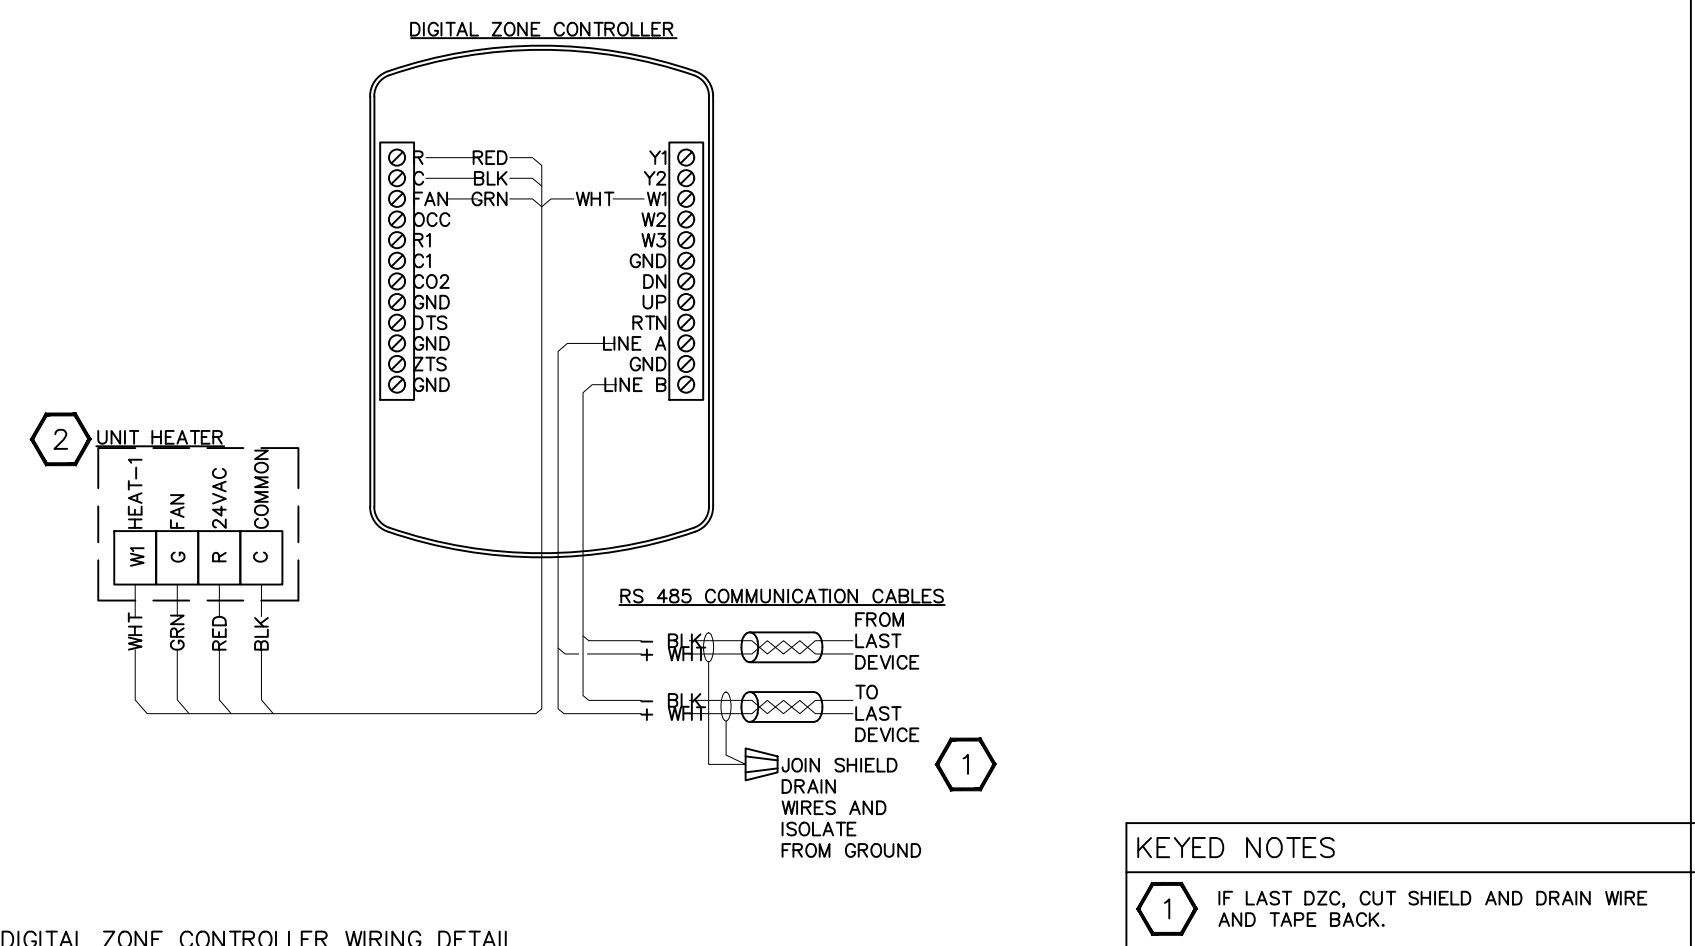


DZC DIGITAL ZONE CONTROLLER WIRING DETAIL
1 NO SCALE

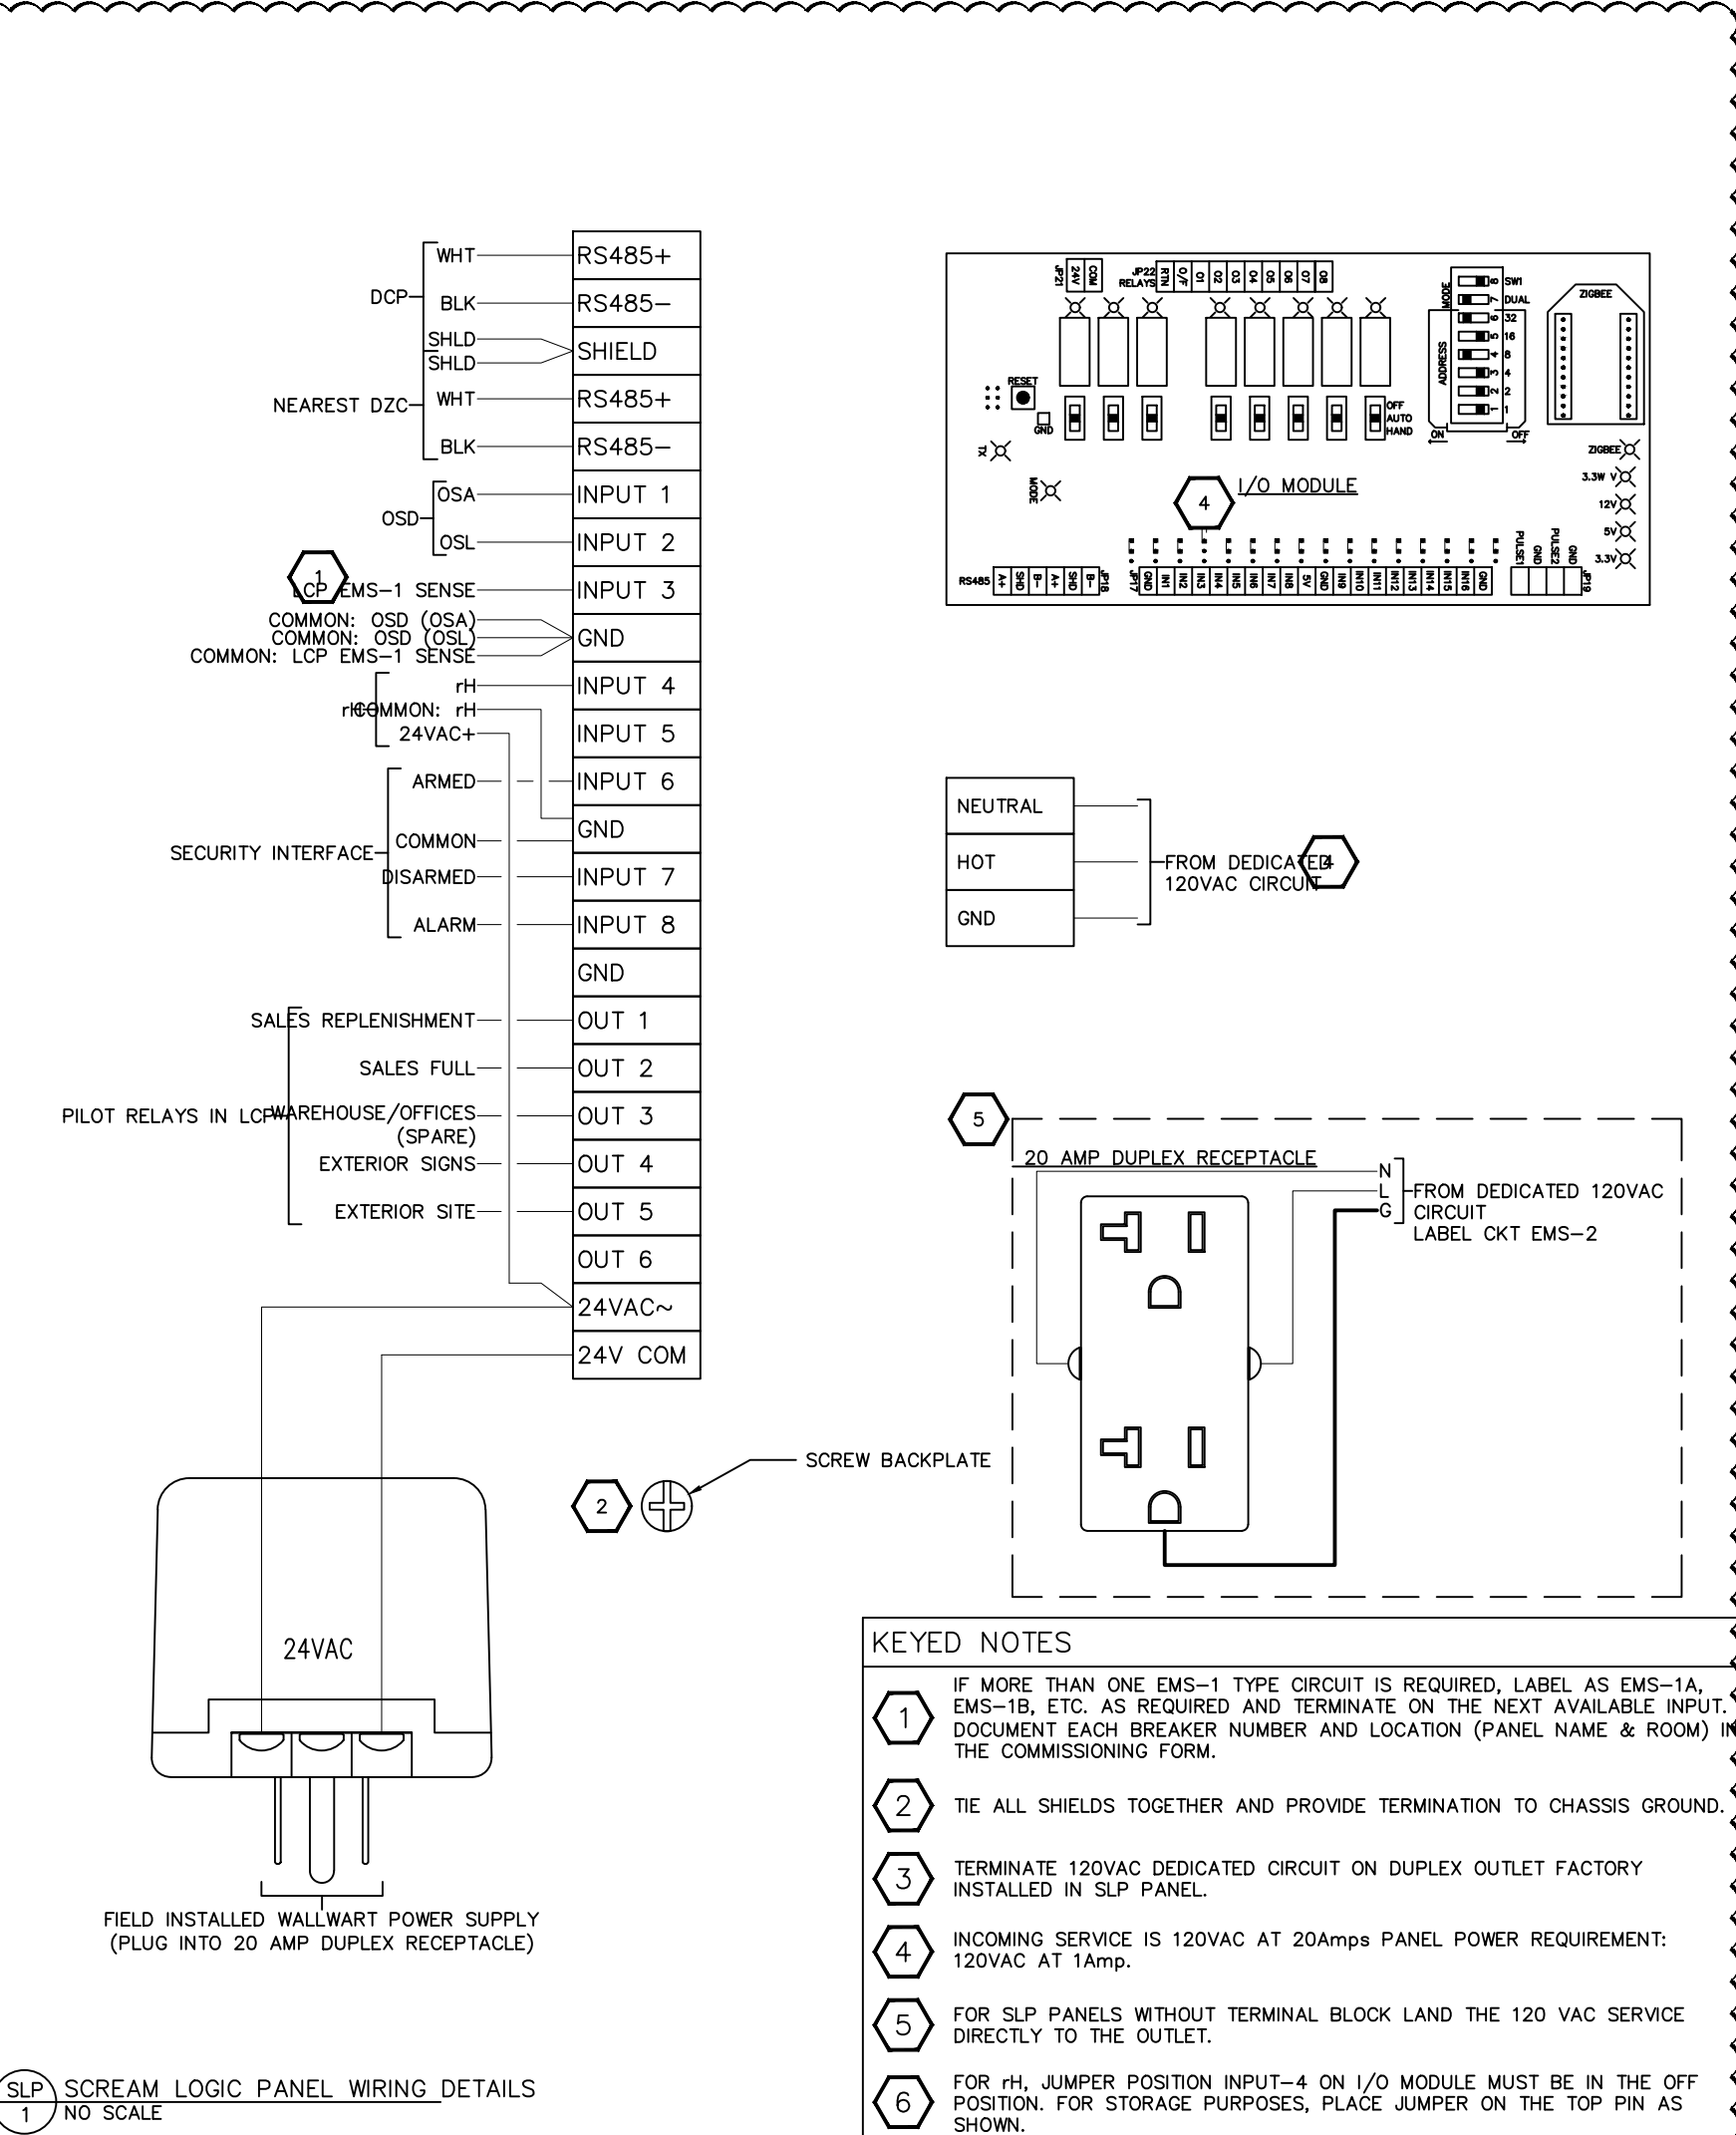


SLP SCREAM LOGIC PANEL WIRING DETAILS
1 NO SCALE

- KEYED NOTES**
- IF MORE THAN ONE EMS-1 TYPE CIRCUIT IS REQUIRED, LABEL AS EMS-1A, EMS-1B, ETC. AS REQUIRED AND TERMINATE ON THE NEXT AVAILABLE INPUT. DOCUMENT EACH BREAKER NUMBER AND LOCATION (PANEL NAME & ROOM) IN THE COMMISSIONING FORM.
 - TIE ALL SHIELDS TOGETHER AND PROVIDE TERMINATION TO CHASSIS GROUND.
 - TERMINATE 120VAC DEDICATED CIRCUIT ON DUPLEX OUTLET FACTORY INSTALLED IN SLP PANEL.
 - INCOMING SERVICE IS 120VAC AT 20amps PANEL POWER REQUIREMENT: 120VAC AT 1amp.
 - FOR SLP PANELS WITHOUT TERMINAL BLOCK LAND THE 120 VAC SERVICE DIRECTLY TO THE OUTLET.
 - FOR H, JUMPER POSITION INPUT-4 ON I/O MODULE MUST BE IN THE OFF POSITION. FOR STORAGE PURPOSES, PLACE JUMPER ON THE TOP PIN AS SHOWN.

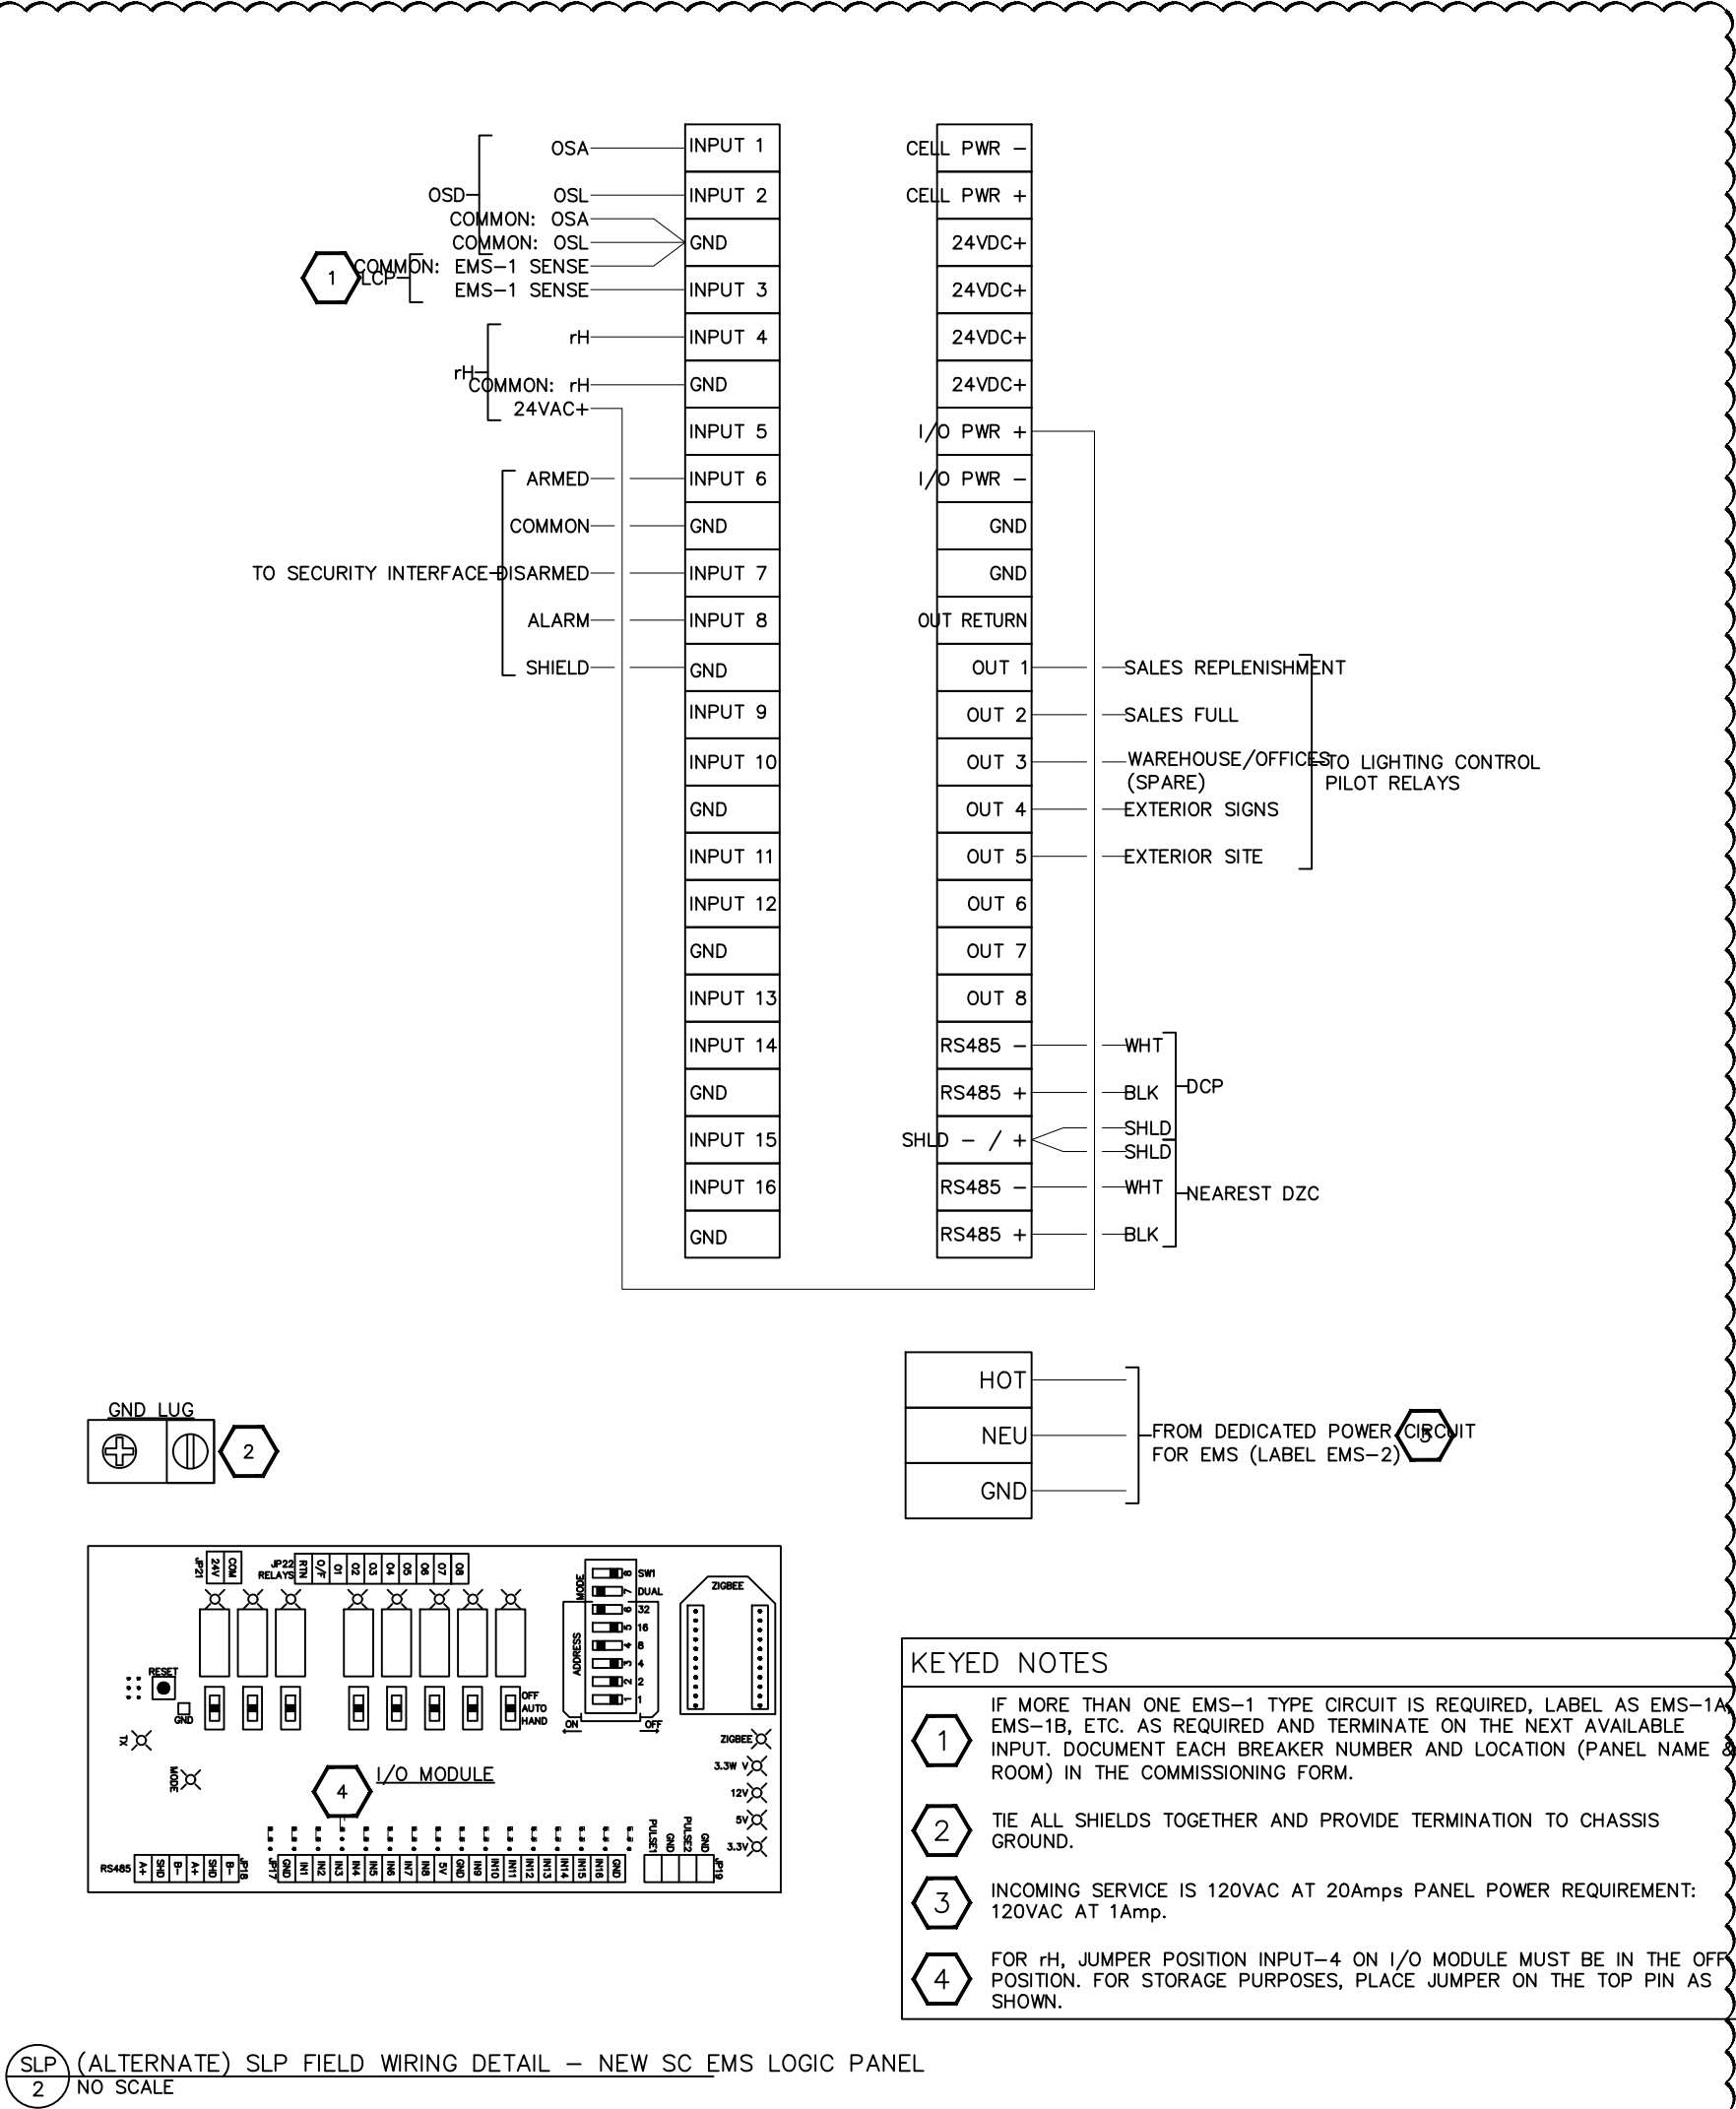

SLP (ALTERNATE) SLP FIELD WIRING DETAIL - NEW SC EMS LOGIC PANEL
2 NO SCALE

- KEYED NOTES**
- IF MORE THAN ONE EMS-1 TYPE CIRCUIT IS REQUIRED, LABEL AS EMS-1A, EMS-1B, ETC. AS REQUIRED AND TERMINATE ON THE NEXT AVAILABLE INPUT. DOCUMENT EACH BREAKER NUMBER AND LOCATION (PANEL NAME & ROOM) IN THE COMMISSIONING FORM.
 - TIE ALL SHIELDS TOGETHER AND PROVIDE TERMINATION TO CHASSIS GROUND.
 - INCOMING SERVICE IS 120VAC AT 20amps PANEL POWER REQUIREMENT: 120VAC AT 1amp.
 - FOR H, JUMPER POSITION INPUT-4 ON I/O MODULE MUST BE IN THE OFF POSITION. FOR STORAGE PURPOSES, PLACE JUMPER ON THE TOP PIN AS SHOWN.

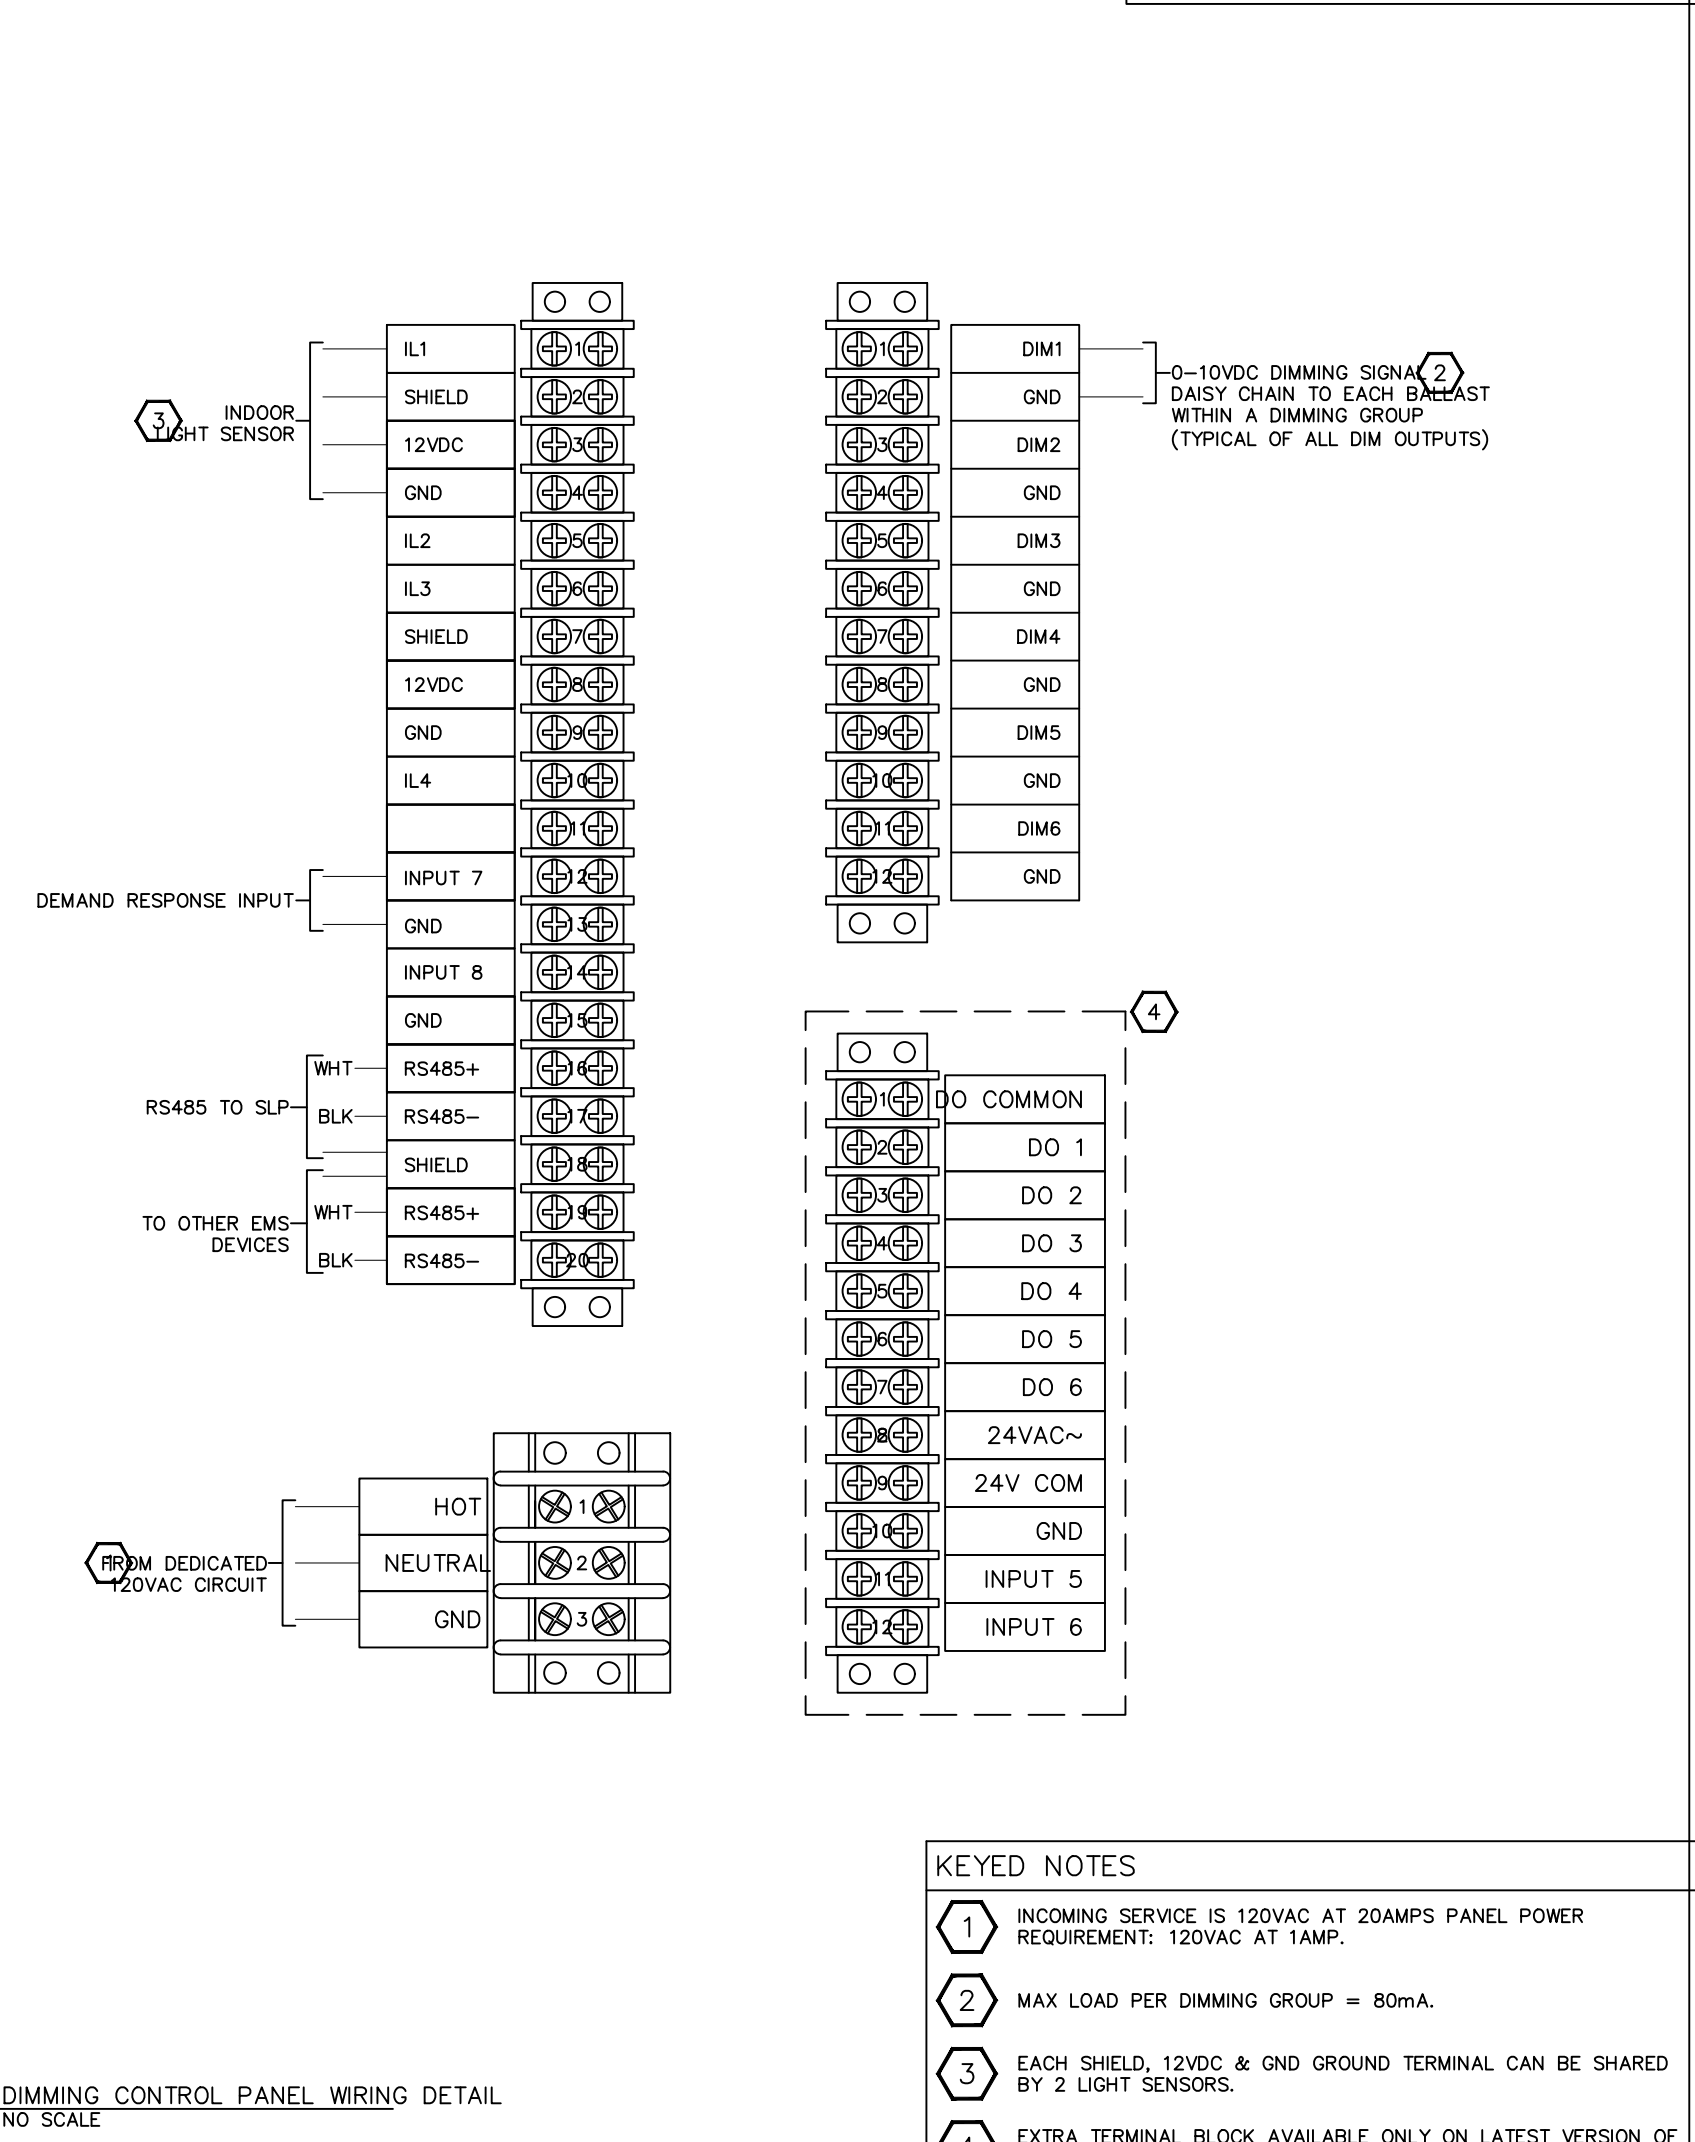

DCP DIMMING CONTROL PANEL WIRING DETAIL
1 NO SCALE

- KEYED NOTES**
- INCOMING SERVICE IS 120VAC AT 20amps PANEL POWER REQUIREMENT: 120VAC AT 1AMP.
 - MAX LOAD PER DIMMING GROUP = 80mA.
 - EACH SHIELD, 12VDC & GND GROUND TERMINAL CAN BE SHARED BY 2 LIGHT SENSORS.
 - EXTRA TERMINAL BLOCK AVAILABLE ONLY ON LATEST VERSION OF DCP.

Project: **HARBOR FREIGHT NEW CONSTRUCTION NATIONAL EMS BID SET**

Description: **PROTOTYPICAL NATIONAL EMS BID SET**


Date: 11-15-17

Scale: NTS

Drawing File Name/Origin: Harbor Freight-Bid Set-Rev8.dwg


#	DESCRIPTION	DATE	BY
0	Initial Release	11-15-17	MS
4	Revised	8-12-19	MS
5	Revised	10-10-19	MS
6	Revised	3-3-20	MS
7	Revised	4-13-20	MS
8	Revised	6-2-20	MS
9	Revised	6-28-22	MS

SIEMENS
9225 BEE CAVES ROAD, BLDG. B, SUITE 100,
AUSTIN, TEXAS 78733 Phone: 512-421-6257

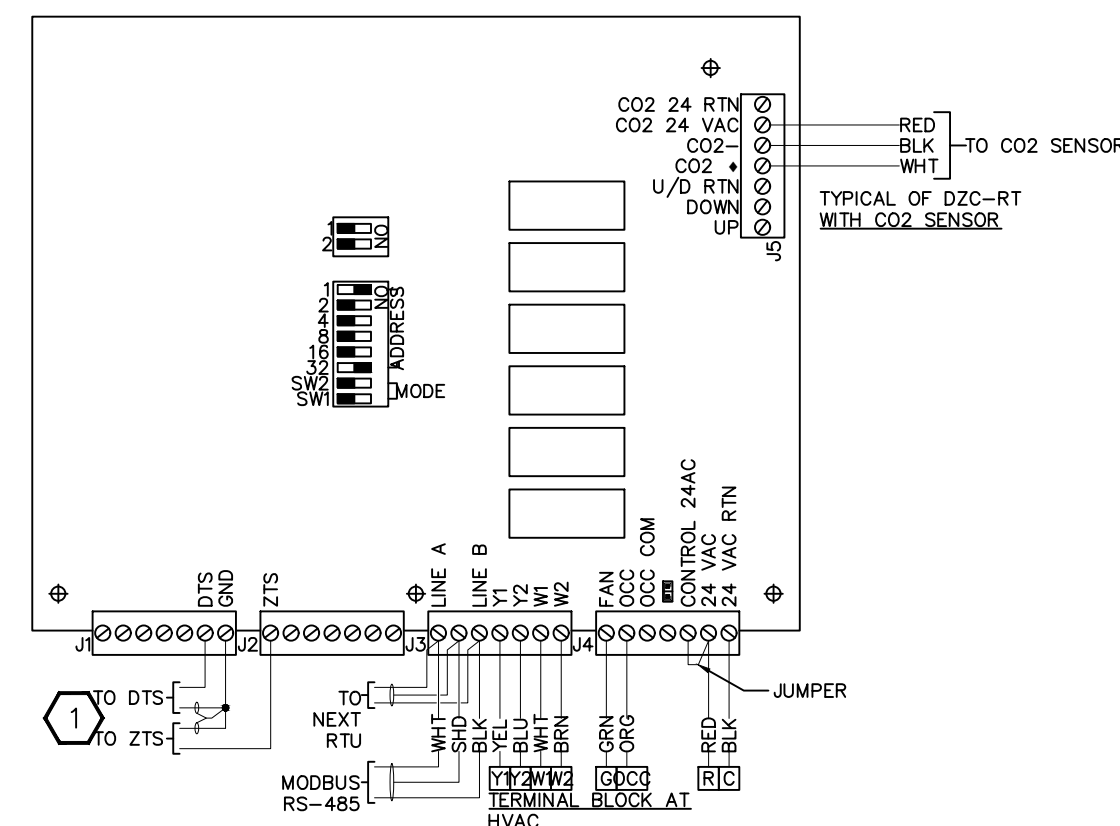

DZC-II ROOFTOP DIGITAL ZONE CONTROLLER WIRING DETAIL
1 NO SCALE

KEYED NOTES
1 TERMINATE COMMON SIGNAL AND SHIELD DRAIN WIRES ON GND TERMINAL.

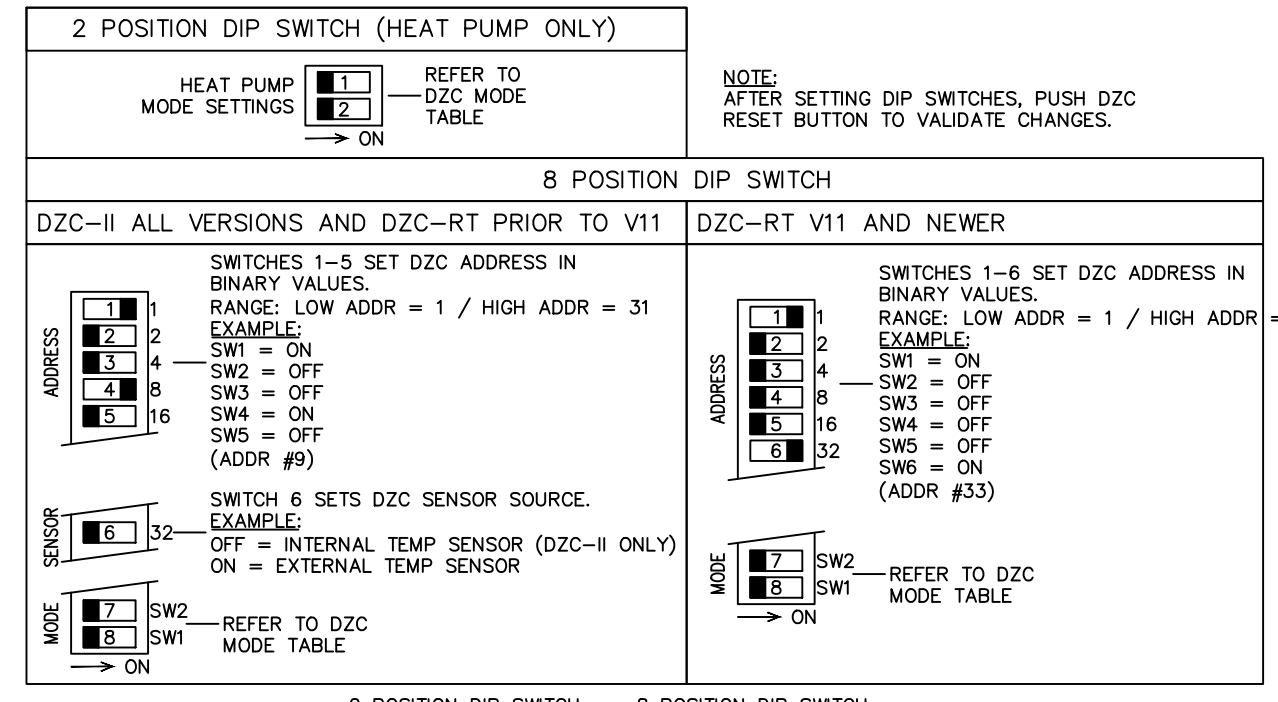


DZC MODE TABLE

MODE	1	2	1	2	3	4	5	6	7	8
MODE1: HP SINGLE STAGE WITH AUX RE-HEAT	ON	OFF	X	X	X	X	X	X	OFF	OFF
MODE2: HP MULTI STAGE WITH AUX RE-HEAT	ON	OFF	X	X	X	X	X	X	ON	OFF
MODE1: HP SINGLE STAGE WITH AUX RE-HEAT	OFF	ON	X	X	X	X	X	X	OFF	OFF
MODE2: HP MULTI STAGE WITH AUX RE-HEAT	OFF	ON	X	X	X	X	X	X	ON	OFF
MODE 5 - STANDARD SINGLE STAGE HEATING/COOLING	OFF	OFF	X	X	X	X	X	X	OFF	OFF
MODE 6 - STANDARD MULTI-STAGE HEATING/COOLING	OFF	OFF	X	X	X	X	X	X	OFF	ON
MODE 7 (AVAILABLE ON V11 OR NEWER) - MULTI-STAGE HEATING/3 STAGE COOLING	OFF	OFF	X	X	X	X	X	X	ON	OFF


DZC SETTINGS
2 NO SCALE

KEYED NOTES
1 WHEN HEAT PUMP MODE IS SELECTED, "W1" IS USED FOR CONTROL OF THE REVERSING VALVE (O/B) AND "W2", "W3" FOR CONTROL OF AUXILIARY HEAT.

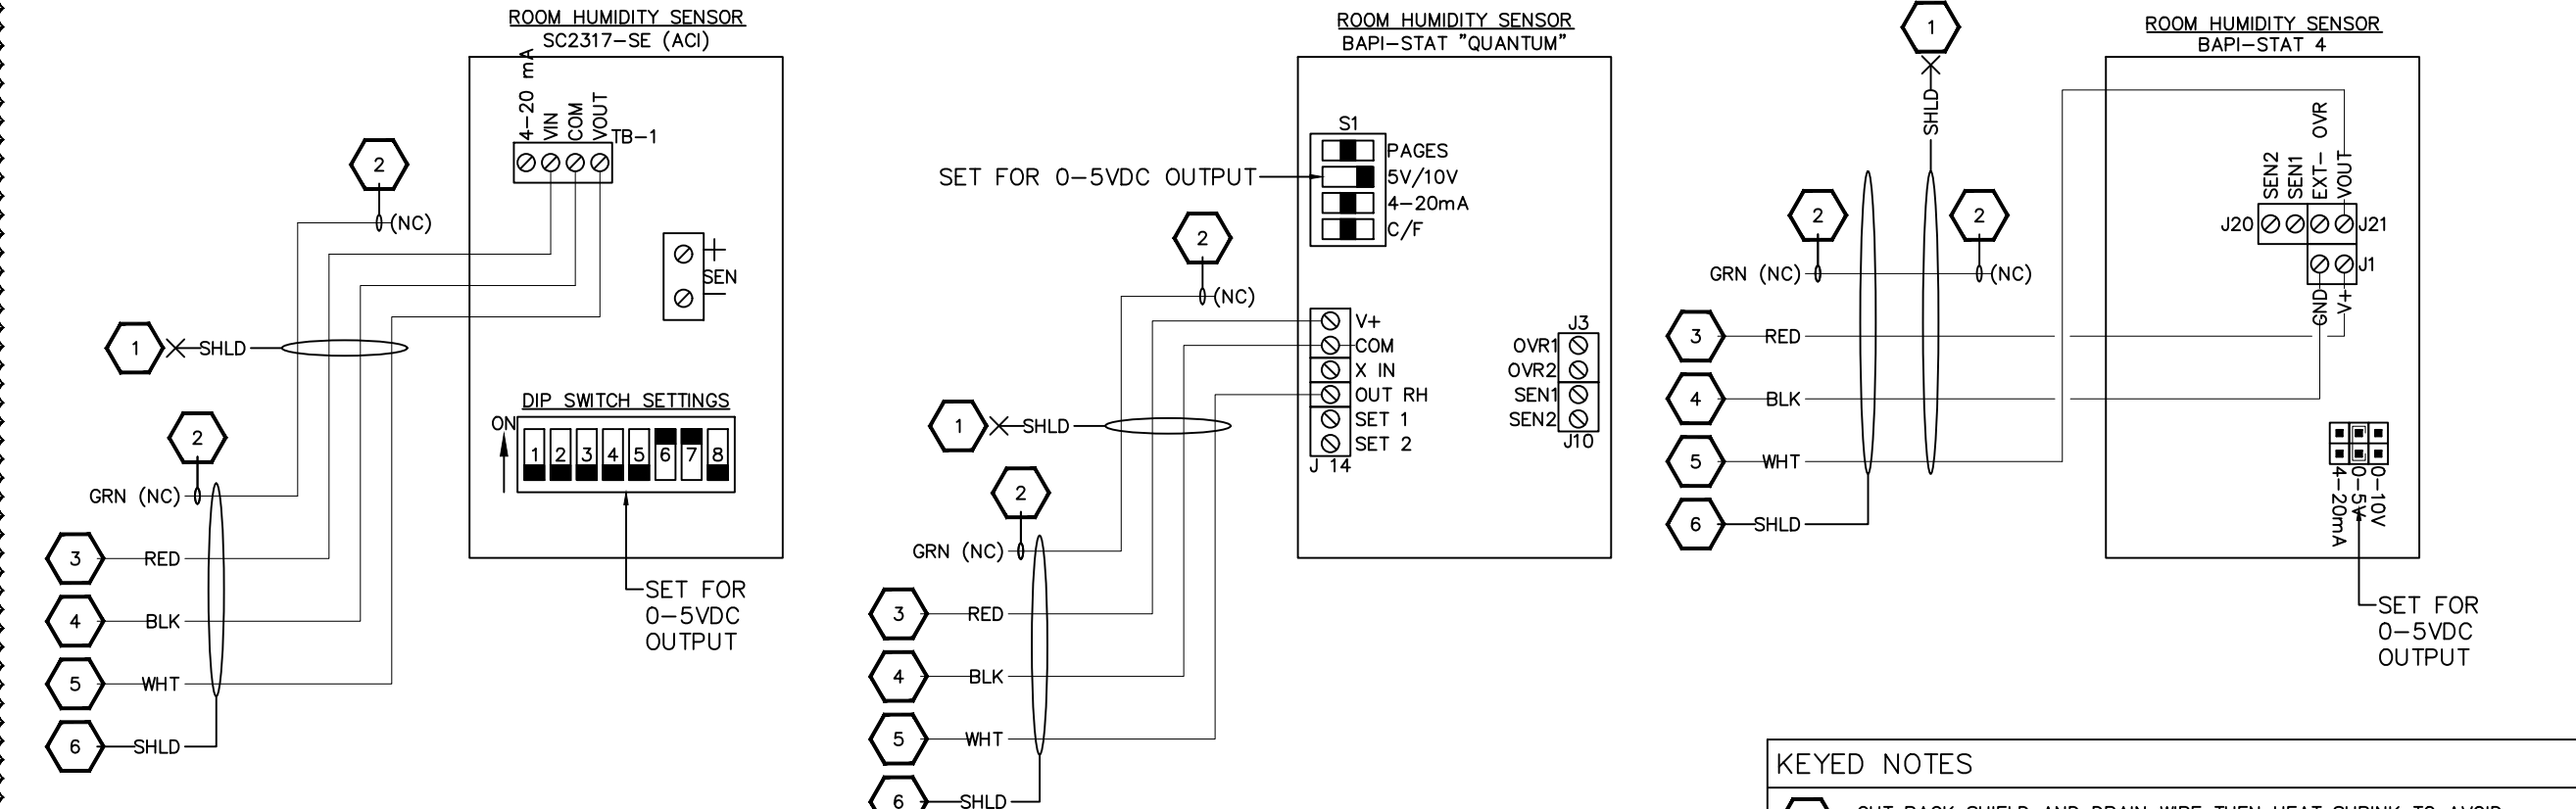


RELATIVE HUMIDITY SENSOR WIRING DETAIL
1 NO SCALE

KEYED NOTES
1 CUT BACK SHIELD AND DRAIN WIRE THEN HEAT SHRINK TO AVOID ACCIDENTAL SHORT TO GROUND.
2 DO NOT CUT SPARE CONDUCTOR, WRAP BACK AND TAPE (AT BOTH ENDS).
3 FOR SCREAM LOGIC PANEL: CONNECT TO "24VAC" FOR NEW SC EMS LOGIC PANEL: CONNECT TO "1/0 PWR +"
4 CONNECT TO "GND" IN SLP.
5 CONNECT TO "INPUT 4" IN SLP.
6 GND SHIELD.

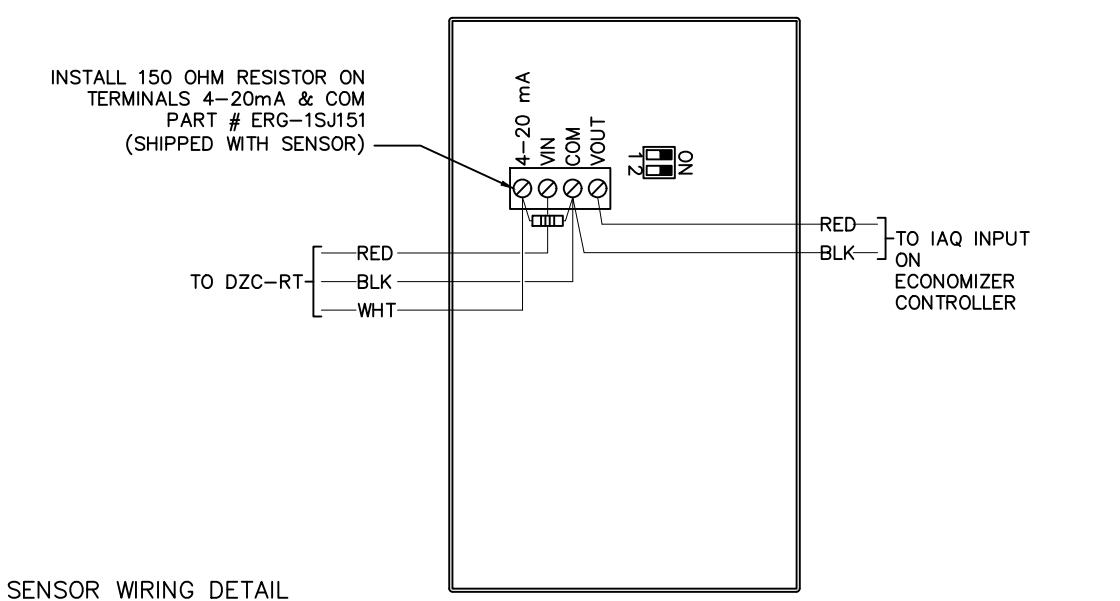


CO2 CO2 SENSOR WIRING DETAIL
1 NO SCALE

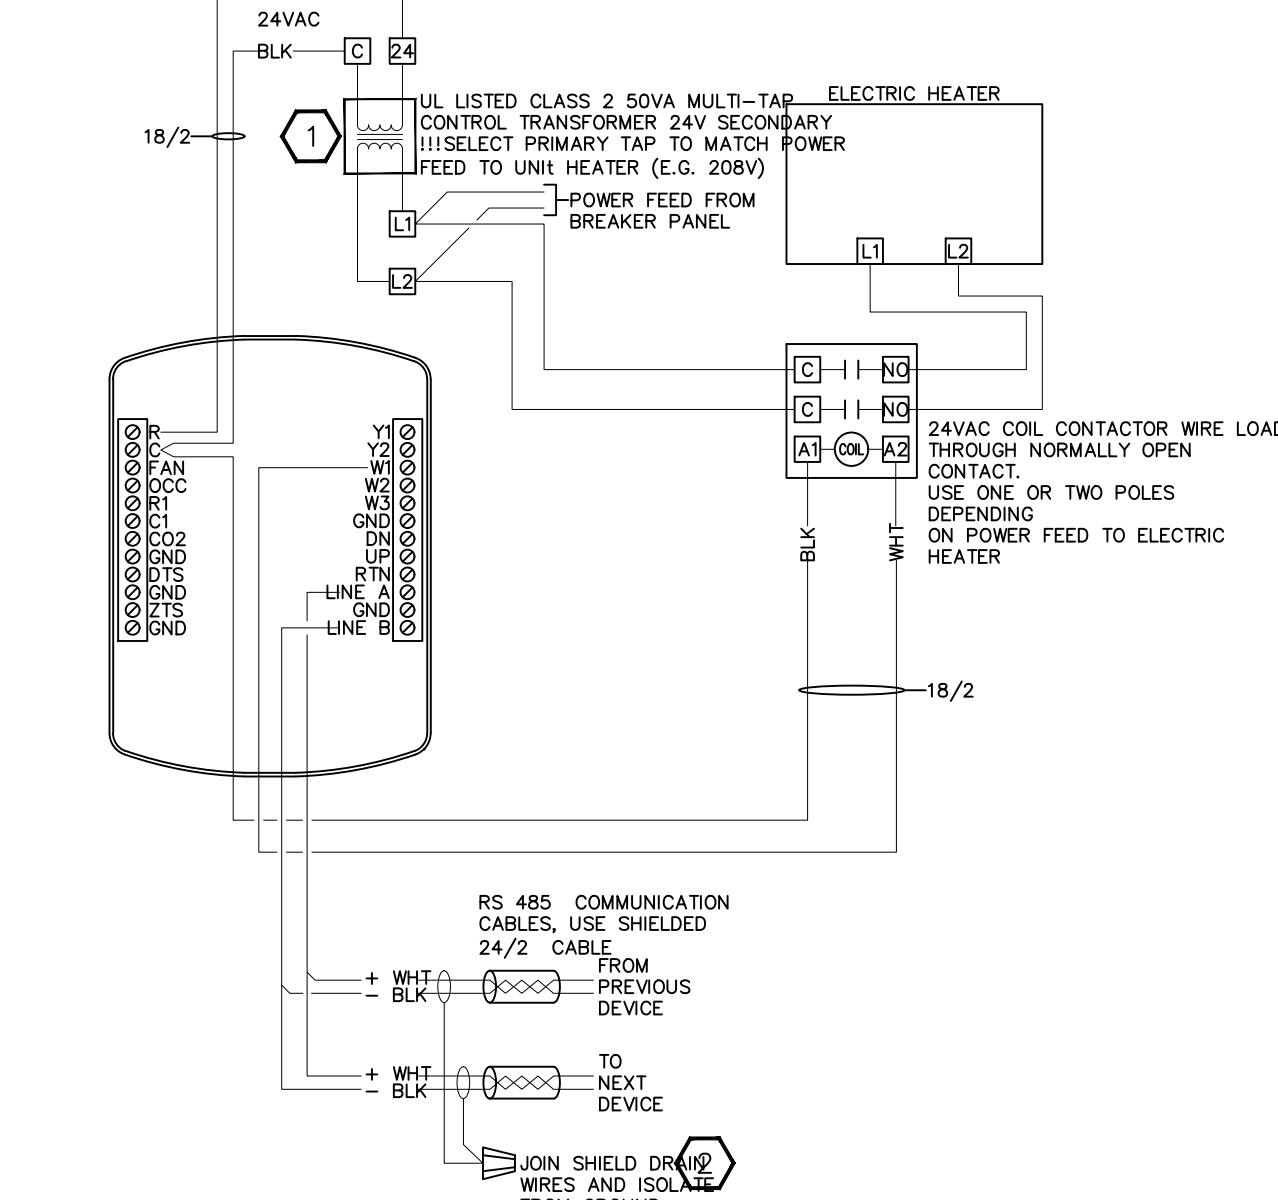


UH UNIT HEATER WIRING DETAIL
1 NO SCALE

KEYED NOTES
1 VERIFY THE CLASS 2 TRANSFORMER POWERING THE DZC HAS ITS 24V COMMON GROUNDED.
2 IF LAST DZC, CUT SHIELD AND DRAIN WIRE AND TAPE BACK.

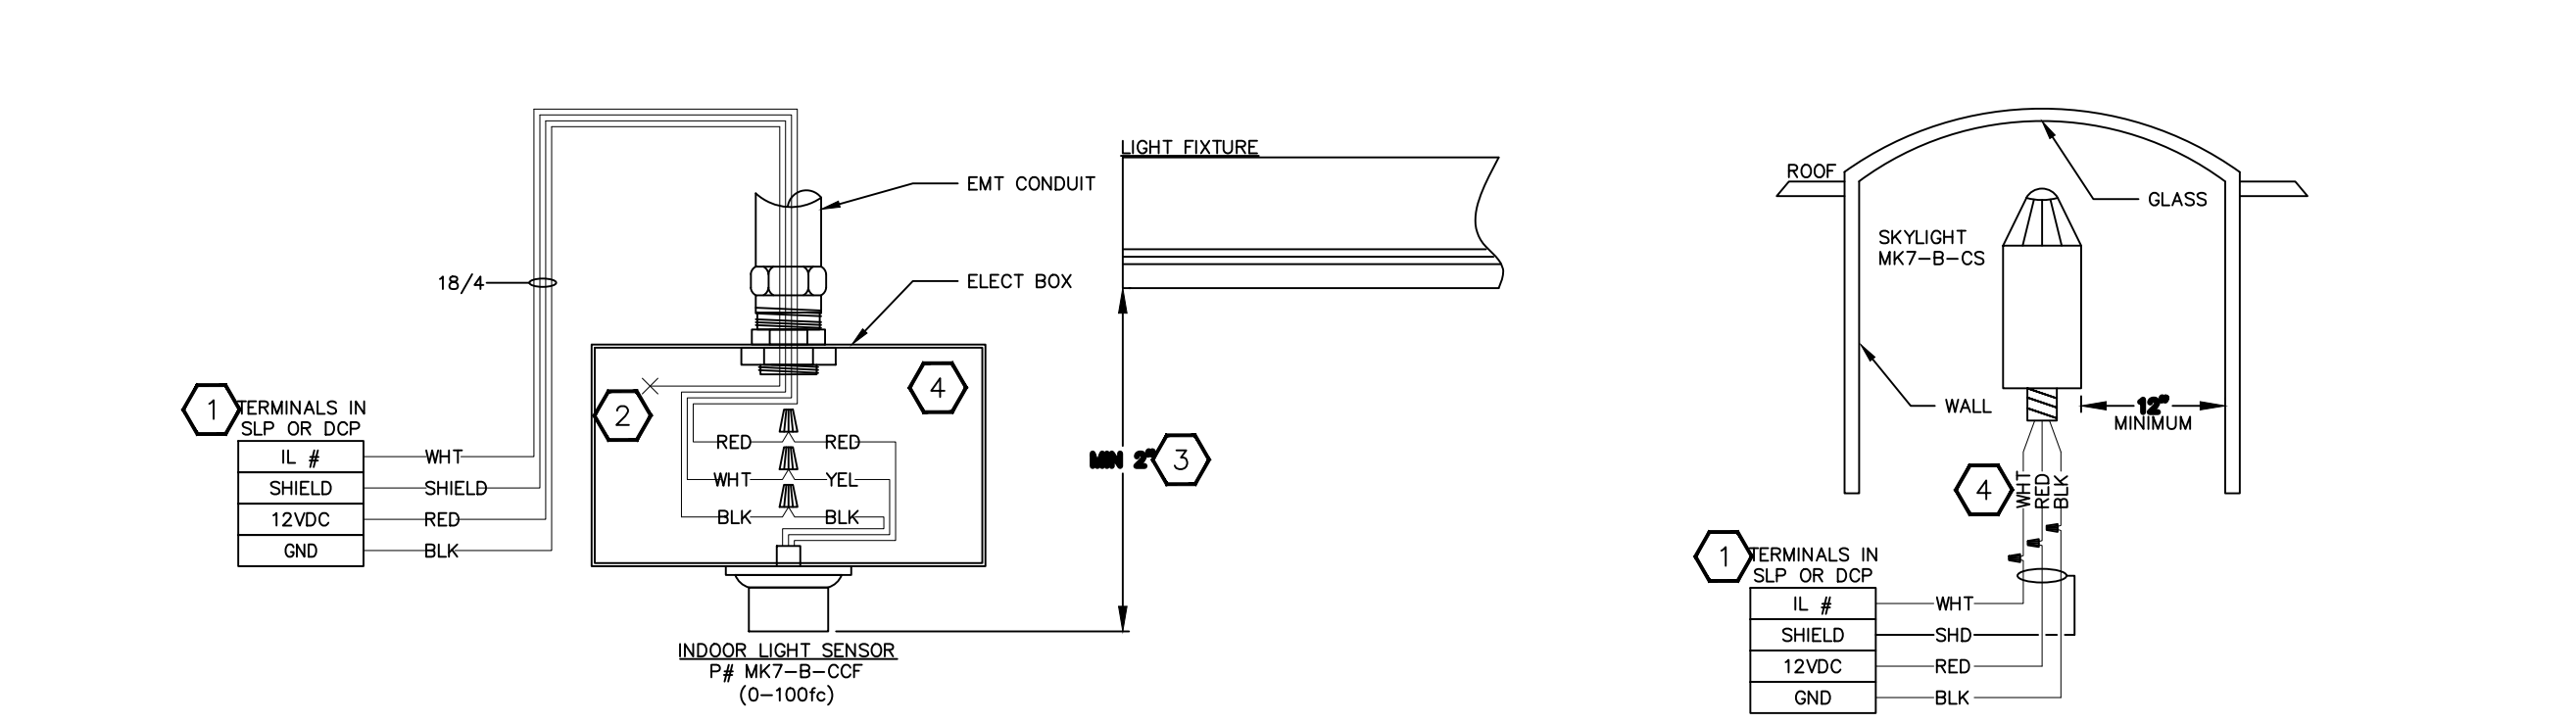


CEILING MOUNT / SKYLIGHT INDOOR LIGHT SENSOR WIRING DETAIL
1 NO SCALE

MOUNTING NOTES:
MOUNT SENSOR VERTICALLY, WITH THE DOME PORTION FACING UP. LOCATE SENSOR AS CLOSE TO ATRIUM WINDOWS (GLASS) AS POSSIBLE AND AS FAR AS POSSIBLE FROM THE WALLS (NO LESS THAN 2" BELOW LEVEL OF LIGHT FIXTURES).
KEYED NOTES
1 REFER TO SLP OR DCP WIRING DIAGRAM FOR DESCRIPTION OF TERMINALS AND ADDITIONAL DETAILS.
2 CUT SHIELD DRAIN WIRE AND TAPE BACK.
3 SENSOR MUST BE INSTALLED IN A LOCATION WHERE IT PROVIDES ADEQUATE CONTROL OF LIGHTING FIXTURES IN THE DAY LIT AREA. MOUNT SENSOR NO LESS THAN 2" BELOW LEVEL OF LIGHT FIXTURES.
4 FOR SKYLIGHT WIRING, SEE INDOOR LIGHT SENSOR WIRING DETAIL.

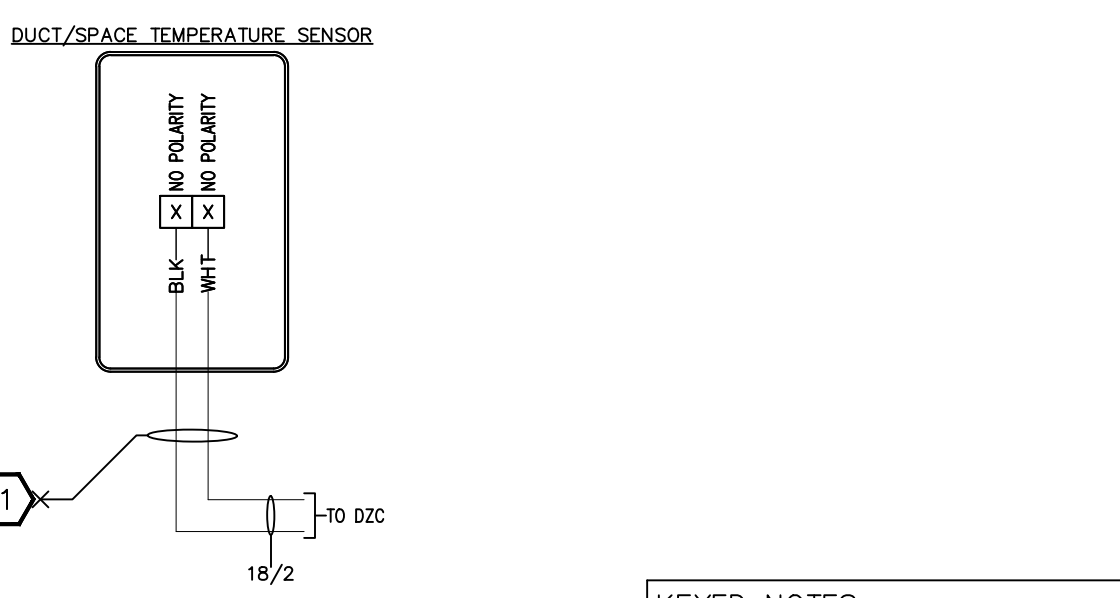


DS DUCT / SPACE SENSOR WIRING DETAIL
1 NO SCALE

KEYED NOTES
1 CUT BACK SHIELD AND DRAIN WIRE THEN HEAT SHRINK OR TAPE BACK TO AVOID ACCIDENTAL SHORT TO GROUND.

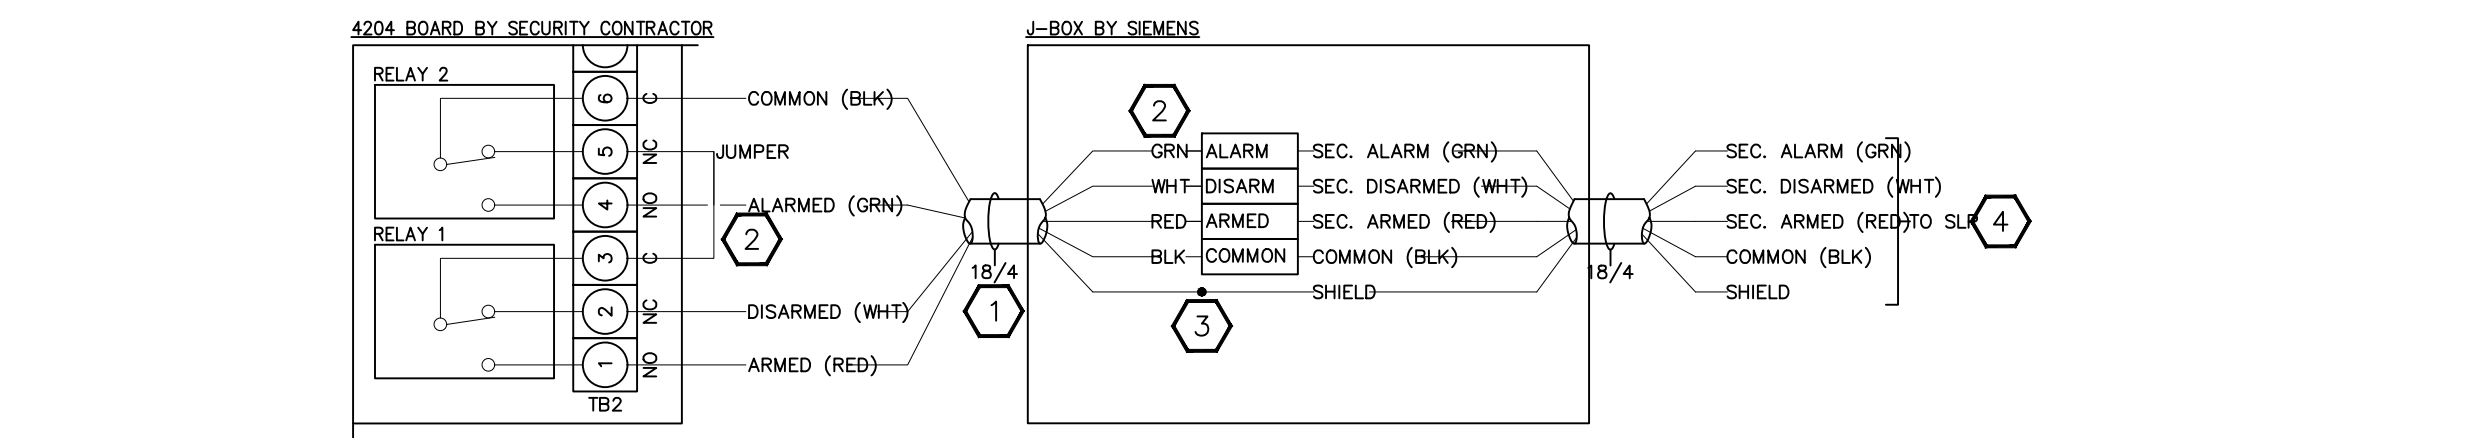

SEC SECURITY INTERFACE SYSTEM WIRING DETAIL
1 NO SCALE

KEYED NOTES
1 CUT AND TAPE BACK UNUSED CONDUCTORS AND SHIELD DRAIN AT SECURITY END.
2 CABLE PULLED BY SECURITY CONTRACTOR. IF SIEMENS HAS ALREADY MOUNTED JUNCTION BOX AND TERMINATED SIGNALS, THE SECURITY CONTRACTOR SHOULD REMOVE RESISTERS AND TERMINATE SECURITY RELAY SIGNALS AS SHOWN. OTHERWISE, THE SECURITY CONTRACTOR SHALL LEAVE ADEQUATE SERVICE LOOP (10 FEET MIN) AND SIEMENS WILL TERMINATE ONCE THE JUNCTION BOX HAS BEEN INSTALLED.
3 SPLICE CONDUCTORS USING WIRE NUT OR A SEALANT FILLED CONNECTOR.
4 DRAIN SHIELD WIRED TERMINATED TO GROUND ONLY AT SLP CONTROLLER.

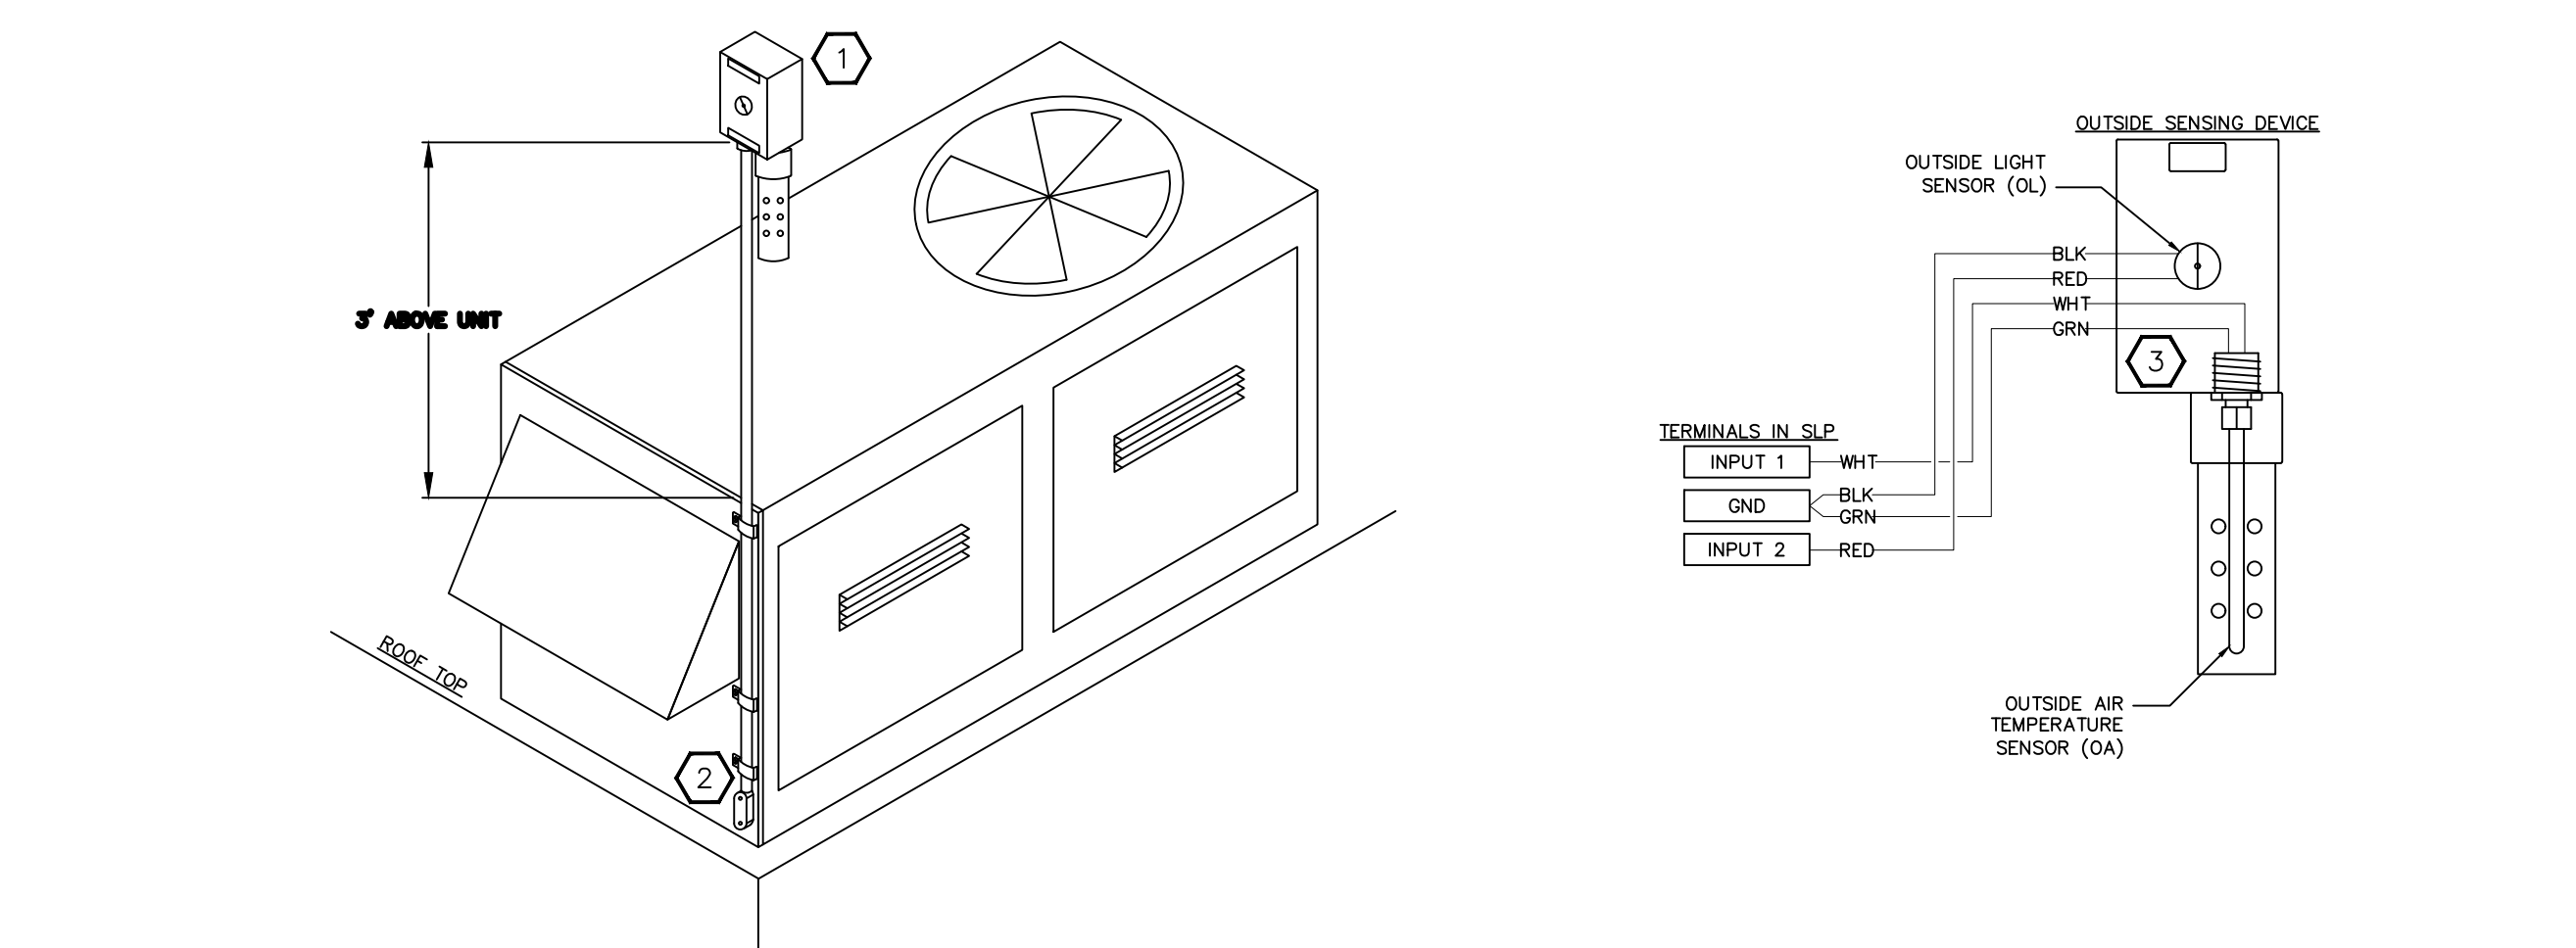

OSD OUTSIDE SENSING DEVICE MOUNTING AND WIRING DETAILS
1 NO SCALE


KEYED NOTES
1 MOUNT OSD 3' ABOVE RTU, FURTHEST FROM CONDENSER FANS. USE 1/2" ELECTRICAL CONDUIT. LIGHT SENSOR MUST FACE TRUE NORTH, UNLESS RE-ORIENTATION IS NECESSARY TO AVOID ARTIFICIAL LIGHTING (E.G. PARKING LIGHTS). INSTALLER SHALL NOT PENETRATE ROOF.
2 USE 1/2" LB FITTING AND RAINIGHT COMPRESSION CONNECTORS.
3 CONDUCTORS MUST BE SPLICED USING SEALANT FILLED CONNECTORS (DOLPHIN OR SIMILAR). MAKE SURE GASKET IS INSTALLED AND ASSEMBLY IS WATER TIGHT.

Project: HARBOR FREIGHT NEW CONSTRUCTION NATIONAL EMS BID SET
Description: PROTOTYPICAL NATIONAL EMS BID SET
Date: 11-15-17
Scale: NTS
Drawing File Name/Origin: Harbor Freight-Bid Set-Rev8.dwg


SIEMENS
9225 BEE CAVES ROAD, BLDG. B, SUITE 100,
AUSTIN, TEXAS 78733 Phone: 512-421-6257

REVISIONS	#	DESCRIPTION	DATE	BY
0	Initial	Release	11-15-17	MS
4	Revised		8-12-19	MS
5	Revised		10-10-19	MS
6	Revised		3-3-20	MS
7	Revised		4-13-20	MS
8	Revised		6-2-20	MS
9	Revised		6-28-22	MS

EMS-3

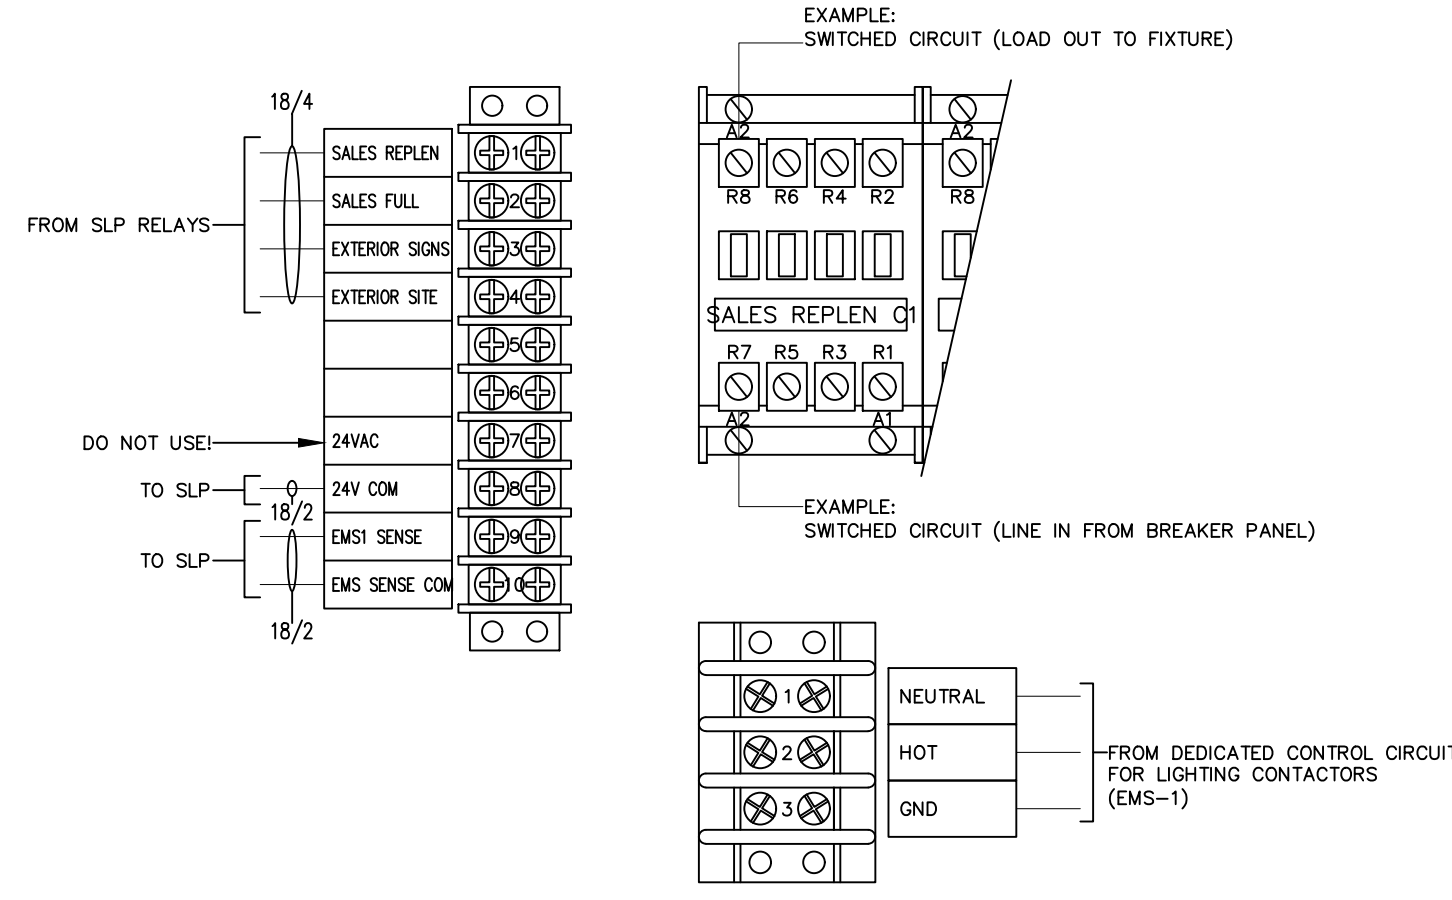


1 LCP LIGHTING CONTROL PANEL WIRING DETAIL
NO SCALE

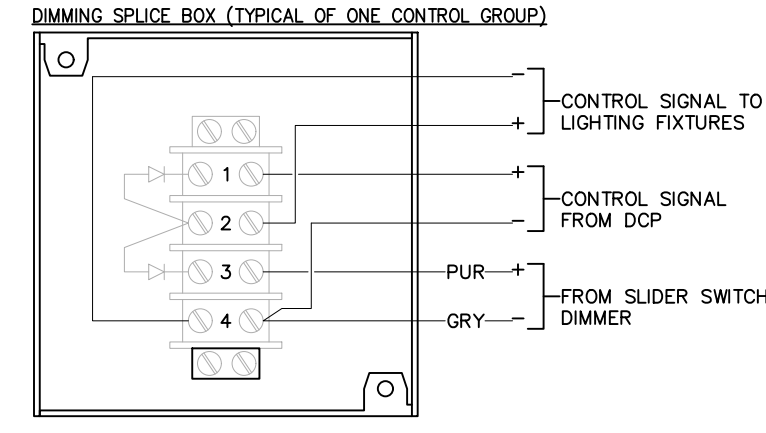

1 SB DIMMING SPLICE BOX WIRING DETAIL
NO SCALE

KEYED NOTES
1 SLIDER SWITCH: DIMMING CONTROL, 0-10VDC, 200MA, SINK DIMMING. REFERENCE P# EATON SF10C.

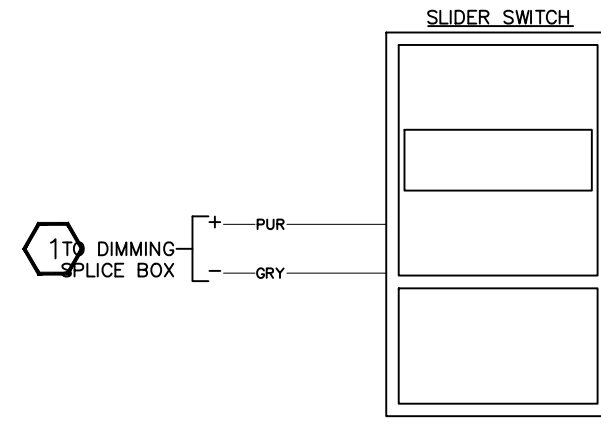

1 SB SLIDER SWITCH WIRING DETAIL
NO SCALE

SIEMENS
9225 BEE CAVES ROAD, BLDG. B, SUITE 100,
AUSTIN, TEXAS 78733 Phone: 512-421-6257


Project: HARBOR FREIGHT
NEW CONSTRUCTION
Date: 11-15-17
Scale: NTS

Description: PROTOTYPICAL
NATIONAL EMS BID SET
Drawing File Name/Origin: Harbor Freight-Bid Set-Rev8.dwg

REVISIONS

#	DESCRIPTION	DATE	BY
0	Initial Release	11-15-17	MS
4	Revised	8-12-19	MS
5	Revised	10-10-19	MS
6	Revised	3-3-20	MS
7	Revised	4-13-20	MS
8	Revised	6-2-20	MS
9	Revised	6-28-22	MS

EMS-4

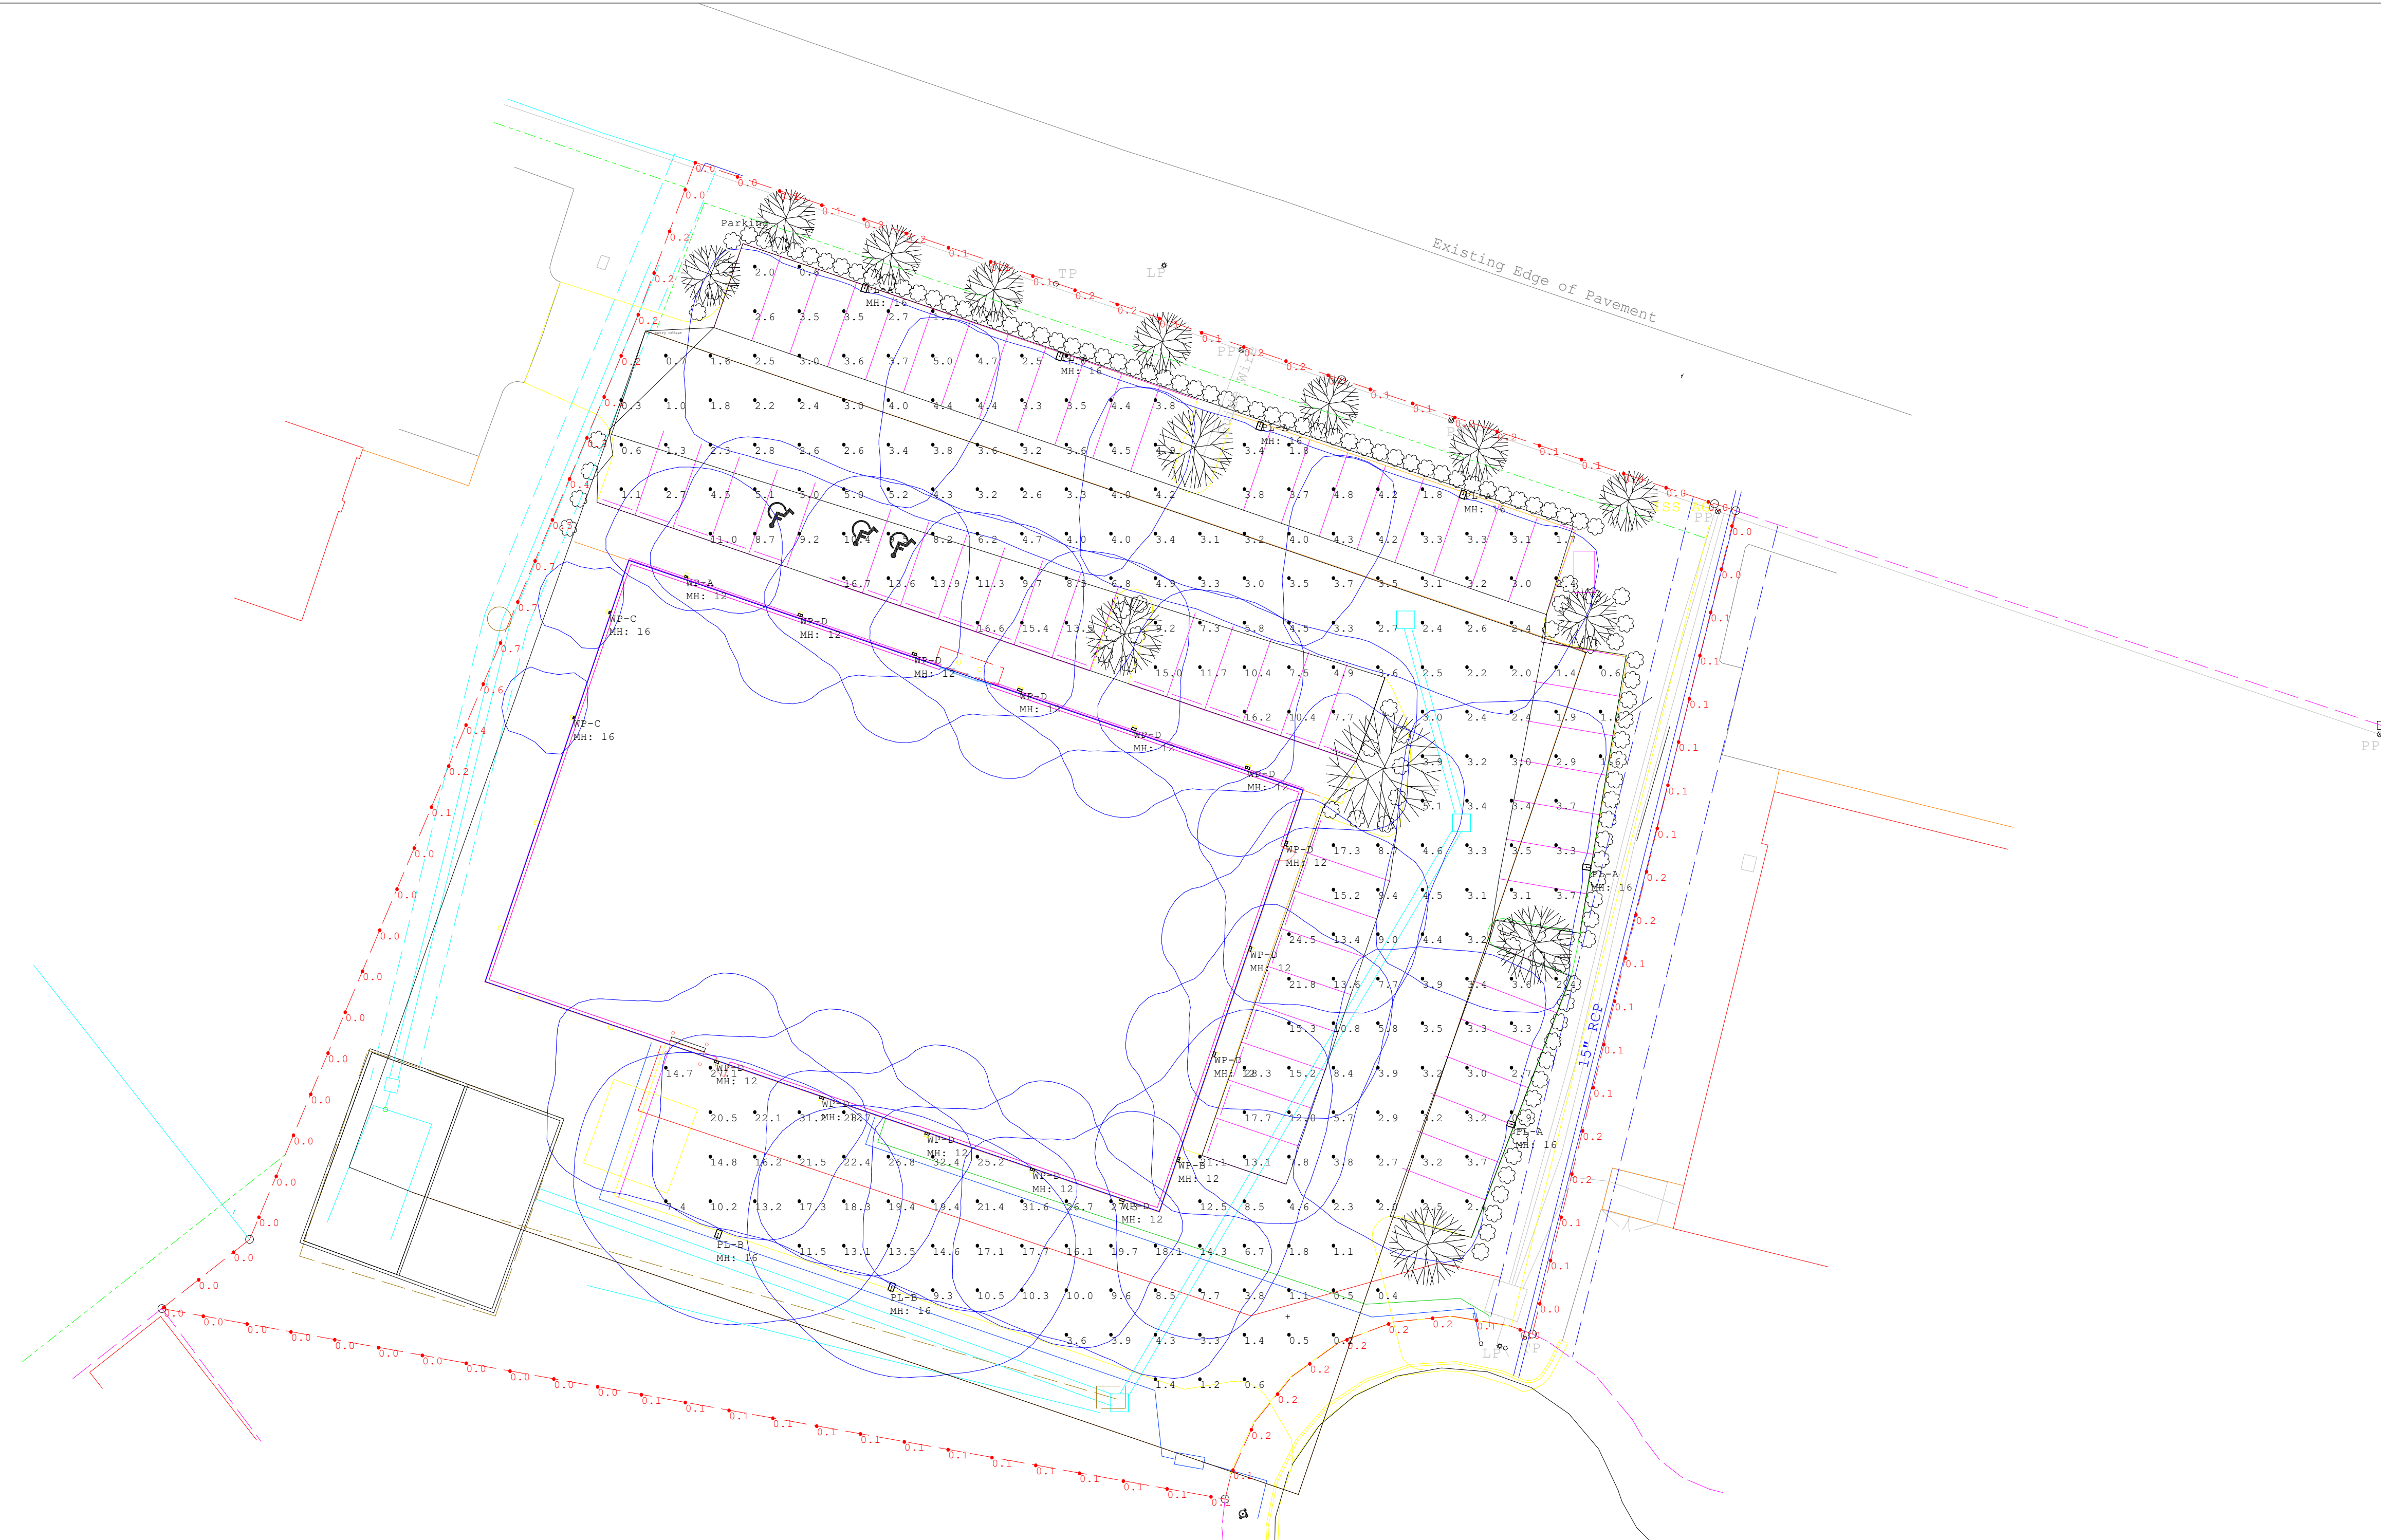

Symbol	Qty	Label	Arrangement	LLF	Description	Lum. Watts	Total Watts	Lum. Lumens	MANUFACTURER
□	6	FL-A	SINGLE	0.890	LITH # R2A-PIED-IV-FT-80LED-350mA-40K-HS-RFA-16'-6E-DM19-F-B-C-COLOR	85.4	512.4	9255	U.S. ARCHITECTURAL LIGHTING
□	2	FL-B	SINGLE	0.890	LITH # R2A-PIED-IV-FT-80LED-350mA-40K-HS-RFA-16'-6E-DM19-F-B-C-COLOR	109	216	14189	U.S. ARCHITECTURAL LIGHTING
□	1	WP-B	SINGLE	0.890	LITH # WDGE4 LED P2 70CRI R3 40K	109.02	109.02	15911	Lithonia Lighting
□	1	WP-A	SINGLE	0.890	LITH # WDGE2 LED P5 40K 80CRI VF	48.44	48.44	5998	Lithonia Lighting
□	13	WP-D	SINGLE	0.890	LITH # WDGE4 LED P3 70CRI R4 40K	124.86	1623.18	18524	Lithonia Lighting
□	2	WP-C	SINGLE	0.890	LITH # WDGE1 LED P1 40K 80CRI VF	10.0002	20.0004	1227	Lithonia Lighting

Label	CalcType	Units	Avg	Max	Min	Avg/Min	Max/Min
CalcPts 1	Illuminance	Fc	7.22	32.4	0.2	36.10	162.00
PROPERTY LINE	Illuminance	Fc	0.12	0.7	0.0	N.A.	N.A.
50' Entry Offset	Illuminance	Fc	8.57	32.4	0.1	85.70	324.00
Parking	Illuminance	Fc	6.63	28.3	0.6	11.05	47.17

Curb Inlet
TBOC = 194.09
Iny Out = 192.16



#	Date	Comments
Revisions		

Drawn By: MEGAN WALL
Checked By:
Date: 4/24/2024
Scale:

24RD-MW-Harbor Freight--B-0422


GENERAL NOTES:

- MATERIALS AND INSTALLATION SHALL COMPLY WITH APPLICABLE NFPA CODES (NFPA 13 2013 EDITION), STATE BUILDING CODE, LOCAL AUTHORITY HAVING JURISDICTION, AND INSURANCE UNDERWRITER'S REQUIREMENTS.
- ALL MATERIALS AND EQUIPMENT SHALL BE NEW, UL LISTED FOR THE INTENDED USE AND SHALL BE INSTALLED IN FULL COMPLIANCE WITH MANUFACTURER'S RECOMMENDATIONS.
- ALL NEW SPRINKLER PIPE 1" AND SMALLER IS SCHEDULE-40 BLACK STEEL WITH THREADED ENDS AND FITTINGS. ALL NEW SPRINKLER PIPE 1 1/4" AND LARGER IS SCHEDULE-10 BLACK STEEL WITH GROOVED ENDS AND FITTINGS.
- SPRINKLER HEAD SPACING IS BASED ON THE NFPA STANDARDS FOR ORDINARY HAZARD OCCUPANCIES ALLOWING A MAXIMUM HEAD SPACING OF 130 S.F. PER HEAD.
- LOCATIONS OF PIPING AS SHOWN ON THE DRAWINGS ARE APPROXIMATE AND SUBJECT TO MINOR ADJUSTMENTS IN THE FIELD.
- SCOPE OF WORK IS TO INSTALL A NEW ONE RISER SPRINKLER SYSTEM FOR NEW SHELL BUILDING.
- THE WATER TEST INFORMATION HAS BEEN PROVIDED BY J&D SPRINKLER DATED 2/6/2024 INDICATES THE FOLLOWING...


STATIC: 52 PSI
 RESIDUAL: 36 PSI
 FLOW: 840 GPM

SYMBOLS:

- DENOTES A HYDRAULIC CALCULATION POINT OF REFERENCE
- DENOTES A HYDRAULIC REMOTE AREA
- DENOTES NEW SPRINKLER PIPE
- DENOTES UNDERGROUND PIPE
- DENOTES PIPE CENTERLINE ELEVATION AFF
- DENOTES PIPE CENTERLINE BELOW TOP OF STEEL

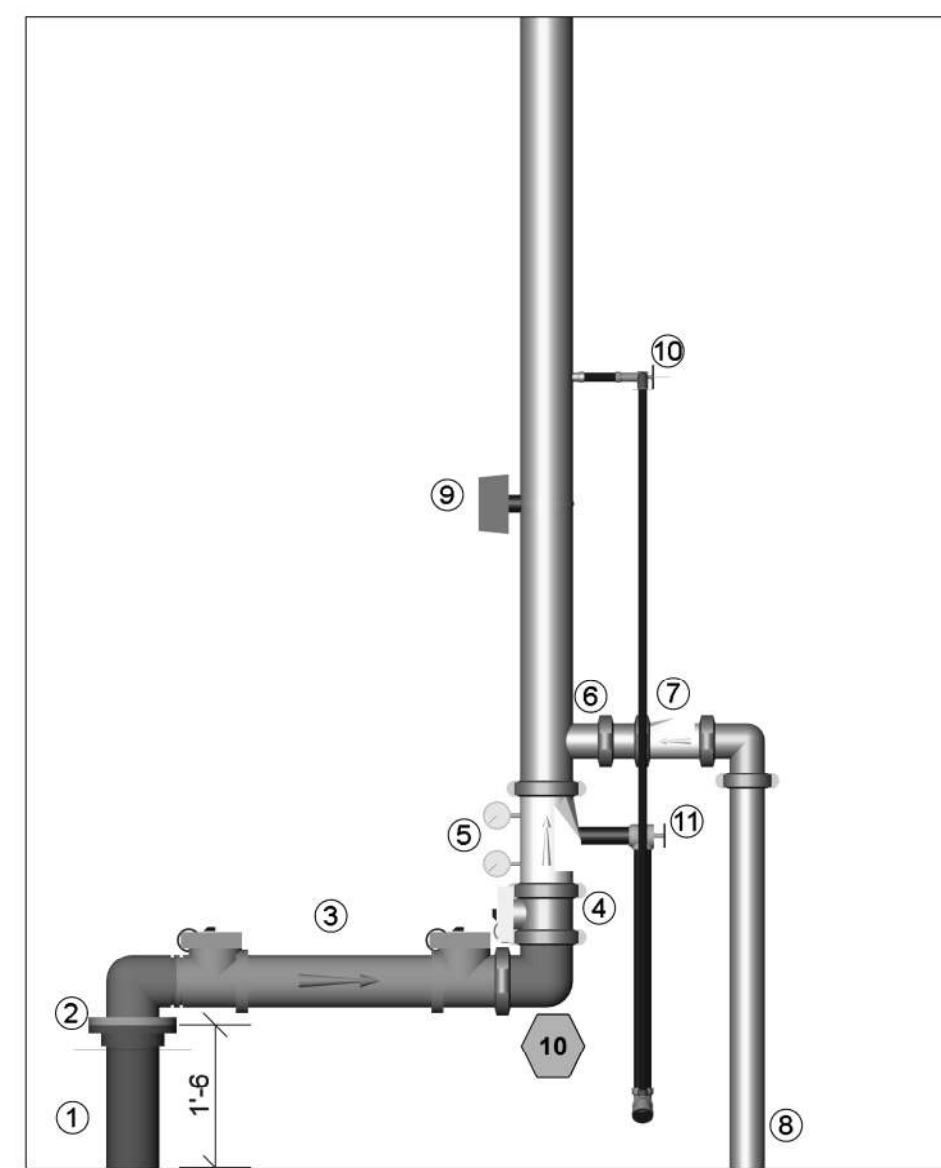


RISER DETAIL
0 1/2" = 1 Foot

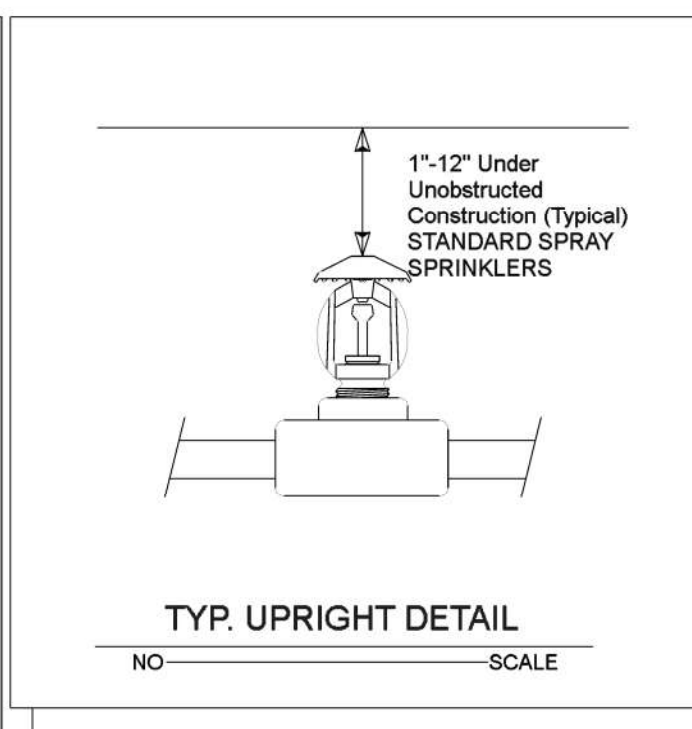


TYP. UPRIGHT DETAIL
NO SCALE


- ### RISER LEGEND
- 6" RUN-IN BY OTHERS
 - 6" GRV-SPLIT FLANGE
 - 6" WILKINS 375ASTDA BACKFLOW
 - 6" BUTTERFLY CONTROL VALVE W/TAMPER
 - 6" VIKING EZ RISER CHECK VALVE
 - 4" GRV OUTLET
 - 4" SWING CHECK VALVE
 - OUT TO YARD FDC
 - FLOW SWITCH
 - TEST & DRAIN ASSMBLY
 - 2" MAIN DRAIN

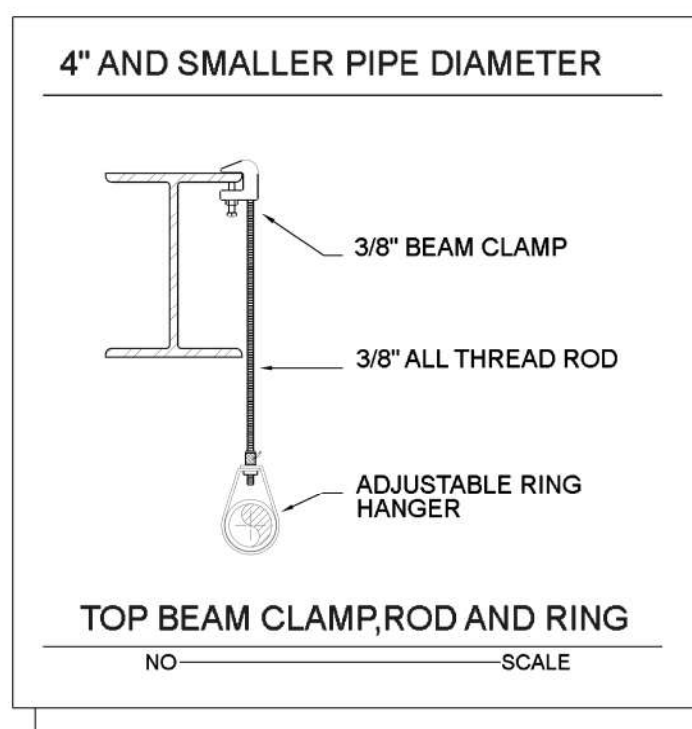

TOP BEAM CLAMP, ROD AND RING
NO SCALE

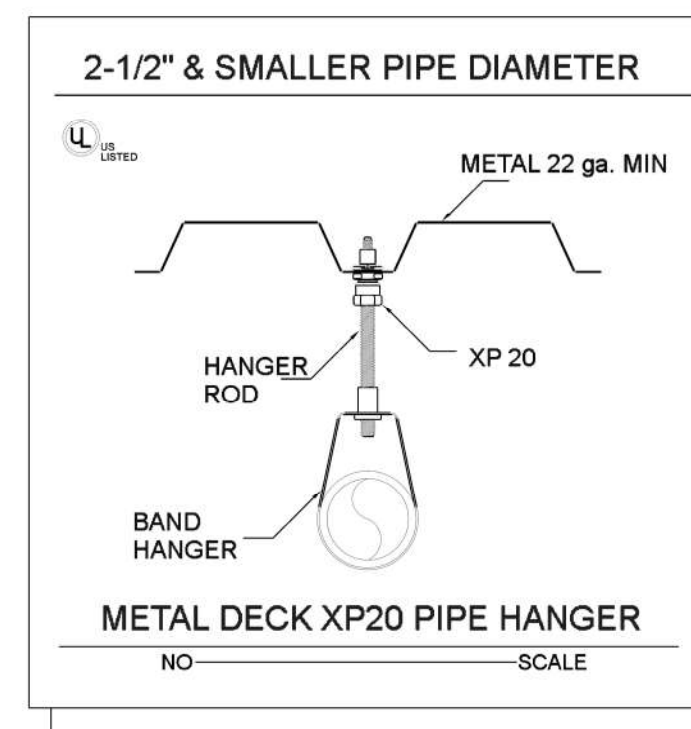

METAL DECK XP20 PIPE HANGER
NO SCALE

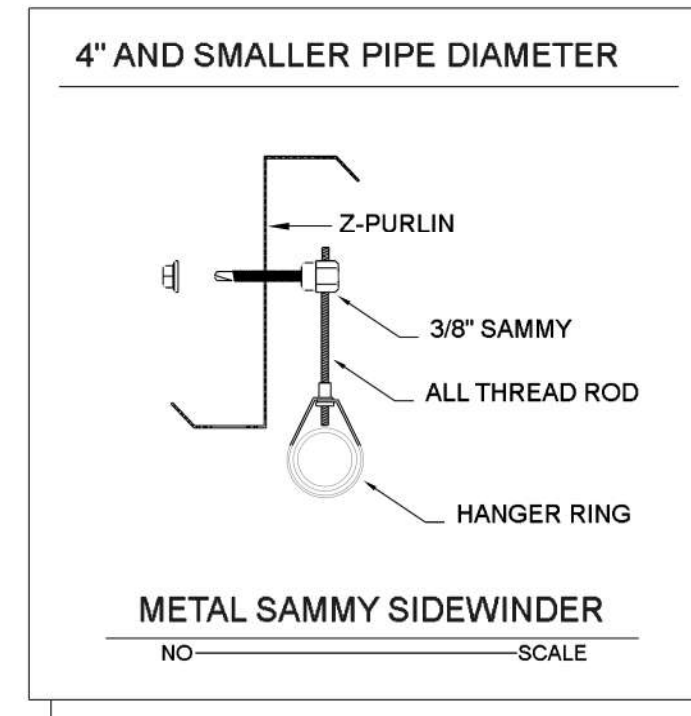


METAL SAMMY SIDEWINDER
NO SCALE

HANGER INSTALLATION REQUIREMENTS										
MAXIMUM DISTANCE BETWEEN HANGERS										
NOMINAL PIPE SIZE	3/4"	1"	1-1/4"	1-1/2"	2"	2-1/2"	3"	4"	6"	
BLAZEMASTER CPVC	5' 6"	6' 0"	6' 6"	7' 0"	8' 0"	9' 0"	10' 0"	N/A	N/A	
THREADABLE LIGHTWALL	N/A	12' 0"	12' 0"	12' 0"	12' 0"	12' 0"	12' 0"	N/A	N/A	
STEEL PIPE (10' 40')	N/A	12' 0"	12' 0"	15' 0"	15' 0"	15' 0"	15' 0"	15' 0"	15' 0"	

100 PSI STATIC PRESSURE ON SYSTEM REQUIRES UP-LIFT RESTRAINT WITHIN 12 INCHES HORIZONTALLY OF HEAD FOR ARM-OVERS AND END OF BRANCH LINE
 THE UNSUPPORTED LENGTH BETWEEN THE END SPRINKLER AND THE LAST HANGER ON THE LINE SHALL NOT EXCEED 36' FOR 1" PIPE, 48' FOR 1 1/4" PIPE AND 60' FOR 1 1/2" PIPE OR LARGER
 THE CUMULATIVE HORIZONTAL LENGTH OF AN UNSUPPORTED ARM/OVER TO A SPRINKLER, SPRINKLER DROP, OR SPRING-UP SHALL NOT EXCEED 24'

TRAPEZE INSTALLATION REQUIREMENTS									
SPAN OF TRAPEZE (Schedule 10)	NOMINAL PIPE SIZE SUPPORTED								
	1"	1-1/4"	1-1/2"	2"	2-1/2"	3"	4"	6"	
1 FT. 6 IN.	1"	1"	1"	1"	1"	1"	1-1/4"	1-1/4"	
2 FT. 0 IN.	1"	1"	1"	1-1/4"	1-1/4"	1-1/4"	1-1/4"	1-1/2"	2"
3 FT. 0 IN.	1-1/4"	1-1/4"	1-1/4"	1-1/4"	1-1/2"	1-1/2"	1-1/2"	2"	
4 FT. 0 IN.	1-1/2"	1-1/2"	1-1/2"	1-1/2"	2"	2"	2"	2-1/2"	2-1/2"
5 FT. 0 IN.	2"	2"	2"	2"	2"	2"	2"	2-1/2"	2-1/2"
6 FT. 0 IN.	2"	2"	2"	2"	2"	2-1/2"	2-1/2"	3"	
7 FT. 0 IN.	2"	2"	2"	2-1/2"	2-1/2"	2-1/2"	2-1/2"	3"	
8 FT. 0 IN.	2-1/2"	2-1/2"	2-1/2"	2-1/2"	2-1/2"	2-1/2"	2-1/2"	3"	
9 FT. 0 IN.	2-1/2"	2-1/2"	2-1/2"	2-1/2"	2-1/2"	2-1/2"	3"	4"	
10 FT. 0 IN.	2-1/2"	2-1/2"	2-1/2"	2-1/2"	2-1/2"	3"	3"	4"	

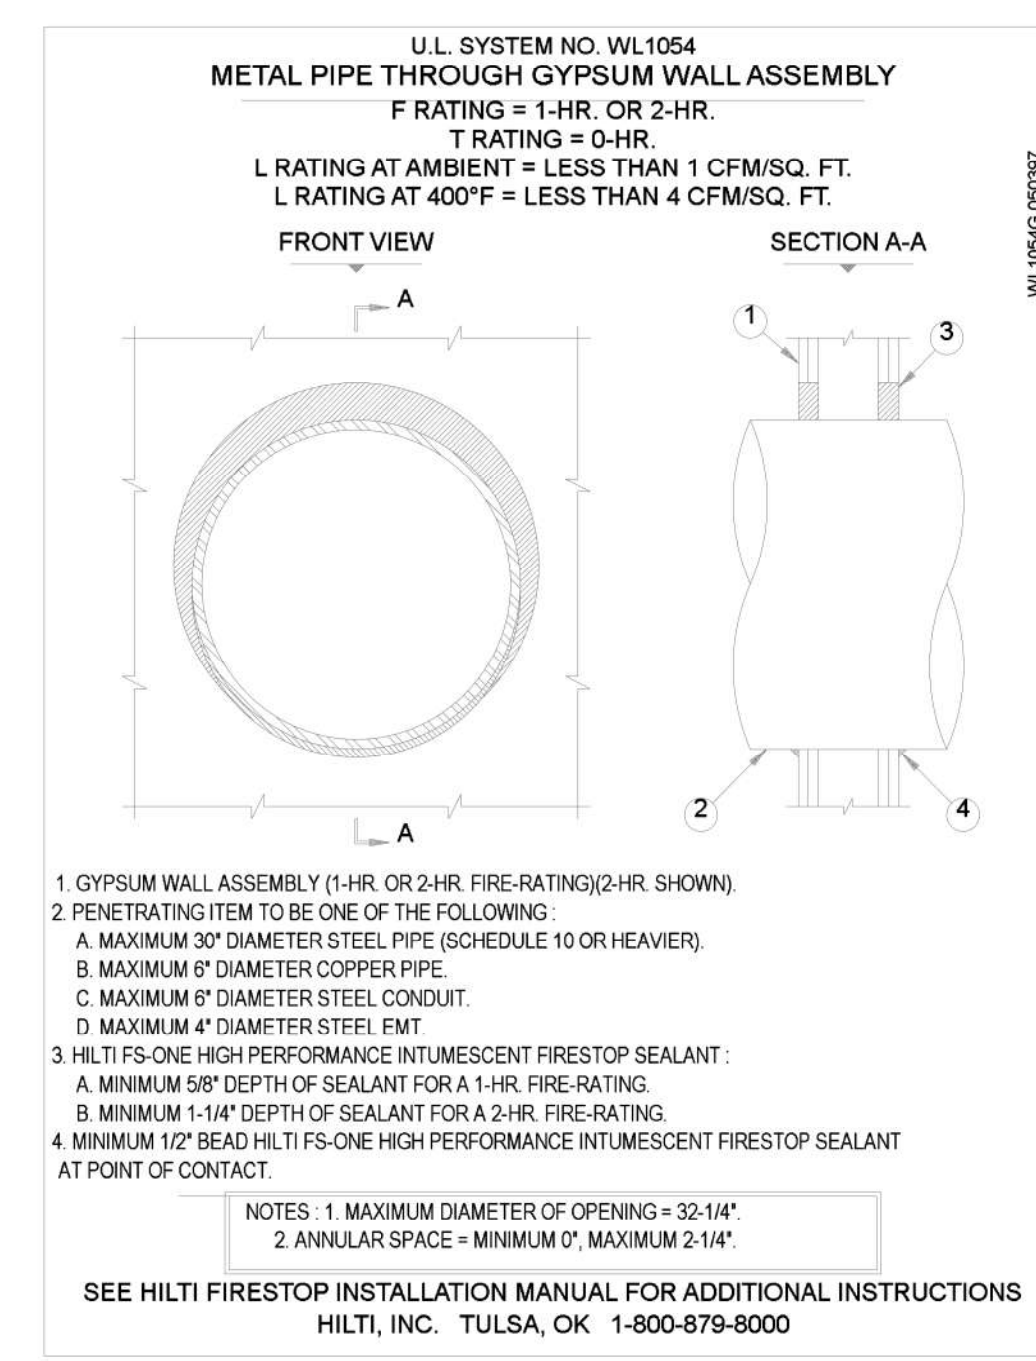

Sprinkler Design Data

Project Name: HARBOR FREIGHT TOOLS	System: WET
Project Street Address: 46 SHRIJI LN, ERWIN NC	Sys. Sq. Ft.: 15,632
Suite: -	Floor#: -
Designed By: J&D SPRINKLER CO	Phone: 919-553-2356
Occupancy: MERCHANTILE	Hazard: ORDINARY GRP II
	Ceiling Height: VARIES
	Total Bldg. Hgt.: 22'-0"

Design Summary

Design Method	Design Area #	Location	Type of System	Hazard Class	Criteria From	Design Area	Sprinkler Spacing	Density	K-factor	Hose Allowance	# Design Sprinklers	Special Application Spk.	Requirement @ BASE	G.P.M. Req'd	P.S.I. Req'd	Requirement @ TEST	GPM Required	PSI Required	Safety factor @ Test	Dry Sys. Volume (gal)
CALCULATED	1	-	WET	ORDINARY GRP II	NFPA13 2013 ED	1500 S.F.	130 S.F. MAX	.20	5.6	250 GPM	13	-		329.08	30.630		579.08	41.467	2.493	-

Water Supply Information

Tested by	J&D SPRINKLER CO	Date/Time	2/6/2024 @ 1:45PM	Pressure Hydrant	-
Hydrant Elevation	-	Flow Hydrant # 1	-	Flow Hydrant #2	-
Static (PSI)	52	Residual (PSI)	36	Flow (gpm)	840

Copy of Water Test Data Included with Calculation is required

HARBOR FREIGHT TOOLS
 46 SHRIJI LN
 ERWIN, NC

J & D SPRINKLER CO. INC.
 315 W. MAIN ST., CLAYTON, NC 27520
 PHONE: (919)553-2356 FAX: (919) 359-0622

SHEET TITLE:
 NOTES/DETAILS

This fire sprinkler planning and design drawing has been prepared by J & D Sprinkler Co. as a licensed fire sprinkler contractor under Article 2 of Chapter 87 of the General Statutes of the State of North Carolina. The designer, J & D Sprinkler Co., is not responsible for any work performed in reliance on this drawing pursuant to G.S. § 55B-15(a)(2). Installation work or any other work performed by any other person or entity in reliance on this drawing or any copy thereof is strictly prohibited.
 c. 2013 J & D Sprinkler Co., Inc.



DANA GRAHAM
 NC # 16269FS CERT # 71075
 NICET LEVEL III
 JASON GRAHAM
 NC # 16269FS CERT # 121842
 NICET LEVEL III

REVISION:
 NO. DATE

Date:
 4/24/2024

Scale:
 1/8" = 1'-0"

Job Number:
 F24084


Drawn By:
 MWL

Sheet Number
 FP-1

Supply Flow Test Data	
Test Conducted By	J&D SPRINKLER CO
Test Witnessed By	FARRIN DUNN/TRAVIS CURRY
Date of Test	2/6/2024
Time of Test	1:45PM
Location	46 SHRIJI LN
Static Pressure	52.000
Residual Pressure:	36.000
Flow	840.00

Reviewed for Fire Code Compliance
 Harnett County
 Leslie Jackson
 05/21/2024 10:46:33 AM

- SYMBOLS:**
- XX DENOTES A HYDRAULIC CALCULATION POINT OF REFERENCE
 - DENOTES A HYDRAULIC REMOTE AREA
 - DENOTES NEW SPRINKLER PIPE
 - - - DENOTES UNDERGROUND PIPE
 - *'-0" FF Ⓢ DENOTES PIPE CENTERLINE ELEVATION AFF
 - *'-0" TS Ⓢ DENOTES PIPE CENTERLINE BELOW TOP OF STEEL

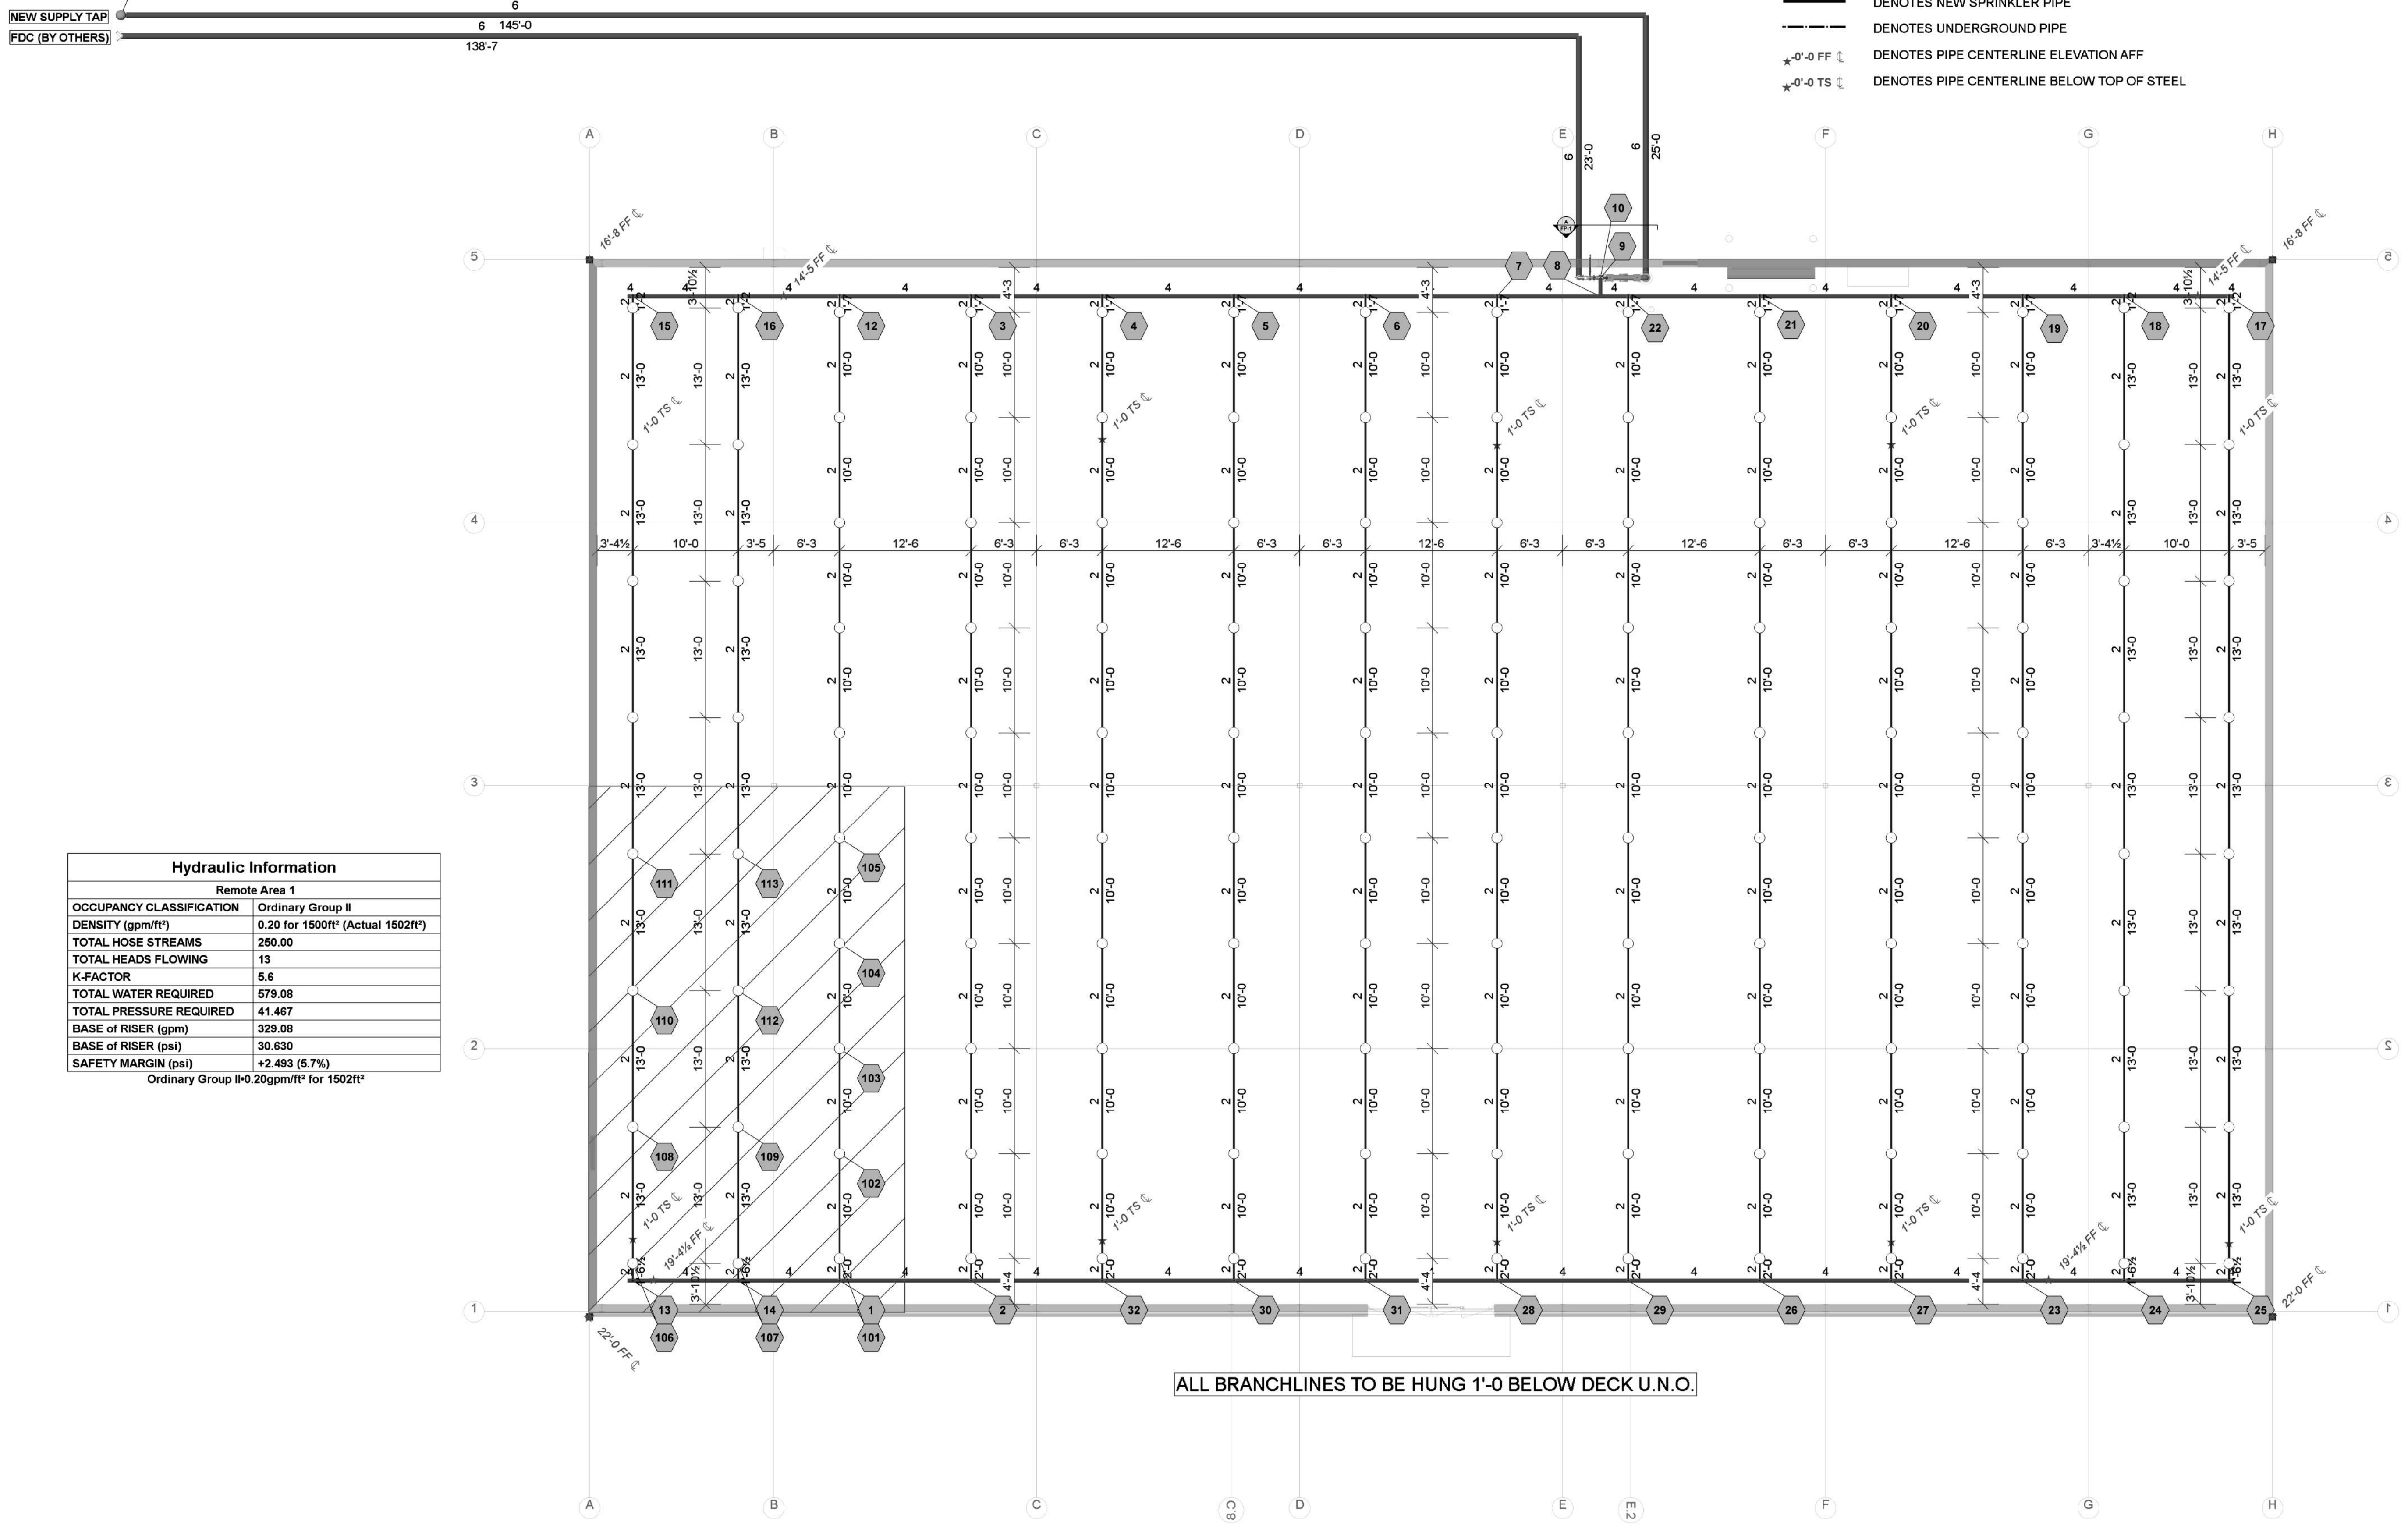

Hydraulic Information	
Remote Area 1	
OCCUPANCY CLASSIFICATION	Ordinary Group II
DENSITY (gpm/ft²)	0.20 for 1500ft² (Actual 1502ft²)
TOTAL HOSE STREAMS	250.00
TOTAL HEADS FLOWING	13
K-FACTOR	5.6
TOTAL WATER REQUIRED	579.08
TOTAL PRESSURE REQUIRED	41.467
BASE OF RISER (gpm)	329.08
BASE OF RISER (psi)	30.630
SAFETY MARGIN (psi)	+2.493 (5.7%)
Ordinary Group II=0.20gpm/ft² for 1502ft²	

ALL BRANCHLINES TO BE HUNG 1'-0" BELOW DECK U.N.O.

Sprinkler Legend											
Symbol	Manufacturer	SIN	Model	Quantity	K-Factor	Type	Size	Response	Finish	Temperature	Note
○	Victaulic	V2704	FL-QR	132	5.6	Upright	½"	Quick	Brass	200°F	
				Total =	132						

Plan North
PIPING PLAN
 1/8"=1'-0"

HARBOR FREIGHT TOOLS
 46 SHRIJI LN
 ERWIN, NC

J & D SPRINKLER CO. INC.
 315 W. MAIN ST., CLAYTON, NC 27520
 PHONE: (919)553-2356 FAX: (919) 359-0622

SHEET TITLE:
PIPING PLAN

This fire sprinkler planning and design drawing has been prepared by J & D Sprinkler Co. as a licensed fire sprinkler contractor under Article 2 of Chapter 87 of the General Statutes of North Carolina. The Engineer must perform any and all installation work and other work performed in reliance on this drawing pursuant to G.S. § 55B-15(a)(2). Installation work or any other work performed by any other person or entity in reliance on this drawing or any copy thereof is strictly prohibited.
 © 2013 J & D Sprinkler Co., Inc.

DANA GRAHAM
 NC # 16269FS CERT # 71075
 NICET LEVEL III
 JASON GRAHAM
 NC # 15269FS CERT # 121842
 NICET LEVEL III
REVISION:
 NO. DATE

Date:
4/24/2024

Scale:
1/8"=1'-0"

Job Number:
F24084

Drawn By:
MWL

Sheet Number
FP-2