

	1 2	3 4	5 6	7 8 9	
	BW&A 26 01 00ELE.DOC 26 01 00-7	12. Busway	2.2 CONDUIT FITTINGS	2. Tamper resistant type:Hubbell No. CR20*TR Series	CFD-XXX-E-002-XXXXX
	CSI MASPEX (Revised 1/13)Electrical General	13. Ground fault system 14. Disconnect switches	A. Rigid conduit and IMC conduit fittings shall be zinc—coated, ferrous metal and taper threaded type.	3. Isolated ground type: Hubbell No. CR5352IG Series 4. Hospital grade (HG) type: Hubbell No. HBL8300 Series	
	SECTION 26 01 00	15. Lighting fixtures 16. Lighting control system	B. EMT fittings shall be zinc—coated steel and hexnut compression or set—screw type. EMT connectors shall have insulated throats.	5. HG Tamper resistant type: Hubbell No. HBL8300SG Series 6. GFCI: Hubbell No. GF20*LA Series	DUKE
Н	ELECTRICAL GENERAL PART 1 — GENERAL	17. Dimming system 18. Life safety system 19. Emergency system	C. PVC fittings, elbows and cement shall be produced by the same manufacturer. All joints shall be	7. GFCI HG: Hubbell No. GFR8300H*LA 8. GFCI HG tamper resistant: Hubbell No. GFR8300H*TR	H ENERGY®
	1.1 SCOPE	20. Motor starters 21. Motor control center	solvent welded in accordance with the manufacturer's recommendations. D. Conduit connections to switchboards, motor control centers, transformers, panel cabinets, and pull	B. Single receptacles shall be two-pole, three wire, self-grounding, side wired, 125 volts and 20A rating and shall be equal to the following (or equal by Leviton, P&S, or Cooper):	MAILING ADDRESS:
	A. Division 26 includes all Specifications in the 260000 Series and the accompanying Electrical Drawings. Provide all labor, materials and equipment, and all necessary operations to provide the	22. Surge Protective Devices23. Lightning Protection System	boxes shall have grounding wedge lugs between the bushing and the box or locknuts designed to bite into the metal.	 Standard receptacle: Hubbell No. HBL5361 Series Isolated ground type: Hubbell No. IG5361 Series 	P.O. BOX 1007 CHARLOTTE, NC 28201
	complete scope of the electrical systems intended under this Division. Division 26 is not a stand alone document, but a part of the complete Project Documents.	C. All shop drawings and submittals shall be submitted in compliance with the requirements of the general and supplementary conditions. No more than four (4) copies of submittal data will be reviewed.	E. Each conduit end shall be provided with either an insulated throat connector or separate locknut and insulated bushing. Bushing shall be installed before any wire is pulled.	C. Color shall be as selected by the Architect.	Safety Expectations:
	B. Attention is called to the fact that there are many interfaces between the work required in this Division and the work required in other Divisions. Provide the necessary interface and coordination with other Divisions to provide a complete project.	Any additional copies will be returned unmarked. The responsibility of copying review comments on any additional copies will rest solely with the contractor.	F. Conduit fittings approved manufacturers are Raco, Steel City, O.Z. Gedney, Thomas & Betts and Appleton.	D. Receptacles in all patient care areas shall be hospital grade type per NEC article 517.18.	Reduce Risk
	1.2 EXISTING CONDITIONS [NOT APPLICABLE]	D. All submittals shall bear the name of the manufacturer to be used.	G. Expansion fittings shall be provided in all conduit which crosses and expansion joint.	E. Receptacles in all pediatric care areas shall be tamper resistant type per NEC article 517.18(C).	ZERO Remove Exposures to Hazards
G		E. All shop drawings and submittals shall include a stamped indication signifying that the submittal has been reviewed for compliance with the Contract Documents by the Contractor. This stamped indication also represents the fact that the Contractor has checked this submittal for its interaction with all other Divisions and certifies by his signature or initials that all coordination has taken place. The	2.3 CONDUCTORS	2.10 COVERPLATES	Reinforce Safe Behavior
	1.3 CODES AND REGULATIONS	stamp shall include the date, name of the Contracting Firm, the signature of the Contractor, certification of compliance and approval. This stamp shall be on the submittal before the Engineer will review it.	A. Conductors shall be copper of 98% conductivity, 600 volt insulation. Sizes specified are AWG gauge for No. 4/0 and smaller and circular mils (MCM) for all sizes larger than no. 4/0. Conductors	A. Coverplates for flush mounted devices shall be brushed finished stainless steel standard size, Hubbell "P" Series or equal by Leviton, P&S, or Cooper.	
	A. All work under this Division shall comply with all local building codes, laws, regulations, ordinances and the requirements of the 2011 National Electrical Code.	F. The engineer will review an individual submittal not more than twice. If the submittal is rejected	No. 10 and smaller shall be solid and type "THHN" or "THWN" insulation. No. 8 and larger shall be stranded and type "THW" or "XHHW" insulation.	B. Telephone and data outlet coverplates shall have same finish as above.	ICZD
	B. Where conflicts of installation requirements occur between the aforementioned codes, regulations or the Contract Documents, the most restrictive shall govern.	again on the second review, the contractor will bare all responsibility for paying for the engineer's time for additional reviews. Such payments to the engineer shall be withheld from the next monthly pay application.	B. Aluminum conductors may be used for service lateral conductor if the same or larger capacity of the conductors specified. Aluminum conductors shall be Alcan 8000 series, Stabiloy or approved equal.	C. Coverplates for exterior devices shall be self—closing, die—cast aluminum Hubbell WP8M or equal by Leviton, P&S, or Cooper.	
	C. Obtain all permits and licenses and pay all fees required by local authorities. Arrange for all	2.3 RECORD (AS-BUILT) DRAWINGS AND MAINTENANCE MANUALS	2.4 OUTLETS	2.11 PLYWOOD BACKBOARDS	
	necessary inspections required by the authorities having jurisdiction and provide written certificates of approval to the project Owner or his designated representative.	A. At job completion, submit to the Architect, a set of prints showing all deviations from the Contract Documents. The Drawings shall also have dimensions locating all underground conduits.	A. Outlet boxes and covers shall be of such form and dimensions as to be adapted to their specified usage, locations, size and quantity of conduit, and size and quantity of conductors entering the boxes. In special "Fire Rated" partitions, outlets shall comply with ASTM No. E119.	A. Provide plywood backboards where shown. Backboards shall be minimum 3/4" thick and sized as shown or to accommodate equipment indicated to be mounted thereon.	
	1.4 DEFINITIONS	B. At job completion, submit to the Architect, three (3) sets of maintenance and instruction manuals for all equipment furnished on the project.	B. Flush ceiling outlets for surface or pendant mounted lighting fixtures shall be one-piece 4" square	B. Secure plywood to the building structure and paint with two coats of gray paint.	&A Barrett, Woodyard and Associates, Inc.
F	 A. Contract Documents: The complete set of project Drawings and Specifications. B. Provide: Furnish, install and connect. 	PART 3 — EXECUTION	or octagonal pressed steel boxes. Boxes for devices in unfinished masonry walls or stud walls shall be pressed steel, square corner, sectional switch boxes, or shall be 4" square box with a square cornered tile wall cover, set flush with masonry construction. Boxes in concrete ceiling slab shall be octagonal,	2.12 SMOKE AND FIRE STOP FITTINGS	License # C-2226 420 Minuet LN. Charlotte, North Carolina 28217 (a) 704 257 0225
	C. Work: All materials installed, including all labor to provide complete system.	3.1 COORDINATION	shallow concrete boxes. Welded boxes are not acceptable. C. All outlet boxes in plaster or masonry walls or ceiling shall be provided with plaster rings.	A. Smoke and Fire Stop Fittings shall be UL listed for that purpose. The fittings used to seal conduit either on the outside of the conduit, busway or cable or internally shall have heat activated intumescent material, which expands to fill all voids. Smoke and fire stop fittings shall be O.Z./Gedney	(p) 704-357-9333 (f) 704-357-9385 © This drawing is copyrighted. It may not be reproduced nor used in any other form or an approach of the project.
	D. Wiring or Wired: All wire or cable installed in conduit from panelboard to equipment and connected at both ends with all required boxes, connectors, couplings, etc.	A. Coordinate all space requirements with all other Divisions before installing any work. Install work such that adequate space will be allotted for all other work from other Divisions to be installed and also will allow room for future access for repair and maintenance.	D. Junction boxes and all outlets not indicated as containing wiring devices or lighting fixtures shall	"FIRE—SEAL" or Dow Corning silicone RTV foam with an hourly fire—rating equal to or higher than the rating of the floor, ceiling or wall through which the cable or conduit passes. The seals for conduit shall be of the flanged type.	form or on any other project. BWA JOB # 2022-0632
	E. Conduit: Rigid steel conduit intermediate metal conduit (I.M.C.), electrical metallic tubing (EMT)	B. Any work installed without proper coordination shall be relocated at the Architect's direction without increasing the Contract price.	have covers. Covers for outlets in walls shall be as specified for wall switches and receptacles.	2.13 FLOOR OUTLETS	
	plastic conduit (PVC), electrical non-metal tubing (ENT), or flexible steel conduit.	C. During the bidding process or the pricing for a guaranteed maximum price, coordinate with all	E. Outlet boxes exposed to the weather and outlet boxes for vaportight lighting fixtures and devices shall be of cast iron corrosion resistant type.	A. Floor outlets shall be single gang floor boxes, Hubbell B2436 Series, complete with cast iron body, vertical angular adjustment, brushed brass frame, brushed brass floor plate and gasket. Larger than	
	1.5 DRAWINGS AND SPECIFICATIONSA. The Drawings and Specifications together are to be considered as the Contract Documents. Any	other Divisions for the total amount of work required in Division 26. Any work shown or implied in another Division requiring work in Division 26 shall be included in the Contract price regardless of whether or not it is addressed in Division 26.	F. Outlet box approved manufacturers are Appleton, Raco, Steel City, or Crouse—Hinds. 2.5 DISCONNECT SWITCHES	standard tappings shall be furnished where required. Adjacent boxes shall be installed on minimum 7" centers.	
_	work shown in one and not shown in the other, or implied by either, shall be provided to give a complete project.	3.2 PROTECTION OF MATERIALS	A. Disconnect switches shall be "heavy—duty" type, enclosed switches of quick—make, quick—break	B. Duplex floor receptacle outlets shall have Hubbell No. S3825 floor plate, a No. SB3083 carpet plate where installed in carpeted floor and a Hubbell CR5262 Series duplex receptacle. Single floor receptacle outlets shall have a S2625 plate and Hubbell single receptacle. Equal manufacturers shall be	
E	B. Should any conflicts exist between the Drawings and Specifications or there is an item shown/called for which is not clearly defined, immediately submit a request for clarification. No additional monies will be granted later when a conflict is resolved or an item is more clearly defined.	A. All equipment shall have the original finish when the building is turned over to the Owner.	construction. Switches shall be horsepower rated for 600 volts AC as required. Lugs shall be UL listed for copper and aluminum.	Levition, P&S, or Cooper.	E POLITICATION OF THE PROPERTY
	C. The Drawings are schematic and are not intended to show the exact location outlets, etc. or the	B. Protect equipment during construction from dirt, water, chemical, mechanical damage, etc. Protect all conduit openings so that no foreign material will enter the conduit.	B. Padlocking provisions shall be provided for padlocking in the OFF position.	2.14 FUSES A. Provide all fuses. All fuses shall be of the same manufacturer. All fuses shall be of the high	STALL ON THE PROPERTY OF THE PARTY OF THE PA
	routing of conduit.	3.3 TESTS, DEMONSTRATION AND INSTRUCTIONS	C. Switches shall be furnished in NEMA 1 General purpose enclosure unless noted otherwise. Switches located on the exterior of the building or in "wet" locations shall have NEMA 3R enclosures.	interrupting rating (200,000 Amps), current limiting type and manufactured by Bussmann. Fuses shall be provided for each fuse cutout and the specified quantity of fuses shall be furnished for spares.	SEAL 05/24/23
	D. The exact location of equipment requiring electrical connections (mechanical equipment, elevators, lights, etc.) shall be as located by other Divisions of the Contract Documents. Refer to the Architectural, Structural and Mechanical Documents for dimensions and details of building construction and provide work described in this Division so that it conforms to the details of the project. The right is reserved	A. Test all systems described in this Division in the presence of the Owner or a designated representative upon completion of the work. Demonstrate that the installation is in accordance with Contract Documents.	D. Fused disconnect switches shall have rejection type fuse clips with dual element, current limiting fuses of rating shown.	B. Circuits 0 to 600 ampere shall be protected by rejection type, current limiting BUSSMANN LOWPEAK Dual Element Fuses LPN-RK (250 volts) or LPS-RK (600 volts). All dual-element fuses shall have	DUNN OPERATIONS
	to relocate any receptacle, switch or other outlet a maximum of 10'-0" before it is permanently installed without incurring additions to the Contract amount.	B. Any work found not to be in compliance with the Contract Documents shall be repaired or replaced without incurring any additions to the Contract price.	E. Disconnect switches shall be mounted to structure. Disconnect switches shall not be mounted to mechanical equipment or ductwork.	separate overload and short—circuit clearing chamber. The fuse must hold 500% of rated current for a minimum of 10 seconds and be listed by Underwriter's Laboratories, Inc., with an interrupting rating of 200,000 amperes RMS symmetrical. The fuses shall be UL Class RK—1.	CENTER
	1.6 SITE VISIT	C. Provide to the Owner, all instruction on maintenance and operation of all systems and equipment	2.6 NAMEPLATES	C. Circuits 601 to 6000 ampere shall be protected by current limiting BUSSMANN HI—CAP Time—Delay Fuses KRP—C. Fuses shall employ "O" rings as positive seals between the end bells and the glass	1269 JONESBORO RD.
D	A. Visit the site and become familiar with all aspects of the site and existing conditions before submitting Contract price.	provided under this Division. Provide all necessary tools and personnel to thoroughly present these instructions.	A. Nameplates shall have 3/8" high engraved letters.	melamine fuse barrel. The terminals shall be opened. Fuses shall be time—delay and must hold 500% of rated current for a minimum of 4 seconds, clear 20 times rated current in 0.1 seconds or less and be listed by Underwriter's Laboratories, Inc., with an interrupting rating of 200,000 amperes RMS	D HARNETT COUNTY, NC 28334
	B. No allowance will be made for lack of knowledge of existing conditions.	3.4 GUARANTEE	B. 120 or 208 volts: white core laminated bakelite with black finish.	symmetrical. The fuses shall be UL Class L. D. Furnish and turn over to the Owner a minimum of one (1) set of spare fuses (set consisting of	OPERATIONS
	1.7 DEVIATIONS	A. All systems, equipment, components, work, etc. provided under this Division shall be covered by a one year guarantee starting at the time of final acceptance of the work by the Owner. Any defects in the work, systems, equipment or components found during this year shall be corrected at no charge. The guarantee shall include providing all necessary cutting, patchwork, repainting, etc. to make the work	C. 277 or 480 or higher volts: white core laminated bakelite with red finish.	three fuses) for each type and rating of fuse used. When the number of fuse sets of the same type and rating actually installed exceeds five (5) sets, furnish an additional spare set of fuses for each five (5) or fraction thereof.	BUILDING
	A. No deviations from the Contract Documents shall be made without the full knowledge and written consent of the Architect.	complete and new.	D. Nameplate shall indicate the panel name and the name of the device or equipment where the power supply/feeder originates.	E. Provide a cabinet in which to store all spare fuses, Bussmann Catalog No. SFC	
	B. If the existing conditions make it desirable to modify the Contract Documents in regard to any item, provide a written request to the Architect.	B. Present this guarantee and any additional warranties or guarantees on furnished equipment or systems to the Architect. All equipment or system guarantees are in addition to the general guarantee.	2.7 WALL SWITCHES	F. Acceptable manufacturers are Bussmann or equal by Littelfuse.	
	PART 2 — PRODUCTS	END OF SECTION	A. Wall switches shall be plastic, totally enclosed, quiet type, self—grounding, 277 volts and 20A rating and shall match existing if possible and equal the following (or equal by Leviton, P&S, or Cooper):	PART 3 — EXECUTION 3.1 CONDUIT	SUCTIO
	2.1 STANDARDS FOR MATERIALS AND WORKMANSHIP	SECTION 26 10 00	 Single Pole: Hubbell No. CS1221 Double Pole: Hubbell No. CS1222 	A. Rigid steel (or IMC) shall be used for service entrance and all feeders and branch circuits where	CONSTE
C	A. All materials used shall be new and shall be stamped with the label of Underwriters Laboratories, Inc. (UL).	ELECTRICAL BASIC MATERIALS & METHODS	3. Three—Way: Hubbell No. CS1223 4. Four—Way: Hubbell No. CS1224	exposed to damage. B. EMT shall be used for branch circuits, fire alarm and telephone when not underground or in	C
	B. All materials shall meet the standards of the following associations and institutes where applicable:	PART 1 — GENERAL	B. Color shall be as selected by architect.	concrete in contact with the earth.	ISSUED
	 National Fire Protection Association (NFPA) American Society of Testing Materials (ASTM) 	1.1 DESCRIPTION	C. Flush motor switches with red pilot light and with overload protection for fractional horsepower motors shall be Hubbell No. HBL1221PL.	C. Schedule 40 PVC may be used for all underground feeders, service entrance conductors when encased in 4" of concrete on all sides, or under the lowest floor slab.	DRN BY
	 American National Standards Institute (ANSI) National Electrical Manufacturer's Association (NEMA) Institute of Electrical and Electronic Engineers (IEEE) 	A. All work specified in this Section shall comply with the provisions of Section 26 01 00.	D. Key switches shall be Hubbell No. HBL1221L 20A Series or approved equal by P&S or Leviton.	ENT may be used for branch circuits in concealed areas which is not used as an environmental air plenum.	TE 23
	C. Manufacturer's names and catalog numbers specified herein are intended to describe the material	B. This Section describes the basic electrical materials and installation methods that are acceptable and applicable to Division 26.	2.8 WALL MOUNTED OCCUPANCY SWITCHES	D. Conduit shall be continuous from outlet to outlet, from outlet to cabinet, junction box and pull box. Conduit shall enter and be secured to all boxes, etc., in such a manner that each system will be	¥
	and set the standard of quality. All bids shall be based on material specified. Requests for approval of material not specified shall be considered if the request is in written form and submitted to the Architect no later than fourteen (14) days before bid date. All requests shall conform with the	PART 2 — PRODUCTS	A. The passive infrared sensor shall be a completely self—contained control system that replaces a standard toggle switch. Sensor shall have ground wire for safety. Switching mechanism shall be a latching air gap relay, compatible with electronic ballasts, compact fluorescent and inductive loads. Triac and other harmonic generating devices shall not be allowed.	electrically continuous from service to all outlets such that a good ground is provided. All conduit from cabinets and junction boxes shall terminate in approved outlet boxes or conduit fittings. Conduit connections to any box which has no threaded hub shall be double locknutted.	PROJECT NO:
В	provisions of the general and supplementary conditions. D. Samples of materials requested to be substituted shall be furnished upon the request of the	2.1 CONDUIT A. Galvanized rigid steel conduit shall be low carbon, hot-dipped galvanized both inside and out with	B. Sensor shall cover up to 1000 sq. ft. for walking motion, with a field of view of 180 degrees.	E. Provide junction boxes or pull boxes where shown and where necessary to avoid excessive runs or too many bends between outlets. The conduit sizes shown may increase if desired to facilitate the	B DRAWING NUMBER
	Architect.	threaded joints.	C. Sensor shall have system which provides superior 180 degree coverage.	pulling of cables. F. All conduit shall be concealed unless indicated otherwise. Install exposed conduit parallel with or	CFD-XXX-E-002-XXXXX
	2.2 SHOP DRAWINGS AND SUBMITTAL A. The Engineer's review of shop drawings or submittals is a cursory review to check for general	B. Intermediate metal conduit (IMC) shall be steel, galvanized both inside and out with threaded joints.	D. Sensor shall operate at 120 VAC or 277 VAC.	at right angles to the building walls and support from walls or ceilings at intervals required by Code with approved galvanized iron clamps or hangers. Concealed conduit above the ceiling shall be supported independent of ceiling construction. Where ceilings of lay—in type are used, conduit must be	DRAWN BY: JFE
	compliances of submittals with the design intent of the Contract Documents. The Engineer's review does not relieve the Contractor of his responsibility of complying with the Contract Documents. All coordination of the work in strict compliance with the Contract Documents is the sole responsibility of	C. Electrical metallic tubing (EMT) shall be steel, galvanized both inside and out.	E. Sensor shall have no minimum load requirement and shall be capable of switching from 0 to 500 watt incandescent; 0 to 800 watts fluorescent or 1/6 hp @ 120 VAC, 60 Hz; and 0 to 1200 watts fluorescent or 1/3 hp @ 277 VAC, 60 Hz.	installed high enough to permit removal of ceiling panels and lighting fixtures. Use threaded rods and hangers for supporting single conduit. Use trapeze hangers consisting of double—nutted threaded rods and "Unistrut" channels or angles of 12 gauge minimum steel for supporting multiple conduit.	CHK'D BY: JSL DATE: E-MAIL: SLOWERY@BARRETTWOODYARD.COM
	the Contractor. B. The following items shall be submitted for review:	D. Plastic conduit (PVC) shall be schedule 40 PVC heavy wall type. A grounding conductor shall be provided.	F. For accuracy and consistency, sensor shall have a DIP switch controlled, digital time delay	G. Minimum size conduit for branch circuits shall not be smaller than 1/2". Home runs shall extend from outlets shown to panel designated. Home runs shown shall not be combined. Home run conduit	THIS DESIGN DRAWING IS THE EXCLUSIVE PROPERTY OF DUKE ENERGY CORPORATION AND IS CONSIDERED CONFIDENTIAL. IT SHALL NOT BE MODIFIED, COPIED, OR DISTRIBUTED WITHOUT PRIOR APPROVAL THIS INFORMATION SHOULD ONLY BE USED FOR THE SPECIFIC PROJECT INTENDED.
	 The following items shall be submitted for review: Conduit and wire 	E. Electrical non—metallic tubing (ENT) shall be of such material that it is resistant to moisture, chemical atmospheres and is flame retardant. A grounding electrode conductor shall be provided.	adjustable from 15 seconds to 30 minutes. G. Sensor shall have standard 5 year warranty and shall be UL and CUL listed.	shall not be smaller than 3/4".	APPROVAL. THIS INFORMATION SHOULD ONLY BE USED FOR THE SPECIFIC PROJECT INTENDED. SHEET TITLE:
	 Grounding system Devices 	F. Flexible metal conduit shall be flexible steel conduit tubing and shall meet Underwriters Laboratories Standard for Flexible Steel Conduit.	H. Sensor shall be Wattstopper WI Series, Leviton Decora Series, or approved equal by engineer.	H. At couplings, conduit ends shall be threaded so that they meet in the coupling. Right and left hand couplings shall not be used; conduit couplings of the Erikson Type shall be used at locations requiring such joints.	SPECIFICATIONS
A	4. Coverplates5. Under floor duct6. Metering equipment	G. Liquid—tight flexible metal conduit and liquid—tight non—metallic conduits shall be liquid—tight and sunlight resistant.	2.9 RECEPTACLES	I. All conduit for future use, for telephone wire, or for data communication cable, shall be left with No. 16 gauge wire pulled in them or a pull line as manufactured by Ideal, and the ends securely	A - ELECTRICAL
	7. Panelboards 8. Switchboards	H. Steel conduit approved manufacturers are Allied, Triangle and Republic.	A. Duplex receptacles shall be plastic, two-pole, three wire, self-grounding, side wired, 125 volts and 15A rating and shall match existing if possible and be equal to the following (or equal by Leviton, P&S,	corked or capped. J. Expansion fittings shall be installed in all conduit which pass through the cross—sectional area of	SHEET NO.
	9. Transformers 10. Fuses 11. Overcurrent devices	I. PVC and ENT conduit approved manufacturers are Carlon and Triangle.	or Cooper): 1. Standard receptacle: Hubbell No. 5362 Series	expansion joints.	E-002
	1 2	3 4	5 6	7 8 9	


	3 4	5	7 8	9
Gardner Bender duct seal, for each conduit entering the building from outside and for each conduit		per side in the base or base frame of the equipment item, then there shall be one anchor for each anchor hole.	panel door is closed and locked.	CFD-XXX-E-003-XXXXX
passing from one space into another which is normally at a lower temperature. L. Provide watertight conduit hubs on conduit terminating in a box or cabinet exposed to the	A. Where more than one device is indicated at a location, the devices shall be gang—mounted in combined multi—gang boxes and covered jointly by a common coverplate. Provide barriers as required by the devices and voltages being used.	Exception No. 2: If the equipment manufacturer recommends a particular quantity greater	E. All exterior and interior steel surfaces of the trim shall be cleaned and finished with gray paint over a rust—inhibiting phosphatized coating.	
weather. M. Space in sleeves or around conduit that pass through fire resistive or fire rated walls, partitions,	3.8 COVERPLATES	than two (2) per side, then that quantity of anchors shall be provided.	F. All interiors shall be completely factory assembled with protective devices, wire connectors, etc. All wire connectors, except screw terminals, shall be of the anti—turn solderless type and all shall be	DUKE
floors or ceilings shall be closed by packing with an unlabelled fire resistive material that will maintain the rating of the barrier penetrated.	A. All junction boxes, outlet boxes, multi—gang switch boxes, utility boxes, etc., shall be covered with a coverplate. The coverplate shall be a finished plate as specified unless designated otherwise.	END OF SECTION	suitable for copper or aluminum wire. G. Interiors shall be so designed that devices can be replaced without disturbing adjacent units and	H ENERGY®
3.2 FLEXIBLE CONDUIT A. PVC extruded cover flexible conduit shall be used in making short flexible connections to rotating	B. Coverplates shall be mounted vertically unless designated otherwise.		without removing the main bus connectors, and shall be so designed that devices may be changed without machining, drilling or tapping.	MAILING ADDRESS: P.O. BOX 1007
or vibrating machinery or equipment. The flexible conduit at these locations shall be as short as possible, but shall have a minimum length of 12".	3.9 GROUNDING A. Ground connections shall be in accordance with the National Electrical Code.	SECTION 26 20 00 SERVICE AND DISTRIBUTION	H. Bus bars for the mains shall be of copper sized in accordance with U.L. standards. Full size bars shall be included. Bus bar taps for panels with single pole branches shall be arranged for sequence phasing of the branch circuit devices.	CHARLOTTE, NC 28201
B. A green stranded bonding jumper shall be installed outside of all flexible conduit that extends directly from a non—flex conduit to a rotating or vibrating machine. Where a junction box is used, the green stranded bonding jumper shall be installed inside the flexible conduit and attached to the junction	 Provide a grounding electrode system consisting of a minimum of three (3) copperweld rods, 3/4" x 10'-0", driven 24" below grade a minimum of 72" apart in the form of an equilateral triangle, 	PART 1 — GENERAL	I. Phase bussing shall be full height without reduction. Cross and center connectors shall be of the same material as the bus.	Safety Expectations:
box and to the machine. When the bonding jumper is installed outside of the flexible conduit, plastic wire straps shall be used 6" o.c. to secure the jumper to the flexible conduit.	bonded together with No. 4/0 conductors. Install rods a minimum of 36" clear of foundation walls to effect the building ground. If the resistance to ground exceeds 25 ohms, additional rods shall be driven and bonded together until a reading of 25 ohms or less to ground is obtained. After completion	1.1 DESCRIPTION	J. The neutral bus shall utilize setscrews to bond the neutral wire to the neutral bus through holes drilled in the neutral bar. A sheet copper neutral bus utilizing flathead screws to hold the neutral wires	Reduce Risk ZERO Remove Exposures to Hazards
C. Flexible metal (MC) conduit system may be utilized where concealed in walls and/or millwork only. MC Cable shall run from point of exit from wall or millwork to nearest structurally supported junction box. MC cable will not be permitted to be installed in the above ceiling space and shall not pass	of the grounding system, measure the system ground resistance with a "Megger Earth Tester". Submit directly to the Architect two (2) copies of each test report certified by the testing technician and the Owner's representative.	A. All work specified in this Section shall comply with the provisions of Section 26 01 00.	will not be acceptable. K. Spaces for future devices shall be included as indicated and shall be bussed for the maximum	Reinforce Safe Behavior
through a fire rated partition. Conductor colors of the MC cable shall comply with 26 10 00 3.4 D. 1. MC cable shall be constructed to have an insulated, copper ground conductor. Sheathing with a	2. Extend from the electrodes to the main service disconnect with a No. 4/0 copper insulated ground conductor in a 1" conduit and connect to the neutral bar, housing and frame.	B. Provide a complete electrical distribution system. The system shall include the service entrance, main switchboard, feeders, transformers, distribution panels, panelboards, busway, remote control switches, contactors, etc., to provide a complete system.	rated device that can be fitted into them. L. All circuit breakers (except as listed below) shall be manually operated, thermal—magnetic,	G
bare aluminum conductor shall not be used as the ground. 2. MC cable in patient care areas shall be hospital grade (HCF) to comply with NEC 517.13.	3. Provide a No. 4/0 copper insulated conductor across the water meter with the conductor attached with clamps to the water line on each side of the meter.	C. All distribution switchgear (branch circuit panelboards, switchboard, distribution panelboards, transformers, busway, etc.) shall be the unit responsibility of one manufacturer. All component parts of	automatic, of the ampacity and poles as indicated. They shall be quick—make, quick—break, both on manual and automatic operation. Breakers shall be over—the—center toggle operating type, with the handle going to a position between ON and OFF to indicate automatic tripping. All multi—pole breakers	I C7D
3.3 CONDUIT PROTECTION	4. Provide a No. 4/0 copper insulated ground conductor in a 1" conduit from cold water entrance	the above listed items shall be of the same manufacturer except where a written request for deviation from this requirement has been approved prior to bid date.	shall have internal common trip. The minimum interrupting capacity of the breakers furnished shall be 10,000 amperes RMS symmetrical for 120/208 volt and 14,000 amperes RMS symmetrical for 480/277 volt unless indicated otherwise on the riser diagram. The breakers furnished shall be determined by the specifications and by the minimum U.L. labeled RMS symmetrical amperes interrupting capacity at circuit	
A. All conduit installed in the ground outside the building exterior line (with the exception of exterior lighting circuits) shall be encased in 4" of concrete on all sides. Concrete shall be a minimum of	pipe ahead of first valve to the main service disconnect and connect to the neutral bar, housing and frame.	D. Shop drawings for equipment specified in this Section shall show that all specified requirements have been incorporated.	voltage. All circuit breakers shall be bolted on and rigidly braced.	
3000 P.S.I. mix. All threaded joints in rigid conduit that is encased in concrete shall have a U.L. listed joint compound applied. All conduit installed outside the building underground shall be buried a minimum of 30" below finished grade but in no case shall be buried deeper than 48". Where conduit	5. Where nonmetallic insulating couplings or dielectric flanges are used in metallic water piping systems, provide a No. 4/0 copper, insulated ground conductor across the couplings with the conductor attached with clamps to the water line on each side of the coupling.	E. Coordination studies shall be done prior to shop drawing submittals. Shop drawings shall include all breakers that meet the coordination study. If study is performed after the shop drawings are submitted, any revisions to breakers or panels shall be at no additional cost to the project.	M All circuit breakers feeding an emergency panel or main breaker for an emergency panel shall have solid state trip units that are insensitive to changes in ambient temperature and a push—to—trip button to mechanically check the trip mechanism or for the use under emergency trip conditions. Interchangeable rating plugs shall establish the continuous current rating of each breaker.	BW
is installed below the ground floor slab inside the building exterior line, the conduit shall be run between the floor slab and the vapor barrier. These conduits shall be installed in the slab itself where feasible. When a conduit duct bank must be installed then the entire duct bank shall be encased in concrete and installed per Appendix B of the NEC. Derating of conductors in the underslab duct bank shall be	6. All ground connections in the building system ground shall be done with Cadweld.	F. All floor mounted distribution equipment shall be mounted on a 4" high concrete pad.	An interlock in the rating plug shall trip the breaker if an attempt is made to remove the plug with the breaker in the ON position. With the plug removed, it shall not be possible to close the breaker.	&A Barrett, Woodyard and Associates, Inc. License # C-2226
the responsibility of the contractor. Conduit installed in any slab, where permitted above, shall be above the bottom steel and below the top steel.	7. All ground clamps shall be equipped with compression type cable lugs independent of the compression device clamping the pipe or rod.	1.2 ELECTRICAL SERVICE (From pad mounted transformer)	N. The solid state trip breakers shall provide long delay and magnetic tripping similar to thermal magnetic breakers. In addition, the magnetic trip shall include a short time delay permitting coordination and selective tripping with downstream devices. It shall be possible to check the breaker	F 420 Minuet LN. Charlotte, North Carolina 28217 (p) 704-357-9333 (f) 704-357-9385
B. Conduit shall be secured in place and protected where necessary to prevent damage to work during construction. The ends of all conduit shall be plugged to avoid filling with any foreign matter. All conduit shall be blown out and swabbed clear of water and trash prior to pulling wire.	8. All steel conduit entering the main service disconnect shall have threaded conduit insulated grounding bushings. All bushings shall be bonded together and bonded to the main grounding bus with a No. 4 bare conductor.	A. Make all arrangements with the power company and pay all charges made by the power company for permanent electric service. In the event that the power company's charges are not available at the time the project is bid, the bids shall be qualified to notify the Owner that such charges are not included.	electrically and mechanically while in service without dismantling equipment and with minimum down time.	© This drawing is copyrighted. It may not be reproduced nor used in any other form or on any other project. BWA JOB # 2022-0632
C. Provide identifying marker tape the entire length of each conduit installed in the ground outside the building. The tape shall be constructed of inert polyethylene, resistant to acids, alkalis, etc., in the	B. Provide an insulated green bonding jumper from the grounding lug of all receptacles to a Steel	B. The power company will provide the underground primary service and the pad mounted	O. Provide arc—fault circuit breakers for all branch circuits supply areas defined by NEC 210.12 in all dwelling units.	
soil, and shall be a minimum 4 mil thickness. The tape shall be yellow, 6" wide, and shall have the words, "CAUTION — ELECTRIC LINE BURIED BELOW," imprinted with contrasting permanent ink. The imprint shall repeat itself for the entire length of the tape. The tape shall be buried at a maximum of	City "GEE" clip or a sheet metal screw in the outlet box. The ground wire installed behind the device mounting screws will not be acceptable.	transformer. C. Provide the pad for the pad—mounted transformer in accordance with the power company	P. Panels having sub—feed lugs for feeding through shall have 8" minimum extra gutter space at the lug end and on one side.	
18" below finished grade, above a portion of the earth fill shall be "Terra Tape" as manufactured by Reef Industries, Inc., P.O. Box 33248, Houston, Texas 77033 (1—800—231—6074).	C. Provide one (1) #6 AWG ground in 3/4" conduit from the system ground to the telephone company main distribution frame or service cabinet and to each telephone backboard.	specification. D. The secondary service to the building shall be (277/480), (120/208) volts, 3 phase, 4 wire, 60	Q. Each panel as a complete unit shall have a short—circuit current rating equal to or greater than the equipment rating indicated.	
3.4 WIRING A. All conductors shall be installed in conduit. No conductors shall be pulled into the conduit until	D. Provide a signal reference grounding grid under the raised floor in the computer room. The signal reference grid shall be as manufactured by Cadweld and shall include the following as a minimum:	Hertz AC. Provide all conduit and wire as specified from the secondary terminals of the transformer to the main switchboard.	R. All circuit breakers serving the fire alarm system shall include red marking and a listed locking mechanism per NFPA 72.	
the conduit system is complete and plaster had dried. Wire pulling lubricants shall be Gardner-Bender "Wireaide" or Ideal "Yellow 77".	1. The signal reference grid shall be 2" wide, 26 AWG gage copper strips on 2' centers in both directions. The grid shall be laid out such that the raised floor pedestals are centered in each 2' x 2' square.	1.3 ELECTRICAL SERVICE (From pole, underground)	S. Panels shall be as manufactured by ABB — General Electric, Square D, Siemens, or Eaton.	E CAROLINA CAROLINA
B. Conductors shall be continuous from outlet to outlet and from outlet to junction box or pull box. All splices and joints shall be carefully and securely made to be mechanically and electrically solid with pressure type connectors, Gardner Bender "Winggard" or Ideal "Wingnut". Tape shall be "Scotch" No. 33	2. All crossovers shall have a welded joint.	A. Make all arrangements with the power company and pay all charges made by the power company for permanent electric service. In the event that the power company's charges are not available at the time the project is bid, the bids shall be qualified to notify the Owner that such charges are not	2.2 DISTRIBUTION PANELBOARDS	
for indoor and No. 88 for outdoor or Gardner Bender No. 95—661. Where connection is made to any terminals of more than 30 amperes capacity and where conductors larger than No. 10 are connected to any terminal, copper terminal lugs shall be bolted to the conductors. Where multiple connections are	3. The grid shall be in sections (16' wide as a maximum and rolled on tubes with the outside of the roll protected for shipment.	B. The power company will provide the transformers on the pole and the connection of the secondary	A. Distribution panelboards (panels) shall be of the circuit breaker type, factory assembled by the manufacturer of the circuit breakers, complete with front door cover. The main breaker and the branch circuit breakers shall be as indicated. The main bus shall be 98% conductivity silver plated copper, rated as and of capacity equal to or greater than the rating or setting of the over—current protective	SEAL 05/24/23
made to the same terminal, individual lugs for each conductor shall be used. Aluminum conductors, if used for service conductors, shall be made with high compression lugs as manufactured by Square D, Ideal or MAC.	4. A 2" wide, 26 AWG gage x 72" copper strip with 5/16" hole in one end (for connection to the computer equipment) shall be installed for each piece of equipment and the connection to the	conductors to the transformers. C. Provide the trench and backfill for the underground secondary service.	device next back in the line. Panel shall be suitable for the voltage and phase indicated. Provide 25% ground bus.	DUNN OPERATIONS
C. Each conduit shall have a minimum of two (2) conductors pulled in unless that particular conduit is noted as being for systems other than electrical circuitry and/or future use or unless noted	equipment provided. 5. All ground connections shall be the Cadweld process.	D. The secondary service to the building shall be (277/480), (120/208) volts, 3 phase, 4 wire, 60 Hertz AC. Provide all conduit and wire as specified from the secondary terminals of the transformer to	B. Panels shall be flush or surface mounted as indicated, with baked—on enamel trim, adjustable trim clamps and door with chromium plated combination cylinder lock and catch, all locks keyed alike. Provide a specified nameplate for each device and a blank (not engraved) nameplate for each spare breaker or space.	CENTER
otherwise. D. Conductors for lighting and receptacle circuits shall have color coded jackets. The wiring shall be	6. Every sixth pedestal in each direction shall be connected to the grid using #6 AWG, 7 strand copper conductor.	the main switchboard. 1.4 ELECTRICAL SERVICE (From pole, overhead)	C. Provide energy reducing active arc flash mitigation system to comply with NEC 240.87 for all breakers rated 1200 amps or can be adjusted to 1200 amps or higher.	1269 JONESBORO RD. HARNETT COUNTY, NC 28334
D color coded with the same color used with its respective phase through the entire job as follows: 208/120 Volt System 480/277 Volt System	7. The grid is not required to be bonded to the floor. However, if any section does not lie flat, a mastic may be used. Consider this step only after all connections are made.	A. Make all arrangements with the power company and pay all charges made by the power company	D. The neutral bus shall utilize setscrews to bond the neutral bus through holes drilled in the neutral	
Phase A — Black Phase A — Brown	8. All columns within and at the perimeter of the room shall be bonded to the grid at the shortest	for permanent electric service. In the event that the power company's charges are not available at the time the project is bid, the bids shall be qualified to notify the Owner that such charges are not included.	bar. A sheet copper neutral bus utilizing flathead screws to hold the neutral wires will not be acceptable.	OPERATIONS BUILDING
Phase B — Red Phase B — Orange Phase C — Blue Phase C — Yellow Neutral — White Neutral — Gray	path using a #6 AWG, 7 strand copper conductor. 9. All conduits, pipes, ducts, miscellaneous steel, etc., shall be bonded to the grid using a #6 AWG,	B. The power company will provide the secondary conductors, overhead from the pole terminating at the weatherhead, and the connection of the overhead conductors to the service conductors.	E. All circuit breakers shall be manually operated, thermal—magnetic, automatic, of the ampacity and poles as indicated. They shall be quick—make, quick—break both on manual and on automatic operation. Breakers shall be over—the—center toggle operating type, with the handle going to a position between "ON" and "OFF" to indicate automatic tripping. All multi—pole breakers shall have internal	
Ground — Green Ground — Green E. The feeder and service entrance conductors shall be color coded by the use of colored plastic	7 strand copper conductor. 10. The installation of the signal reference grid shall be in compliance with Cadweld's installation	C. Provide the insulated terminals for the overhead conductors, the weatherhead(s), and the conduit and wire for the service entrance, terminating at the main switchboard.	common trip. F. The minimum interrupting capacity of the breakers furnished shall be 10,000 amperes RMS	
tape applied within 6" of each conductor end.	recommendations.	D. The secondary service to the building shall be (277/480), (120/208) volts, 3 phase, 4 wire, 60 Hertz AC.	symmetrical for 120/208 volt and 14,000 amperes RMS symmetrical for 480/277 volt unless indicated otherwise on the riser diagram.	
F. Branch circuit conductors shall not be smaller than No. 12 and where the home run from center of load exceeds 100'-0", the conductors from home run outlet to panel shall be No. 10 minimum.	3.10 TELEPHONE CONDUIT SYSTEM A. Telephone service shall include wood backboards and equipment cabinets with service entrance	1.5 METERING (From pole, underground)	G. All main circuit breakers (except as listed below) shall be molded case and vertically mounted. All vertically mounted molded case circuit breakers shall be mounted so that the handle is up for "ON"	NONSTRI
G. For branch circuits terminating in outlet without device, leave minimum of 12" of slack wire coiled for connection of equipment. All conductors shall be identified with proper circuit numbers at terminals, junction boxes at panelboards within 6" of conductor ends.	conduit as shown. B. Telephone service entrance cable, all branch cabling and telephone instruments shall be provided	A. Metering equipment will be by the power company. The power company will furnish the meter base for installation at a location as directed by the power company. The power company will provide meter, control wires to the meter, and the current transformers.	and down for "OFF", when viewed from the normal standing position. All vertically mounted molded case main circuit breakers shall be UL approved for feeding in the bottom and out the top.	
3.5 OUTLETS	by the telephone equipment vendor. C. Provide an outlet and conduit system for the telephones as shown and leave the same in	B. Provide the current transformers cabinet and a 1" conduit with fish—wire to the meter base. Install all equipment as directed by the power company.	H. All circuit breakers feeding an emergency panel or main breaker for an emergency panel shall have solid state trip units that are insensitive to changes in ambient temperature and a push—to—trip button to mechanically check the trip mechanism or for the use under emergency trip conditions. Interchangeable rating plugs shall establish the continuous current rating of each breaker. An interlock	ISSUED TO THE PARTY OF THE PART
A. Provide galvanized steel or cast type boxes for all outlets.	readiness for wiring by others. Provide pull line in all telephone conduit. Terminate all conduit at a uniform height with smooth insulated bushings at the telephone wood backboards.	1.6 METERING (From pole, overhead)	in the rating plug shall trip the breaker if an attempt is made to remove the plug with the breaker in the ON position. With the plug removed, it shall not be possible to close the breaker.	
B. Where outlet boxes are used to support lighting fixtures, the outlet box shall be anchored to the structural members of the building per NEC 370—13.	D. Telephone wall outlets shall be pressed steel sectional switch boxes, wall mounted at the locations indicated. Coverplate shall have a bushed hole.	A. Provide a 1" conduit with a weather—head from the point of attachment of the service conductors to the meter base.	I. The solid state trip breakers shall provide long delay and magnetic tripping similar to thermal magnetic breakers. In addition, the magnetic trip shall include a short time delay permitting coordination and selective tripping with downstream devices. It shall be possible to check the breaker	DATE DATE
C. Outlet boxes shall be flush mounted unless they are specifically shown as being used with exposed conduit or are located above a ceiling.	E. Telephone floor outlets shall be floor boxes as specified at the locations indicated. 3.11 CONNECTION TO EQUIPMENT	1.7 METERING (From pad mounted transformer)	electrically and mechanically while in service without dismantling equipment and with minimum down time.	MARK COCO CO
D. Where outlets are supplied from conduit run in or below floor slabs, the conduit shall be stubbed up at the location shown and the wall built up around the conduit.	A. Equipment furnished by the Owner or under other Sections, such as mechanical equipment,	A. Metering equipment will be by the power company. The power company will furnish the meter cabinet for installation at a location as directed by the power company and as detailed at the	J. All circuit breakers, including any connectors to the main bus, shall be bolted and rigidly braced.K. Spaces for future installation of molded case circuit breakers are specifically by range of trip	PROJECT NO: DRAWING NUMBER
E. Cuts for outlet boxes in masonry walls shall be made so that the coverplate will completely cover the cut. The mounting height of switch, receptacle and other outlets may be varied slightly, with the Architect's approvals, so that the outlet box, top or bottom, will occur at a masonry joint.	elevators, escalators, signs, kitchen equipment, etc., will be installed by others. Provide electrical service and make the electrical circuit connection to this equipment.	pad—mounted transformer. B. Provide a 1" conduit from the transformer to the meter cabinet as shown. The power company	rather than a single trip size or frame size. The spaces so scheduled shall be complete with all bus and required bus connectors such that future breakers can be installed without adding or changing bus connectors on the main bus and without using a larger (frame size) or more expensive breaker than the trip size and interrupting capacity would require. If the bus connectors furnished on the main bus	CFD-XXX-E-003-XXXXX
F. The edge of all outlet boxes shall be flush with the surface in which they are recessed. The devices that fit into the outlet boxes shall be screwed tight before the coverplate is installed and the	B. Provide PVC insulated flexible cord sets for all cord and plug connected building appliances and equipment. Cords shall be sized in accordance with electrical circuits indicated. Multiple conductor cords shall be "SO" cable with PVC jacket and green insulated ground conductor.	will provide the control wires to the meter. PART 2 — PRODUCTS	will not cover the trip range specified, then duplicate sets of connectors shall be furnished on the main bus bus for each frame size required.	ELECTRONIC FILE NAME: DRAWN BY: JFE
coverplate shall not be used as a means of tightening the devices in place. G. Where outlets are shown as being adjacent and different mounting heights are specified for each,	3.12 CORING, CUTTING AND PATCHING	2.1 BRANCH CIRCUIT PANELBOARDS	L. Distribution panels shall be as manufactured by ABB — General Electric, Square D, Siemens, or Eaton.	CHK'D BY: JSL DATE:
they shall be mounted one directly over the other, on the centerline of the group. 3.6 NAMEPLATES	A. Set sleeves for conduit accurately before the concrete floors are poured, or set boxes on the forms so as to leave openings in the floors in which the required sleeves can be subsequently located. Fill in the voids around the sleeves with concrete.	A. Panelboards (panels) shall be general purpose enclosures and shall be surface or flush mounted as indicated. Panels shall be of the automatic circuit breaker type, factory assembled by the manufacturer of the circuit breakers. Panels shall be for the voltage indicated with the quantity of	2.3 TRANSFORMERS	E-MAIL: SLOWERY@BARRETTWOODYARD.COM THIS DESIGN DRAWING IS THE EXCLUSIVE PROPERTY OF DUKE ENERGY CORPORATION AND IS CONSIDERED CONFIDENTIAL. IT SHALL
A. Provide specified nameplates on the main switchboard, distribution panels, feeder switches, feeder breakers, panelboards motor control centers, disconnect switches, contactors, starters, transformers,	B. Should the performance of this preliminary work be neglected and should cutting be required in order to install conduit, then the expense of the cutting and restoring of surfaces to their original	poles and ampacity of circuit breakers shown.	A. Branch circuit and distribution transformers shall be the dry type and shall have the ratings indicated.	THIS DESIGN DRAWING IS THE EXCLUSIVE PROPERTY OF DUKE ENERGY CORPORATION AND IS CONSIDERED CONFIDENTIAL. IT SHALL NOT BE MODIFIED, COPIED, OR DISTRIBUTED WITHOUT PRIOR APPROVAL. THIS INFORMATION SHOULD ONLY BE USED FOR THE SPECIFIC PROJECT INTENDED. SHEET TITLE:
start—stop push buttons and motor switches.	conditions shall be accomplished without incurring additions to the Contract. 3.13 EQUIPMENT ANCHORING	B. Boxes and trim shall be made from code gauge steel. Boxes shall be sufficient size to provide a minimum gutter space of 4" on all sides. Boxes shall be minimum 20" width and 5 3/4" depth.	B. Single phase transformers shall be 480 volt primary and 120/208 volt secondary. Three phase transformers shall be 480 volt delta primary and 120/208 volt grounded type secondary. Transformers 25 kVA and larger shall have a minimum of four (4) 2.5% full capacity primary taps.	SPECIFICATIONS
B. Provide nameplates on every device in the main switchboard, distribution panels and motor control centers.	A. All items of electrical equipment, such as switchboards, motor control centers, transformers, standby generator, etc., shall be securely anchored to the building structure. The anchoring shall be	C. Hinged door covering all device handles shall be included in all panel trim. Doors shall have flush—type cylinder lock and catch, except that doors over 48" in height shall have auxiliary fasteners at top and bottom of door in addition to flush—type cylinder lock and catch. Door hinges shall be concealed. All locks shall be keyed alike. Directory frame and card having a transparent cover shall	C. Transformers shall have a U.L. recognized 220 degree insulation system and shall be designed so that under full load, the average conductor temperature rise does not exceed 115 degree C. rise above	A - ELECTRICAL
C. Nameplates for surface mounted equipment shall be installed on the exterior of equipment with sheetmetal screws. Nameplates for flush or recessed mounted equipment shall be installed on the inside of the panel door or cover with epoxy cement.	accomplished by utilizing a minimum size of 3/8" steel anchor bolts in the structure and to the item of equipment. A minimum of two (2) anchor bolts shall be provided on each side of each item of equipment with the following exceptions:	be furnished each panel door.	a 40 degree C. ambient and the enclosure does not exceed a 50 degree C. rise at any point. D. Transformer coils shall be of the continuous wound construction and shall be impregnated with	SHEET NO.
3.7 WALL SWITCHES AND RECEPTACLES	Exception No. 1: If the equipment manufacturer includes more than two (2) anchor holes	D. Trims for flush panels shall overlap the box by at least 3/4" all around. Surface trims shall have the same width and height as the box. Trims shall be mountable by a screwdriver without the need for special tools. After installation, trim mounting mechanism or hardware shall not be accessible when	non—hygroscopic, thermosetting varnish. All cores to be constructed of high grade, non—aging silicon steel with high magnetic permeability, and low hystersesis and eddy current losses. Magnetic flux densities shall be kept well below the saturation point. The core laminations shall be clamped together	E-003
1 2	3	5	7	9





1	2	3	4	5	6	7 8	9	
1.2 RELATED DOCUMENTS				mounted instruments, water temperature gaug	ge, lubrication oil pressure gauge and battery charging	meet standards as established by U.L., NEMA and the N.E.C.		CFD-XXX-E-005-XXXXX
A. General Conditions		H. All dimmer modules shall be U.L. listed to	o control the lighting loads connected to it. in capacity ratings from 1440 watts to 12,000 watts at	B. A gear driven hydraulic governor shall r	naintain frequency regulation not to exceed 3% to 5% from	2.11 AUTOMATIC LOAD TRANSFER SWITCHES		
B. Electrical Section General Provisions		120 volts and 5500 watts to 27,700 watts at 2	277 volts. Dimmer ratings shall be full capacity, no uit breakers shall be at least 20% over—rated. All	no load to full rated load. Generator sets o governor.	bove 150KW shall have an electronic isochronous type	A. The amperage rating of the automatic load transfer switch shall be as shown.		DUKE
C. Conduit		2.5 DIMMER MODULE TYPES		C. The unit shall be mounted on a structuisolators.	ral steel sub—base and shall be provided with suitable	B. The automatic transfer switch shall be mechanically held on both the emergency a side. The switch shall be double throw with the main contacts rigidly and mechanically insure only two possible positions: Normal or Emergency. A manual operator must be	interlocked to	H ENERGY®
D. Wire and Cable 1.3 MANUFACTURER'S SERVICES		A. Each dimmer system may require one or capacity of the following dimmer types as show	more types of dimmers. Provide the quantity and wn on the drawings or in dimmer schedules.	D. Safety shut—off for high water temperated alarm for low water temperature shall be pro-	ture, low oil pressure overspeed and engine overcrank, with ovided. Alarms per NFPA—110 Level 1.	enable manual operation without having to assemble the handle.		
A. Shop drawings shall be submitted for approval	within 30 days after receipt of contract. No	Incandescent dimmers		E. Guards shall be provided over all expos	ed moving parts as required by OSHA.	C. The automatic load transfer control shall be rated for continuous duty when enclos non—ventilated NEMA 1 enclosure. It shall be rated for all classes of load, including inconominductive, at 600 volts and tungsten lamp load at 250 volts. The transfer switch possible control shall be designed, built and tested to close on an inrush current up to and included	ductive and prtion of the	MAILING ADDRESS: P.O. BOX 1007 CHARLOTTE, NC 28201
fabrication of equipment is to proceed prior to app contain (6) six sets of the following:		a. Incandescent dimmers shall be available to	to operate tungsten lamps including quartz and halogen s. Dimming range shall be from 0% to 100%. All lighting	2.3 GENERATOR		(20) times the continuous rating of the switch without welding or excessive burning of the transfer switch shall be capable of enduring six thousand (6000) cycles of operation current, at a rate of six (6) cycles per minute, without failure. One cycle shall consist	the contacts. n, at rated	
1. Complete bill of materials.		intensity changes shall be instantaneous in resp smooth without flicker or stepping.	ponse to control changes. Dimming shall be visually	A. The generator shall be rated for contine factor, 277/480 volts, three—phase, four wire	uous standby service at ratings indicated with 0.8 power e, 60 hertz, 1800 RPM.	complete opening and closure of both sets of contacts on an inrush current of ten (10 continuous rating of the switch.		Safety Expectations:
2. Sets of catalog cut sheets for standard equip		2.6 EIGHT SCENE PRESET CONTROL		B. The generator shall be a three phase, built to NEMA standards. A voltage regulator	60 hertz, single bearing, rotating field, synchronous type shall be provided to match the characteristics of the	D. The transfer switch shall be as listed under U.L. 1008. Switch utilizing reversing a mechanisms as a means to transfer load are disallowed and will not be considered.	contactor	Reduce Risk Remove Exposures to Hazards
wire counts, internal wiring, and physical dimensions unacceptable.	and electrical equipment including on line diagrams, of each item. Marked up catalog cut sheets are		Preset Select switches, Maximum (full on), Off and er for preset recall, Record and station Enable key switch, ers and a programmable fade rate controller.	accessible voltage droop, voltage level and voltage adjustment shall be a minimum of $\pm 1/-100$ 5%.	all be +/- 2% from no load to full rated load. Readily oltage gain controls shall be provided. Voltage level Generator and exciter shall be inherently capable of	E. The automatic load transfer switch shall include the following accessories:		Reinforce Safe Behavior
lamped, a qualified factory representative shall comp			near potentiometer with an integral LED indicator in the senever the slide controller has taken control of channel	include a twelve lead, reconnectable bus syst brushless permanent magnet, and shall susta	f equivalent electrical characteristics, and stator shall em for each load reconnection. Generator shall be in short circuit current at 300% of rated current up to 10	1. Engine starting contacts to provide for generator starting.		G
system. At the time of the checkout and testing, instructed in the proper operation to the	•	intensity from preset level or when station is in Raise/Lower switches with LED bar graph indicar	n manual mode. Systems suing thumbwheels or	seconds. 2.4 COOLING SYSTEM		2. Full phase protection. Three-phase relays shall be field adjustable, close differenti 92-95% pickup and 82-85% drop out. Relays are to be connected across live lines.	al type with	I C7 D
sets of as-built drawings and three (3) sets of op-	completed, the manufacturer is to provide three (3) erations and maintenance manuals for the dimming	C. The flush wall mounted master station sho latching cover of machined aluminum, not plasti	nall be constructed of machined aluminum with a hinged stic. Station shall be supplied with a back box.		provided to maintain safe operation at 110 degrees F.	3. Test switch, to simulate a power outage.		
systems. 1.4 QUALITY ASSURANCE		D. Systems shall be available with multiple re portable wireless infrared controls, Audio Visual	remote options including remote preset select stations,	ductwork with flexible connecting section betweengine coolant heater with thermostat to ma	m the radiator shall not exceed 0.5" H20. Provide veen radiator and discharge louver frame. Provide an intain coolant temperature at not lower than 60 degrees F.	4. Adjustable time delay on engine starting to override momentary outages and nuisa		
	erwriters Laboratories, Inc. (U.L.) and comply with	•	nal accessories as indicated on drawings.	engine is operating.	·	 Adjustable time delay on transfer of load to emergency source. Adjustable time delay transfer switch contact to allow motor loads to decay. 	lelay to open	
the National Electrical Code (NEC) and local building		PART 3 — EXECUTION		· · · · · · · · · · · · · · · · · · ·	treated by the system supplier for the inhibition of internal nnection to heater from base building panel in core (HM or	6. Adjustable time delay on retransfer of load to normal with 5 minute cool—down tir generator set runs unloaded after transfer to line.	mer wherein the	BW &A Barrett, Woodyard and Associates, Inc.
B. The equipment specified herein shall be the confidence of dimmer and cabinet fabrication must take place in component assemblers is not acceptable.	·	3.1 INSTALLATION A It shall be the responsibility of the Flectric	ical Contractor to receive and store the necessary	2.5 FUEL SYSTEM		7. Plant exerciser to start and run the generator set with or without load each 168 minute interval. Selector switch will be provided for with—load or without—load testing.	hours for a 30	License # C-2226 420 Minuet LN. Charlotte, North Carolina 28217
C. The manufacturer shall be one who has been architectural lighting controls and dimmers for a mi		materials and equipment for dimming system. include everything required for proper and comp	It is the intent of these specifications and plans to applete installation and operation of the dimming system, y mentioned, the contractor shall timely deliver to other		with all required black iron fuel oil piping. Provide a low ble wall, closed top dike, UL labeled, sized as required by	8. One auxiliary contact closed on emergency and one auxiliary contact open on eme	rgency.	(p) 704-357-9333 (f) 704-357-9385 © This drawing is copyrighted. It may not be reproduced nor used in any other
D. All equipment shall be 100% tested as a commethods are not acceptable.	olete system. Manufacturers using sample testing	trades any equipment that must be installed du	·	local code. ***(24 hour)*** run time minimu 2.6 OUTDOOR HOUSING AND EXHAUST MUFFL	um based on GPH rating of manufacturing engine.	9. Pilot lights to indicate the normal and emergency position of the transfer switch.		form or on any other project. BWA JOB # 2022-0632
1.5 WARRANTY			sible for field measurements and coordinating the physical quirements of the spaces into which they are to be		c completely enclose the engine generator and accessories.	10. Isolated (underground) neutral bar.	_	
A. All equipment shall be warranted free of defeat	• • • • • • • • • • • • • • • • • • •	C. The Electrical Contractor shall install all lig	ighting control dimming equipment in accordance with the	Housing shall have removable swing doors or and controls. Side doors shall have a mean	om the environment, yet be conducive to easy maintenance. each side and lockable rear door for access to meters s to lock. Construction of housing shall be of a minimum	11. Disconnect plug.		
eighteen (18) months from date of shipment or two occurs first.	elve (12) months from date to turn—on, whichever	D. All branch load circuits shall be live tested to the dimmer system load terminals.	ed by the Electrical Contractor before connecting the loads	14 gauge sheet steel and painted manufactures. B. Exhaust muffler shall be mounted on to	rers' standard color. op of housing. The exhaust muffler shall be a critical	2.12 WEATHER—PROTECTIVE ENCLOSURE A. Enclosure and all other items to be designed and built by manufacturer as an inte	egral part of the	
PART 2 — PRODUCTS		3.2 MANUFACTURER'S SERVICES		grade muffler. Muffler shall be factory insta flexible exhaust fitting shall be supplied and	lled so that its weight is not supported by the engine. A installed between the muffler and exhaust manifold. All ncludes flanges, muffler, tail pipe and raincap.	entire generator set and be designed to perform without overheating in the ambient tem area installed. Constructed of 14— and 18— gauge sheet metal, suitably reinforced to in the operating mode. Four hinged doors provide complete access without their remov	perature of the be vibration free al. Each door	
E 2.1 MANUFACTURER'S REQUIREMENTS. A. The equipment herein specified is manufacture	d by Macro Flectronics Corporation of Austin. Texas.		ding testing of load circuits, the contractor shall notify stem is available for formal checkout. This notification is	2.7 INDOOR UNIT EXHAUST SYSTEM		to have at least two latch—bearing points. Side and rear panels to be completely and removable to major service access. Roof to be peaked to allow drainage of rain water doors shall be lockable from the enclosure manufacturer.	simply . Enclosure	E CAPOLINA
(512) 837—5100 and shall serve to indicate the quequipment by Macro Electronics Corporation. If alter an add or deduct from the base bid price and shall shall be a second sho	ality of equipment required. Base bid shall be for rnate equipment is proposed, it shall be shown as	to be given in writing two weeks prior to the ti	time factory trained personnel are needed on the job site. on can be waived. No power is applied to the dimming	· · · · · · · · · · · · · · · · · · ·	ion flanges and flexible stainless steel exhaust fittings shall recommendations. Mounting shall be supported by building	B. Provide baked enamel finish with primer and finish coat to be painted before asse fasteners to be rust resistant. Unit shall have sufficient guards to prevent entrance by		
B. Other manufacturers who wish to bid must su information listing qualifications and experience to the permission to bid. All manufacturers must comply	omit a complete bill of materials with company ne Architect ten days prior to bid date for	system unless specifically duthorized by written	matractions from the manaracturer.	structure. The silencer shall be mounted so	that its weight is not supported by the engine. Exhaust xhaust back—pressure does not exceed the maximum	Batteries to fit inside enclosure and alongside the engine. Batteries under the generato acceptable.	r are not	MAN COTT LOWER TO THE TENT OF THE PARTY OF T
2.2 SYSTEM TESTING		END OF SECTION SECTION 26 61 00			ng shall be lagged to maintain a surface temperature not all be installed so that it does not cover or interfere with	C. Unit shall have coolant and oil drains outside the unit to facilitate maintenance. It is to have a high quality valve located near the fluid source. Fuel filter must be inside perimeter and located so spilled fuel cannot fall on hot parts of engine or generator.	e the base	SEAL 05/24/23
A. All dimmers shall be assembled into the dimm factory prior to shipment. All dimmers shall be sin		EMERGENCY SYSTEM			Insulation shall be supplied under Division 15.	primary fuel strainer shall be used to collect water and sediment between tank and mai filter. Crankcase fumes disposal shall terminate in front of the radiator to prevent oil on the radiator core and reducing cooling capacity.	n engine fuel	DUNN OPERATIONS CENTER
stations shall be connected to the dimmer cabinet complete system under power at the factory prior t functions, such as take control, transferring, master	(or cabinets) and testing shall be done as a o shipment. This testing shall include exercising all	PART 1 — GENERAL		2.8 AUTOMATIC STARTING SYSTEM	ive engagement chall be provided. The meter voltage chall	PART 3 - EXECUTION		CLIVILIC
this shall be done for each individual control and a systems shipped as components for job site assem at the factory prior to shipping shall not be accept	oly or that are not completely tested as a system	1.1 DESCRIPTION		be as recommended by the engine manufact	ive engagement shall be provided. The motor voltage shall urer.	3.1 INSTALLATION		1269 JONESBORO RD. HARNETT COUNTY, NC 28334
2.3 DIMMER CABINETS		A. All work specified in this Section shall conB. Provide all labor and material necessary to	to install a standby diesel engine—generator set in a		o controls in the generator control panel shall be provided. ressure, high water temperature, overspeed and overcrank. Inking cycle limit with lockout.	A. Mount generator on 4 inch thick re—enforced 3000 psi concrete pad. Concrete she larger in all directions than footprint of generator.	nall be 1 foot	OPERATIONS
A. The cabinets shall contain all dimmer modules supplies, primary and secondary circuit breakers, ba	rriered section for power separation of emergency	complete and operating condition.		C. A belt driven battery charging alternator Voltage shall match the electric starting syst	shall be provided with transistorized voltage regulator. em.	3.2 MANUFACTURING		BUILDING
lighting circuits, and all wiring as required for lighting. The dimmer cabinet shall contain main lugs for termination of all branch circuits. The dimmer system with three phase four wire consists plus againment.	mination of input feeders and a neutral block for	enclosure and components.	e for outdoor use and complete with weather—protective		heavy duty starting type shall be provided. Battery voltage The battery set shall be rated as required by generator	A. The unit shall be shipped to the job by the manufacturer's authorized dealer having service facility within a 120 mile radius of the job. In addition, and in order not to perfor unnecessary or prolonged periods of time for service or repairs to the emergency service.	enalize the Owner	
equipment ground. Emergency feeds shall be as sl		1.2 SUBMITTALS	e ² are del accordence allocations and acceptable for the constant	manufacturer in amp hours. Necessary cable		bidding generator set supplier must have replacement parts in stock at all times. Certi this requirement shall be available from the dealer and a personal inspection of the dealer may be made by the Architect or his appointed representative to substantiate claims may	fied proof of all all all all all all all all all al	
in a textured medium blue color two part epoxy typerear, wall mount or floor standing, and so arranged	that all dimmers and related components are	generator and major auxiliary equipment.	s' model numbers, dimensions and weights for the engine,	be constructed of metal and so treated as t	n battery and shall conform to NEC 480—7,a,1. They shall o be resistant to deteriorating action by battery electrolyte. onducting insulation material directly supports the cells.	generator set supplier.		CTION
c. Internal power wiring shall be U.L. Listed (UL3		B. Submit copies of pertinent drawings and s following:	schematic diagrams for approval and include the		be provided to automatically recharge batteries. It shall wave rectifiers, voltage surge suppressor, DC ammeter, DC	3.3 TESTINGA. Prior to acceptance of the installation, equipment shall be tested to show it is free	ee of any	ISION
neatly placed and bundled with suitable tie wraps. and all wiring shall be terminated in compression ty wiring. The complete system shall be a U.L. Listed	Control wiring and power wiring shall be separate type terminals for installation of job site contractor's	 Engine generator set including plans and e the interconnections required. 	elevations clearly indicating entrance points for each of	voltmeter, equalize timer and fused AC input. Amperage output shall be no less than 10 a and battery charger fault in the charger. Co	AC input voltage shall be 120 volts, single phase. mperes. Alarm shall be provided for low—battery voltage ontrol circuit shall be wired from charger to generator	defects and will start automatically and be subjected to full load test through the use of dry—type load banks supplied for this purpose at the job by the generator set supplier.	of portable,	C A A A A A A A A A
D. Dimmer cabinets shall be convection cooled.	In very large systems with floor— mounted cabinets,	2. Engine generator/exciter control cubicle.		control panel by electrical contractor for indi- from base building panel in core (HM or L c	cation on control panel. Obtain power for battery charger is necessitated by voltage requried).	B. The load bank shall be capable of definite and precise incremental loading and sh dependent on the generator control instrumentation to read amperage and voltage of ec Rather, the test instrumentation will serve as a check of the generator set meters.		SUED
fans are permitted only if they are controlled by a cabinet. Dimmers shall operate in 0 to 40 degrees air temperature. Heat load generated by the dimm	Centigrade (32 to 104 degree Fahrenheit) ambient	3. Fuel consumption rate at various loads, ve	ventilation and combustion CFM requirements.	2.9 GENERATOR CONTROL PANEL		C. Saltwater brine tanks or those load banks requiring water as a source for cooling	are not	N N N
E. The dimmer cabinets and controls shall be sto	ored in their original cartons or crates in a dry III. Dimmers shall not be used to furnish any	4. Exhaust mufflers and vibration isolators.		A. A generator mounted NEMA 1 type vibro contain, but shall not be limited to, the follo	ation isolation control panel shall be provided. Panel shall wing equipment:	acceptable for this purpose and are disallowed and shall not be utilized for this test. D. Load bank testing shall be done in the presence of the Owner or his appointed re	presentative only	DR
temporary light or power for construction activities. 2.4 DIMMING MODULES		5. Battery charger, battery and battery racks.6. Day tank fuel connection points.	5.	1. Frequency Meter, 3 1/2", dial type.		after the unit is permanently installed in accordance with the Contract Documents. Test a period of four (4) hours under full load.		DATE 05.24.
A. The dimming modules shall be 100% solid sta		7. Automatic load transfer control switch.		2. Voltmeter, 3 1/2", 2% accuracy.		3.4 START UP AND INSTRUCTIONS		AN AND AND AND AND AND AND AND AND AND A
silicon Controlled Rectifiers (SCR) as power handling cycle surge rating of 600 amps or greater. Dimme bypass jumpers for system installation are not acce	ers using Triac Thryistors, air gap relays or special	8. Actual electrical diagrams including schemo all equipment to be provided.	natic diagrams and inter—connection wiring diagrams for	3. Ammeter, 3 1/2", 2% accuracy.4. Ammeter/Voltmeter phase selector switch	h	A. On completion of the installation, start up shall be performed by the engine manudealer service representative.	facturers' trained	PROJECT NO: DRAWING NUMBER
B. The Silicon Controlled Rectifiers, along with the shall be mounted in modular dimmina units. The c	e filter inductor and control printed circuit board, limmer module shall be constructed on a heavy—duty	9. Legends for all devices on all diagrams.		 Automatic starting controls as specified. 		B. Operating and maintenance instruction manual shall be furnished and procedures exoperating personnel.	xplained to	CFD-XXX-E-005-XXXXX
	und. Each module shall be connectorized to plug in,	10. Weather—protective housing.		6. Voltage level adjustment rheostat.		3.5 SYSTEM SERVICE CONTRACT		DRAWN BY: JFE
C. Each dimmer power module shall incorporate of to the air the heat generated by the silicon control directly exposed to ambient air, and operation in an		C. The specified standby KW shall be for con normal utility source and shall be certified by t	ntinuous electrical service during interruption of the the manufacturer for the actual unit supplied.	7. Contacts for remote alarms wired to te	rminal strips.	A. The supplier of the standby power system must furnish a copy of, and make avail Owner, his standard service contract which, at the Owner's option, may be accepted or	refused. This	CHK'D BY: JSL DATE:
Fahrenheit shall not require fans for cooling.		PART 2 — PRODUCTS		8. Individual fault indicator lights for low cand low water temperature.	il pressure, high water temperature, overspeed, overcrank	contract will accompany any documents, drawings, catalog cuts, specification sheets, wire drawings, etc. submitted for approval. This contract shall be for the complete power sy		E-MAIL: SLOWERY@BARRETTWOODYARD.COM THIS DESIGN DRAWING IS THE EXCLUSIVE PROPERTY OF DUKE
cards shall be of U.L. listed fire retardant epoxy glaintegrated circuit and transistor type active elements		2.1 MANUFACTURER		9. Three position function switch marked,	RUN-STOP and REMOTE.	3.6 GUARANTEE		THIS DESIGN DRAWING IS THE EXCLUSIVE PROPERTY OF DUKE ENERGY CORPORATION AND IS CONSIDERED CONFIDENTIAL. IT SHALL NOT BE MODIFIED, COPIED, OR DISTRIBUTED WITHOUT PRIOR APPROVAL. THIS INFORMATION SHOULD ONLY BE USED FOR THE SPECIFIC PROJECT INTENDED.
long term stability with no periodic calibrations or a incorporate voltage compensation to reduce the effe	ct of line voltage changes.	A. The equipment shall be as manufactured be Kohler of the size and ratings indicated.	by Cummins's, Detroit Diesel Caterpillar/Olympian or		y charging ammeter and water temperature gauges.	A. Equipment provided under this Section shall be guaranteed against defective parts under terms of the manufacturer's and dealer's standard warranty. But in no event shaperiod of less than five (5) years from date of initial start up of the system and shall and target time for passage and the interval time for passage and the interval time for passage and the interval time.	all it be for a	SPECIFICATIONS
A frequency interference (R.F.I.) and reduce filament r of 350 microseconds from 0% to 90% measured ur	der full load at 90 degree conduction angle. Filter	B. Equipment shall include weather—protective	e housing for outdoor use.	2.10 MAIN LINE CIRCUIT BREAKERS	broakers sized as about made a little of the control of the contro	and travel time for necessary repairs at the job.		A - ELECTRICAL
chokes shall be securely mounted and adequately versions. F. Dimmer efficiency shall be 98% at full output		2.2 ENGINE		The outputs of the generator shall be protec	breakers sized as shown and mounted upon the generator. ted by load circuit interrupting and protection devices. switching functions and automatically during overload and	END OF SECTION		SHEET NO.
G. Dimmer control voltage shall be 0 to 10 volts		diesel. It shall meet specifications when operat requiring premium fuels will not be considered.	or vee—type two or four stroke cycle compression ignition ation on Number 2 domestic burner oil. Diesel engines The engine shall be equipped with fuel, lube oil, intake fuel priming pump, engine driven water pump, and unit	B. The trip unit for each pole shall have a	elements providing inverse time delay during overload	SECTION 26 65 00 SURGE PROTECTION DEVICES		E-005
1	2	3	fuel priming pump, engine driven water pump and unit	conditions and instantaneous magnetic trippin 5	g for short circuit protection. The circuit breaker shall	7	9	
	_		ſ					

1 2	3 4	5 6	7	9
PART 1 — GENERAL	3. Line to Line: [1800 V for 480Y/277 V] [1200 V for 208Y/120 V]	lead length. Do not bond neutral and ground.	END OF SECTION	CFD-XXX-E-006-XXXXX
1.1 DESCRIPTION	F. Protection modes and UL 1449 VPR for 240/120 V, single—phase, three—wire circuits shall not exceed the following:	E. Use crimped connectors and splices only. Wire nuts are not acceptable.	SECTION 28 72 10	
A. All work in this Section shall comply with the provisions of Section 260100.	1. Line to Neutral: 700V	3.2 STARTUP SERVICES	LIFE SAFETY SYSTEMS	DUKE
H 1.2 DEFINITIONS	 Line to Ground: 700 V Line to Line: 1200V 	 A. Complete startup checks according to manufacturer's written instructions. B. Do not perform insulation—resistance tests of the distribution wiring equipment with SPDs installed. 	PART 1 — GENERAL 1.1 DESCRIPTION	H ENERGY®
A. I/nominal: Nominal discharge current	G. Unit shall have a short-circuit current rating of 200 kA.	Disconnect SPDs before conducting insulation—resistance tests, and reconnect them immediately after the testing is over.	A. This section of the specification includes the furnishing, installation, connection and testing of the	
B. MCOV: Maximum continuous operating voltage	H. Unit shall have an I/nominal rating of 20 kA and shall comply with all UL96A requirements for ac surge protection.	C. Energize SPDs after power system has been energized, stabilized, and tested. D. Train owner's maintenance personnel to operate and maintain SPDs.	microprocessor controlled, intelligent reporting fire alarm equipment required to form a complete, operative, and coordinated system.	MAILING ADDRESS: P.O. BOX 1007 CHARLOTTE, NC 28201
C. Mode(s), also Modes of Protection: The pair of electrical connections where the VPR applies	I. Unit shall survive a minimum of 14,000 repetitive category C3 (20kV/10kA) surges with no more than 10% deterioration. Calculated repetitive surge values will not be accepted. Manufacturer shall	b. Train owner's maintenance personner to operate and maintain or be.	B. The fire alarm system shall comply with requirements of the NFPA Standard 72 for Protected Premises Signaling Systems and all local codes and regulations. The system shall be electrically supervised and monitor the integrity of all conductors. The manufacturer shall confirm all codes have	
D. MOV: Metal—oxide varistor; an electronic component with a significant non—ohmic current—voltage characteristic	provide repetitive surge test report. J. Unit shall be able to withstand a minimum of 100 temporary over voltage events, defined as: 30A	END OF SECTION	been met and all necessary devices provided prior to submitting price.	Safety Expectations:
E. OCPD: Overcurrent protective device	available fault current, 30 cycles duration, 10 second interval between events.	SECTION 26 92 00	C. Alarm, trouble and supervisory signals from all intelligent reporting devices shall be encoded onto the Signaling Line Circuits.	Reduce Risk ZERO Remove Exposures to Hazards
F. SCCR: Short—circuit current rating G. SPD: Surge protective device	K. Unit shall be able to prevent common temporary over voltages from damaging the MOVs. Voltages shall be limited per the following:	MOTOR CONTROLS AND WIRING	D. The system shall be an active/interrogative type system where each transponder is repetitively scanned, causing a signal to be transmitted to the local fire alarm control panel/node indicating that the transponder and its associated initiating device and notification appliance circuit wiring is functional.	Reinforce Safe Behavior
G H. VPR: Voltage protection rating		PART 1 — GENERAL	Loss of this signal at the local FACP shall result in a trouble indication on both the FACP display and at the network display, as specified hereinafter for the particular input.	G
1.3 CODES AND REGULATIONS	L. The basis of design for this unit is the Select SL3 series.2.3 DISTRIBUTION PANELBOARD SURGE PROTECTION	1.1 SCOPEA. All work specified in this Section shall comply with the provisions of Section 26 01 00.	E. The system shall be arranged such that not less than 20 percent additional transponders may be inserted into any network communication loop.	
A. The following codes and regulations shall govern the design of the surge protection device:	A. Unit shall be listed as a Type I or Type II surge protection device per UL 1449, 3rd/ edition.	B. All motors shall be provided under Division 23.	F. The FACP and peripheral devices shall be manufactured by Notifier, Edwards, or Siemens.	
1. Underwriters Laboratories, Inc. Standard No. 1449 — Third Edition	B. Unit shall have the following features:	C. A motor starter shall be provided under this Section for each motor except for those specified in Division 23 to be furnished with integral starters. Motor starters shall be installed either in a Motor	G. The installing company shall employ NICET (minimum Level II Fire Alarm Technology) technicians on site. To guide the final checkout and to ensure the systems integrity, the submitting company shall	
2. Underwriters Laboratories, Inc. Standard No. 1283	1. It shall consist of parallel connections only. Series elements shall not be used.	Control Center or separately mounted adjacent to the motor served.	employ NICET Level IV minimum managers and engineers. Proof of NICET level training shall be included as part of submittal package and kept on site with personnel.	
3. National Electrical Manufacturers Association (NEMA LS1)	2. The primary suppression path shall not be to ground.	D. Motor power wiring is defined as those conductors between the energy source and the motor. This power wiring shall be terminated at the motor terminals.	H. The installing company shall be UL listed for fire alarm installations. UL certificate shall accompany submittal package. The certification listing category shall be UUJJ and shall be indicated in the project submittal.	$\overline{\mathbf{B}}\mathbf{W}$
4. IEEE 587 A&B Waveforms, IEEE C62.41 F 5. National Electrical Code — NFPA 70	3. The unit shall not short or crowbar the power flow resulting in an interruption to the load.	E. All control wiring required for automatic starting and stopping of motors shall be provided under Division 23 unless specifically shown on the electrical drawings.	I. The Contractor shall make arrangements and pay all fees in connection with the testing of the	License # C-2226 420 Minuet LN.
a. Article 110.9 — Interrupting Capacity	4. Internal thermal protection that disconnects the unit before damaging internal suppressor components.	F. Power wiring shall be connected through all line voltage control devices such as fire—stats and thermostats.	Life Safety System. All system devices shall be tested for their correct operation, except non—restorable type heat detectors which shall be sample tested. All tests carried out shall meet the requirements of the local authority having jurisdiction.	Charlotte, North Carolina 28217 (p) 704-357-9333 (f) 704-357-9385 © This drawing is copyrighted. It may not
b. Article 240.21 — Equipment complying with tap conductor rules c. [Only applies to NEC 2014]Article 700.8 — Required SPD for Emergency Systems	5. Indicator LED light display for power and protection status. Lights indicating only internal component failure while continuing to allow the main power flow are NOT acceptable.	PART 2 - PRODUCTS	J. The system shall have proper listing and/or approval from the following nationally recognized agencies:	be reproduced nor used in any other form or on any other project. BWA JOB # 2022-0632
1.4 SUBMITTALS	6. Form—C contacts, one normally open and one normally closed, for remote monitoring of protection status. Contacts shall reverse on failure of any surge diversion module or on opening of any	2.1 MOTOR STARTERS		
A. For each different model of device to be used, submit the following:	current—limiting device. [Coordinate connection requirements with building power monitoring and control system.]	A. Starters for motors 1/3 horsepower or smaller shall be manual unless remote or automatic starting is required, in which case the starters shall be magnetic, full voltage, non—reversing,	 Factory Mutual Systems Underwriters Laboratories 	
1. Dimensional drawings and installation instructions for the specified parallel connected unit.	7. Compression lugs that can accept up to #2 AWG wire,	single—speed, unless otherwise indicated. All other starters shall be magnetic. B. Each starter for a three—phase motor shall be furnished with three (3) overload relays sized for	1.2 SCOPE	
2. The rated capacities, operational characteristics, electrical characteristics, and all furnished accessories and options.	8. A low impedance cabling system shall be provided with unit, thereby improving the connection of	the full load running current of the motor actually provided. Provide an external "HAND—OFF—AUTO" selector switch with green "RUNNING" light. Provide a red pilot light to indicate motor "STOPPED".	A. A new intelligent reporting, microprocessor controlled fire detection system shall be installed in accordance to the project specifications and drawings.	
3. Copy of the UL Category Code certification, listing the tested values for VPRs, I/nominal ratings, MCOVs, type designations, any OPCD requirements, model numbers, system voltage, and modes of protection	the SPD to the electrical system. Cabling system shall utilize a minimum wire size of #6 AWG. C. Unit shall have a maximum attenuation of 34dB based on 50 ohm insertion loss test per	Each pilot light shall have a legend plate indicating reason for signal. C. Each overload relay shall have a normally open alarm contact which will close only when actuated	B. Basic Performance	E THE THE CANON THE PROPERTY OF THE PROPERTY O
1.5 WARRANTY	MIL-STD-220B.	by an overload (not to be confused with N.O. or N.C. auxiliary contacts). These contacts shall be properly wired to their respective blue pilot light provided on the starter front cover and having a "TRIPPED" legend plate.	1. Each SLC loop shall be wired NFPA 72 Class B, Survivability Level 1.	
A. Manufacturer's Warranty: Manufacturer agrees to replace or replace SPDs that fail in materials or	D. Unit shall have a minimum single—phase pulse surge current rating of [50 or 100] kA per mode. The peak surge current rating shall not be the arithmetic sum of the ratings of the individual MOVs in a given mode. Manufacturer shall provide independent 3rd/ party testing, validating that unit is capable	D. Individually mounted motor starters shall be in a NEMA Type 1 general purpose enclosure in	2. Initiation Device Circuits (IDC) shall be wired NFPA Class B, Survivability Level 1 as part of an addressable device connected by the SLC circuit.	COTT LOW,
workmanship within specified warranty period of each Type of device. 1. Warranty period for all Type 1 SPDs shall be twenty (20) years.	of surviving a single surge at the specified rating.	unfinished areas and shall be flush mounted in all finished areas. All starters mounted in exterior areas shall have a NEMA 3R enclosure. Each starter shall have a laminated nameplate to indicate Division 23 unit number, function and circuit number.	3. Notification Appliance Circuits (NAC) shall be wired NFPA Class B, Survivability Level 1 as part of an addressable device connected by the SLC circuit or a panel circuit.	SEAL 05/24/23
2. Warranty period for all Type 2 SPDs shall be fifteen (15) years.	E. Protection modes and UL 1449 VPR for grounded wye circuits with [480Y/277 V] [208Y/120 V], three—phase, four—wire circuits shall not exceed the following:	E. A control power transformer shall be provided at each motor starter for connection to the controls provided under Division 23. The control power transformer shall be mounted inside the motor starter	4. NAC speaker circuits shall be arranged such that there is a minimum of one speaker circuit per	DUNN OPERATIONS
1.6 MANUFACTURERS	 Line to Neutral: [1200 V for 480Y/277 V] [700 V for 208Y/120 V] Line to Ground: [1200 V for 480Y/277 V] [700 V for 208Y/120 V] 	enclosure. All control transformers at 50 VA or greater shall have primary fusing. Coordinate all control equipments with Division 23 and equipment manufacturers.	floor of the building or smoke zone, which ever is greater. 5. NAC speaker circuits and control equipment shall be arranged such that loss of any one (1)	CENTER
A. The surge protection system shall be manufactured by Current Technology.	3. Neutral to Ground: [1000 V for 480Y/277 V] [700 V for 208Y/120 V] 4. Line to Line: [2000 V for 480Y/277 V] [1200 V for 208Y/120 V]	F. All motor starters, push buttons and pilot lights shall be of the same manufacturer as the switchboard and shall be General Electric, Square D, Siemens, Joslyn Clark Controls, or Eaton.	speaker circuit will not cause the loss of any other speaker circuit in the system.	1269 JONESBORO RD.
B. The specific series of surge protection device shall be as defined by the application or as defined on the drawing.	F. Protection modes and UL 1449 VPR for 240/120 V, single—phase, three—wire circuits shall not exceed the following:	2.2 COMBINATION STARTERS	C. Basic System Functional Operation1. As part of the fire alarm; when a fire alarm condition is detected and reported by one of the	D HARNETT COUNTY, NC 28334
PART 2 — PRODUCTS	1. Line to Neutral: 700V	A. Combination starters shall consist of a circuit breaker and a motor starter mounted in a common NEMA Type 1 general purpose enclosure.	system initiating devices, the following functions shall immediately occur:	OPERATIONS BUILDING
2.1 GENERAL A. All units shall be listed and labeled as defined in NFPA 70, by a qualified testing agency, and	 Line to Ground: 700 V Neutral to Ground: 700V 	B. The motor starter components shall be as specified in paragraph 2.01 for motor starters.	a. FACP will sound and display the alarm condition showing the device address, location, zone information, time/date, and device type.	BUILDING
marked for intended location and application.	4. Line to Line: 1200V G. Unit shall have a short-circuit current rating of 200 kA.	C. The circuit breaker component shall be a minimum 22,000 amperes RMS interrupting capacity and shall be as required in Section 26 20 00.	b. The remote annunciator will sound and display the same information as shown on the FACP display unit.	
B. The MCOV of the SPD shall be the nominal voltage of the system to which it is connected. The MCOV of the device shall be a tested value per section 37.7.3 of UL 1449.	H. Unit shall have an I/nominal rating of 20 kA.	2.3 MOTOR CONTROL CENTER	c. Via system programming, the horn/bell outputs for all zones will activate and sound in temporal 3—3 pattern in synchronized fashion until silenced from FACP panel.	
2.2 SERVICE ENTRANCE [AND TRANSFER SWITCH] SURGE PROTECTION	I. The basis of design for this unit is the Currentguard series.	A. The Motor Control Center shall consist of a combination starter for each motor, plus other associated equipment. Combination starters shall be plug—in circuit breaker or switch and fuse type, as	d. All strobes on floors with activated horn/bell outputs shall flash in a synchronized pattern per	TRUCTIC
A. Unit shall be listed as a Type I surge protection device per UL 1449, 3rd/ edition.	2.4 PHYSICAL REQUIREMENTS	scheduled, with voidable cover interlock, provision for padlocking the cover closed and provision for padlocking the operating handle in either the open or closed position. Switches shall be quick—make, quick—break type of quantity, size and poles as scheduled. All switches shall be rated at 600 volts, fused as scheduled. Circuit breakers shall have the interrupting capacity scheduled with 22,000	floor until silenced from the FACP panel. e. Automatic functions including, but not limited to: elevator(s) recall, smoke evacuation, smoke door	CONST
B. Unit shall have the following features: 1. It shall consist of parallel connections only. Series elements shall not be used.	A. Interior installations shall have a NEMA 250, Type 1 enclosure.	amperes RMS minimum.	release and supply/return fan shutdown shall be activated via system programming as directed by codes and/or drawings.	
2. Integral disconnect switch — unit shall not require disconnection of power to customer equipment	B. Exterior installations shall have a NEMA 250, Type 4X enclosure.	B. Motor starters shall be mounted in individual steel compartment immediately below the breaker or the switch and fuse associated with it. A mechanical interlock shall prevent opening the starter compartment door unless the device is in the off position.	f. Release all magnetically held smoke doors.	
for testing and/or maintenance.	2.5 ENVIRONMENTAL REQUIREMENTS	C. Each section in the Motor Control Center shall include an individual 480/120 volt control circuit transformer, with fused secondary.	g. Provide signals to the mechanical controls including smoke dampers to shut down or reroute air—handling systems to prevent the recirculation of smoke.	DRN BY
 The primary suppression path shall not be to ground. The unit shall not short or crowbar the power flow resulting in an interruption to the load. 	A. The unit shall not add appreciably to air conditioning load. Heat load shall not exceed 0.2 kVA (0.682 BTU/hr.).B. Average power consumption shall be less than 0.2 kVA. Average power factor inefficiencies or	D. Provide a control terminal strip in the Motor Control Center. The control wiring from these	h. Provide a DACT (Digital Alarm Communicator Transmitter) and a signal via DACT for connection to a central station or local municipal fire department (connection and leased line, if required, shall be	H H 23
5. Internal thermal protection that disconnects the unit before damaging internal suppressor	harmonic distortion shall not result from use (THD — 0%).	terminal strips, external to the Motor Control Center, to the respective control device, shall be included in Division 23.	a central station or local municipal tire department (connection and leased line, it required, shall be provided by building owner).	\\\\\\\\\\\\\\\\\\\\\\\\\\\\\\\\\\\\
components. 6. Indicator LED light display for power and protection status. Lights indicating only internal	C. No audible noise shall be generated.D. No appreciable magnetic fields shall be generated. All units shall be capable of use in any	E. All circuit breakers, motor starters, push buttons and pilot lights shall be of the same manufacturer as the main switchboard.	i. Initiate a preprogrammed timing sequence.	PROJECT NO:
component failure while continuing to allow the main power flow are NOT acceptable.	location (in a computer room) without danger to disc units, disc packs or tapes.	F. Each starter shall have a laminated nameplate engraved to indicate Division 23 unit number, function and Motor Control Center circuit number.	j. Additionally, actuation of a lobby elevator smoke detector shall cause immediate non—stop return of all automatic elevators served by that lobby to the primary discharge level; except that, when the alarm has been initiated on the primary discharge level, the elevators, shall be returned to the designated alternate discharge level per the requirements of ANSI ASME A17.1.	B DRAWING NUMBER
7. Form—C contacts, one normally open and one normally closed, for remote monitoring of protection status. Contacts shall reverse on failure of any surge diversion module or on opening of any current—limiting device. [Coordinate connection requirements with building power monitoring and control	 E. Operating Conditions: 140 - 185 degrees F 	G. The Motor Control Center shall be General Electric, Square D, Siemens, or Eaton.	k. Additionally, actuation of any elevator equipment room or shaft smoke detector shall cause	CFD-XXX-E-006-XXXXX ELECTRONIC FILE NAME:
system.] 8. Compression lugs that can accept up to #2 AWG wire.	140 - 185 degrees F 2. 5% - 95% humidity non-condensing	PART 3 — EXECUTION	immediate non—stop return of all automatic elevators served by that equipment room or shaft, to the primary discharge level per the requirements of ANSI ASME A17.1. Provide all required signals from FACP to elevator controls for smoke detector in elevator machine room per the requirements of ANSI ASME	DRAWN BY: JFE
9. A low impedance cabling system shall be provided with unit, thereby improving the connection of	PART 3 — EXECUTION	3.1 INSTALLATION	A17.1 I. Additionally, actuation of any smoke detector located in the air handling units and/or equipment	CHK'D BY: JSL DATE:
the SPD to the electrical system. Cabling system shall utilize a minimum wire size of #6 AWG.	3.1 INSTALLATION	A. Provide power wiring to and install all motor starters, unless integrally factory mounted on a piece of equipment.	rooms shall activate signals to the mechanical controls indicating the floor of occurrence.	E-MAIL: SLOWERY@BARRETTWOODYARD.COM THIS DESIGN DRAWING IS THE EXCLUSIVE PROPERTY OF DUKE ENERCY CORPORATION AND IS CONSIDERED CONFIDENTIAL IT SHALL
C. Unit shall have a maximum attenuation of 54dB based on 50 ohm insertion loss test per MIL—STD—220B.	A. The unit must be installed in accordance with the manufacturer's printed instruction to maintain warranty. All local and national codes must be observed.	B. Provide power wiring to all motors except packaged units that are prewired between the starter and motor.	m. It shall be possible to silence the alarm signals by operating the signal silence switch. However, the activation of another zone shall repeat the entire alarm process, thus causing the signals to resound.	THIS DESIGN DRAWING IS THE EXCLUSIVE PROPERTY OF DUKE ENERGY CORPORATION AND IS CONSIDERED CONFIDENTIAL. IT SHALL NOT BE MODIFIED, COPIED, OR DISTRIBUTED WITHOUT PRIOR APPROVAL. THIS INFORMATION SHOULD ONLY BE USED FOR THE SPECIFIC PROJECT INTENDED. SHEET TITLE:
D. Unit shall have a minimum single—phase pulse surge current rating of [150 or 200] kA per mode. The peak surge current rating shall not be the arithmetic sum of the ratings of the individual MOVs in a given mode. Manufacturer shall provide independent 3rd/ party testing, validating that unit is capable	B. For service entrance units, wiring harness shall be connected to the line side bussing of the service entrance electrical equipment as shown on the drawings.	C. Where line voltage control devices are mounted at, on or inside a unit, such as aqua—stats, fire—stat for single phase devices, etc., the power wiring to the unit shall be connected through such a	n. Silencing the alarm shall cause all speakers to silence. Firelights will continue to flash.	SPECIFICATIONS
A of surviving a single surge at the specified rating.	C. For distribution panelboard units, install OCPD as required to comply with the UL listing of the	control device.	o. Fire pump (if applicable) normal power availability, fire pump phase reversal and fire pump run status shall be monitored. Loss of normal power, phase reversal shall annunciate as supervisory alarms	A - ELECTRICAL
E. Protection modes and UL 1449 VPR for grounded wye circuits with [480Y/277 V] [208Y/120 V], three-phase, four-wire circuits shall not exceed the following:	SPD.	D. On final inspection, it shall be demonstrated to the Architect or his representative, that each overload relay control circuit is properly wired and functioning correctly by manually tripping each overload relay individually, one at a time. This inspection procedure shall not involve removing any wiring or disconnecting any current carrying parts	and pump running shall annunciate as an alarm.	SHEET NO.
1. Line to Neutral: [1200 V for 480Y/277 V] [700 V for 208Y/120 V] 2. Line to Ground: [1200 V for 480Y/277 V] [700 V for 208Y/120 V]	D. Install SPDs with cabling system between suppressor and points of attachment as short and straight as possible. In panelboard applications, adjust circuit—breaker positions to achieve shortest and straightest leads. Do not splice and extend SPD leads. Do not exceed manufacturer's recommended	wiring or disconnecting any current carrying parts.	p. Provide a signal to activate the elevator shunt trip breaker upon activation of the heat detector(s) in the elevator shaft or elevator machine rooms.	E-006
1	3	5	7 8	9
	4		, O	

1 2	3 4	5 6	7 8 9	
2. General Operation	B. Wiring shall be in accordance with local, state and National codes (e.g., NEC Article 760) and as	2. Horns in corridors and all public spaces shall produce a nominal sound output of 15 dBA above average ambient noise levels with a minimum sound output of 15 dBA.	Detector shall have a dual purpose red LED that flashes continuously to show that the device is operating and, that comes on steady to show that the device is in alarm.	CFD-XXX-E-007-XXXXX
 a. Power failures, opens, grounds or any disarrangement of the system wiring or components shall be indicated by a visual and audible trouble signal. The audible trouble signal may be silenced, however, the trouble LED shall remain lit until the system has been returned to normal operating condition. 1.3 SUBMITTALS 	recommended by the manufacturer of the fire alarm system. C. All wire and cable shall be listed and/or approved by a recognized testing agency for use with a protective signaling system.	3. Horns shall be UL—464 listed for fire evacuation and operate on 12 or 24 voltage in a temporal 3—3 pattern.	3. Nominal detector sensitivity shall be 1.4% per foot obscuration with a range of 1% to 1.84%. Regardless of sensitivity settings, the detector's stability shall be unaffected by high air velocity. No radioactive materials shall be used.	DUKE
H A. General	D. The fire alarm control panel shall be connected to a separate dedicated branch circuit, maximum 20 amperes from the 120 volt normal power source or from a generator powered source if available.	 The back of each speaker shall be sealed to protect the speaker cone from damage and dust. Speakers shall be bone white in color. 	4. Provide smoke detectors in elevator lobbies, at stairwell doors, in telephone rooms, electrical rooms, mechanical rooms, elevator pits, the top of the elevator shaft, adjacent to the fire alarm control panel, fire pump room, computer rooms as defined by NFPA 90, chiller plants, pump rooms, UPS rooms	H ENERGY®
 Copies of all submittals shall be submitted to the Architect/Engineer for review prior to acceptance of system. 	E. All junction boxes and conduit utilized for fire alarm system cabling shall be painted red.	6. Provide a unit cost to add 2 speakers per 25,000 sq.ft. This unit cost shall be applied to additional speakers that may be required at the request of the Fire Marshal during field inspections.	and elevator machine rooms. C. Linear Beam Smoke Detector	MAILING ADDRESS: P.O. BOX 1007
2. All references to manufacturer's model numbers and other pertinent information herein is intended to establish minimum standards of performance, function and quality.	F. All circuit breakers serving the fire alarm system shall include red marking and a listed locking mechanism per NFPA 72.	B. Strobe Lights	 Each beam shall be comprised of a solid state infrared (IR) transmitter, photodiode receiver and microprocessor based control module. Should IR output be attenuated below the desired alarm 	CHARLOTTE, NC 28201
3. The authority having jurisdiction shall be notified prior to installation of equipment and wiring. Complete information regarding the system including specifications, wiring diagrams, battery and power supply calculations, floor plans and graphics shall be submitted for approval.	2.2 MAIN FIRE ALARM CONTROL PANEL:A. The FACP shall be completely microprocessor based.	 All strobe lights shall meet the requirements of the ADA, UL Standard 1971. Strobe intensity and flash rate shall meet the requirements of UL 1971, ADA and NFPA 72. 	obscuration level as a result of smoke interference an alarm will be annunciated. Total obscuration of the beam is annunciated as a beam blockage trouble signal. All wiring from the control module to the transmitter and receiver heads is supervised.	Safety Expectations:
4. If submittals, upon review by the Owner and/or the Owners Representative, are found not to conform with the performance, type and quality of products as well as all other requirements of these specifications; the Contractor shall be required to resubmit. The Contractor shall be responsible for the	B. System Capacity and General Operation:	3. Combination horn/strobe devices shall meet all above requirements as well as horn/bell requirements listed herein.	2. The projected beam smoke detector system shall have an operating range of 10M. (33 ft.) to 100M. (330 ft.) and be listed for spacing the beam 30 ft. from a wall and 60 ft. on center. The transmitter and receiver optical elements shall be adjustable +/- 90 degrees horizontally and +/- 30 degrees vertically. The sensitivity shall be field selectable from 7% to 50% obscuration.	Reduce Risk Remove Exposures to Hazards Reinforce Safe Behavior
Owner's extra expenses for subsequent review(s) of rejected submittals. Such extra fees shall be deducted from payments by the Owner to the Contractor. Approval of the submittals by the Owner shall, in no case, relieve the Contractor of the responsibility to meet the requirements of this specification.	 Configure size of panel to operate number of SLC circuits in a fashion so that each circuit handles no greater than 70% load of capacity or a maximum of 5 floors per circuit. The fire alarm control panel shall include a full—featured operator interface and backlit 	4. Strobe unit shall mount to a four inch square electrical outlet box. The strobe light shall have a white lens with red "FIRE" imprinted on it. When the unit is combination speaker/strobe, the speaker portion shall comply with the requirements stated in A. above.	D. Intelligent Thermal Detectors	G Reinforce Safe Behavior
B. Shop Drawings	80-character Liquid Crystal Display (LCD). 3. The system shall be fully field programmable from the display panel. Panels requiring the use of	5. All strobes shall have selectable output intensities from 15 to 110 cd. The intensity selected shall meet NFPA 72 requirements for the layout shown on the drawings.	 Thermal detectors shall be intelligent addressable devices rated at 135 degrees Fahrenheit (58 degrees Celsius) and have a rate—of—rise element rated at 15 degrees F (9.4 degrees C) per minute. It shall connect via two wires to the fire alarm control panel signaling line circuit. 	
 Drawings shall include the following minimum requirements for submittal: a. Point—to—point wiring/conduit layout for all devices on 1/8" scale plans. 	external keyboards for programming and changes are not acceptable. 4. The FACP shall provide the minimum following features:	6. Strobe spacing shall be as follows:	E. Addressable Dry Contact Monitor Module	
b. Device placement showing all addresses and device ID.	a. Drift compensation to extend detector accuracy over life.	a. Strobes shall be spaced a maximum of 100' apart in corridors and within 15' of the end of every corridor to comply with the	1. Addressable monitor modules shall be provided to connect one supervised IDC zone of conventional alarm initiating devices (any N.O. dry contact device such as flow, tamper, release systems, etc.) to one of the fire alarm control panel SLCs.	
c. All panel and equipment terminations.	b. Detector sensitivity test, per NFPA 72, Chapter 7.	requirements of NFPA 72. b. Strobes in open areas shall be provided to comply with NFPA 72.	2. The IDC zone shall be suitable for Survivability Level 1 operation. An LED shall be provided that shall flash under normal conditions, indicating that the monitor module is operational and in regular	
 d. All circuit voltage drop and current calculations spread sheets. e. All battery calculation spreadsheets. 	c. Maintenance alert, to warn of excessive smoke detector dirt or dust accumulation.	c. Provide strobes in public spaces such as restrooms, kitchens, breakrooms, cafeterias, conference rooms, training rooms and any other space where six or more people are likely to gather.	communication with the control panel.	BW &A Barrett, Woodyard and Associates, Inc. License # C-2226
f. Legend reflecting device description, manufacturer, model number, and back—box requirement.	d. Multiple sensitivity levels for alarm, selected by detector.e. System status reports to display and printer. Provide printer.	7. Provide a unit cost to add 5 strobes including required signal circuits per 25,000 sq.ft. This unit cost shall be applied to additional strobes that may be required at the request of the fire marshal	3. For difficult to reach areas, the monitor module shall be available in a miniature package and shall be no larger than 2-3/4 inch (70 mm) x 1-1/4 inch (31.7 mm) x 1/2 inch (12.7 mm). This version need not include an LED.	F 420 Minuet LN. Charlotte, North Carolina 28217 (p) 704-357-9333 (f) 704-357-9385
g. Wiring legend reflecting wire function, type, and recommended manufacturer's part number. h. Full sequence of operations.	f. Alarm verification, with verification counters.	during field inspections. C. Manual Fire Alarm Stations	4. Monitor module shall be provided for all sprinkler flow and tamper switches. Switches are furnished and installed by others and electrically connected to the fire alarm system by the electrical contractor. Verify quantities and locations and coordinate installation of devices required with fire protection shop	© This drawing is copyrighted. It may not be reproduced nor used in any other form or on any other project.
i. Power supply and amplifier calculations.	g. Cross zoning with the capability of counting two detectors in alarm.	1. Manual fire alarm stations shall be dual—action, non—coded, non—break glass type, equipped with	drawings. Provide connections to devices per fire protection shop drawings.	BWA JOB # 2022-0632
2. Specification data sheets on each individual system component.	h. Walk test. i. UL—1076 security monitor points.	key lock so that they may be tested without operating the handle. 2. Stations must be designed such that after an actual activation, they cannot be restored to normal	F. Addressable Control Module: 1. Addressable control modules shall be provided to supervise and control the operation of one	
C. Data Sheets 1. Submit simultaneously with the shop drawings, complete manufacturer's technical data sheets	j. Control—by—time with holiday schedules.	except by key reset. Units shall be master keyed with control equipment. 3. An operated station shall automatically condition itself so as to be visually detected, as operated,	conventional NACs of compatible, 24 VDC powered, polarized audio/visual notification appliances. For fan shutdown and other auxiliary control functions, the control module may be set to operate as a dry contract relay. Each relay shall have a red LED mounted on its cover to indicate if that relay has been activated.	
showing product description, listings, and specs. 2. Copies of NICET II and IV certifications.	k. Day/night automatic adjustment of detector sensitivity.	at a minimum distance of 100 feet (30.5 m) front or side. This shall be achieved with the pull lever remaining at a right angle to the station body until reset.	2. The control module NAC may be wired for Class (A/B) Survivability Level 1 with up to 1 amp of inductive A/V signal, or 2 amps of resistive A/V signal operation, or as a dry contact (Form—C) relay.	
E 3. Copy of company UL listing certificate.	I. Device blink control for sleeping areas.m. Releasing capability.	 The station body shall be constructed so that chips and scratches will not expose metal. Manual fire alarm stations shall be located as required by NFPA 101 and the International Building 	The relay coil shall be magnetically latched to reduce wiring connection requirements, and to ensure that 100% of all auxiliary relay or NACs may be energized at the same time on the same pair of wires.	E CAROLINIA CAROLINIA
1.4 APPLICABLE STANDARDS AND SPECIFICATIONS:	n. Pre-Alarm.	Code. D. Duct Smoke Detectors	G. Door Holders	WGINE CO.
A. The specifications and standards listed below form a part of this specification. The system shall comply with the latest standards.	o. Selectable sensitivity levels, three minimum.	1. Duct smoke detectors shall be addressable type with visual alarm and power indicators. Provide	 Provide door holders for wall mounting and for floor mounting. Door holders shall operate on 24 volt dc power and each holder shall not draw more than 70 milliamps of power. 	SEAL 05/24/23
1. National Fire Protection Association (NFPA), 2000 Edition — USA:	p. History Storage, with a minimum of 400 events. g. Point Enable/Disable.	remote LED/test stations where duct detectors are mounted in non-visible areas such as above ceiling. 2. Each detector shall be installed upon the composite supply/return air ducts(s), with properly sized	2. Coordinate quantities of door holders required with architect's door schedule.	DUNN OPERATIONS
No. 13 Sprinkler Systems No. 13A Halon 1301 Extinguishing Systems No. 17 Dry Chemical Extinguishing Systems	r. Point Read (status and level of obscuration).	air sampling tubes where required. Provide smoke detectors in each return air path of any mechanical equipment that moves air in excess of 2000 CFM to meet the requirements of NFPA 72 and 90A. Provide smoke detectors in each supply and return air path of any mechanical equipment that moves air in excess of 15,000 CFM to meet the requirements of NFPA 72 and 90A. Confirm quantities of	2.5 BATTERIES A. The batteries shall be sealed, 12 volt nominal (two required).	CENTER
No. 17A Wet Chemical Extinguishing Systems Clean Agent Extinguishing Systems	s. Output point for connection to any building EMS. C. Signaling Line Circuits (SLC)	smoke detectors required for mechanical equipment with Division 23. Room detectors may be used to accomplish smoke detection in the supply/return air paths if the application permits.	B. The battery shall have sufficient capacity to power the fire alarm system for the time required in NFPA 72. This time shall be based on the type of system installed. At the end of this period the	1269 JONESBORO RD. HARNETT COUNTY, NC 28334
Specifically Article 760 No. 72 National Fire Alarm Code	1. Each SLC interface shall provide power to communicate with 99 intelligent detectors (ionization,	3. Each duct detector shall be installed along with addressable control module as needed for fan shutdown and/or smoke control. Detectors zoned with other devices shall be capable of operating its control module even if all other devices on their circuit have gone into alarm.	system shall be capable of operating all alarm notification appliances used for evacuation or to direct aid to the location of an emergency for 5 minutes upon a normal AC power failure.	OPERATIONS
No. 101 Life Safety Code 2. International Building Code	photoelectric or thermal) and 99 intelligent modules (monitor or control). 2. Each SLC circuit shall not exceed 70%, load capacity or cover more than 5 floors.	4. Duct detectors shall be provided by this division, installed by the mechanical contractor and electrically connected to the fire alarm system by the electrical contractor.	2.6 ELEVATOR VISUAL SIGNAL (NC & FLA)	BUILDING
3. American National Standard A17.1—1980	D. Serial Interface	E. Smoke Dampers	A. Provide 1/8" diameter minimum red LED mounted in a single gang polished stainless steel coverplate. Engrave nameplate "DO NOT USE ELEVATOR" with 1/8" high black filled letters. Coordinate installation of this device with the architect prior to rough—in to assure this component is integrated into the architecture of all elevator lobbies.	
4. Underwriter's Laboratories Fire Resistance Directory	1. The system shall include two serial EIA—232 interfaces. Each interface shall be a means of connecting UL Listed Electronic Data Processing (EDP) peripherals.	1. Smoke dampers shall be provided by Division 23.	B. Provide gasketed coverplate for elevator lobbies in parking decks and similar damp locations.	
5. Local and State Building Codes6. ADA Public Law 101—336	a. One serial port shall support a serial printer.	 Provide a smoke detector at each smoke damper location to meet the requirements of NFPA 72. Confirm quantities and locations of smoke detectors required for smoke dampers with Division 23. Provide 120 volt power as required for operation of smoke dampers. 	PART 3 — EXECUTION	SUCTION TO THE PART OF THE PAR
7. All requirements of the Authority Having Jurisdiction (AHJ)	b. One serial port shall support a CRT/NRT device.c. The system shall include an EIA—485 port for the serial. connection of annunciators and remote	F. LCD Alphanumeric Display Remote Annunciator	3.1 INSTALLATION A. Provide all equipment, wiring, conduit and outlet boxes required for the erection of a complete and	REVISION
1.5 APPROVALS	LCD displays. E. Field Charging Power Supply (FCPS): The FCPS is a device designed for use as either a remote	1. The alphanumeric display annunciator shall be a supervised, backlit LCD display containing a minimum of eighty, (80) characters for alarm annunciation in clear English text. Annunciator shall be located as shown on the drawings or at the location selected by the local fire department.	A. Provide all equipment, wiring, conduit and outlet boxes required for the erection of a complete and operating system in accordance with applicable local, state and national codes, the manufacturer's recommendations, these plans and specifications. Color code shall be used throughout.	ED FOR
A. The system shall have proper listing, approval and labeling from the following nationally recognized agencies:	24—volt power supply or used to power Notification Appliances. 1. The FCPS shall offer up to 6.0 amps (4.0 amps continuous) of regulated 24—volt power. It shall	2. The LCD annunciator shall display all alarm, supervisory, and trouble conditions from the FACP via the serial card.	3.2 TEST A. The manufacturer's authorized representative shall provide supervision of final system panel.	BY ISSUE
FM Factory Mutual Systems UL Underwriters Laboratories	include an integral charger designed to charge 7.0 amp hour batteries. Provide batteries to support 60—hour standby with ten minutes of alarm indication at the end of this period. Battery charger shall be capable of recharging all batteries to seventy percent capacity in twelve hours.	2.4 SYSTEM COMPONENTS - ADDRESSABLE DEVICES	A. The manufacturer's authorized representative shall provide supervision of final system panel connections, perform a complete functional test of the system and submit a written report to the contractor attesting to the proper operation of the system.	DRN
1.6 SYSTEM FEATURES A. The system shall include the following features as a minimum:	2. The Field Charging Power Supply shall have four outputs (Survivability Level 1) and shall be available for connection to the Notification devices.	A. Addressable Devices — General 1. Detectors shall be intelligent (analog) and addressable, and shall connect with two wires to the fire	3.3 FINAL INSPECTIONA. Upon completion of the installation, the electrical contractor shall provide to the architect, with a	C DATE 05.24.2
1. During an alarm condition, the LCD annunciator shall display the activated alarm until acknowledged. This shall allow determination of where the last alarm has taken place.	3. Provide 20—watt spare capacity in each electrical room on each floor for tenant audible circuits. Locate in a junction box clearly labeled "tenant fire alarm audible circuits".	2. Addressable photoelectric smoke and thermal detectors shall provide alarm and power/polling LEDs.	copy to the manufacturer's representative, a signed written statement attesting that all system equipment was installed in accordance with these specifications and in accordance with wiring diagrams, instructions and directions provided to the contractor by the manufacturer.	PROJECT NO:
B 2. Ground fault detection in wiring on either plus or minus side.	4. Provide 1ea. Field Charging Power Supply (DC) per floor to allow for tenant build—out expansion of NAC devices. At no time shall there exceed 70% load capacity of any FCPS on any of the common levels. Provide power capacity as follows:	LED(s) shall flash under normal conditions and LED(s) shall be placed into steady illumination by the control panel, indicating an alarm condition.	3.4 INSTRUCTION	B CFD-XXX-E-007-XXXXX
3. Separate alarm and trouble shall be displayed on the LCD annunciator.	Floor Size Capacity	 The fire alarm control panel shall permit detector sensitivity adjustment through field programming of the system. Detectors will operate in an analog fashion, where the detector simply measures its designed environment variable and transmits an analog value to the FACP based on real—time measured values. 	A. Instruction shall be provided as required for operating the system. Hands—on demonstrations of the operation of all system components shall be provided and shall include one session for a period of 8 hours. Additional time that may be required for end—user training will be at added cost to owner.	ELECTRONIC FILE NAME:
 Resound feature. Dead Front" design control panel with all LED alarm trouble and power on indicators and all 	<25,000 gross sq. ft. 6 amps DC 25,001 to 35,000 gross sq. ft. 10 amps DC 35,001 gross sq. ft. and greaterconsult engineer	environment variable and transmits an analog value to the FACP based on real—time measured values. The FACP software, not the detector, shall make the alarm/normal decision, thereby allowing the sensitivity of each detector to be set in the FACP program and allowing the system operator to view the current analog value of each detector.	3.5 GUARANTEE	DRAWN BY: JFE CHK'D BY: JSL DATE:
switches located behind a locked tempered glass door. 6. Solid state construction.	5. Locate audible (where required) and visual power supplies adjacent to one another and in a location within each room approved by the engineer.	5. All field wiring is to be terminated on the detector base, not on the sensor head. Addressing of detectors shall be via integral decade switches built into sensor. Devices requiring separate addressing	A. All equipment and wiring shall be guaranteed against defects in materials and workmanship for a two year period from the start up and beneficial use of the system. Warranty service for the equipment shall be provided by the manufacturer's factory trained representative during normal working hours, Monday through Friday excluding holidays. Emergency service provided at times other than as	E-MAIL: SLOWERY@BARRETTWOODYARD.COM
7. All alarm initiating circuit wiring, signal circuit wiring, speaker circuit wiring shall be supervised.	6. Provide battery capacity and amplifier capacity in the main fire control panel for addition of tenant devices described above.	means will not be accepted. 6. Any additional equipment required to program devices are not acceptable.	stipulated above shall be available from the same source at additional cost to the owner. 3.6 INSPECTIONS	THIS DESIGN DRAWING IS THE EXCLUSIVE PROPERTY OF DUKE ENERGY CORPORATION AND IS CONSIDERED CONFIDENTIAL. IT SHALL NOT BE MODIFIED, COPIED, OR DISTRIBUTED WITHOUT PRIOR APPROVAL. THIS INFORMATION SHOULD ONLY BE USED FOR THE SPECIFIC PROJECT INTENDED. SHEET TITLE:
8. Automatic transfer to standby batteries upon power failure.	F. Provide and install ceiling mounted smoke detector within 5 horizontal feet of FACP.	B. Intelligent Photoelectric Smoke Detector	A. Upon satisfactory completion of the system test, the manufacturer's representative shall present	SPECIFICATIONS
9. Lightning and surge protection. PART 2 - PRODUCTS	2.3 SYSTEM COMPONENTS	1. The detectors shall use the photoelectric (light—scattering) principal to measure smoke density and shall, on command from the control panel, send data to the panel representing the analog level of smoke density.	for the owner's consideration, a proposal to provide semi—annual inspection and tests of the system.	A - ELECTRICAL
2.1 CONDUIT AND WIRE	A. Horns/Bells1. All Horns/Bells shall be installed as shown on drawings and in accordance with NFPA 72 and local	2. Provide photoelectric smoke detector heads with bases as required. Detectors shall be of the solid state photoelectric type utilizing a stable LED light source and a silicone photo diode as the	END OF SECTION	SHEET NO.
A. All fire alarm wiring shall be installed in conduit. Conduit shall be installed as required by specification Section 26 10 00.	codes.	receiving element to form a highly accurate means of smoke detection. Internal detector circuits shall be shielded against electrical interference and resistant to transients, noise and, RF interference. Detector shall be low profile, the complete unit including base shall not exceed 1.875 inches in depth.		E-007
1 2	3 4	5	7 8 9	

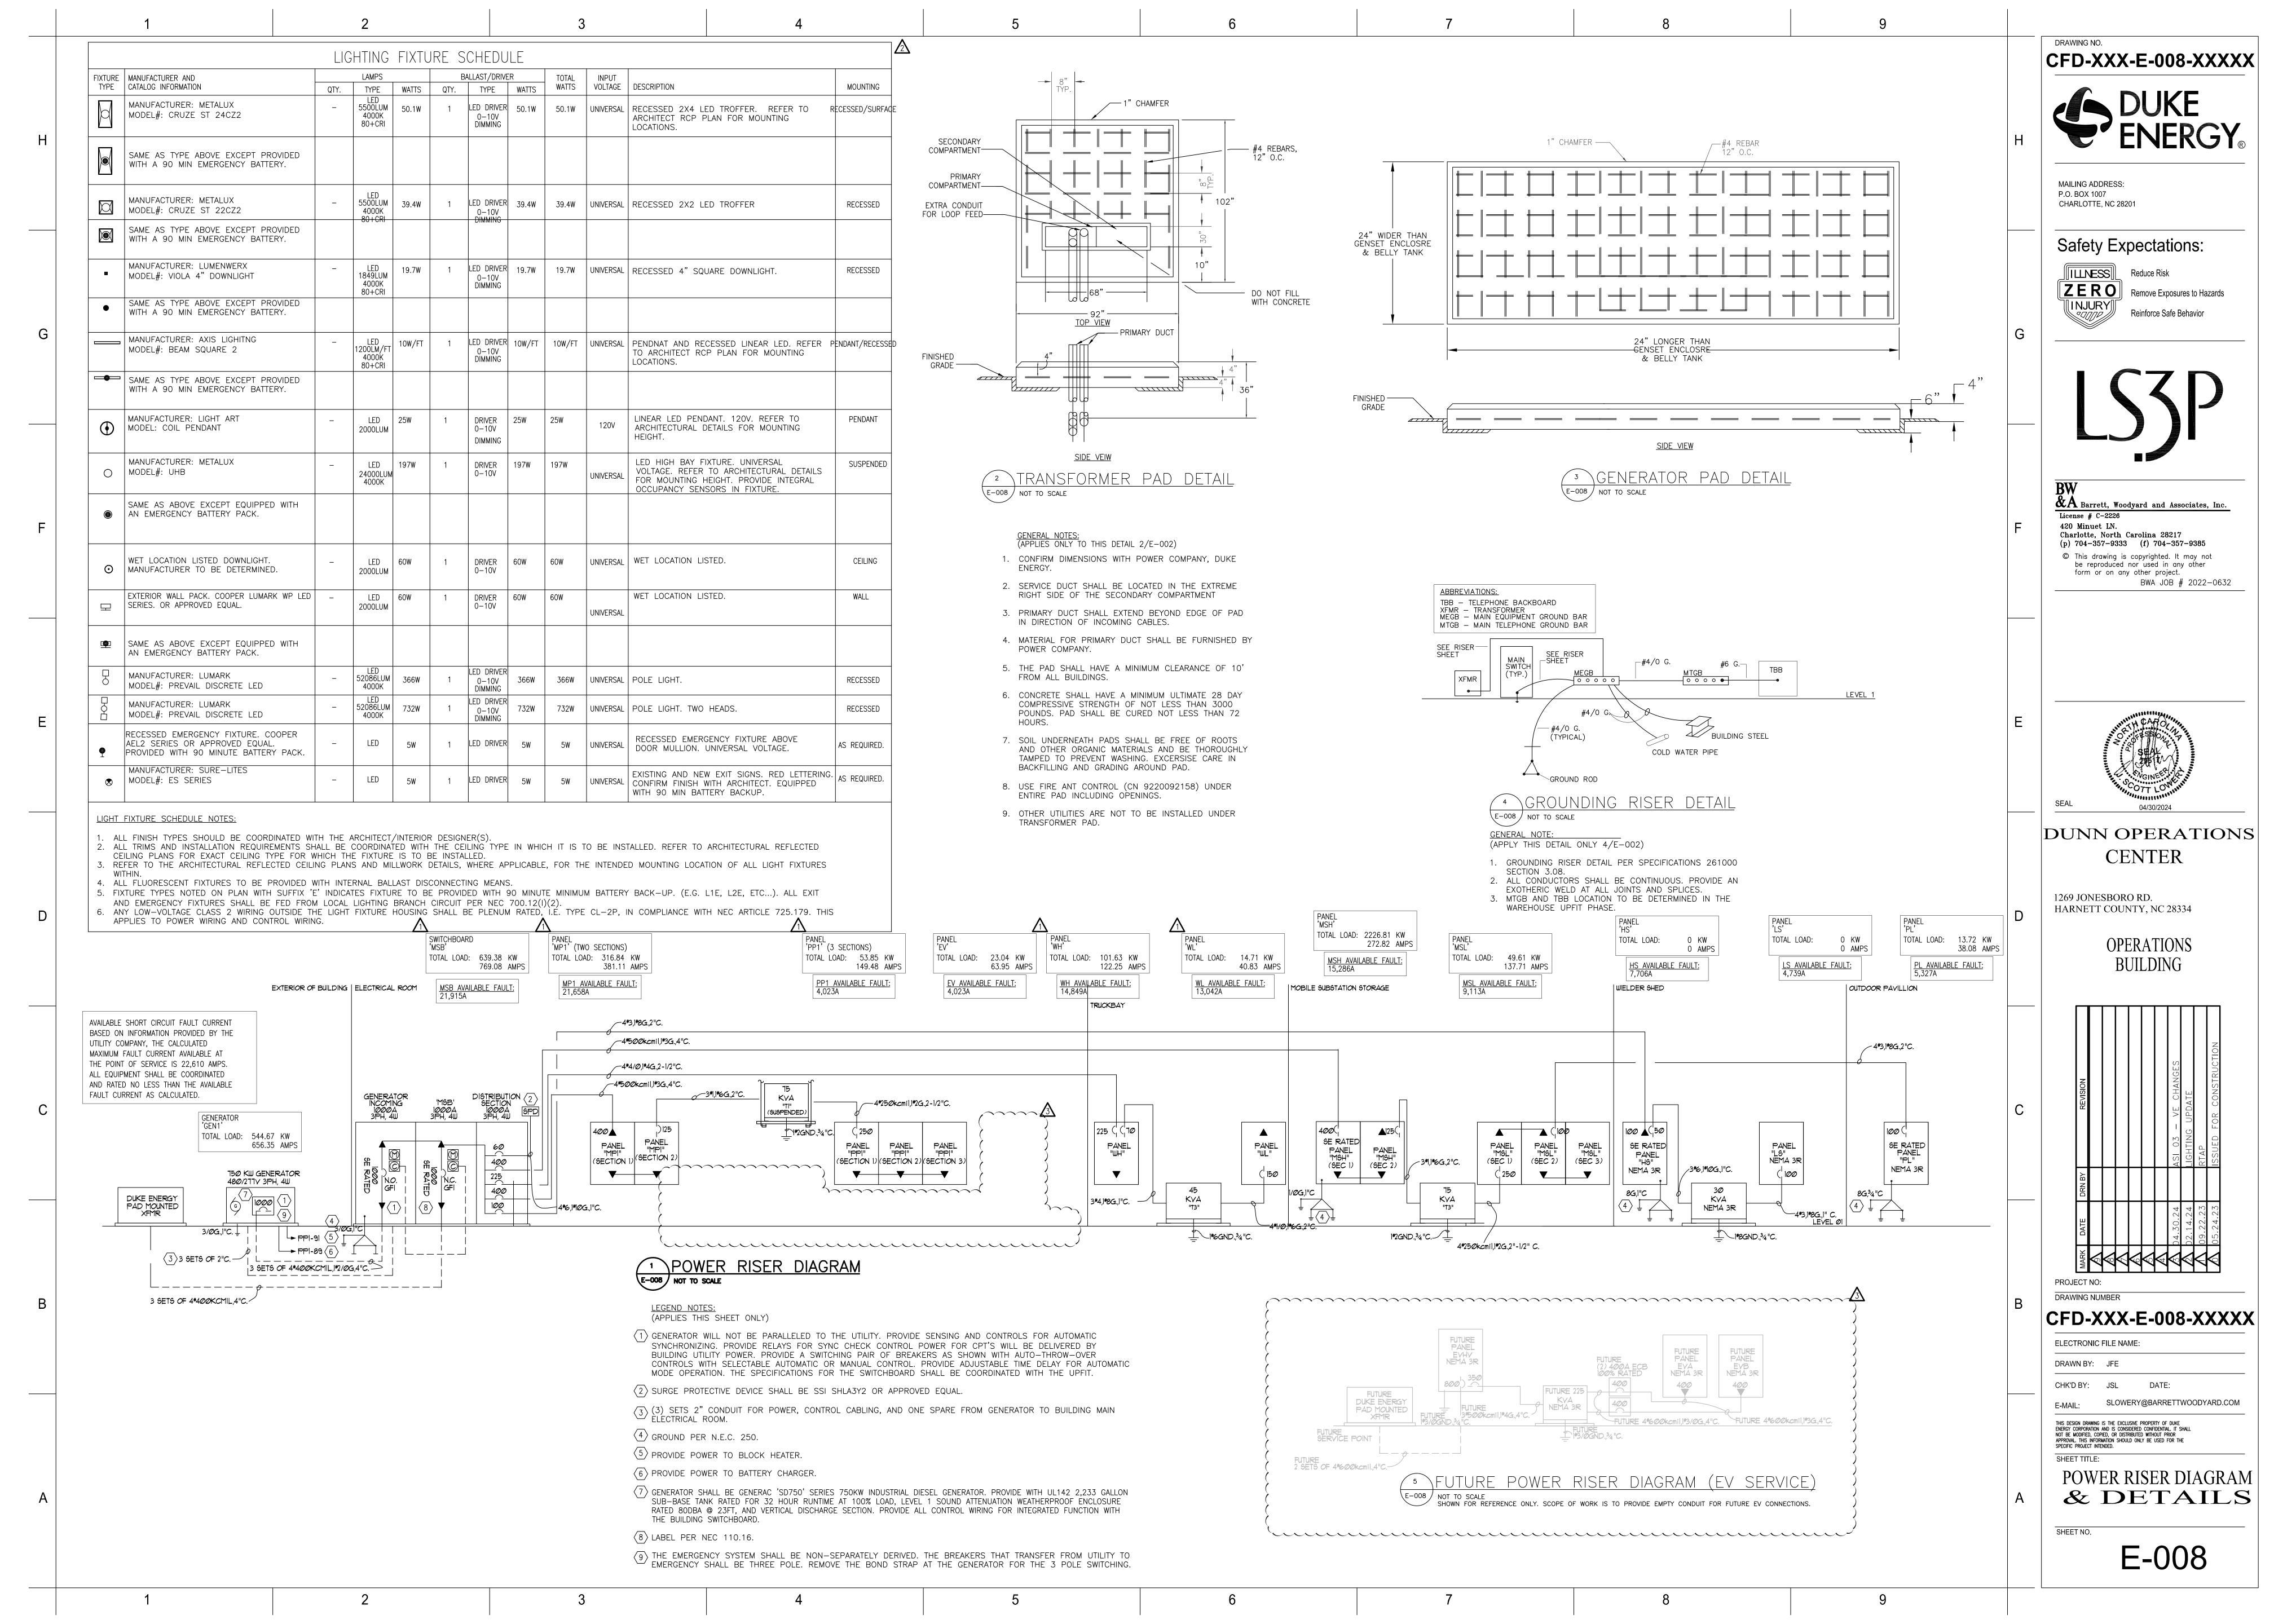


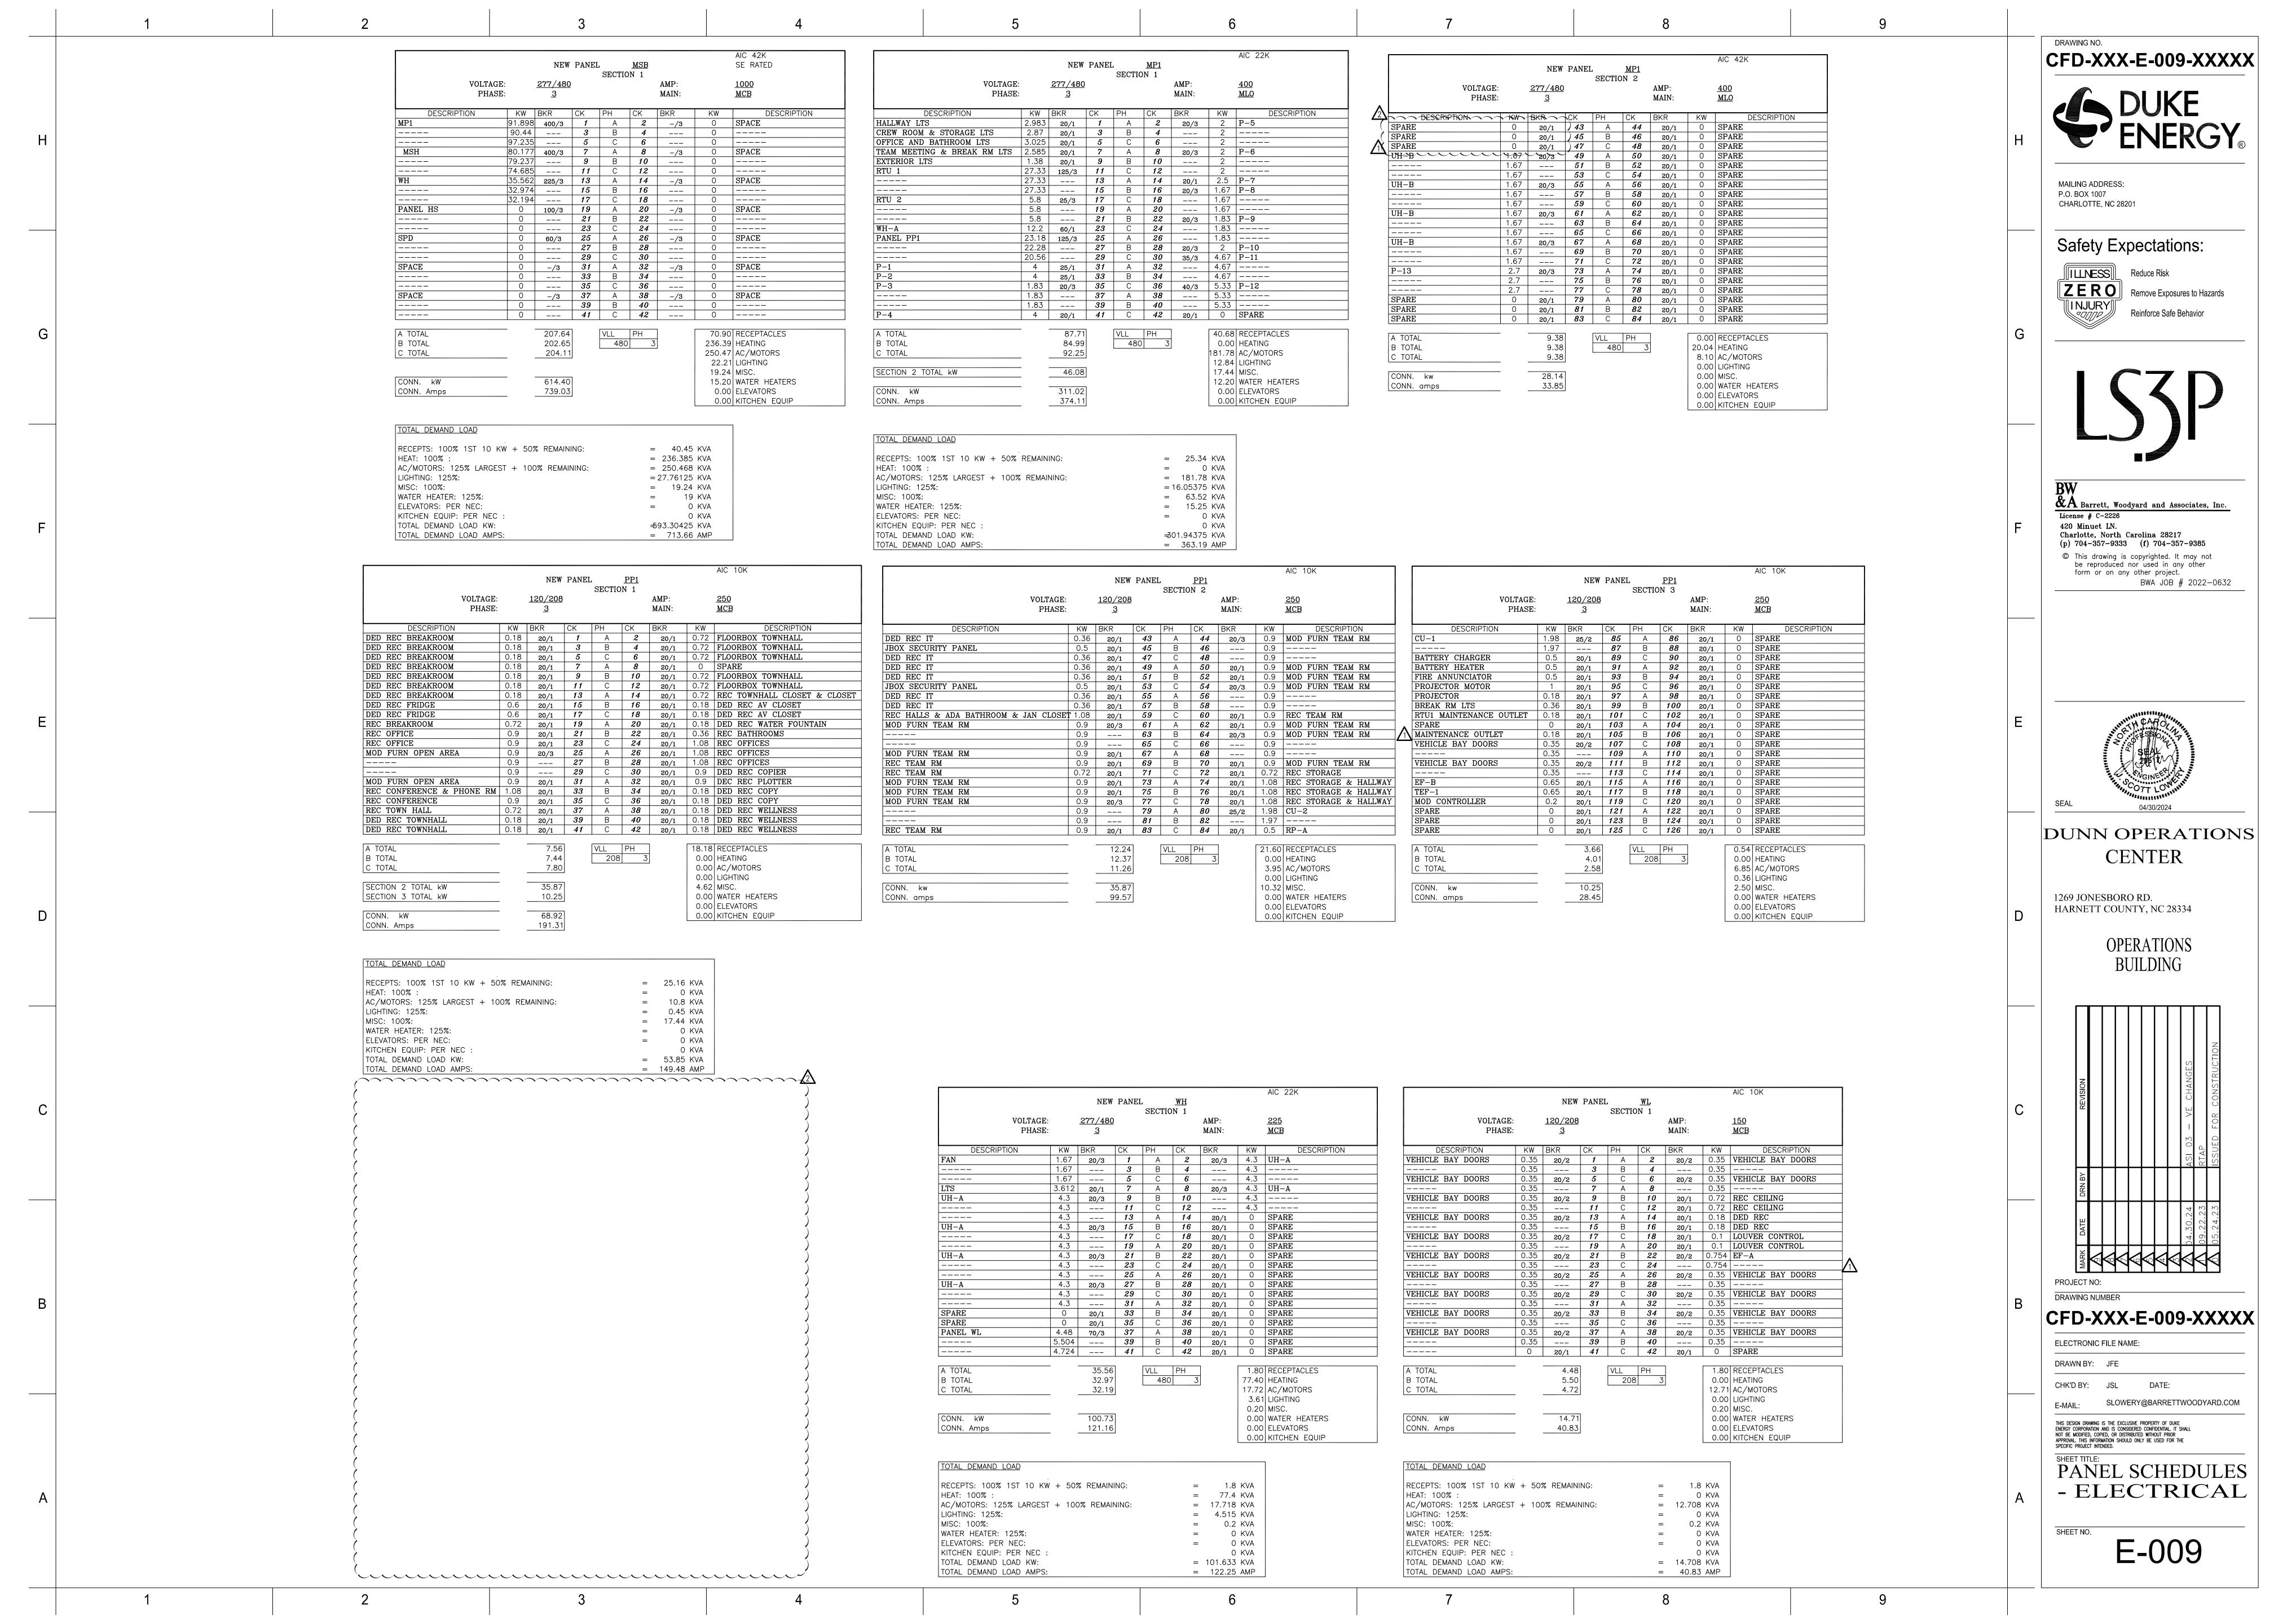


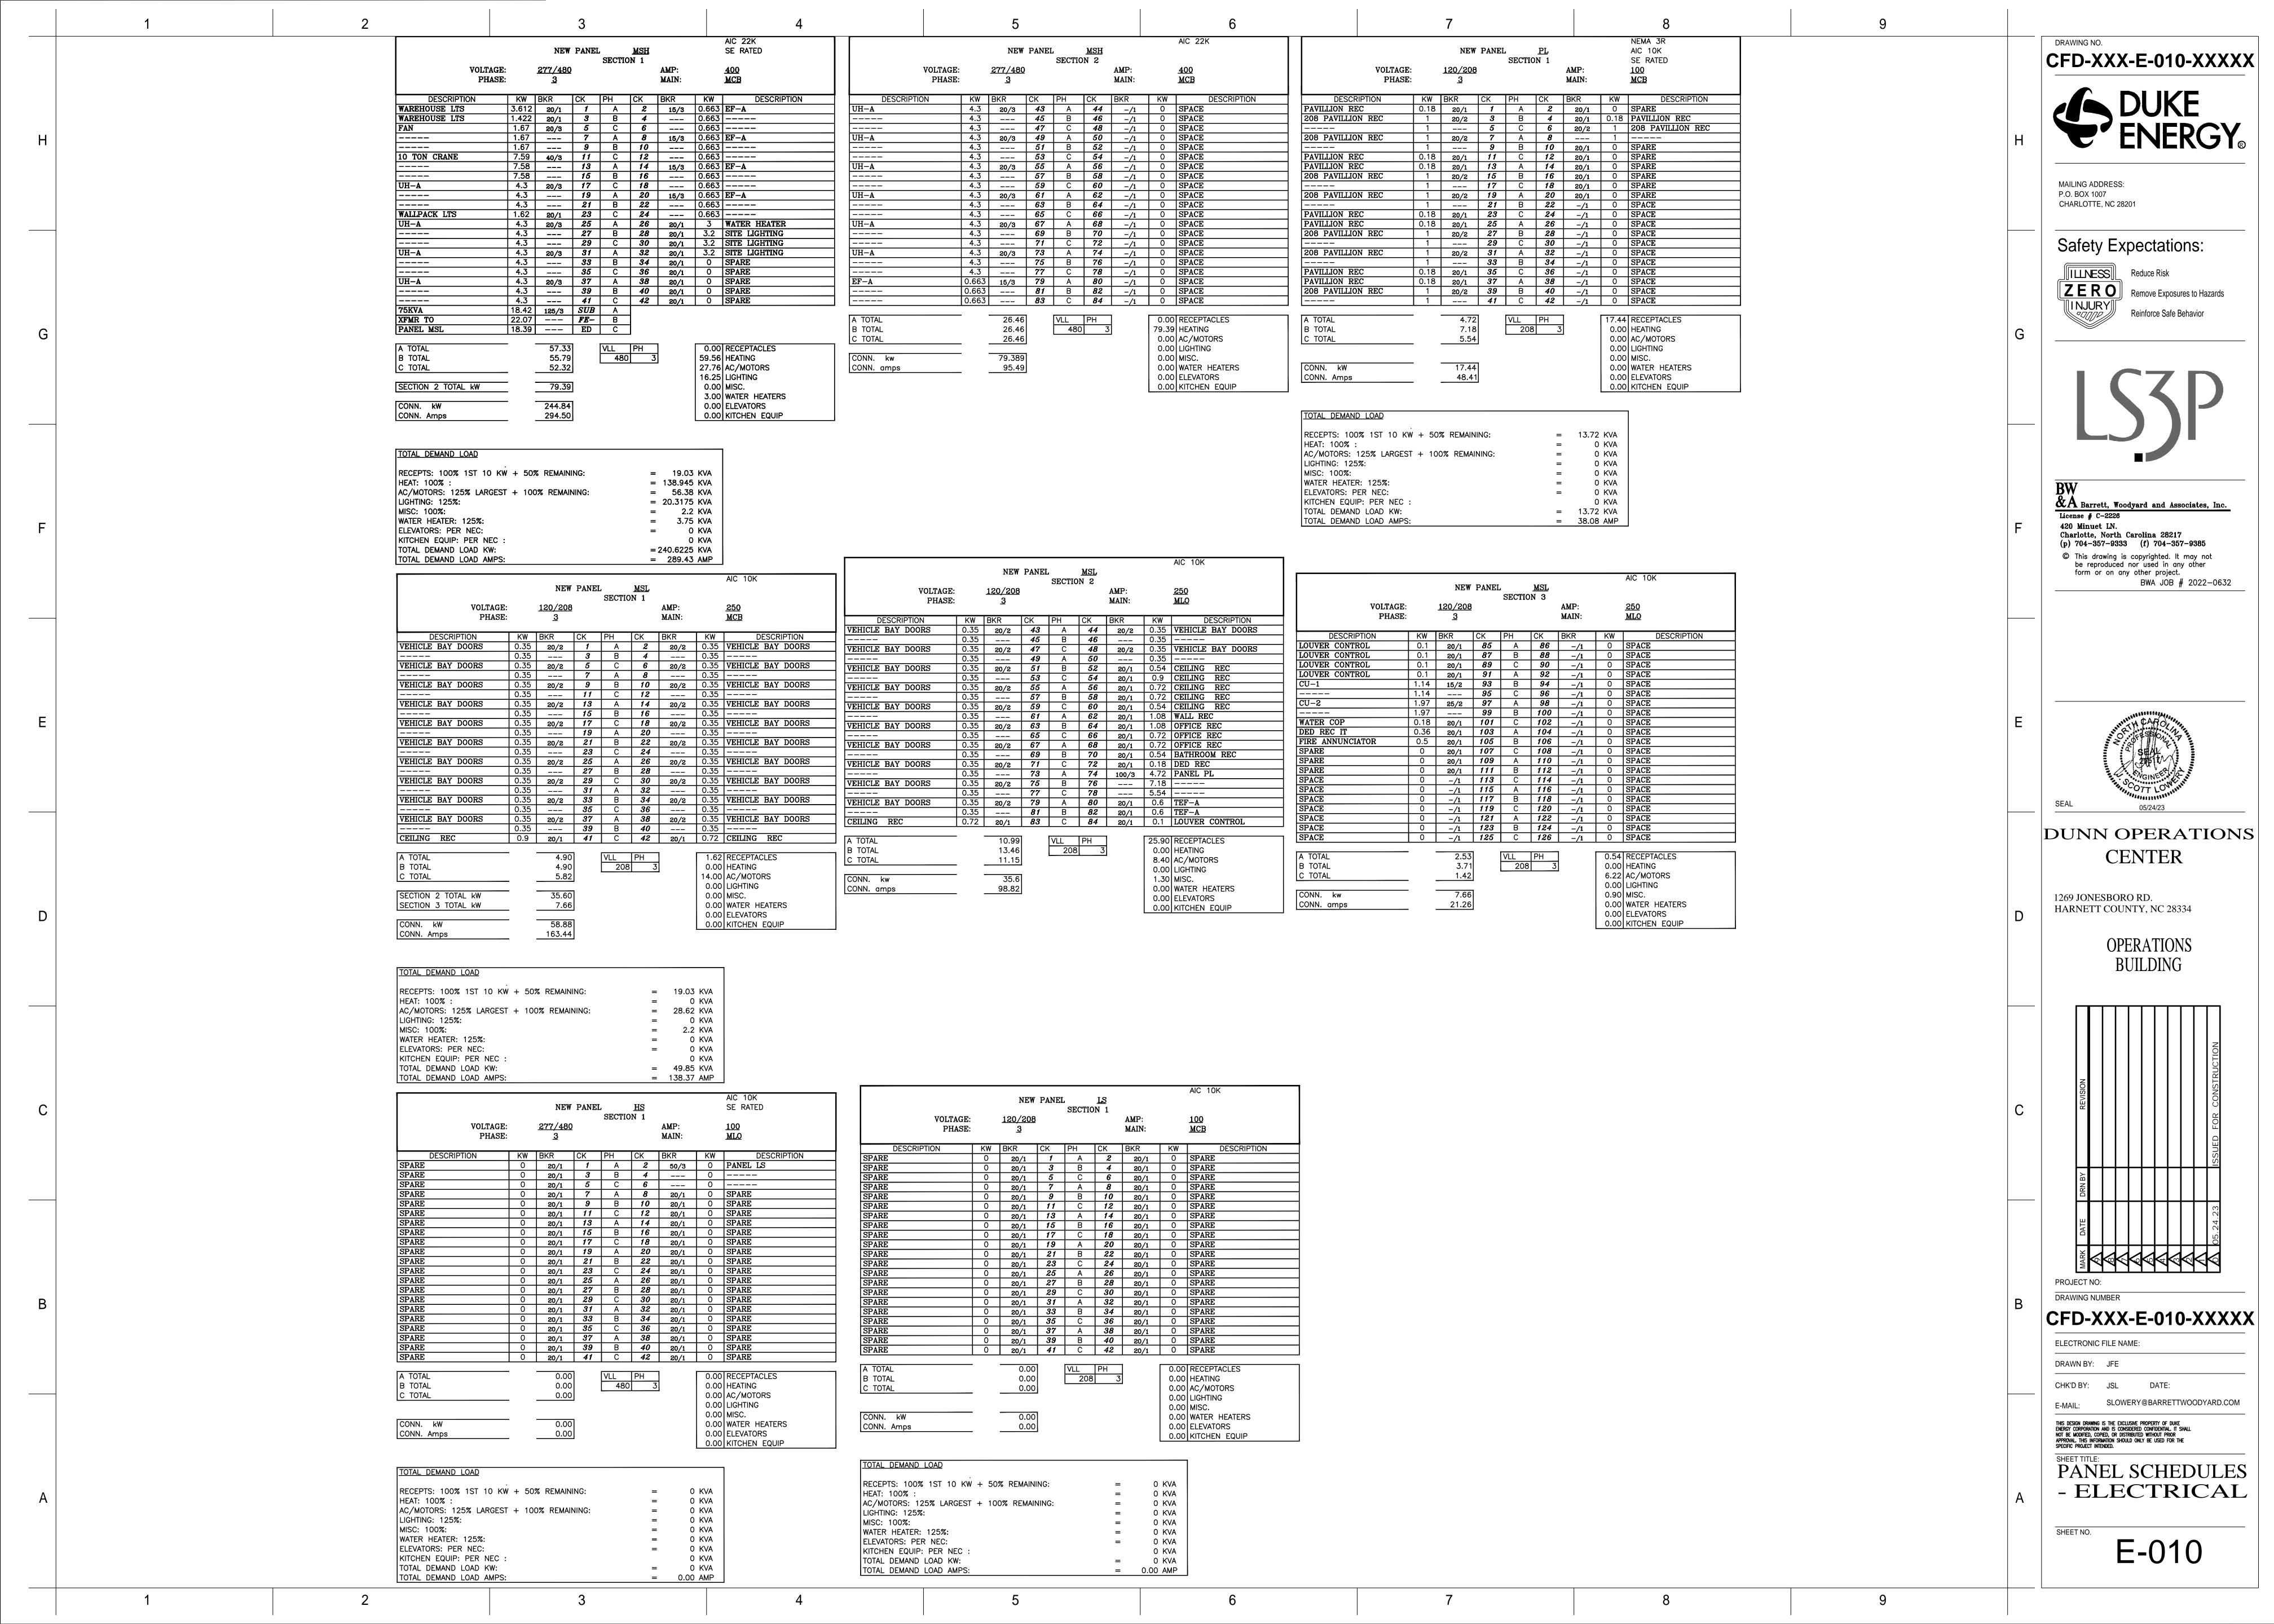





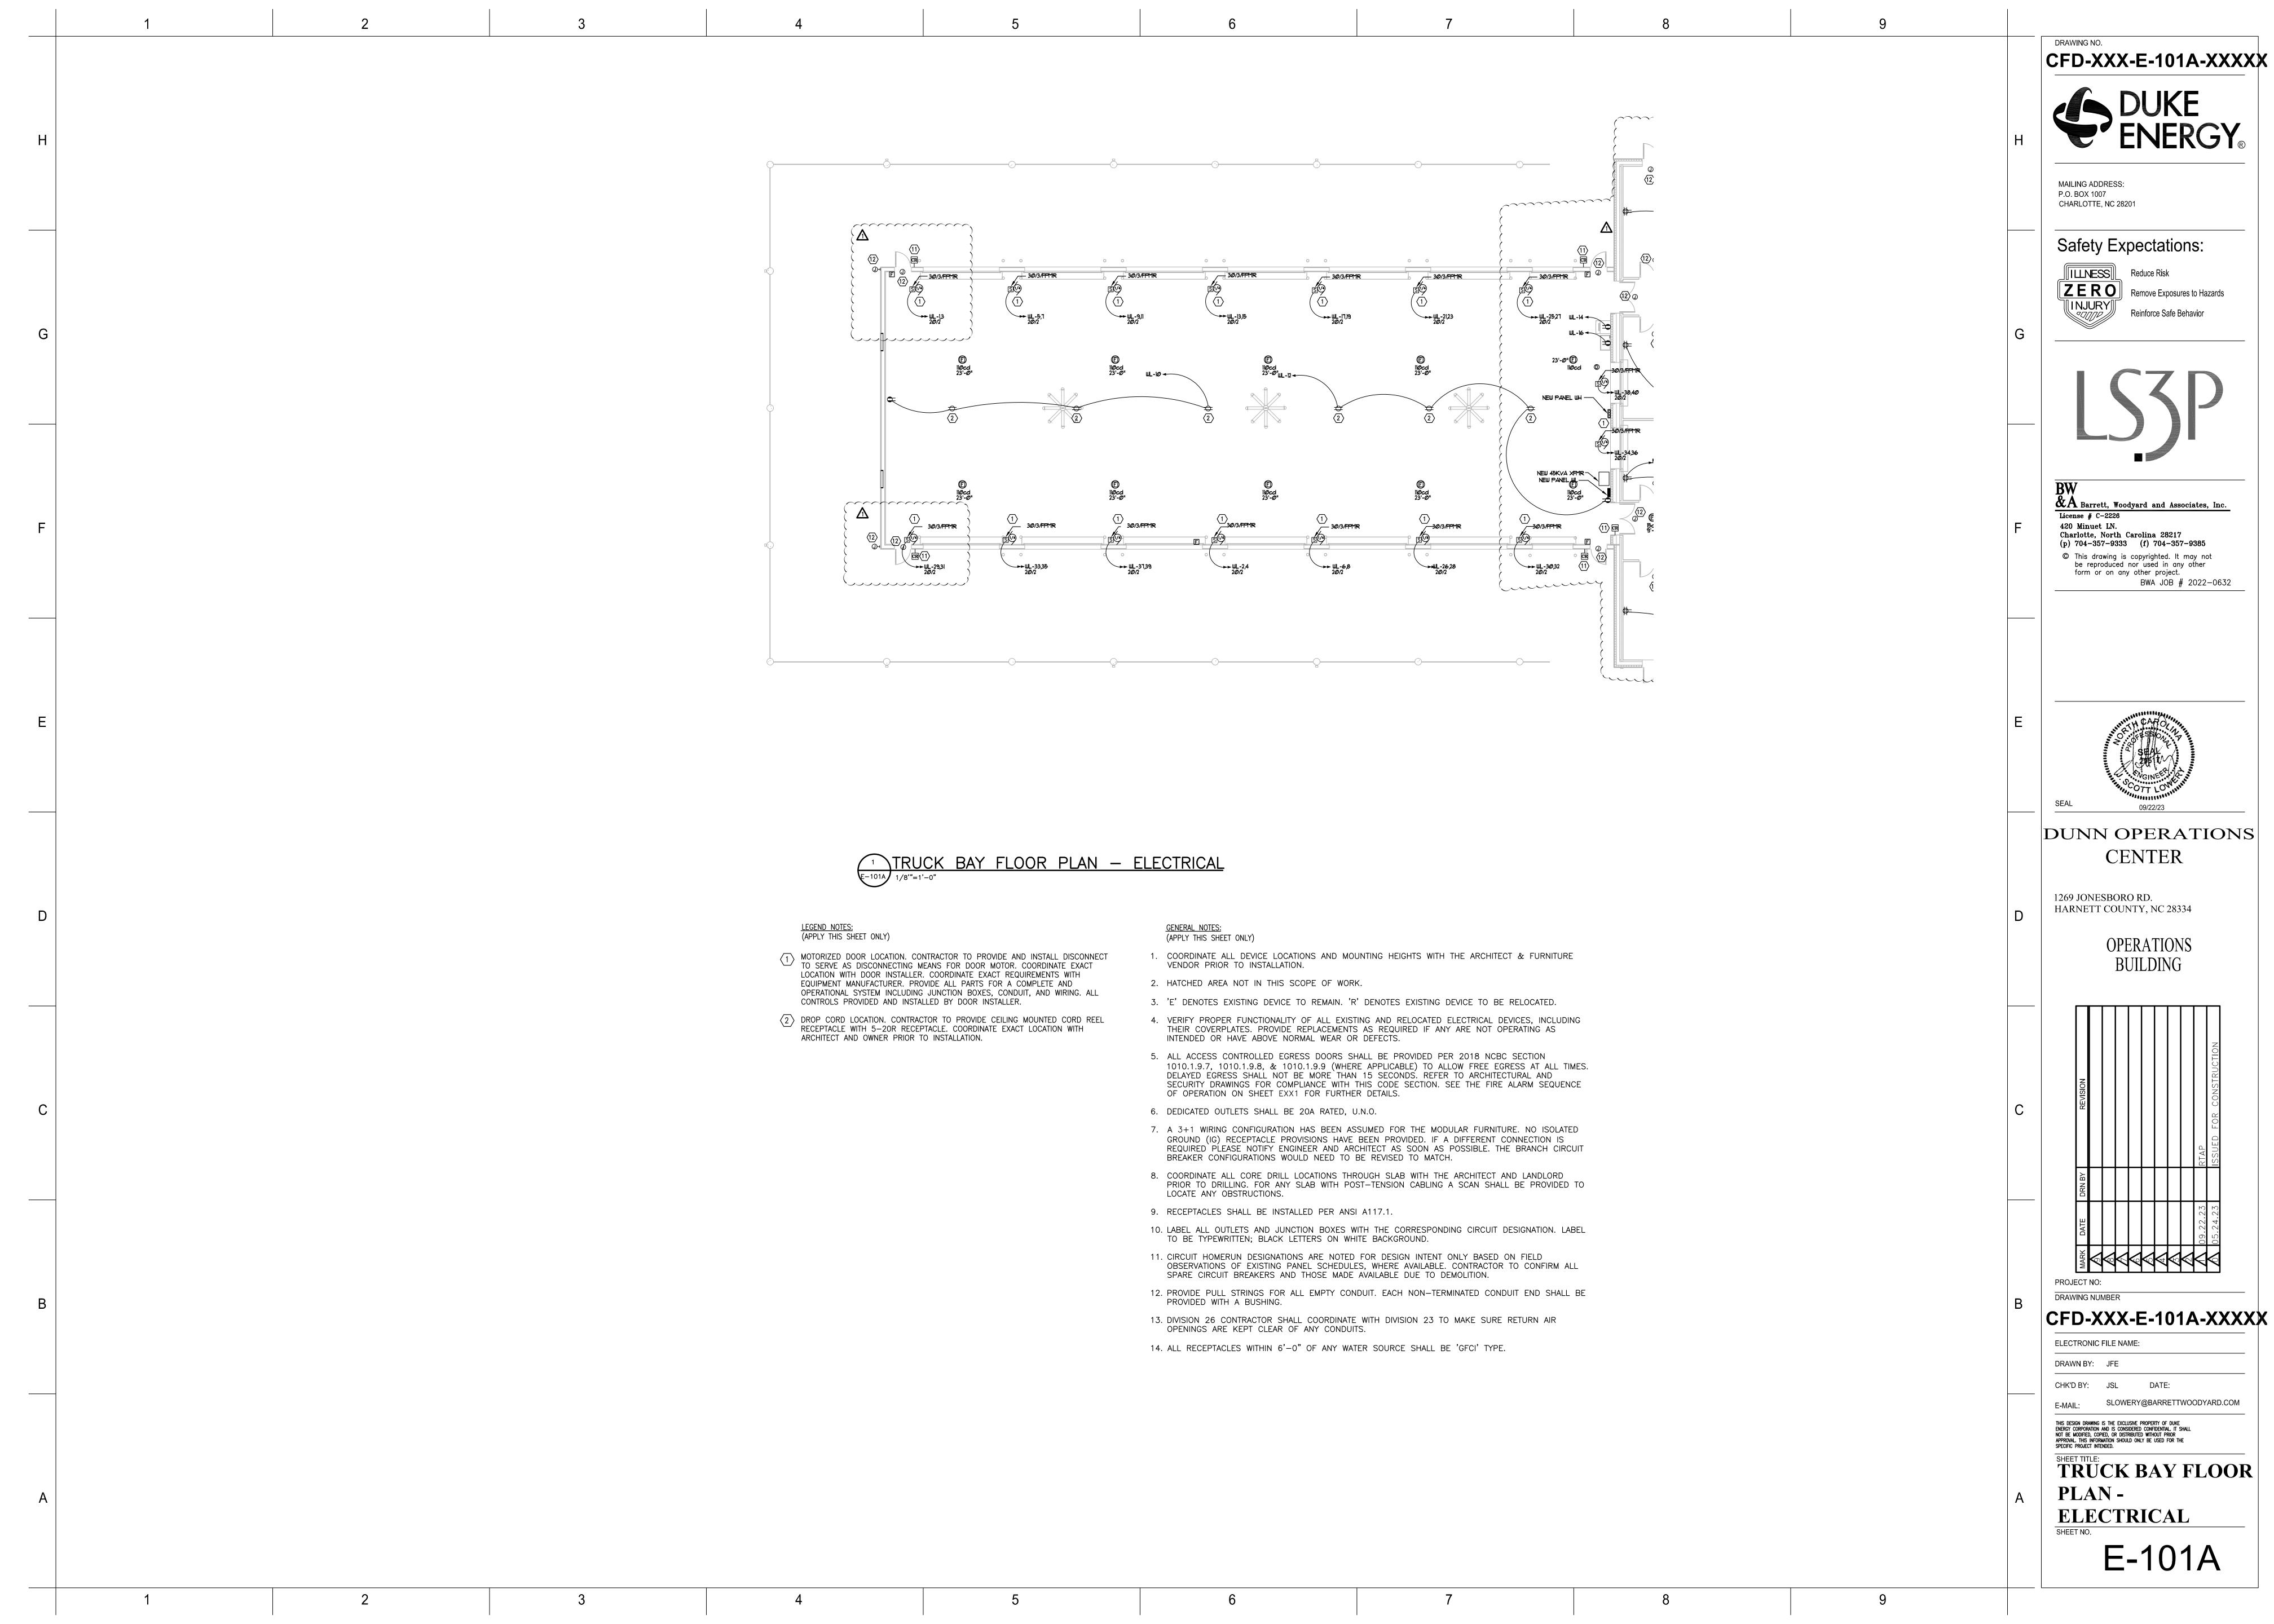

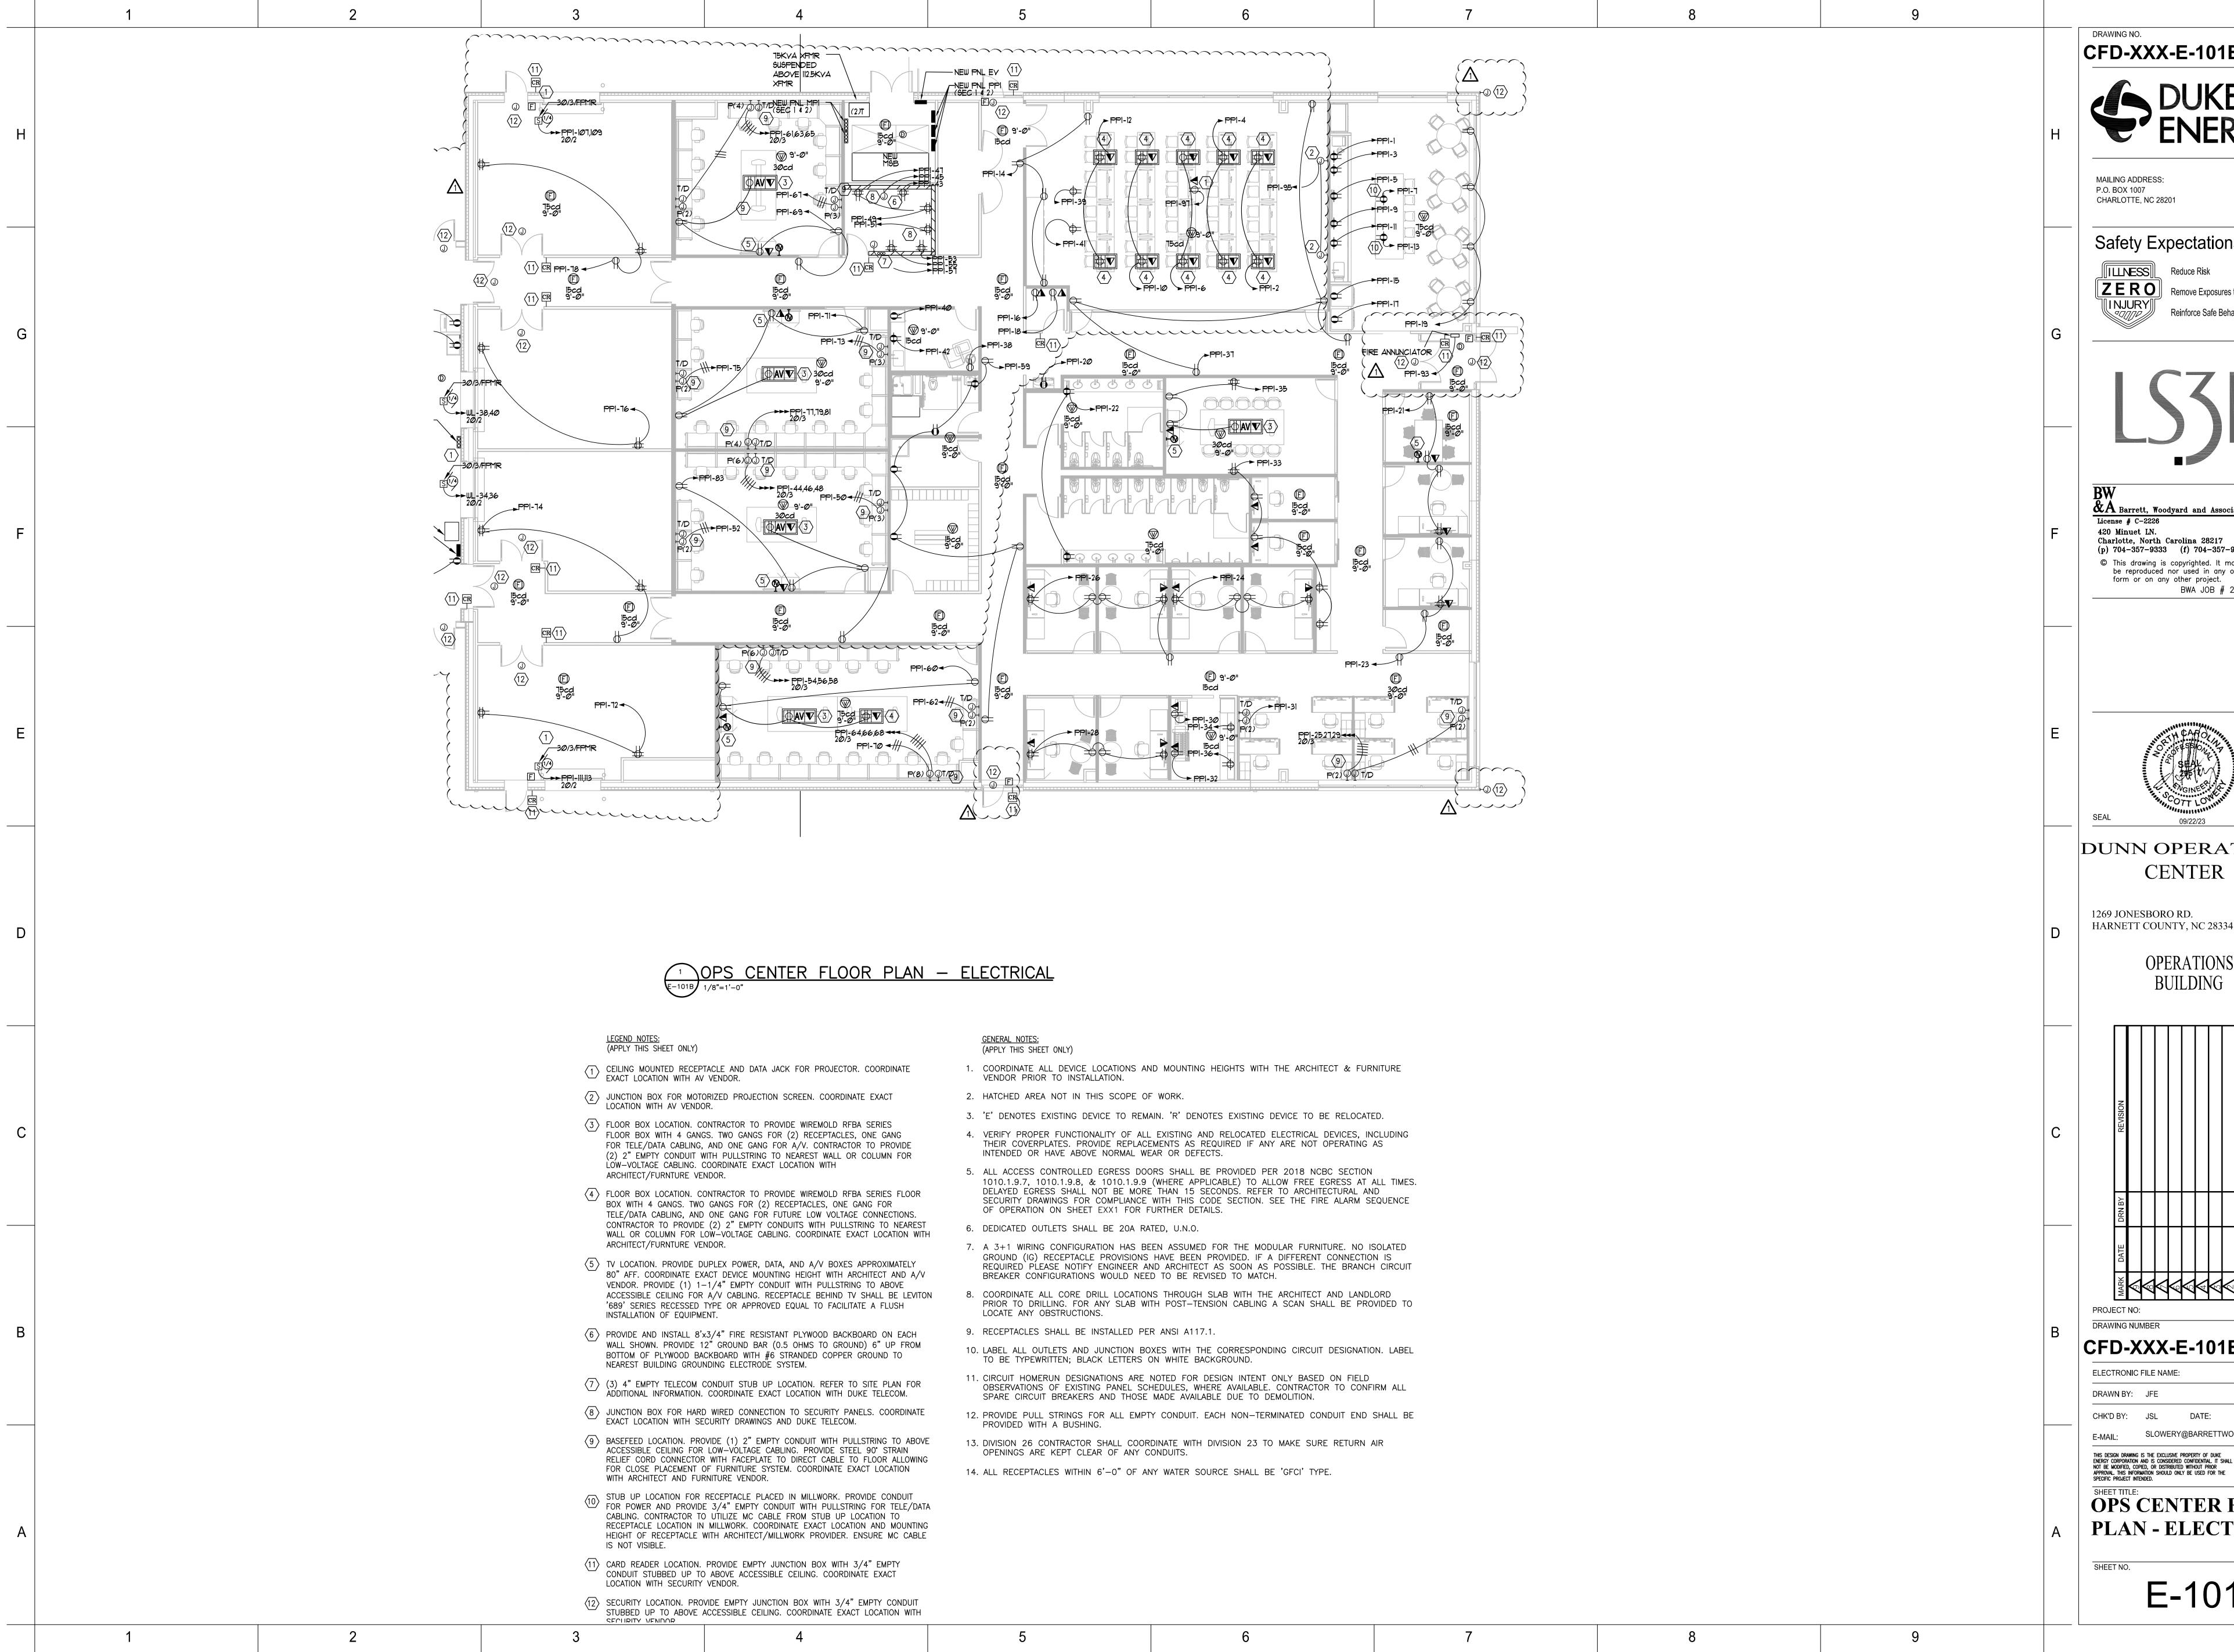

CFD-XXX-E-101B-XXXXX

CHARLOTTE, NC 28201

Safety Expectations:




ZERO Remove Exposures to Hazards Reinforce Safe Behavior



420 Minuet LN. Charlotte, North Carolina 28217 (p) 704-357-9333 (f) 704-357-9385 © This drawing is copyrighted. It may not be reproduced nor used in any other form or on any other project.


BWA JOB # 2022-0632

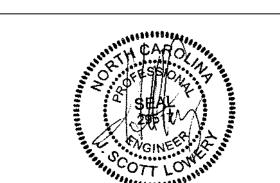

DUNN OPERATIONS CENTER

1269 JONESBORO RD.

OPERATIONS

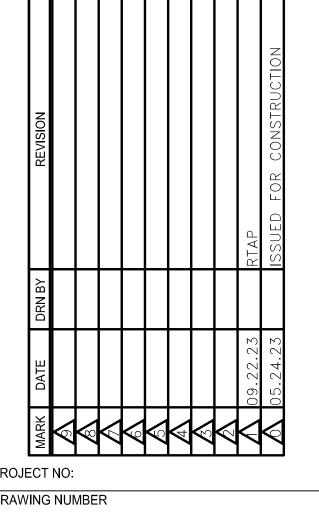

CFD-XXX-E-101B-XXXXX

ELECTRONIC FILE NAME: CHK'D BY: JSL DATE: SLOWERY@BARRETTWOODYARD.COM THIS DESIGN DRAWING IS THE EXCLUSIVE PROPERTY OF DUKE ENERGY CORPORATION AND IS CONSIDERED CONFIDENTIAL. IT SHALL NOT BE MODIFIED, COPIED, OR DISTRIBUTED WITHOUT PRIOR APPROVAL. THIS INFORMATION SHOULD ONLY BE USED FOR THE SPECIFIC PROJECT INTENDED.

OPS CENTER FLOOR PLAN - ELECTRICAL

E-101B

