



**San Lee Security**  
INCORPORATED  
*Residential & Commercial*

**Jacob Maness**  
Operations Manager



105 West Main Street  
Sanford, NC 27332

Reviewed for Fire Code Compliance







Leslie Jackson

06/26/2025 9:20:20 AM


(919) 774-3005  
jacobm@sanleesecurity.com



[sanleesecurity.com](http://sanleesecurity.com)

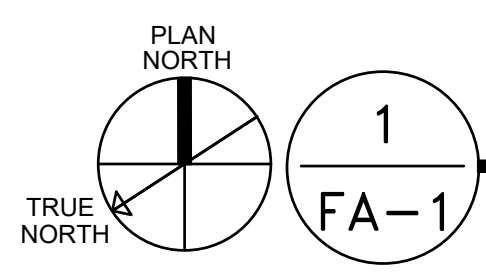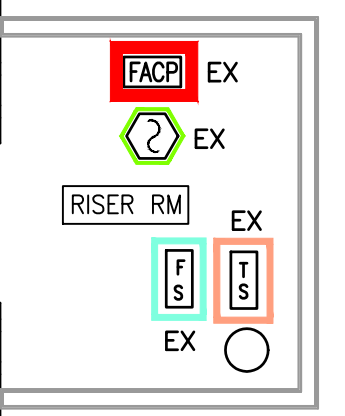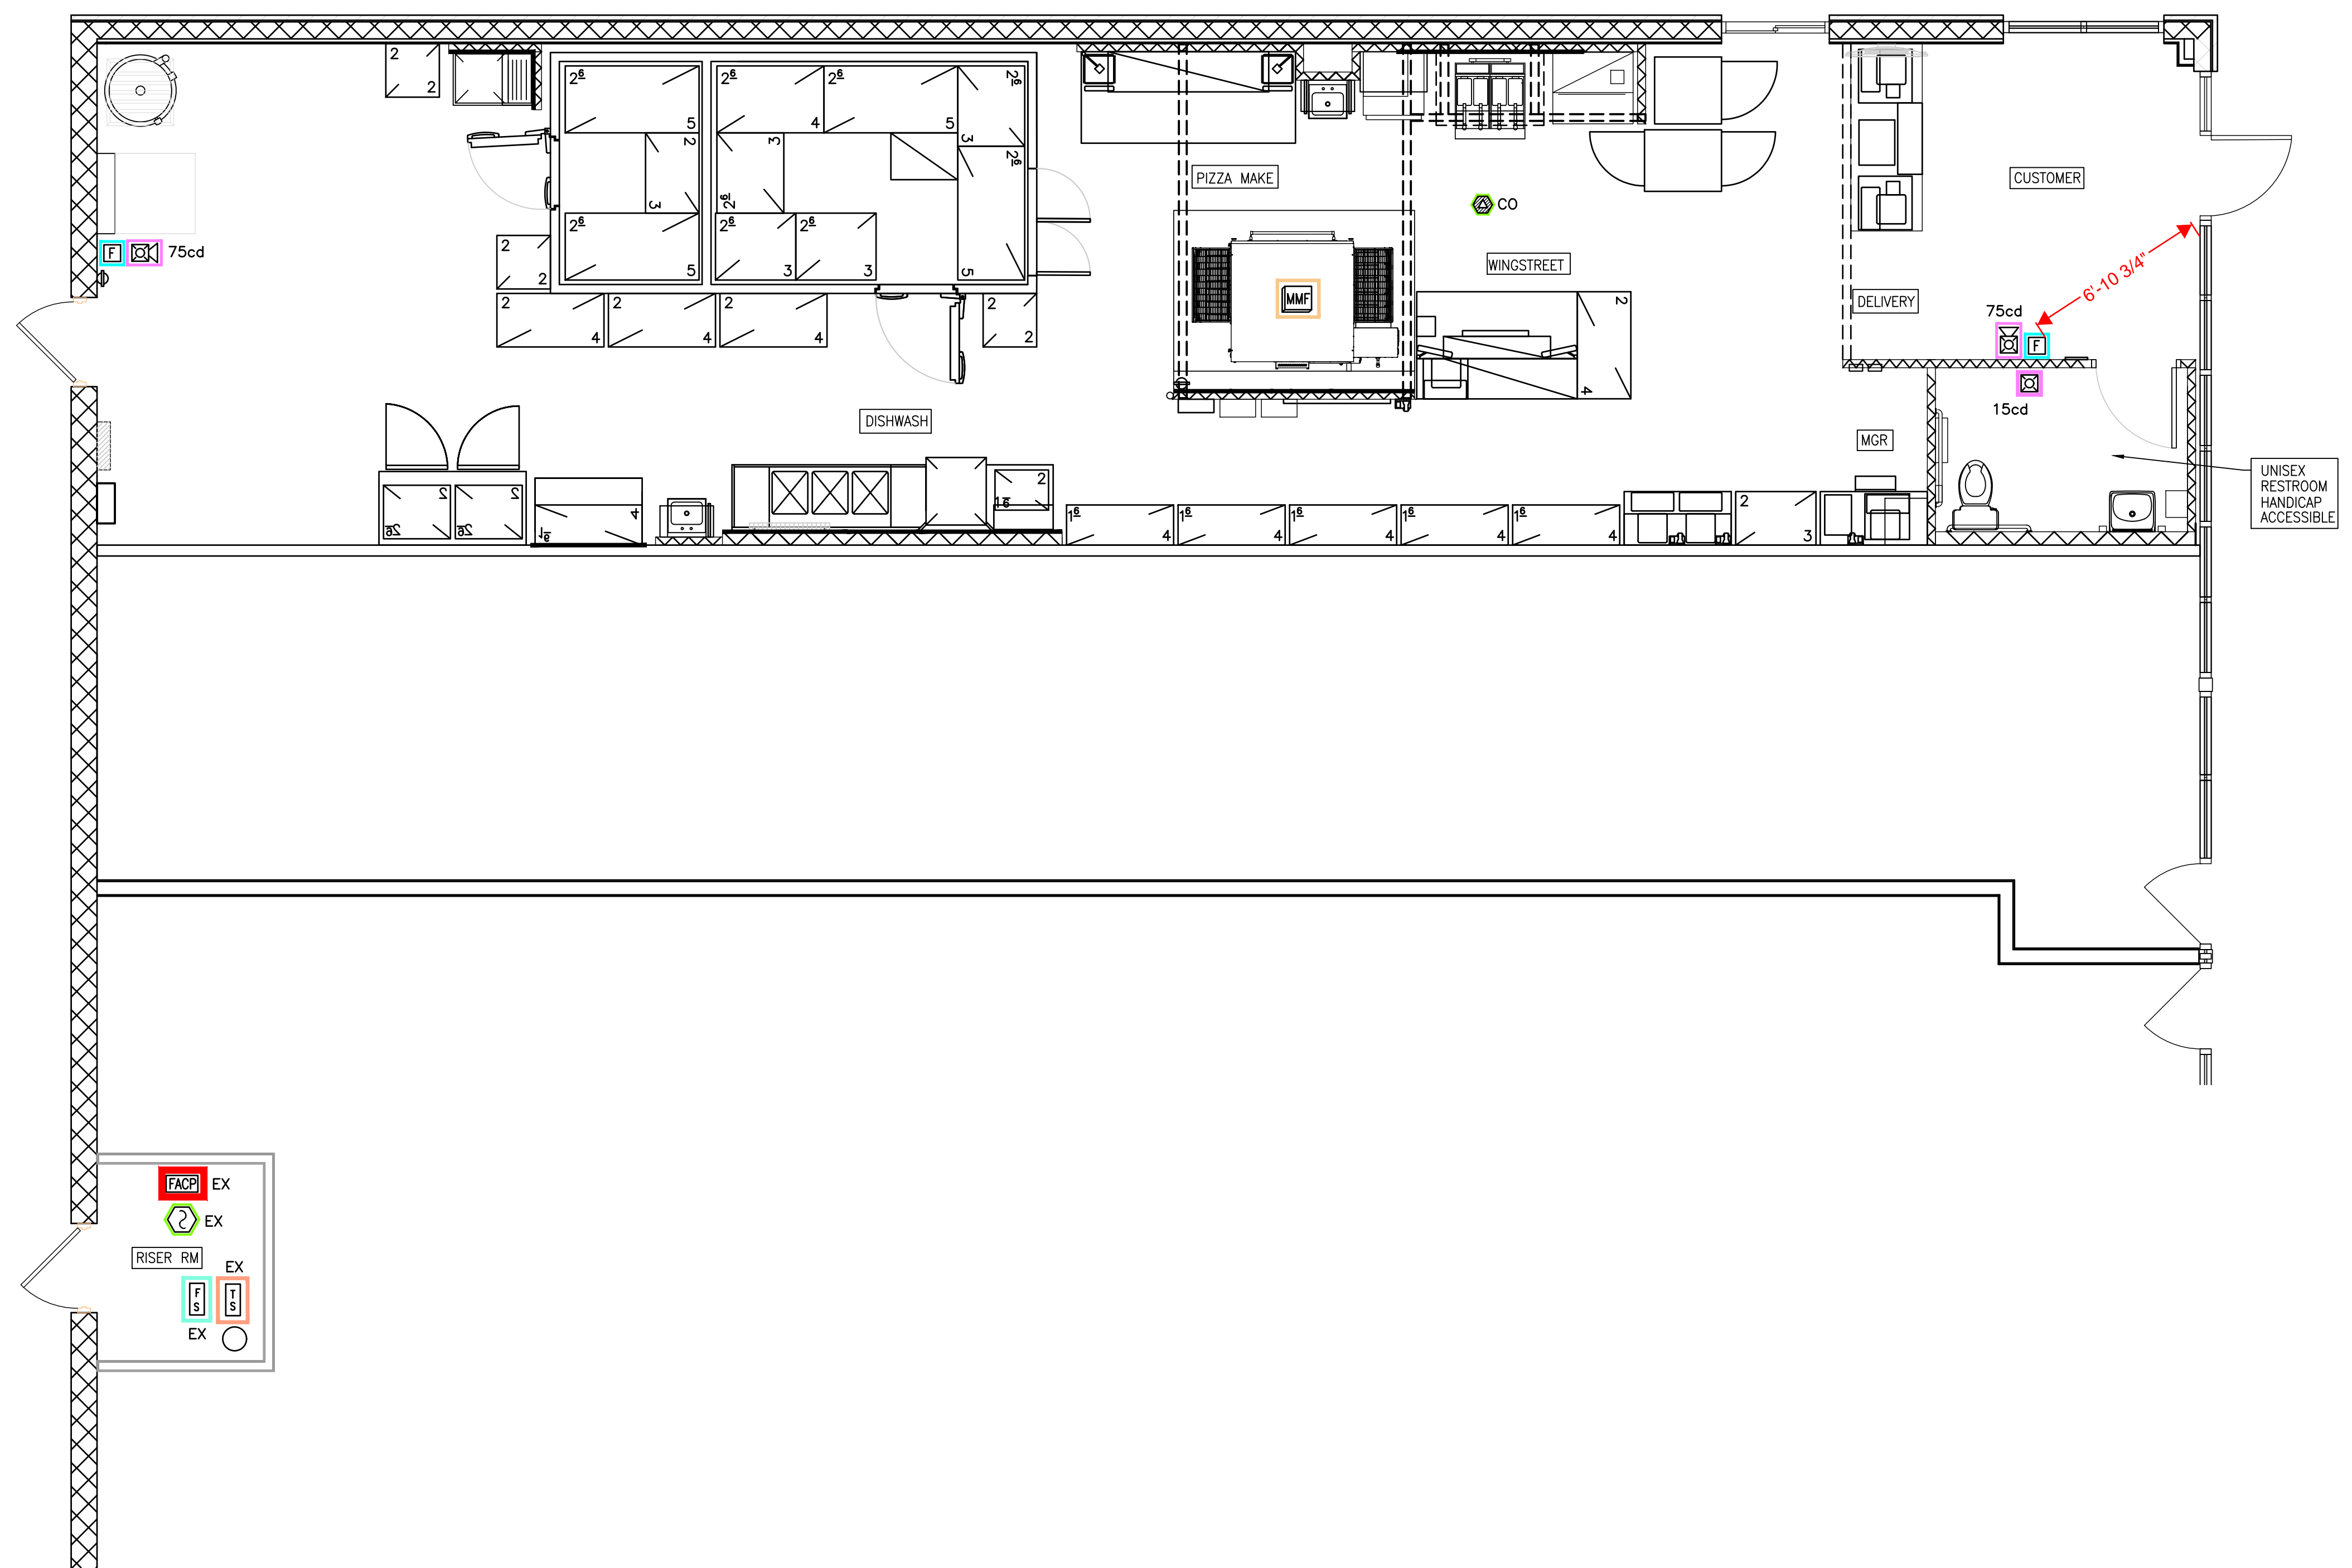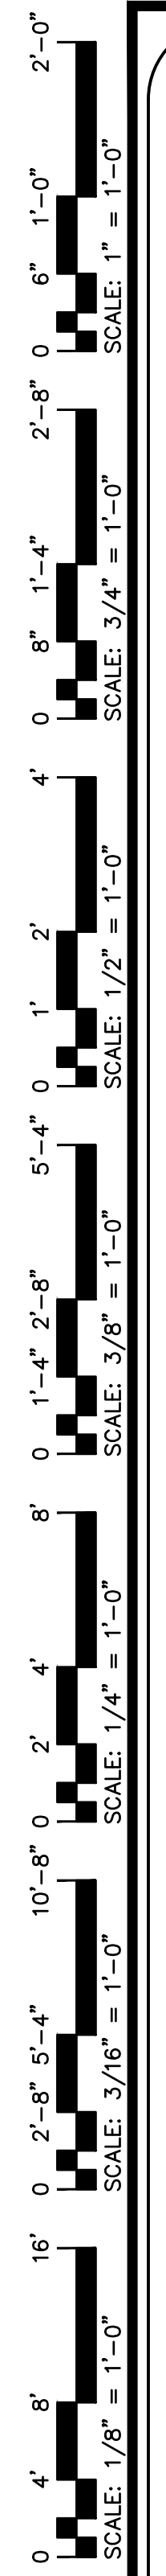

**FIRE ALARM PLAN - FLOOR PLAN**  
**TENANT GSF = 1,625**

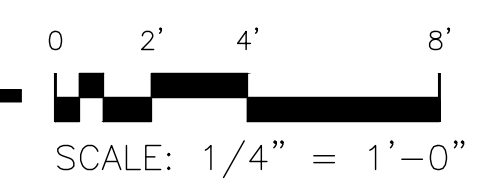

Drawing File: J:\2025\Pizza Hut (Under) FA Plan\Pizza Hut-FA-16Jun25-BLDG.dwg  
 Printed Date: Jun 16, 2025 - 2:21pm

THIS BUILDING IS FULLY PROTECTED BY FIRE SPRINKLERS



**B. JENKINS**  
 CONSULTING ENGINEERS, PA  
 OFFICE: EUREKA SPRINGS, NORTH CAROLINA  
 NORTH CAROLINA CORPORATION NUMBER: C-3070  
 OFFICE No. 910.522.1724

DESIGNED / CHECKED BY: **B. JENKINS**  
 DRAWN BY: **MAW**  
 PROJECT #: **2025-06-08**  
 DATE: **16 JUN 25**

FINAL DRAWING  FOR REVIEW PURPOSES ONLY  
 PRELIMINARY  FOR DESIGN DEVELOPMENT ONLY  
 FINAL DRAWING  FOR CONSTRUCTION  
 OWNER/TENANT:  
**PIZZA HUT**  
 185 MITTIE HADDOCK DRIVE, SPOUT SPRINGS  
 CONTRACTOR/BUILDER:  
**DUNRITE, INC. C/O MATTHEW KELLY**  
 714 FERRY AVE., CHESTERFIELD, VA 23223

PROJECT: **FIRE ALARM PLAN: PIZZA HUT STORE #42473**  
 185 MITTIE HADDOCK DRIVE SPOUT SPRINGS, NC. 28368  
 SHEET: **FIRE ALARM -- FLOOR PLAN**

**FA-1**





## Application for Plan Review

Application # BLOM 2502-0009

Date Received: 6-10-25 Received By: OLJOHNSM

Name of Project: PIZZA HUT STORE #42473

Physical Address of Project: 185 METTIE HADDOCK DR  
CAMERON, NC 28326

Plans Submitted By: JACOB MANESS

Project Phone: 919-774-3005

Contact Person/Address: JACOB MANESS

Contact Email: jacobm@sanleesecurity.com

Contact Phone: 919-548-1947

Contractor's Name/Info: JACOB MANESS  
105 WEST MAIN ST  
SANFORD NC 27330

Contractor's Phone: 919-548-1947

- Plans that are submitted will be reviewed as quickly as possible with an average time of review between 7-10 working days.
- Status checks may be conducted on plan reviews by visiting the website <http://hteweb.harnett.org/Click2GovBP/Index.jsp> or by calling the Harnett County Central Permitting Office (910-893-7525, Option #2), or the Harnett County Fire Marshal's Office (910-893-7580).
- Approved plans must be picked up from the Central Permitting Office and all fees paid before any required inspections can be conducted.