

WILLIAM A. PERSON, P.E.
CONSULTING ENGINEER

774A E F COTTRELL RD.
LOUISBURG, NC 27549

(919) 496-5228
(FAX)(919) 496-3213
1-800-545-3496

November 12, 2019

Clayton Homes
3912 Fayetteville Rd.
Raleigh, N.C. 27603

Re: Elevated Manufactured Home Inspection
388 Turlington Rd.
Dunn, N.C.

Dear Sirs:


On 11/11/19, an inspection was performed on the stabilizing system of the manufactured home described above. More than one-fourth of the main I beam piers exceed 36" in height. The stabilizing system has been designed for the height of the home and the wind, live, and dead loads specified by the State of North Carolina Regulations for Manufactured Homes.

The stabilizing system, including piers, anchors, and straps, is structurally adequate as installed for the specified loads and site conditions. The location of each tie down is shown on the attached sheet 2 of 2.


Sincerely,

William A. Person, PE



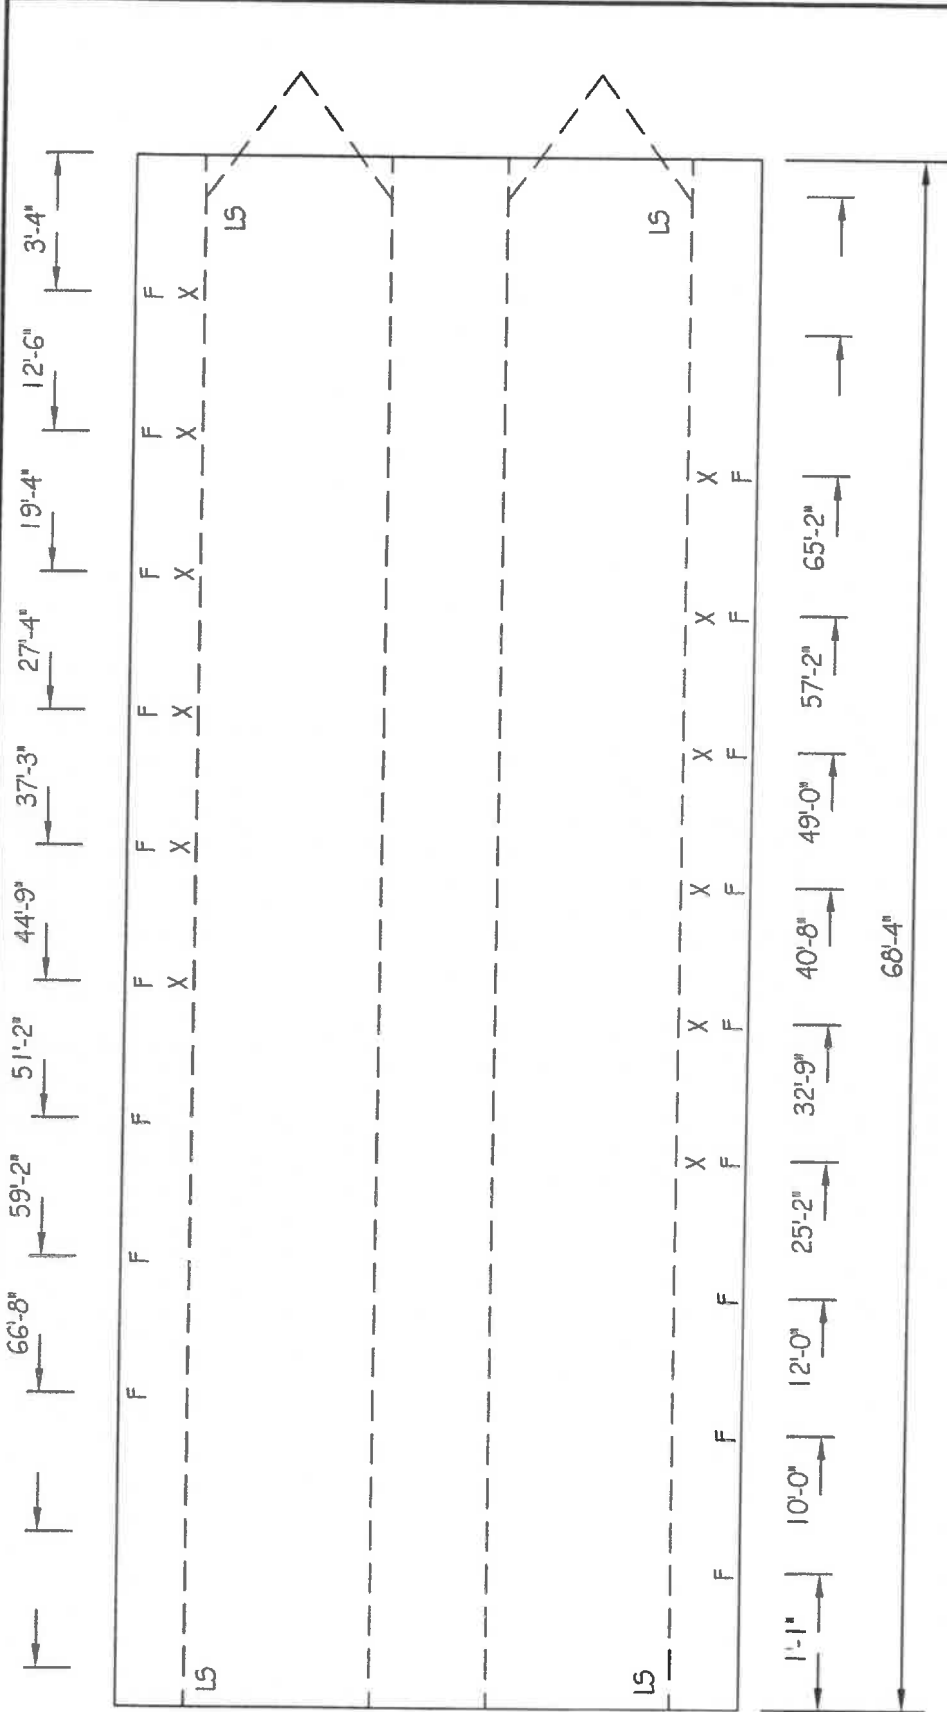

NOTES:
 F = FRAME TIE
 X = CROSS TIE
 LS = LONGITUDINAL STRAP

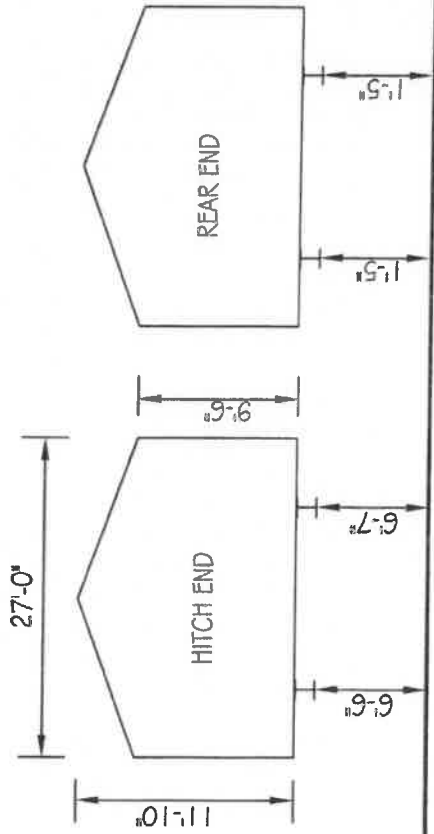

FIELD INSPECTION REPORT	
CLAYTON HOMES	
388 TURLINGTON RD., DUNN, NC	
DATE	DWG. NO.
1/11/19	
SHEET NO. 2 OF 2	