


VICINITY MAP
 44 Carriage Lane
 Lot 14, Carriage Village
 Map Number 98-507
 PIN: 0684-60-1221.000

D & S Properties


As built Survey

Black River Twp. Harnett County
 Scale: 1" = 40' Date: 11-22-19

Surveyed & Mapped By
STANCIL & ASSOCIATES
 Professional Land Surveyor, P.A. C-0831
 P.O. Box 730, Angier, N.C. 27501
 919-639-2133 919-639-2602 (FAX)
 stancilsurvey@gmail.com

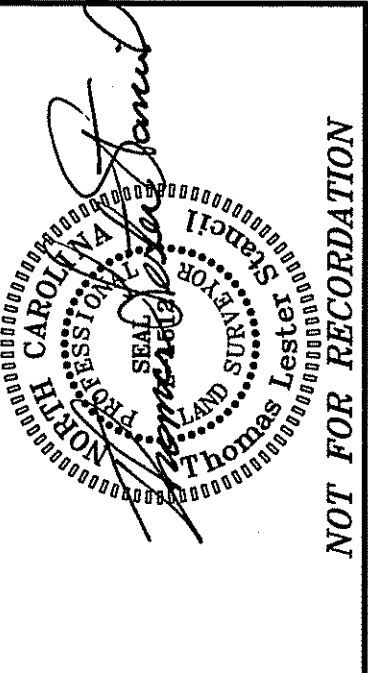

NOT FOR RECORDATION

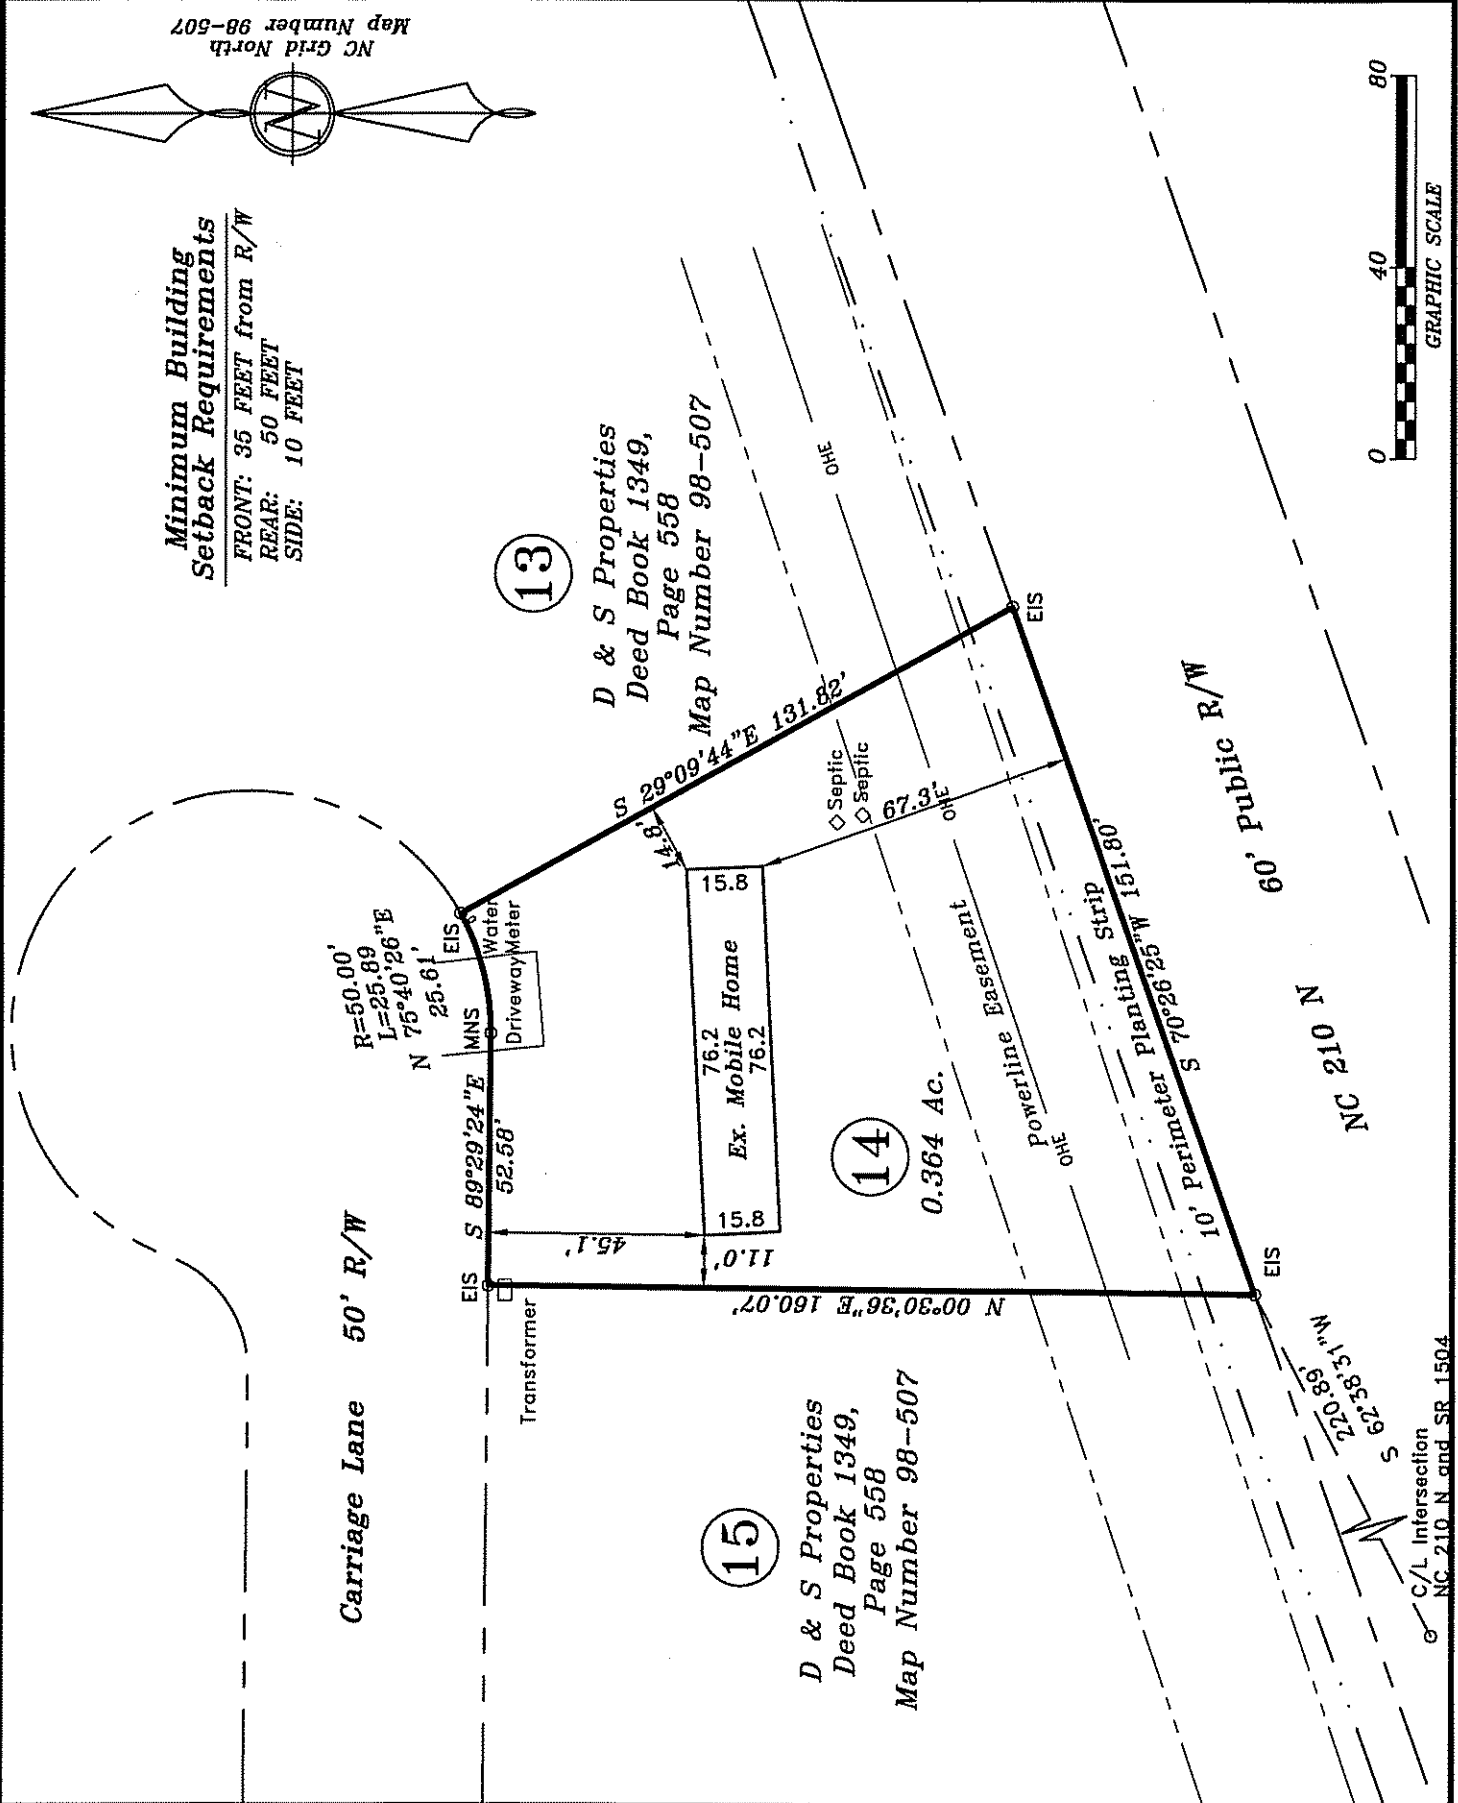

Minimum Building Setback Requirements
 FRONT: 35 FEET from R/W
 REAR: 50 FEET
 SIDE: 10 FEET

NC Grid North
 Map Number 98-507

C/L Intersection
 NC 210 N and SR 1504