


✓
 floor
 and
 insulation
 completed
 and inspected
 when house
 was built. in 2019





FOR GABLE ROOF ELEVATION
SECOND FLOOR PLAN
 SCALE: 1/4"=1'-0"
 8'-0" CLG. HGT.
 SET WINDOWS AT 6'-8" A.F.F.



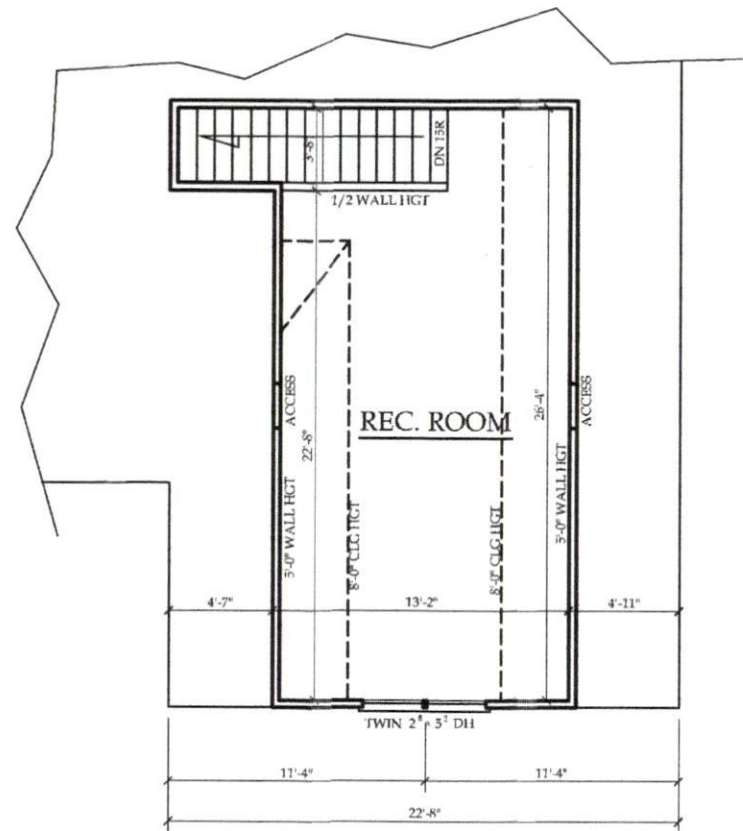



FOR HIP ROOF ELEVATION
SECOND FLOOR PLAN
 SCALE: 1/4"=1'-0"
 8'-0" CLG. HGT.
 SET WINDOWS AT 6'-8" A.F.F.

ORDINANCES, D&R DESIGNS, LLC
 CONDITIONS, CONSTRUCTION IN
 THESE PLANS.

ALL SPECIFIC INFORMATION FOR CLADDING.

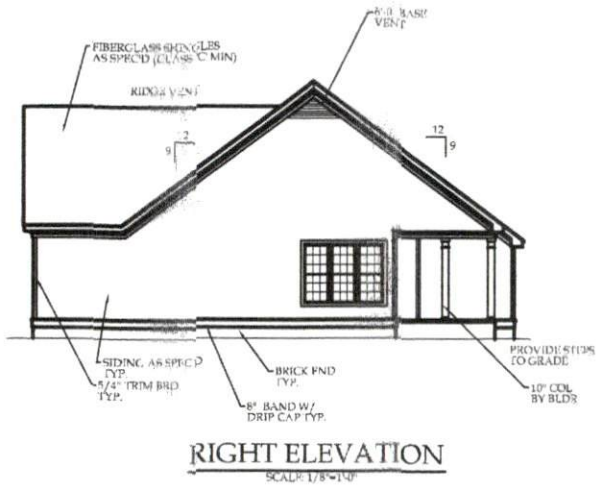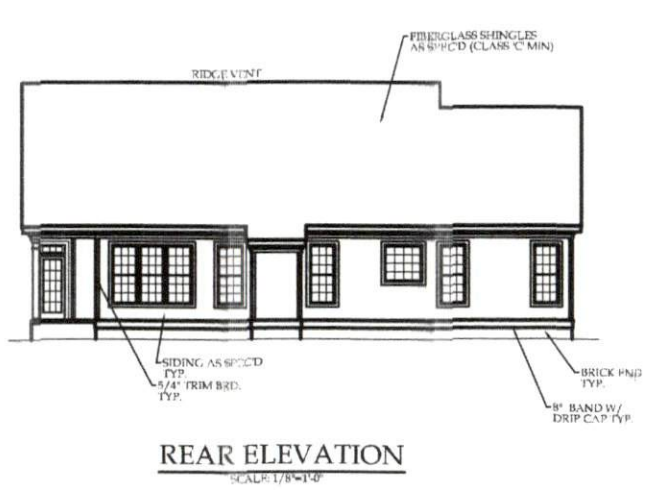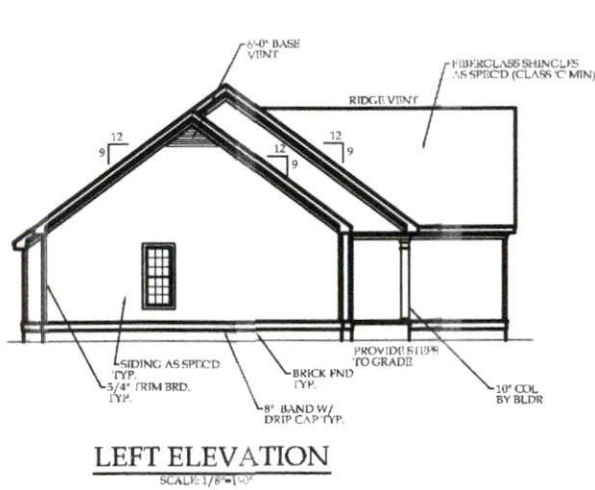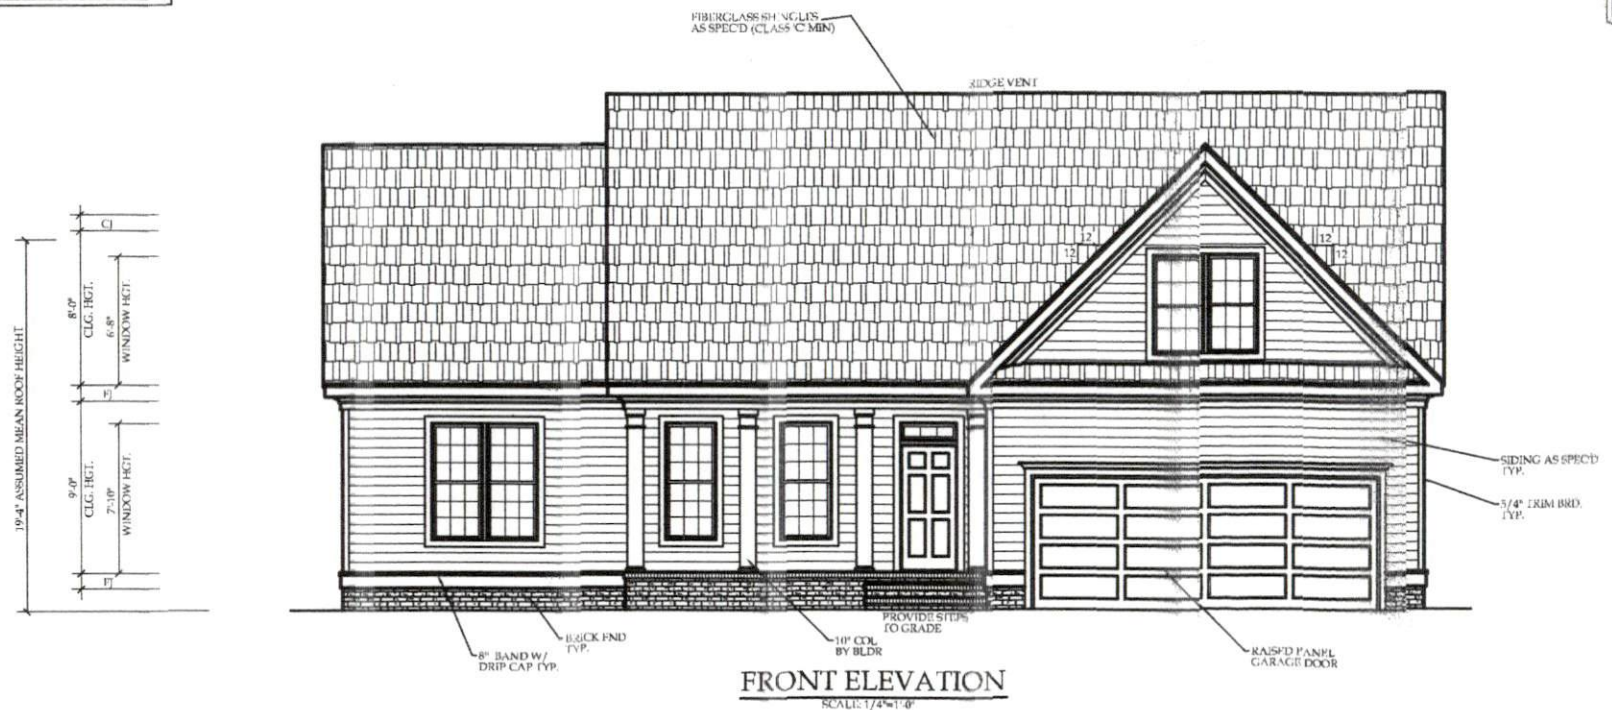

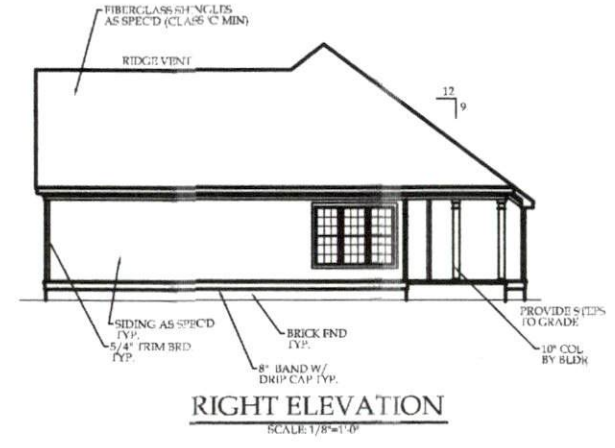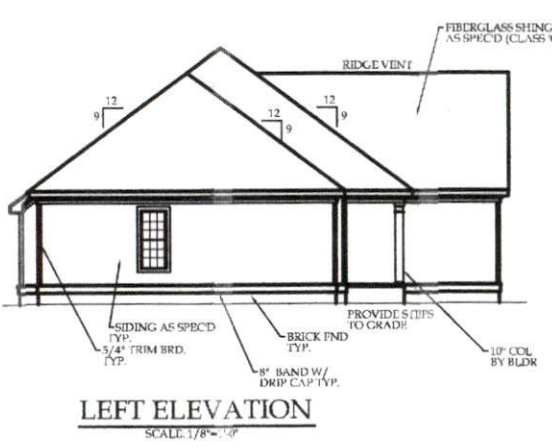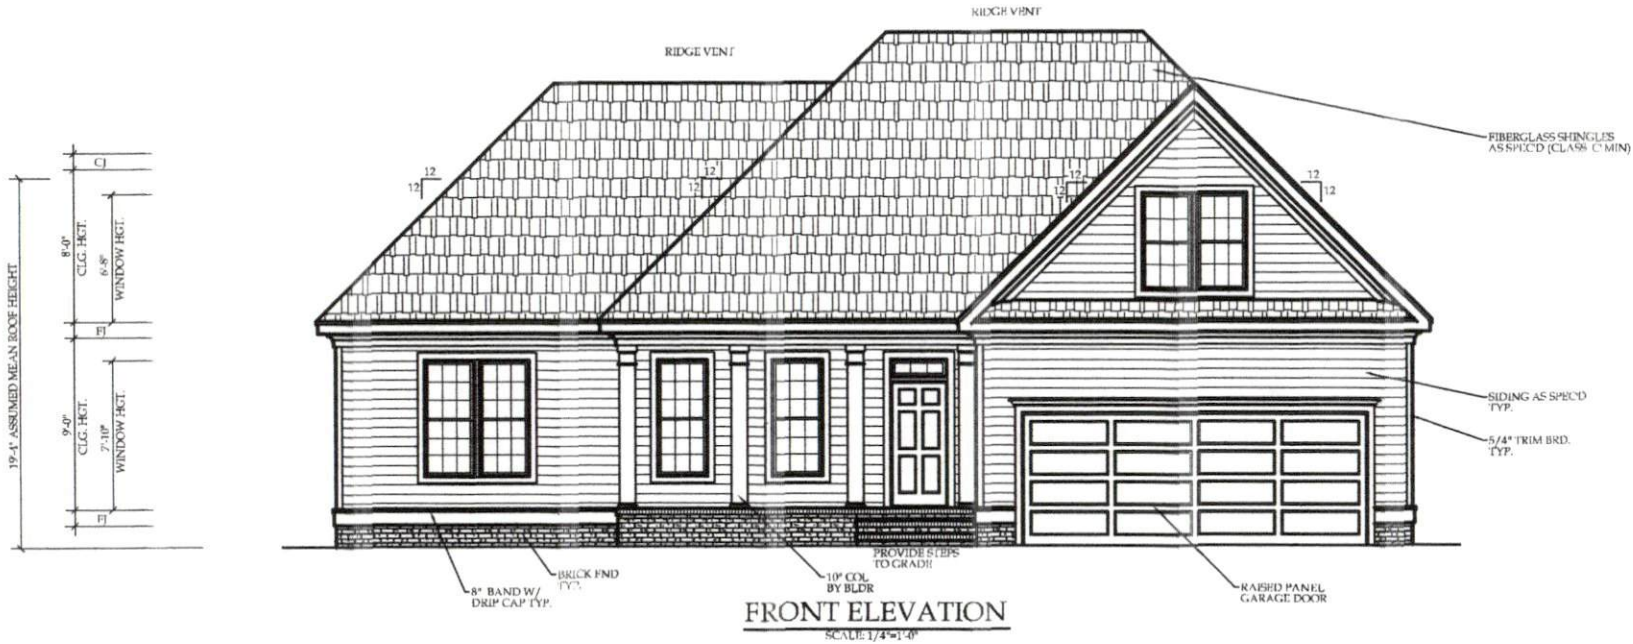

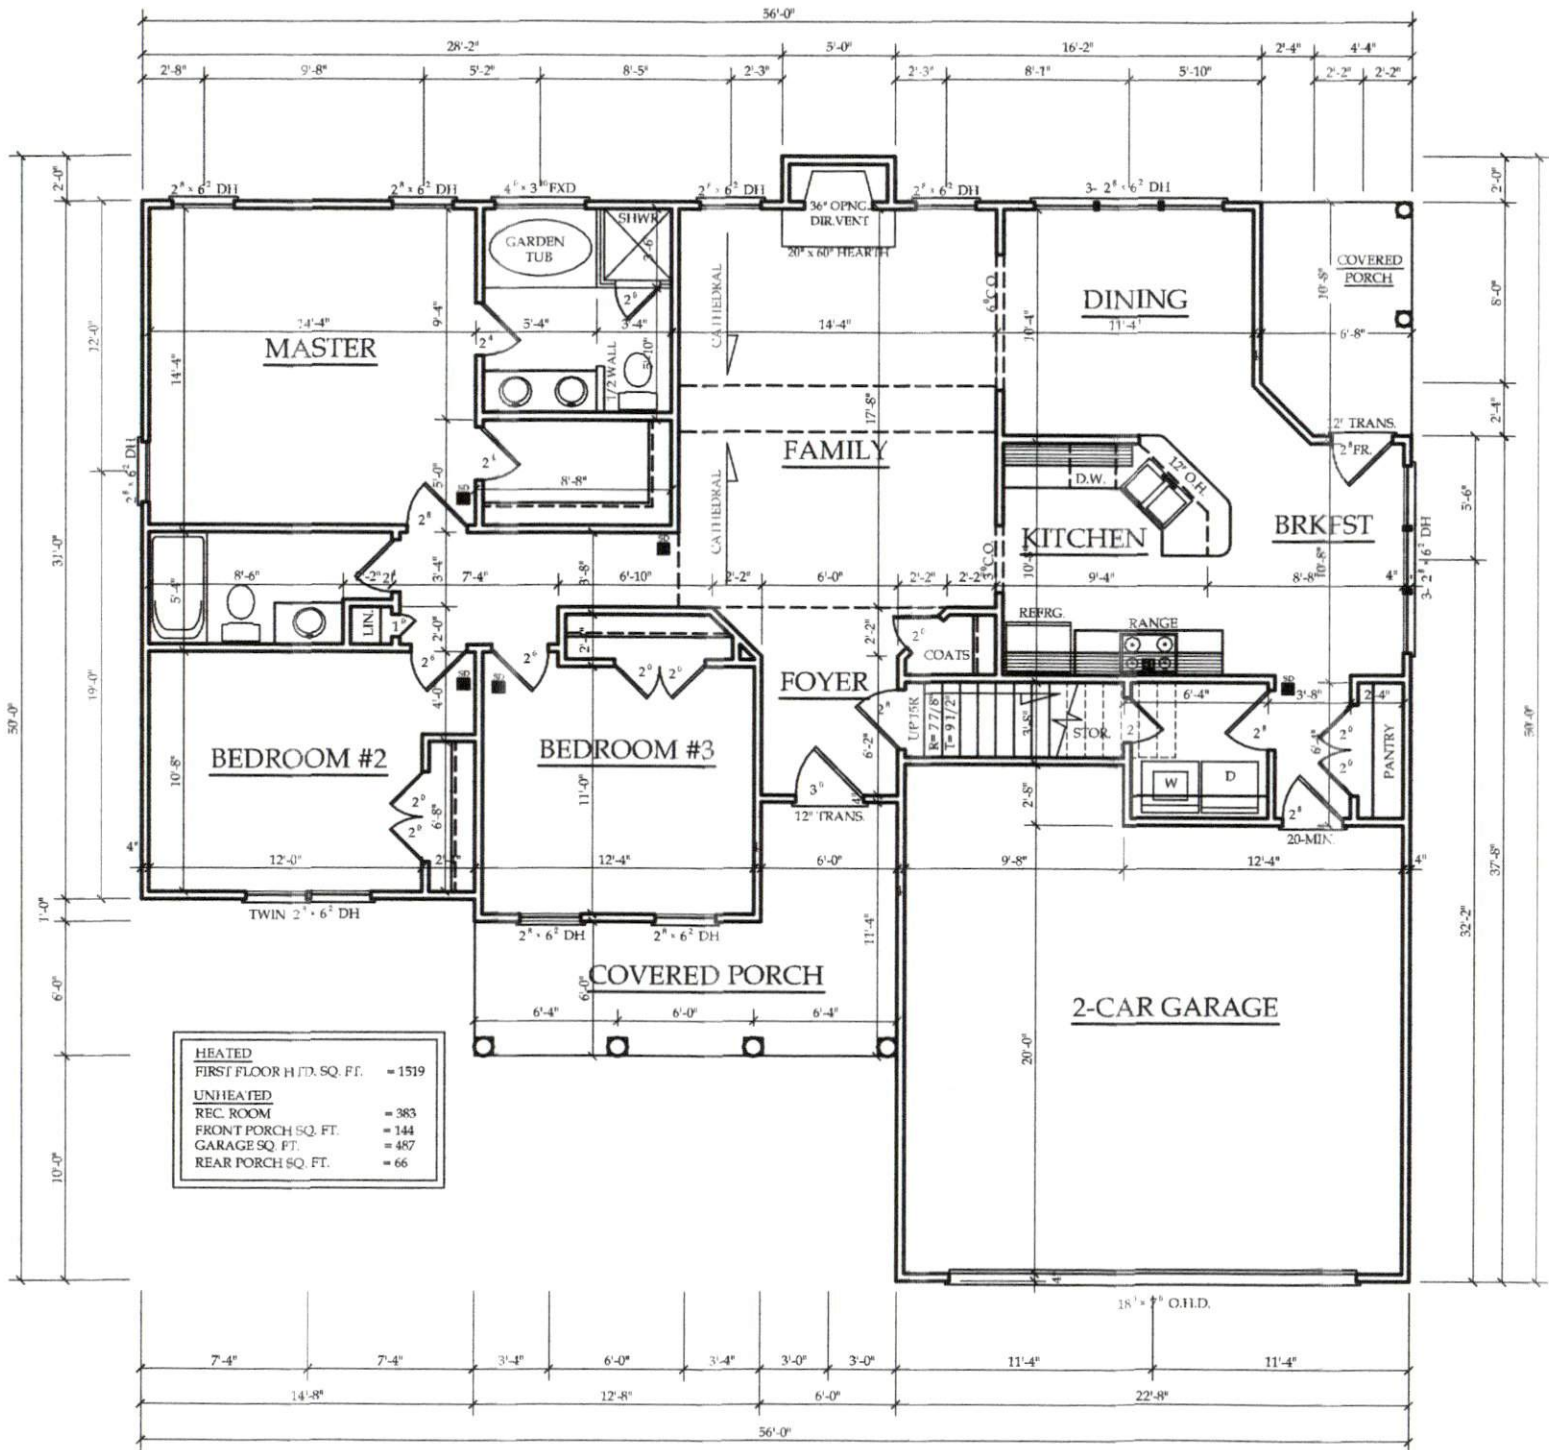

HEATED	
FIRST FLOOR H.T.D. SQ. FT.	= 1519
UNHEATED	
REC. ROOM	= 383
FRONT PORCH SQ. FT.	= 144
GARAGE SQ. FT.	= 487
REAR PORCH SQ. FT.	= 66