

CAROLINA ENGINEERS, PA (Lic. C-0205)

Geotechnical • Construction Materials • Forensic • Site Development • Surveying

March 25, 2020

Mr. Allen Denning
34 Bumpass Creek Access Rd
Dunn, NC 28335

Re: **Shelter Foundation**
34 Bumpass Creek Access Rd

Mr. Denning,

Let this letter serve purpose that the foundation installed at the subject-referenced location was constructed per the attached plan.


If further assessment is required, please advise.

Sincerely,
Carolina Engineers, PA

A handwritten signature in blue ink, appearing to read "M.P. Meadows".

Myron P. Meadows, PE, PLS
Engineer

Enclosures: Shelter Plan (1 sheet)

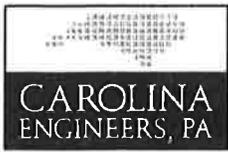


CAROLINA ENGINEERS, PA

Geotechnical • Materials Testing
Forensic • Site Development • Surveying
PO Box 1595 • New Bern, NC 28563
Tel: (252) 633-2425 • Fax: (252) 634-9718
www.carolinaengineers.com


Project: ALLEN DENNING
Job: POLE SHED
Sheet No.: _____ of _____
Designed: MPM Date: 2.4.20
Checked: _____ Date: _____

LOCATION: 34 BYPASS CREEK ACCESS RD.
DUNN, NC 28335

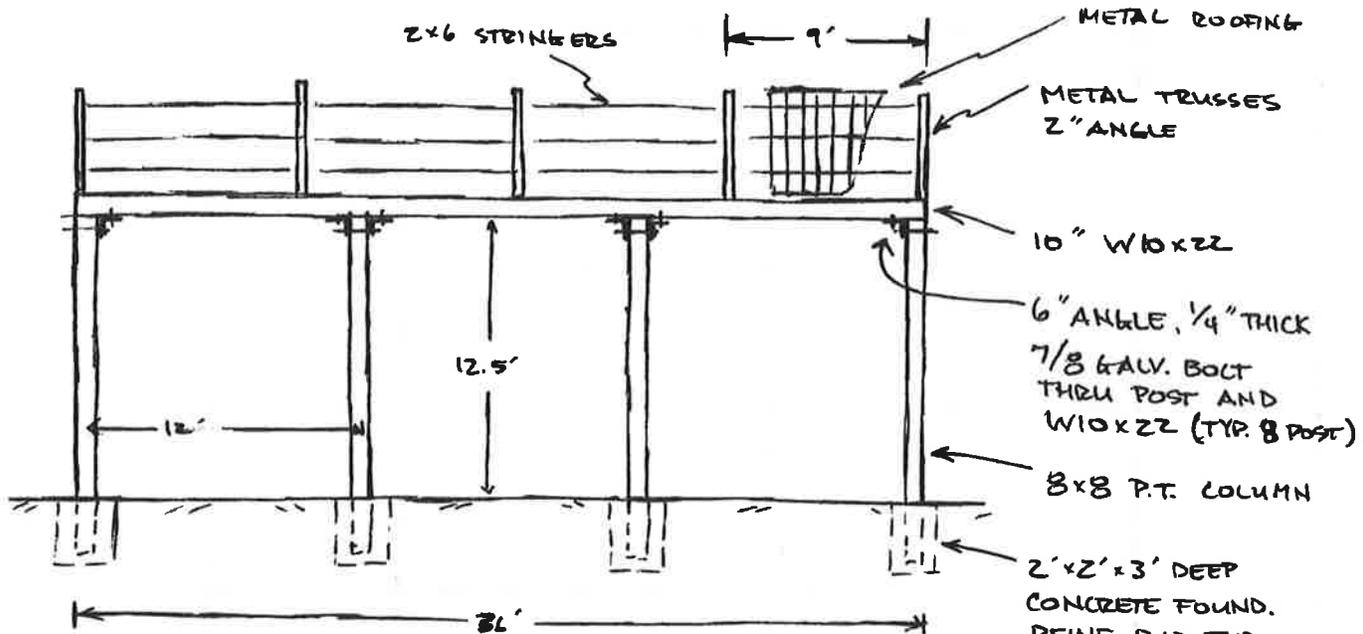

S I D E V I E W

SCALE AS SHOWN

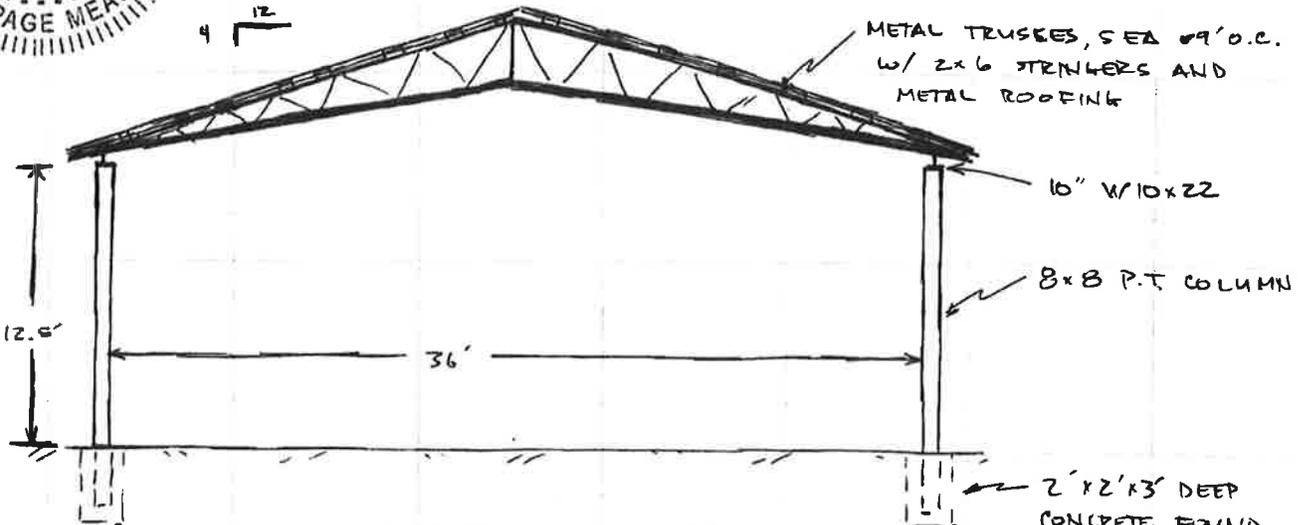

F R O N T V I E W

SCALE AS SHOWN