


As Built

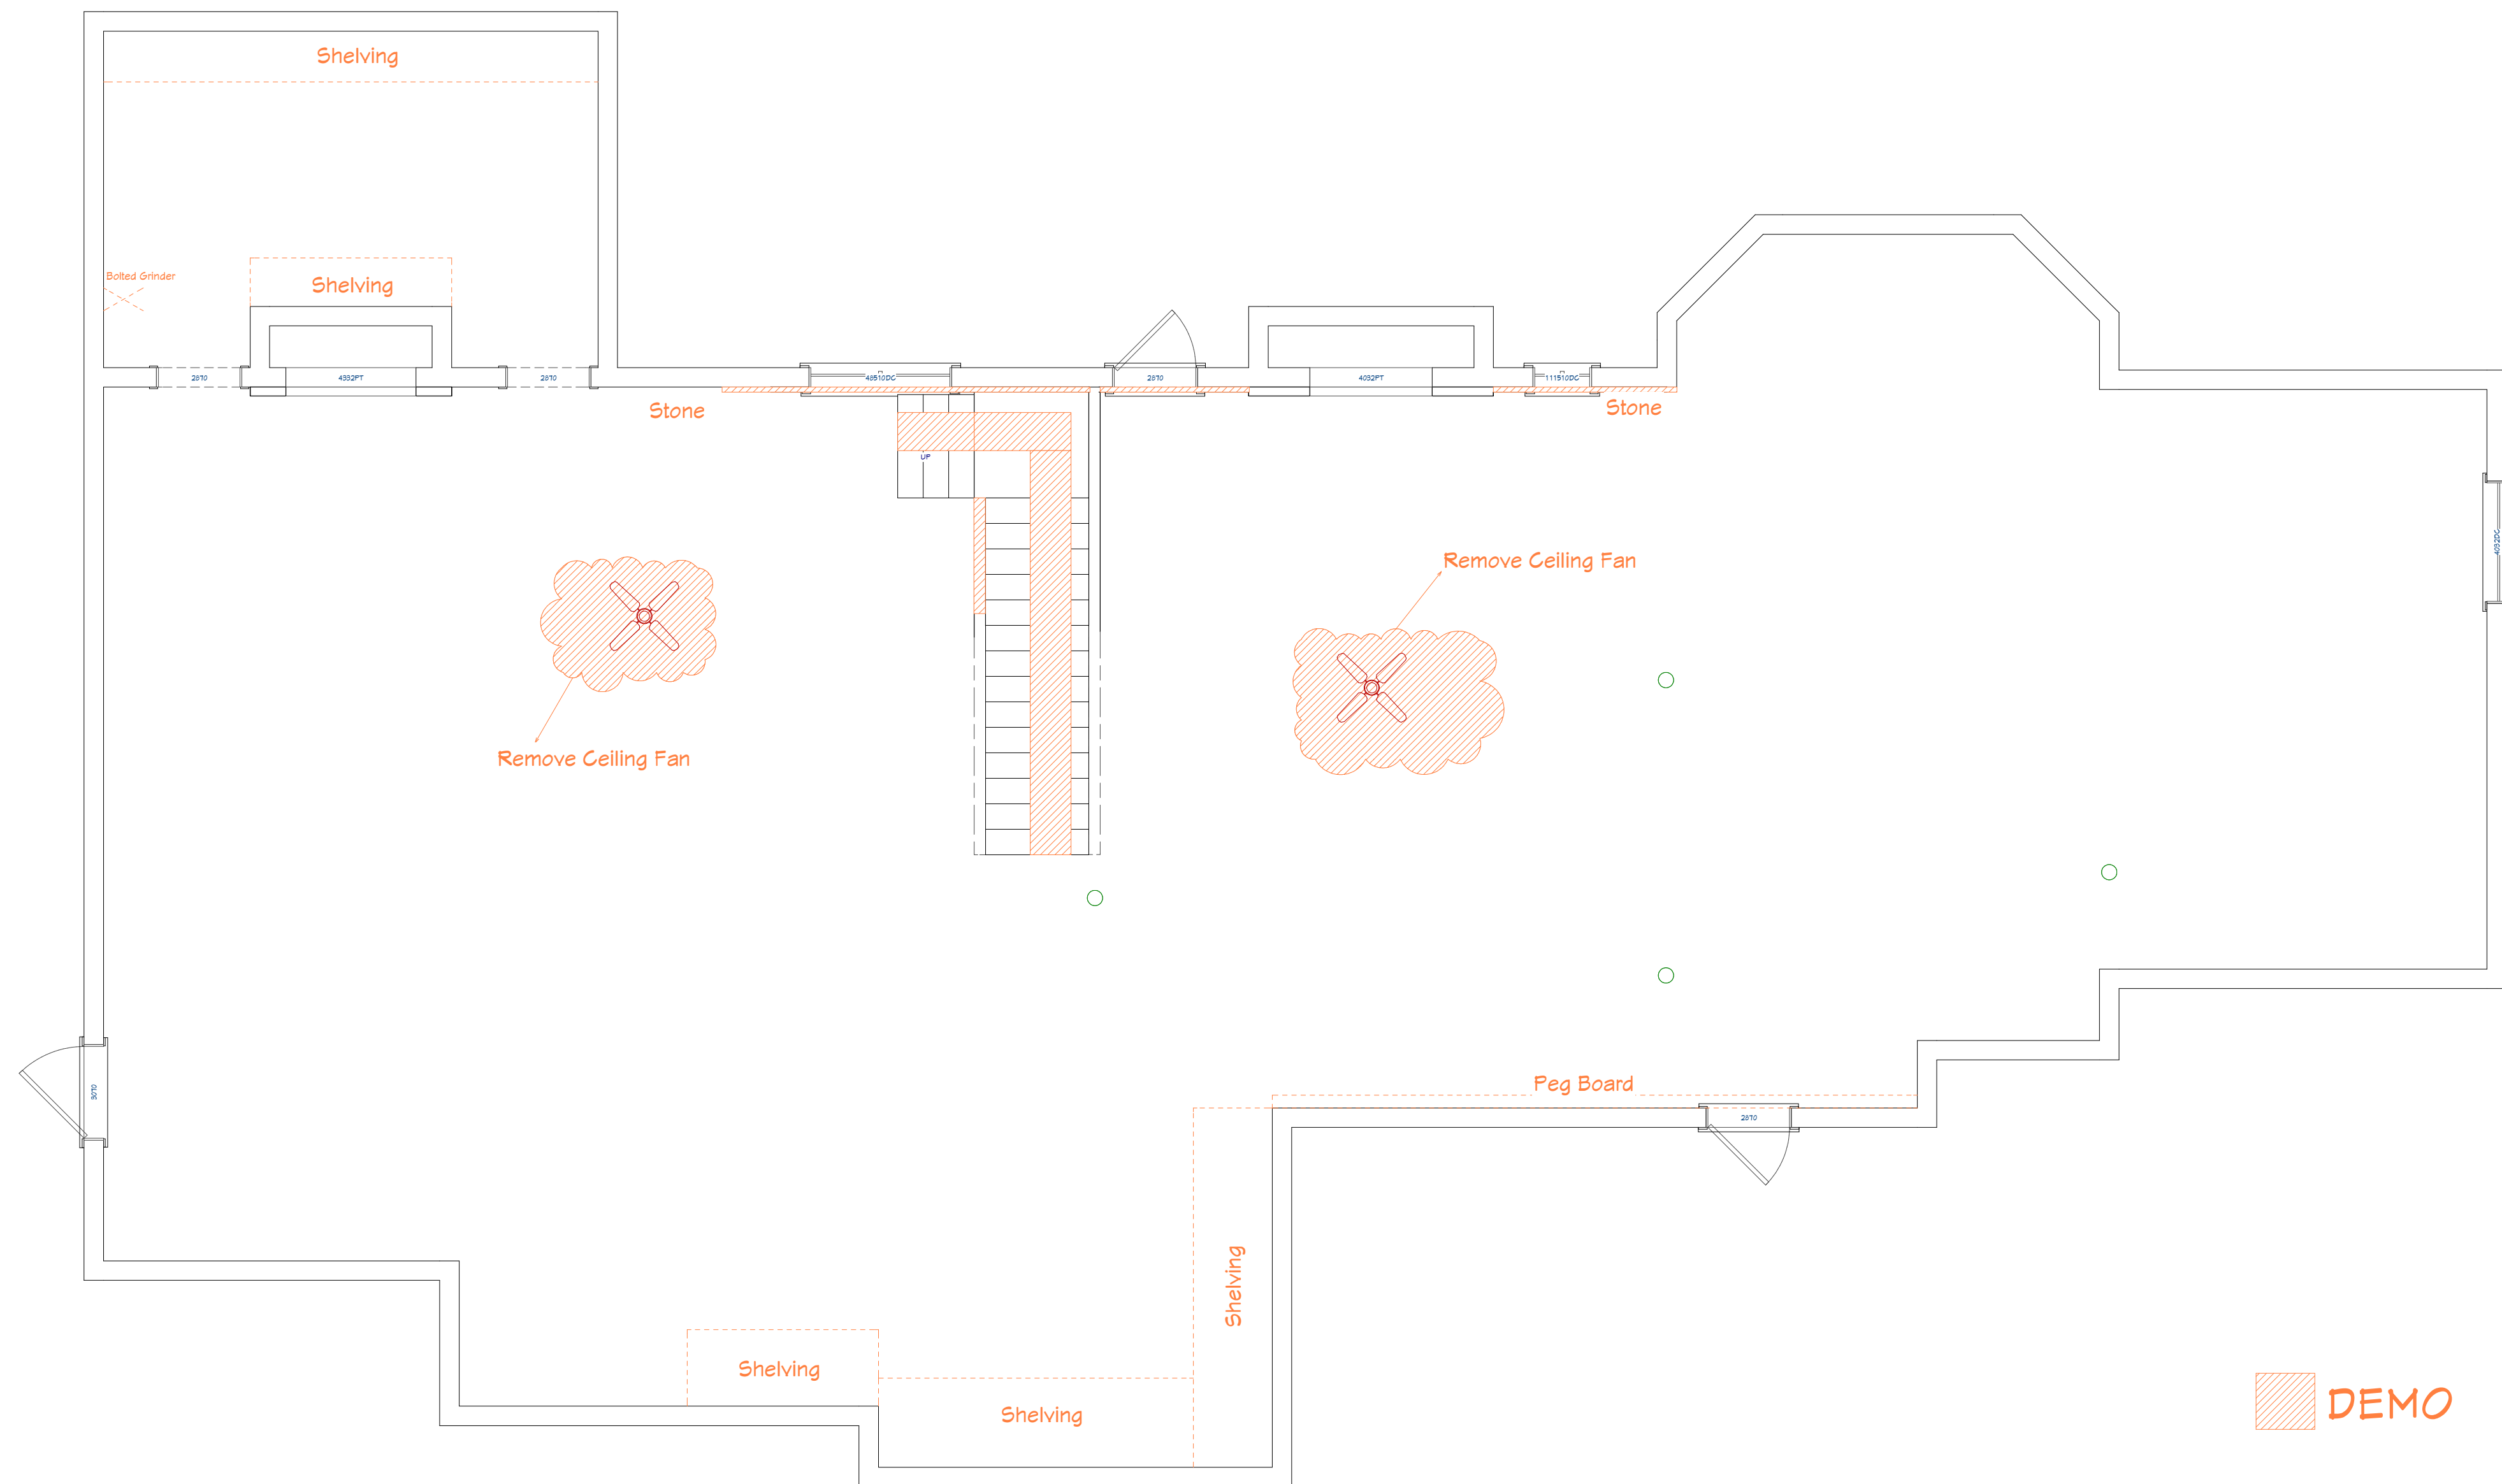

Demo

**NOTICE TO CONTRACTOR**  
 All construction must comply with current NC Building Codes and is subject to field inspection and verification.

**APPROVED**


Limited building only review  
 Permit holder responsible for full compliance with the code

06/16/2020

*Signature*



THIS PLAN HAS BEEN DESIGNED TO MEET OR EXCEED THE 2018 NORTH CAROLINA STATE BUILDING CODE

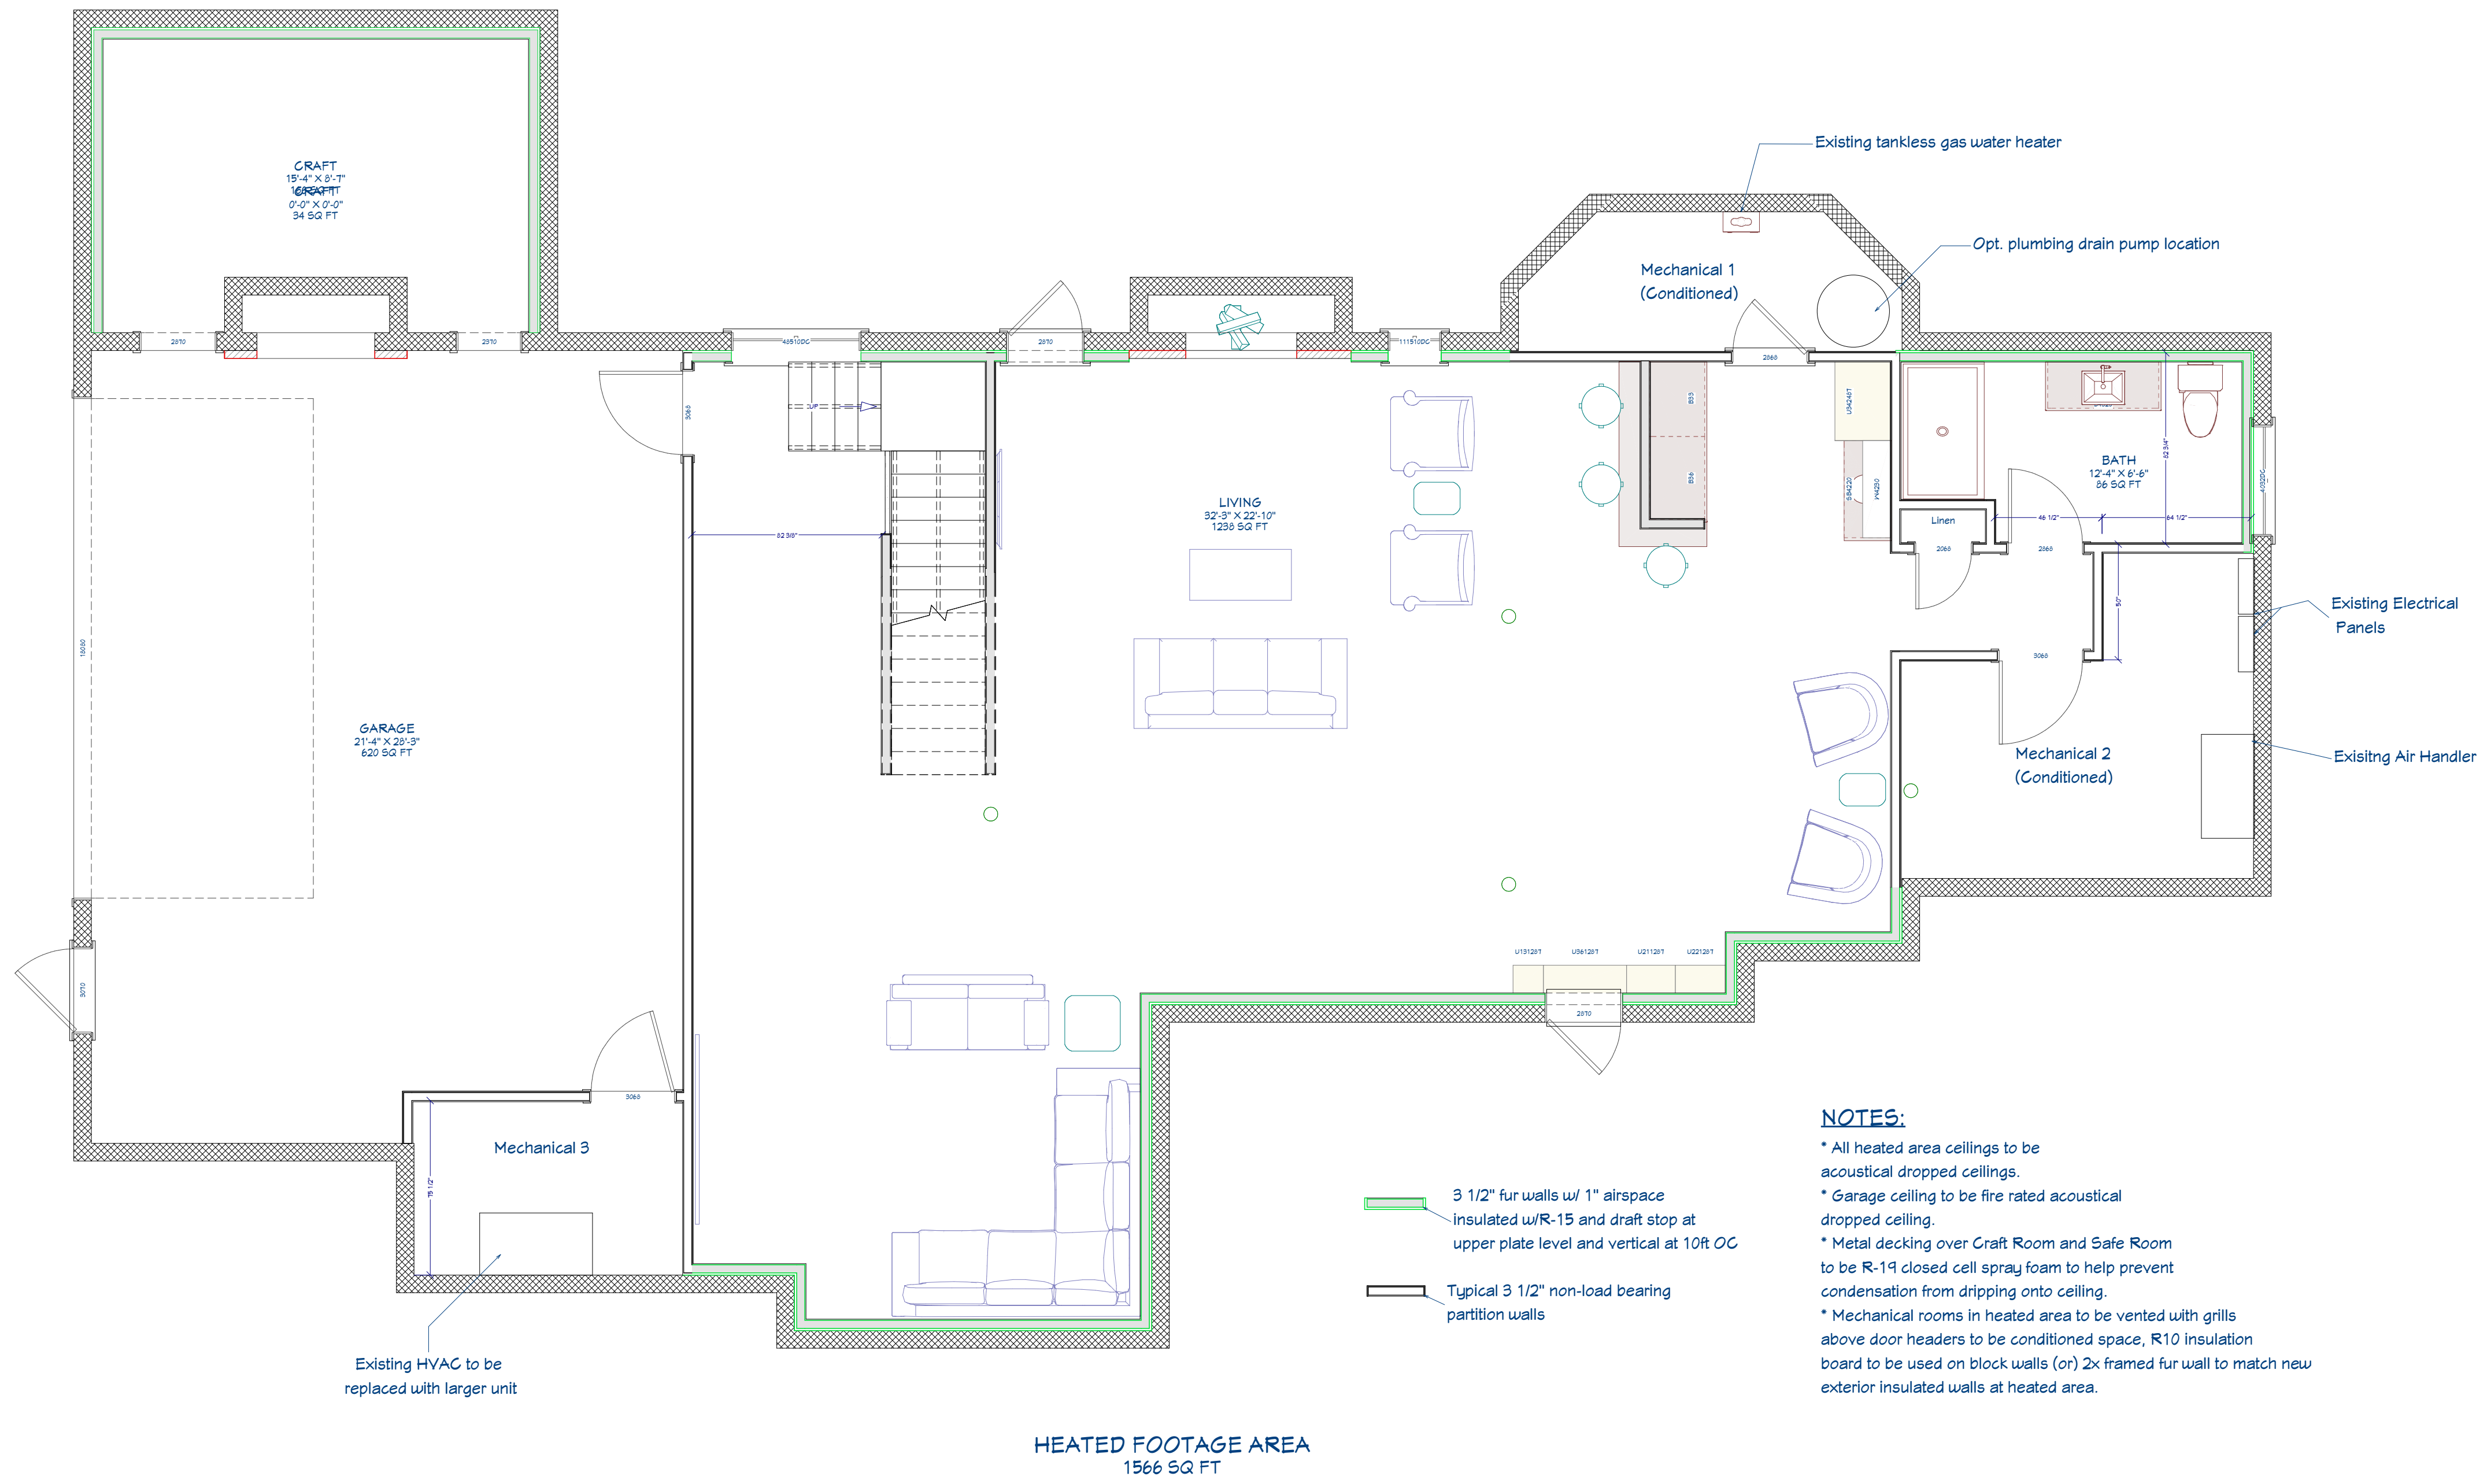


HEATED FOOTAGE AREA  
 1566 SQ FT

1st Floor

- NOTES:**
- \* All heated area ceilings to be acoustical dropped ceilings.
  - \* Garage ceiling to be fire rated acoustical dropped ceiling.
  - \* Metal decking over Craft Room and Safe Room to be R-19 closed cell spray foam to help prevent condensation from dripping onto ceiling.
  - \* Mechanical rooms in heated area to be vented with grills above door headers to be conditioned space, R10 insulation board to be used on block walls (or) 2x framed fur wall to match new exterior insulated walls at heated area.

- 3 1/2" fur walls w/ 1" airspace insulated w/R-15 and draft stop at upper plate level and vertical at 10ft OC
- Typical 3 1/2" non-load bearing partition walls

Wimberly Builders, LLC  
 www.wimberlybuilders.com  
 Tony R Wimberly  
 tony@wimberlybuilders.com  
 (919) 669-7066

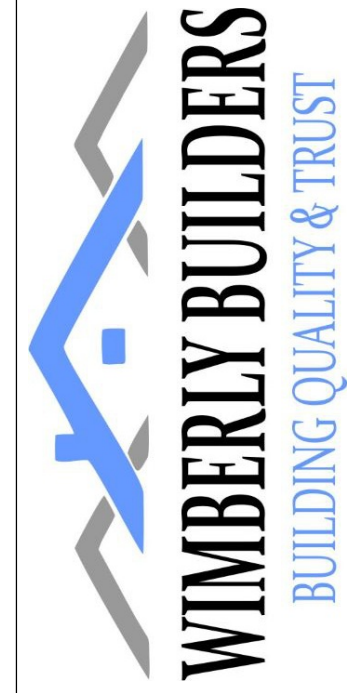

Bloom Basement  
 Remodel

New Plan

Plans Drawn By:  
 Tony R Wimberly  
 twimberly@gmail.com  
 (919) 669-7066

DATE:

6/9/2020

SCALE:

1/4" = 1"

SHEET:

3