
Harnett County Department of Public Health

nameti county bepartment of rubi	1 A to	
Improvement Permit	Permit 247 Kong Charles Ave	
A building permit cannot be issued with only an Improvement Permit		
ISSUED TO: WENDERD LTDGE Properties, The SUBDIVISION KNOTHENGH NEW REPAIR EXPANSION Site Improvements req Type of Structure: 5 W MH Proposed Wastewater System Type: 75% o TENUCTON	m m to LOT # 17 uired prior to Construction Authorization Issuance:	
Projected Daily Flow: 360 GPD		
Number of bedrooms: Number of Occupants: max		
Basement Nes No Pump Required: Yes No May be required based on final location and elevations of facilities		
Pump Required: Yes No May be required based on final location and elevations of facilities Type of Water Supply: Community Public Well Distance from well feet Permit conditions:	Permit valid for: Five years No expiration	
\$ 1 1 1 00 25HS		
Authorized State Agent: Date: 9-38-20 The issuance of this permit by the Health Department in no way guarantees the issuance of other permits. The permit holder is responsible for check site is subject to revocation if the rife plan, plat, or the intended use changes. The Improvement Permit shall not be affected by a change in owner the Laws and Rules for Sewage Treatment and Disposal and to conditions of this permit.	king with appropriate governing bodies in meeting their requirements. This	
Construction Authorization		
(Required for Building Permit)		
The construction and installation requirements of Rules .1950, .1952, .1954, .1955, .1956, .1957, .1958, and .1959 are incorporated by references in with the attached system layout.	(0 -1 ()	
ISSUED TO: WINDERS PLACE Properties, FUC PROPERTY LOCATION: 30 11 SUBDIVISION KNOHEOS Facility Type: SWMH New Expansion Repair	05 McKoy Town RA HVE Lam MHP 101 # 17	
Basement? Yes No Basement Fixtures? Yes No		
Type of Wastewater System** Z5% RODUCTOD Syston	(Initial) Wastewater Flow: GPD	
(See note below, if applicable) (Repair)		
Installation Requirements/Conditions Number of trenches		
Septic Tank Size 1000 gallons Exact length of each trench 160 feet	Trench Spacing: Feet on Center	
Pump Tank Sizegallons Trenches shall be installed on contour at a	Soil Cover:inches	
Maximum Trench Depth of: 18 inches	(Maximum soil cover shall not exceed	
(Trench bottoms shall be level to +/-1/4"	36" above the trench bottom)	
in all directions) Pump Requirements:ft. TDH vsGPM	inches below pipe	
Tump negurementstt. 1011 43tt.	Aggregate Depth:	
Conditions:		
WATER LINES (INCLUDING IRRIGATION) MUST BE 10FT. FROM ANY PART OF SEPTIC SYSTEM OR RINO UTILITIES ALLOWED IN INITIAL OR REPAIR DRAIN FIELD AREA.	EPAIR AREA.	
**If applicable: I understand the system type specified is different from the type specified on the application.	I accept the specifications of this permit.	
Owner/Legal Representative Signature:	Date:	
This Construction Authorization is subject to revocation if the site plan, plat, or the intended use changes. The Construction Authorization shall not be	transferred when there is a change in ownership of the site. This	
Construction Authorization is subject to compliance with the provisions of the Laws and Rules for Sewage Treatment and Disposal and to the condition	in or this permit. SEE MITACRED SHE SKETCH	
	8-28-20	
Construction Authorization Expiration Da	ite: 9-24-25	

Harnett County Department of Public Health Site Sketch

Property Location: 5R 1105 McKoy Town PD 247 KING Charles	5 AVC
Issued To: Wondows Rodge Properties to Subdivision KNO HEAR Mm INITY	Lot # [7]
Authorized State Agen Date: _	8-28-20

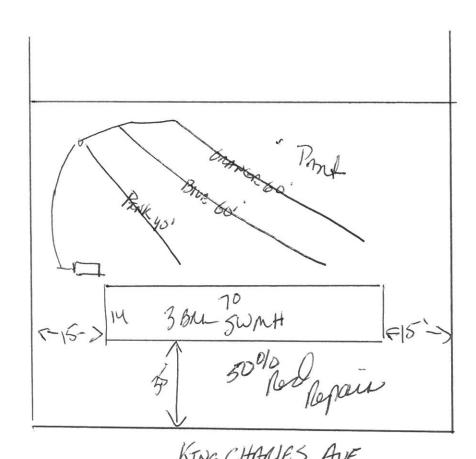

 $\begin{tabular}{ll} KING CHAUES AVE \\ This drawing is for illustrative purposes only. System installation must meet all pertinent laws, rules, and regulations. \\ \end{tabular}$