
Harnett County Department of Public Health

Improvement A building permit cannot be issued with PROPERTY LOCAL PROPERTY	Permit	1951	King Chroles Are	
A building permit cannot be issued with	n only an Improvemen	nt Permit	m 120	
ISSUED TO, WINDING RIDGE Promedies The SUBDIVISION	Knotten	nam mHP	10I # ZD	
MEN [2] METAIN [Site Improvements re	equired prior to Constructio	n Authorization Issuance:	
Type of Structure: SWMH	*			
Proposed Wastewater System Type: 75% 7612 CTCV				
Projected Daily Flow: 360 GPD				
Number of Dedrooms: Number of Occupants: max Basement Yes No				
Pump Required: Yes No May be required based on final location and elevat				
Type of Water Supply: Community Public Well Distance from well		Permit valid	d for: Five years	
Permit conditions:			No expiration	
\$ 1 1025	de des de las estadas participas de la composição de la c			
Authorized State Agent: Date:	7-30-20	0	SEE ATTACHED SITE SKETCH	
The issuance of this permit by the Health Department in no way guarantees the issuance of other permits. The permit	holder is responsible for ch	ecking with appropriate governing	bodies in meeting their requirements. This	
site is subject to revocation if the intended use changes. The Improvement Permit shall not be a the Laws and Rules for Sewage Treatment and Disposal and to conditions of this permit.	fected by a change in own	ership of the site. This permit is	subject to compliance with the provisions of	
Construction Authorization				
(Required for Building	g Permit)			
The construction and installation requirements of Rules . 1950, .1952, .1954, .1955, .1956, .1957, .1958, and .1959 are	incorporated by references	into this permit and shall be me	st. Systems shall be installed in accordance	
with the attached system layout.			King Charles LA	
ISSUED TO: WINDERS Redge Properties, FAC PROPERTY SUBDIVISION Facility Type: SWMH New Expansion	LOCATION: AL	105 McKon	TOWN RAS	
SUBDIVISION	1 KNOHED	chom MHP	LOT # 20	
Facility Type: SWMH New Expansion	on 🗌 Repair)		
Basement? Yes No Basement Fixtures? Yes No				
		(Initial) Wastewater	Flow: 360 GPD	
(See note below, if applicable) 25% / 50% RESOURTED	(Repair)			
Installation Requirements/Conditions Number of trenches 2			á	
Septic Tank Size 1000 gallons Exact length of each trench	BOfeet	Trench Spacing:	Feet on Center	
Pump Tank Sizegallons Trenches shall be installed on cor	ntour at a	Soil Cover:	inches	
Maximum Trench Depth of: _Z	Z > 18 inches	(Maximum soil cover	shall not exceed	
(Trench bottoms shall be level to	+/-1/4"	36" above the tren	ch bottom)	
in all directions)			,	
Pump Requirements:ft. TDH vsGPM		-	inches below pipe	
Conditions:		Aggregate Depth:	inches above pipe // inches total	
			was an altitude country and an account of the second of th	
WATER LINES (INCLUDING IRRIGATION) MUST BE 10FT. FROM ANY PART OF SE	PTIC SYSTEM OR F	REPAIR AREA.		
NO UTILITIES ALLOWED IN INITIAL OR REPAIR DRAIN FIELD AREA.				
**If applicable: / understand the system type specified is different from the type specified	on the application.	I accept the specification	ons of this permit.	
Owner/Legal Representative Signature:		Date:		
This Construction Authorization is subject to revocation if the site plan, plat, or the intended use changes. The Construction Authorization shall not be transferred when there is a change in ownership of the site. This				
Construction Authorization is subject to compliance with the provisions of the Laws and Rules for Sewage Treatment and Disposal and to the conditions of this permit.				
Authorized State Agent: Jones & Manhan & The	NBAS Date:	7-30-20		
Construction Authorization Expiration Date: 7-30:25				

Application # BULS 2007-0035

Harnett County Department of Public Health Site Sketch

185 KING Charle	Ave
Property Location: 5/2 1105 mckoy Town Po	
Issued To: Wondows Ridge Properties to Subdivision Knottanton InI+	Lot # 20
Authorized State Agent James & Manhant TISHS Date	: 7-30-20

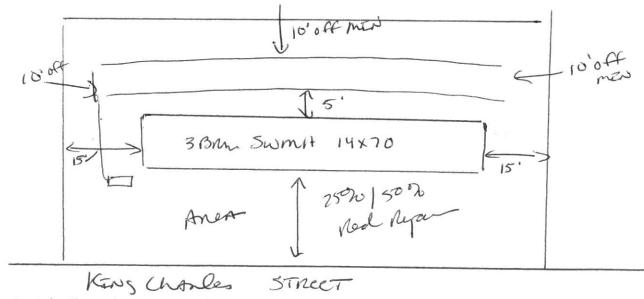

This drawing is for illustrative purposes only. System installation must meet all pertinent laws, rules, and regulations.