
Harnett County Department of Public Health

	Improvement Permit	165 KENS	Charles Ave
	A building permit cannot be issued with only an Improveme	nt Permit	
NEW REPAIR DE EXPA	openes, Inc subdivision Knothing	5 McKoy Town is Nam MH? equired prior to Construction Authori	LOT # 21
Proposed Wastewater System Type: 75% 70.	CUSTOUNIE	The second control of	
	Occupants:bmax		
	required based on final location and elevations of facilities c	Permit valid for:	Five years No expiration
A 100 T 27 27 27 20 00 00 000 000 000 000 000 0	M Langes		
Authorized State Agent:	Date: 7-30.2		CHED SITE SKETCH
site is subject to revocation if the are plan, plat, or the intended the Laws and Rules for Sewage Treatment and Disposal and to con	uarantees the issuance of other permits. The permit holder is responsible for cl use changes. The Improvement Permit shall not be affected by a change in ow ditions of this permit.	necking with appropriate governing bodies in a nership of the site. This permit is subject to c	meeting their requirements. This ompliance with the provisions of
Construction Authorization			
The construction and installation and in	(Required for Building Permit)		
with the attached system layout.	2, .1954, .1955, .1956, .1957, .1958, and .1959 are incorporated by reference	into this permit and shall be met. Systems s	hall be installed in accordance CAA-Oes AV-C
ISSUED TO: WINDLING Ridge Pro	pecties, FAC PROPERTY LOCATION: SA 1 SUBDIVISION KNOHTO		
Facility Type: DWMH	New Expansion Repair) prize mili	
	Fixtures? Yes No		
	DUCTUS System	(Initial) Wastewater Flow: _	360 GPD
(See note below, if applicable [])	16 RESSULTION (Repair)		
Installation Requirements/Conditions	Number of trenches Z		
Septic Tank Size 1000 gallons	Exact length of each trench 80 feet	Trench Spacing:	Feet on Center
Pump Tank Sizegallons	Trenches shall be installed on contour at a	10 1 10 10 10 10 10 10 10 10 10 10 10 10	ches
	Maximum Trench Depth of: 22-18 inches	(Maximum soil cover shall no	
	(Trench bottoms shall be level to +/-1/4" in all directions)	36" above the trench bottor	m)
Pump Requirements:ft. TDH vs	GPM	6	inches below pipe
Conditions:		Aggregate Depth: 2	inches above pipe inches total
WATER LINES (INCLUDING IRRIGATION) MILE	T DE 10ET EDOM ANY DADT OF CENTIC CYCTEM OD	DEDAID ADEA	and the same of th
NO UTILITIES ALLOWED IN INITIAL OR REPAIR	T BE 10FT. FROM ANY PART OF SEPTIC SYSTEM OR I R DRAIN FIELD AREA.	KEPAIK AKEA.	
**If applicable: 1 understand the system type specifi	fied is different from the type specified on the application	I accept the specifications of this	s permit.
Owner/Legal Representative Signature: Date:			
This Construction Authorization is subject to revocation if the site plan, plat, or the intended use changes. The Construction Authorization shall not be transferred when there is a change in ownership of the site. This Construction Authorization is subject to compliance with the provisions of the Laws and Rules for Sewage Treatment and Disposal and to the conditions of this permit. SEE ATTACHED SITE SKETCH			
The state of the s	Manhan FER REAS Date:		3343456444555555543.30.40.40044555666655555444556666666666666
-/)	Construction Authorization Evoluation D		<u>-</u>

Harnett County Department of Public Health Site Sketch

165 KENG Charles Ave

Property Location: SR 1105 McKoy Town Po Issued To: Wondows Rodge Properties to Subdivision Knottensform INI+P Date: 7-30-20

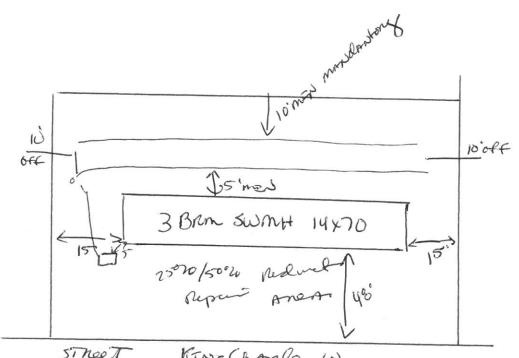

This drawing is for illustrative purposes only. System installation must meet all pertinent laws, rules, and regulations.