




ROOF PLAN
SCALE: 1/8" = 1'-0"

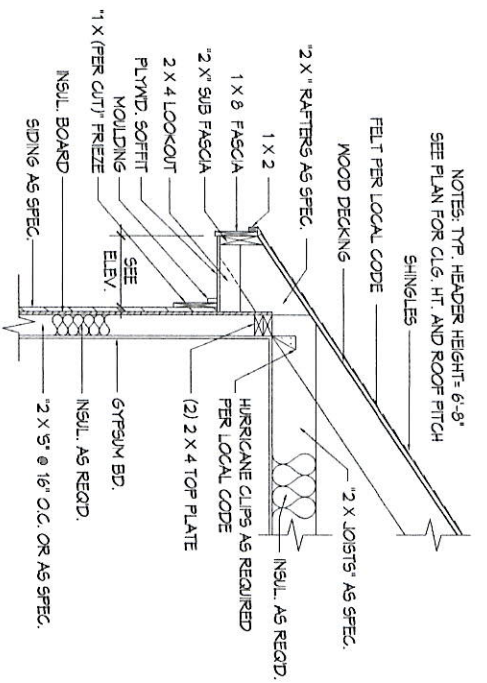


TYPICAL CORNICE DETAIL W/ SIDING
NO SCALE

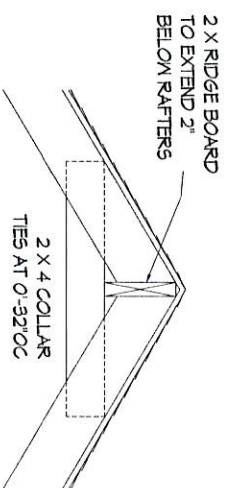


TYPICAL RIDGE BOARD / BRACING
NO SCALE

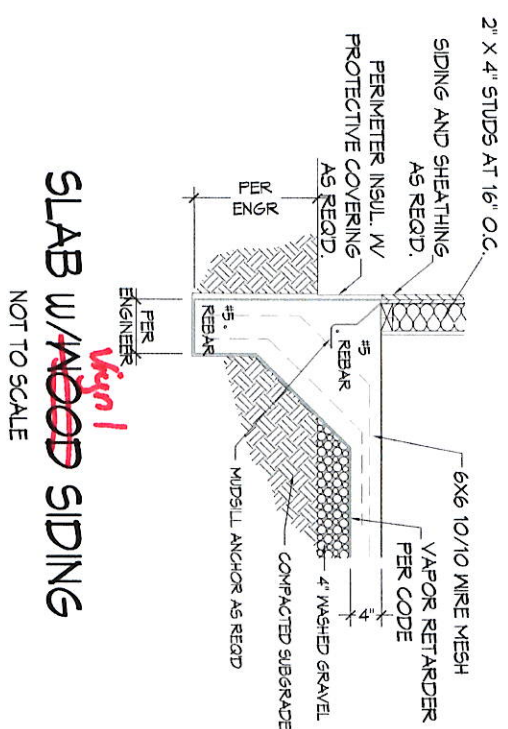

SLAB W/ WOOD SIDING
NOT TO SCALE

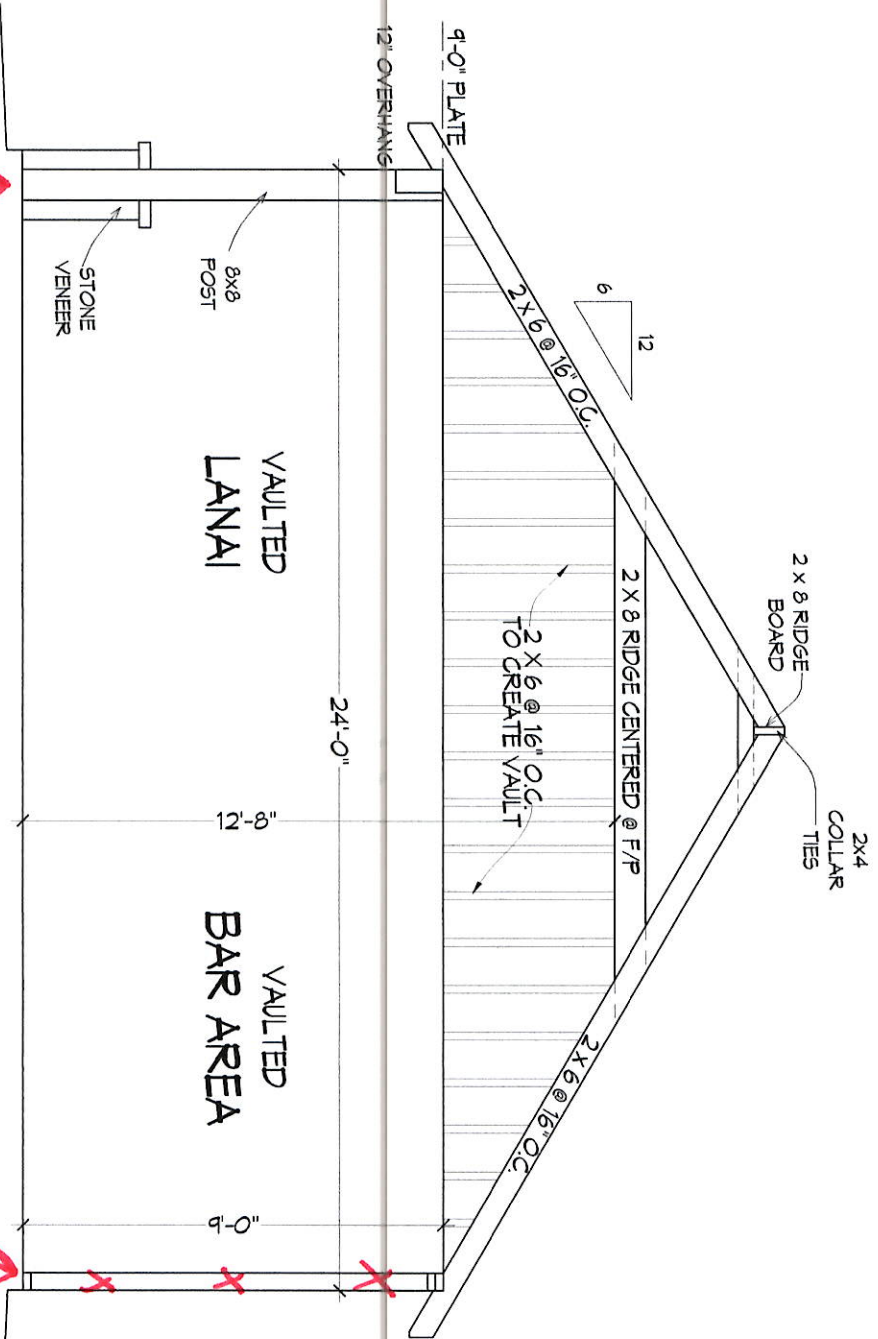

MAIN BODY SECTION
SCALE: 1/4" = 1'-0"

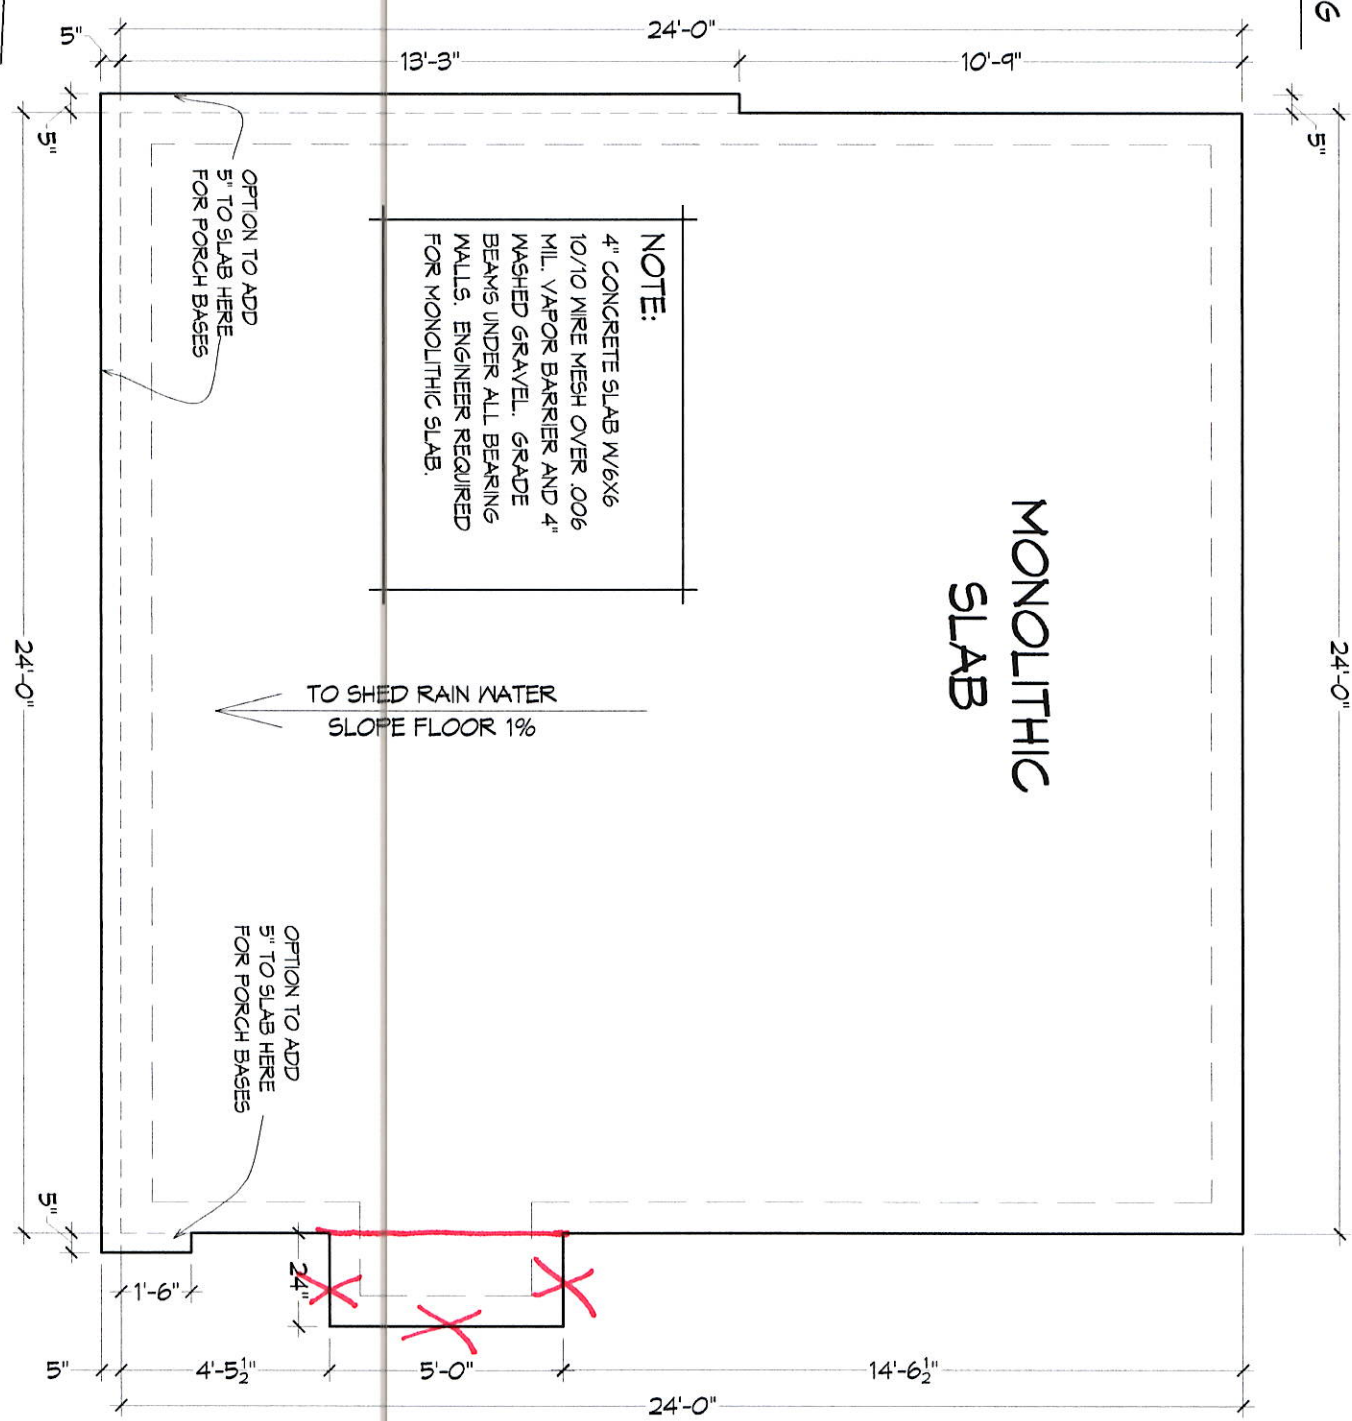

MONOLITHIC SLAB

NOTE:
4" CONCRETE SLAB W/ 6X6 10/10 WIRE MESH OVER .006 MIL. VAPOR BARRIER AND 4" WASHED GRAVEL. GRADE BEAMS UNDER ALL BEARING WALLS. ENGINEER REQUIRED FOR MONOLITHIC SLAB.

TO SHED RAIN WATER
SLOPE FLOOR 1%

OPTION TO ADD 5" TO SLAB HERE FOR PORCH BASES

OPTION TO ADD 5" TO SLAB HERE FOR PORCH BASES

FOUNDATION PLAN
SCALE: 1/4" = 1'-0"

NOTES: TYP. HEADER HEIGHT= 6'-9"
SEE PLAN FOR CLG. HT. AND ROOF FITCH
SHINGLES

FOR	SCALE	DATE	FILE
PLAN NAME	As Shown	9-21-18	
PLAN NO.	DRAWN BY	SHEET #	
0586-PH A Poolhouse	MIGUEL P./ STEVE V.	1	



© Copyright by Legacy Home Plans LLC
REPRODUCTION OF ANY PORTION OF THESE DRAWINGS FOR ANY PURPOSE IS STRICTLY PROHIBITED. THESE DRAWINGS ARE SOLELY FOR USE IN THE CONSTRUCTION OF ONE DWELLING ONLY AND ANY FURTHER USE WITHOUT THE EXPRESS PERMISSION OF LEGACY HOME PLANS LLC IS PROHIBITED. THESE DRAWINGS HAVE BEEN PREPARED TO MEET THE TOP PROFESSIONAL STANDARDS AND PRACTICES. HOWEVER, LOCAL VARIATIONS MAY REQUIRE CHANGES. ALWAYS BUILDING CODE REQUIREMENTS MAY VARY WITH LOCATION AND CHANGE FROM TIME TO TIME. BEFORE STARTING CONSTRUCTION, THE BUILDER MUST REVIEW AND BE RESPONSIBLE FOR ALL DETAILS AND CONDITIONS AND INSURE THAT THESE PLANS MEET ALL CURRENT GOVERNMENTAL REQUIREMENTS IN YOUR AREA. AN ENGINEER IS REQUIRED FOR ALL CONSTRUCTION. TOTAL LIABILITY OF LEGACY HOME PLANS, LLC NOT TO EXCEED THE COST OF ORIGINAL PLANS.

Legacy HOME PLANS
PLANS YOU CAN BUILD YOUR LEGACY ON
5690 SUMMER AVENUE MEMPHIS, TENNESSEE (901)754-9874

MEMBER
A I B D
AMERICAN INSTITUTE OF BUILDING DESIGN

ELECTRICAL PLAN


SCALE: 1/4" = 1'-0"

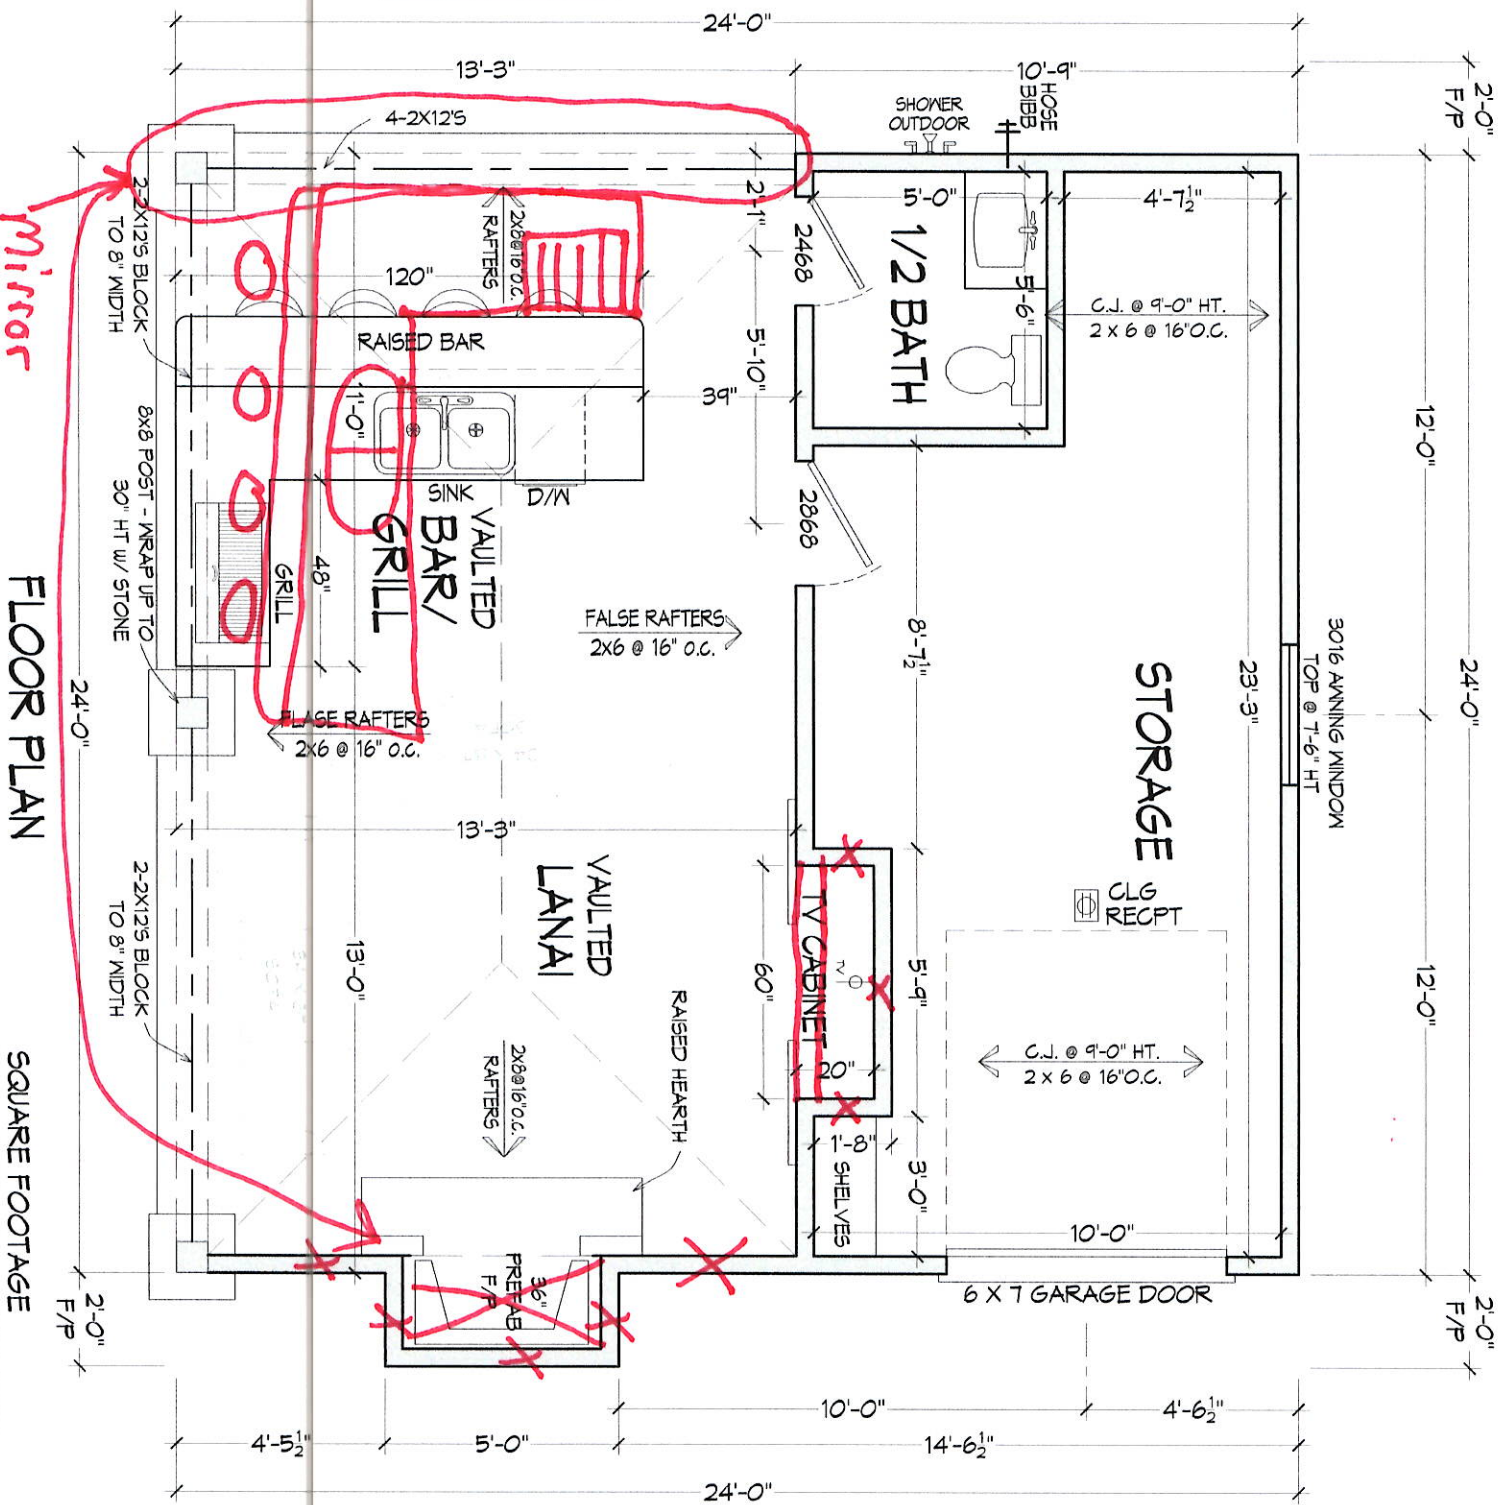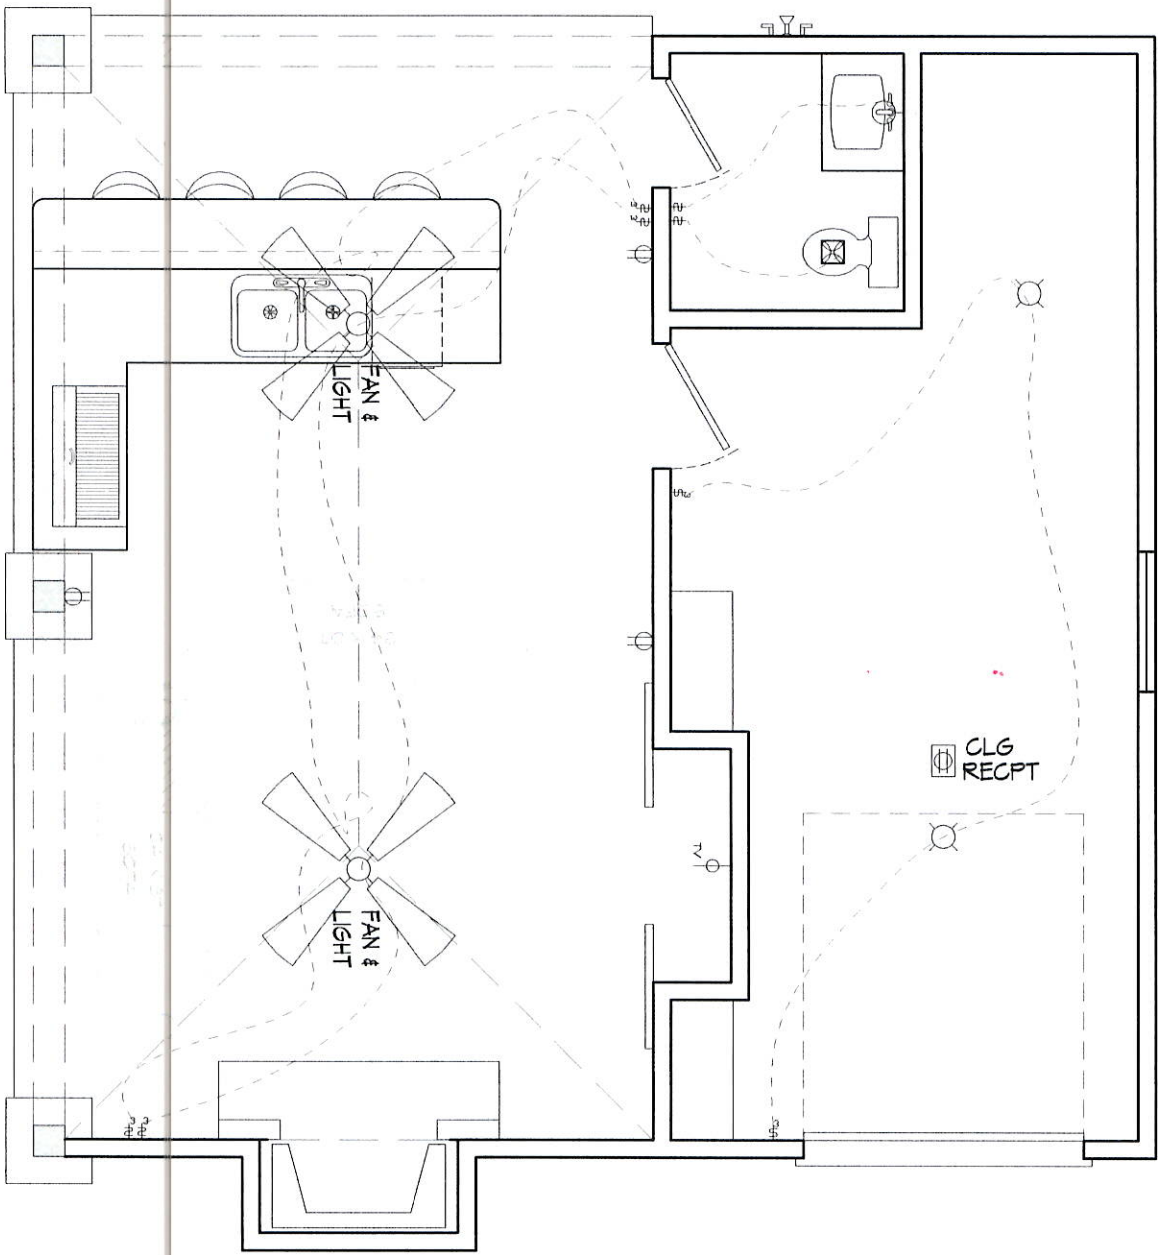

FLOOR PLAN


SCALE: 1/4" = 1'-0"

SQUARE FOOTAGE
 347 OPEN COVERED AREA
 36 BATH
 203 STORAGE
 586 TOTAL UNHEATED

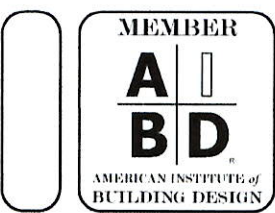


© Copyright by Legacy Home Plans LLC
 REPRODUCTION OF ANY PORTION OF THESE DRAWINGS FOR ANY PURPOSE IS STRICTLY PROHIBITED. THESE DRAWINGS ARE SOLD FOR USE IN THE CONSTRUCTION OF ONE DWELLING ONLY AND ANY FURTHER USE, WITHOUT THE EXPRESS PERMISSION OF LEGACY HOME PLANS, LLC IS PROHIBITED. THESE DRAWINGS HAVE BEEN PREPARED TO MEET THE TOP PROFESSIONAL STANDARDS AND PRACTICES. HOWEVER, LOCAL VARIATIONS MAY REQUIRE CHANGES. UNLESS SPECIFIC CODE REQUIREMENTS VARY WITH LOCATION AND CHANGE FROM TIME TO TIME, BEFORE STARTING CONSTRUCTION, THE BUILDER MUST REVIEW AND BE RESPONSIBLE FOR ALL LOCAL AND CURRENT GOVERNMENTAL REQUIREMENTS IN YOUR AREA. AN ENGINEER IS REQUIRED FOR ALL CONSTRUCTION. TOTAL LIABILITY OF LEGACY HOME PLANS, LLC NOT TO EXCEED THE COST OF ORIGINAL PLANS.

EOR PLAN NAME PLAN NO. 0586-PH A Poolhouse	SCALE As Shown	DATE 9-21-18	FILE SHEET # 2
DRAWN BY MIGUEL P./ STEVE V.			

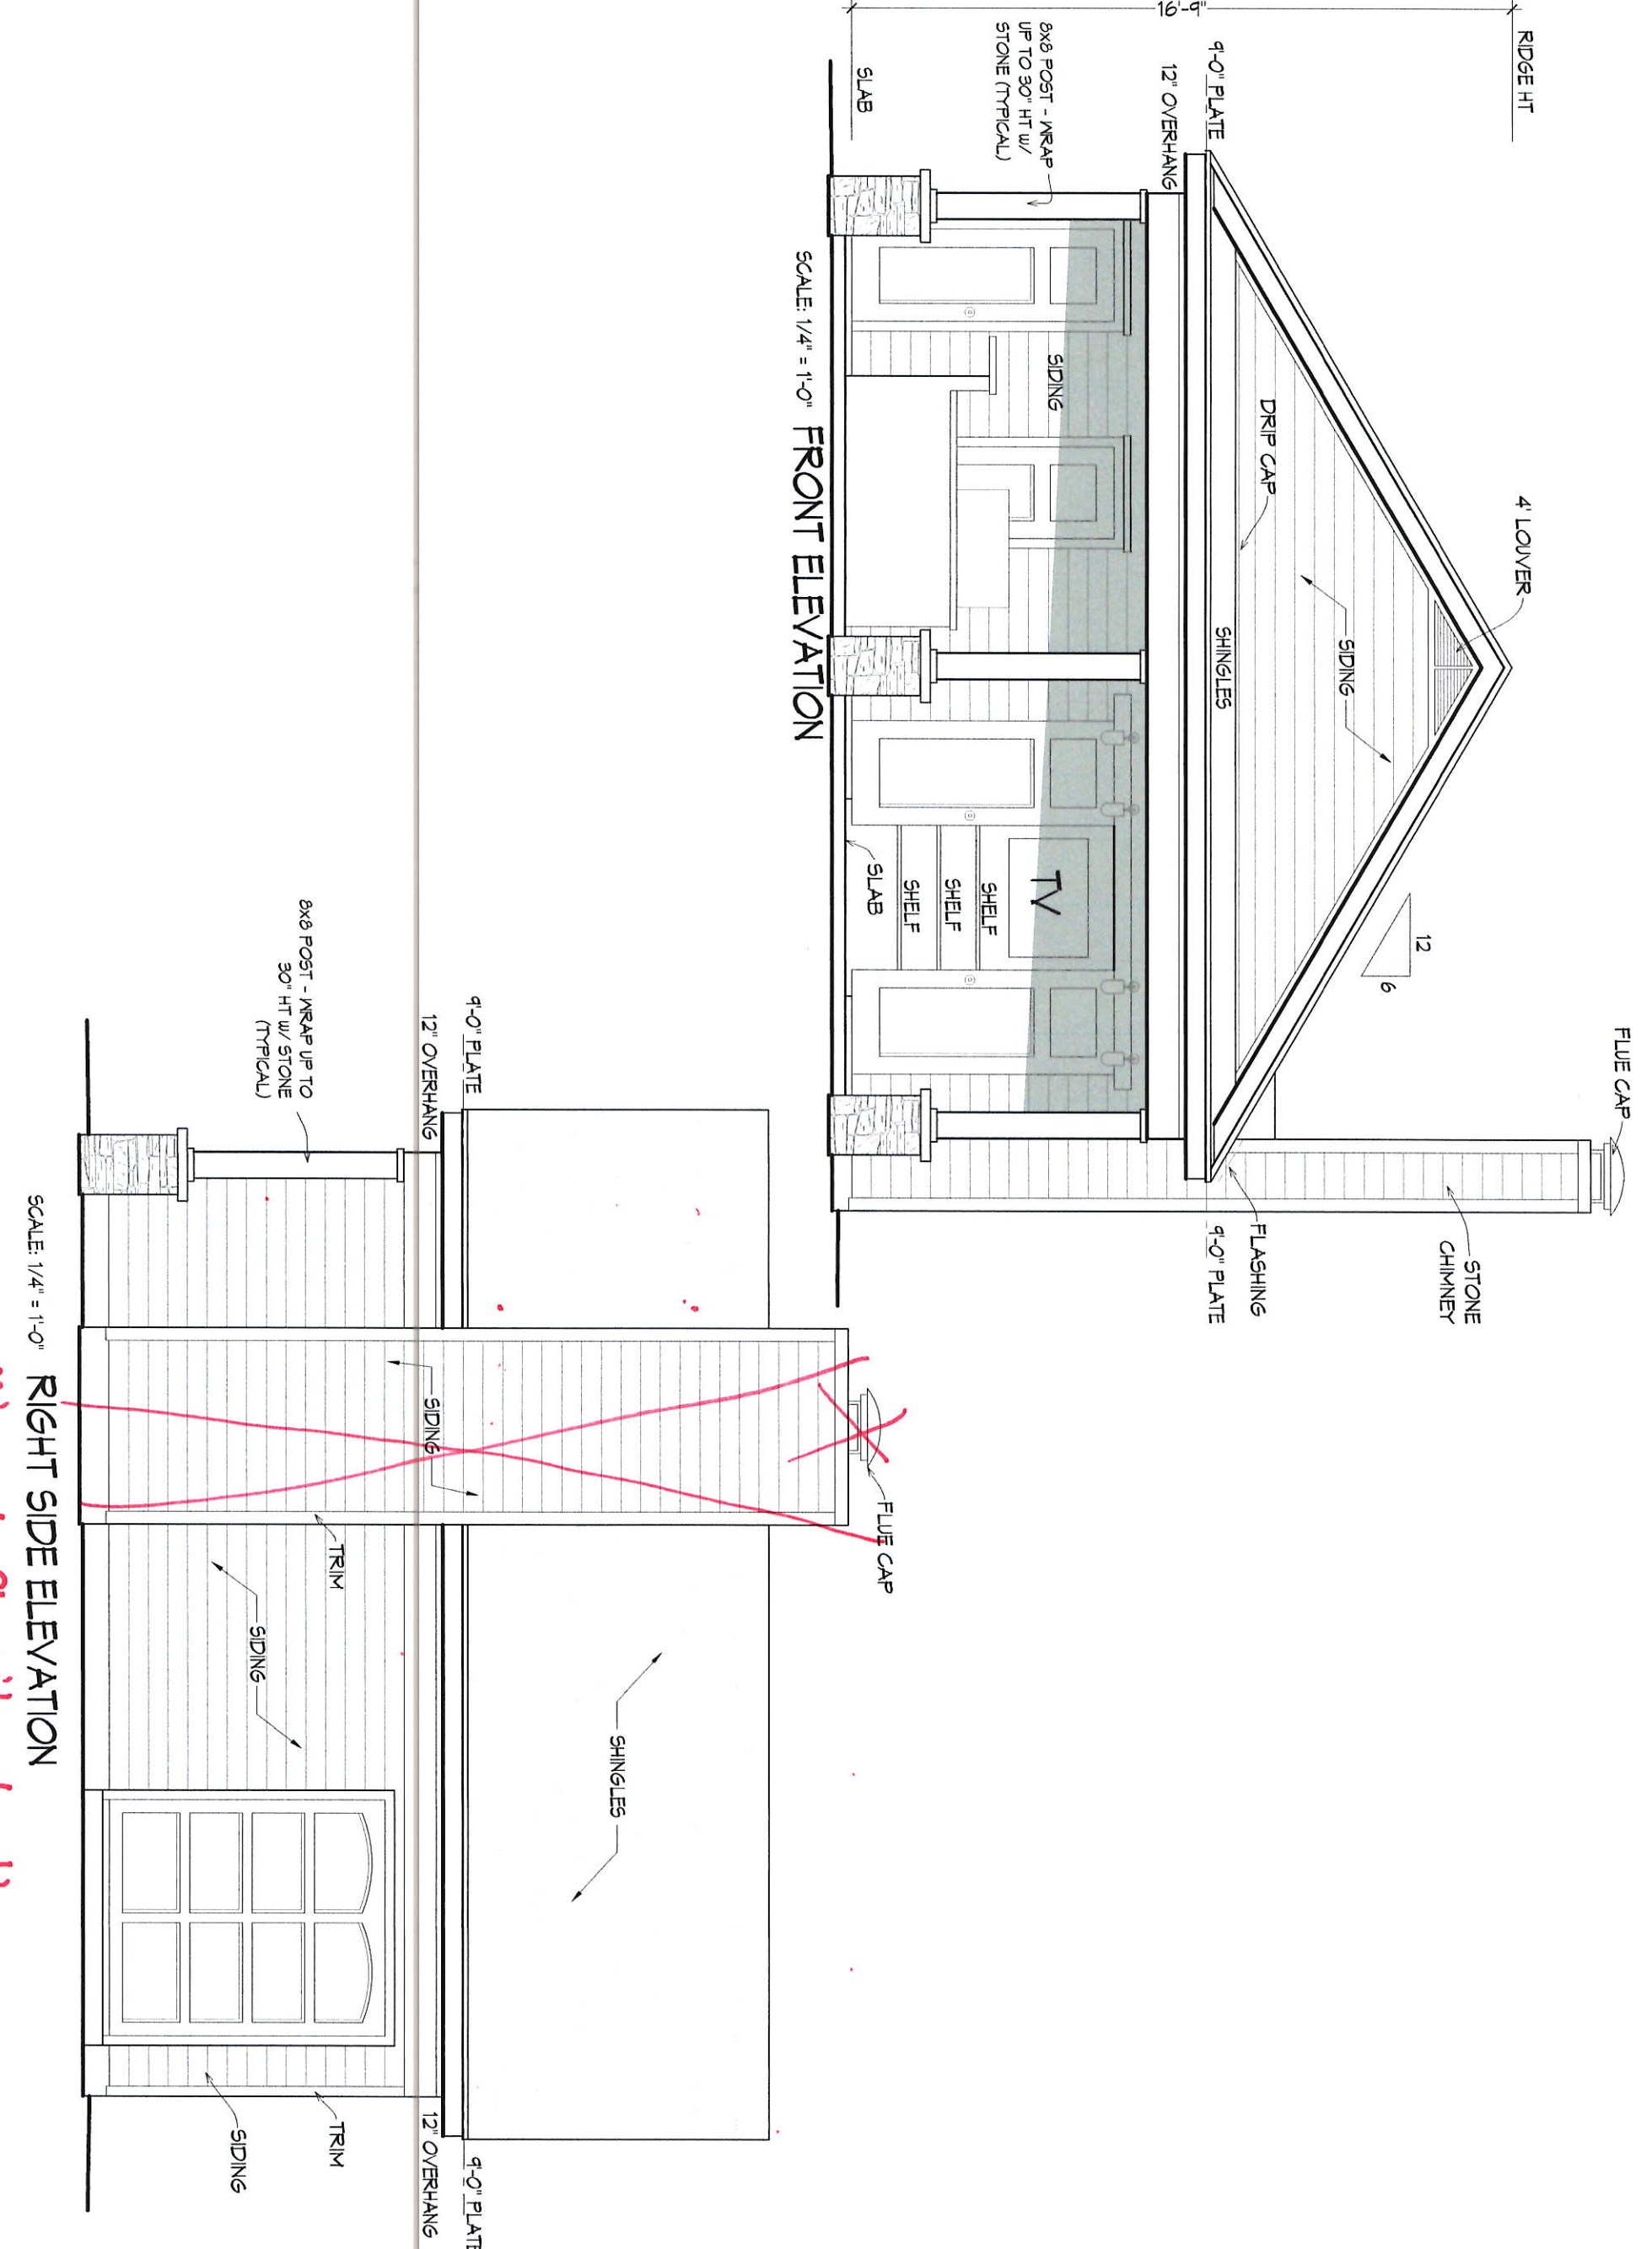


Minor Left side elevation

SCALE: 1/4" = 1'-0" RIGHT SIDE ELEVATION

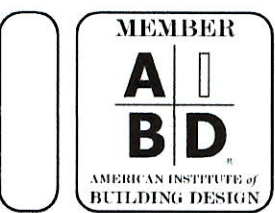


© Copyright by Legacy Home Plans LLC
 REPRODUCTION OF ANY PORTION OF THESE DRAWINGS FOR ANY PURPOSE IS STRICTLY PROHIBITED. THESE DRAWINGS ARE SOLD FOR USE IN THE CONSTRUCTION OF ONE DWELLING ONLY AND ANY FURTHER USE WITHOUT THE EXPRESS PERMISSION OF LEGACY HOME PLANS LLC IS PROHIBITED. THESE DRAWINGS HAVE BEEN PREPARED TO MEET THE TOP PROFESSIONAL STANDARDS AND PRACTICES. HOWEVER, LOCAL VARIATIONS MAY REQUIRE CHANGES. LIKEWISE BUILDING CODE REQUIREMENTS MAY VARY WITH LOCATION AND CHANGE FROM TIME TO TIME. BEFORE STARTING CONSTRUCTION, THE BUILDER MUST REVIEW AND BE RESPONSIBLE FOR ALL LOCAL AND CURRENT GOVERNMENTAL REQUIREMENTS IN YOUR AREA. AN ENGINEER IS REQUIRED FOR ALL CONSTRUCTION. TOTAL LIABILITY OF LEGACY HOME PLANS LLC NOT TO EXCEED THE COST OF ORIGINAL PLANS.


FOR	SCALE	DATE	FILE
PLAN NAME	As Shown	9-21-18	
PLAN NO.	DRAWN BY	SHEET #	
0586-PH A Poolhouse	MIGUEL P./ STEVE V.	3	

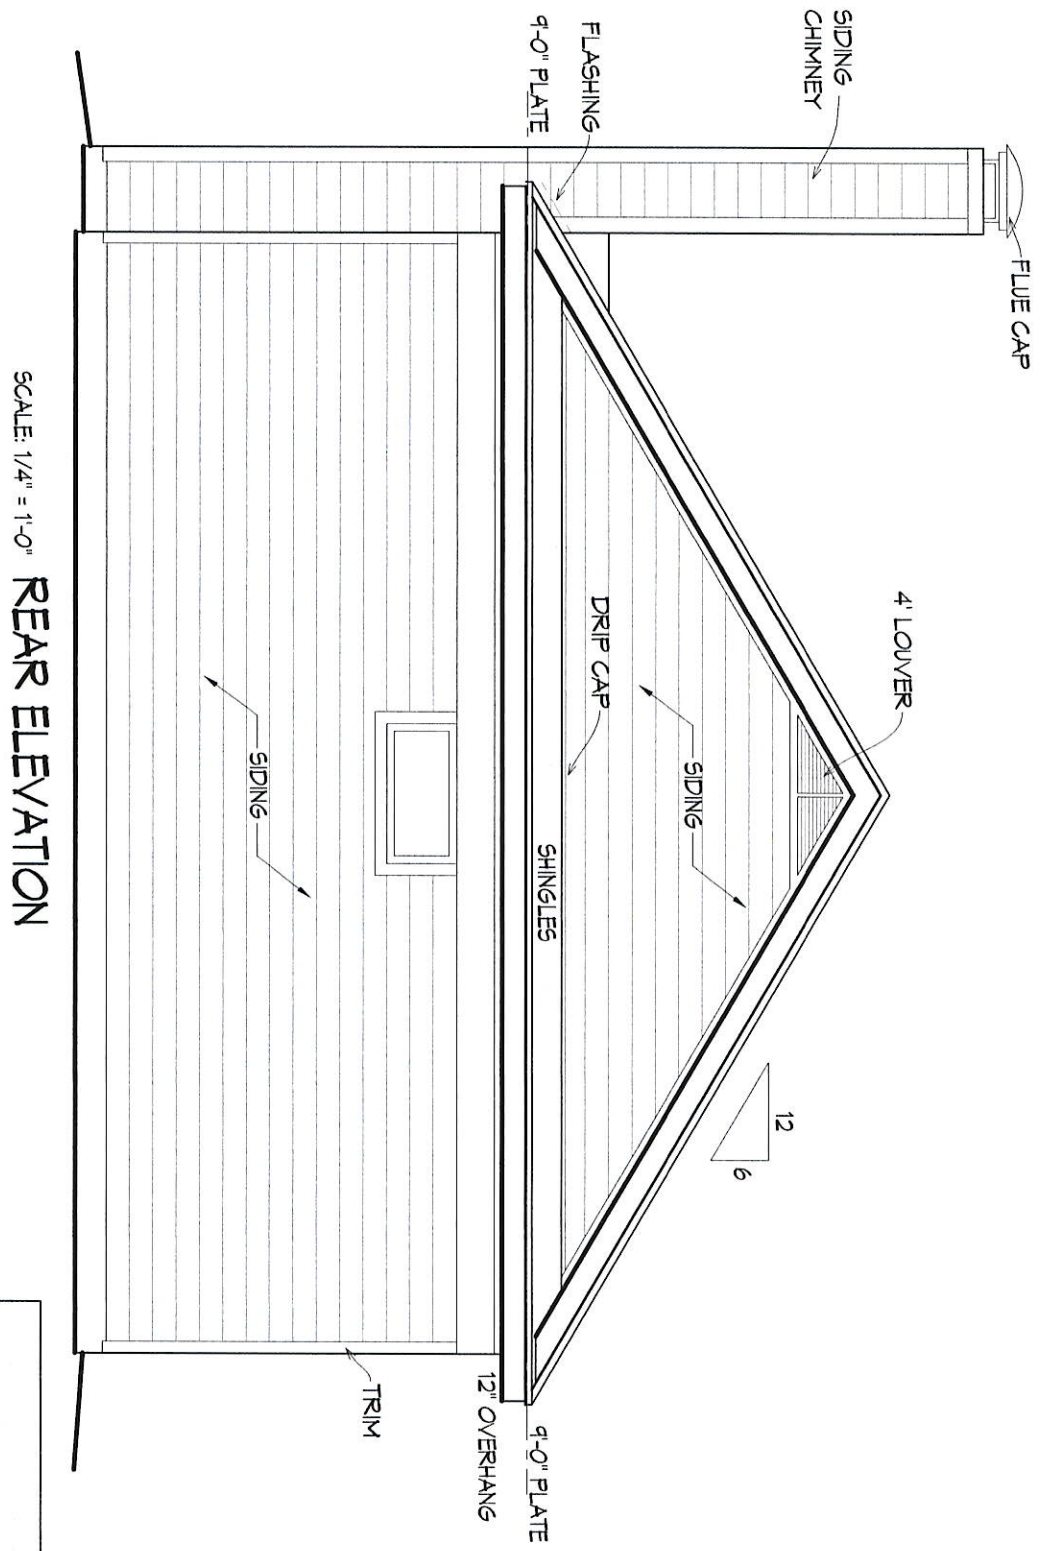

SCALE: 1/4" = 1'-0" REAR ELEVATION

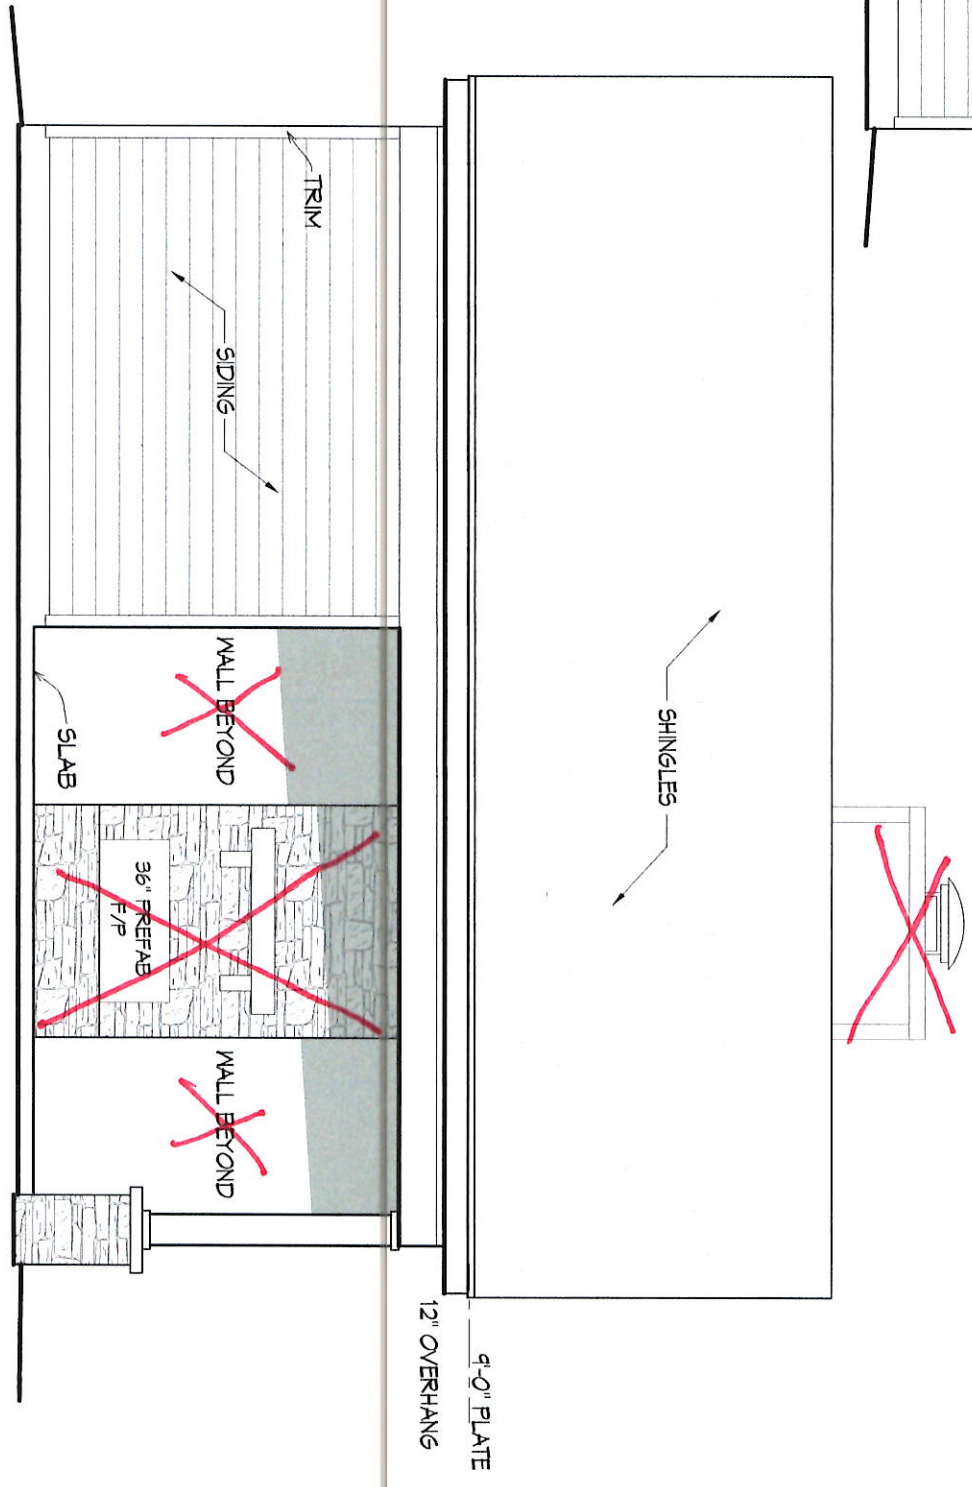

SCALE: 1/4" = 1'-0" LEFT SIDE ELEVATION

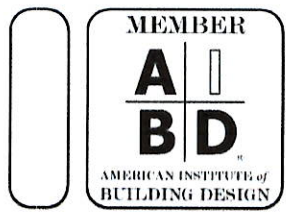

© Copyright by Legacy Home Plans LLC
 REPRODUCTION OF ANY PORTION OF THESE DRAWINGS FOR ANY PURPOSE IS STRICTLY PROHIBITED. THESE DRAWINGS ARE SOLD FOR USE IN THE CONSTRUCTION OF ONE DWELLING ONLY AND ANY FURTHER USE WITHOUT THE EXPRESS PERMISSION OF LEGACY HOME PLANS LLC IS PROHIBITED. THESE DRAWINGS HAVE BEEN PREPARED TO MEET THE TOP PROFESSIONAL STANDARDS AND PRACTICES. HOWEVER, LOCAL VARIATIONS MAY REQUIRE CHANGES. LICENSE BUILDING CODE REQUIREMENTS MAY VARY WITH LOCATION AND CHANGE FROM TIME TO TIME. BEFORE STARTING CONSTRUCTION, THE BUILDER MUST REVIEW AND BE RESPONSIBLE FOR ALL DETAILS AND SPECIFICATIONS, AND INSURE THAT THESE PLANS MEET ALL CURRENT GOVERNMENTAL REQUIREMENTS IN YOUR AREA. AN ENGINEER IS REQUIRED FOR ALL CONSTRUCTION. TOTAL LIABILITY OF LEGACY HOME PLANS LLC NOT TO EXCEED THE COST OF ORIGINAL PLANS.

EDR PLAN NAME PLAN NO. 0586-PH A Poolhouse	SCALE As Shown	DATE 9-21-18	FILE SHEET # 4
DRAWN BY MIGUEL P./ STEVE V.			