

7722 Hwy 27 W Lillingston

Description of Work

Building - Demo 2 walls in existing master bath

- Demo steps in garage to accommodate new $11\frac{1}{2} \times 10\frac{1}{2}$ Addition.

- Install new walls in master bath

- Install walls in garage for laundry, walk in closet, and storage room.

- Install wall for entry door and new 10' garage door.


Elect. - Rewire existing house, Change service from 100A to 200A. Install new wiring for addition

HVAC - Install new 3 ton heat pump system

Plumbing - Install new water lines/waste lines.


Install plumbing in new bath and laundry

Building - Insulate, Dry wall, paint where needed

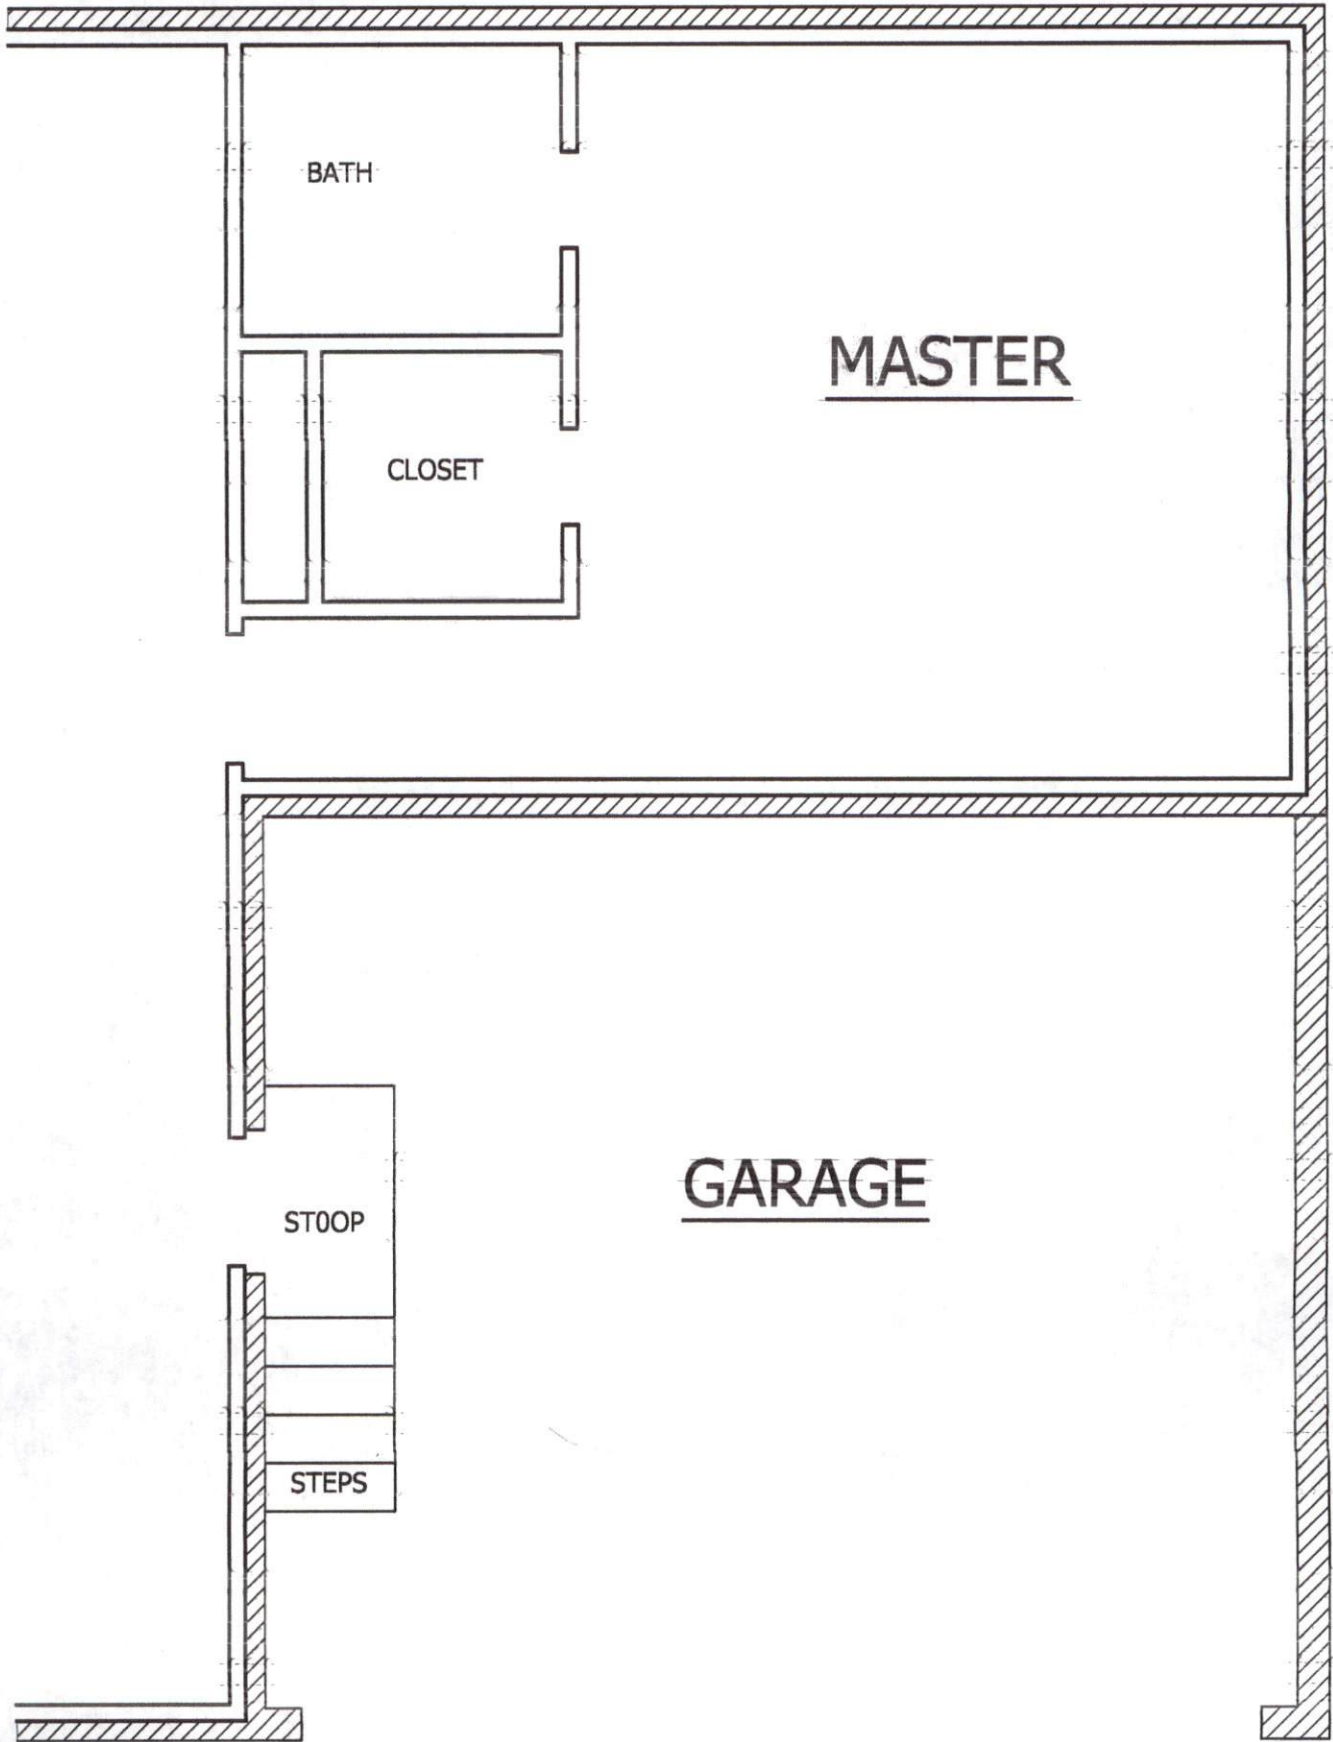

AS BUILTS

SCALE: 1/4"=1'-0"

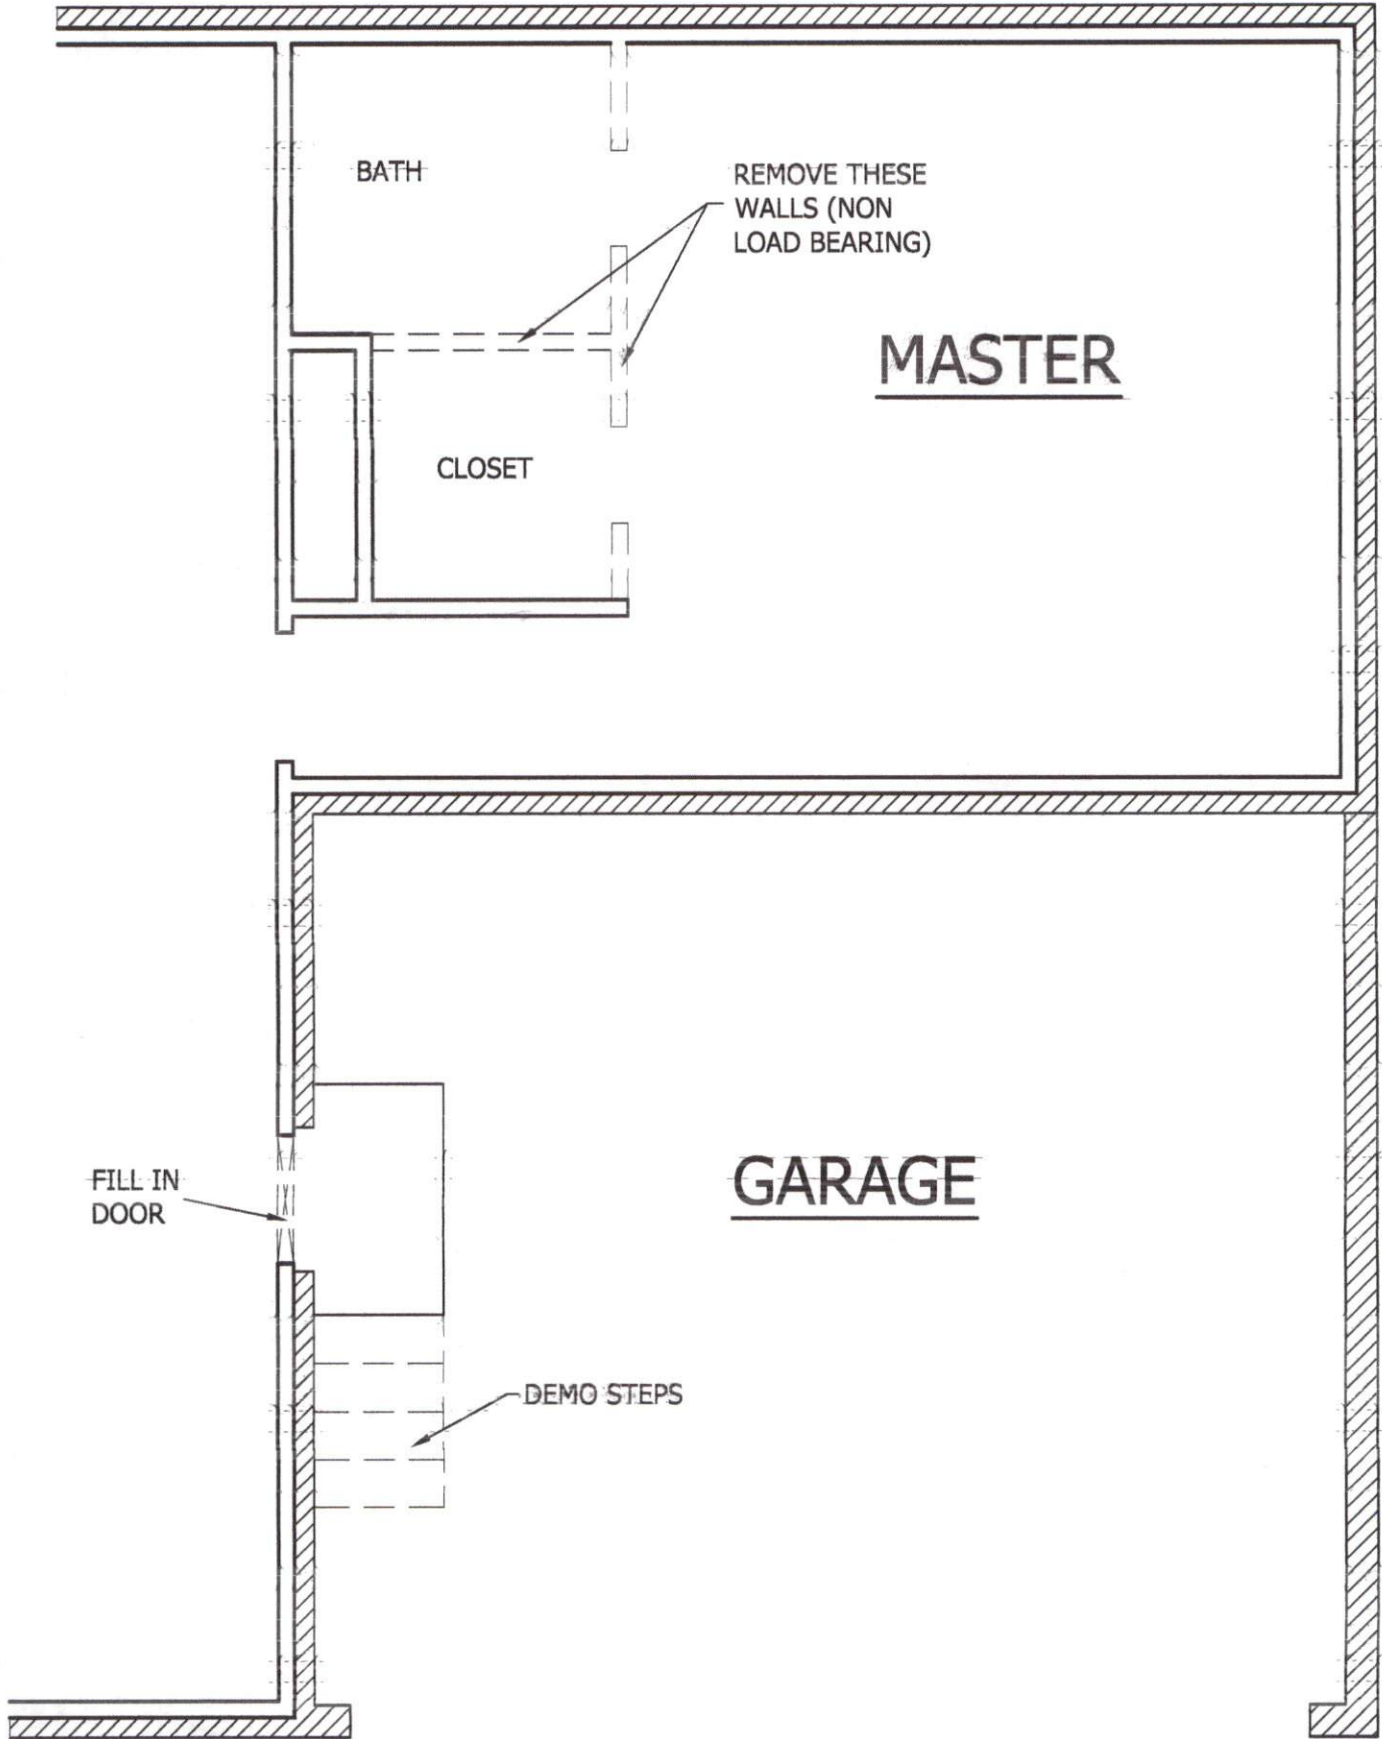

BATH

REMOVE THESE WALLS (NON LOAD BEARING)

MASTER

CLOSET


GARAGE

FILL IN DOOR

DEMO STEPS

DEMO PLAN

SCALE: 1/4"=1'-0"

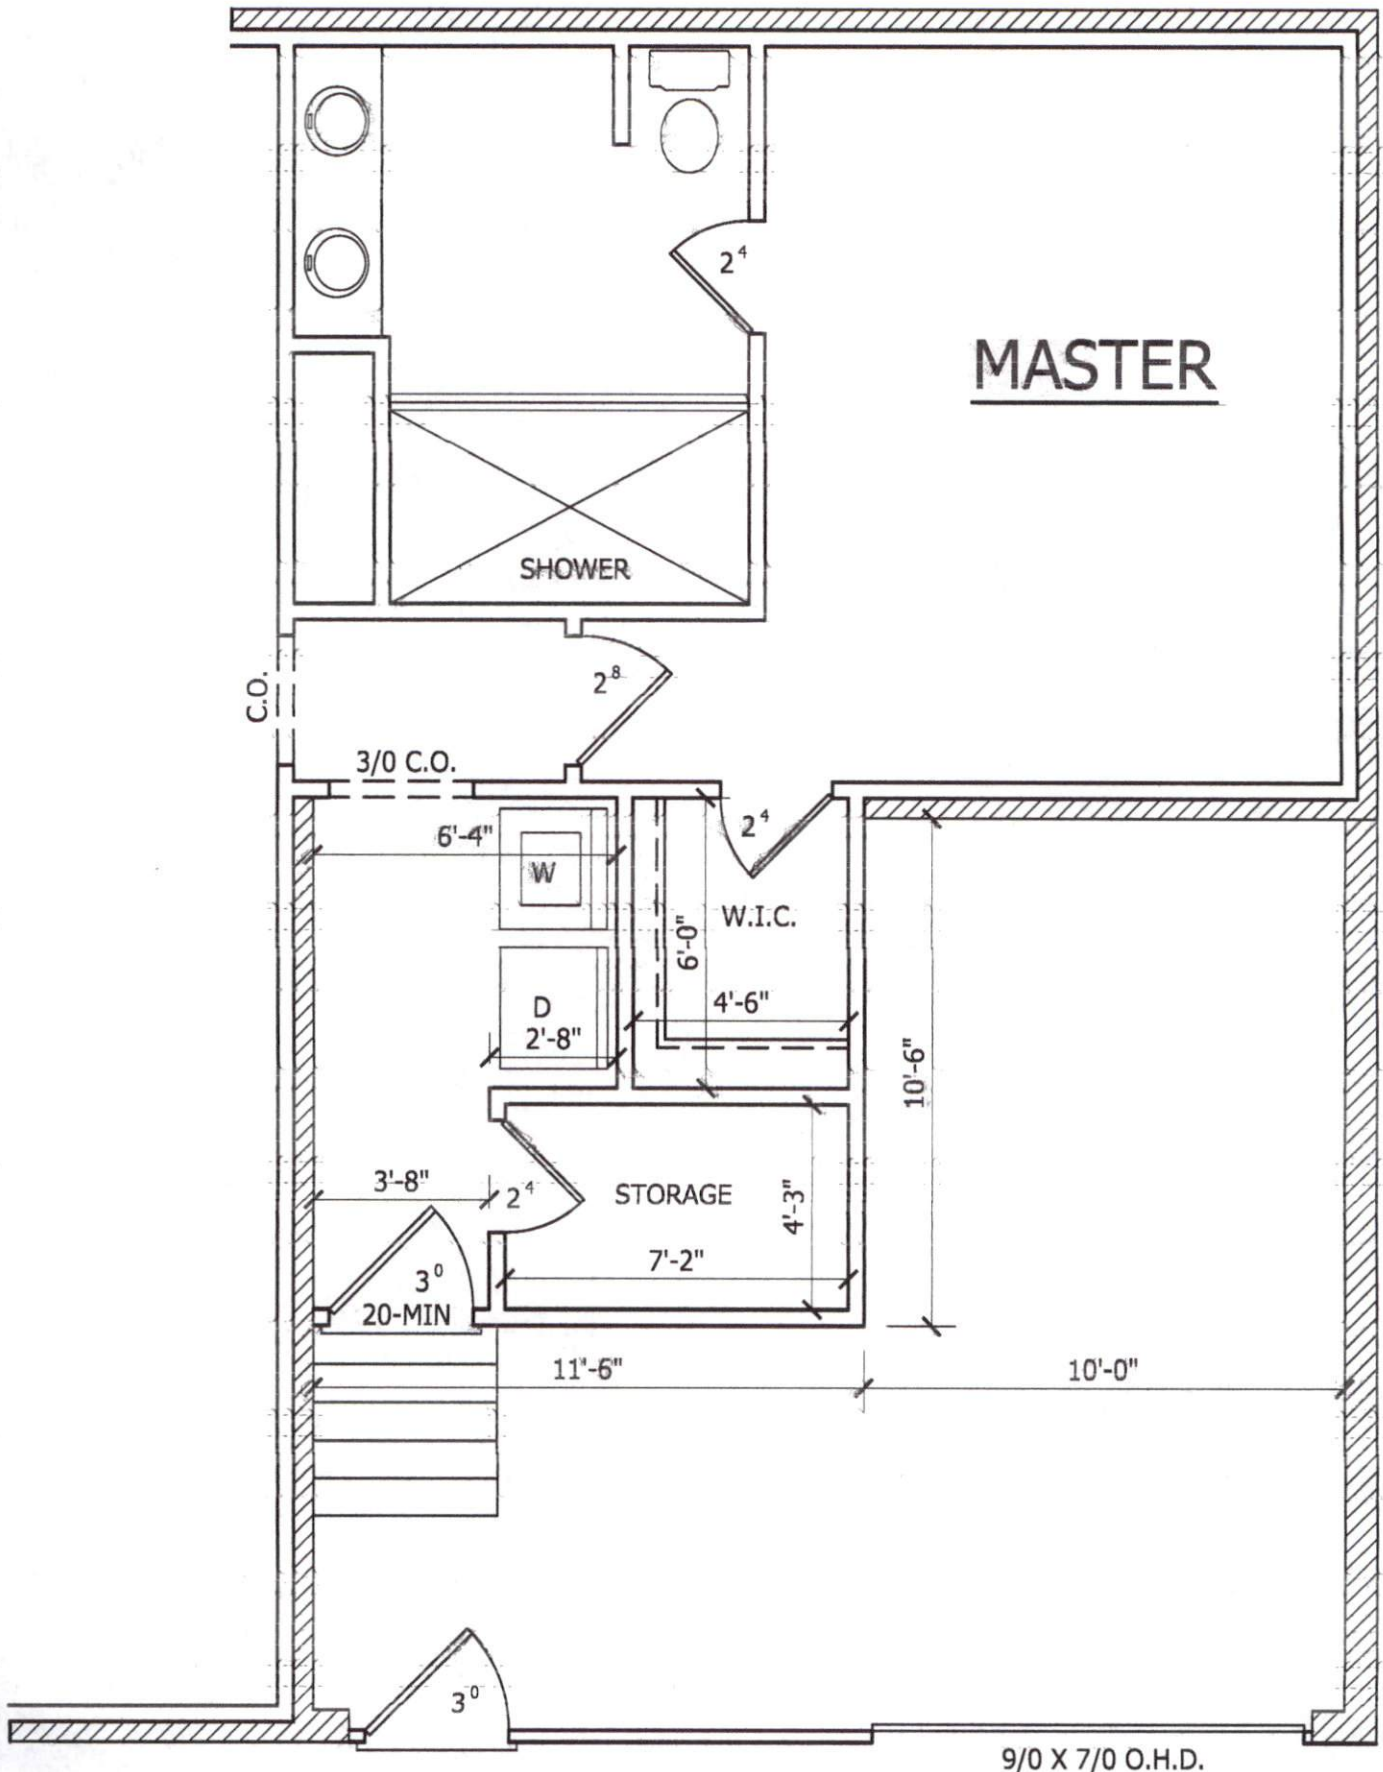

MASTER

PROPOSED PLAN

SCALE: 1/4"=1'-0"

9/0 X 7/0 O.H.D.