
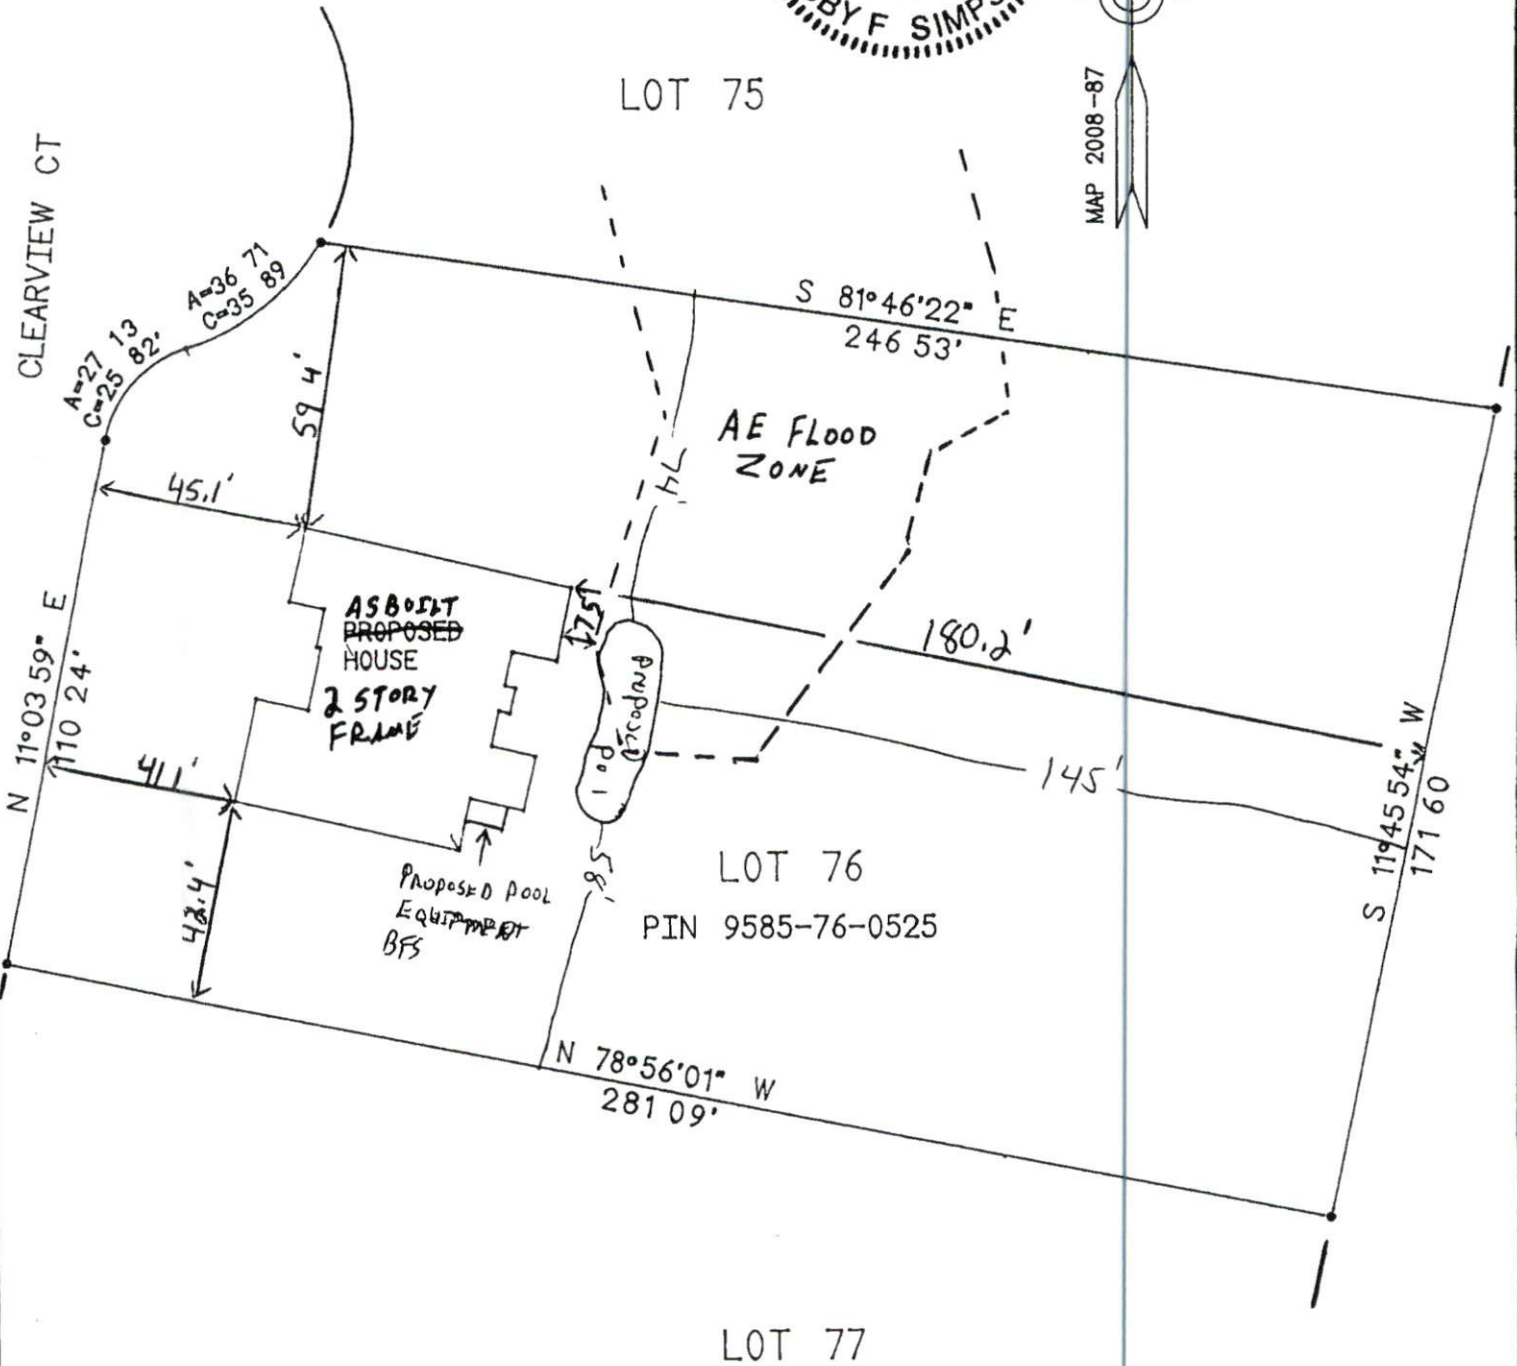


I HAVE CONSULTED THE FEDERAL EMERGENCY
 MANAGEMENT AGENCY FLOOD MAP AND DETERMINED
 THAT A PORTION OF THE PROPERTY AS SHOWN
 IS IN THE AE FLOOD ZONE HOWEVER THE PROPOSED
 HOUSE LOCATION IS OUTSIDE THE FLOOD ZONE
 AS SHOWN ON FIRM PANEL 3710958400J

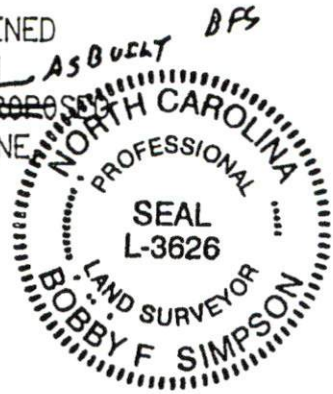

ASBUILT
 SITE PLAN SURVEY
 OF


THIS IS TO CERTIFY THAT ON THE 6th DAY OF April 2011 I SURVEYED THE PROPERTY SHOWN ON THIS PLAT AND THAT THE TITLE LINES AND THE WALLS OF THE BUILDINGS IF ANY ARE SHOWN HEREON

UPDATED 5-12-11 BFS

UPDATED 2-15-12 BFS (PROPOSED POOL EQUIPMENT)

SIGNED Bobby F. Simpson
REGISTERED SURVEYOR


I HAVE CONSULTED THE FEDERAL EMERGENCY MANAGEMENT AGENCY FLOOD MAP AND DETERMINED THAT A PORTION OF THE PROPERTY AS SHOWN IS IN THE AE FLOOD ZONE HOWEVER THE HOUSE LOCATION IS OUTSIDE THE FLOOD ZONE AS SHOWN ON FIRM PANEL 3710958400J

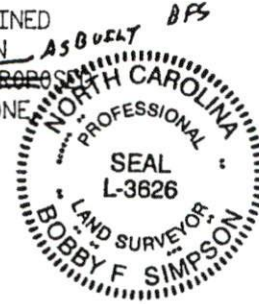

N



MAP 2008-87

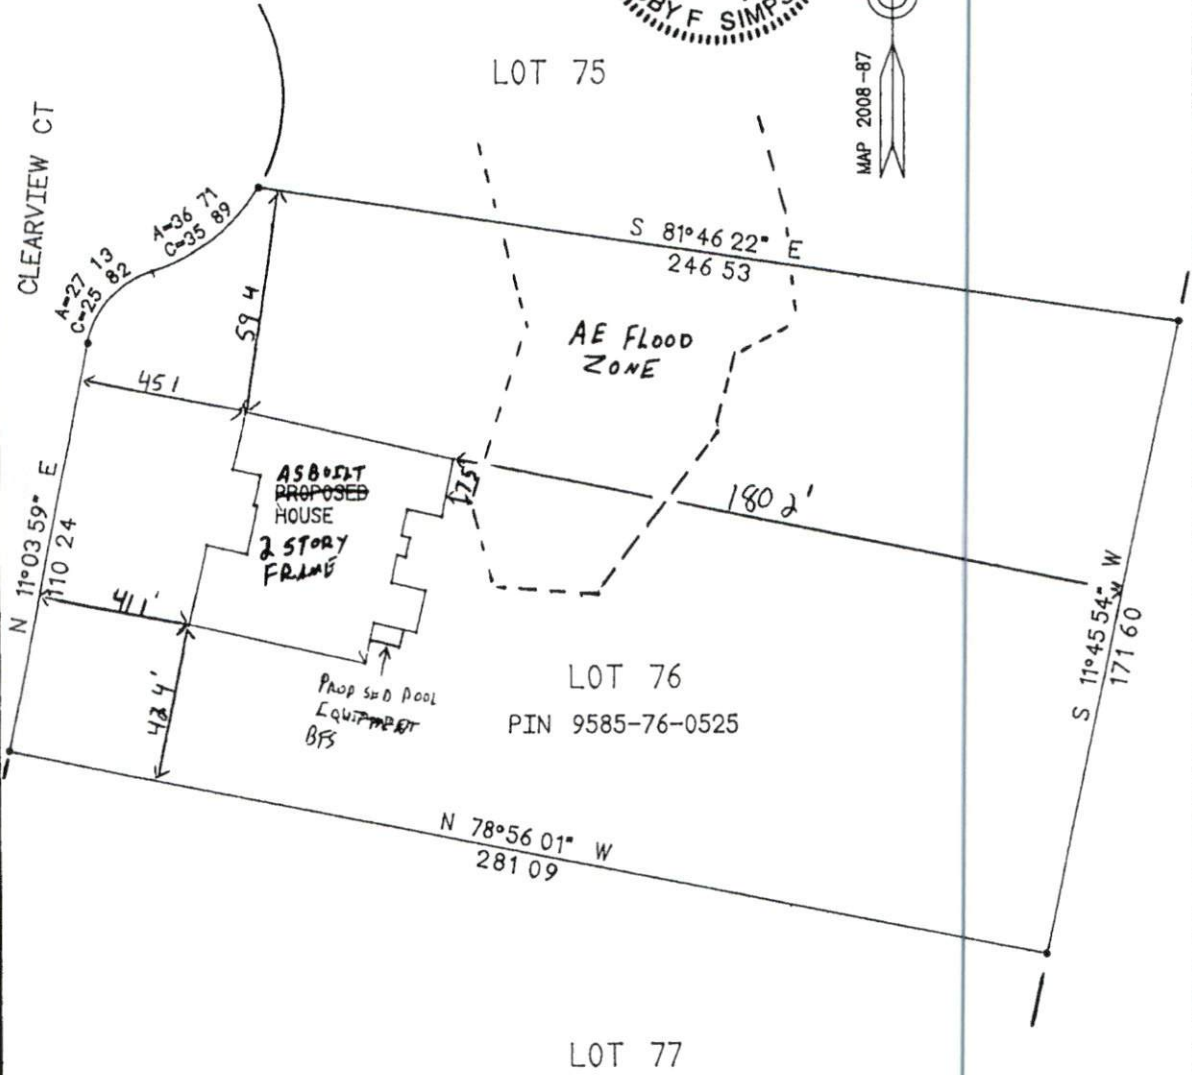

ASBUILT
SITE PLAN
SURVEY
OF

LOT 76 BLOCK T CAROLINA LAKES PHASE 8

SCALE 1 INCH = 40 FEET

THE PROPERTY OF