
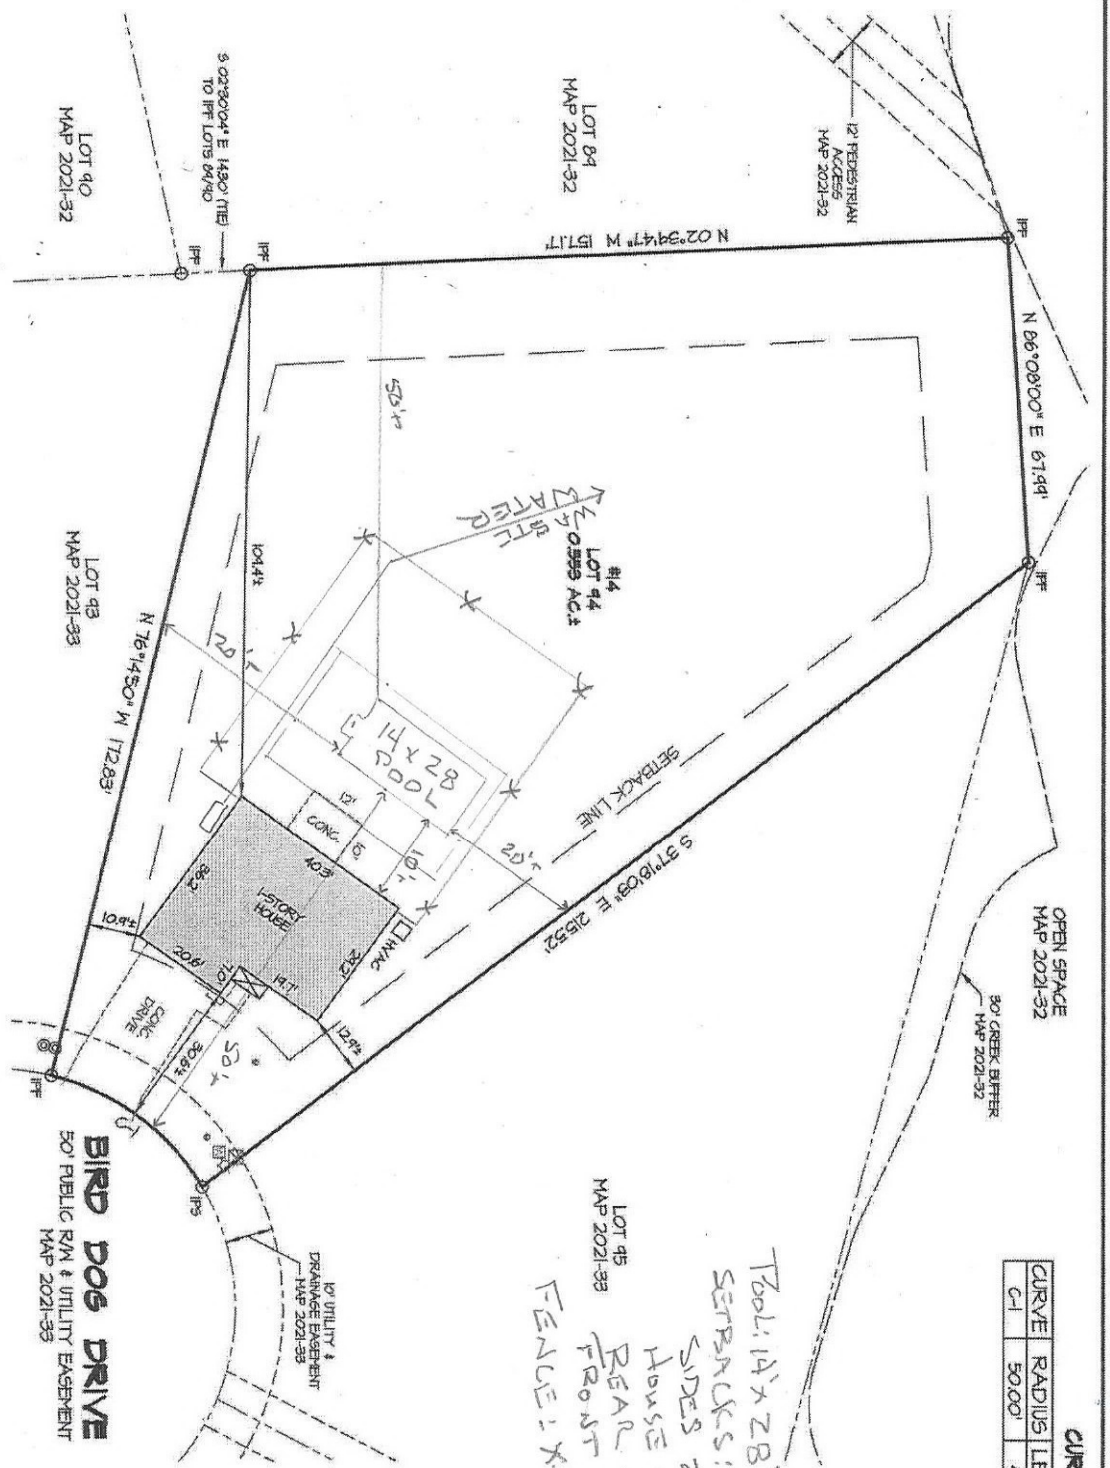


CURVE TABLE

CURVE	RADIUS	LENGTH	CHORD
C-1	50.00'	40.00'	5 36°40'15" N 38.94'

TOOL: 14' X 28'
 SERBACKS:
 SIDES 20'
 HOUSE 16'
 REAR 50'
 FRONT 50'
 FENCE: X-X-X

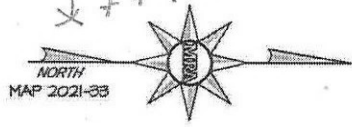


LOT	INTERVIEWS AREA
94	2024 SF.

I.S.A. 2029 SQFT.
 PROPOSED 769 SQFT.
 DECKING
 TOTAL 2798 SQFT.



MIRA
 MORRIS & RITCHIE ASSOCIATES of NC, PC
 ENGINEERS, PLANNERS, SURVEYORS AND LANDSCAPE ARCHITECTS
 FIRM LICENSE C-482, 6-442
 5605 CHAPEL HILL ROAD, SUITE 112
 RALEIGH, NORTH CAROLINA 27607
 (919) 200-2100
 MIRA@MIRA.COM

SCALE: 1"=30'	DATE: 7/23/2021	DRAWN BY: MLR	DESIGNED BY:
PHASE: BLACK			5

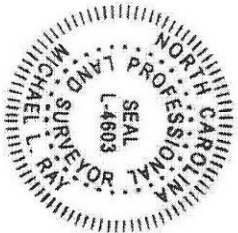

I HEREBY CERTIFY THAT THIS FINAL AS-BUILT SURVEY WAS DRAWN UNDER MY DIRECT SUPERVISION FROM AN ACTUAL FIELD-RUN SURVEY AND THAT THERE ARE NO ENCROACHMENTS UNLESS OTHERWISE SHOWN. DEED REFERENCES ARE AS DESIGNATED HEREON. THE RATIO OF PRECISION OR POSITIONAL ACCURACY IS 1:10,000+ AND THAT THIS FLAT MEETS THE REQUIREMENTS OF THE STANDARD OF PRACTICE FOR LAND SURVEYING IN NORTH CAROLINA (21 NCAC 56, 1600).

Michael L. Ray
 MICHAEL L. RAY, PLS L-4603