

HTE# 5151902-0062

Permit # 3049D

Harnett County Department of Public Health Site Sketch


M: Mikell Lawie Woodward PROPERTY LOCATION: 335 Forting Road (SN 1538)
ISSUED TO: SFC General Contractors LLC SUBDIVISION

Authorized State Agent:

[Signature]
ADDRESS CORRID

Date: 05/31/2019
03/19/2019 03/05/2019 (AIC)

LOT # 38

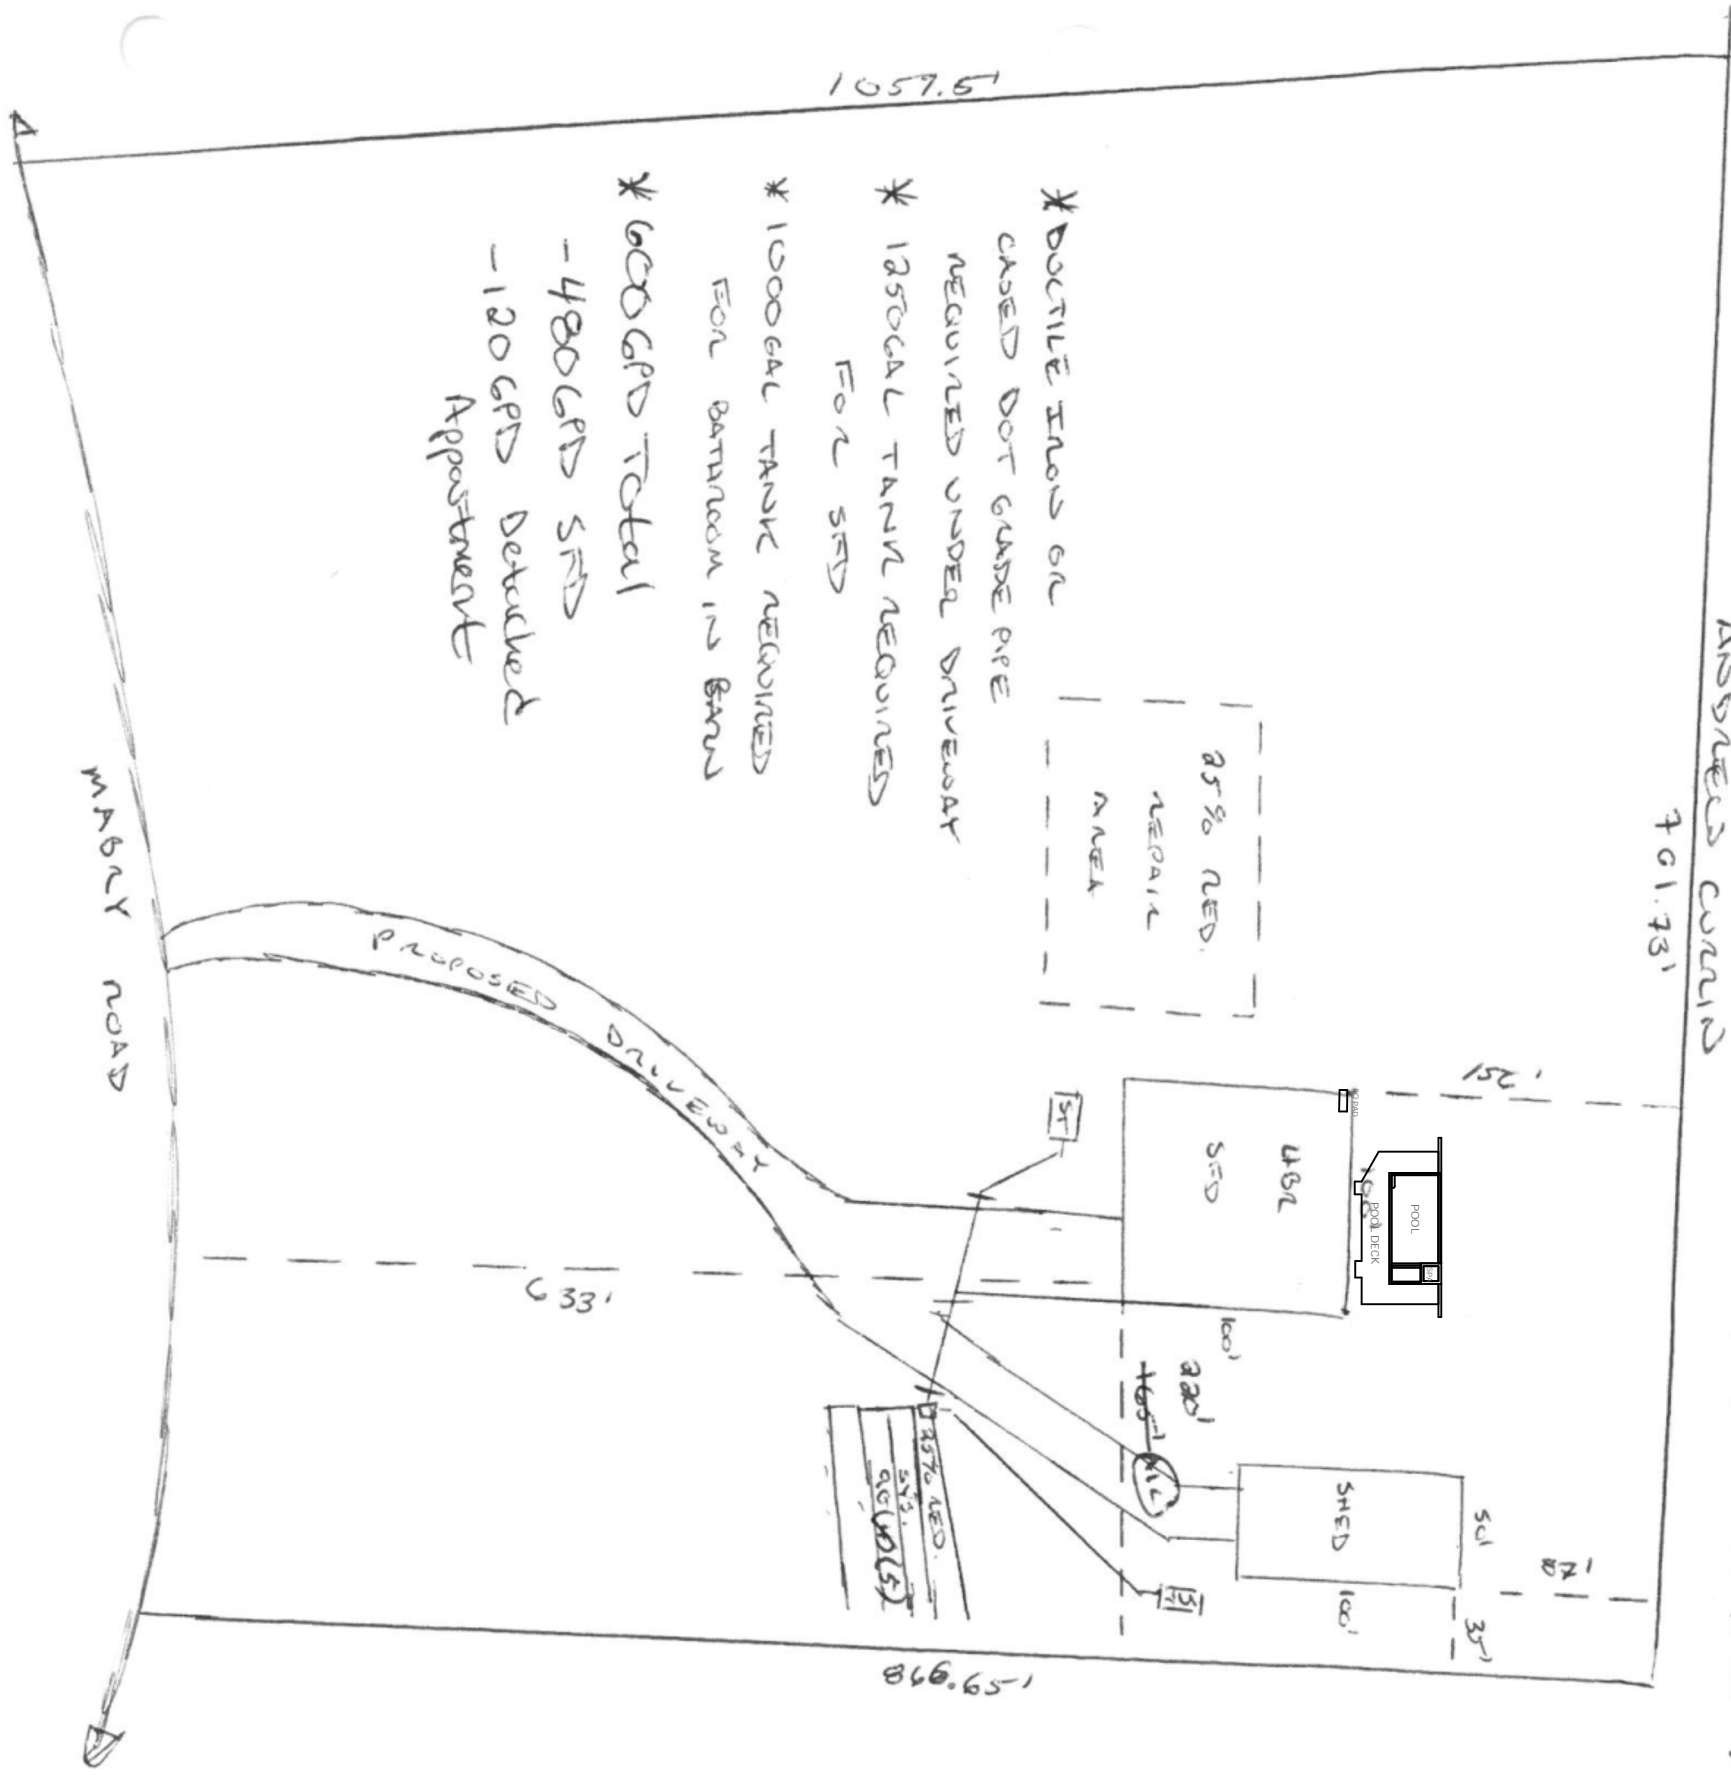

- * DOUBLE INCH OR CASSED DOT GUSSE PIPE REQUIRED UNDER DRIVEWAY
- * 1350 GAL TANK REQUIRED FOR SF2
- * 1000 GAL TANK REQUIRED FOR BATHROOM IN BRN
- * 600 GPD TOTAL
- 480 GPD SF2
- 120 GPD Detached Apartment