

213 Hugh Massie Rd.
Waynesville, NC 28786
(828) 400-3193

April 4, 2023

Cooper's Mobile Home Service, Inc.
227 Forest Oaks Dr.
Clayton, N.C. 27520


Re: Elevated Manufactured Home Inspection
29 Kaitlyn St
Fuquay-Varina, NC


Dear Sirs:



An inspection has been performed on the anchoring system of the manufactured home described above. More than one-fourth of the main I-beam support piers exceed 36" in height. The stabilizing system has been designed for the height of the home and the wind, live, and dead loads specified by the State of North Carolina Regulations for Manufactured Homes.

The anchoring system, including, anchors, straps and piers, are structurally adequate as installed for the specified loads and site conditions. The location and type of each tie down is shown on the attached sheet 2 of 2.

Sincerely,

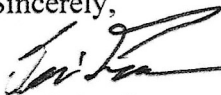
Travis M. Person, PE

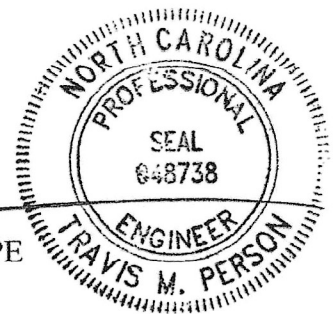

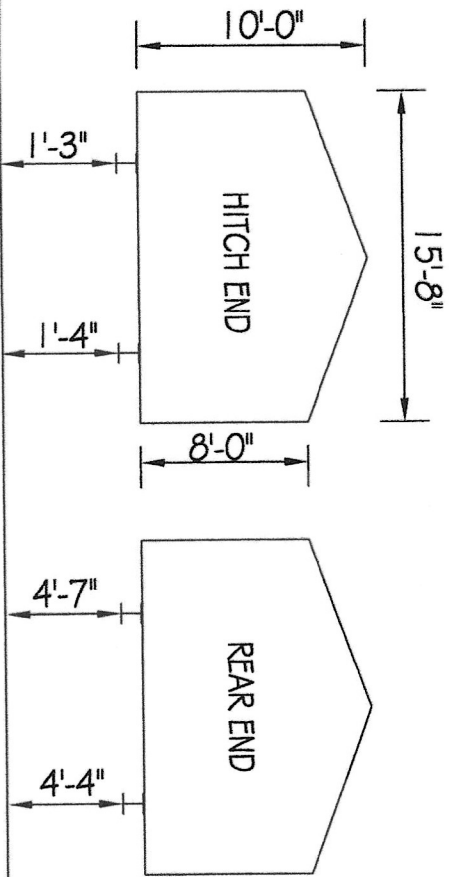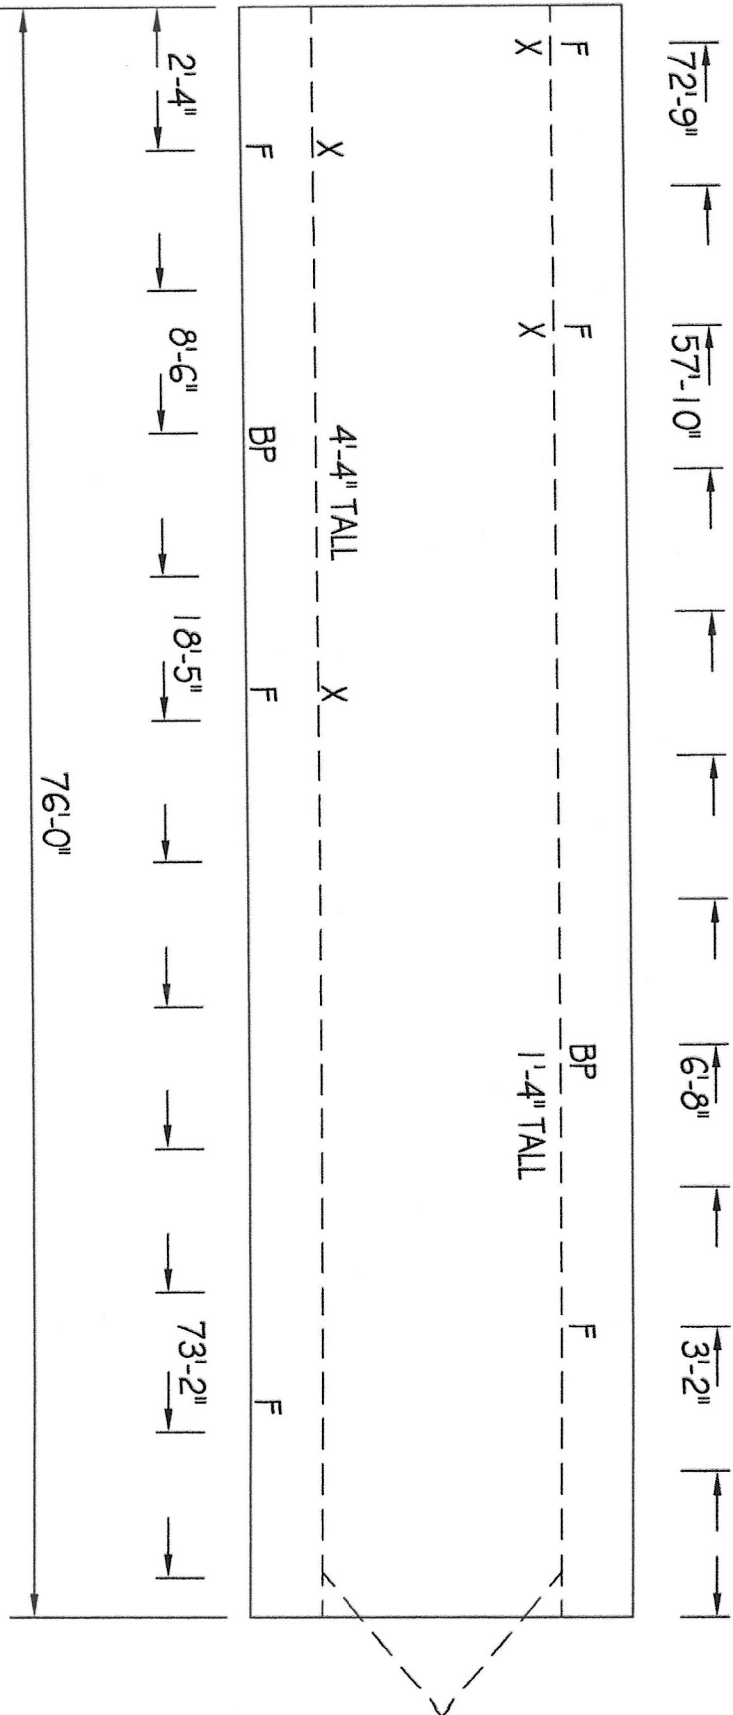

NOTES: F = FRAME TIE
 BP = BRACED PIER
 X = CROSS TIE

FIELD INSPECTION REPORT			
29 KAITLYN ST			
FUQUAY-VARINA, NC			
DATE	DWG. NO.	SHEET NO.	
03/30/2023		2 OF 2	