

IMPROVEMENT PERMIT

Be it ordained by the Harnett County Board of Health as follows: Section III, Item B. "No Person shall begin construction of any building at which a septic tank system is to be used for disposal of sewage without first obtaining a written permit from the Harnett County Health Department."

Name: (owner) WALTER O'Reilly

New Installation Septic Tank

Property Location: SR# 1141

Repairs

Nitrification Line

SERINA WOODS

Subdivision: SERINA WOODS

Lot # TRACT 1

Tax ID #

Quadrant #

Number of Bedrooms Proposed: 4 BR 1 (Green 35x50)

Lot Size: 8.96 ac

Basement with Plumbing: Total

Garage: with 1 Bedroom

Water Supply: Well Public

Community

3 BR House 45x160

Distance From Well: 50 ft.

Green house with no rest rooms
Green house does not require septic system

Following is the minimum specifications for sewage disposal system on above captioned property. Subject to final approval.

Type of system: Conventional

Other

Size of tank: Septic Tank 2 (1000) gallons

Pump Tank: _____ gallons

Subsurface Drainage Field

No. of ditches 1

exact length of each ditch 320 ft.

width of ditches 3 ft.

depth of ditches 18-24 in.

French Drain Required: _____ Linear feet

Date: 12-11-01


This permit is subject to revocation if site plans or intended use change.

Signed: [Signature]

Environmental Health Specialist

Keep SYSTEM 15' from swimming pool
Meet onsite

to SE 1141

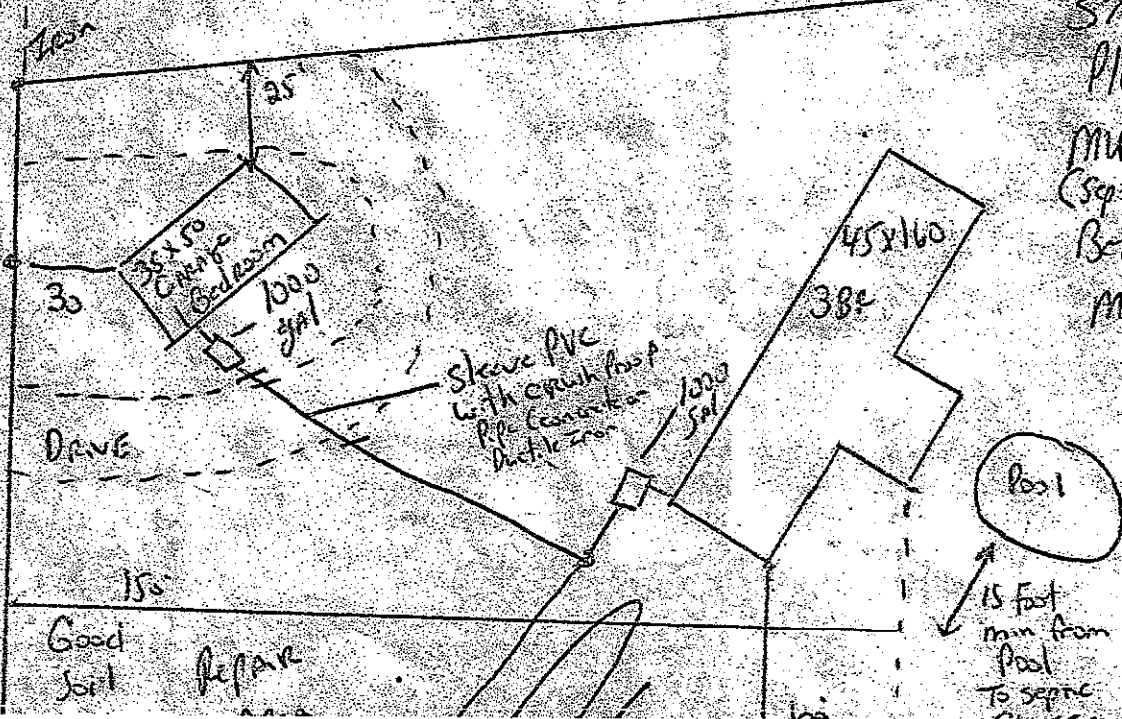

STUB OUT ALL Plumbing shallow MW meet onsite (septic contractor) Before installing

MAINTAIN ALL Set Backs

Do not DRIVE OR PARK ON septic system

where DRIVE cross PVC supply line sleeve with