

HTE# 07-5-18754

Harnett County Department of Public Health

20901

PERMIT # 24441

Operation Permit

New Installation Septic Tank Repair Nitrification Line Expansion

PROPERTY LOCATION: SR 1442 BARKENS RD S

Name: (owner) STANCI Builders INC SUBDIVISION Hornhills Farms LOT # 6

System Installer: STANCI Builders Registration # _____

Basement with plumbing Garage Number of Bedrooms 3


Type of Water Supply: Community Public Well Distance from well _____ feet

System Type: 25% REDUCTION SYSTEM III G Types V and VI Systems expire in 5 years.

(In accordance with Table V a)

Owner must contact Health Department 6 months prior to expiration for permit renewal.

This system has been installed in compliance with applicable North Carolina General Statutes, Rules for Sewage Treatment and Disposal, and all conditions of the Improvement Permit and Construction Authorization.

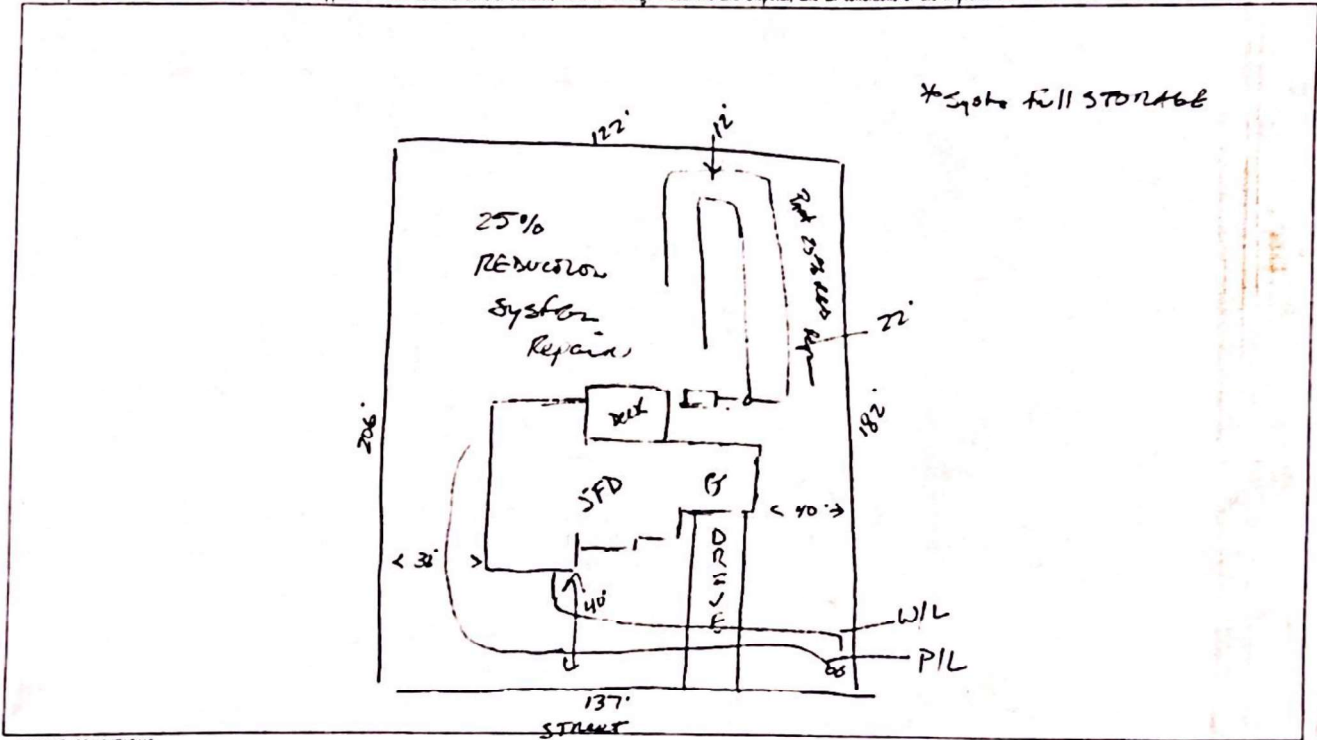

PERMIT CONDITIONS:

- I. Performance: System shall perform in accordance with Rule .1961.
- II. Monitoring: As required by Rule .1961.
- III. Maintenance: As required by Rule .1961. Other: _____
Subsurface system operator required? Yes No
If yes, see attached sheet for additional operation conditions, maintenance and reporting
- IV. Operation: _____
- V. Other: _____

Following are the specifications for the sewage disposal system on the above captioned property

Type of system: Conventional Other 25% REDUCTION E26100 Septic Tank: 1000 gallons Pump Tank: _____ gallons
 Subsurface No. of _____ exact length _____ width of _____ depth of _____
 Drainage Field ditches 2 of each ditch 120 feet ditches 3 feet ditches 26-28 inches
 French Drain Required: _____ Linear feet

Authorized State Agent James S. Manhart Date 1-13-10