

Person Engineering
NC Firm License No. F-1440
213 Hugh Massie Rd.
Waynesville, NC 28786
(828) 400-3193

September 29, 2023

Steve Sost

Re: Elevated Manufactured Home Inspection
2717 Overhills Rd
Bunnlevel, NC

Dear Sirs:

An inspection has been performed on the anchoring system of the manufactured home described above. More than one-fourth of the main I-beam support piers exceed 36" in height. The stabilizing system has been designed for the height of the home and the wind, live, and dead loads specified by the State of North Carolina Regulations for Manufactured Homes.


The anchoring system, including, anchors, straps and piers, are structurally adequate as installed for the specified loads and site conditions. The location and type of each tie down is shown on the attached sheet 2 of 2.

Sincerely,

A handwritten signature in black ink, appearing to read 'Travis M. Person'.

Travis M. Person, PE



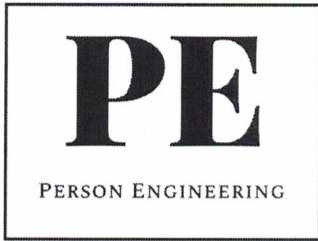

Person Engineering
NC Firm License No. F-1440
213 Hugh Massie Rd.
Waynesville, NC 28786
(828) 400-3193

September 29, 2023

Invoice No. 23236



Steve Sost

Re: Elevated Manufactured Home Inspection
2717 Overhills Rd
Bunnlevel, NC

Invoice Amount:	<u>\$ 600.00</u>
Amount Paid:	<u>\$ 600.00</u>
Balance:	<u>\$ 0.00</u>

Please make checks payable to: Person Engineering
213 Hugh Massie Rd.
Waynesville, N.C. 28786

Terms: Net 30, 1½% added monthly to past due accounts.
Please include invoice number with payment.

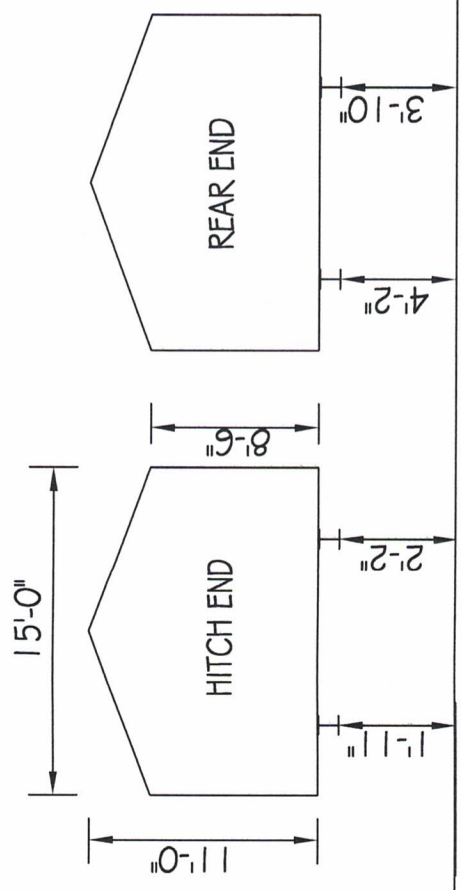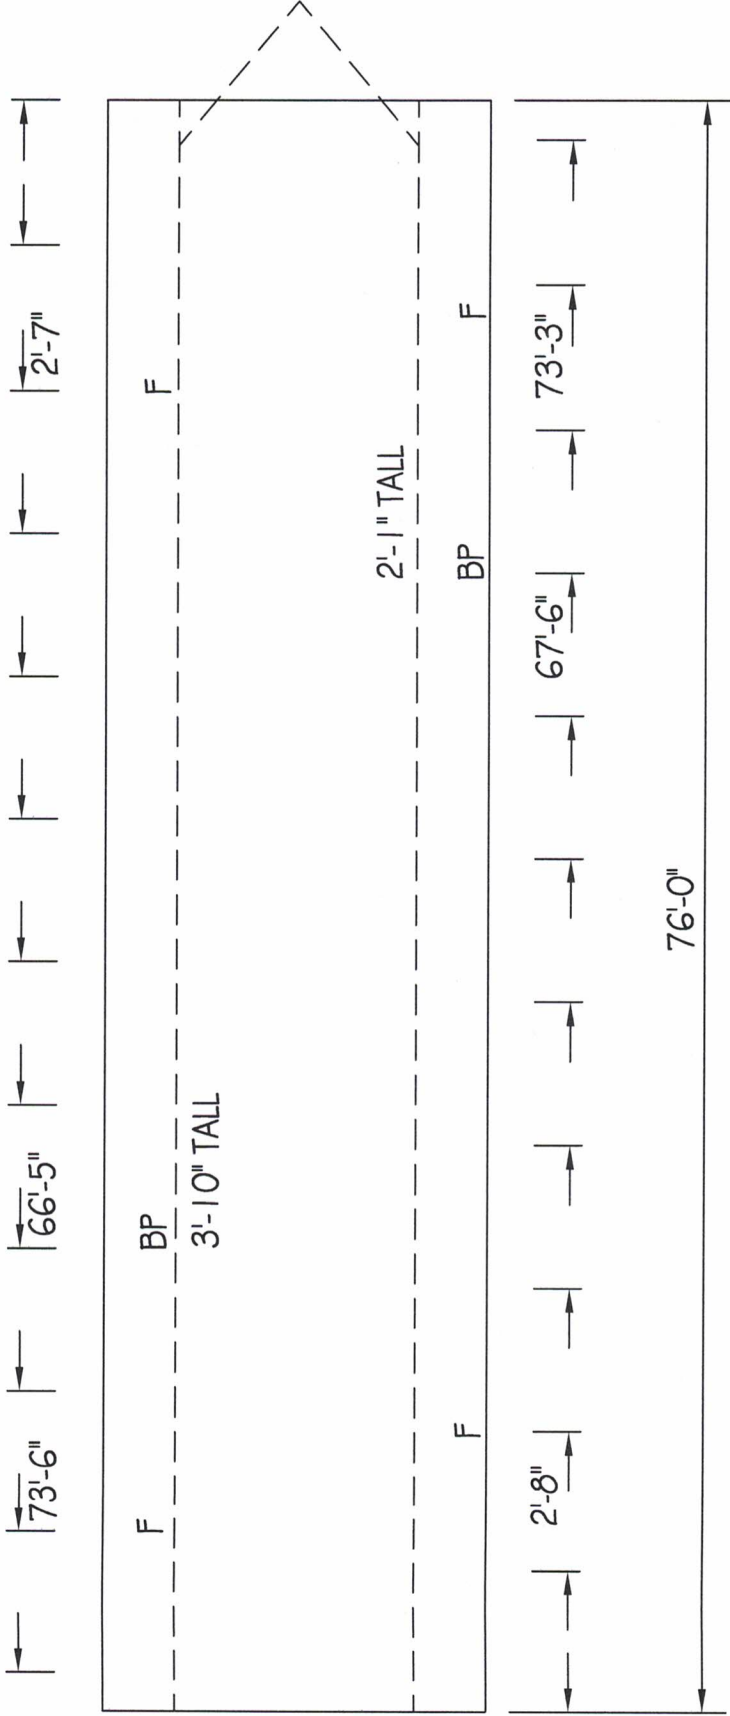

- NOTES:
- F = FRAME TIE
 - BP = BRACED PIER
 - X = CROSS TIE

FIELD INSPECTION REPORT	
2717 OVERHILLS RD	
BUNNLEVEL, NC	
DATE	DWG. NO.
09/26/2023	
SHEET NO. 2 OF 2	