

HTE 03-5-8441

OPERATIONS PERMIT

Name: (owner) Robert Keith Owen

New Installation

Septic Tank

Property Location: SR# 1448 ATKENS

Repairs

Nitrification Line

Subdivision _____

Lot # 2

Tax ID # _____

Quadrant # _____

Contractor: CLINT ADAMS - ANJIAN EVERGREEN INC

Registration # _____

Basement with Plumbing:

Garage:

Water Supply: Well

Public

Community

Distance From Well: 50' ft.

Following are the specifications for the sewage disposal system on above captioned property.

Type of system:

Conventional

Other _____

Size of tank:

Septic Tank: 1000 gallons

Pump Tank: _____ gallons

Subsurface
Drainage Field

No. of
ditches 3

exact length
of each ditch 100 ft.

width of
ditches 3 ft.


depth of
ditches 24-18 in.

French Drain Required: - Linear feet

Date: 1-20-05

Inspected by: James E. Manland
Environmental Health Specialist

PERMIT NO. 20342

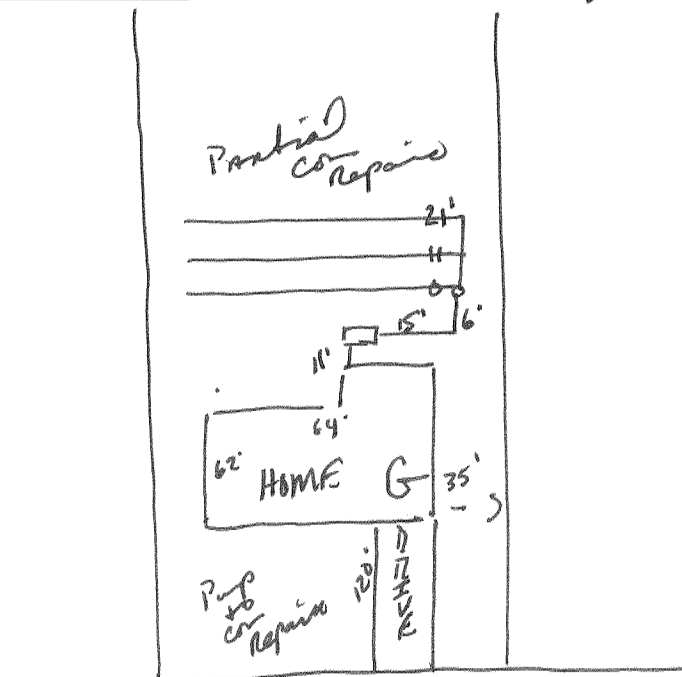

TAN KEIN LN

SO INGRESS - EGRESS BASEMENT →

OUT TO
SR 1448