

# Harnett County Department of Public Health

PERMIT # Bres 2310-0046

## Operation Permit

☒ New Installation ☒ Septic Tank ☒ Nitrification Line ☐ Repair ☐ Expansion

PROPERTY LOCATION: 185 Rollins Acres LN, Lillington

Name: (owner) DAB Holdings of NC, LLC SUBDIVISION Rollins Acres LOT # 5

System Installer: Stancil Builders Inc

Basement with plumbing: ☐ Garage ☒ Number of Bedrooms 3


Type of Water Supply: ☐ Community ☐ Public ☒ Well Distance from well \_\_\_\_\_ feet

System Type: 25% Reduction Type III(b) EZ-Flow Types V and VI Systems expire in 5 years.

(In accordance with Table V a)

Owner must contact Health Department 6 months prior to expiration for permit renewal.

This system has been installed in compliance with applicable North Carolina General Statutes, Rules for Sewage Treatment and Disposal, and all conditions of the Improvement Permit and Construction Authorization.

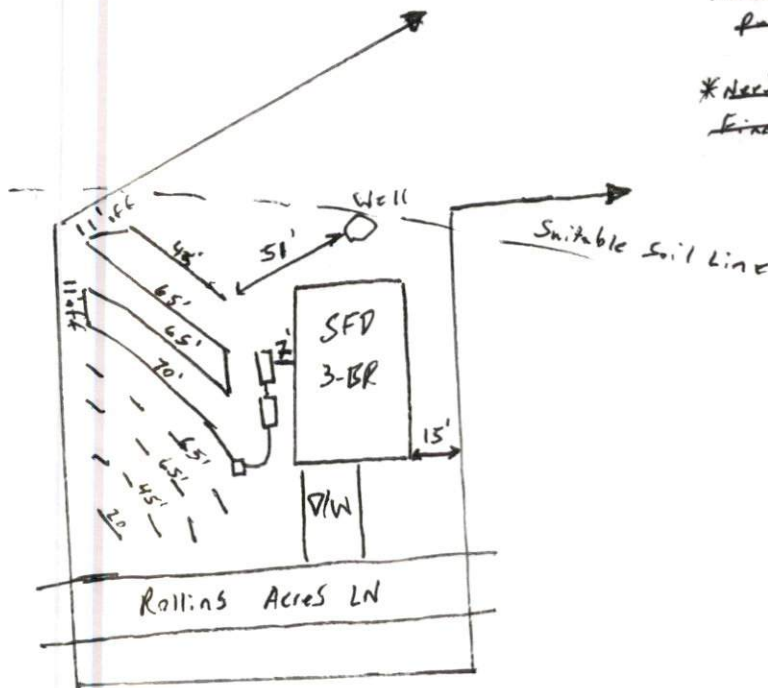

### PERMIT CONDITIONS:

I. Performance: System shall perform in accordance with Rule .1961.

II. Monitoring: As required by Rule .1961.

III. Maintenance: As required by Rule .1961. Other: \_\_\_\_\_

Subsurface system operator required? Yes ☐ No ☐

If yes, see attached sheet for additional operation conditions, maintenance and reporting.

IV. Operation: \_\_\_\_\_

V. Other: \_\_\_\_\_

☐ \_\_\_\_\_ D-Box ☐ \_\_\_\_\_ Pump ☐ \_\_\_\_\_ Alarm ☐ \_\_\_\_\_ H2O Line ☐ \_\_\_\_\_ PWR Line

Following are the specifications for the sewage disposal system on the above captioned property.

Type of system: ☐ Conventional ☒ Other Type III(b) EZ-Flow Septic Tank: 1,000 gallons Pump Tank: 1,000 gallons

Subsurface No. of \_\_\_\_\_ exact length \_\_\_\_\_ width of \_\_\_\_\_ depth of \_\_\_\_\_  
Drainage Field ditches 1 of each ditch 245' feet ditches 3' feet ditches 18" inches

French Drain Required: \_\_\_\_\_ Linear feet

Authorized State Agent RW J. REHS


Date 7-21-25

\*At time of installation design was slightly modified to add pump in order to dose septic field.

Design change approved by Alex Adams  
7-16-25

185 Rollins Acres Ln  
AS BUILT REVISION  
DAB Holdings of NC, LLC  
Harnett County PIN: 0681-41-2800  
Lot #5

\*Not a Survey  
Sketched from a plot plan supplied by owner

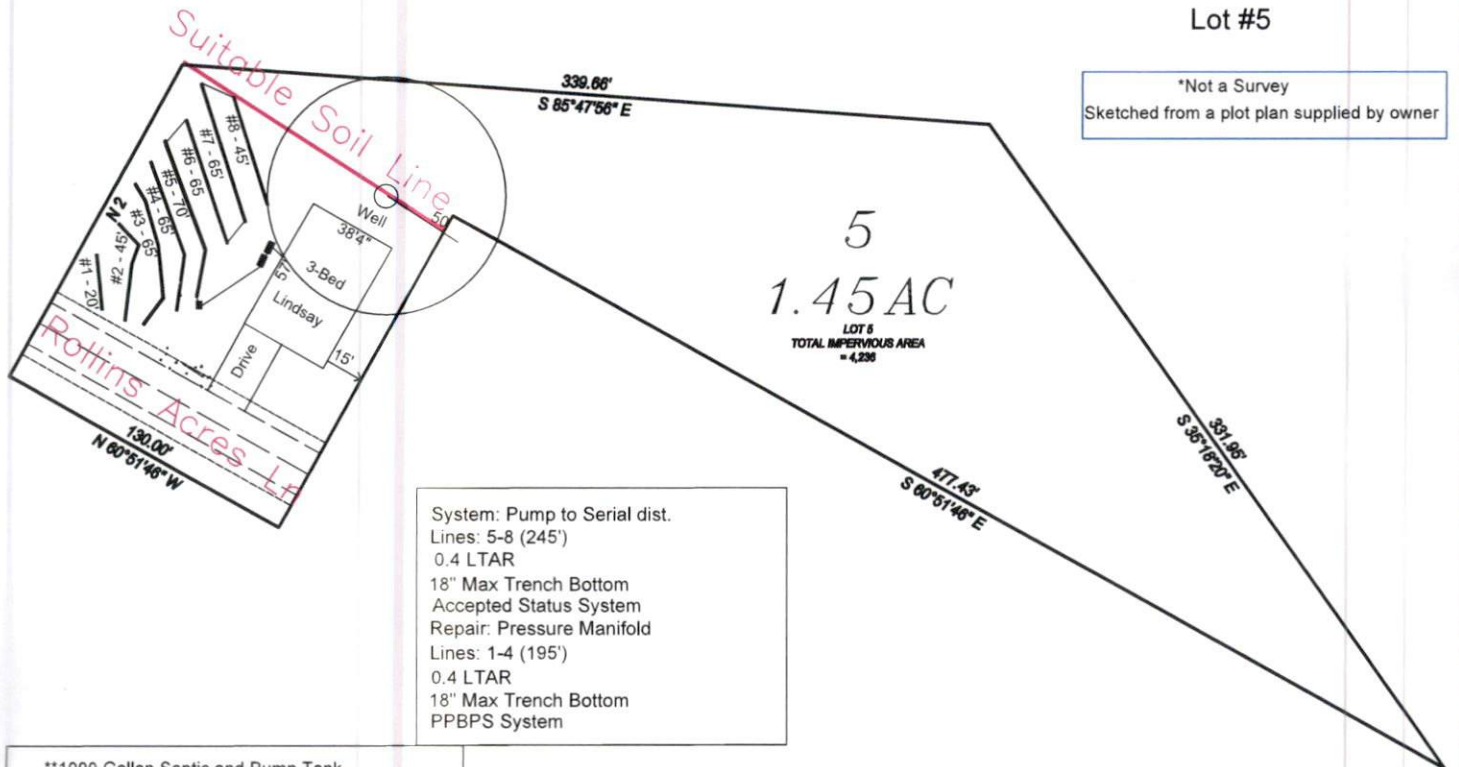

\*\*1000 Gallon Septic and Pump Tank

Tank and trenches to be located minimum of 10'  
from any property line and minimum of 5'  
from any building foundation.

\*Do Not Cut, Fill, or Alter Drainfield or Repair Area

\*Comply with all setbacks

\*Contact local health dept. and/or Alex Adams prior to  
or during installation with any questions or concerns.

GRAPHIC SCALE  
1" = 60'



Adams  
Soil Consulting  
919-414-6761  
Job #1862