



AUTHORIZATION TO OPERATE (ATO)

3592 Hillmon Grove Road, Cameron, NC, 28326, USA

PROPERTY ADDRESS

The system at the above referenced address was installed in accordance with applicable laws, rules and permit conditions.



09/18/25

DATE OF ATO

Garners Septic Tanks, Inc.

INSTALLER

Thomas J. Boyce

THOMAS BOYCE, AOWE

Sarahi Duarte

OWNER/REPRESENTATIVE



Agreement

By signing below, the undersigned Property Owner(s) acknowledge, agree, and expressly accept the following:

1. Approval of Location

I acknowledge and approve the septic system installation in its current location, regardless of its deviation from the originally permitted and flagged area.

2. Reserve Area

I understand and agree that the originally permitted area will remain designated as a future reserve/repair area, and that this change is in lieu of installation in that originally permitted area.

3. Assumption of Responsibility

I acknowledge that my approval of this change is voluntary and that I have had the opportunity to ask questions and seek independent advice before signing.

4. Hold Harmless

I agree to fully release, indemnify, and hold harmless Marlin Wastewater Services, LLC, its owners, officers, employees, and representatives from and against any and all claims, damages, costs, or liabilities of any kind, known or unknown, arising out of or related to the installation of the septic system in the alternate location.

5. Binding Effect

This acknowledgment and release is binding upon me, my heirs, successors, and assigns, and shall inure to the benefit of Marlin Wastewater Services, LLC and its successors and assigns.


Property Owner(s):

Signature: Sarhi Duarte



Printed Name: Sarhai Duarte

Date: 09 / 18 / 2025

ATO 3592 Hillmon Grove Rd. 2025

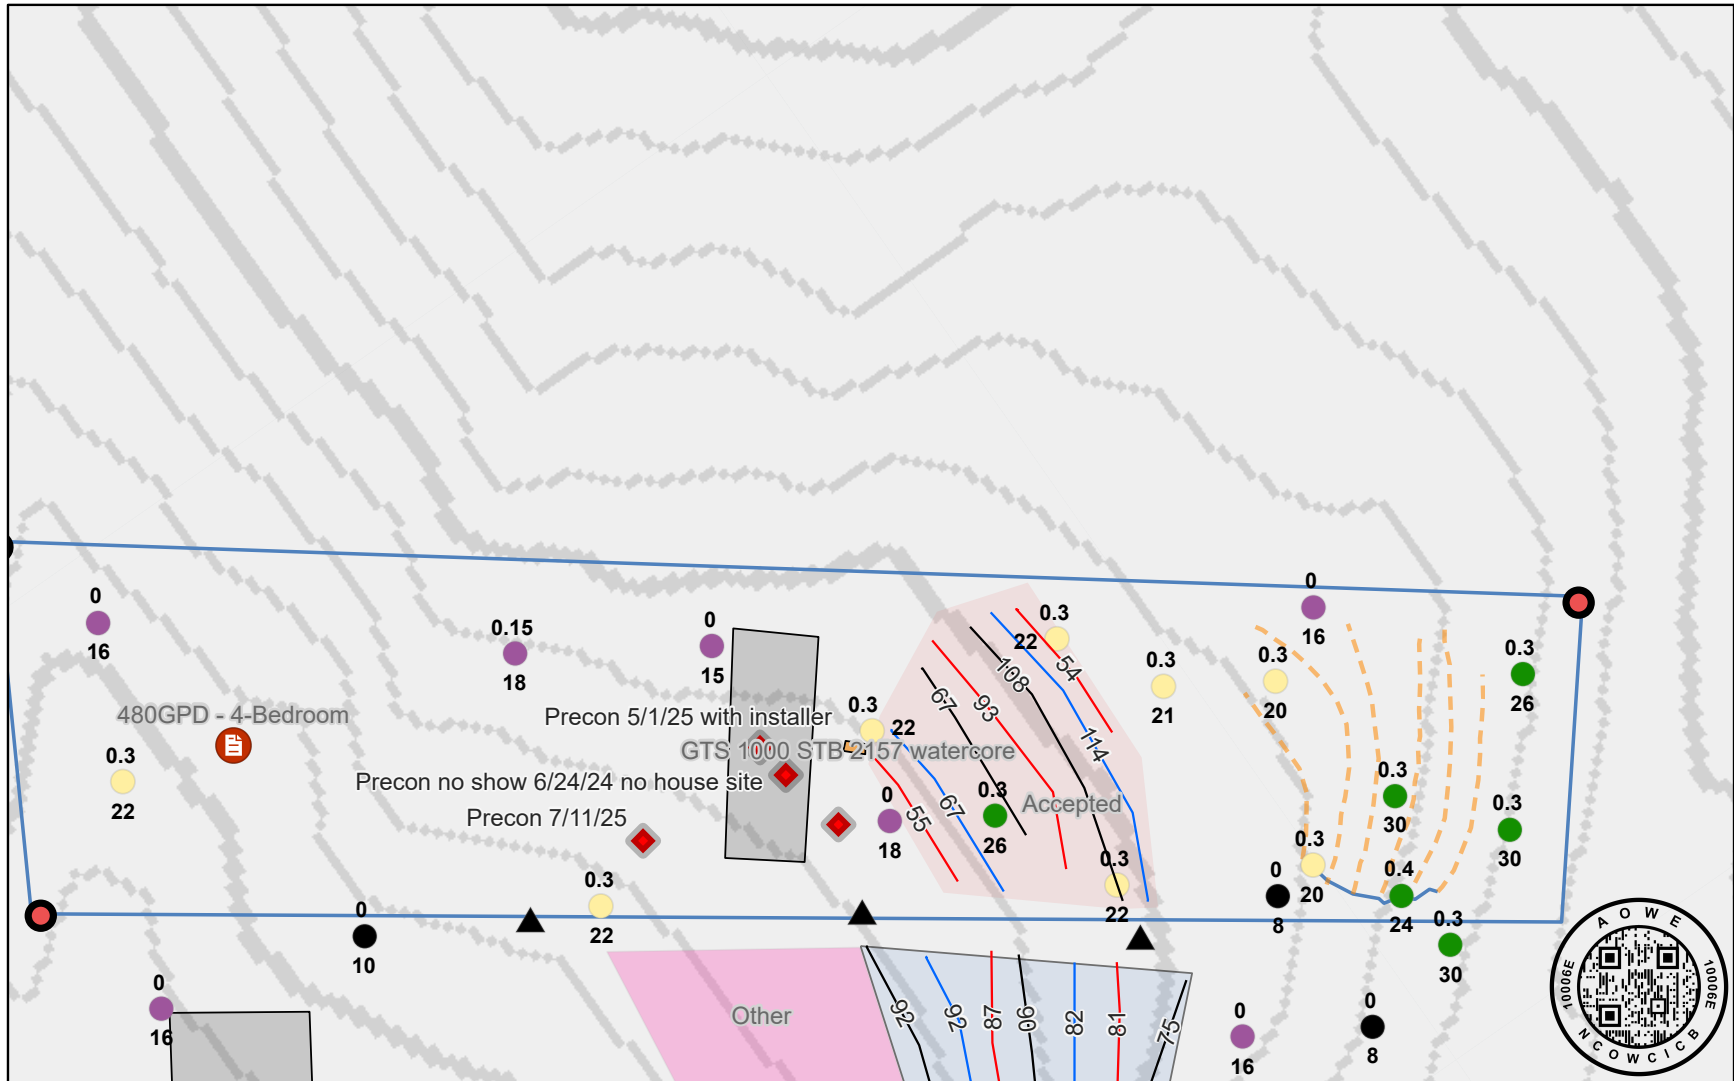

9/18/2025

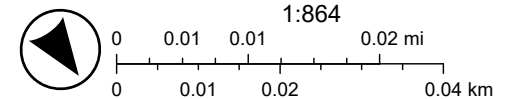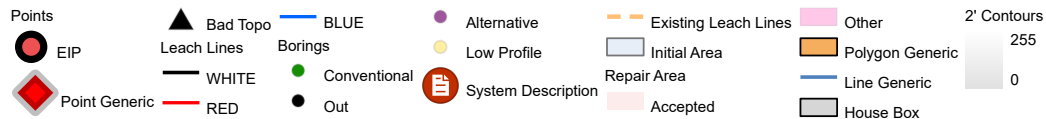

Sources: Esri, TomTom, Garmin, FAO, NOAA, USGS, (c) OpenStreetMap contributors, and the GIS User Community. Sources: Esri, TomTom, Garmin,