



Person Engineering
NC Firm License No. F-1440
213 Hugh Massie Rd.
Waynesville, NC 28786
(828) 400-3193

September 24, 2024

Clayton Homes
2001 W Cumberland St
Dunn, NC 28334


Re: Elevated Manufactured Home Inspection
276 Legacy Ln
Lillington, NC 27546

Dear Sirs:



An inspection has been performed on the anchoring system of the manufactured home described above. More than one-fourth of the main I-beam support piers exceed 36" in height. The stabilizing system has been designed for the height of the home and the wind, live, and dead loads specified by the State of North Carolina Regulations for Manufactured Homes.

The anchoring system, including, anchors, straps and piers, are structurally adequate as installed for the specified loads and site conditions. The location and type of each tie down is shown on the attached sheet 2 of 2.

Sincerely,


Travis M. Person, PE



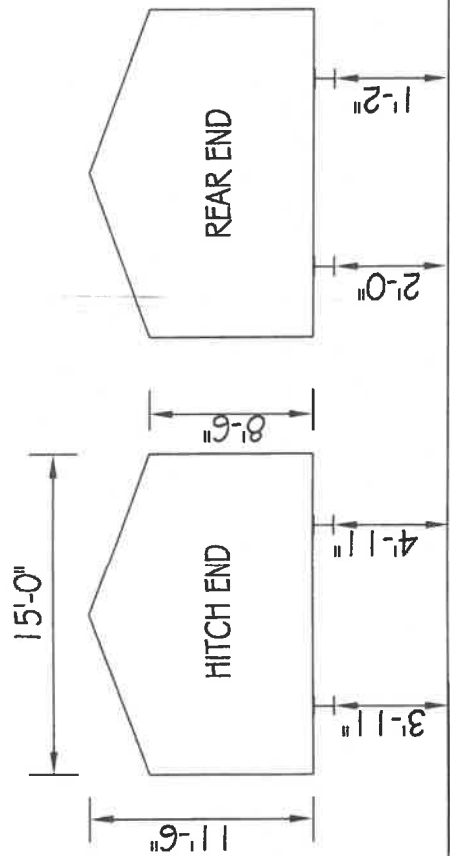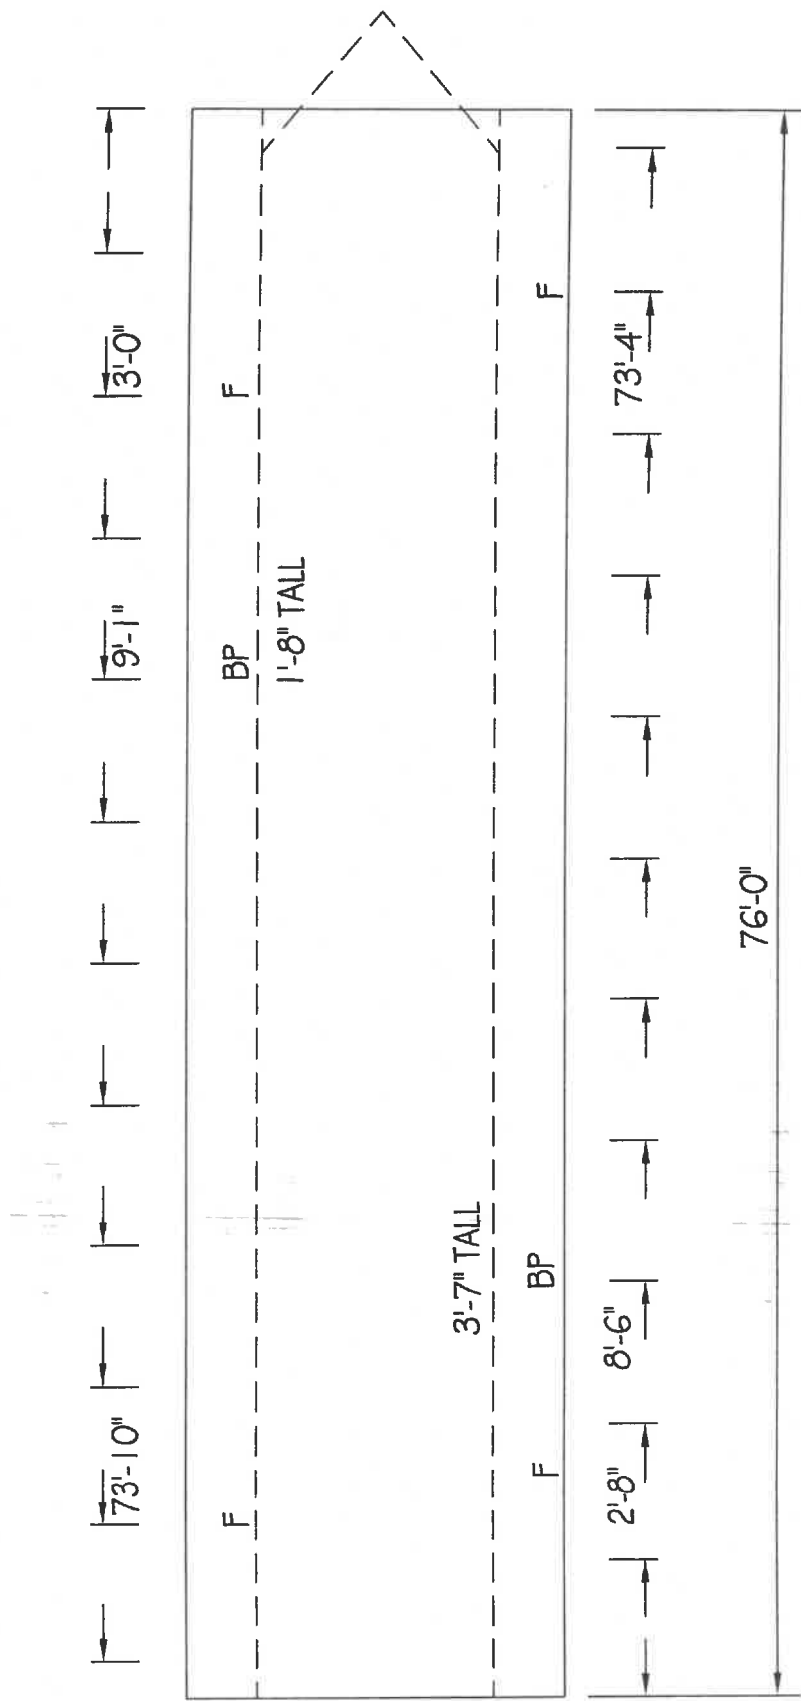

- NOTES:
- F = FRAME TIE
 - BP = BRACED PIER
 - X = CROSS TIE

FIELD INSPECTION REPORT
 276 LEGACY LN
 LILLINGTON, NC
 DATE 09/22/2024 DWG. NO. SHEET NO. 2 OF 2