


2:57

5G+ 46

2025-04-23 10-36.pdf

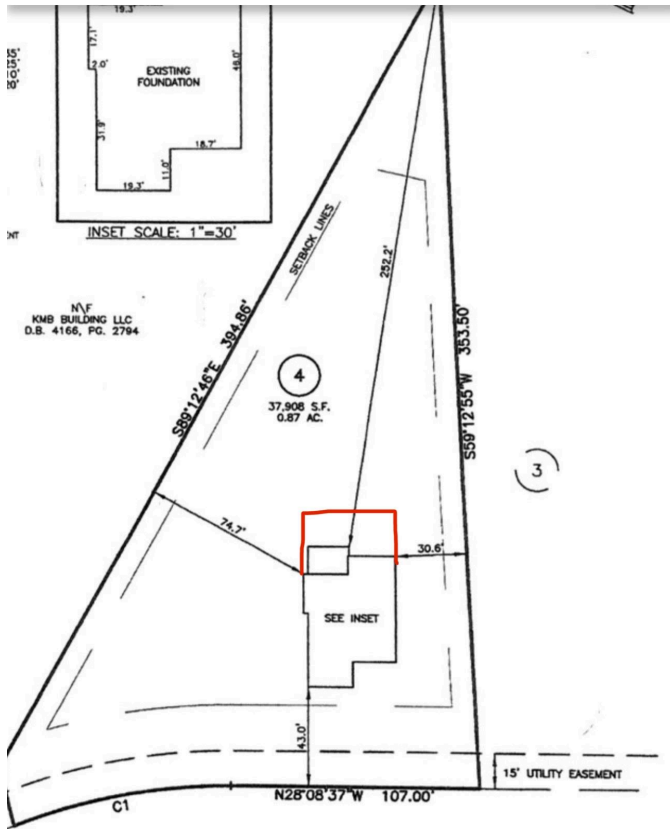

YATES MILL DRIVE  
50' PUBLIC R/W & UTILITY EASEMENT

XLINA  
HAS DRAWN UNDER MY  
IRK DONE UNDER  
IMPROVEMENTS LIE  
THAT THE PROPERTY  
ICEL OR PARCELS OF

THIS AS-BUILT IS  
FOR CODE COMPLIANCE.  
NOT FOR SALES OR  
CONVEYANCE

NOTES

1. THIS SURVEY SUBJECT TO ANY FACTS THAT MAY BE DISCLOSED BY A FULL AND ACCURATE TITLE SEARCH.
2. THIS MAP MAY NOT BE A CERTIFIED SURVEY AND HAS NOT BEEN REVIEWED BY A LOCAL GOVERNMENT AGENCY FOR COMPLIANCE WITH ANY APPLICABLE LAND DEVELOPMENT REGULATIONS AND HAS NOT BEEN REVIEWED FOR COMPLIANCE WITH RECORDING REQUIREMENTS FOR PLATS.

50 0 50  
SCALE: 1" = 50'

6-27-24  
DATE

DATE: JUNE 24, 2024

03/06/2024 4:20 PM

**RWK, PA**  
ENGINEERING - SURVEYING  
CORPORATE LICENSE C-1771  
101 W. MAIN ST., SUITE 202  
GARNER, NC 27529  
PHONE (919) 779-4854  
FAX (919) 779-4056

