
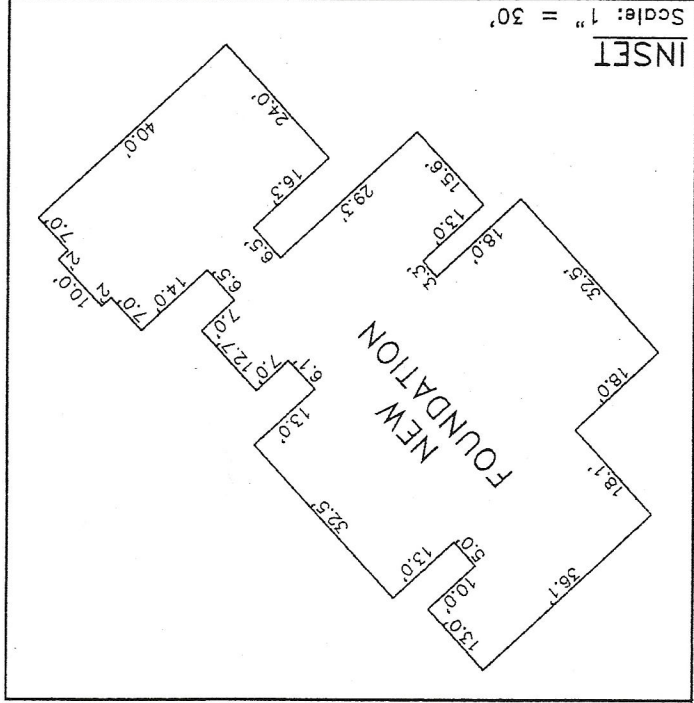


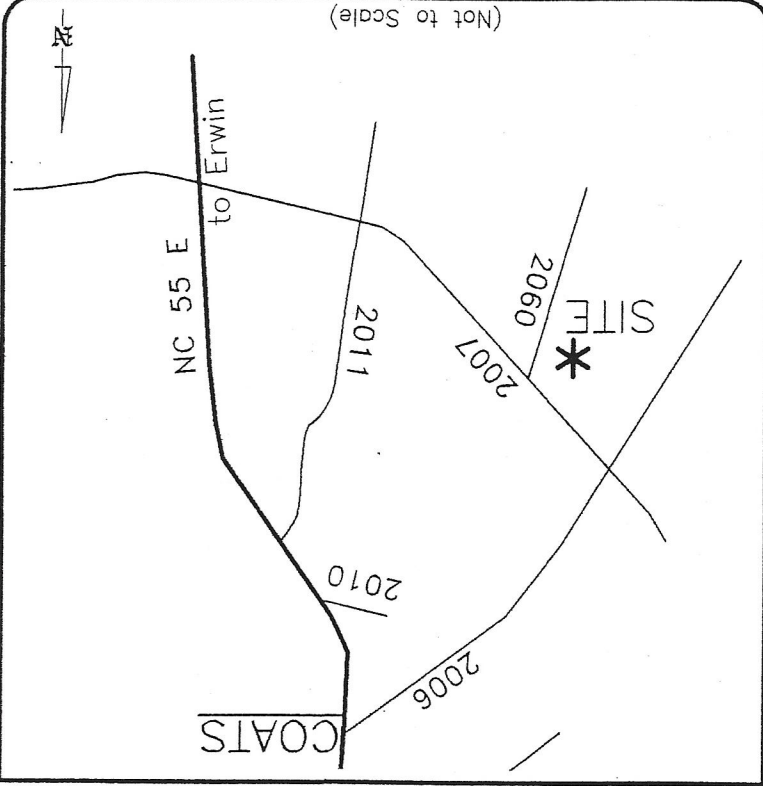

- SYMBOLS & ABBREVIATIONS:
- EIP/EIS... Existing Iron Pipe or Stake
 - ERB... Existing Rebar Stake
 - ERS... Existing Rail Road Spike
 - EPK... Existing Parker-Kaydon Nail
 - ERM... Existing Magnetic Nail
 - ECS... Existing Cotton Picker Spindle
 - ECM... Existing Concrete Monument
 - AC/BG... Above/Below Ground Surface
 - CP... Calculated Point (not set)
 - CNTRL... Control Point - Grid Coordinates
 - ISS... Iron Stake Set (#4 rebar)
 - MNS... Magnetic Nail Set
 - CSS... Cotton Spindle Set
 - FH... Fire Hydrant
 - PP... Power Pole
 - OHE... Overhead Electric Lines
 - Land Hook (Property combined)
 - C/L... Centerline of Road or Easement
 - R/W... Right-of-Way
 - D.B... Deed Book
 - P.B/P.C... Plot Book / Plot Cabinet
 - M.B... Map Book
 - NC PIN... Parcel Identifier Number
 - Ac... Acres (Area of property)
 - SF... Square Feet
 - [123]... House Address

Note:
Foundation location based upon nails set in concrete footing for brick masons on August 9th, 2023. As-built dimensions of foundation confirmed on this date.

I hereby certify that the foundation location shown hereon is correct in relation to property lines of record. Survey is to locate the newly constructed foundation. Other features, fixtures, encumbrances and indications of use may be revealed by a complete site survey.

Robert E. Godwin, Jr.
LAND SURVEYOR
L-3799
NORTH CAROLINA
Professional Seal

Sharon E. Ammons
DB 4179, Pg. 225
Map #2023-208
Map #2022-617 (Tract 2)

Corey Michael Ellis Ammons
& Alyssa Stephenson Ammons
Site Address: 1505 Clayhole Rd., Dunn, NC 28334
Lot 2, Map #2023-208, Deed Book 4192, Page 2521
GROVE TOWNSHIP - HARNETT COUNTY - NORTH CAROLINA
ZONED: RA-30 - PIN: 0599-35-8111.000 - PID: 070599 0034 04

STREAMLINE LAND SURVEYING, Inc.
NC FIRM C-1898
870 NC 55 W, Coats, N.C. 27521
Phone: 910-897-7715
DATE: AUGUST 28, 2023
SURVEYED BY: REG
DRAWN BY: MGG
SCALE: 1" = 50'
FILE: DATA\0599\230608AM.dwg (Foundation)

Harnett County
Minimum Building Setback Requirements
RA-20R, RA-20M,
RA-30 & RA-40
FRONT: 35' from R/W
REAR: 25'
SIDE: 10'
MAXIMUM HEIGHT: 35'

