


Stephenson Builders, Inc
Sept 6-1-18

460 Husley Road, FV
Lot # 1 Private Land
2 acres

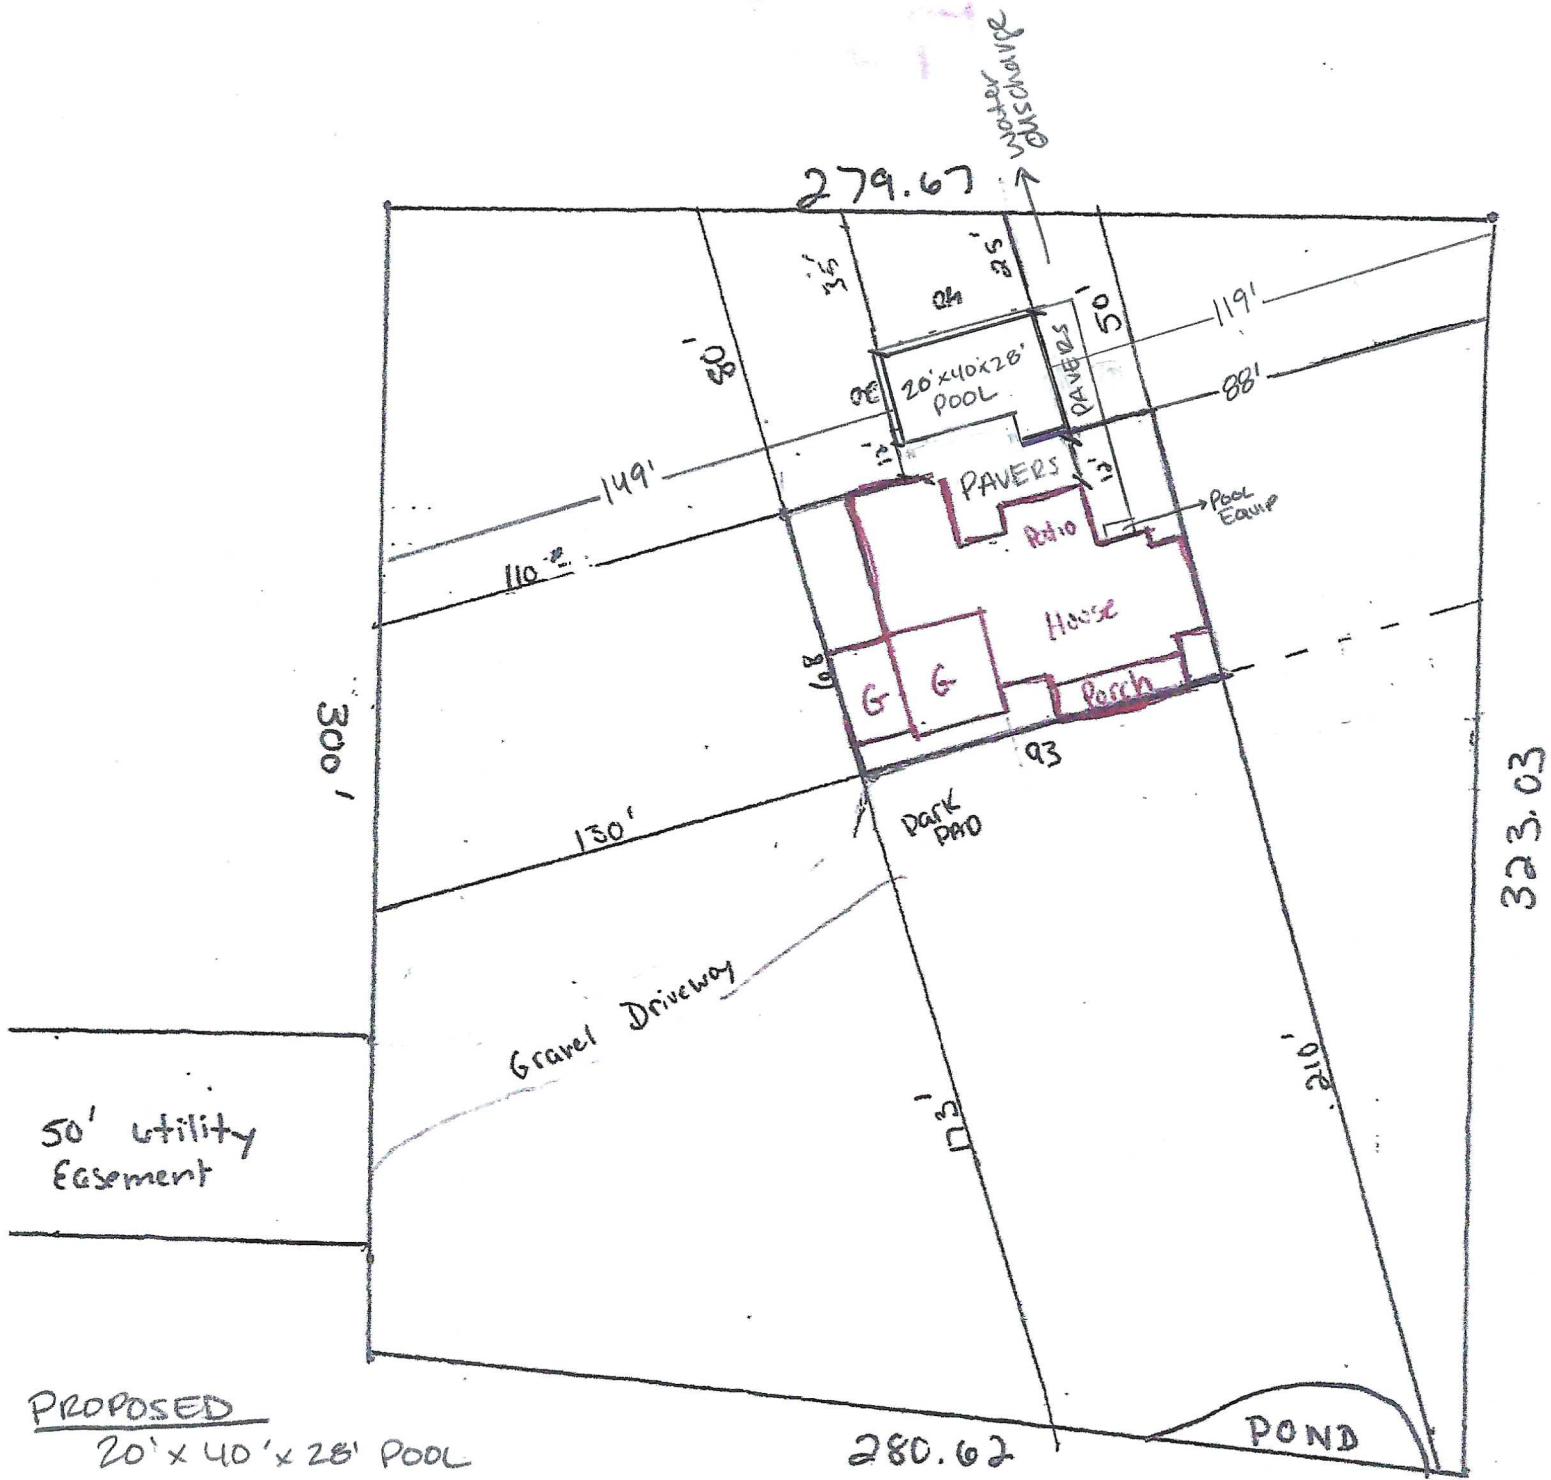

PROPOSED
 20' x 40' x 28' POOL
 PAVER DECKING
 = 1420 SQFT

* Red Line is actual House Corners

Scale 1" = 50 feet