

03-5-0434

Harnett County Central Permitting  
PO Box 65 Lillington, NC 27546

Telephone Number 910-893-4759

Application for ~~Environmental Health Improvement~~ Permit in Areas Zoned by Municipalities

Existing Septic

Landowner Information:

Name: BILL / KELLY JOHNSON

Address: 53 KINGS WAY  
ANGIER, NC

Phone: \_\_\_\_\_

Applicant Information:

Name: VUNCANNON CONSTR, INC

Address: 101 PARKER DR.  
F.U., NC

Phone: 557-7770

Property Location:

E911 Address: 53 KINGS WAY

PIN or Parcel #: PLOT CAB. F / SLIP 434-0.

State Road #: \_\_\_\_\_ Lot/Tract Size: ~~5~~ 346 ACRES

Subdivision: STOCKTON Lot #: 15

Give Specific directions to the property from Lillington: 210 TOWARDS ANGIER  
TURN L. INTO STOCKTON SUBDIVISION, LST L. ON KINGS  
WAY, HOUSE IS ON LEFT.

Proposed Use:


- ( ) Single Family Dwelling (Size \_\_\_\_\_ X \_\_\_\_\_) # of Bedrooms \_\_\_\_\_  
Basement \_\_\_\_\_ Basement w/plumbing \_\_\_\_\_ Deck \_\_\_\_\_
- ( ) Multi-Family Dwelling - # of Units \_\_\_\_\_ # of Bedrooms/Units \_\_\_\_\_
- ( ) Manufactured Home (Size \_\_\_\_\_ X \_\_\_\_\_) # of Bedrooms \_\_\_\_\_ Garage \_\_\_\_\_  
Deck \_\_\_\_\_
- ( ) Number of Persons per Household \_\_\_\_\_
- ( ) Business - Square Footage Retail Space \_\_\_\_\_ Type \_\_\_\_\_
- ( ) Industry - Square Ft. \_\_\_\_\_ Type \_\_\_\_\_
- ( ) Home Occupation - # of Rooms/Size \_\_\_\_\_ Use \_\_\_\_\_
- () Addition to Existing Building - Size 41x14 Use \_\_\_\_\_
- ( ) Other \_\_\_\_\_

Water Supply: ( ) County ( ) Well ( ) Other


Sewer: ( ) New Septic Tank () Existing Septic Tank ( ) Revision ( ) Sewer

Applicant's Signature WR Vuncannon

775 2/5 N

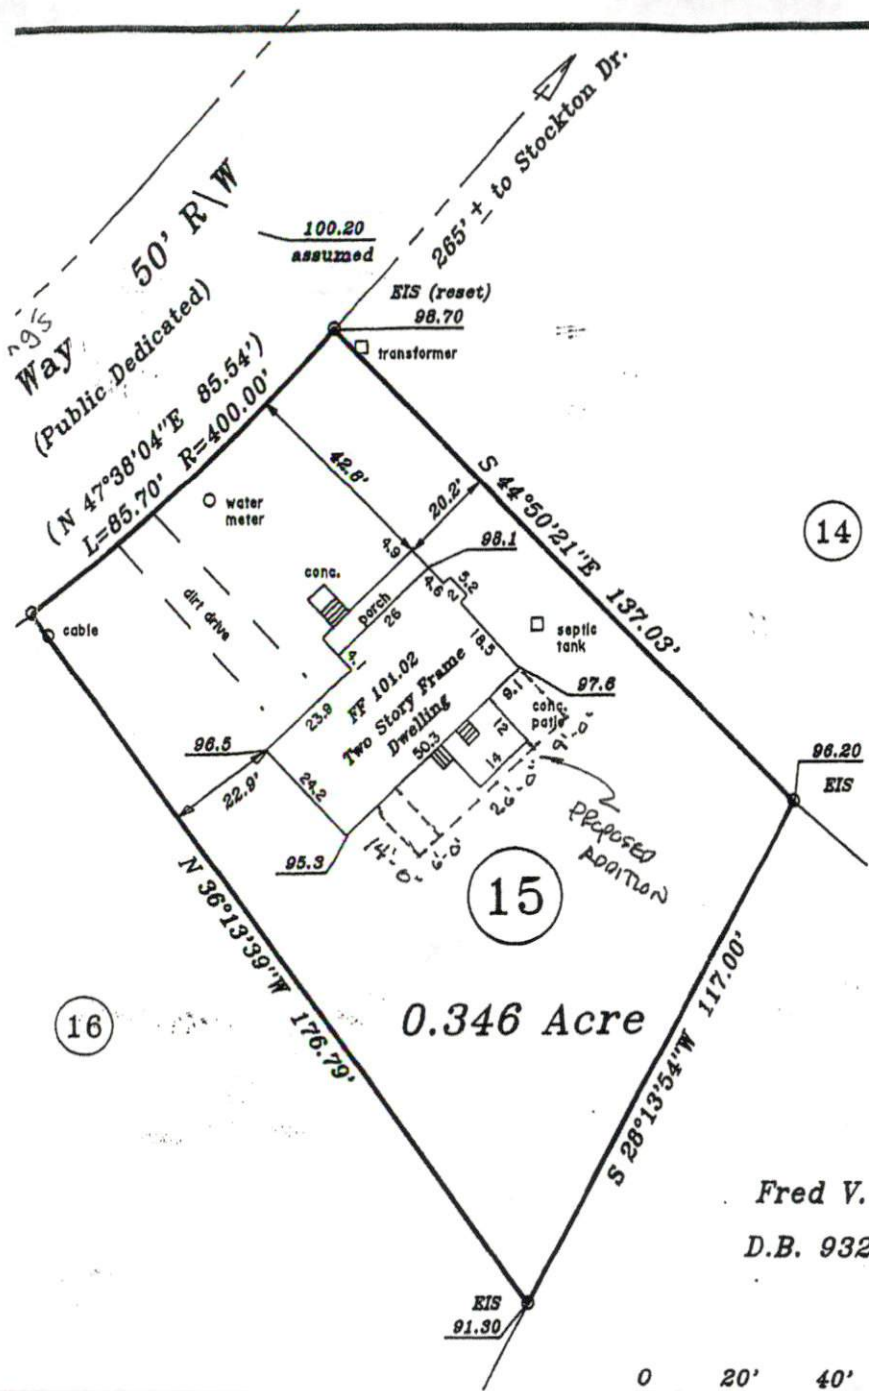

NC GRID  
 NAD 83  
 P. C. F,  
 Slide 436-D

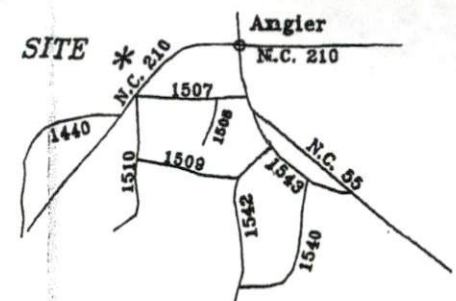

VICINITY MAP

Lot 15, 1107 Kings Way  
 Stockton Subdivision  
 Plat Cabinet F, Slide 436-D

Property Of  
**FREDERICK WILLIAM JOHNSON**  
 and wife  
**KELLY BITTNER JOHNSON**

|                  |                |
|------------------|----------------|
| Black River Twp. | Harnett Co.    |
| Scale 1" = 40'   | Date 9-18-1996 |

Surveyed & Mapped By  
**STANCIL & ASSOCIATES**  
 Registered Land Surveyor, P.A.  
 P.O. Box 730, Angier, N.C. 27501  
 919-639-2133



Fred V. Wilburn  
 D.B. 932, Pg. 883



M.G.E.

FB 1996 31-v

S-H-BK-1009

✓ 22