
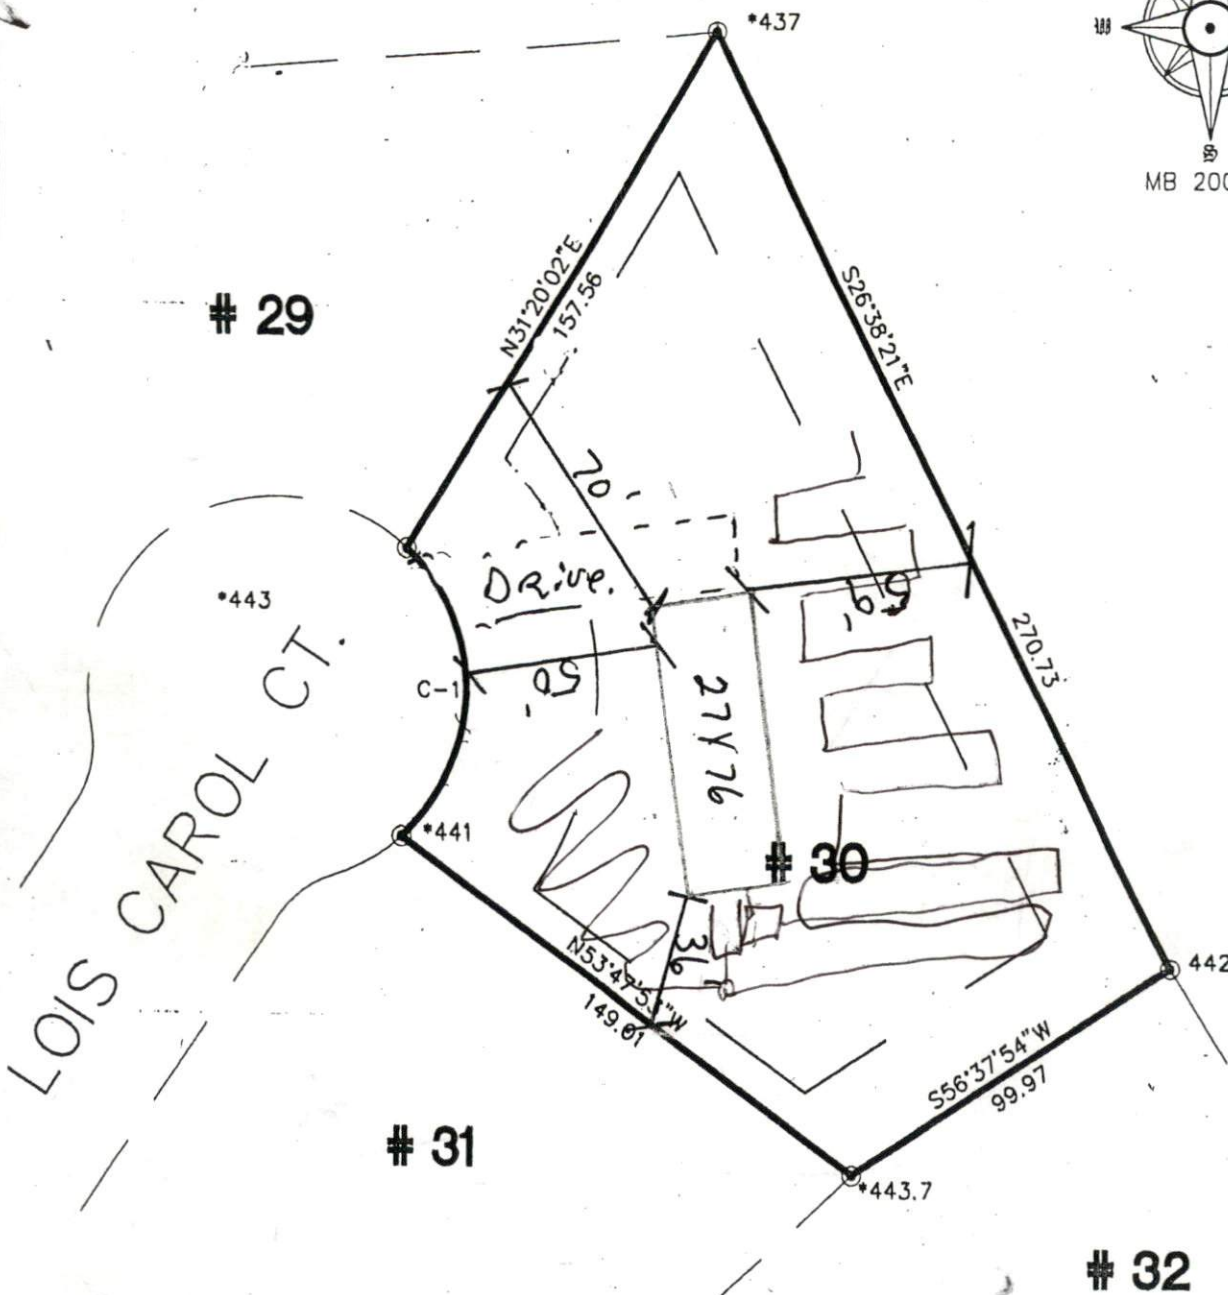


TOWNSHIP: BARBECUE-HARNETT CO., N.C.

SCALE: 1" = 50'

DATE: NOVEMBER 9, 2000

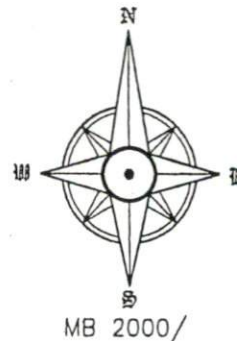

CURVE DATA

C	BEARING	CHD	RAD
C-1	N 00 18 40 E	74.39	50

NOTE:

BEING ALL OF LOT # 30, HEATHER BROOK ESTATES, PHASE 4, RECORDED IN MAP BK 2000, PG , HARNETT COUNTY REG.

ALL IMPROVEMENTS SHOWN AS PROPOSED.

LEGEND:

- FIP FOUND IRON PIPE
- SIP SET IRON PIPE
- R/W RIGHT OF WAY
- ELEVATIONS
- PP POWER POLE

I FURTHER CERTIFY THAT THIS PROPERTY (DOES NOT) LIE WITHIN A SPECIAL FLOOD HAZARD AREA AS DESIGNATED BY FIRM FLOOD INSURANCE

I, **ROBERT J. BRACKEN** CERTIFY THAT UNDER MY DIRECTION AND SUPERVISION THIS MAP WAS DRAWN FROM AN ACTUAL FIELD SURVEY AND THAT THE ERROR OF CLOSURE IS REGULATED BY LATITUDE AND DEPARTURE IS 1373

Robert J. Bracken


BRACKEN & ASSOCIATES

ENGINEER & SURVEYING

P. O. BOX 532 • SANFORD NC 27330
Off (919) 776-5622 Fax (919) 774-6717

Need Batters 2 of RB
May not need Pump

25 Choad
Placed a lot
How is
on side
Wrest

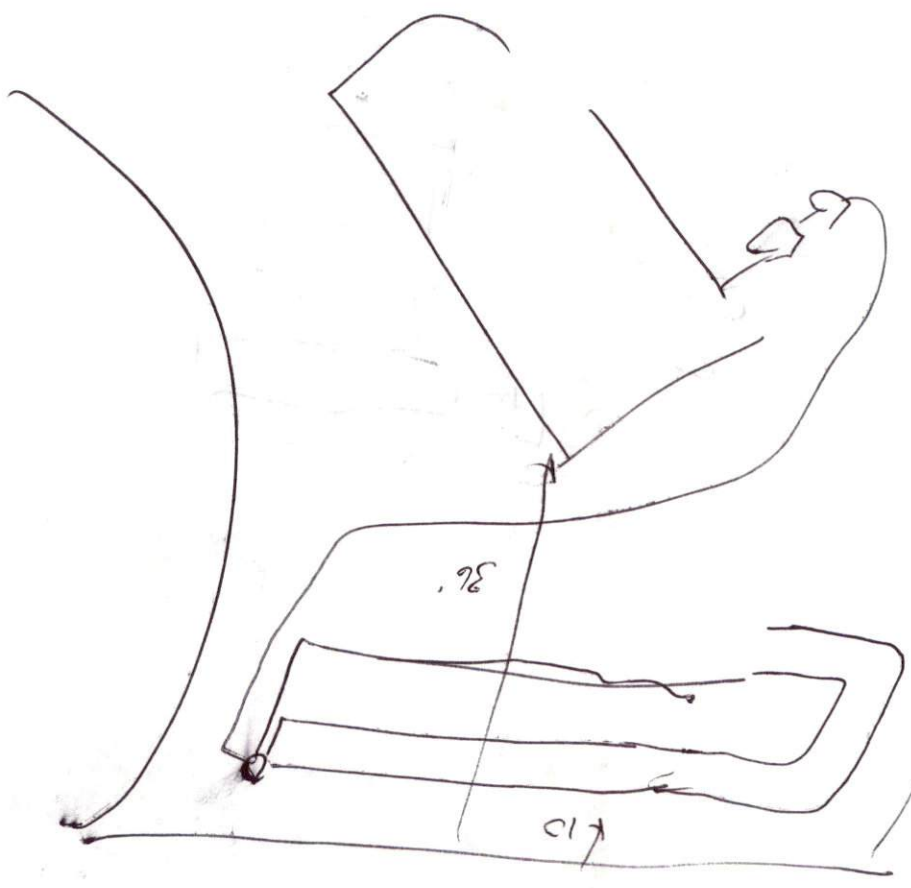

2 1/2
~~8~~
18"

3
~~7~~
3/1

70
15