

HTE 03-5-6079

# IMPROVEMENT PERMIT

20600

Be it ordained by the Harnett County Board of Health as follows: Section III, Item B. "No Person shall begin construction of any building at which a septic tank system is to be used for disposal of sewage without first obtaining a written permit from the Harnett County Health Department."

Name: (owner) James Fort  New Installation  Septic Tank  
Property Location: SR# NC24  Repairs  Nitrification Line

Subdivision VIRANDA Lot # 4

Tax ID # \_\_\_\_\_ Quadrant # \_\_\_\_\_

Number of Bedrooms Proposed: 3 (27x40) Lot Size: 2.66 ac

Basement with Plumbing:  Garage:  This perm. replaces # 19218

Water Supply:  Well  Public  Community SYSTEM was installed but in correct  
Distance From Well: 60 ft. And could not be fixed This is the solution to  
Problem

Following is the minimum specifications for sewage disposal system on above captioned property. Subject to final approval.

Type of system:  Conventional  Other \_\_\_\_\_

Size of tank: Septic Tank: 1000 gallons Pump Tank: \_\_\_\_\_ gallons

Subsurface Drainage Field No. of 4 exact length 75 ft. width of 3 ft. depth of 18 in.  
ditches of each ditch ditches ditches


French Drain Required: \_\_\_\_\_ Linear feet

Date: 6-22-04

This permit is subject to revocation if site plans or intended use change.

Signed: [Signature]  
Environmental Health Specialist

Must meet on site  
Before installing  
SYSTEM Flagged out  
MAY install as 4x75  
or 1x300  
maintain all set back

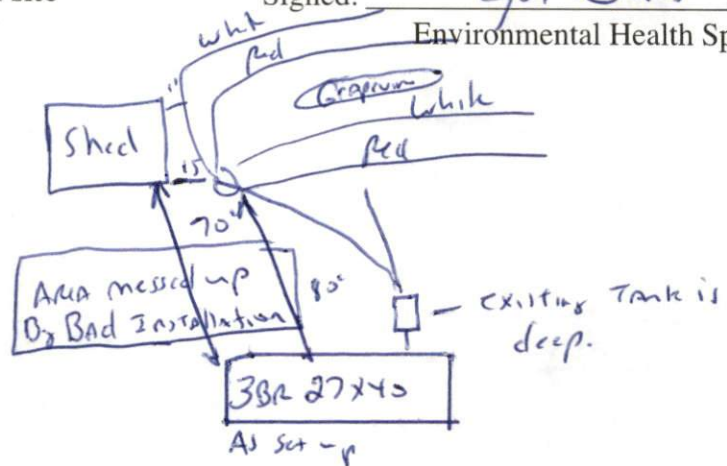

50' EASEMENT

TONE 24 →

Ask  
2nd

HARNETT COUNTY DEPARTMENT OF PUBLIC HEALTH  
AUTHORIZATION TO CONSTRUCT

Authorization is hereby given to construct a wastewater system to the specifications described by Harnett County Department of Public Health, Improvement Permit # 20600. This authorization shall be valid for a period not to exceed five (5) years from the date of issuance. *This authorization will be invalid if ownership, site plans, or intended use change.*

James Fort

Name

Telephone #

5761 Holland St. Fayette, NC

Address

NC 24

Property Location SR#

Road Name

Vivanda

4

3607x401

2-66A2

Subdivision

Lot #

# Bedrooms Proposed

Lot Size

**TYPE OF SYSTEM**

New Installation  Repair  Septic Tank  Nitrification Lines

Conventional  Other \_\_\_\_\_

Basement  With Plumbing  Without Plumbing

Water Supply:  Well  Public Water Supply Minimum Well Setback: 50 Ft.

Septic Tank \_\_\_\_\_ gal Pump Chamber \_\_\_\_\_ gal

**NITRIFICATION FIELD SPECIFICATIONS**

Number of fields 1 # of lines per field 4 Length of lines 75 Ft.

Width of ditches 3 ft. Depth of ditches 18 inches

French Drain: Linear feet required \_\_\_\_\_ Depth of gravel \_\_\_\_\_

No wastewater system shall be covered or placed into use by any person until an inspection by the Harnett County Health Department has determined that the system has been installed according to the conditions of the Improvement Permit and that a valid Operations Permit has been issued.

Joe West RS

Signature of Authorized Agent for Harnett County

6-22-04

Date