

# WELL CONSTRUCTION RECORD

North Carolina - Department of Environment and Natural Resources - Division of Water Quality - Groundwater Section

WELL CONTRACTOR (INDIVIDUAL) NAME (print) Larry Williford CERTIFICATION # 2863  
 WELL CONTRACTOR COMPANY NAME Larry Williford's Well Drilling PHONE # (910) 567-2579  
 STATE WELL CONSTRUCTION PERMITS \_\_\_\_\_ ASSOCIATED WQ PERMITS \_\_\_\_\_  
 (if applicable) (if applicable)

1. WELL USE (Check Applicable Box): Residential  Municipal/Public  Industrial  Agricultural   
 Monitoring  Recovery  Heat Pump Water Injection  Other  If Other, List Use \_\_\_\_\_

2. WELL LOCATION:  
 Nearest Town: Erwin County Harnett  
Pit Rd  
 (Street Name, Number, Community, Subdivision, Lot No., Zip Code)

Topographic/Land setting  
 Ridge  Slope  Valley  Flat  
 (check appropriate box)  
 Latitude/longitude of well location \_\_\_\_\_

3. OWNER: Elbert Maynard  
 Address 1368 W. Blackman Rd  
Dunn NC 28334  
 (Street or Route No.)  
 City or Town State Zip Code


(degrees/minutes/seconds)  
 Latitude/longitude source:  GPS  Topographic map  
 (check box)

DEPTH		DRILLING LOG
From	To	Formation Description
0	2	top soil
2	7	Clay - sand mix
7	18	grayish-orange clay
18	22	sand
22	27	tan clay
27	31	coarse sand & gravel

4. DATE DRILLED 10-08  
 5. TOTAL DEPTH: 31 FT  
 6. DOES WELL REPLACE EXISTING WELL? YES  NO   
 7. STATIC WATER LEVEL Below Top of Casing: 7 FT.  
 (Use "+" if Above Top of Casing)  
 8. TOP OF CASING IS 1 FT. Above Land Surface\*  
 \*Top of casing terminated at/ or below land surface requires a variance in accordance with 15A NCAC 2C .0118.  
 9. YIELD (gpm): 10 METHOD OF TEST pumping  
 10. WATER ZONES (depth): 18-22, 27-31

### LOCATION SKETCH

Show direction and distance in miles from at least two State Roads or County Roads. Include the road numbers and common road names.

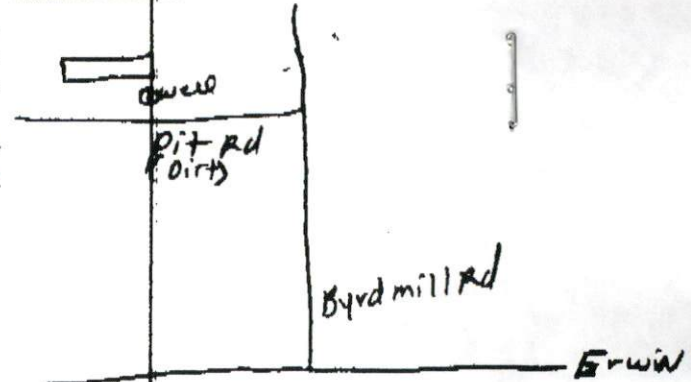

11. DISINFECTION: Type Chlorine Amount 2 gal  
 12. CASING:  
 From 1 To 27 Ft. 2" Diameter or Weight/Ft. SCH40 Material PVC  
 From \_\_\_\_\_ To \_\_\_\_\_ Ft. \_\_\_\_\_ Diameter or Weight/Ft. \_\_\_\_\_ Material \_\_\_\_\_  
 From \_\_\_\_\_ To \_\_\_\_\_ Ft. \_\_\_\_\_ Diameter or Weight/Ft. \_\_\_\_\_ Material \_\_\_\_\_  
 13. GROUT: Depth 0 To 20 Ft. Material Quikrete Method pour  
 From \_\_\_\_\_ To \_\_\_\_\_ Ft. \_\_\_\_\_ Material \_\_\_\_\_ Method \_\_\_\_\_  
 14. SCREEN: Depth 27 To 31 Ft. 2 in. Diameter Slot Size 10/32 in. Material PVC  
 From \_\_\_\_\_ To \_\_\_\_\_ Ft. \_\_\_\_\_ in. Diameter Slot Size \_\_\_\_\_ in. Material \_\_\_\_\_  
 15. SAND/GRAVEL PACK:  
 From 20 To 31 Ft. #3 Size Material sandpack  
 From \_\_\_\_\_ To \_\_\_\_\_ Ft. \_\_\_\_\_ Size Material \_\_\_\_\_

16. REMARKS: \_\_\_\_\_  
 I DO HEREBY CERTIFY THAT THIS WELL WAS CONSTRUCTED IN ACCORDANCE WITH 15A NCAC 2C, WELL CONSTRUCTION STANDARDS, AND THAT A COPY OF THIS RECORD HAS BEEN PROVIDED TO THE WELL OWNER  
Larry Williford SIGNATURE OF PERSON CONSTRUCTING THE WELL  
11-24-08 DATE