

Harnett County Central Permitting  
PO Box 65 Lillington, NC 27546  
Telephone Number 910-893-4759  
www.harnett.org

Application # \_\_\_\_\_

00-500146021  
1180331

**Application for Environmental Health Improvement Permit in Areas Zoned by Municipalities**

Land Owner Information:

Name: BJ Norris  
Address: 94 BJ Norris Lane  
Croats NC 27521  
Phone: 897-7294

Applicant Information:

Name: Same  
Address: \_\_\_\_\_  
Phone: \_\_\_\_\_

Property Location:

E911 Address: Bill Avery Rd  
PIN or Parcel Number: 0090-00-4501.000  
Subdivision: Bobby Joe Norris Lot Number: 3  
State Road Number: 1503 Lot Size: \_\_\_\_\_

Specific Directions to Job from Lillington: Take S1E turn left on Bill Avery Rd  
Take Right on BJ Norris Lane Through Croats on Right

Proposed Use:


- moved house  
 Single Family Dwelling (Size: 360 x 100) # of Bedrooms: 3  
Basement: N/A Basement w/ Plumbing: N/A Deck: N/A
- Multi Family Dwelling # of Units: \_\_\_\_\_ # of Bedrooms/Units: \_\_\_\_\_
- Manufactured Home (Size: \_\_\_\_\_ x \_\_\_\_\_) # of Bedrooms: \_\_\_\_\_  
Garage: \_\_\_\_\_ Deck: \_\_\_\_\_
- Number of Persons per Household 4
- Business Square Footage Retail Space: \_\_\_\_\_ Type: \_\_\_\_\_
- Industry Square Footage: \_\_\_\_\_ Type: \_\_\_\_\_
- Home Occupation # of Rooms: \_\_\_\_\_ Use: \_\_\_\_\_
- Addition to Existing Building Size: \_\_\_\_\_ Use: \_\_\_\_\_
- Other: \_\_\_\_\_

Water Supply:  County  Well  Other

Sewer:  New Septic Tank  Existing Septic Tank  Revision  Sewer

Applicant Signature: B. J. Norris Date: 4/19/2000

4/20/01

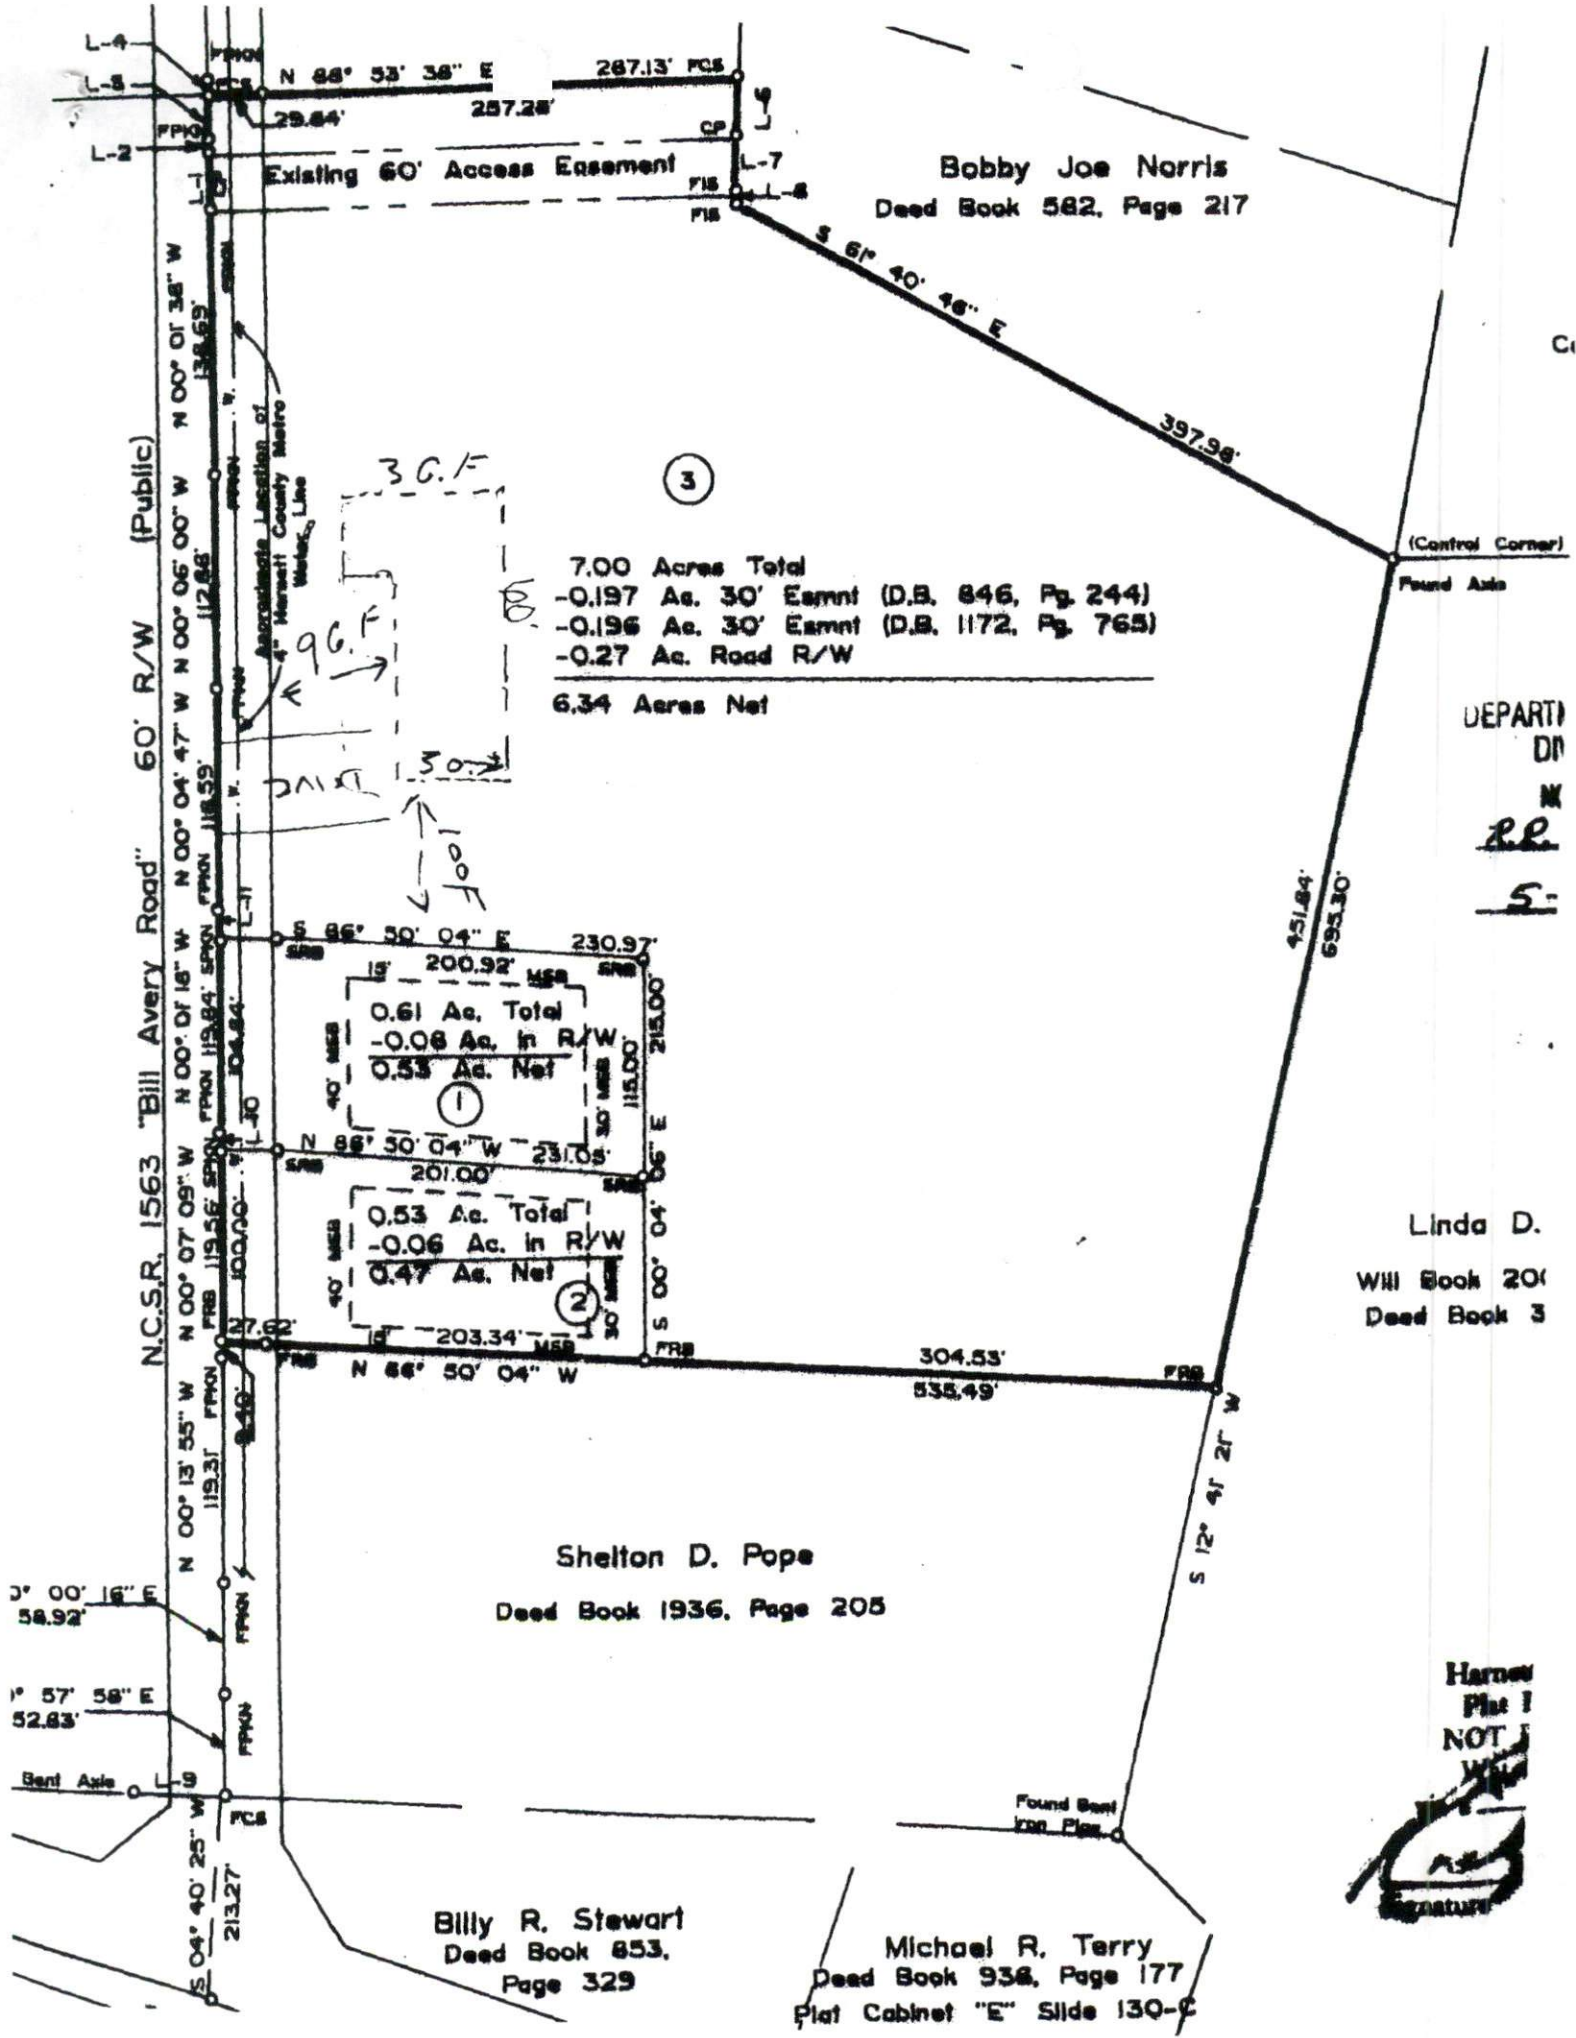

DEPART  
 DI  
 M  
 R.R.  
 S-

Linda D.  
 Will Book 201  
 Deed Book 3

Harnes  
 Plat I  
 NOT I

*[Signature]*




NOTE: This property does not appear to be located within 2,000 Feet of a High Speed System Transmission.

MINIMUM SETBACK REQUIREMENTS  
 Front ..... 40'  
 Side ..... 15'  
 Rear ..... 30'

NORTH CAROLINA

HARNETT COUNTY

This Map/Plan was prepared by Andrew H. Joines, P.L.S. registered in the office of Map Number 003-351 under Title 316 day of SEPT. 05 at 10:16 A.M. 2005  
Kimberly S. Harbrow  
 Register of Deeds  
 BY: L. Bruce W. Lee  
 Asst./Deputy Register of Deeds

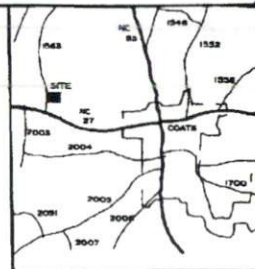

DEPARTMENT OF TRANSPORTATION  
 DIVISION OF HIGHWAYS  
 NO APPROVAL NECESSARY  
 DISTRICT ENGINEER  
 DATE

NOTE: Lot will be surveyed by Harnett County Survey and Subdivision Agency Team.

State of North Carolina  
 County of Harnett  
Shelia K. Bennett Register of Deeds  
 Review Office of Harnett  
 County, hereby certifies that this map or plan is correct and that the same is in full compliance with all laws and regulations of this State and this County.  
Shelia K. Bennett  
 6-5-05  
 Date

I hereby certify that I am the owner of the property above and described herein, which is located in the unincorporated portion of Harnett County, North Carolina and that I hereby adopt this plan of subdivision with my free consent, establish permanent lines or markers, further certify that I have been awarded an equal owner, tenant, option holder or had my legal interest in any property adjacent to or located directly across a street, easement, road, or right of way from the property shown herein.  
Bobby Joe Norris  
 Date

CERTIFICATE OF APPROVAL FOR RECORDING  
 I hereby certify that the subdivision plat above herein has been found to comply with the Subdivision Regulations of the Town of Coats, N.C. and that this plat has been approved for recording in the office of the Register of Deeds of Harnett County.  
Debra J. Davis  
 Subdivision Administrator  
 Town of Coats

I, Andrew H. Joines, Professional Land Surveyor No. 2465, Certify That This Plat is of a Survey That Created a Subdivision of Land Within The Town of a County or Municipality That Has An Ordinance That Regulates Parcels of Land.  
Andrew H. Joines  
 Andrew H. Joines, P.L.S. # 2465

Andrew H. Joines, a Registered Land Surveyor, certifies that this plat and cover with my registration have been filed with the appropriate local jurisdiction in accordance with the provisions of G.S. 170-20.1 and that the same are in full compliance with all laws and regulations of this State and this County.  
Andrew H. Joines  
 Andrew H. Joines, P.L.S. # 2465



LINE DATA:

LINE No.	Description	Distance
L-1	N 00° 15' 57" W	30.00'
L-2	N 00° 15' 57" W	7.31'
L-3	N 00° 10' 56" E	22.63'
L-4	N 00° 26' 06" W	7.29'
L-5	N 00° 27' 55" W	108.62'
L-6	S 02° 44' 35" W	30.07'
L-7	S 02° 44' 38" W	30.07'
L-8	S 02° 44' 38" W	5.60'
L-9	N 86° 50' 04" W	43.54'
L-10	N 00° 57' 05" W	10.38'
L-11	N 00° 51' 18" W	18.04'

7.00 Acres Total  
 -0.197 Ac. 30' Easmt (D.B. 846, Pg. 244)  
 -0.196 Ac. 30' Easmt (D.B. 1172, Pg. 765)  
 -0.27 Ac. Road R/W  
 6.34 Acres Net

DEPARTMENT OF TRANSPORTATION  
 DIVISION OF HIGHWAYS  
 NO APPROVAL NECESSARY  
R.P. Jones  
 DISTRICT ENGINEER  
 5-25-2005  
 DATE

Linda D. Barefoot  
 Will Book 2002E, Page 628  
 Deed Book 360, Page 525

Harnett County Public Utilities  
 Plat Approval Only  
 NOT FOR CONSTRUCTION  
 TO THIS PLAT  
Robert Cant  
 Date

MAJOR SUBDIVISION  
 SURVEY FOR:  
**BOBBY JOE NORRIS**  
 341 Bobby Joe Lane, Coats, NC 27521  
 GROVE TWP., HARNETT COUNTY, N.C.  
 SURVEY BY: JOXNER PIEDMONT SURVEYING  
 2005-05-18-05

ZONE: R-A MAY 11, 2005 SCALE: 1" = 100'  
 Revisors: May 18, 2005  
 Out of PIN # 0680-96-3443-000

This is to certify that I have consulted the Federal Bureau of Investigation's Platted Boundary Maps and found the above property described (a) is not located in a special flood hazard area.  
Andrew H. Joines  
 Andrew H. Joines, P.L.S. # 2465

The Lateral on this plat have been conducted by a private consultant. Based on the review it appears that lateral on this plat meet appropriate regulations. Note that that approval for such lot requires issuance of the appropriate Harnett County Health Department permits for specific use and siting in accordance with regulations. In the event of the State of permitting this certification does not represent approval of a permit for any other work.  
Shelia K. Bennett  
 Date  
 Harnett County Health Department

NOTE: Deed Reference: Deed Book 1902, Page 224



FOR REGISTRATION IN REGISTERED OF DEEDS  
 HARNETT COUNTY, N.C.  
 2005 JUN 03 10 16 58 AM  
 BK 2005 PG 448-450 FEE \$21.00

INSTRUMENT # 2005050758

MAY 11 2005 - 0519

**Harnett County Planning Department**

PO Box 65, Lillington, NC 27546  
910-893-7527

Environmental Health New Septic Systems Test

**Environmental Health Code** 800 *trans*

- Place "property flags" in each corner of lot. All property lines must be clearly flagged.
- Place "house corner flags" at each corner of where the house/manufactured home will sit. Use additional flagging to outline driveways, garages, decks, out buildings, swimming pools, etc.
- Place flags at locations as developed on site plan by Customer Service Technician and you.
- Place Environmental Health "orange" card in location that is easily viewed from road.
- *No grading of property should be done.* Undergrowth should be cleaned out to allow soil evaluation to be performed. Inspectors should be able to walk freely.
- After preparing proposed site call the voice permitting system at 910-893-7527 and give code **800** for Environmental Health confirmation. Please note confirmation number given at end of recording for proof of request.
- To hear results, call IVR in approx. 7-10 working days. Once approved, proceed to Central Permitting for permits.

Environmental Health Existing Tank Inspections

**Environmental Health Code** **800**

- Place Environmental Health "orange" card in location that is easily viewed from road.
- Prepare for inspection by removing soil over door as diagram indicates. Loosen trap door cover. (Unless inspection is for a septic tank in a mobile home park)
- After preparing trapdoor call the voice permitting system at 910-893-7527 and give code **800** for Environmental Health confirmation. Please note confirmation number given at end of recording for proof of request.
- To hear results, call IVR in approx. 7-10 working days. Once approved, proceed to Central Permitting for permits.

Health and Sanitation Inspections

**Health and Sanitation Plan Review** **826**

- After submitting plans for food and lodging, call the voice permitting system at 910-893-7527 and give code **826** for Health and Sanitation confirmation. Please note confirmation number given at end of recording for proof of request.
- To hear results, call IVR in approx. 7-10 working days. Once approved, proceed to Central Permitting for permits.

Fire Marshal Inspections

**Fire Marshall Plan Review Code** **804**

- Call the voice permitting system at 910-893-7527 and give code **804** for plan review. Please note confirmation number given at end of recording for proof of request.
- To hear results, call IVR in approx 7-10 working days. Once approved, proceed to Central Permitting for permits.
- Pick up Fire Marshal's letter and place on job site until work is completed.

Public Utilities

- Place stake with "orange" tape/name thirty feet (30) from the center of the road at the location you wish to have water tap installed.
- Allow four to six weeks after application for water/sewer taps. Call Utilities at 893-7575 for technical assistance.

Building Inspections

- Call the voice permitting system at 910-893-7527 to schedule inspections. Please note confirmation number given at end of recording for proof of request.
- For new housing/set up permits must meet E 911 / Addressing guidelines prior to calling for final inspection.
- To hear results of inspections, call IVR after scheduled inspection is done.

E911 Addressing

**Addressing Confirmation Code** **814**

- Address numbers shall be mounted on the house, 3 inches high (5" for commercial).
- Numbers must be a contrasting color from house, must be clearly visible night and day at entrance of driveway if home is 100 ft or more from road, or if mailbox is on opposite side of road.
- Once you purchase permits and footing inspection has been approved call the voice permitting system at 910-893-7527 and give code **814** for address confirmation. This must be called in even if you have contacted E911 for verbal confirmation.

**Customers can view all inspection results online at [www.harnett.org](http://www.harnett.org).**

Applicant Signature: B J Norris Date: 04/19/2006