

15.50036664

Harnett County Department of Public Health

Well Construction Permit Application

If the information in the application for a Well Construction Permit is *falsified, changed, or the site is altered*, then the Well Construction Permit shall become invalid.

APPLICANT INFORMATION

Thomas Eugene White (919) 389-5685
Applicant/Owner Phone Number
91 Violet Ln Coats, NC 27521
Street Address, City, State, Zip Code

The Applicant must submit a Site Plan. The Site Plan is a map/drawing of the property and must show:
1. existing and/or proposed property lines and easements with dimensions;
2. the location of the facility and appurtenance;
3. the location for the proposed well;
4. the location of existing or proposed sewer lines and/or sewage disposal systems within 100 feet of the proposed well;
5. the location of any existing wells within 100 feet of the property; surface water bodies;
6. above ground and/or underground storage tanks;
7. and any other known sources of contamination within 100 feet of the proposed well site.

The Applicant shall notify the Harnett County Health Director through or by way of the Harnett County Division of Environmental Health if any of the following occur prior to well construction:
1. there is a relocation of the proposed facility;
2. there is a change in the intended use of the facility;
3. there is a need for installing the waste water system in an area other than indicated on the well permit; or
4. there are landscape changed that affect site drainage.

Contact information: Environmental Health Division - 910-893-7547

see back
↓

PROPERTY INFORMATION

Proposed use of well

Single-Family Multifamily Church Restaurant Business Irrigation

Street Address 91 Violet Ln Subdivision/Lot # Dreamland
Parcel # _____ PIN # _____

Directions to the Site

From Killington take 210 to Old Coats Rd. Go through 2 intersections to Hwy 27. Turn left onto 27 go 3 miles + left onto Bill Avery Rd. Violet Lane is on right

I have thoroughly read and completed this Application and certify that the information provided herein is true, complete and correct to the best of my knowledge and is give in good faith. Representatives of the Harnett County Health Department and state officials are granted right of entry to conduct necessary inspections to determine compliance with applicable rules.

I understand that I am solely responsible for the proper identification and labeling of all property lines, underground utility lines, and making the site accessible so that a well can be properly constructed according to the permit.

Thomas E White

7/20/15

Property Owner's of Owner's Legal Representative Signature Required

Date

Harnett County Department of Public Health

Well Abandonment Permit Application

APPLICANT INFORMATION

Thomas Eugene White (419) 389-5685
Applicant/Owner Phone Number

91 Violet Ln Coats, NC 27521
Street Address, City, State, Zip Code

PROPERTY INFORMATION

Street Address 91 Violet Ln Subdivision/Lot # Dreamland

Parcel # _____ PIN # _____

Directions to the Site

Brief description of the well location (ex. front yard, behind out building, front yard, etc.)

front yard in woods

***Please include a Site Plan of your property showing the location of the well. If the well is underground, it must be uncovered prior to the department's site visit.**

Please Complete the Following Information:

Date Well Was Constructed 1994 Grouted: Yes No
Above Ground or Below Ground Total Depth of Well 25 ft
Well Type: Drilled Bored Hand dug Diameter _____ inches

I have thoroughly read and completed this Application and certify that the information provided herein is true, complete and correct to the best of my knowledge and is given in good faith. Representatives of the Harnett County Health Department and State Officials are granted right of entry to conduct necessary inspections to determine compliance with applicable rules.

I understand that I am solely responsible for the proper identification and labeling of all property lines, underground utility lines, and making the site accessible so that a well can be properly constructed according to the permit.

Thomas E White 7/20/19
Property Owner's or Owner's Legal Representative Signature Required Date

If you have any questions please contact Environmental Health Division at 910-893-7547

Harnett
COUNTY
strong roots • new growth

Harnett County GIS


51 VIOLET LN

QUINCY GOLF

house

back

new proposed well

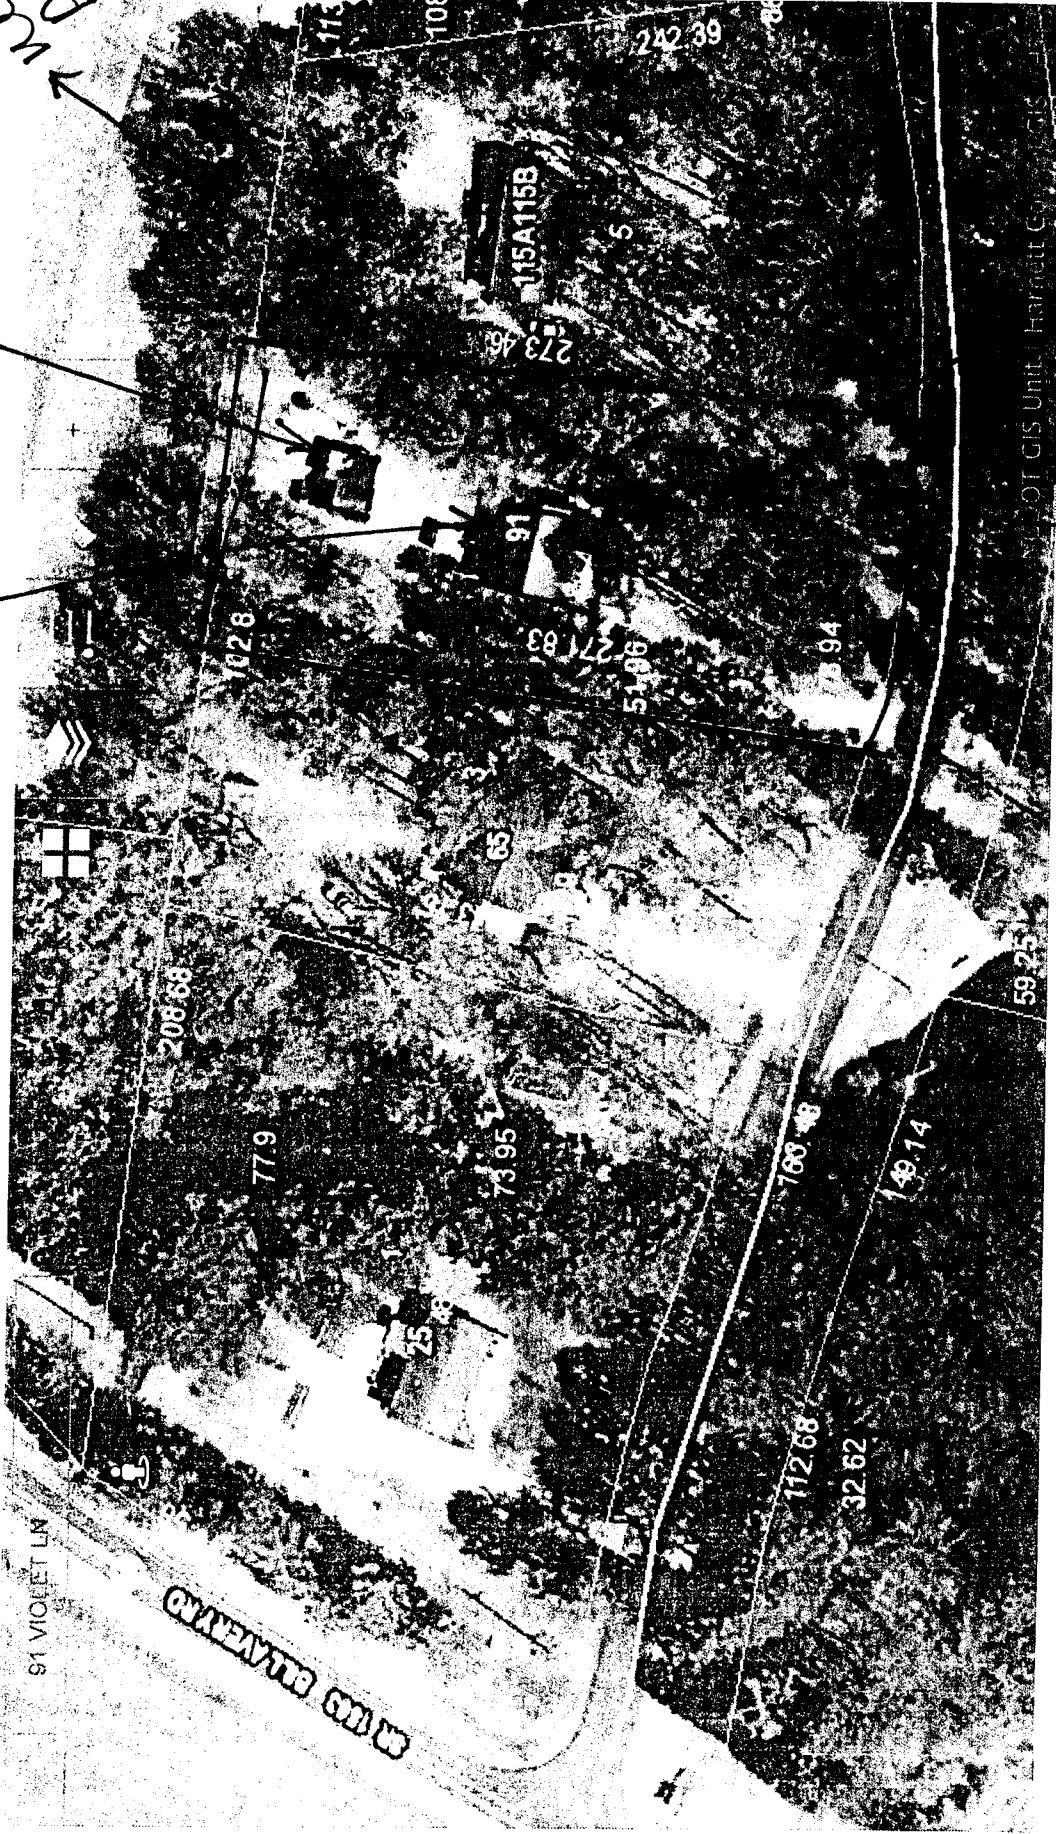

↓ existing old well
 ↓ Violet Ln well SL1590

