

WELL CONSTRUCTION RECORD

North Carolina - Department of Environment and Natural Resources - Division of Water Quality - Groundwater Section

WELL CONTRACTOR (INDIVIDUAL) NAME (print) Larry Williford CERTIFICATION # 2863

WELL CONTRACTOR COMPANY NAME Larry Williford's Well Drilling PHONE # (910) 567-2579

STATE WELL CONSTRUCTION PERMIT# _____ ASSOCIATED WQ PERMIT# _____
(if applicable) (if applicable)

1. WELL USE (Check Applicable Box): Residential Municipal/Public Industrial Agricultural
Monitoring Recovery Heat Pump Water Injection Other If Other, List Use _____

2. WELL LOCATION:
Nearest Town: Dunn County Harnett
1210 Chicken Farm Rd
(Street Name, Number, Community, Subdivision, Lot No., Zip Code)

Topographic/Land setting,
 Ridge Slope Valley Flat
(check appropriate box)
Latitude/longitude of well location _____

3. OWNER: Lee & Jeanett Herring
Address 2501 Parliment Place
Dunn NC 28334
(Street or Route No.)
City or Town State Zip Code

(degrees/minutes/seconds)
Latitude/longitude source: GPS Topographic map
(check box)

DEPTH		DRILLING LOG
From	To	Formation Description
0	2	topsoil
2	7	reddish clay
7	18	orange-white clay
18	21	tan clay
21	35	course sand

4. DATE DRILLED 2-6-12
5. TOTAL DEPTH: 35 FT


6. DOES WELL REPLACE EXISTING WELL? YES NO
7. STATIC WATER LEVEL Below Top of Casing: 16 FT.
(Use "+" if Above Top of Casing)

8. TOP OF CASING IS 1 FT. Above Land Surface*
*Top of casing terminated at/or below land surface requires a variance in accordance with 15A NCAC 2C .011B.

9. YIELD (gpm): 10 METHOD OF TEST pumping
10. WATER ZONES (depth): 21-35

LOCATION SKETCH

Show direction and distance in miles from at least two State Roads or County Roads. Include the road numbers and common road names.

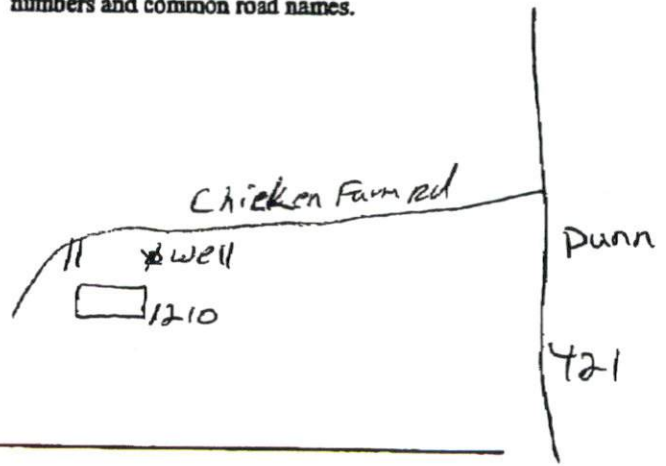

11. DISINFECTION: Type HTH Amount 1/2 cup

12. CASING:

From	To	Depth	Diameter	Wall Thickness	Material
-1	21	Ft.	4"	SC1140	PVC

13. GROUT:

From	To	Depth	Material	Method
0	8	Ft.	Cement	gravity
8	20	Ft.	Bentonite	gravity

14. SCREEN:

From	To	Depth	Diameter	Slot Size	Material
21	35	Ft.	4 in.	016 in.	PVC

15. SAND/GRAVEL PACK:

From	To	Depth	Size	Material
20	35	Ft.	#2	Sandpack

16. REMARKS: _____

I DO HEREBY CERTIFY THAT THIS WELL WAS CONSTRUCTED IN ACCORDANCE WITH 15A NCAC 2C, WELL CONSTRUCTION STANDARDS, AND THAT A COPY OF THIS RECORD HAS BEEN PROVIDED TO THE WELL OWNER

Larry Williford Jr 2-6-12
SIGNATURE OF PERSON CONSTRUCTING THE WELL DATE