Department of Environment, Health, and Natural Resources Division of Environmental Health

Property ID On-site Wastewater Section

## SOIL/SITE EVALUATION for ON-SITE WASTEWATER SYSTEM

Owner:

Applicant:

Sheet:

Lot #. File #:

Code:

Address:

Date Evaluated:

Property Size:

Property Recorded:

Proposed Facility: Location of Site:

Design Flow (.1949):

Water Supply:

[] Public

[] Individual

[] Well

[] Spring

[]Other

Evaluation Method:

[ ] Auger Boring

[]Pit

[] Cut

Type of Wastewater:

[] Sewage

[ ] Industrial Process

[] Mixed

| PROF.       |  |                           | SOILM                          | ORPHOLOGY<br>,1941                 | PROFIL                             | OTHER<br>LE FACTO            | RS                      |                         |                            |
|-------------|--|---------------------------|--------------------------------|------------------------------------|------------------------------------|------------------------------|-------------------------|-------------------------|----------------------------|
| L<br>E<br># | .1940 The Landscape Position/ Landscape Slope% | Horizon<br>Depth<br>(IN.) | .1941<br>Structure/<br>Texture | .1941<br>Consistence<br>Mineralogy | .1942<br>Soil<br>Wetness/<br>Color | .1943<br>Soil<br>Depth (IN.) | .1956<br>Sapro<br>Class | .1944<br>Restr<br>Horiz | Profile<br>Class<br>& LTAR |
|             |  | 2448                      | 51<br>564                      | FRICA                              |                                    | 4/                           |                         |                         |                            |
|             | E.   | 024                       | SL                             | FA/62                              |                                    | <del>((</del> )              |                         |                         | -                          |
|             |  | 024                       | SL                             | FRICA                              |                                    | 48                           |                         |                         | -                          |
|             |  | 024                       | SL                             | FRIGA                              |                                    | ¥x                           |                         |                         |                            |
|             |  | 447                       | SCL                            | FALLA                              |                                    | 10                           |                         |                         | -                          |
|             |  | 024                       | SCL                            | FALL                               |                                    | 48                           |                         |                         |                            |
|             |  | 2441                      | 5(1                            | FALLA                              |                                    | 48                           |                         |                         |                            |
|             |  | 014                       | SL                             | FALCA                              |                                    | 48                           |                         |                         |                            |

| Description             | Initial System | Repair System |
|-------------------------|----------------|---------------|
| Available Space (.1945) |                |               |
| System Type(s)          | GRANEL         | LCC           |
| Site LTAR               | . (            | -7            |

2501. ladutu 57,2

Other Factors (.1946):

Site Classification (.1948):

Evaluated By:

Others Present:

| FILE | # |  |
|------|---|--|
|------|---|--|

| COMMENTS: |  |
|-----------|--|
|           |  |
|           |  |

| LANDSCAPE POSITIONS   | GROUP | TEXTURES   | .1955 LTAR                          | CONSISTENCE MOIST  | WET   |
|---|-------|--|-------------------------------------|--|---|
| R-RIDGE S-SHOULDER SLOPE L-LINEAR SLOPE FS-FOOT SLOPE N-NOSE SLOPE H-HEAD SLOPE CC-CONCLAVE SLOPE CV-CONVEX SLOPE T-TERRACE FP-FLOOD PLAN | п     | S-SAND LS-LOAMY SAND  SL-SANDY LOAM L-LOAM  SI-SILT- SIL-SILT LOAM CL-CLAY LOAM SCL-SANDY CLAY LOAM SICL-SILTY CLAY LOAM | 1.2 - 0.8<br>0.8 - 0.6<br>0.6 - 0.3 | VFR-VERY FRIABLE<br>FR-FRIABLE<br>FI-FIRM<br>VFI-VERY FIRM<br>EFI-EXTREMELY FIRM | NS-NON-STICKY<br>SS-SLIGHTLY STICKY<br>S-STICKY<br>VS-VERY STICKY<br>NP-NON-PLASTIC<br>SP-SLIGHTLY STICKY<br>P-PLASTIC<br>VP-VERY PLASTIC |
|   | IV    | SIC-SILTY CLAY   | 0.4 - 0.1                           |  |   |

STRUCTURE SG-SINGLE GRAIN M-MASSIVE CR-CRUMB GR-GRANULAR SBK-SUBANGULAR BLOCKY ABK-ANGULAR BLOCKY PL-PLATY PR-PRISMATIC


MINERALOGY SLIGHTLY EXPANSIVE

EXPANSIVE

C-CLAY SC-SANDY CLAY

|              |    |   |   |   |   |   | - | j | 1            |       |   | tures   |   |   |        |   |   |   |        |   |      | 1      |     |                 |   |  |
|--------------|----|---|---|---|---|---|---|---|--------------|-------|---|---------|---|---|--------|---|---|---|--------|---|------|--------|-----|-----------------|---|--|
|              | -  |   |   |   |   | 1 |   |   |              |       |   |         |   | - | $\neg$ |   |   | - |        |   |      |        | -   | <br>-1          |   |  |
|              |    | - | - | - | - |   |   | - |              | <br>  |   |         |   | - |        |   |   |   |        | - |      |        |     |                 |   |  |
| -            |    | - |   |   |   |   |   |   |              |       |   |         |   |   |        |   |   |   |        |   |      |        |     |                 |   |  |
|              |    |   |   |   |   |   |   |   |              |       |   |         |   |   |        |   |   |   |        | 1 |      |        |     |                 |   |  |
|              |    |   |   |   |   |   |   |   |              |       |   |         |   |   |        |   |   |   | $\neg$ | - |      |        |     |                 | - |  |
|              |    |   | - | 7 |   |   |   |   |              | <br>  |   |         | _ |   |        |   |   | - |        |   |      |        |     |                 | - |  |
|              | -  |   |   |   |   |   |   |   |              | <br>  |   |         |   |   |        |   |   |   |        |   |      |        |     |                 |   |  |
|              | -  |   |   |   |   |   |   |   |              |       |   |         |   |   |        |   |   |   |        |   |      |        |     |                 |   |  |
|              |    |   |   |   |   |   |   |   |              |       |   |         |   |   |        |   |   |   |        |   |      |        |     |                 |   |  |
|              |    |   |   |   |   |   |   |   |              |       | - |         |   |   |        |   | • |   |        |   |      |        |     | <br>            | - |  |
| -            | 1  |   |   |   |   |   |   |   |              | <br>- |   |         |   |   |        |   |   |   |        |   |      | ****** |     |                 |   |  |
|              |    |   |   |   |   |   |   |   |              | <br>  |   |         |   |   |        |   |   |   |        |   |      |        |     |                 |   |  |
|              |    |   |   |   |   |   |   | - |              |       |   |         |   |   |        |   |   |   |        |   |      |        |     |                 |   |  |
|              | 1  |   |   |   |   |   |   |   |              | <br>1 | T |         | ļ |   |        | ~ |   |   |        |   | **** |        | ~~~ | <br>            |   | na matu Walanda                              |
| <del> </del> | 1- | - |   |   |   |   |   |   |              | <br>  |   |         | - |   |        |   |   |   |        |   | -14  |        |     | <br>            |   |  |
|              |    |   | - |   |   |   |   |   |              | <br>- | - |         |   |   |        |   |   |   |        |   |      |        |     |                 |   |  |
|              |    |   |   |   |   |   |   |   |              |       |   |         |   |   |        |   |   |   |        |   |      |        |     |                 |   |  |
| -            |    |   |   | - |   |   |   |   |              |       |   | -       |   |   |        |   |   |   |        |   |      |        |     | <br>            |   |  |
| 1            | 1. |   |   |   |   |   |   | - |              |       |   | -       |   |   |        |   | ļ |   |        |   |      |        |     | <br>            |   |  |
|              | -  |   |   |   |   |   |   | ļ | ļ            | <br>- | - | <u></u> |   |   |        |   |   |   |        |   |      |        |     | and the same of |   |  |
|              |    |   |   |   |   |   |   |   |              |       | - |         | - |   |        |   |   |   |        |   |      |        |     |                 |   | elelen en e |
| -            |    |   |   |   |   |   |   |   |              | 1     | 1 |         |   | 1 | 1      |   | 1 | 1 |        |   |      | ļ      |     | <br>            |   |  |
| ļ            | -  | ļ |   |   |   |   |   |   | <del> </del> | <br>ļ |   |         | - | ļ |        | ļ |   |   |        |   | L    |        | -   |                 |   |  |

.(##

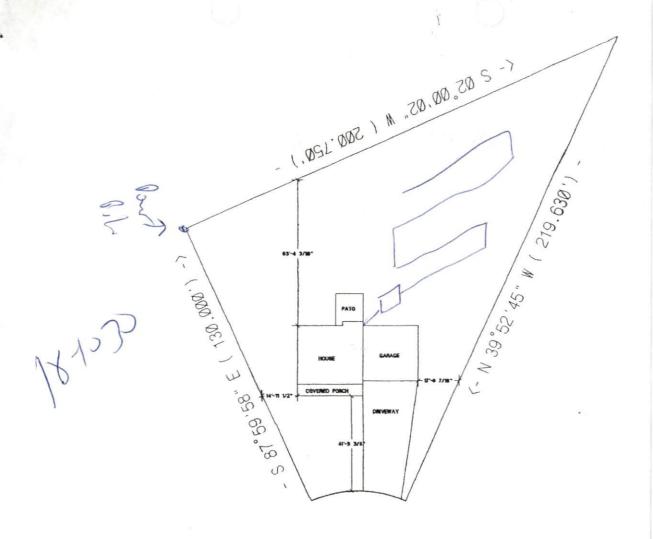

CUMBERLAND HOMES INC.
THE FRANKLIN
LOT# 81 HIGHLAND FOREST
SCALE: 1"=40'

PERMIT COPY