

### SOIL/SITE EVALUATION for ON-SITE WASTEWATER SYSTEM

Owner: \_\_\_\_\_ Applicant: \_\_\_\_\_  
 Address: \_\_\_\_\_ Date Evaluated: \_\_\_\_\_  
 Proposed Facility: \_\_\_\_\_ Design Flow (.1949): \_\_\_\_\_ Property Size: \_\_\_\_\_  
 Location of Site: \_\_\_\_\_ Property Recorded: \_\_\_\_\_  
 Water Supply:  Public  Individual  Well  Spring  Other  
 Evaluation Method:  Auger Boring  Pit  Cut  
 Type of Wastewater:  Sewage  Industrial Process  Mixed

P R O F I L E #	1940 Landscape Position/ Slope%	Horizon Depth (IN.)	SOIL MORPHOLOGY .1941		OTHER PROFILE FACTORS				Profile Class & LTAR
			.1941 Structure/ Texture	.1941 Consistence Mineralogy	.1942 Soil Wetness/ Color	.1943 Soil Depth (IN.)	.1956 Sapro Class	.1944 Restr Horiz	
1	L	0-8	SL	FL GR NSNP					25
		8-30	CLAY	FL GR NSNP - SP	24 or less				
2	L	0-12	SL	FL GR NSNP					-3
		12-42	CLAY	SL FL GR NSNP SS? RAW	30				
3	L	0-10	SL	FL GR NSNP					25
		10-26	SL CLAY	SL FL GR NSNP SP RAW	24				

Description	Initial System	Repair System
Available Space (.1945)	<del>          </del>	<del>          </del>
System Type(s)	<del>          </del>	<del>          </del>
Site LTAR	?	?


Other Factors (.1946): \_\_\_\_\_  
 Site Classification (.1948): \_\_\_\_\_  
 Evaluated By: \_\_\_\_\_  
 Others Present: \_\_\_\_\_





# Michael Anderson Homes, Inc.

## Lot 60 Victoria Hills

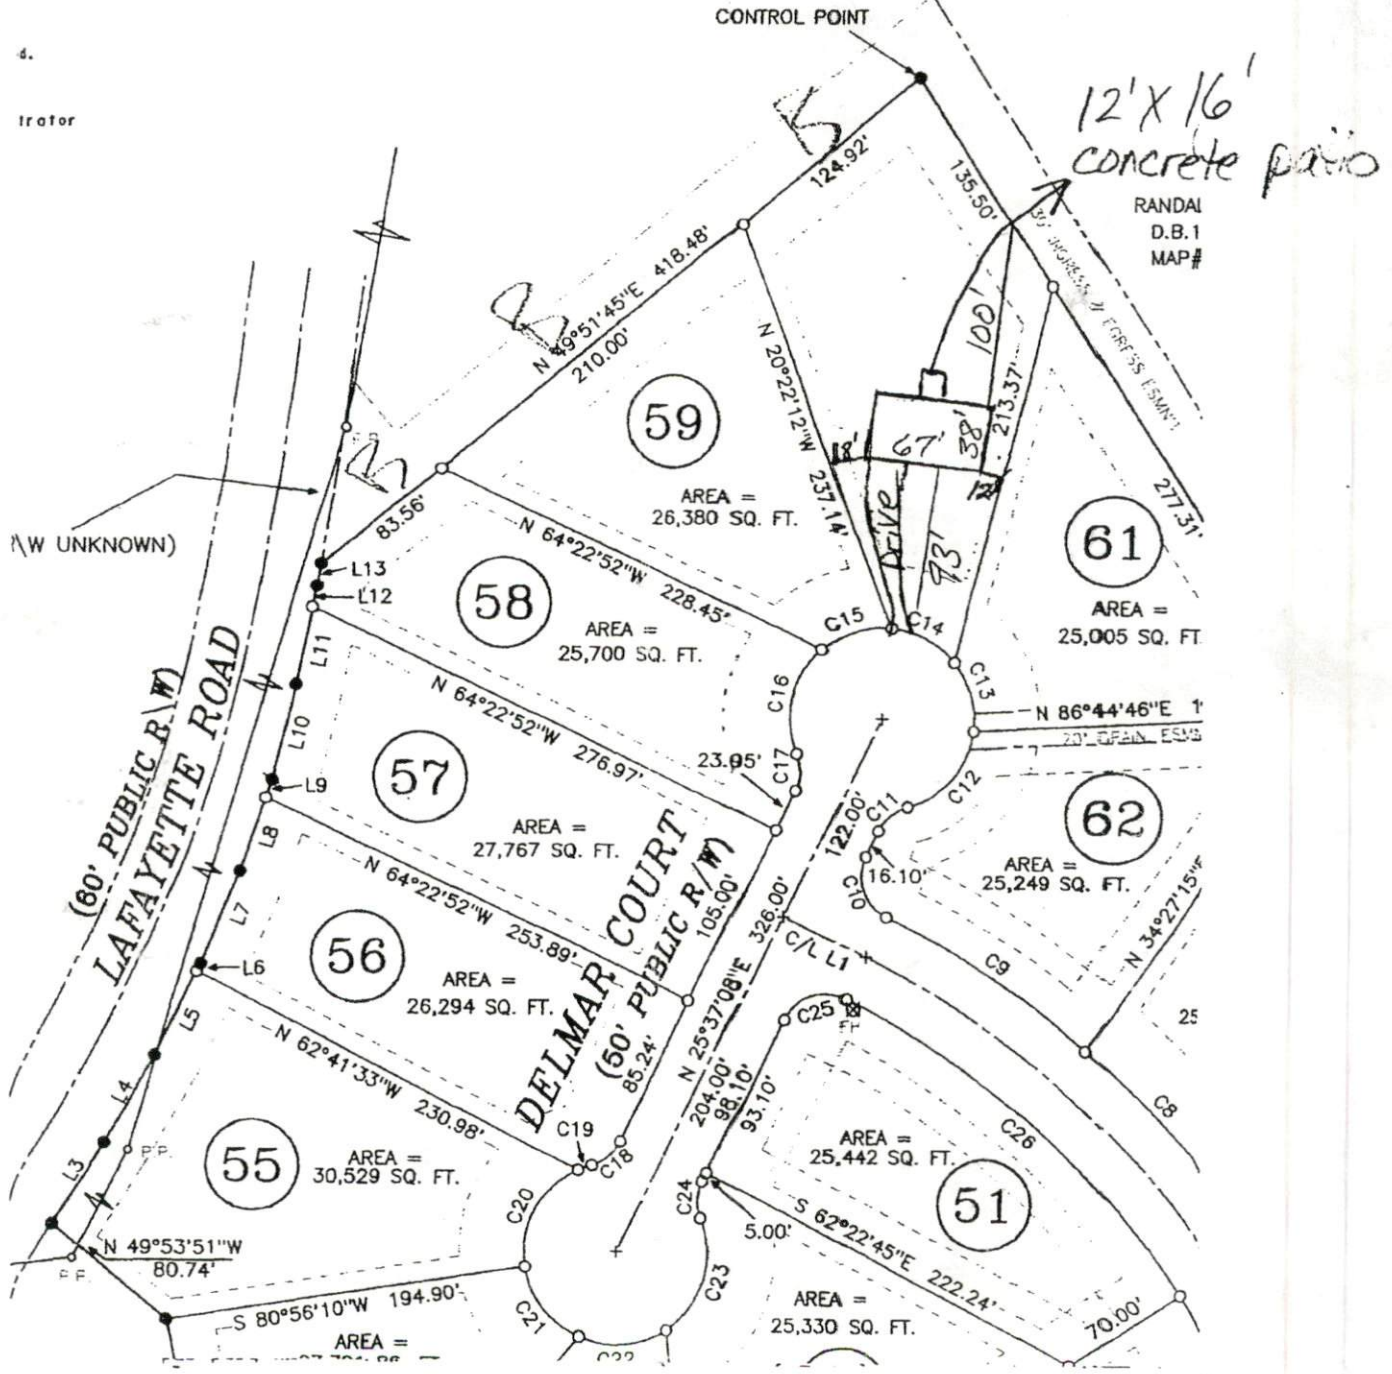

Scale - 1" = 100'

SITE PLAN APPROVAL  
 DISTRICT AA30 USE SFD  
 #BEDROOMS 3  
929-04  
 ZONING ADMINISTRATOR