

Initial Application Date: 10-11-04

Application # 04-50010568

COUNTY OF HARNETT LAND USE APPLICATION

Planning Department 102 E. Front Street, Lillington, NC 27546

Phone: (910) 893-7525 Fax: (910) 893-2793

LANDOWNER: HUTAFF Construction Address: 6000 PUNCH RD
City: Fayetteville NC State: NC Zip: 28305 Phone #: 910-484-5848

APPLICANT: SAME Address: ~~6000 PUNCH RD~~
City: _____ State: _____ Zip: _____ Phone #: _____

PROPERTY LOCATION: SR #: 1141 SR Name: Alpine Dr
Parcel: 03958711002058 PIN: 9596-09-7108.000
Zoning: RA20R Subdivision: Hickland Forest Lot #: 117 Lot Size: .45
Flood Plain: X Parcel: 0075 Watershed: NA Deed Book/Page: 01902/0958 Plat Book/Page: MAP 2003-1165

DIRECTIONS TO THE PROPERTY FROM LILLINGTON: New 275 to Buffalo NC Rd 1mi to
Alpine ~~turn left~~ left 1/2 mi to Hickland Forest

PROPOSED USE:

Sg. Family Dwelling (Size 58 x 26) # of Bedrooms 3 Basement _____ Garage 24x26 Deck Patio 20x12

Multi-Family Dwelling No. Units _____ No. Bedrooms/Unit _____

Manufactured Home (Size x) # of Bedrooms _____ Garage _____ Deck _____

Comments: _____

Number of persons per household 5 per

Business Sq. Ft. Retail Space _____ Type _____

Industry Sq. Ft. _____ Type _____

Home Occupation (Size x) # Rooms _____ Use _____

Accessory Building (Size x) Use _____

Addition to Existing Building (Size x) Use _____

Other _____

Water Supply: County Well (No. dwellings _____) Other _____

Sewer: Septic Tank Existing: YES NO County Other New

Erosion & Sedimentation Control Plan Required? YES NO

Structures on this tract of land: Single family dwellings _____ Manufactured homes _____ Other (specify) _____

Property owner of this tract of land own land that contains a manufactured home w/in five hundred feet (500') of tract listed above? YES NO


Required Property Line Setbacks:	Minimum	Actual	Minimum	Actual
Front	<u>35</u>	<u>35</u>	Rear	<u>25</u>
Side	<u>10</u>	<u>15</u>	Corner	<u>70</u>
Nearest Building	_____	_____		

If permits are granted I agree to conform to all ordinances and the laws of the State of North Carolina regulating such work and the specifications or plans submitted. I hereby swear that the foregoing statements are accurate and correct to the best of my knowledge.

[Signature]
Signature of Applicant

10-11-04
Date

conf 10/18
755285

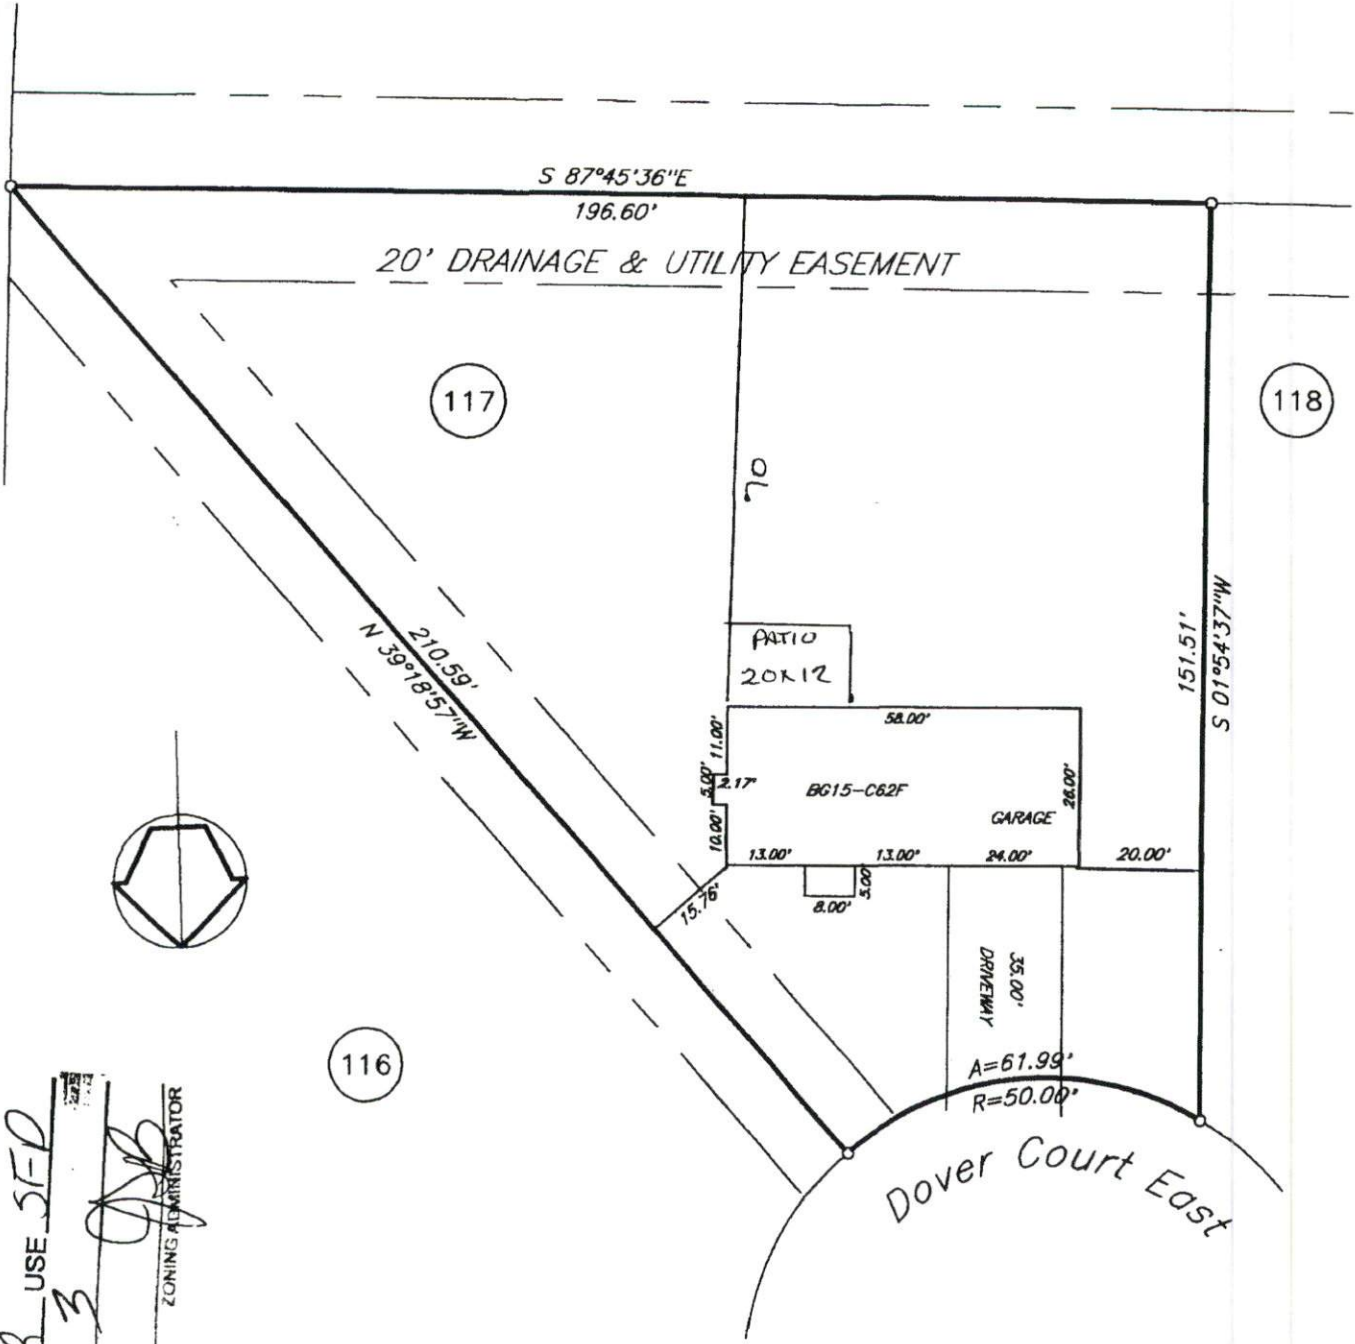

SITE PLAN APPROVAL
 DISTRICT RRB USE SFD
 #BEDROOMS 3
10-13-04
 ZONING ADMINISTRATOR

plot plan

Owner: HUTAFF CONSTRUCTION

Subdivision: Highland Forest

PC # _____ Slide _____ Map No. 2003-1163

Harnett County North Carolina

Scale 1" = 30' Date: 10/08/04 House No. _____

App: on Number: 04-50010568

Phone Access Code: 469353

Harnett County Planning Department

PO Box 65, Lillington, NC 27546
910-893-7527

Environmental Health New Septic Systems Test
Environmental Health Code 800

- Place "property flags" in each corner of lot. All property lines must be clearly flagged approximately every 50 feet between corners.
- Place "house corner flags" at each corner of where the house/manufactured home will sit. Use additional flagging to outline driveways, garages, decks, out buildings, swimming pools, etc.
- Place flags at locations as developed on site plan by Customer Service Technician and you.
- Place Environmental Health "orange" card in location that is easily viewed from road.
- If property is thickly wooded, Environmental Health requires that you clean out the undergrowth to allow the soil evaluation to be performed. Inspectors should be able to walk freely around site. *No grading of property should be done.*
- After preparing proposed site call the voice permitting system at 910-893-7527 and give code 800 for Environmental Health confirmation.
- To hear results, call IVR again. Once approved, proceed to Central Permitting for permits

Environmental Health Existing Tank Inspections
Environmental Health Code 800

- Place Environmental Health "orange" card in location that is easily viewed from road.
- Prepare for inspection by removing soil over door as diagram indicates. Loosen trap door cover.
- After preparing trapdoor call the voice permitting system at 910-893-7527 and give code 800 for Environmental Health confirmation.
- To hear results, call IVR again. Once approved, proceed to Central Permitting for permits

Health and Sanitation Inspections
Health and Sanitation Plan Review 826

- After submitting plans fro food and lodging, call the voice permitting system at 910-893-7527 and give code 826.
- To hear results, call IVR again. Once approved, proceed to Central Permitting for permits

Fire Marshal Inspections
Fire Marshall Plan Review Code 804

- Call the voice permitting system at 910-893-7527 and give code 804 for plan review.
- Pick up Fire Marshal's letter and place on job site until work is completed.
- To hear results, call IVR again. Once approved, proceed to Central Permitting for permits

Public Utilities

- Place stake with "orange" tape/name thirty feet (30) from the center of the road at the location you wish to have water tap installed.
- Allow four to six weeks after application for water/sewer taps. Call Utilities at 893-7575 for technical assistance.

Planning
Planning Plan Review Code 806

- To hear results, call IVR again. Once the plans are approved, proceed to Central Permitting for permits

Building Inspections
Building Plan Review Code 802

- Call the voice permitting system at 910-893-7527 and give code 802 for building plan review.
- For new housing/set up permits ensure you meet E 911 / Addressing prior to calling for final inspection.
- To hear results, call IVR again. Once the plans are approved, proceed to Central Permitting for permits

E911 Addressing

- Address numbers shall be mounted on the house, 3 inches high (5" for commercial).
- Numbers must be a contrasting color from house, must be clearly visible night and day at entrance of driveway if home is 100 ft or more from road, or if mailbox is on opposite side of road.
- Once you purchase permits and footing inspection has been approved call the voice permitting system at 910-893-7527 for address confirmation.
- To hear results, call IVR again.

Applicant Signature: [Signature]

Date: 10-13-04