

Initial Application Date: 12/10/04

Application 450010899

COUNTY OF HARNETT LAND USE APPLICATION

Central Permitting 102 E. Front Street, Lillington, NC 27546 Phone: (910) 893-4759 Fax: (910) 893-2793

LANDOWNER: ~~XXXXXXXXXXXX~~ Regency Homes Inc Mailing Address: 6506 Dental Lane  
City: Fayetteville State: NC Zip: 28314 Phone #: 910 424 0455

APPLICANT: Regency Homes Inc. Mailing Address: 6506 Dental Lane  
City: Fayetteville State: NC Zip: 28314 Phone #: 910 424 0455

PROPERTY LOCATION: SR #: 1141 SR Name: Alpine Road  
Parcel: 03 058710 0000 100 PIN: 9586-99-7786  
Zoning: DHSCP Subdivision: Highland Forest Lot #: 22 Lot Size: .37  
Flood Plain: X Panel: 15 Watershed: N/A Deed Book/Page: 19116/201 Plat Book/Page: 2003-1165

DIRECTIONS TO THE PROPERTY FROM LILLINGTON: 27 W To Tungen to Highland Forest

PROPOSED USE:  
 Sg. Family Dwelling (Size 50 x 33) # of Bedrooms 3 # Baths 2 Basement (w/wo bath) NO Garage 24x24 Deck   
 Multi-Family Dwelling No. Units \_\_\_\_\_ No. Bedrooms/Unit \_\_\_\_\_  
 Manufactured Home (Size \_\_\_\_\_ x \_\_\_\_\_) # of Bedrooms \_\_\_\_\_ Garage \_\_\_\_\_ Deck \_\_\_\_\_  
Comments: Included not included in total size

Number of persons per household SPEC  
 Business Sq. Ft. Retail Space \_\_\_\_\_ Type \_\_\_\_\_  
 Industry Sq. Ft. \_\_\_\_\_ Type \_\_\_\_\_  
 Home Occupation (Size \_\_\_\_\_ x \_\_\_\_\_) # Rooms \_\_\_\_\_ Use \_\_\_\_\_  
 Accessory Building (Size \_\_\_\_\_ x \_\_\_\_\_) Use \_\_\_\_\_  
 Addition to Existing Building (Size \_\_\_\_\_ x \_\_\_\_\_) Use \_\_\_\_\_  
 Other \_\_\_\_\_

Water Supply:  County  Well (No. dwellings \_\_\_\_\_)  Other \_\_\_\_\_  
Sewage Supply:  New Septic Tank  Existing Septic Tank  County Sewer  Other \_\_\_\_\_  
Erosion & Sedimentation Control Plan Required? YES  NO

Structures on this tract of land: Single family dwellings  Manufactured homes \_\_\_\_\_ Other (specify) \_\_\_\_\_  
Property owner of this tract of land own land that contains a manufactured home w/in five hundred feet (500') of tract listed above? YES  NO

Required Property Line Setbacks:	Minimum	Actual	Minimum	Actual
Front	<u>35</u>	<u>36</u>	Rear	<u>25</u>
Side	<u>10</u>	<u>16</u>	Corner	<u>20</u>
Nearest Building	<u>/</u>	<u>/</u>		

If permits are granted I agree to conform to all ordinances and the laws of the State of North Carolina regulating such work and the specifications or plans submitted. I hereby swear that the foregoing statements are accurate and correct to the best of my knowledge.

Rebecca Puczykowski  
Signature of Applicant



12-1-04  
Date

\*\*This application expires 6 months from the date issued if no permits have been issued\*\*

A RECORDED SURVEY PLAT AND RECORDED DEED ARE REQUIRED WHEN APPLYING FOR A LAND USE PERMIT

12/10 N

THIS WILL CERTIFY THAT THE DWELLING IS  IS NOT  LOCATED IN A FLOOD HAZARD AREA, AS DETERMINED BY THE DEPARTMENT OF HOUSING AND URBAN DEVELOPMENT.

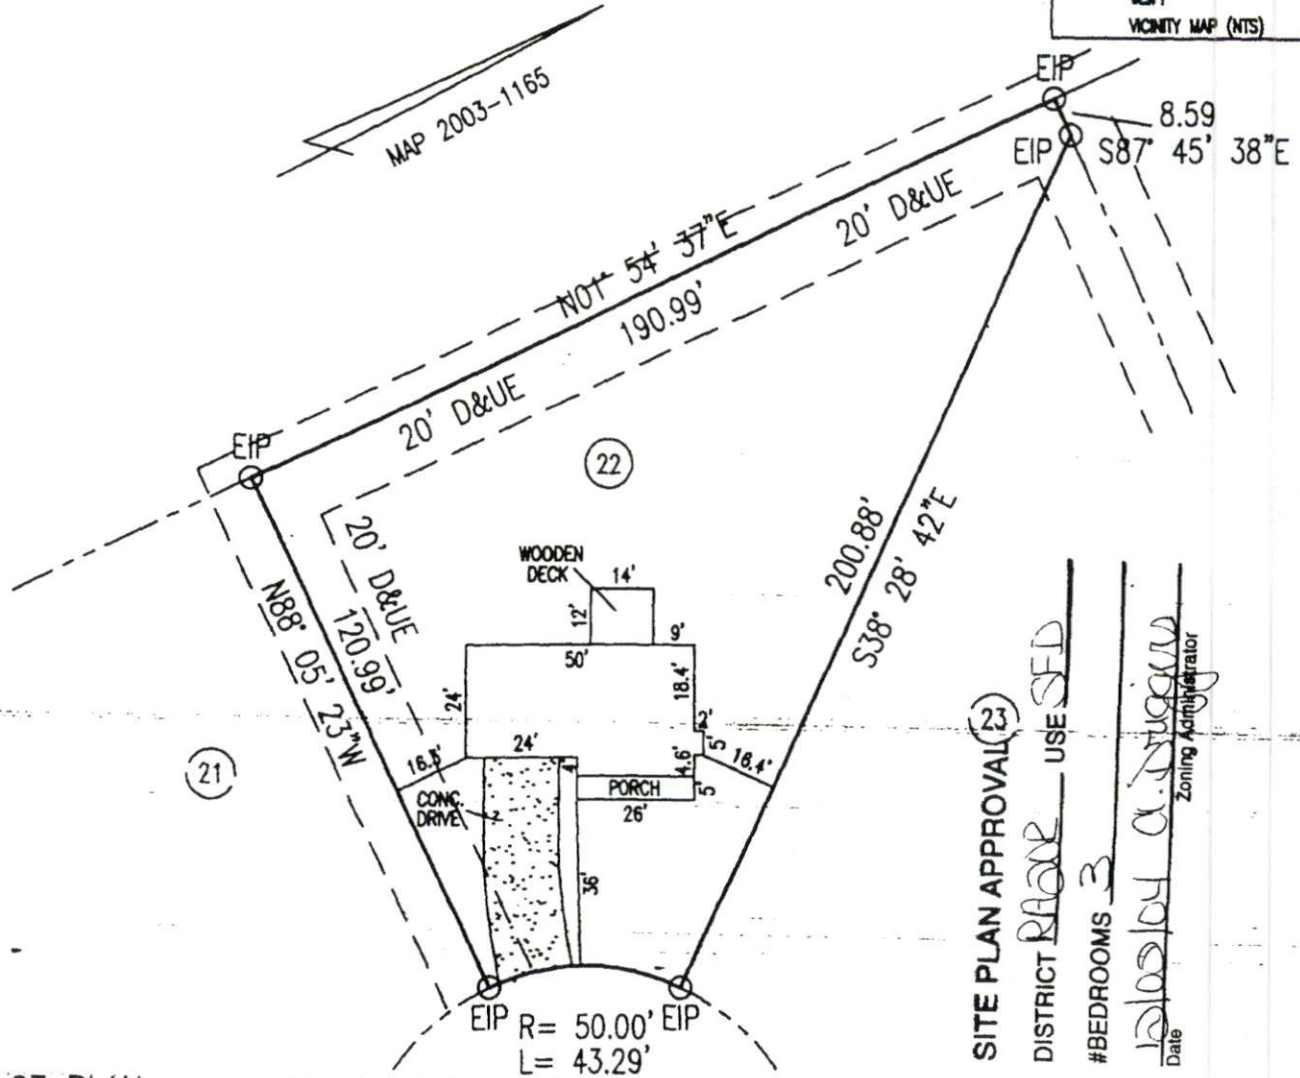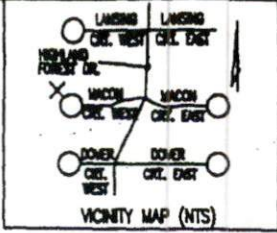

SITE PLAN APPROVAL (23)  
 DISTRICT R30UR USE SFD  
 #BEDROOMS 3  
 Date 11/30/04  
 Zoning Administrator A. Nugent

**PLOT PLAN**

PROPERTY OF: REGENCY CONSTRUCTION  
 ADDRESS OF: MACON COURT WEST  
 CITY OF: SPOUT SPRINGS  
 COUNTY OF: HARNETT  
 TOWNSHIP OF: BARBECUE  
 DATE: 11/30/04  
 SCALE: 1" = 40'  
 REFERENCE: LOT 22 HIGHLAND FOREST MAP, 2003-1165

**MACON COURT WEST**  
**50' PUBLIC R/W**

NOTE: - NOT IN ACCORDANCE WITH GS 47-30

\*\*NOTE\*\* THIS PLAN CAN NOT BE USED FOR RECORDATION OR ATTACHED TO A DEED TO BE RECORDED.

*Harvey H. Allen*  
 HARVEY H. ALLEN



REGISTRATION NO. L-3171  
 ALLEN-ALLEN & ASSOCIATES  
 136-D BOW STREET  
 AYETTEVILLE, NORTH CAROLINA 28301  
 (910) 437-9800



HARNETT COUNTY TAX ID #
03-458710-0020-58
+ 200
4-18-04 BY SLS

FOR REGISTRATION REGISTER OF DEEDS  
 KIMBERLY S. HARGROVE  
 HARNETT COUNTY, NC  
 2004 APR 12 03:15:19 PM  
 BK: 1916 PG: 261-263 FEE: \$17.00  
 NC REV STAMP: \$480.00  
 INSTRUMENT # 2004006567

### NORTH CAROLINA GENERAL WARRANTY DEED

Excise Tax: \$ 480.00

Parcel Identifier No. \_\_\_\_\_ Verified by \_\_\_\_\_ County on the \_\_\_\_\_ day of \_\_\_\_\_, 20\_\_\_\_  
 By: \_\_\_\_\_

Mail/Box to: Grantee Thorp and Clarke P.A. R-0901-03

This instrument was prepared by: R. Daniel Rizzo, Attorney at Law

Brief description for the Index: Lots 18-27 and Lots 91-95 Highland Forest

THIS DEED made this 15th day of March, 2004, by and between

GRANTOR	GRANTEE
NPS ASSOCIATES, a North Carolina Partnership  P. O. Box 727 Dunn, NC 28335	REGENCY HOMES, INC., a North Carolina Corporation  6506 Dental Lane Fayetteville, NC 28314

Enter in appropriate block for each party: name, address, and, if appropriate, character of entity, e.g. corporation or partnership.

The designation Grantor and Grantee as used herein shall include said parties, their heirs, successors, and assigns, and shall include singular, plural, masculine, feminine or neuter as required by context.

WITNESSETH, that the Grantor, for a valuable consideration paid by the Grantee, the receipt of which is hereby acknowledged, has and by these presents does grant, bargain, sell and convey unto the Grantee in fee simple, all that certain lot or parcel of land situated in the City of \_\_\_\_\_, \_\_\_\_\_ Barbecue Township, \_\_\_\_\_ Harnett County, North Carolina and more particularly described as follows:

Being all of Lots 18, 19, 20, 21, 22, 23, 24, 25, 26, 27 and 91, 92, 93, 94, and 95 of Highland Forest Subdivision, as recorded in Map Number 2003-1163 of the Harnett County Registry. And also recorded in Map Number 2003-1165 of the Harnett County Registry.

The property hereinabove described was acquired by Grantor by instrument recorded in Book 1758 page 949.

A map showing the above described property is recorded in Plat Book 2003 page 1163 & 1165

Application Number: \_\_\_\_\_

Phone Access Code: \_\_\_\_\_

### Harnett County Planning Department

PO Box 65, Lillington, NC 27546

910-893-7527

①

Environmental Health New Septic Systems Test

**Environmental Health Code 800**

- Place "property flags" in each corner of lot. All property lines must be clearly flagged approximately every 50 feet between corners.
- Place "house corner flags" at each corner of where the house/manufactured home will sit. Use additional flagging to outline driveways, garages, decks, out buildings, swimming pools, etc.
- Place flags at locations as developed on site plan by Customer Service Technician and you.
- Place Environmental Health "orange" card in location that is easily viewed from road.
- If property is thickly wooded, Environmental Health requires that you clean out the undergrowth to allow the soil evaluation to be performed. Inspectors should be able to walk freely around site. *No grading of property should be done.*
- After preparing proposed site call the voice permitting system at 910-893-7527 and give code 800 for Environmental Health confirmation.
- To hear results, call IVR again. Once approved, proceed to Central Permitting for permits

Environmental Health Existing Tank Inspections

**Environmental Health Code 800**

- Place Environmental Health "orange" card in location that is easily viewed from road.
- Prepare for inspection by removing soil over door as diagram indicates. Loosen trap door cover.
- After preparing trapdoor call the voice permitting system at 910-893-7527 and give code 800 for Environmental Health confirmation.
- To hear results, call IVR again. Once approved, proceed to Central Permitting for permits

Health and Sanitation Inspections

**Health and Sanitation Plan Review 826**

- After submitting plans for food and lodging, call the voice permitting system at 910-893-7527 and give code 826.
- To hear results, call IVR again. Once approved, proceed to Central Permitting for permits

Fire Marshal Inspections

**Fire Marshal Plan Review Code 804**

- Call the voice permitting system at 910-893-7527 and give code 804 for plan review.
- Pick up Fire Marshal's letter and place on job site until work is completed.
- To hear results, call IVR again. Once approved, proceed to Central Permitting for permits

Public Utilities

- Place stake with "orange" tape/name thirty feet (30) from the center of the road at the location you wish to have water tap installed.
- Allow four to six weeks after application for water/sewer taps. Call Utilities at 893-7575 for technical assistance.

Planning

**Planning Plan Review Code 806**

- To hear results, call IVR again. Once the plans are approved, proceed to Central Permitting for permits

Building Inspections

**Building Plan Review Code 802**

- Call the voice permitting system at 910-893-7527 and give code 802 for building plan review.
- For new housing/set up permits ensure you meet E 911 / Addressing prior to calling for final inspection.
- To hear results, call IVR again. Once the plans are approved, proceed to Central Permitting for permits

E911 Addressing

- Address numbers shall be mounted on the house, 3 inches high (5" for commercial).
- Numbers must be a contrasting color from house, must be clearly visible night and day at entrance of driveway if home is 100 ft or more from road, or if mailbox is on opposite side of road.
- Once you purchase permits and footing inspection has been approved call the voice permitting system at 910-893-7527 for address confirmation.
- To hear results, call IVR again.

Applicant Signature

*[Handwritten Signature]*

Date:

*12-2-09*