

Initial Application Date: Dec 29, 2004

Application # 04 B0011009

817441

COUNTY OF HARNETT LAND USE APPLICATION
Central Permitting 102 E. Front Street, Lillington, NC 27546 Phone: (910) 893-4759 Fax: (910) 893-2793

LANDOWNER: Keith Bullock Builders, Inc Mailing Address: 72 Overlook Ct
City: Angier State: NC Zip: 27501 Phone #: 919-639-7424 / 427-4628
APPLICANT: same Mailing Address: _____
City: _____ State: _____ Zip: _____ Phone #: _____

PROPERTY LOCATION: SR #: 1439 SR Name: Wed Denning Rd.
Address: Adams Pointe Ct
Parcel: 04 01 013 0008 05 PIN: 00103-101-4333.000
Zoning: RA-30 Subdivision: Adams Pointe Lot #: 6 Lot Size: .576
Flood Plain: X Panel: 0050 Watershed: IV Deed Book/Page: DTP Plat Book/Page: 500-1160
DIRECTIONS TO THE PROPERTY FROM LILLINGTON: Hwy. 210 N. turn left on James Norris Rd. turn left on wed Denning Rd. turn right into Adams Pointe

PROPOSED USE:

- Sg. Family Dwelling (Size 65 x 50) # of Bedrooms 3 # Baths 2 Basement (w/w/o bath) _____ Garage included Deck included
- Multi-Family Dwelling No. Units _____ No. Bedrooms/Unit _____
- Manufactured Home (Size _____ x _____) # of Bedrooms _____ Garage _____ Deck _____
- Number of persons per household spec.
- Business Sq. Ft. Retail Space _____ Type _____
- Industry Sq. Ft. _____ Type _____
- Church Seating Capacity _____ Kitchen _____
- Home Occupation (Size _____ x _____) # Rooms _____ Use _____
- Additional Information: _____
- Accessory Building (Size _____ x _____) Use _____
- Addition to Existing Building (Size _____ x _____) Use _____
- Other _____

Additional Information: _____
Water Supply: County Well (No. dwellings _____) Other _____
Sewage Supply: New Septic Tank Existing Septic Tank County Sewer Other _____
Erosion & Sedimentation Control Plan Required? YES NO
Property owner of this tract of land own land that contains a manufactured home w/in five hundred feet (500') of tract listed above? YES NO
Structures on this tract of land: Single family dwellings 1 Proposed Manufactured homes _____ Other (specify) _____

Required Residential Property Line Setbacks:

	Minimum	Actual
Front	<u>35</u>	<u>60</u>
Rear	<u>25</u>	<u>90</u>
Side	<u>10</u>	<u>15</u>
Corner	<u>20</u>	<u>/</u>
Nearest Building	<u>10</u>	<u>/</u>

If permits are granted I agree to conform to all ordinances and the laws of the State of North Carolina regulating such work and the specifications or plans submitted. I hereby swear that the foregoing statements are accurate and correct to the best of my knowledge.

[Signature]
Signature of Owner or Owner's Agent


12/29/2004
Date

This application expires 6 months from the initial date if no permits have been issued

A RECORDED SURVEY PLAT AND RECORDED DEED ARE REQUIRED WHEN APPLYING FOR A LAND USE APPLICATION

Lot 6 Adams Pt. Sub. 1" = 50'

3x75 2590 Reductors

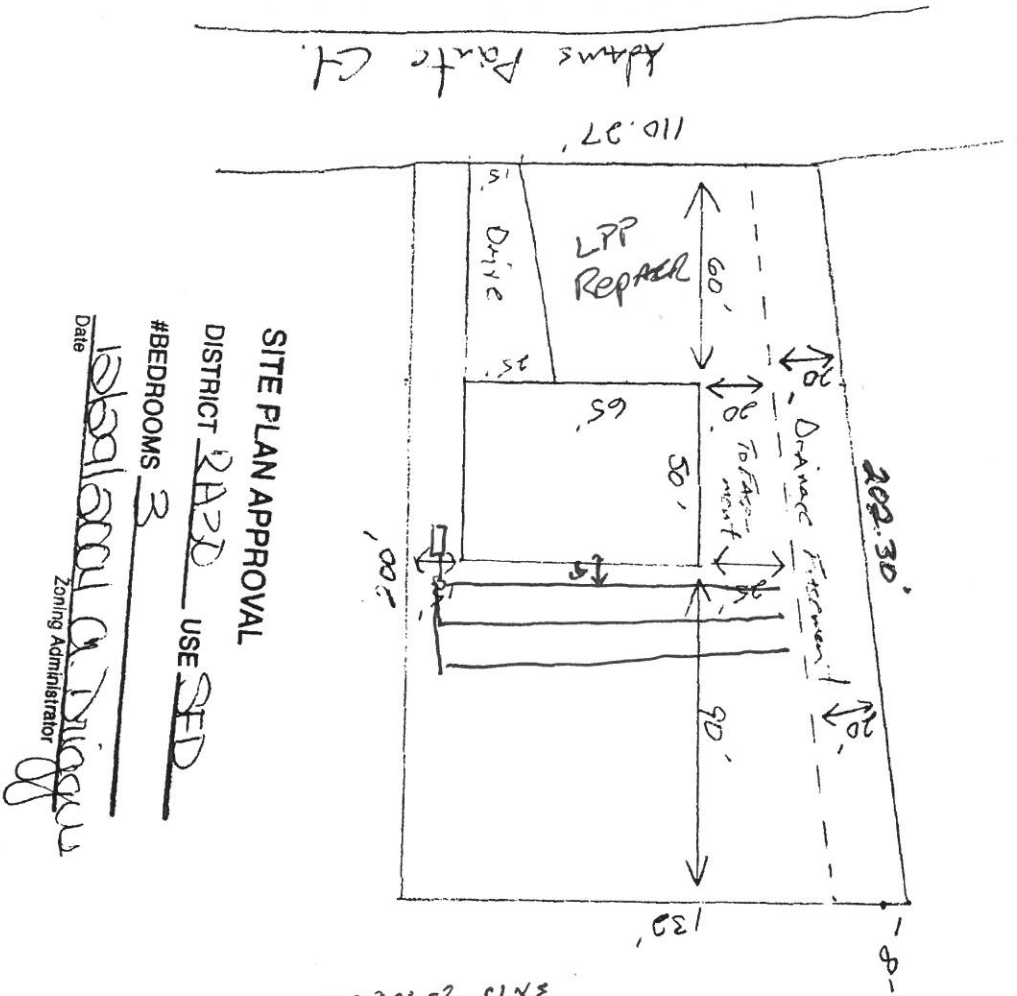

SITE PLAN APPROVAL


DISTRICT RAPD USE SFD

#BEDROOMS 3

Date

Isabel Ann O. Diago
Zoning Administrator

Lot 6 Adams Pt Sub. 1" = 50'

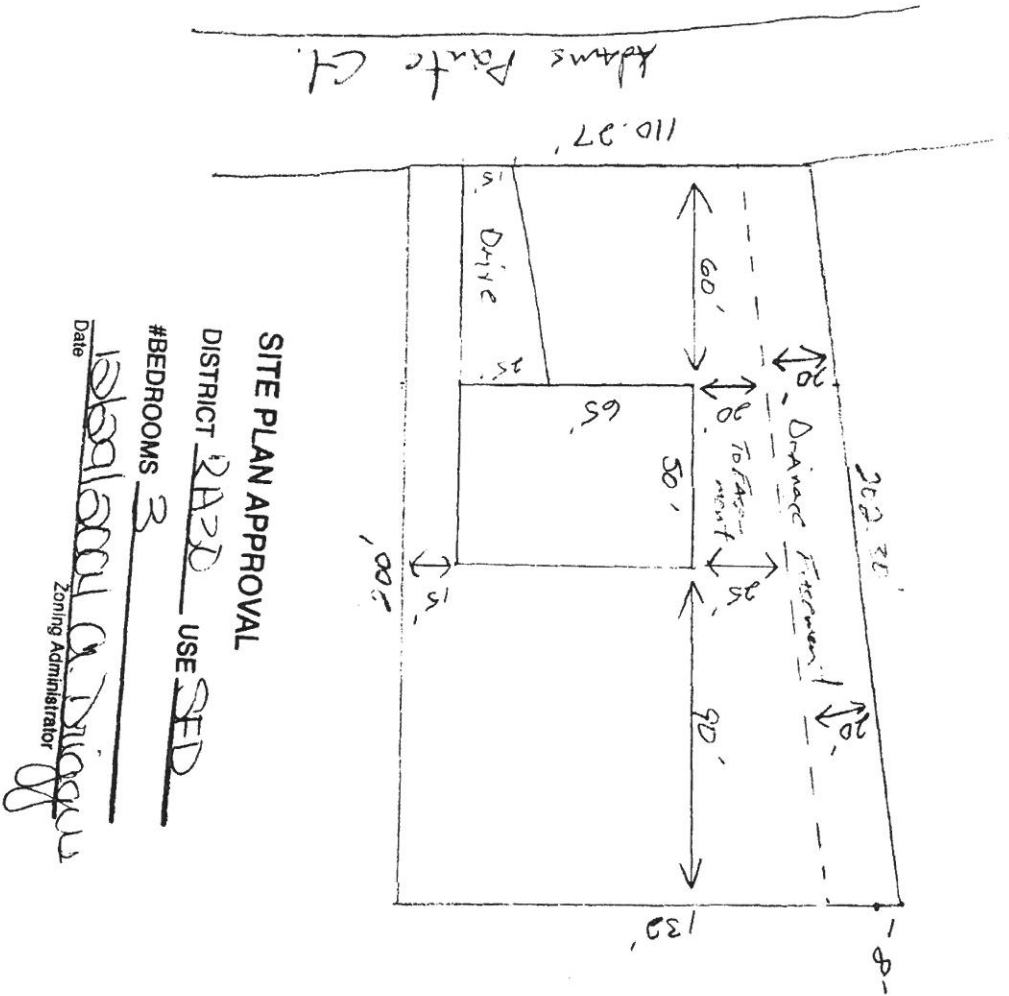

SITE PLAN APPROVAL

DISTRICT RA2D USE SED

#BEDROOMS 3

Date 10/21/2011
Zoning Administrator [Signature]

Application Number: 0450011009

Phone Access Code: _____

Harnett County Planning Department

PO Box 65, Lillington, NC 27546
910-893-7527

- Environmental Health New Septic Systems Test
Environmental Health Code 800
 - Place "property flags" in each corner of lot. All property lines must be clearly flagged approximately every 50 feet between corners.
 - Place "house corner flags" at each corner of where the house/manufactured home will sit. Use additional flagging to outline driveways, garages, decks, out buildings, swimming pools, etc.
 - Place flags at locations as developed on site plan by Customer Service Technician and you.
 - Place Environmental Health "orange" card in location that is easily viewed from road.
 - If property is thickly wooded, Environmental Health requires that you clean out the undergrowth to allow the soil evaluation to be performed. Inspectors should be able to walk freely around site. *No grading of property should be done.*
 - After preparing proposed site call the voice permitting system at 910-893-7527 and give code 800 for Environmental Health confirmation.
 - To hear results, call IVR again. Once approved, proceed to Central Permitting for permits

- Environmental Health Existing Tank Inspections
Environmental Health Code 800
 - Place Environmental Health "orange" card in location that is easily viewed from road.
 - Prepare for inspection by removing soil over door as diagram indicates. Loosen trap door cover.
 - After preparing trapdoor call the voice permitting system at 910-893-7527 and give code 800 for Environmental Health confirmation.
 - To hear results, call IVR again. Once approved, proceed to Central Permitting for permits

- Health and Sanitation Inspections
Health and Sanitation Plan Review 826
 - After submitting plans for food and lodging, call the voice permitting system at 910-893-7527 and give code 826.
 - To hear results, call IVR again. Once approved, proceed to Central Permitting for permits

- Fire Marshal Inspections
Fire Marshall Plan Review Code 804
 - Call the voice permitting system at 910-893-7527 and give code 804 for plan review.
 - Pick up Fire Marshal's letter and place on job site until work is completed.
 - To hear results, call IVR again. Once approved, proceed to Central Permitting for permits

- Public Utilities
 - Place stake with "orange" tape/name thirty feet (30) from the center of the road at the location you wish to have water tap installed.
 - Allow four to six weeks after application for water/sewer taps. Call Utilities at 893-7575 for technical assistance.

- Planning
Planning Plan Review Code 806
 - To hear results, call IVR again. Once the plans are approved, proceed to Central Permitting for permits

- Building Inspections
Building Plan Review Code 802
 - Call the voice permitting system at 910-893-7527 and give code 802 for building plan review.
 - For new housing/set up permits ensure you meet E 911 / Addressing prior to calling for final inspection.
 - To hear results, call IVR again. Once the plans are approved, proceed to Central Permitting for permits

- E911 Addressing
 - Address numbers shall be mounted on the house, 3 inches high (5" for commercial).
 - Numbers must be a contrasting color from house, must be clearly visible night and day at entrance of driveway if home is 100 ft or more from road, or if mailbox is on opposite side of road.
 - Once you purchase permits and footing inspection has been approved call the voice permitting system at 910-893-7527 for address confirmation.
 - To hear results, call IVR again.

Applicant Signature: [Signature] Date: 02/29/04