

Initial Application Date: 1/4/05

Application # 0550011091

822426

Driveway - Cottonade COUNTY OF HARNETT LAND USE APPLICATION

Central Permitting 102 E. Front Street, Lillington, NC 27546 Phone: (910) 893-4759 Fax: (910) 893-2793

Woodshire Partners, LLC.

LANDOWNER: HHT Constructors, Inc. Mailing Address: 2929 Breezewood Ave. Ste. 200  
City: Fayetteville State: NC Zip: 28303 Phone #: 910-486-4864

APPLICANT: HHT Constructors, Inc. Mailing Address: 2929 Breezewood Ave. Ste. 200  
City: Fayetteville State: NC Zip: 28303 Phone #: 910-486-4864

PROPERTY LOCATION: SR #: 1117 SR Name: Nursery Rd.

Parcel: D10520010038110 PIN: \_\_\_\_\_

Zoning: RA-20R Subdivision: Woodshire Lot #: 65 Lot Size: 344

Flood Plain: X Panel: 155 Watershed: N/A Deed Book/Page: 1899/852 Plat Book/Page: Map 2004-1314

DIRECTIONS TO THE PROPERTY FROM LILLINGTON: Hwy 27W. to Nursery Rd. (SR 1117); Turn left on Nursery Rd., Left on Wood Point Dr., Right on Dunbar; Left on Advance; Right on Woodshire Dr.

PROPOSED USE:

Sg. Family Dwelling (Size 59 x 62 Incl. deck) # of Bedrooms 4 # Baths 3 Basement (w/wo bath) NO Garage DBV Deck Incl.

Multi-Family Dwelling No. Units \_\_\_\_\_ No. Bedrooms/Unit \_\_\_\_\_

Manufactured Home (Size \_\_\_\_\_ x \_\_\_\_\_) # of Bedrooms \_\_\_\_\_ Garage \_\_\_\_\_ Deck \_\_\_\_\_

Comments: \_\_\_\_\_ Included

Number of persons per household Spec.

Business Sq. Ft. Retail Space \_\_\_\_\_ Type \_\_\_\_\_

Industry Sq. Ft. \_\_\_\_\_ Type \_\_\_\_\_

Home Occupation (Size \_\_\_\_\_ x \_\_\_\_\_) # Rooms \_\_\_\_\_ Use \_\_\_\_\_

Accessory Building (Size \_\_\_\_\_ x \_\_\_\_\_) Use \_\_\_\_\_

Addition to Existing Building (Size \_\_\_\_\_ x \_\_\_\_\_) Use \_\_\_\_\_

Other \_\_\_\_\_

Water Supply:  County  Well (No. dwellings \_\_\_\_\_)  Other \_\_\_\_\_

Sewage Supply:  New Septic Tank  Existing Septic Tank  County Sewer  Other \_\_\_\_\_

Erosion & Sedimentation Control Plan Required? YES  NO

Structures on this tract of land: Single family dwellings 1 Manufactured homes \_\_\_\_\_ Other (specify) \_\_\_\_\_

Property owner of this tract of land own land that contains a manufactured home w/in five hundred feet (500') of tract listed above? YES  NO

Required Property Line Setbacks:	Minimum	Actual	Minimum	Actual
Front	<u>35'</u>	<u>36'</u>	Rear	<u>25'</u>
Side	<u>10'</u>	<u>19; 21.7'</u>	Corner	<u>20'</u>
Nearest Building	<u>—</u>	<u>—</u>		<u>—</u>

If permits are granted I agree to conform to all ordinances and the laws of the State of North Carolina regulating such work and the specifications or plans submitted. I hereby swear that the foregoing statements are accurate and correct to the best of my knowledge.

Signature of Applicant D. Ralph Hyl


Date 1-03-05

\*\*This application expires 6 months from the date issued if no permits have been issued\*\*

A RECORDED SURVEY PLAT AND RECORDED DEED ARE REQUIRED WHEN APPLYING FOR A LAND USE PERMIT

1-2-05(S)

"COTTONADE CIRC " 50' R/W

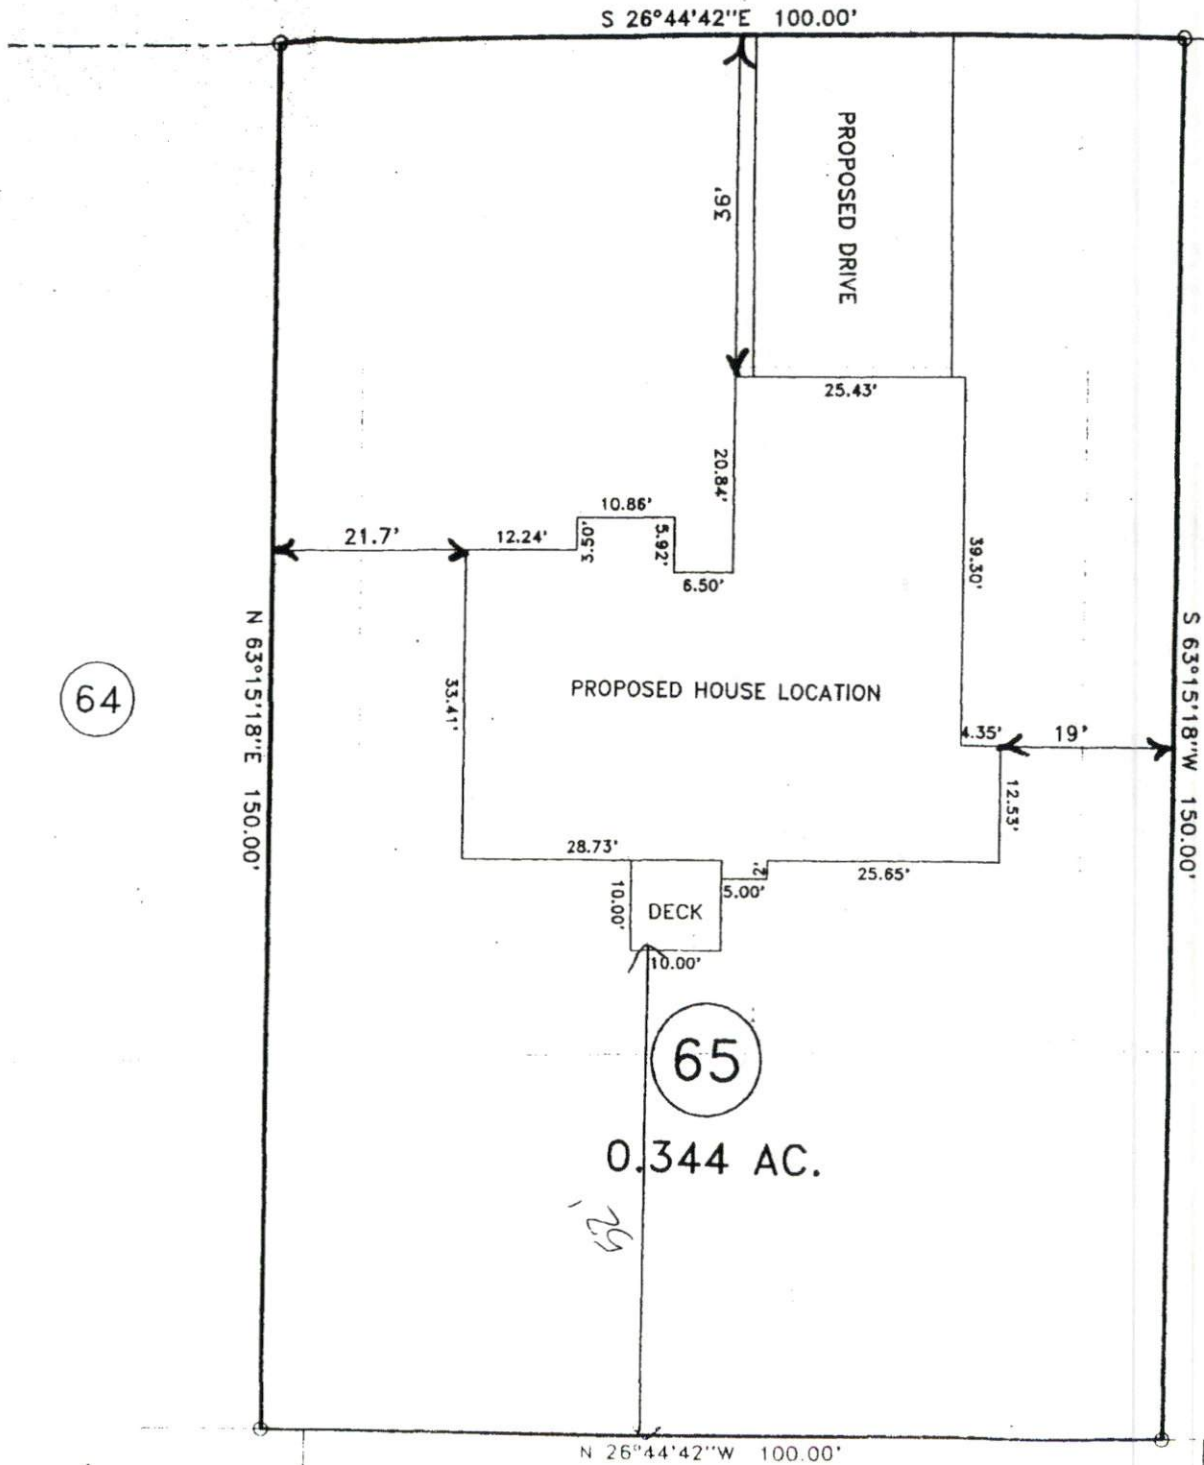

64

65

0.344 AC.

1" = 20'  
 SITE PLAN APPROVAL  
 DISTRICT KAZOR USE SFD  
 #BEDROOMS 4  
1/1/05 PRR  
 Zoning Administrator

72

Application Number: 1450011087  
Phone Access Code: 11088

### Harnett County Planning Department

PO Box 65, Lillington, NC 27546  
910-893-7527

11089  
11090  
11091

Environmental Health New Septic Systems Test

**Environmental Health Code 800**

- Place "property flags" in each corner of lot. All property lines must be clearly flagged approximately every 50 feet between corners.
- Place "house corner flags" at each corner of where the house/manufactured home will sit. Use additional flagging to outline driveways, garages, decks, out buildings, swimming pools, etc.
- Place flags at locations as developed on site plan by Customer Service Technician and you.
- Place Environmental Health "orange" card in location that is easily viewed from road.
- If property is thickly wooded, Environmental Health requires that you clean out the undergrowth to allow the soil evaluation to be performed. Inspectors should be able to walk freely around site. *No grading of property should be done.*
- After preparing proposed site call the voice permitting system at 910-893-7527 and give code 800 for Environmental Health confirmation.
- To hear results, call IVR again. Once approved, proceed to Central Permitting for permits

Environmental Health Existing Tank Inspections

**Environmental Health Code 800**

- Place Environmental Health "orange" card in location that is easily viewed from road.
- Prepare for inspection by removing soil over door as diagram indicates. Loosen trap door cover.
- After preparing trapdoor call the voice permitting system at 910-893-7527 and give code 800 for Environmental Health confirmation.
- To hear results, call IVR again. Once approved, proceed to Central Permitting for permits

Health and Sanitation Inspections

**Health and Sanitation Plan Review 826**

- After submitting plans for food and lodging, call the voice permitting system at 910-893-7527 and give code 826.
- To hear results, call IVR again. Once approved, proceed to Central Permitting for permits

Fire Marshal Inspections

**Fire Marshall Plan Review Code 804**

- Call the voice permitting system at 910-893-7527 and give code 804 for plan review.
- Pick up Fire Marshal's letter and place on job site until work is completed.
- To hear results, call IVR again. Once approved, proceed to Central Permitting for permits

Public Utilities

- Place stake with "orange" tape/name thirty feet (30) from the center of the road at the location you wish to have water tap installed.
- Allow four to six weeks after application for water/sewer taps. Call Utilities at 893-7575 for technical assistance.

Planning

**Planning Plan Review Code 806**

- To hear results, call IVR again. Once the plans are approved, proceed to Central Permitting for permits

Building Inspections

**Building Plan Review Code 802**

- Call the voice permitting system at 910-893-7527 and give code 802 for building plan review.
- For new housing/set up permits ensure you meet E 911 / Addressing prior to calling for final inspection.
- To hear results, call IVR again. Once the plans are approved, proceed to Central Permitting for permits

E911 Addressing

- Address numbers shall be mounted on the house, 3 inches high (5" for commercial)
- Numbers must be a contrasting color from house, must be clearly visible night and day at entrance of driveway if home is 100 ft or more from road, or if mailbox is on opposite side of road
- Once you purchase permits and footing inspection has been approved call the voice permitting system at 910-893-7527 for address confirmation
- To hear results, call IVR again

Applicant: \_\_\_\_\_ Date: \_\_\_\_\_