

ENV. Rec'd 11/3/05

Initial Application Date: 2-2-05 11/2/05

Application # 05-50011460R

COUNTY OF HARNETT LAND USE APPLICATION

1084105

PJK

Planning Department 102 E. Front Street, Lillington, NC 27346

Phone: (910) 893-7525 Fax: (910) 893-2793

LANDOWNER: IOM Developers, Inc Address: 466 Stawcill Road
City: Angier State: NC Zip: 27501 Phone #: 639-2073

APPLICANT: Bradley Built, Inc Address: 466 Stawcill Road
City: Angier State: NC Zip: 27501 Phone #: 639-2073

PROPERTY LOCATION: SR #: 1415 SR Name: Rawls Church Rd
Parcel: 04 0664 0157-04 PIN: 0674-08-1256.000
Zoning: BA30 Subdivision: Alex Place Lot #: 4 Lot Size: 1.03
Flood Plain: X Panel: 0050 Watershed: IV Deed Book/Page: 1939/554 Plat Book/Page: 2005/149

DIRECTIONS TO THE PROPERTY FROM LILLINGTON: 210 to Angier left on
55 - Left Rawls Church Rd - S/D on left

PROPOSED USE:

- Sg. Family Dwelling (Size 40 x 60) # of Bedrooms 3 Basement NA Garage yes Deck yes
- Multi-Family Dwelling No. Units _____ No. Bedrooms/Unit _____ included
- Manufactured Home (Size ___ x ___) # of Bedrooms _____ Garage _____ Deck _____

Comments:

- Number of persons per household: spec
- Business Sq. Ft. Retail Space _____ Type _____
- Industry Sq. Ft. _____ Type _____
- Home Occupation (Size ___ x ___) # Rooms _____ Use _____
- Accessory Building (Size ___ x ___) Use _____
- Addition to Existing Building (Size ___ x ___) Use _____
- Other _____

Water Supply: County Well (No. dwellings _____) Other _____

Sewer: Septic Tank/ Existing: YES NO County Other _____

Erosion & Sedimentation Control Plan Required? YES NO

Structures on this tract of land: Single family dwellings 1 proposed Manufactured homes _____ Other (specify) _____

Property owner of this tract of land own land that contains a manufactured home w/in five hundred feet (500') of tract listed above? YES NO

Required Property Line Setbacks:	Minimum	Actual	Minimum	Actual
Front	<u>35</u>	<u>40</u>	Rear	<u>25</u> <u>195</u>
Side	<u>10</u>	<u>45</u>	Corner	<u>20</u>
Nearest Building	<u>10</u>	<u>—</u>		


*Customer never confirmed, charged \$25 revision

If permits are granted I agree to conform to all ordinances and the laws of the State of North Carolina regulating such work and the specifications or plans submitted. I hereby swear that the foregoing statements are accurate and correct to the best of my knowledge.

Signature of Applicant: Bradley Built

Date: 2/24/05

11/2 N

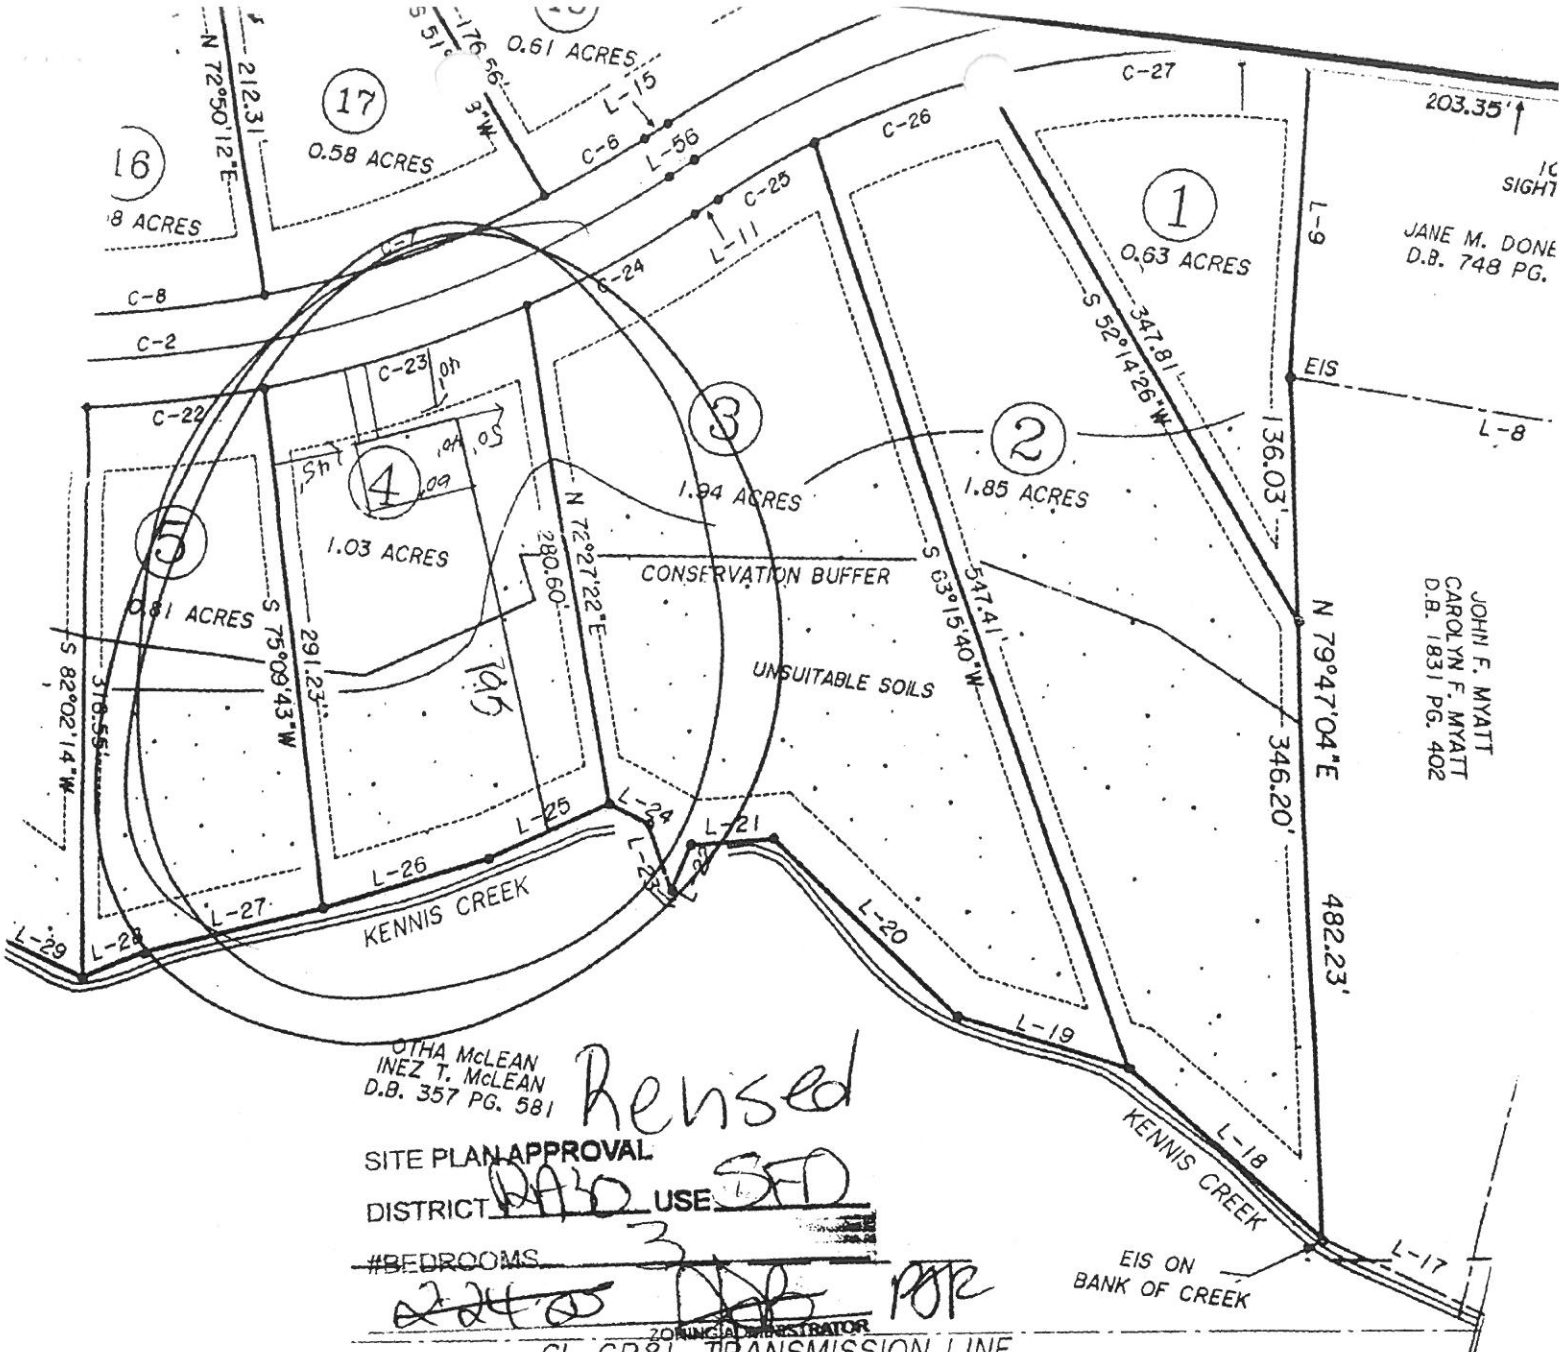

JANE M. DONE
D.B. 748 PG.

JOHN F. MYATT
CAROLYN F. MYATT
D.B. 1831 PG. 402

OTHA McLEAN
INEZ T. McLEAN
D.B. 357 PG. 581

Revised

SITE PLAN APPROVAL
DISTRICT DA30 USE SED
#BEDROOMS 3
2240 *10R*

CL CP&L TRANSMISSION LINE

11/2/05 100' R/W

10:53A.m.
49

1 DEPUTY

SOCIATES
BYOR



FOR REGISTRATION REGISTER OF DEEDS
KIMBERLY S. HARGROVE
HARNETT COUNTY, NC
2005 FEB 21 10:53:56 AM
BK: 2005 PG: 149-150 FEE: \$21.00

INSTRUMENT # 2005002883

FINAL SUBDIVISION PLAT FOR:
ALEX PLACE SUBDIVISION

OWNER: IOM DEVELOPERS
466 STANCIL ROAD
ANGIER, N.C. 27501

DEED BOOK 828 PAGE 281
PIN #0874-08-1256
BLACK RIVER TOWNSHIP
HARNETT COUNTY - NORTH CAROLINA
SCALE: 1" = 100' NOVEMBER 17
100 0

JAN-22-2002 02:29P FROM:


TO: 6398841

P: 4/4

PROPOS:

GRAHAM F. HOWARD JR.
PIN 00664-98-5296
MAP H2003-297

- L-44 S 26°45'06"E 63.16'
- L-45 S 05°53'44"W 47.09'
- L-46 S 26°21'24"E 66.24'
- L-47 S 16°54'13"W 43.31'
- L-48 S 05°48'34"W 77.06'
- L-49 N 83°15'57"W 42.39'
- L-50 S 10°22'28"W 25.38'
- L-44 98.60'
- L-45 144.41'
- L-46 45.58'
- L-47 27.18'
- L-48 39.72'
- L-49 23.93'
- L-50 71.72'
- L-19 S 10°00'09"W 36.35'
- L-20 S 36°35'14"W 103.66'
- L-21 S 11°45'03"E 62.08'
- L-22 S 75°26'07"E 100.70'
- L-23 S 62°38'25"W 176.07'
- L-24 S 20°41'29"W 36.08'
- L-25 S 32°03'22"E 121.09'
- L-19 S 36°35'14"W 103.66'
- L-20 N 12°51'21"W 89.60'
- L-21 N 24°40'32"W 151.96'
- L-22 N 36°41'07"W 103.66'
- L-23 N 37°48'23"W 62.08'
- L-24 N 27°58'31"W 100.70'
- L-25 N 11°12'36"W 176.07'
- L-26 N 45°35'58"E 36.08'
- L-12 N 06°23'55"W EIS 146.77'
- L-13 N 14°17'18" 94.40'
- L-14 N 7°29'35" 72.93'
- L-15 N 21°21'41" 212.14'
- L-16 N 92°15'28" 92.21'
- L-17 N 12°51'21" 89.60'
- L-18 N 24°40'32" 151.96'
- L-19 N 36°41'07" 103.66'
- L-20 N 37°48'23" 62.08'
- L-21 N 27°58'31" 100.70'
- L-22 N 11°12'36" 176.07'
- L-23 N 45°35'58" 36.08'
- L-24 N 06°23'55" 146.77'
- L-25 N 14°17'18" 94.40'
- L-26 N 7°29'35" 72.93'
- L-27 N 21°21'41" 212.14'
- L-28 N 92°15'28" 92.21'

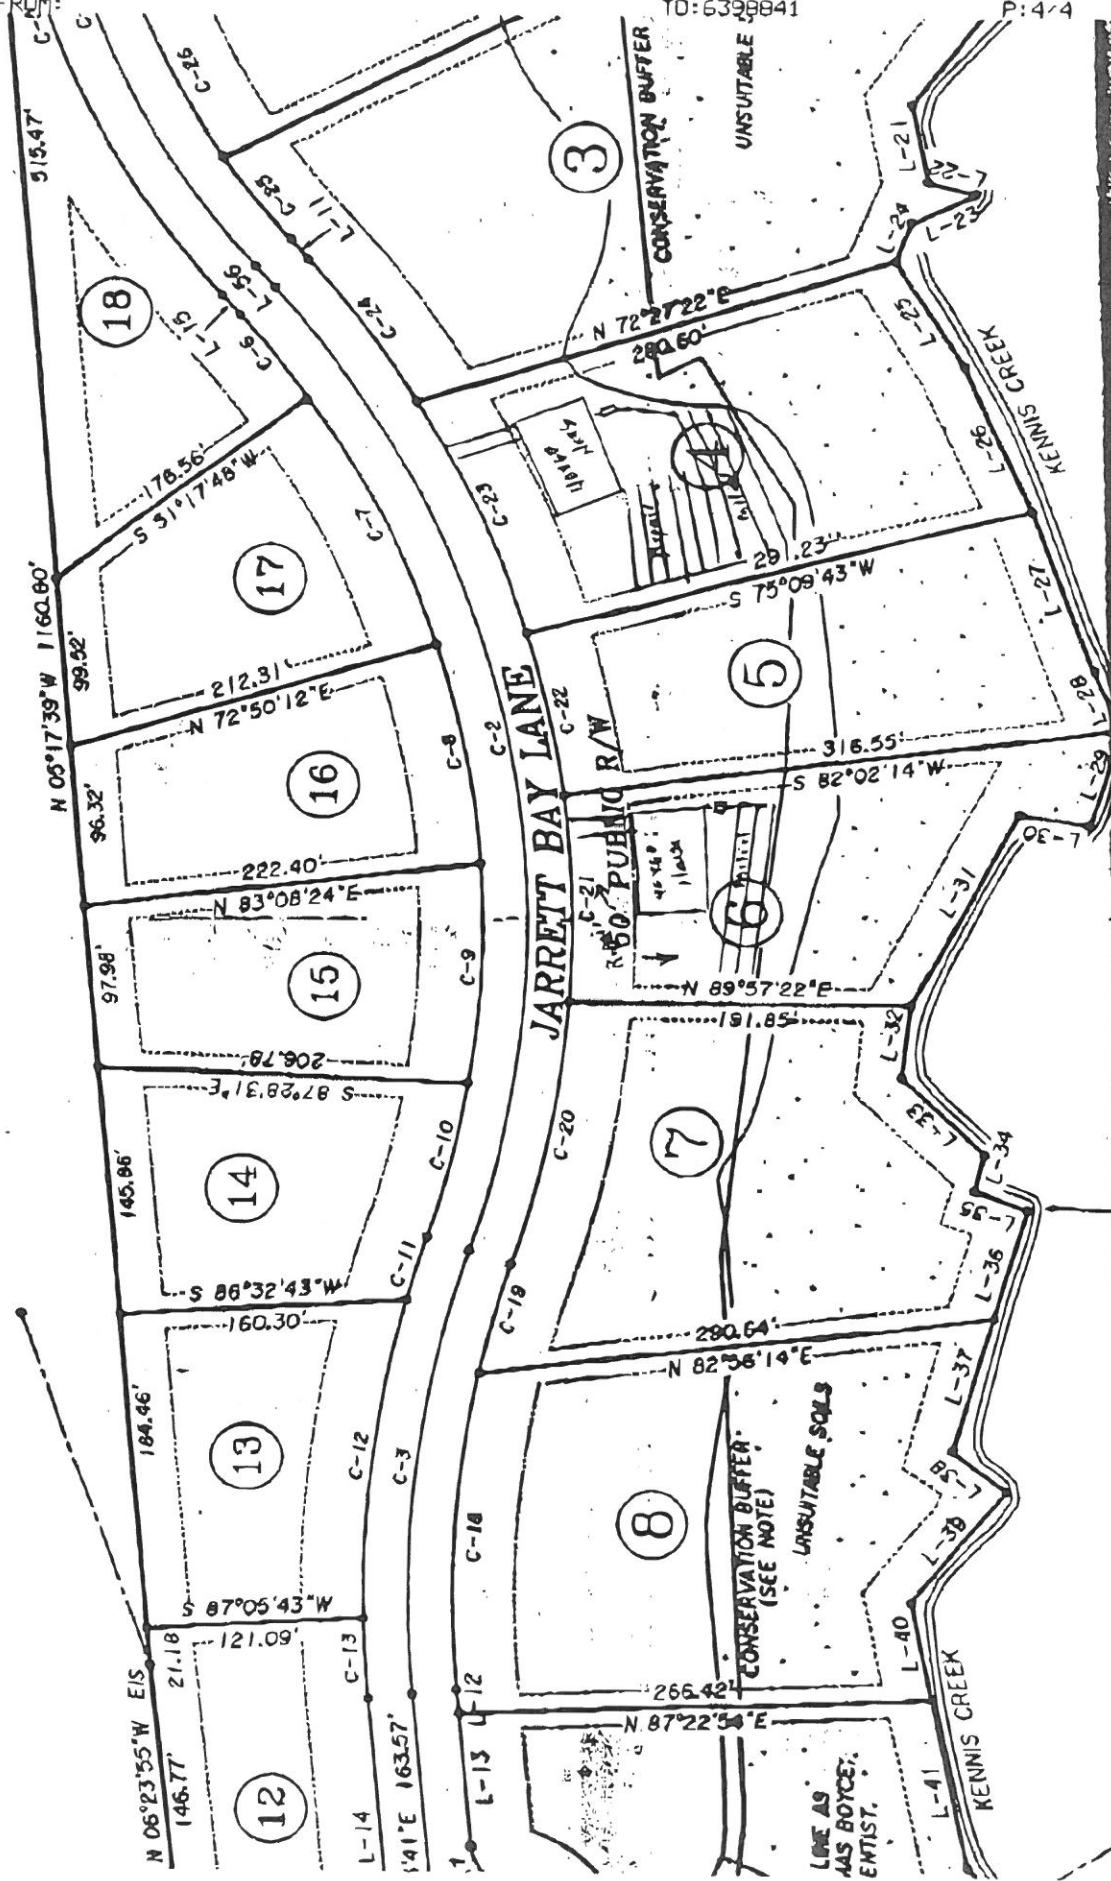

2004010312

FOR REGISTRATION REGISTER OF DEEDS
KIMBERLY S. HARGROVE
HARNETT COUNTY, NC
2004 JUN 03 04:04:58 PM
BK: 1939 PG: 554-556 FEE: \$17.00
NC REV STAMP: \$458.00
INSTRUMENT # 2004010312

HARNETT COUNTY TAX I.D.#
04-06064-0159
11/3/04 BY (CWP)

Prepared By: Pope & Pope, Attorneys at Law, P.A.
& Mail To: PO Box 790, Angier, N.C. 27501
File No.: 04-430

STATE OF NORTH CAROLINA
COUNTY OF HARNETT

WARRANTY DEED

This INDENTURE is made this 3rd day of June, 2004 by and between **Graham F. Howard, Jr. and Graham F. Howard, Sr. and wife, Edna C. Howard** whose address is 1110 Atkins Road, Fuquay-Varina, NC 27526 hereinafter referred to as Grantor; and **IOM Developers, Inc., a North Carolina Corporation**, whose address is 466 Stencil Road, Angier, NC 27501, hereinafter referred to as Grantee.

WITNESSETH:

WHEREAS Grantor(s) for and in consideration of the Sum of Ten Dollars (\$10.00) and other good and valuable consideration, receipt of which is hereby acknowledged, have given, granted, bargained, sold and conveyed, and by these presents do hereby give, grant, bargain, sell and convey unto the Grantee(s) in fee simple. Said property being all of that certain piece, parcel or tract of land situated, lying and being in Black River Township, Harnett County, North Carolina, and more particularly described as follows:

BEING all that certain tract or parcel of land containing 19.956 acres, more or less, as shown on map of survey entitled, "Boundary Survey for Graham F. Howard, Jr." dated 11/17/03 by Benton W. Dewar and Associates, Inc., Professional Land Surveyors, Holly Springs, North Carolina and recorded in Map No. 2003-1119, Harnett County Registry, reference to which is hereby made for greater accuracy of description.

This being the same property conveyed from Howard Farms to Graham F. Howard, Jr. by warranty deed dated 03/30/87 and recorded in Deed Book 828, Page 281, Harnett County Registry. For further reference see: Deed Book 1885, Page 723; Bankruptcy Court File - In Re: Graham F. Howard, Jr., Case No. 86-02766-S05, Order Filed: 04/06/87 whereby the Deed of Trust to J. Norwood Adams recorded in Deed Book 749, Page 281, Harnett County Registry and Deed of Trust to Richmond Guano Company recorded in Deed Book 804, Page 836 were deemed to be unsecured creditors of the debtor and should not have a secured or lien claim in any manner against the debtor or against the real property which was then titled to Howard Farms and

Harnett County Planning Department

PO Box 65, Lillington, NC 27546

910-893-7527

Environmental Health New Septic Systems Test
Environmental Health Code 800

- Place "property flags" in each corner of lot. All property lines must be clearly flagged approximately every 50 feet between corners.
- Place "house corner flags" at each corner of where the house/manufactured home will sit. Use additional flagging to outline driveways, garages, decks, out buildings, swimming pools, etc.
- Place flags at locations as developed on site plan by Customer Service Technician and you.
- Place Environmental Health "orange" card in location that is easily viewed from road.
- If property is thickly wooded, Environmental Health requires that you clean out the undergrowth to allow the soil evaluation to be performed. Inspectors should be able to walk freely around site. *No grading of property should be done.*
- After preparing proposed site call the voice permitting system at 910-893-7527 and give code 800 for Environmental Health confirmation.
- To hear results, call IVR again. Once approved, proceed to Central Permitting for permits

Environmental Health Existing Tank Inspections
Environmental Health Code 800

- Place Environmental Health "orange" card in location that is easily viewed from road.
- Prepare for inspection by removing soil over door as diagram indicates. Loosen trap door cover.
- After preparing trapdoor call the voice permitting system at 910-893-7527 and give code 800 for Environmental Health confirmation.
- To hear results, call IVR again. Once approved, proceed to Central Permitting for permits

Health and Sanitation Inspections
Health and Sanitation Plan Review 826

- After submitting plans for food and lodging, call the voice permitting system at 910-893-7527 and give code 826.
- To hear results, call IVR again. Once approved, proceed to Central Permitting for permits

Fire Marshal Inspections
Fire Marshall Plan Review Code 804

- Call the voice permitting system at 910-893-7527 and give code 804 for plan review.
- Pick up Fire Marshal's letter and place on job site until work is completed.
- To hear results, call IVR again. Once approved, proceed to Central Permitting for permits

Public Utilities

- Place stake with "orange" tape/name thirty feet (30) from the center of the road at the location you wish to have water tap installed.
- Allow four to six weeks after application for water/sewer taps. Call Utilities at 893-7575 for technical assistance.

Planning
Planning Plan Review Code 806

- To hear results, call IVR again. Once the plans are approved, proceed to Central Permitting for permits

Building Inspections
Building Plan Review Code 802

- Call the voice permitting system at 910-893-7527 and give code 802 for building plan review.
- For new housing/set up permits ensure you meet E 911 / Addressing prior to calling for final inspection.
- To hear results, call IVR again. Once the plans are approved, proceed to Central Permitting for permits

E911 Addressing

- Address numbers shall be mounted on the house, 3 inches high (5" for commercial).
- Numbers must be a contrasting color from house, must be clearly visible night and day at entrance of driveway if home is 100 ft or more from road, or if mailbox is on opposite side of road.
- Once you purchase permits and footing inspection has been approved call the voice permitting system at 910-893-7527 for address confirmation.
- To hear results, call IVR again.

Applicant Signature: _____

Date: _____

[Handwritten Signature] 2/24/05