

Initial Application Date: 3/21/05

Application # 0550011602B

R 1/18/00

v. Rec'd  
19-06  
BRW

1126169

COUNTY OF HARNETT LAND USE APPLICATION

Central Permitting 102 E. Front Street, Lillington, NC 27546

Phone: (910) 893-4759

Fax: (910) 893-2793

LANDOWNER: Cozart Smith Mailing Address: 4307 Driftwood Dr.

City: Raleigh State: NC Zip: 27606 Phone #: 919 880 4188

APPLICANT: Jason Batten Mailing Address: 2212 Stonerose Circle

City: Raleigh State: NC Zip: 27606 Phone #: 919 278 8790

PROPERTY LOCATION: SR #: 1450 SR Name: Talbert Drive Ball Rd.

Address: Talbert Drive Lot 42

Parcel: 050626003822 PIN: 0625-33-3989.000

Zoning: RA30 Subdivision: Hidden Valley Subdivision Lot #: 42 Lot Size: 1.00

Flood Plain: X Panel: 10 Watershed: N/A Deed Book/Page: OTR Plat Book/Page: Plat #1467-C

DIRECTIONS TO THE PROPERTY FROM LILLINGTON: 401 toward Fuquay Varina - (Christian Light) ->  
(1) Colesbury -> (2) Ball -> (3) Talbert -> Hidden Valley Dr -> (4) Talbert

PROPOSED USE:

Sg. Family Dwelling (Size 49 x 58) # of Bedrooms 3 # Baths 2 Basement (w/wo bath) NO Garage 418 sq ft Deck 380 sq ft

Multi-Family Dwelling No. Units \_\_\_\_\_ No. Bedrooms/Unit \_\_\_\_\_

Manufactured Home (Size x) # of Bedrooms \_\_\_\_\_ Garage \_\_\_\_\_ Deck \_\_\_\_\_

Number of persons per household 2

Business Sq. Ft. Retail Space \_\_\_\_\_ Type \_\_\_\_\_

Industry Sq. Ft. \_\_\_\_\_ Type \_\_\_\_\_

Church Seating Capacity \_\_\_\_\_ Kitchen \_\_\_\_\_

Home Occupation (Size x) # Rooms \_\_\_\_\_ Use \_\_\_\_\_

Additional Information: \_\_\_\_\_

Accessory Building (Size x) Use \_\_\_\_\_

Addition to Existing Building (Size x) Use \_\_\_\_\_

Other \_\_\_\_\_

Additional Information: \_\_\_\_\_

Water Supply:  County  Well (No. dwellings \_\_\_\_\_)  Other \_\_\_\_\_

Sewage Supply:  New Septic Tank  Existing Septic Tank  County Sewer  Other \_\_\_\_\_

Erosion & Sedimentation Control Plan Required? YES NO

Property owner of this tract of land own land that contains a manufactured home w/in five hundred feet (500') of tract listed above? YES NO

Structures on this tract of land: Single family dwellings 1 prop Manufactured homes - Other (specify) -

Required Residential Property Line Setbacks:	Minimum	Actual
Front	35	131'
Rear	25	90'
Side	10	27'
Corner	20	-
Nearest Building	10	-

If permits are granted I agree to conform to all ordinances and the laws of the State of North Carolina regulating such work and the specifications or plans submitted. I hereby swear that the foregoing statements are accurate and correct to the best of my knowledge.

Signature of Owner or Owner's Agent J. T. Batten

Date 3-8-05

\*\*This application expires 6 months from the initial date if no permits have been issued\*\*

A RECORDED SURVEY PLAT AND RECORDED DEED ARE REQUIRED WHEN APPLYING FOR A LAND USE APPLICATION

1/18 N

*Revised*

*Site plan did not change - but customer did clear mow land.*

PLAT PLAN APPROVAL

DISTRICT RA30 USE SFD

EDROOMS 3

3/21/05

*PAR*

Date 7-18-06


Zoning Administrator  
*A. Dugger*

LOT 43

LOT 1

LOT 42  
1.00 ACRES

LOT 41

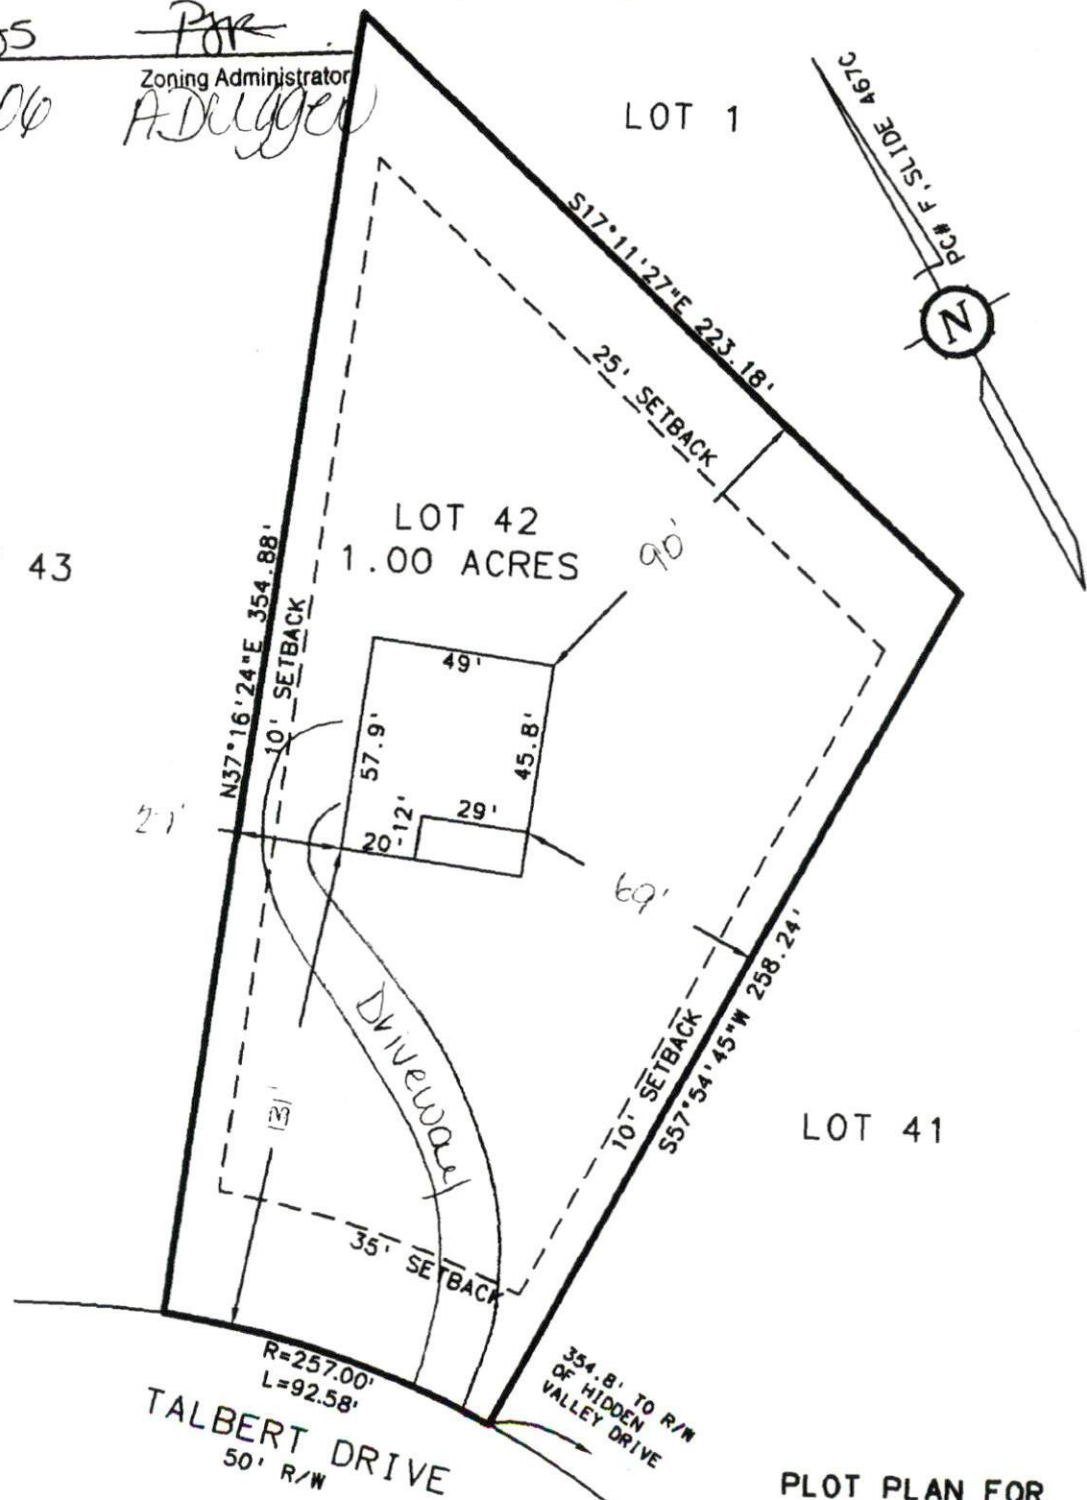

PLOT PLAN FOR  
 JASON BATTEN  
 LOT 42, PHASE 1  
 HIDDEN VALLEY SUBDIVISION  
 BUCKHORN TWSP., HARNETT CO., N.C.  
 MARCH 2005. SCALE: 1"=50'



**Harnett County Planning Department**

PO Box 65, Lillington, NC 27546

910-893-7527

Environmental Health New Septic Systems Test

**Environmental Health Code 800**

- Place "property flags" in each corner of lot. All property lines must be clearly flagged approximately every 50 feet between corners.
- Place "house corner flags" at each corner of where the house/manufactured home will sit. Use additional flagging to outline driveways, garages, decks, out buildings, swimming pools, etc.
- Place flags at locations as developed on site plan by Customer Service Technician and you.
- Place Environmental Health "orange" card in location that is easily viewed from road.
- If property is thickly wooded, Environmental Health requires that you clean out the undergrowth to allow the soil evaluation to be performed. Inspectors should be able to walk freely around site. *No grading of property should be done.*
- After preparing proposed site call the voice permitting system at 910-893-7527 and give code 800 for Environmental Health confirmation.
- To hear results, call IVR again. Once approved, proceed to Central Permitting for permits

Environmental Health Existing Tank Inspections

**Environmental Health Code 800**

- Place Environmental Health "orange" card in location that is easily viewed from road.
- Prepare for inspection by removing soil over door as diagram indicates. Loosen trap door cover.
- After preparing trapdoor call the voice permitting system at 910-893-7527 and give code 800 for Environmental Health confirmation.
- To hear results, call IVR again. Once approved, proceed to Central Permitting for permits

Health and Sanitation Inspections

**Health and Sanitation Plan Review 826**

- After submitting plans for food and lodging, call the voice permitting system at 910-893-7527 and give code 826.
- To hear results, call IVR again. Once approved, proceed to Central Permitting for permits

Fire Marshal Inspections

**Fire Marshal Plan Review Code 804**

- Call the voice permitting system at 910-893-7527 and give code 804 for plan review.
- Pick up Fire Marshal's letter and place on job site until work is completed.
- To hear results, call IVR again. Once approved, proceed to Central Permitting for permits

Public Utilities

- Place stake with "orange" tape/name thirty feet (30) from the center of the road at the location you wish to have water tap installed.
- Allow four to six weeks after application for water/sewer taps. Call Utilities at 893-7575 for technical assistance.

Planning

**Planning Plan Review Code 806**

- To hear results, call IVR again. Once the plans are approved, proceed to Central Permitting for permits

Building Inspections

**Building Plan Review Code 802**

- Call the voice permitting system at 910-893-7527 and give code 802 for building plan review.
- For new housing/set up permits ensure you meet E 911 / Addressing prior to calling for final inspection.
- To hear results, call IVR again. Once the plans are approved, proceed to Central Permitting for permits

E911 Addressing

- Address numbers shall be mounted on the house, 3 inches high (5" for commercial).
- Numbers must be a contrasting color from house, must be clearly visible night and day at entrance of driveway if home is 100 ft or more from road, or if mailbox is on opposite side of road.
- Once you purchase permits and footing inspection has been approved call the voice permitting system at 910-893-7527 for address confirmation.
- To hear results, call IVR again.

Applicant Signature:  Date: 3-21-05