

Initial Application Date: 4-12-05

ENV. Rec'd 4/13

Application # 05-50011859  
896356

COUNTY OF HARNETT LAND USE APPLICATION  
Central Permitting 102 E. Front Street, Lillington, NC 27546 Phone: (910) 893-4759 Fax: (910) 893-2793

LANDOWNER: STEPHENSON BUILDERS INC. Mailing Address: 1197 N. RAYGH ST. ANGIER NC. 2801  
City: ANGIER State: NC Zip: 27501 Phone #: 919-639-2862  
APPLICANT: STEPHENSON BUILDERS INC. Mailing Address: 1197 N. RAYGH ST. NC  
City: ANGIER State: N.C. Zip: 27501 Phone #: 919-639-2862

PROPERTY LOCATION: SR #: \_\_\_\_\_ SR Name: WED DENNING  
Address: 50 Bass Lane  
Parcel: 24 0663 0008 23 PIN: 0663-60-2728.000  
Zoning: R130 Subdivision: ADAMS POINT Lot #: 24 Lot Size: 0.576  
Flood Plain: \_\_\_\_\_ Panel: \_\_\_\_\_ Watershed: IV Deed Book/Page: Clearing statement Plat Book/Page: 2001-1160  
DIRECTIONS TO THE PROPERTY FROM LILLINGTON: 210 EAST TO JAMES HARRIS RD.  
TURN LT. ON JAMES HARRIS THEN RT. ON WED DENNING THEN  
RIGHT ON BASS LANE LOT 24 ON RIGHT

PROPOSED USE:

- Sg. Family Dwelling (Size 63 x 58) # of Bedrooms 3 # Baths 2 Basement (w/wc bath) \_\_\_\_\_ Garage  Deck
- Multi-Family Dwelling No. Units \_\_\_\_\_ No. Bedrooms/Unit \_\_\_\_\_
- Manufactured Home (Size \_\_\_\_\_ x \_\_\_\_\_) # of Bedrooms \_\_\_\_\_ Garage \_\_\_\_\_ Deck \_\_\_\_\_
- Number of persons per household 5
- Business Sq. Ft. Retail Space \_\_\_\_\_ Type \_\_\_\_\_
- Industry Sq. Ft. \_\_\_\_\_ Type \_\_\_\_\_
- Church Seating Capacity \_\_\_\_\_ Kitchen \_\_\_\_\_
- Home Occupation (Size \_\_\_\_\_ x \_\_\_\_\_) # Rooms \_\_\_\_\_ Use \_\_\_\_\_
- Additional Information: \_\_\_\_\_
- Accessory Building (Size \_\_\_\_\_ x \_\_\_\_\_) Use \_\_\_\_\_
- Addition to Existing Building (Size \_\_\_\_\_ x \_\_\_\_\_) Use \_\_\_\_\_
- Other \_\_\_\_\_

Additional Information: \_\_\_\_\_

Water Supply:  County  Well (No. dwellings \_\_\_\_\_)  Other \_\_\_\_\_

Sewage Supply:  New Septic Tank  Existing Septic Tank  County Sewer  Other \_\_\_\_\_

Erosion & Sedimentation Control Plan Required? YES  NO

Property owner of this tract of land own land that contains a manufactured home w/in five hundred feet (500') of tract listed above? YES  NO

Structures on this tract of land: Single family dwellings 1 proposed Manufactured homes \_\_\_\_\_ Other (specify) \_\_\_\_\_

Required Residential Property Line Setbacks:

	Minimum	Actual
Front	35	52'
Rear	25	92' / 89
Side	10	36'
Corner	20	—
Nearest Building	10	—

If permits are granted I agree to conform to all ordinances and the laws of the State of North Carolina regulating such work and the specifications or plans submitted. I hereby swear that the foregoing statements are accurate and correct to the best of my knowledge.

[Signature]  
Signature of Owner or Owner's Agent

4-12-05  
Date

\*\*This application expires 6 months from the initial date if no permits have been issued\*\*


A RECORDED SURVEY PLAT AND RECORDED DEED ARE REQUIRED WHEN APPLYING FOR A LAND USE APPLICATION

4/12 N

STEPHENSON BUILDERS INC

LOT 24 ADAMS POINT

SCALE = 1" = 50'

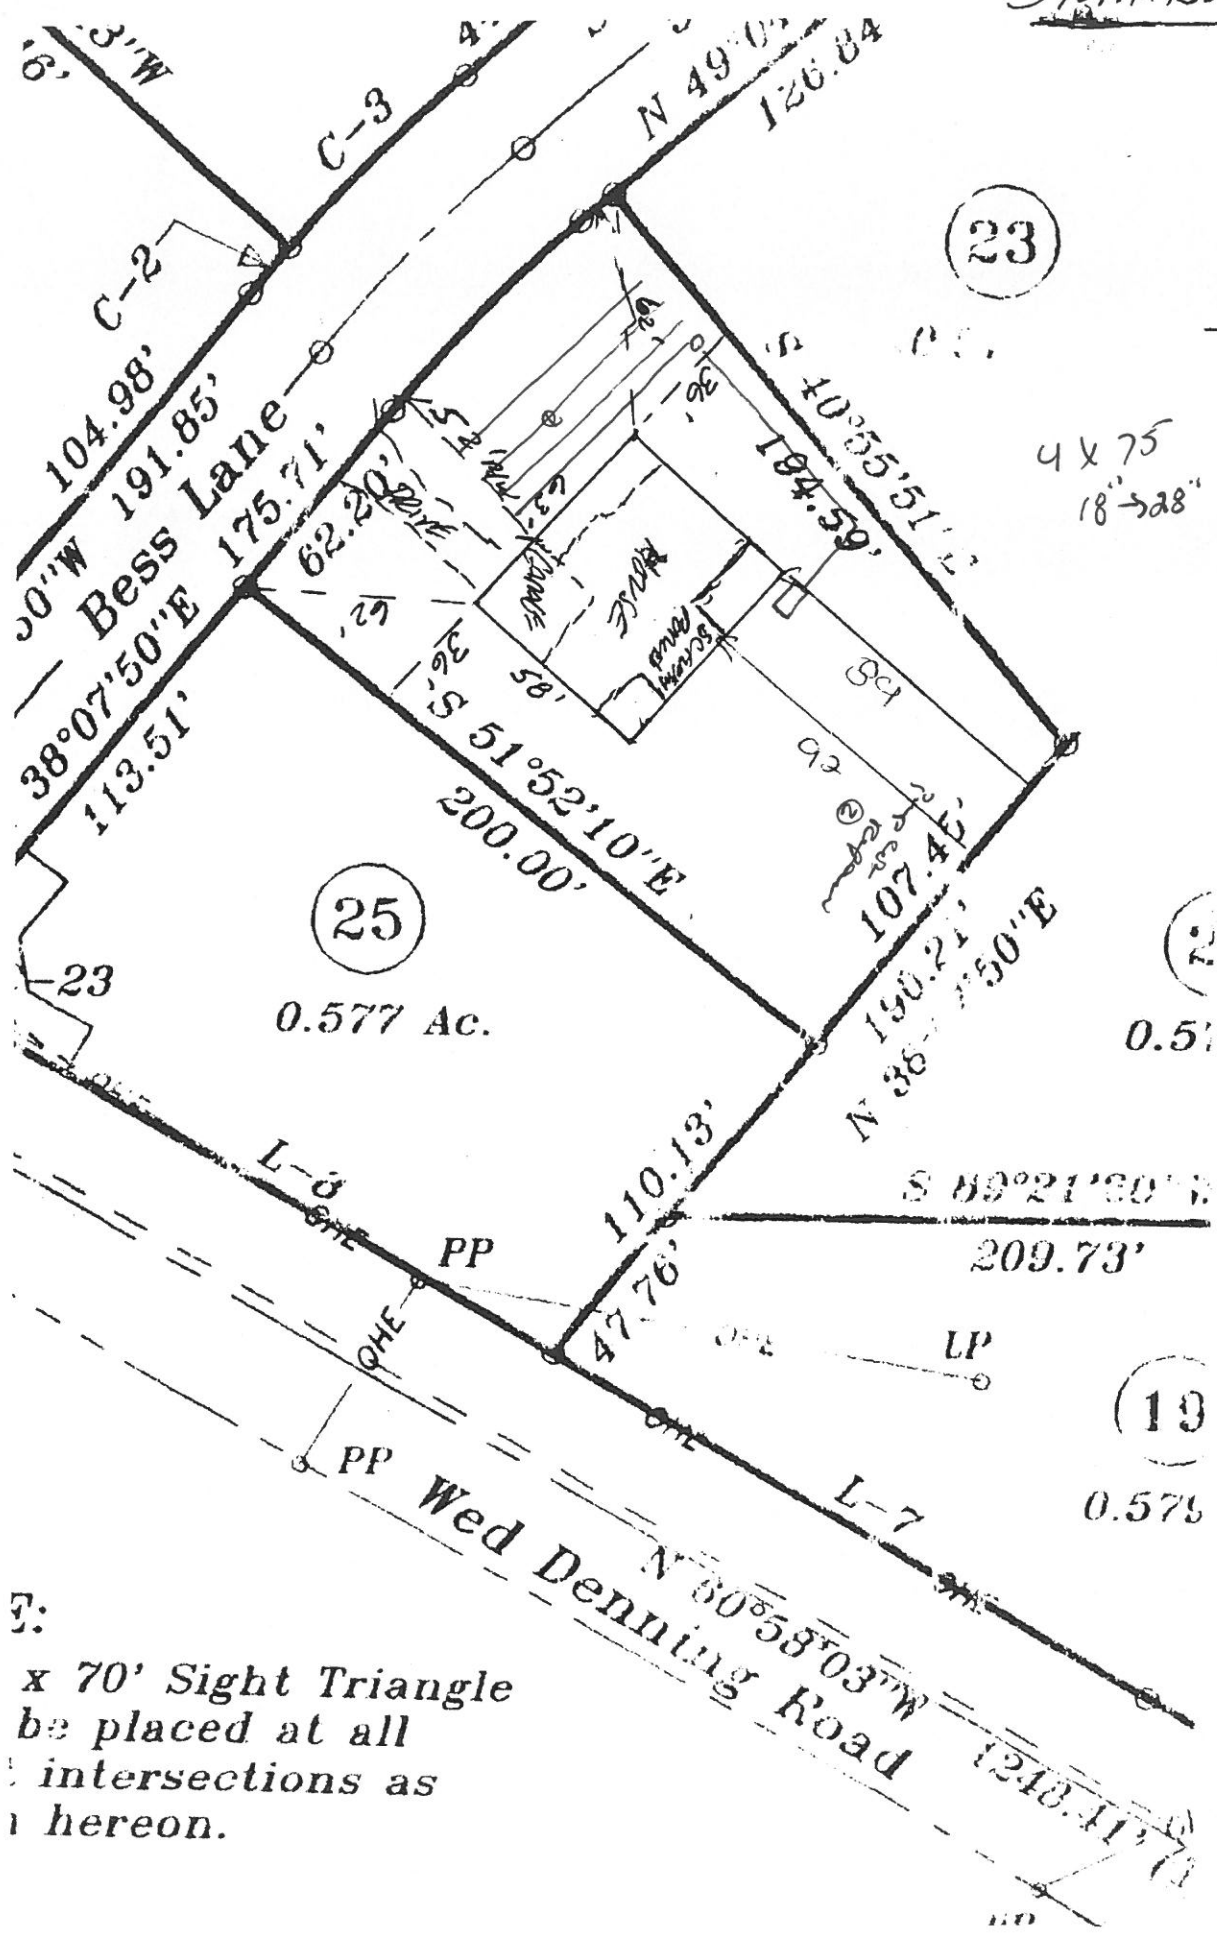

23

25

0.577 Ac.

24

0.51

19

0.576

4 x 75  
18" x 28"

SITE PLAN APPROVAL  
 DISTRICT RA3D USE SFD  
 #BEDROOMS 3


4-12-05  
 ZONING ADMINISTRATOR

7:  
 x 70' Sight Triangle  
 be placed at all  
 intersections as  
 hereon.

STEPHENSON BUILDERS INC

LOT 24 ADAMS PARK

SCALE = 1" = 50'

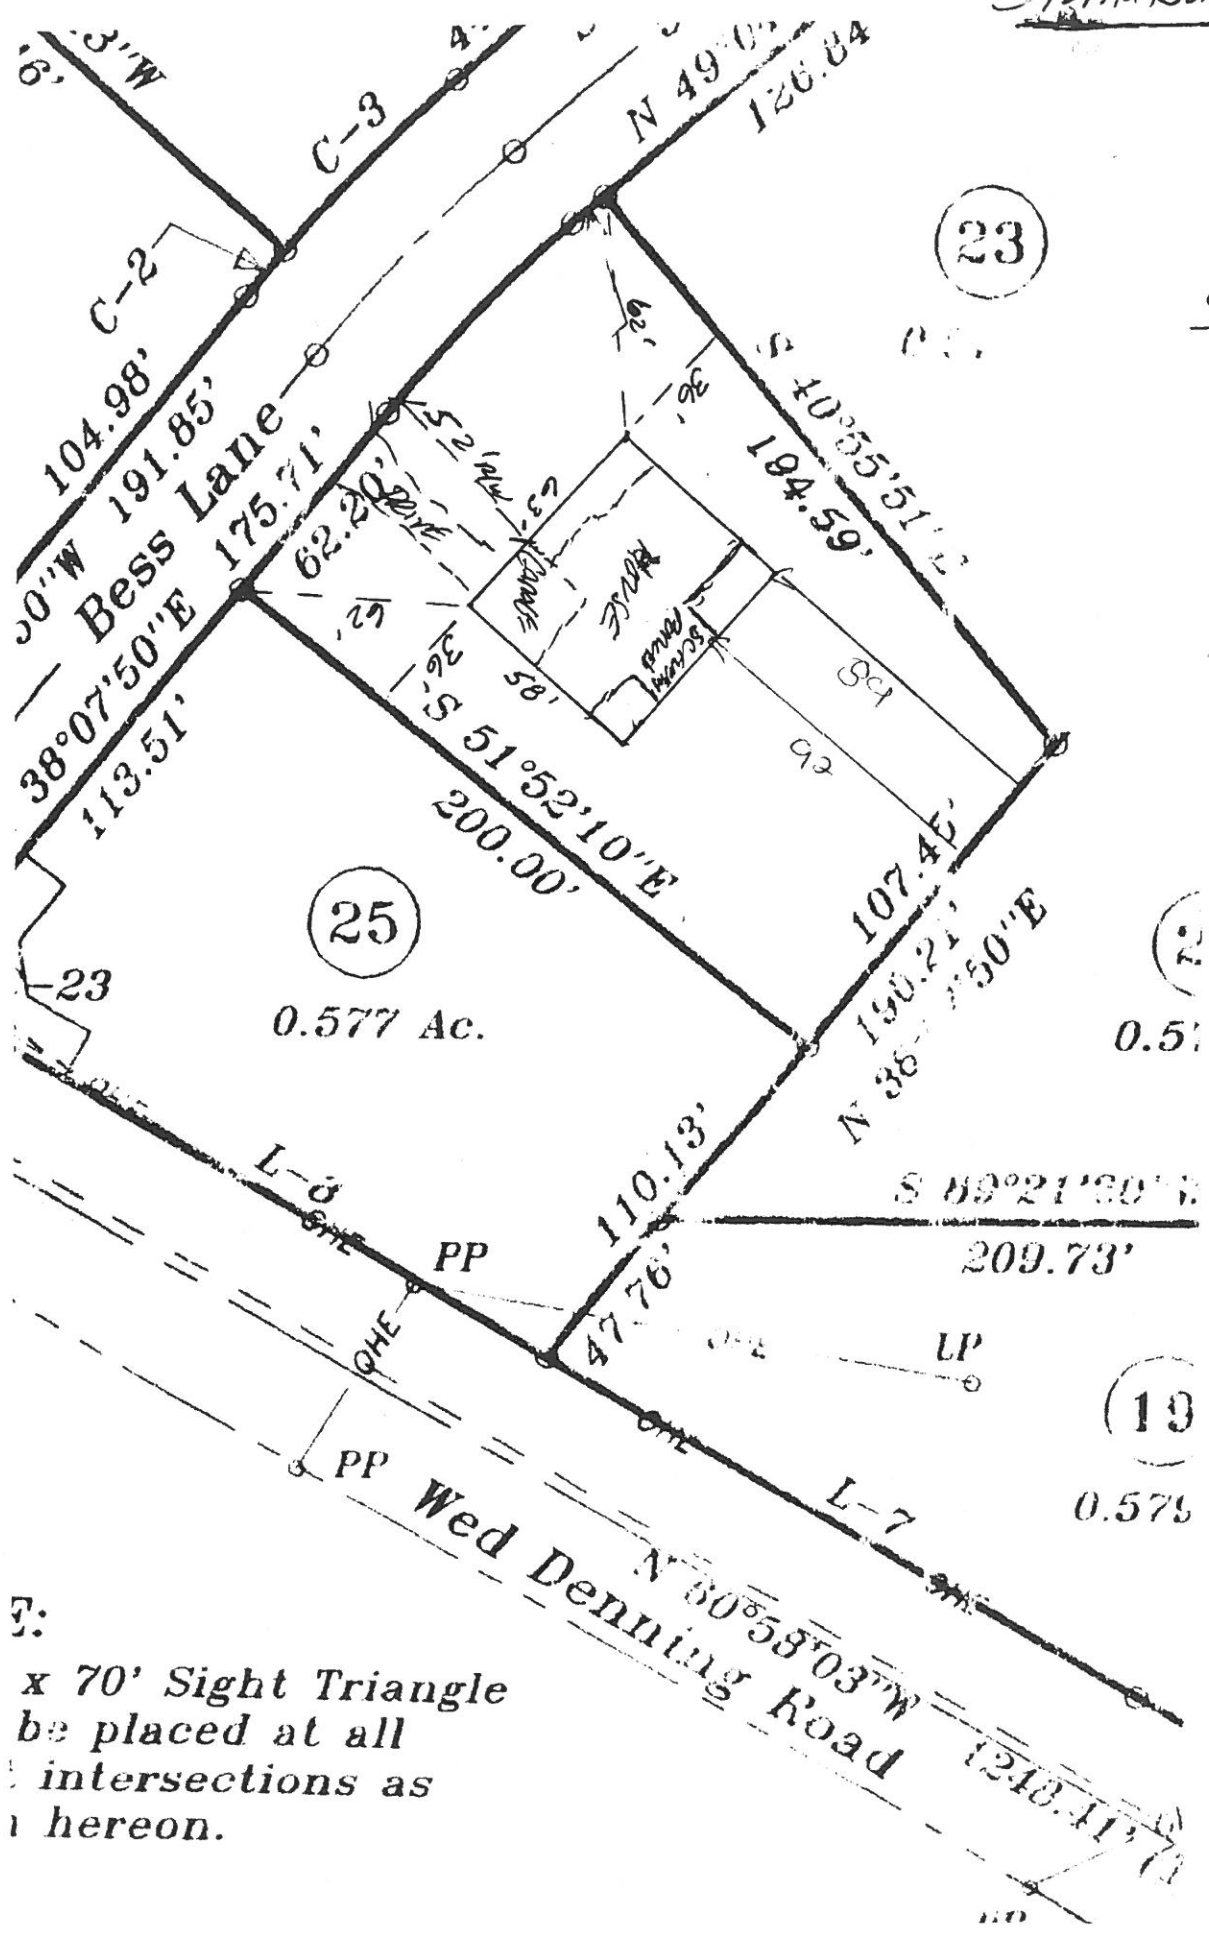

SITE PLAN APPROVAL  
 DISTRICT RA3D USE SFD  
 #BEDROOMS 3  
4-12-05  
 ZONING ADMINISTRATOR

7:  
 x 70' Sight Triangle  
 be placed at all  
 intersections as  
 hereon.

Application Number: 05-50011859

Phone Access Code: \_\_\_\_\_

## Harnett County Planning Department

PO Box 65, Lillington, NC 27546  
910-893-7527

Environmental Health New Septic Systems Test  
**Environmental Health Code 800**

- Place "property flags" in each corner of lot. All property lines must be clearly flagged approximately every 50 feet between corners.
- Place "house corner flags" at each corner of where the house/manufactured home will sit. Use additional flagging to outline driveways, garages, decks, out buildings, swimming pools, etc.
- Place flags at locations as developed on site plan by Customer Service Technician and you.
- Place Environmental Health "orange" card in location that is easily viewed from road.
- If property is thickly wooded, Environmental Health requires that you clean out the undergrowth to allow the soil evaluation to be performed. Inspectors should be able to walk freely around site. *No grading of property should be done.*
- After preparing proposed site call the voice permitting system at 910-893-7527 and give code 800 for Environmental Health confirmation.
- To hear results, call IVR again. Once approved, proceed to Central Permitting for permits

Environmental Health Existing Tank Inspections  
**Environmental Health Code 800**

- Place Environmental Health "orange" card in location that is easily viewed from road.
- Prepare for inspection by removing soil over door as diagram indicates. Loosen trap door cover.
- After preparing trapdoor call the voice permitting system at 910-893-7527 and give code 800 for Environmental Health confirmation.
- To hear results, call IVR again. Once approved, proceed to Central Permitting for permits

Health and Sanitation Inspections  
**Health and Sanitation Plan Review 826**

- After submitting plans for food and lodging, call the voice permitting system at 910-893-7527 and give code 826.
- To hear results, call IVR again. Once approved, proceed to Central Permitting for permits

Fire Marshal Inspections  
**Fire Marshall Plan Review Code 804**

- Call the voice permitting system at 910-893-7527 and give code 804 for plan review.
- Pick up Fire Marshal's letter and place on job site until work is completed.
- To hear results, call IVR again. Once approved, proceed to Central Permitting for permits

Public Utilities

- Place stake with "orange" tape/name thirty feet (30) from the center of the road at the location you wish to have water tap installed.
- Allow four to six weeks after application for water/sewer taps. Call Utilities at 893-7575 for technical assistance.

Planning  
**Planning Plan Review Code 806**

- To hear results, call IVR again. Once the plans are approved, proceed to Central Permitting for permits

Building Inspections  
**Building Plan Review Code 802**

- Call the voice permitting system at 910-893-7527 and give code 802 for building plan review.
- For new housing/set up permits ensure you meet E 911 / Addressing prior to calling for final inspection.
- To hear results, call IVR again. Once the plans are approved, proceed to Central Permitting for permits

E911 Addressing

- Address numbers shall be mounted on the house, 3 inches high (5" for commercial).
- Numbers must be a contrasting color from house, must be clearly visible night and day at entrance of driveway if home is 100 ft or more from road, or if mailbox is on opposite side of road.
- Once you purchase permits and footing inspection has been approved call the voice permitting system at 910-893-7527 for address confirmation.
- To hear results, call IVR again.

Applicant Signature: \_\_\_\_\_

Date: 4-12-05